




Storm Water Asbuilt Sheet Index

SWCatchment 15r

Compiled on 2023-05-02 from as-builts of various dates. For up to date as-builts please visit [http://geo.rdc.govt.nz/images/plotfiles/3waters\\_mobile\\_asbuilts/](http://geo.rdc.govt.nz/images/plotfiles/3waters_mobile_asbuilts/)

U16-1000/43.03

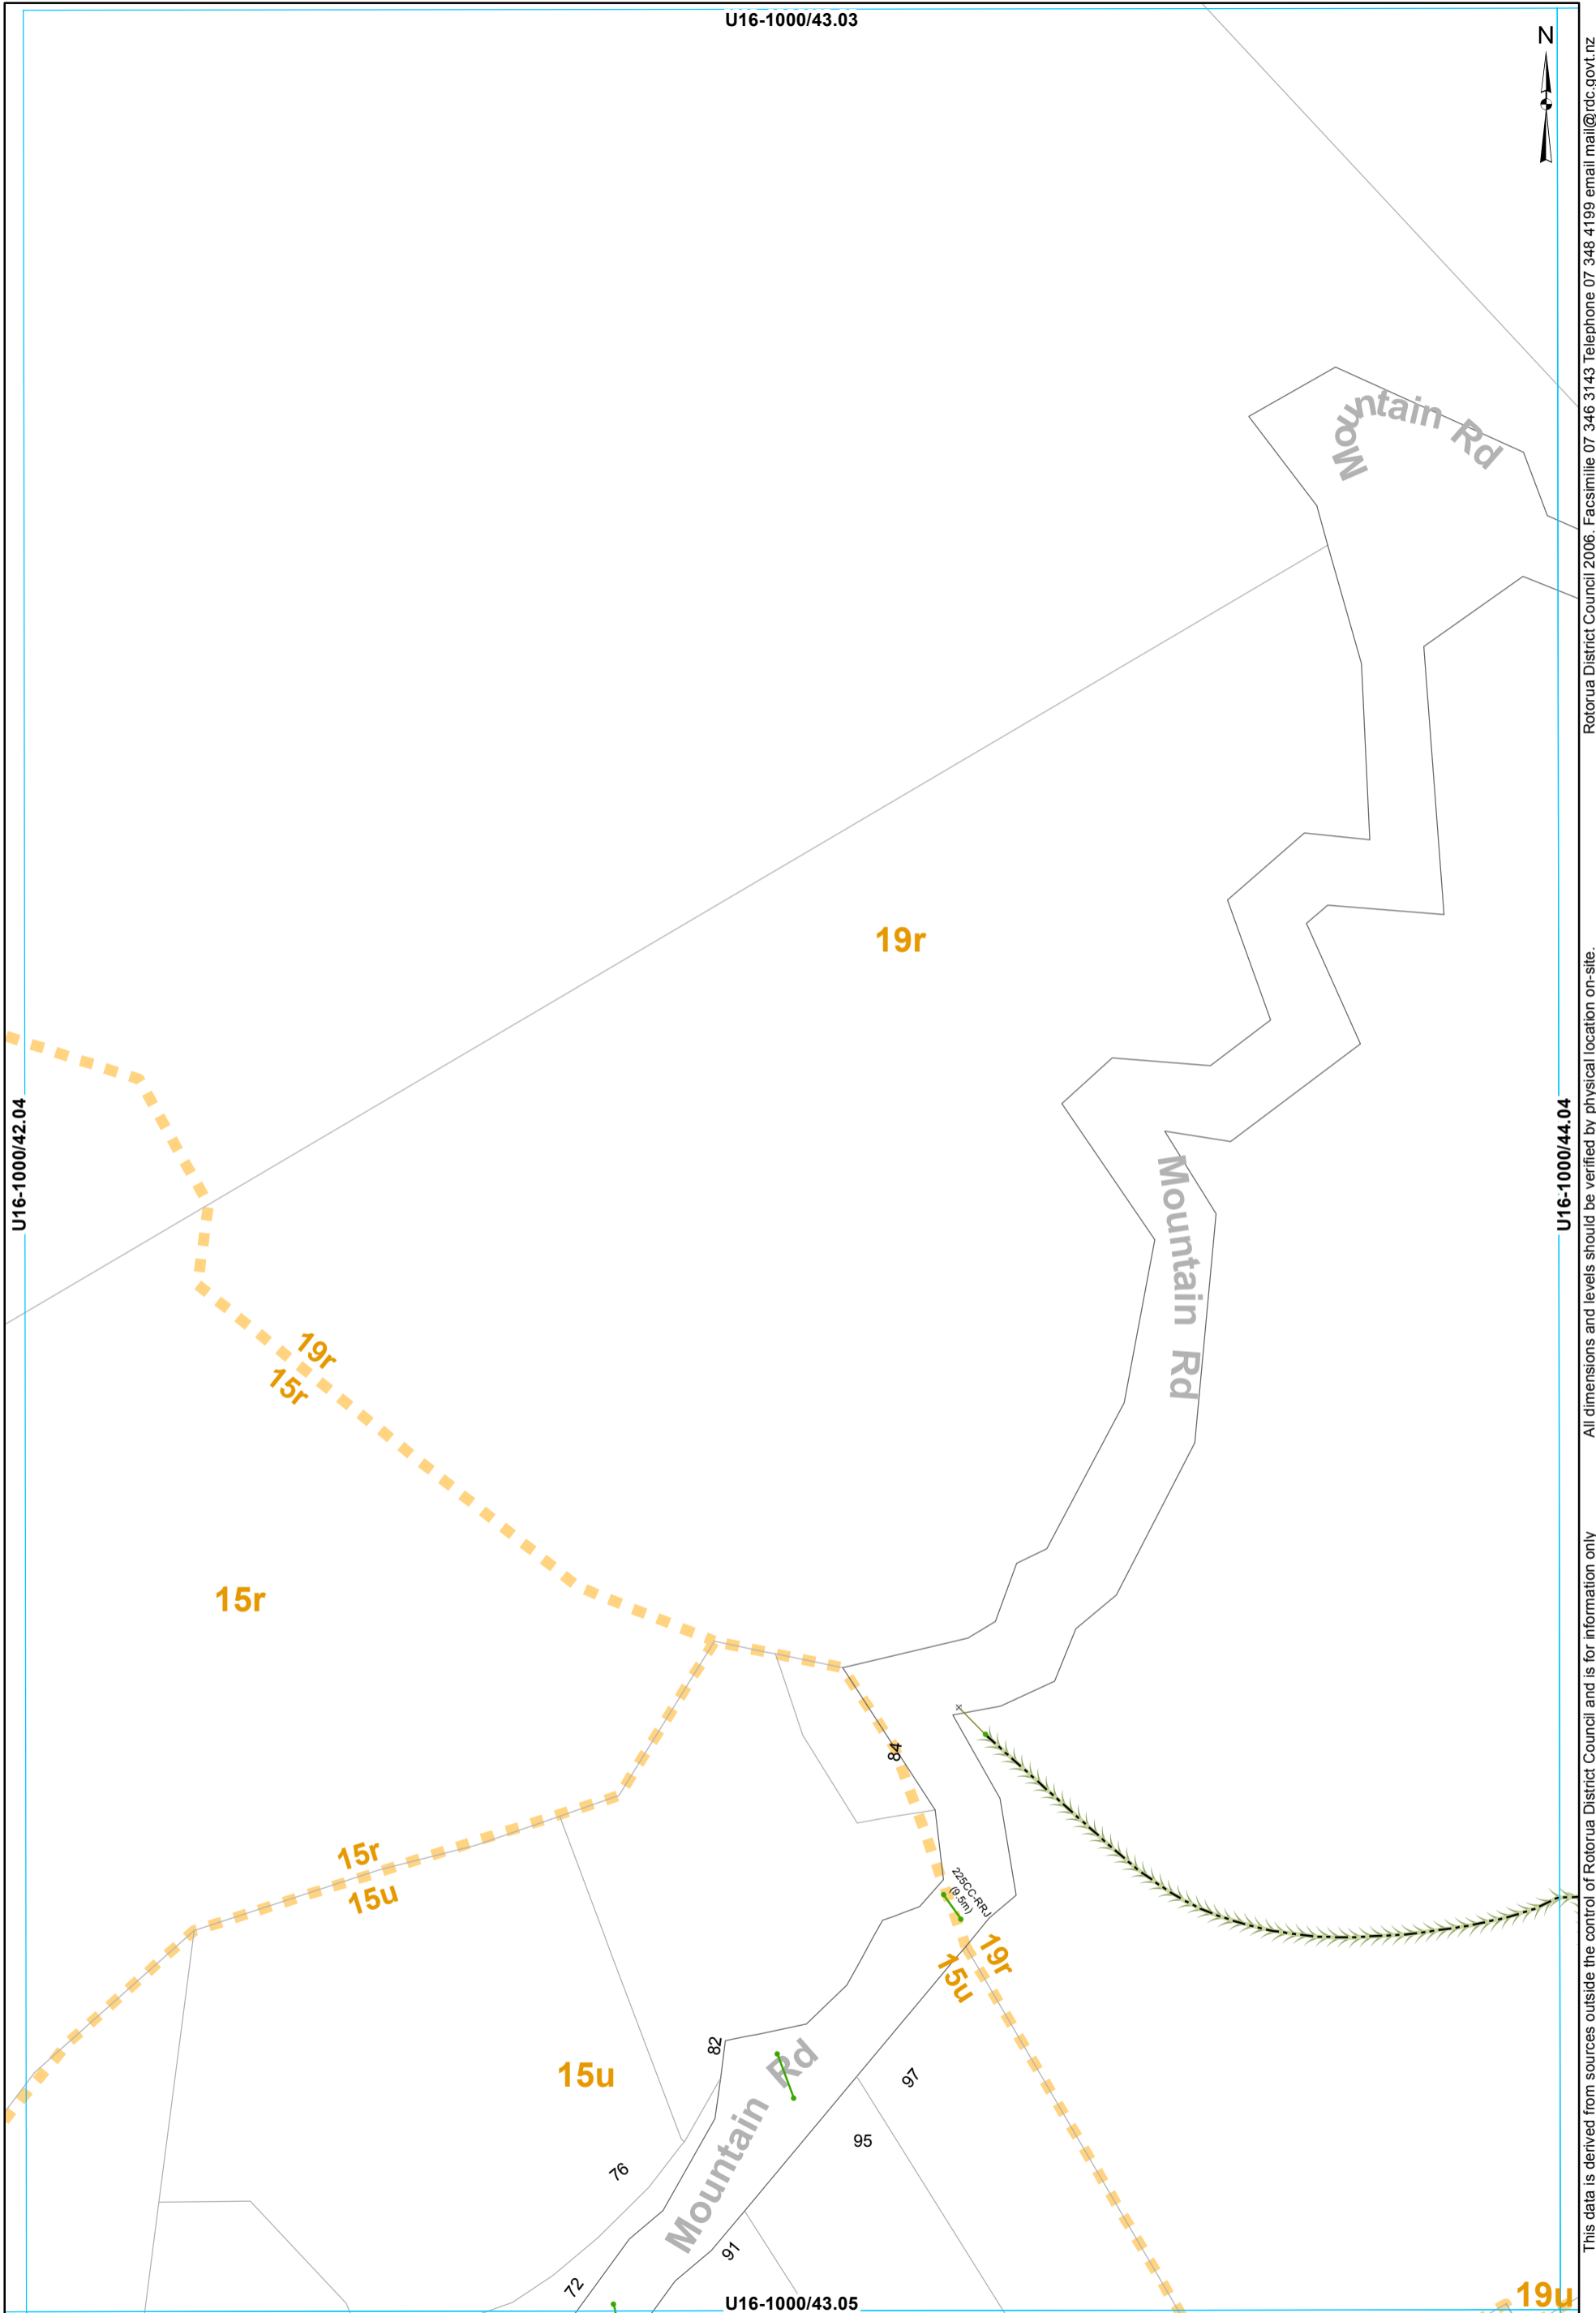

- × SWInlet
- Node
- Overland Flow
- Culvert
- SWLead
- Catchment Boundary

STORMWATER SERVICES  
1:2000 @ A3 - (U16-1000/43.04)

This data is derived from sources outside the control of Rotorua District Council and is for information only

Rotorua District Council 2006. Facsimile 07 346 3143 Telephone 07 348 4199 email mail@rdc.govt.nz

U16-1000/39.04



U16-1000/38.05

U16-1000/40.05


15r

Paradise Valley Rd

Paradise Valley Rd

105

93

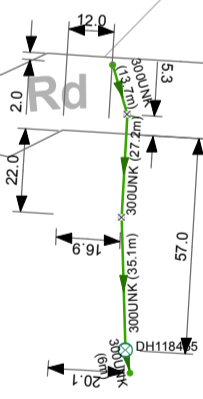

All dimensions and levels should be verified by physical location on-site.

Rotorua District Council 2006. Facsimile 07 346 3143 Telephone 07 348 4199 email mail@rdc.govt.nz

- ⊗ SWManhole    — Gravity Main    SWServiceline
- × SWInlet       — SWServiceline
- Node

**STORMWATER SERVICES**  
1:2000 @ A3 - (U16-1000/39.05)

U16-1000/39.06

U16-1000/40.04



U16-1000/39.05

15r

U16-1000/41.05


Paradise Valley Rd

40

55

32

U16-1000/40.06

• Node     Stream

**STORMWATER SERVICES**  
1:2000 @ A3 - (U16-1000/40.05)

This data is derived from sources outside the control of Rotorua District Council and is for information only. All dimensions and levels should be verified by physical location on-site.

Rotorua District Council 2006. Facsimile 07 346 3143 Telephone 07 348 4199 email mail@rdc.govt.nz

U16-1000/41.04



U16-1000/40.05

U16-1000/42.05

15r

15r

15u

15u

357

357A

U16-1000/41.06

361

300LNK (20m)

349

DH119838 600CC-RRJ (79.8m)

DH119839

750CC-RRJ (88.1m)


345

335

- ⊗ SWManhole
- × SWInlet
- Node
- ▬ Lined Channel
- ▬ Open Drain
- ▬ Stream
- ▬ Culvert
- ▬ Gravity Main
- ▬ SWLead
- ▬ Catchment Boundary

**STORMWATER SERVICES**  
1:2000 @ A3 - (U16-1000/41.05)

All dimensions and levels outside the control of Rotorua District Council and is for information only. Rotorua District Council 2006. Facsimile 07 346 3143 Telephone 07 348 4199 email mail@rdc.govt.nz

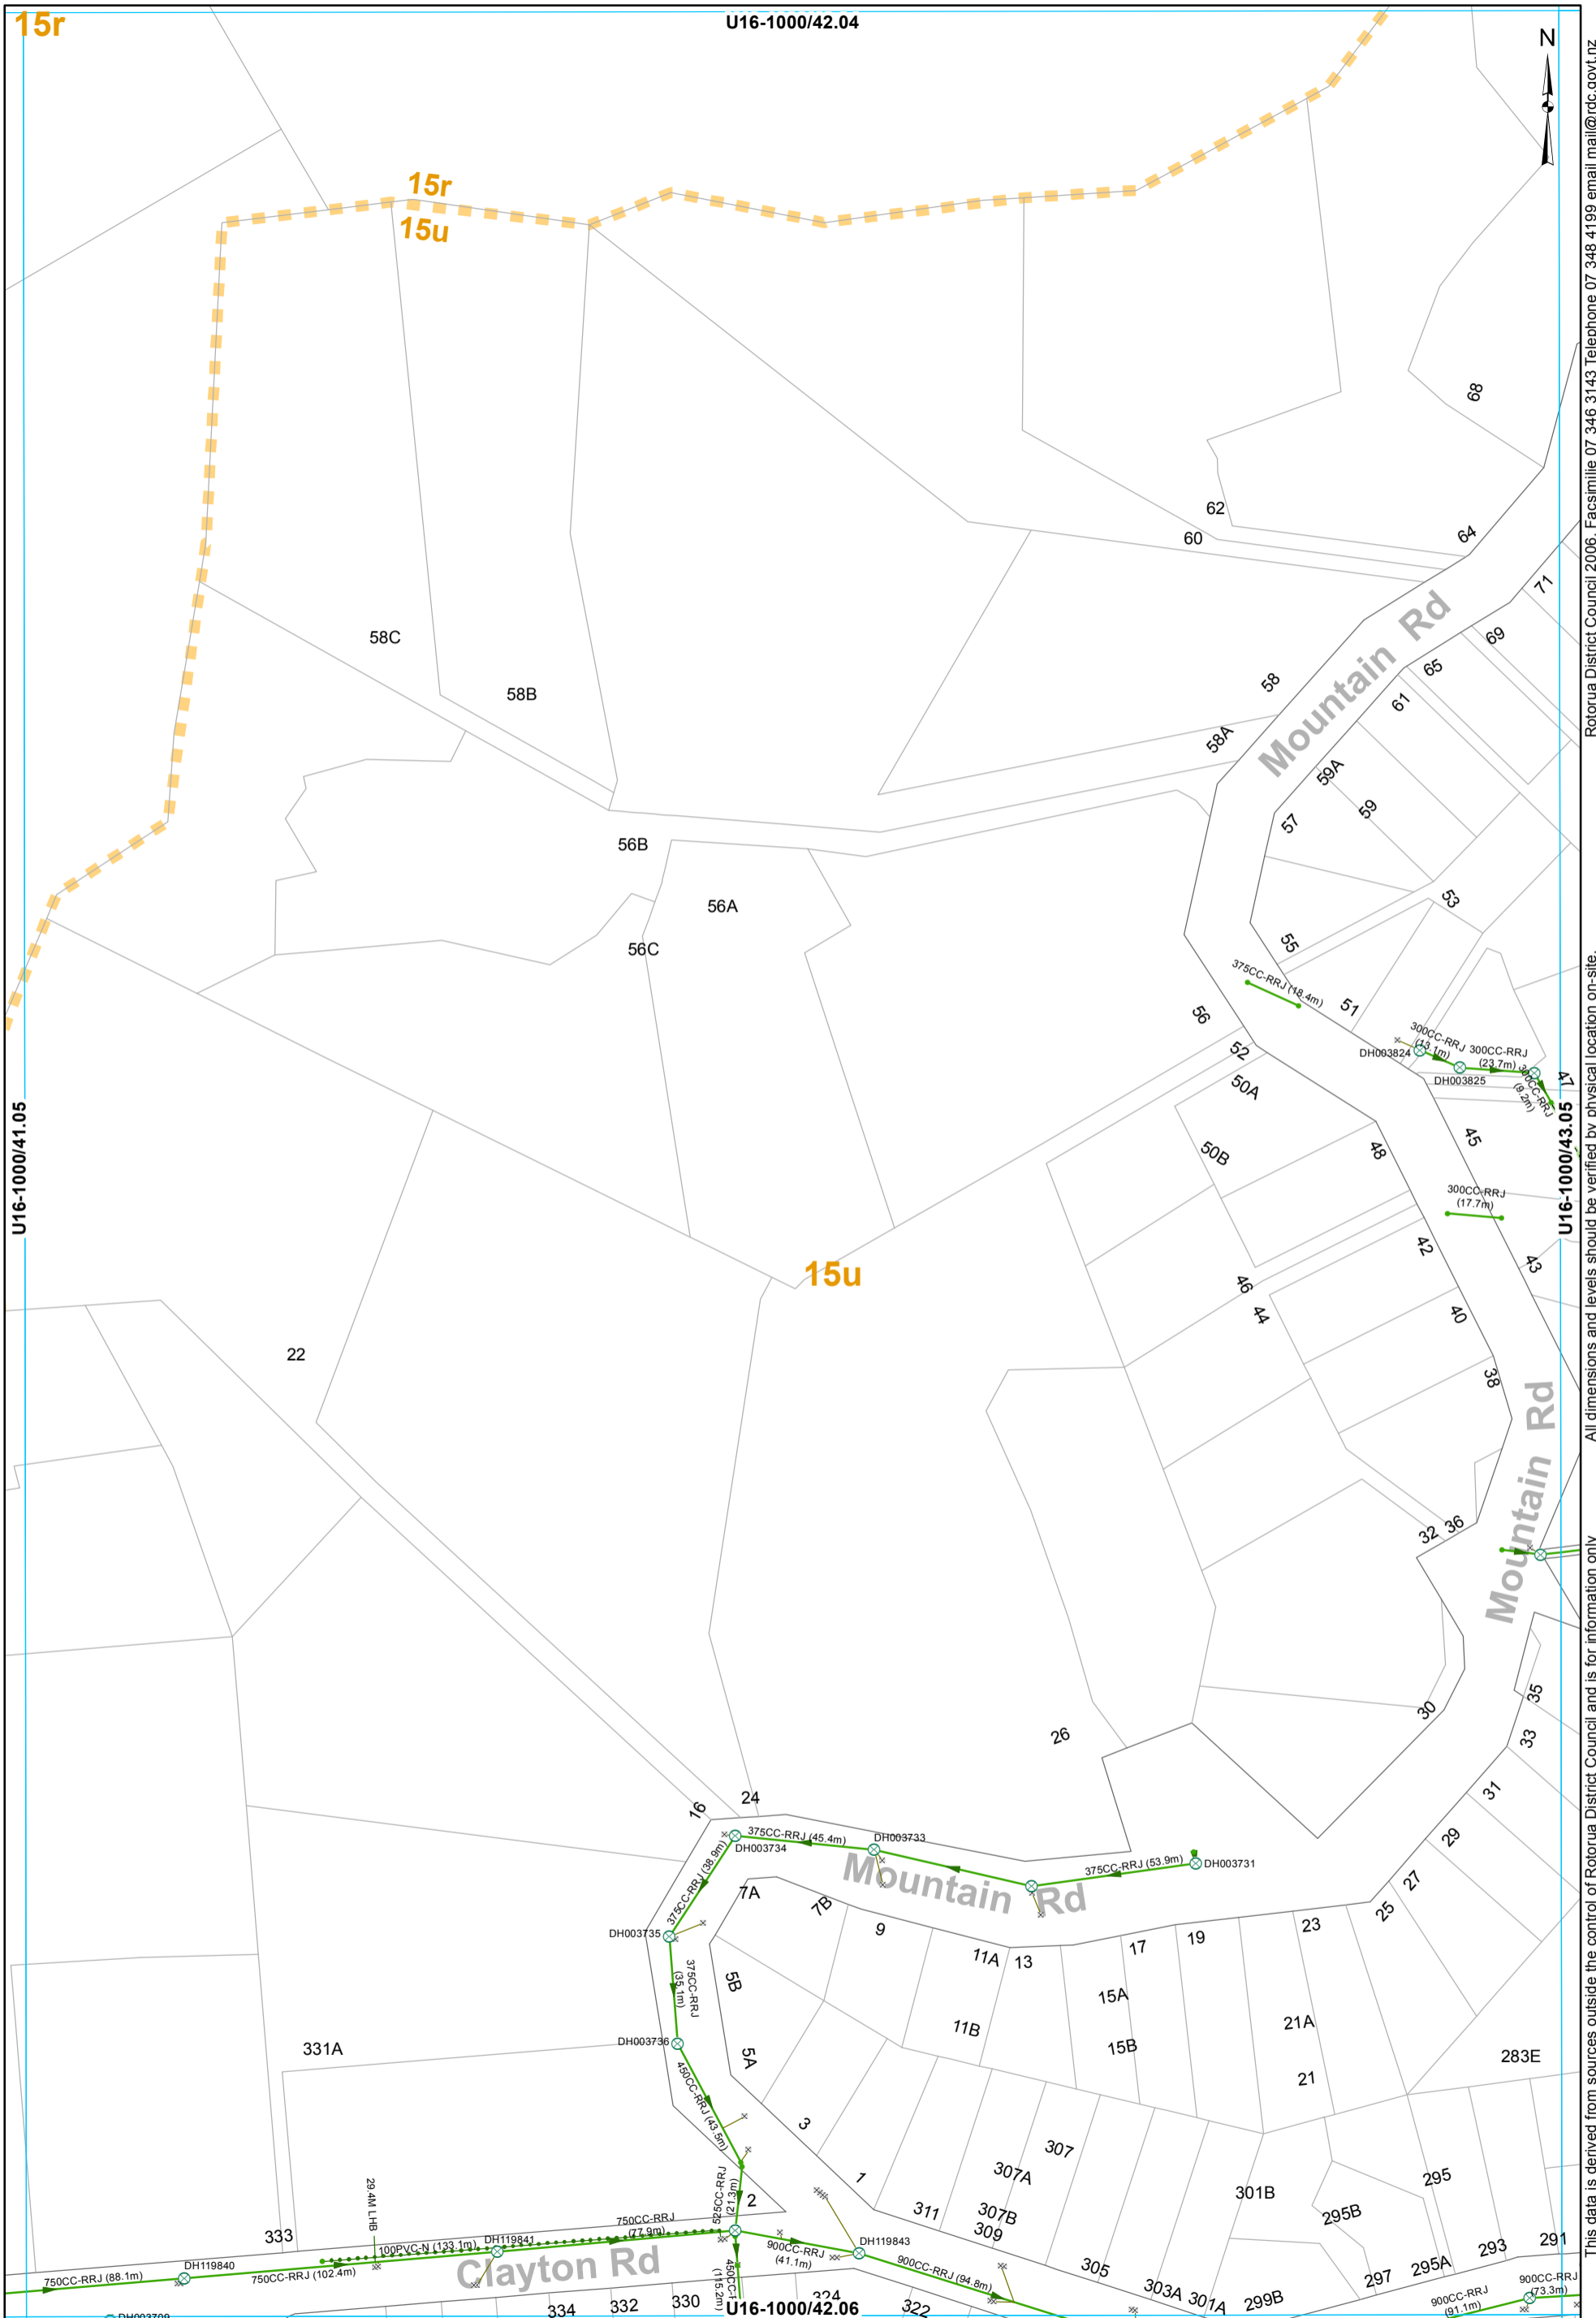


- ⊗ SWManhole
- × SWInlet
- Node
- Open Drain
- Culvert
- Gravity Main
- Subsoil Drain
- SWServiceline
- SWServiceline
- SWLead
- Catchment Boundary

**STORMWATER SERVICES**  
**1:2000 @ A3 - (U16-1000/42.05)**

This data is derived from sources outside the control of Rotorua District Council and is for information only. All dimensions and levels should be verified by physical location on-site.

Rotorua District Council 2006. Facsimile 07 346 3143 Telephone 07 348 4199 email mail@rdc.govt.nz

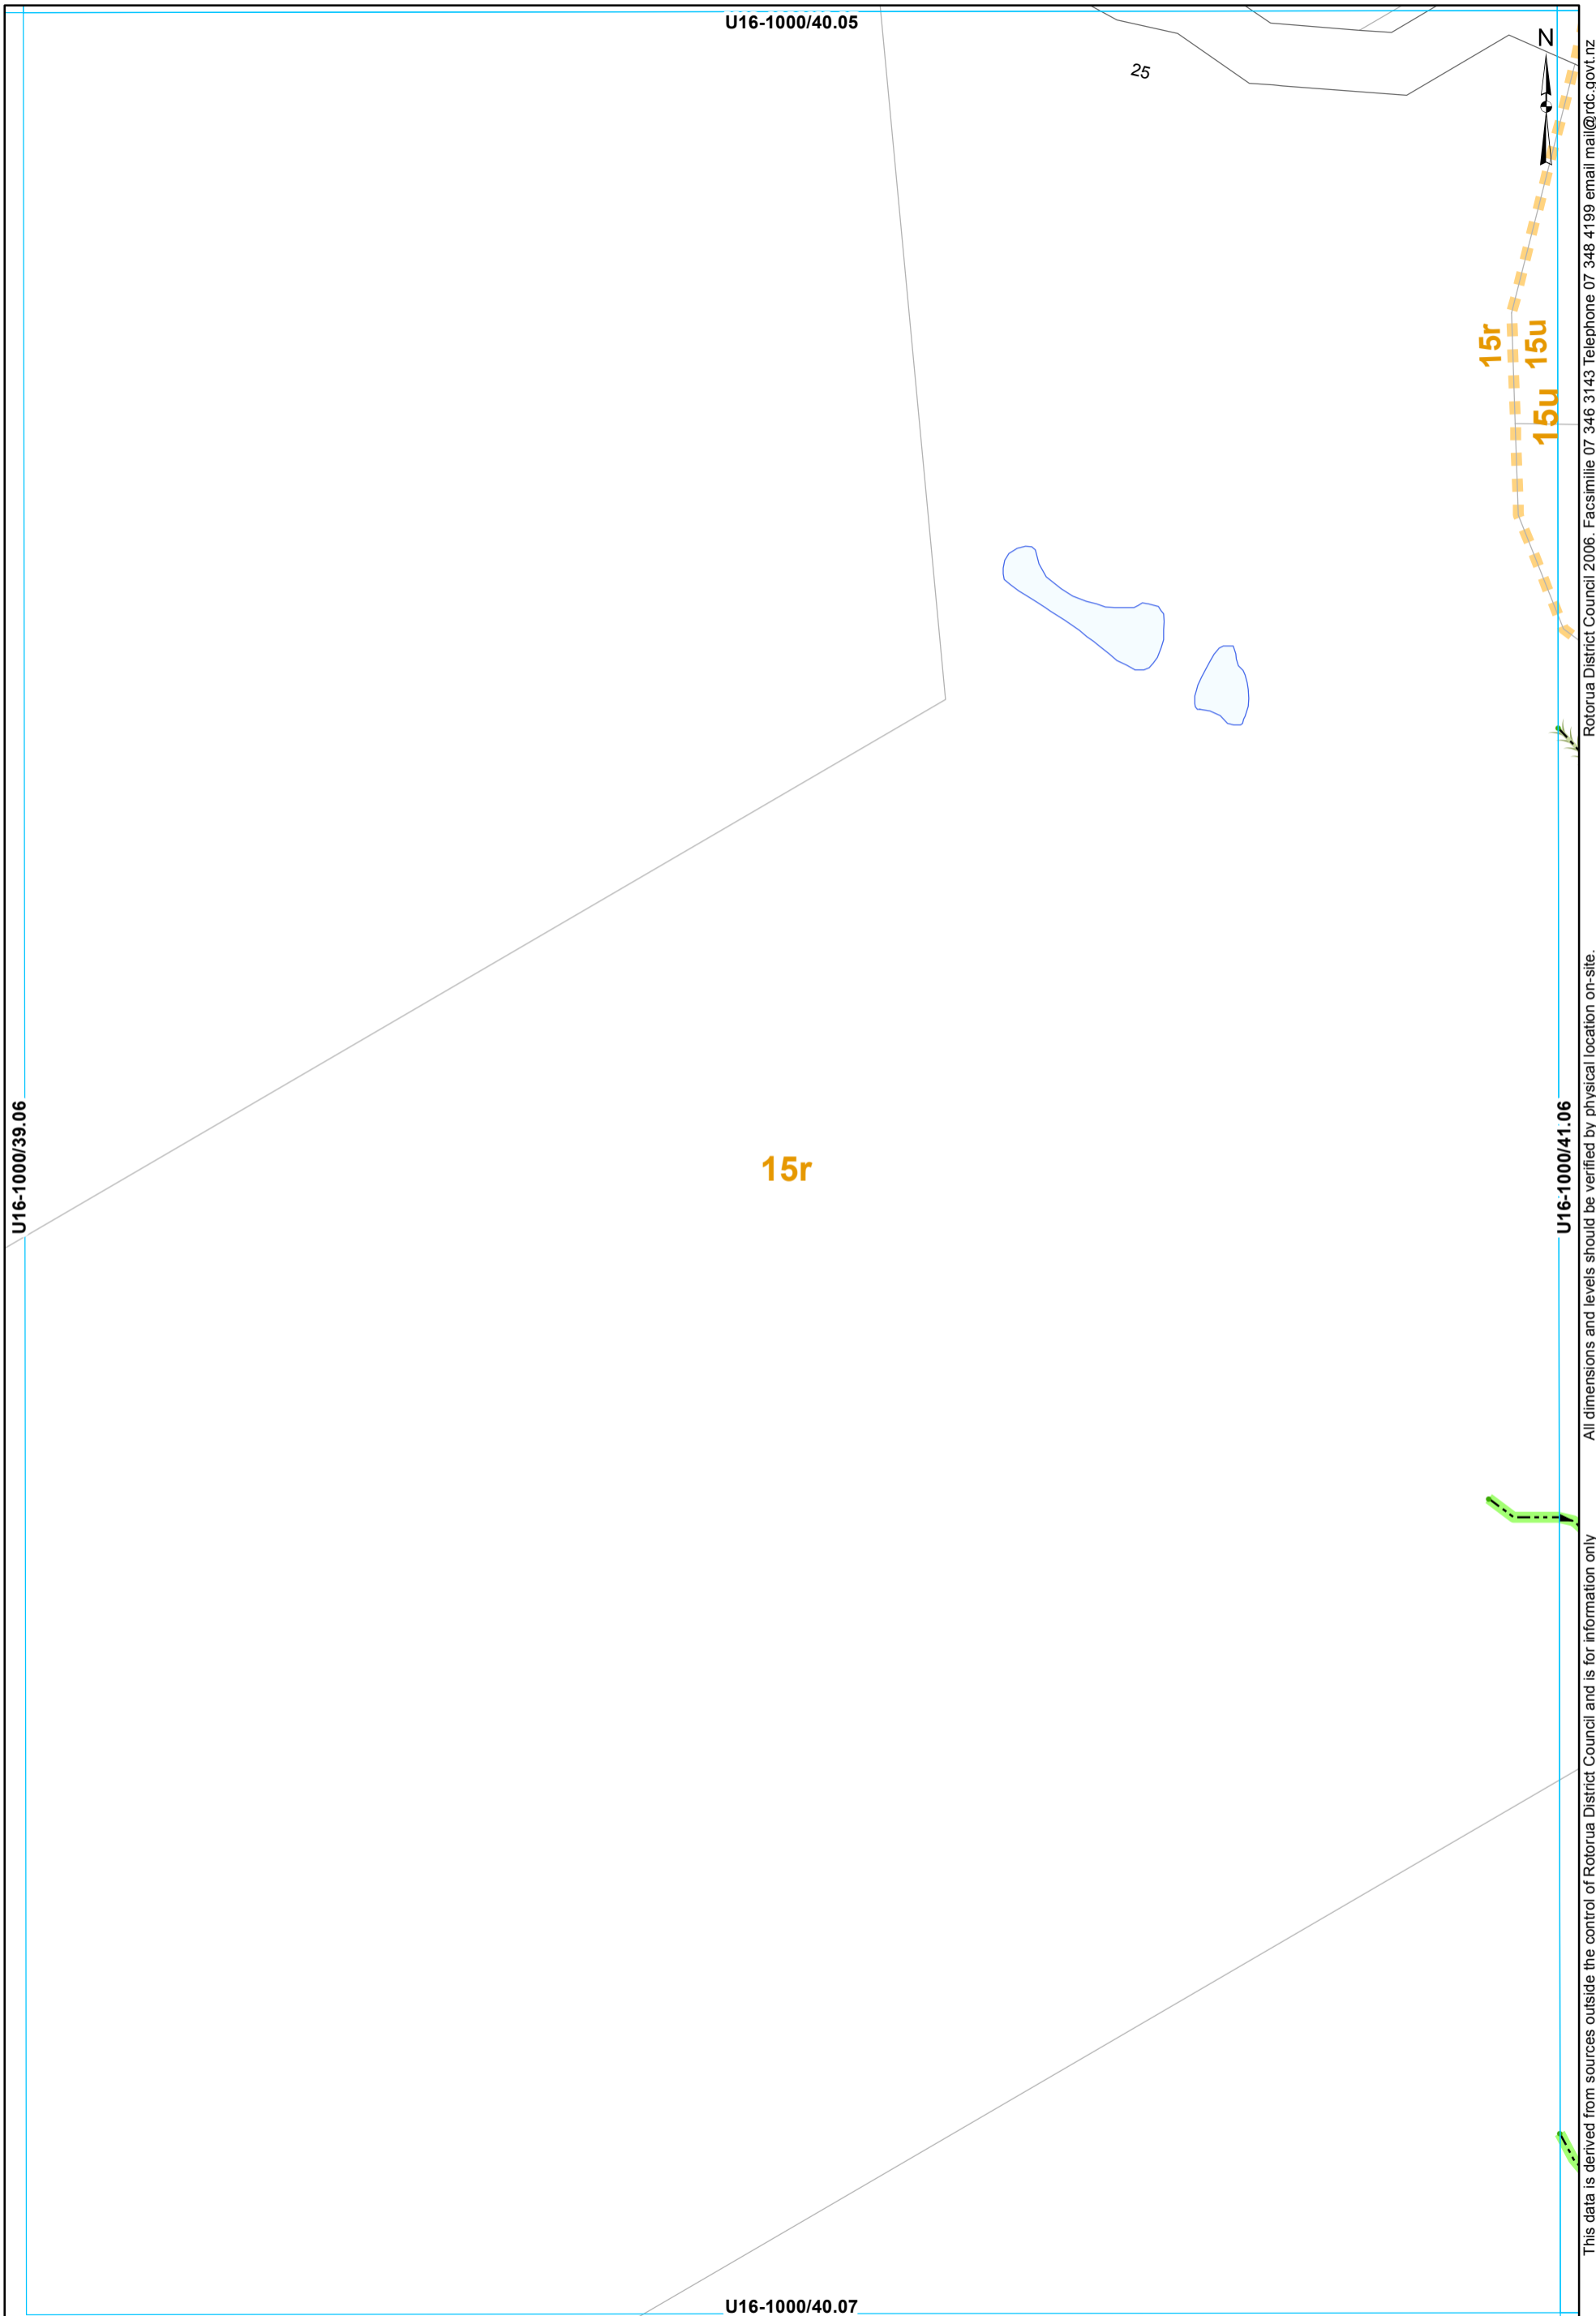


- Node
- Overland Flow
- Stream
- ▬ Catchment Boundary

**STORMWATER SERVICES**  
 1:2000 @ A3 - (U16-1000/40.06)

This data is derived from sources outside the control of Rotorua District Council and is for information only

Rotorua District Council 2006. Facsimile 07 346 3143 Telephone 07 348 4199 email mail@rdc.govt.nz

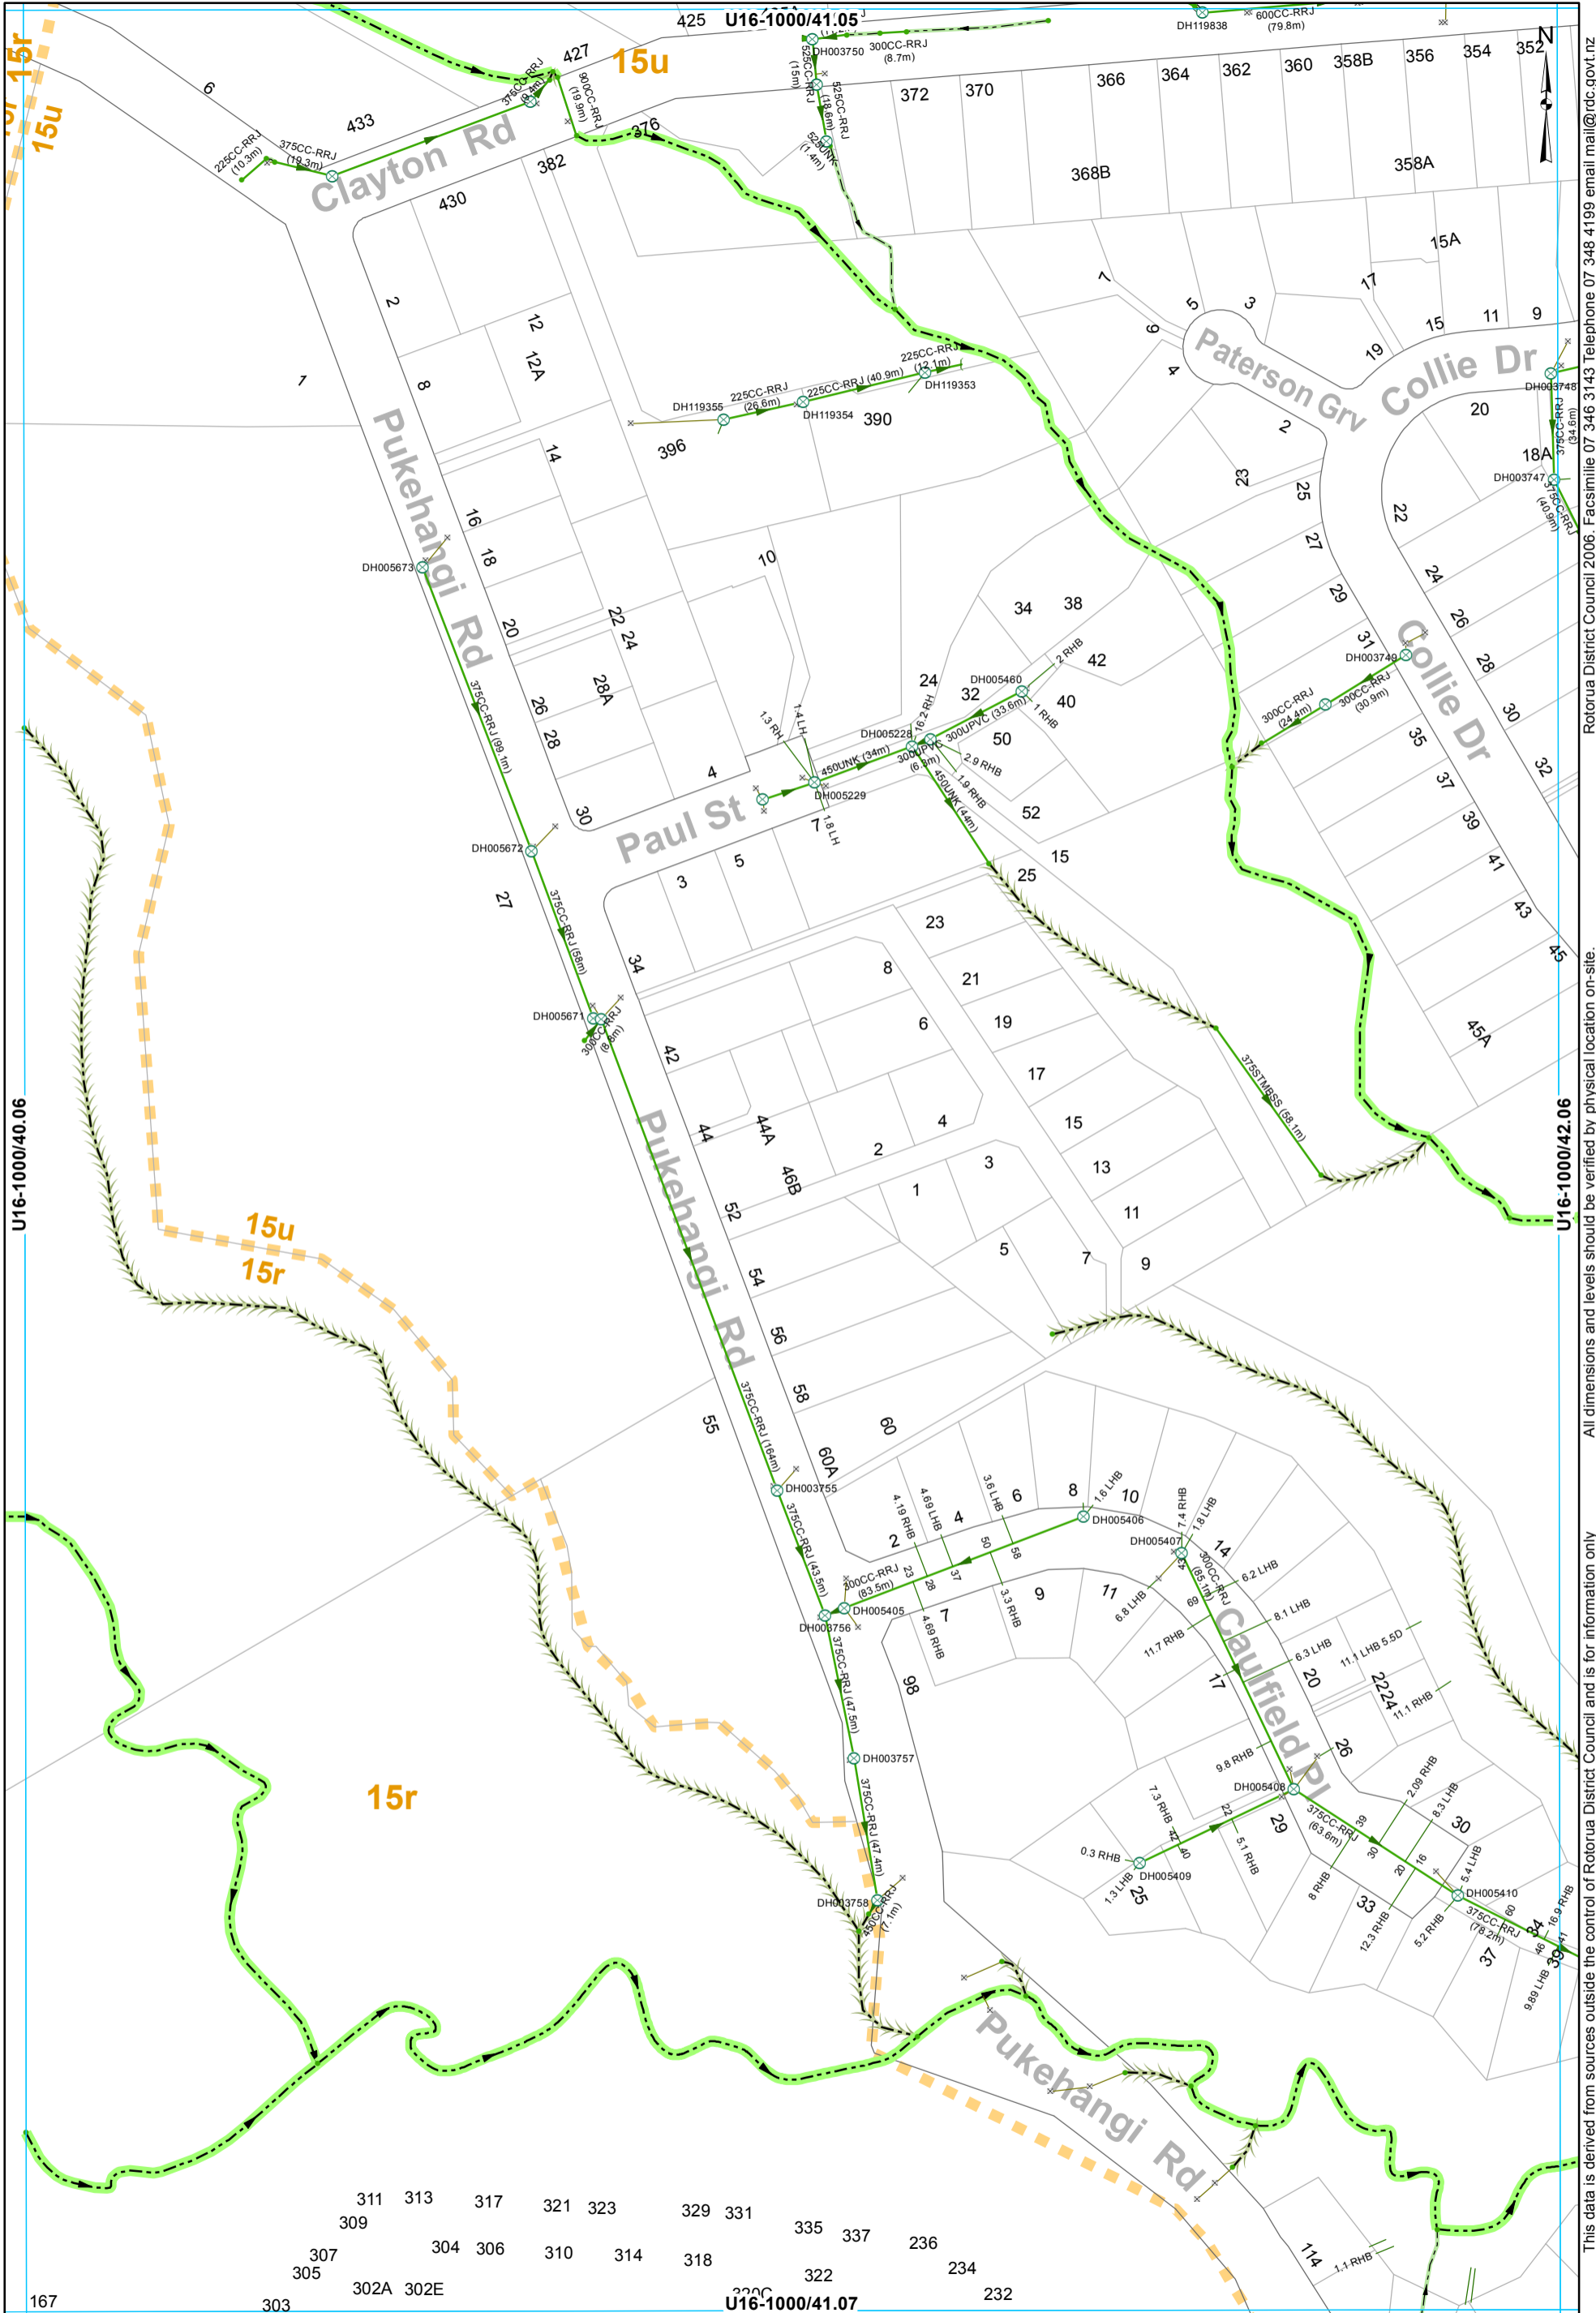

- |                      |                 |                      |                      |
|----------------------|-----------------|----------------------|----------------------|
| ⊗ SWManhole          | ▬ Lined Channel | — Culvert            | — SWServiceline      |
| × SWInlet            | ▬ Open Drain    | — Gravity Main       | — SWServiceline      |
| • Node               | ▬ Overland Flow | — SWLead             | — SWLead             |
| — Headwall Structure | ▬ Stream        | ▬ Catchment Boundary | ▬ Catchment Boundary |


**STORMWATER SERVICES**  
**1:2000 @ A3 - (U16-1000/41.06)**

This data is derived from sources outside the control of Rotorua District Council and is for information only

All dimensions and levels should be verified by physical location on-site.

Rotorua District Council 2006. Facsimile 07 346 3143 Telephone 07 348 4199 email mail@rdc.govt.nz



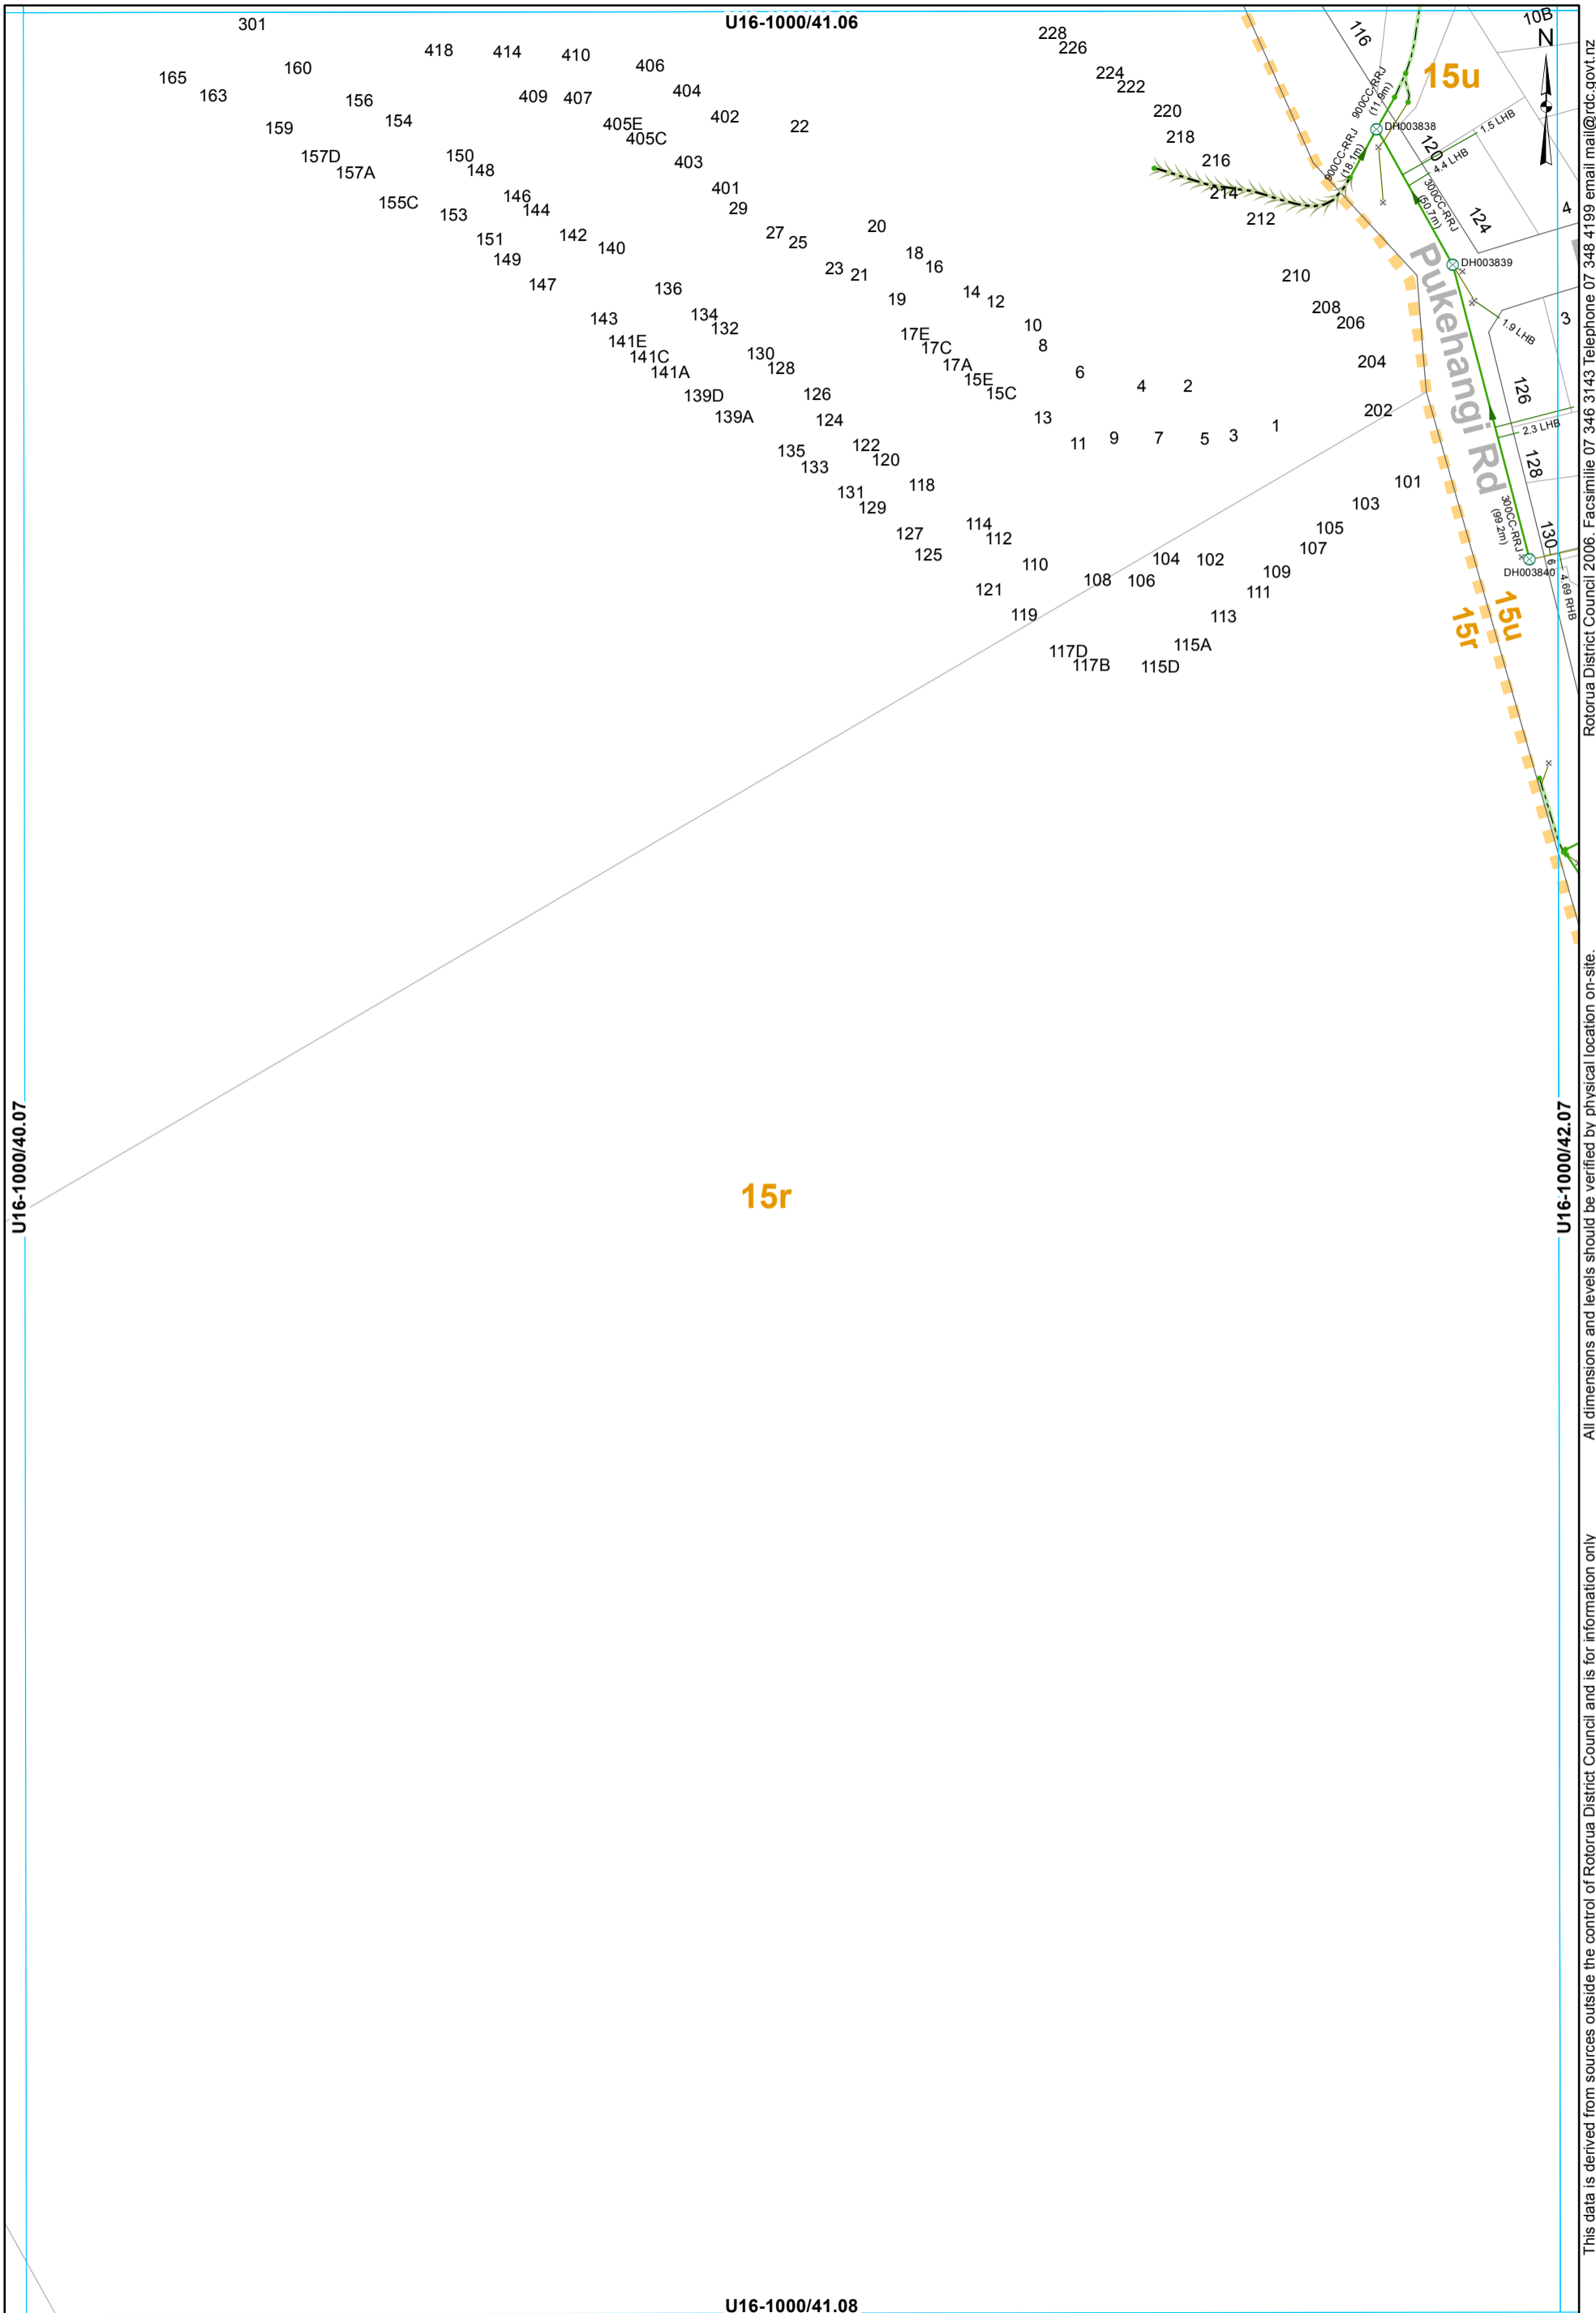


Rotorua District Council 2006. Facsimile 07 346 3143 Telephone 07 348 4199 email mail@rdc.govt.nz

All dimensions and levels should be verified by physical location on-site.

This data is derived from sources outside the control of Rotorua District Council and is for information only

- ⊗ SWManhole
- × SWInlet
- Node
- Open Drain
- Overland Flow
- Culvert
- Gravity Main
- SWServiceline
- SWServiceline
- SWLead
- Catchment Boundary

**STORMWATER SERVICES**  
**1:2000 @ A3 - (U16-1000/41.07)**

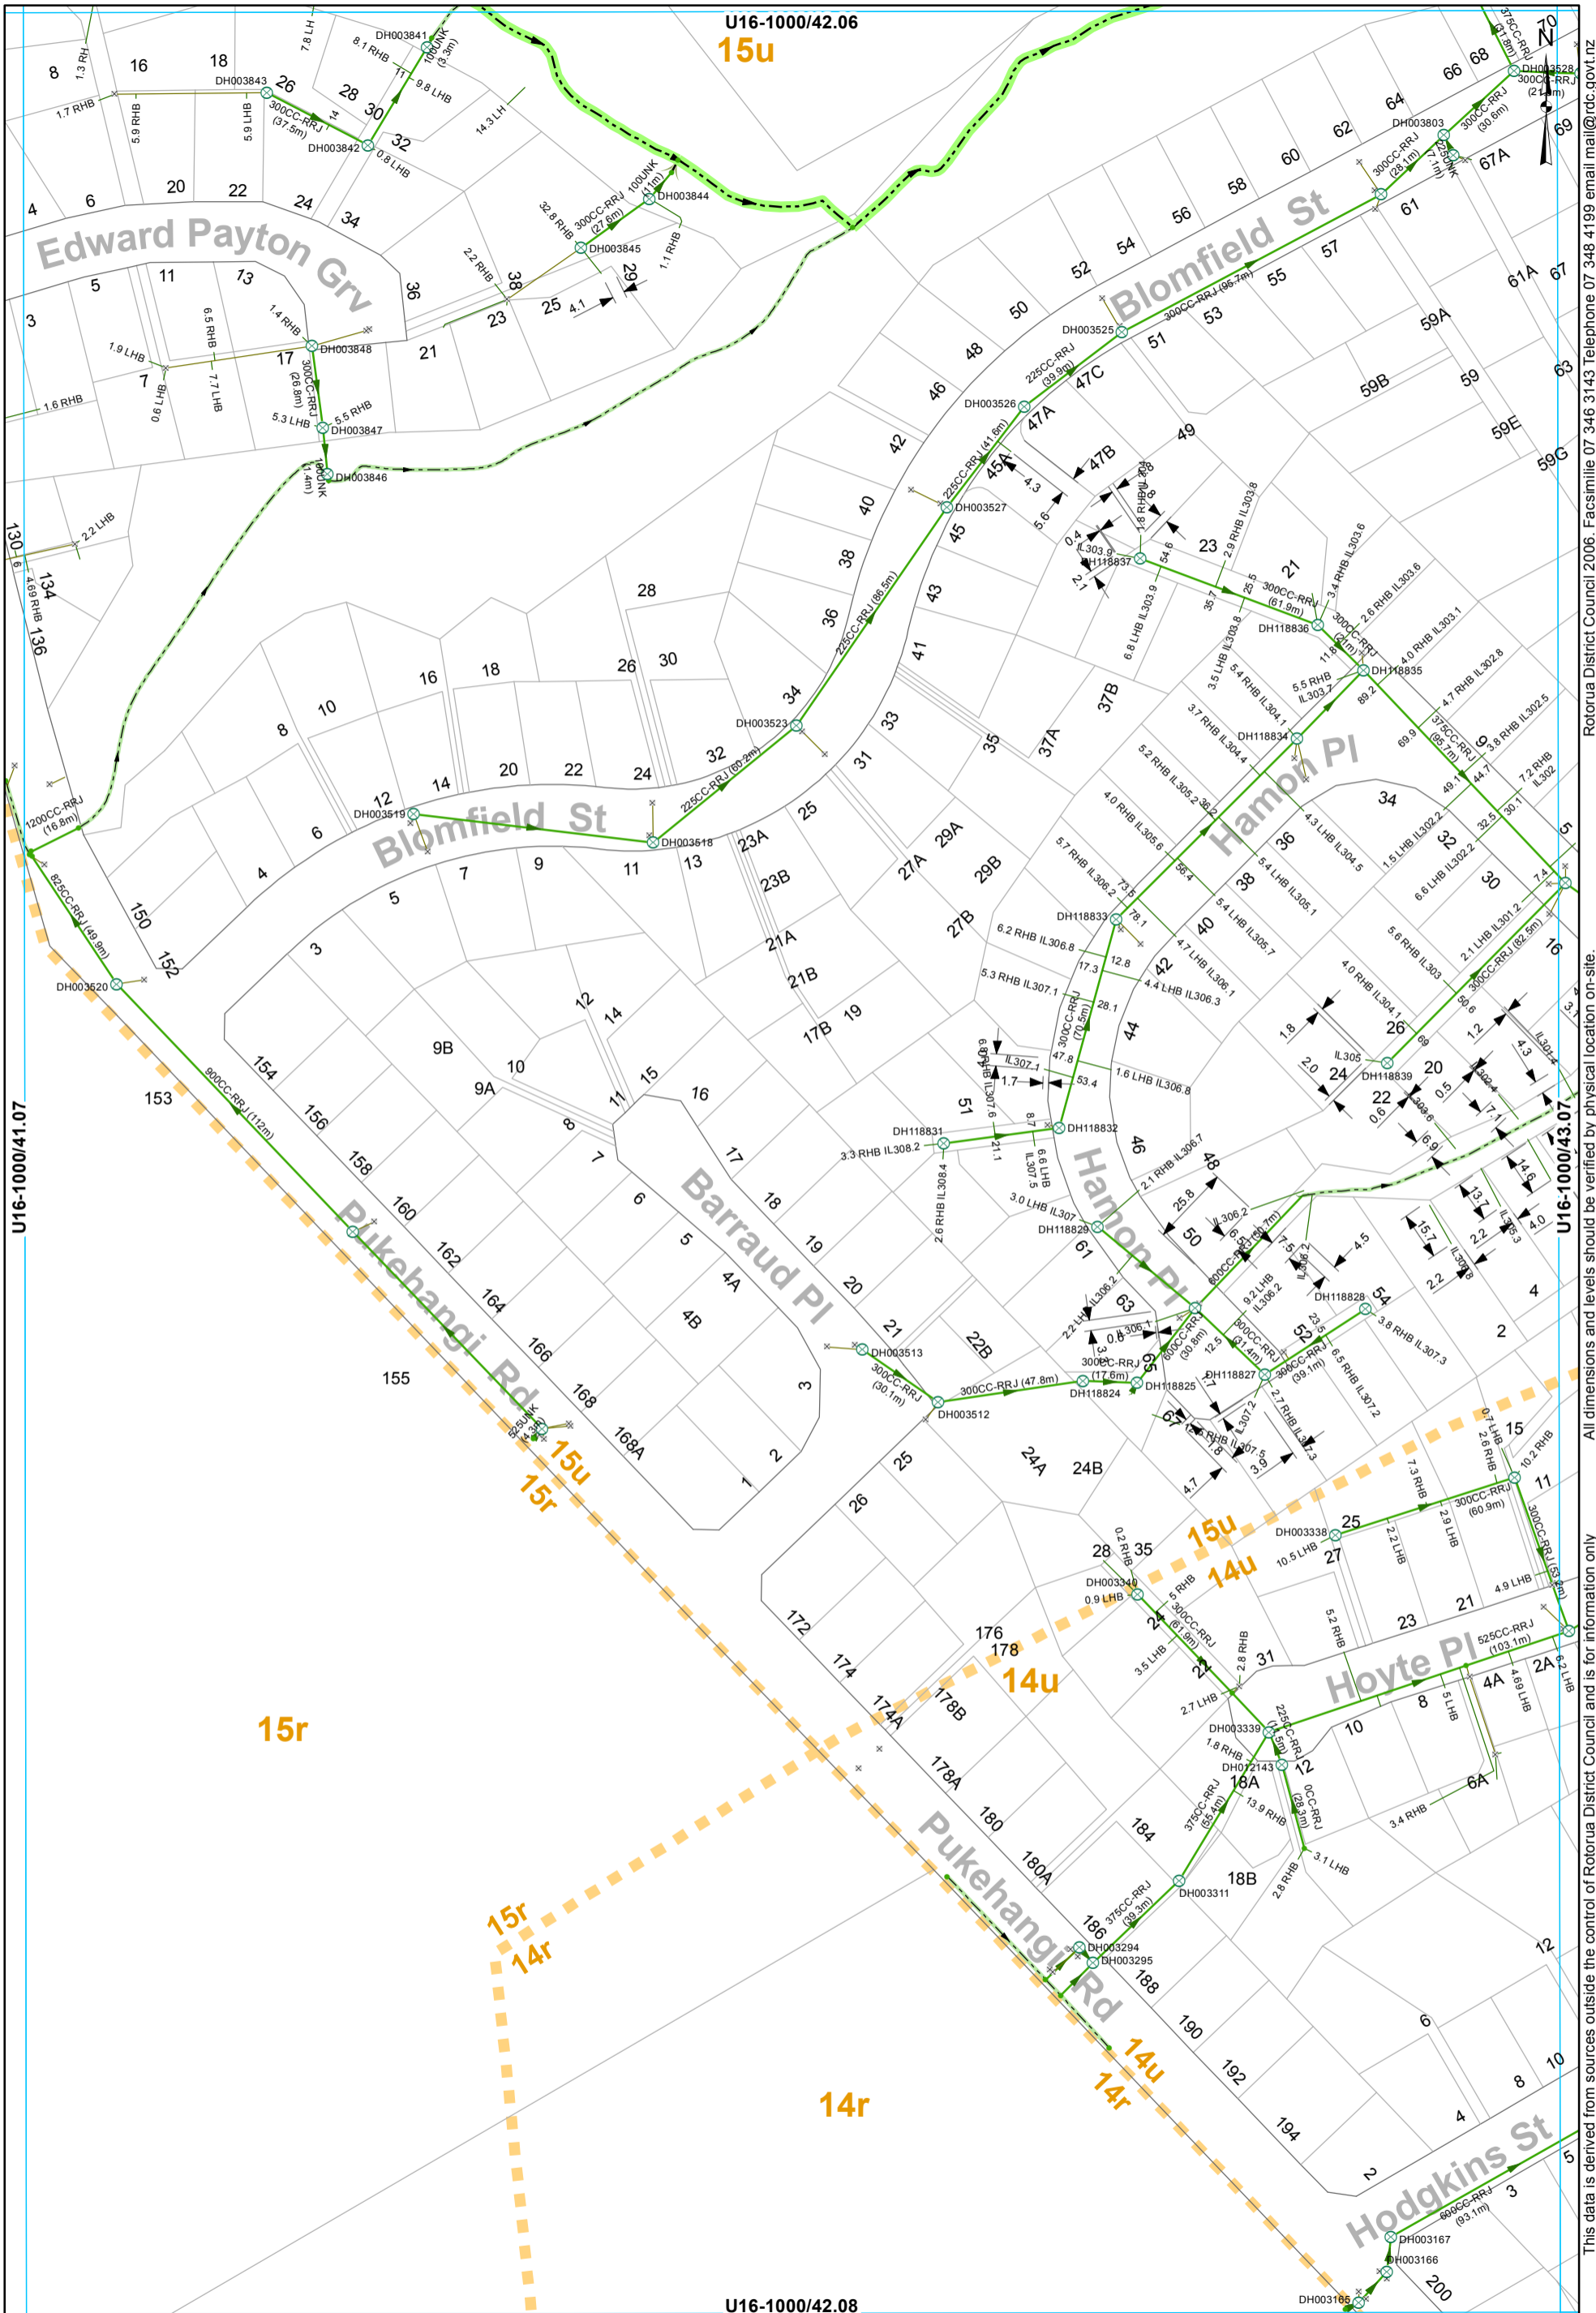

- ⊗ SWManhole
- × SWInlet
- Node
- Headwall Structure
- Open Drain
- Overland Flow
- Stream
- Culvert
- Gravity Main
- SWServiceline
- SWServiceline
- SWLead
- Catchment Boundary

**STORMWATER SERVICES**  
**1:2000 @ A3 - (U16-1000/42.07)**

Rotorua District Council 2006. Facsimile 07 346 3143 Telephone 07 348 4199 email mail@rdc.govt.nz

All dimensions and levels outside the control of Rotorua District Council and is for information only

U16-1000/42.08

U16-1000/41.07

U16-1000/43.07