

Storm Water Asbuilt Sheet Index
SWCatchment 18u



U15-1000/49.40




Not in a catchment. Bay Of Plenty Region
Lake Rotorua

U16-1000/48.01

U16-1000/50.01

All dimensions and levels should be verified by physical location on-site.

This data is derived from sources outside the control of Rotorua District Council and is for information only

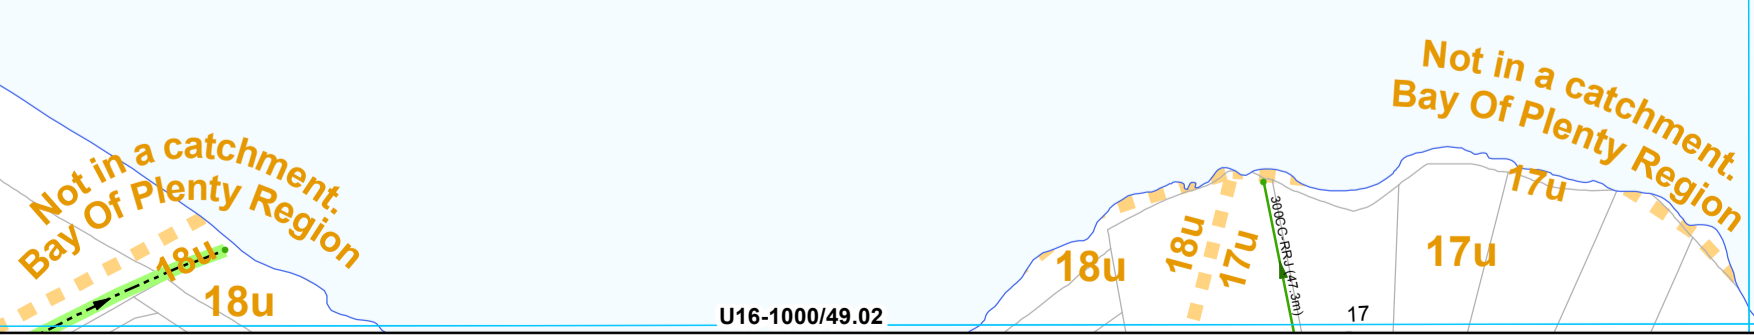

- Node
- Stream
- Gravity Main
- ▬ Catchment Boundary

U16-1000/49.02

STORMWATER SERVICES
1:2000 @ A3 - (U16-1000/49.01)

This data is derived from sources outside the control of Rotorua District Council and is for information only


U16-1000/47.01



Not in a catchment. Bay Of Plenty Region

Not in a catchment. Bay Of Plenty Region

Not in a catchment. Bay Of Plenty Region

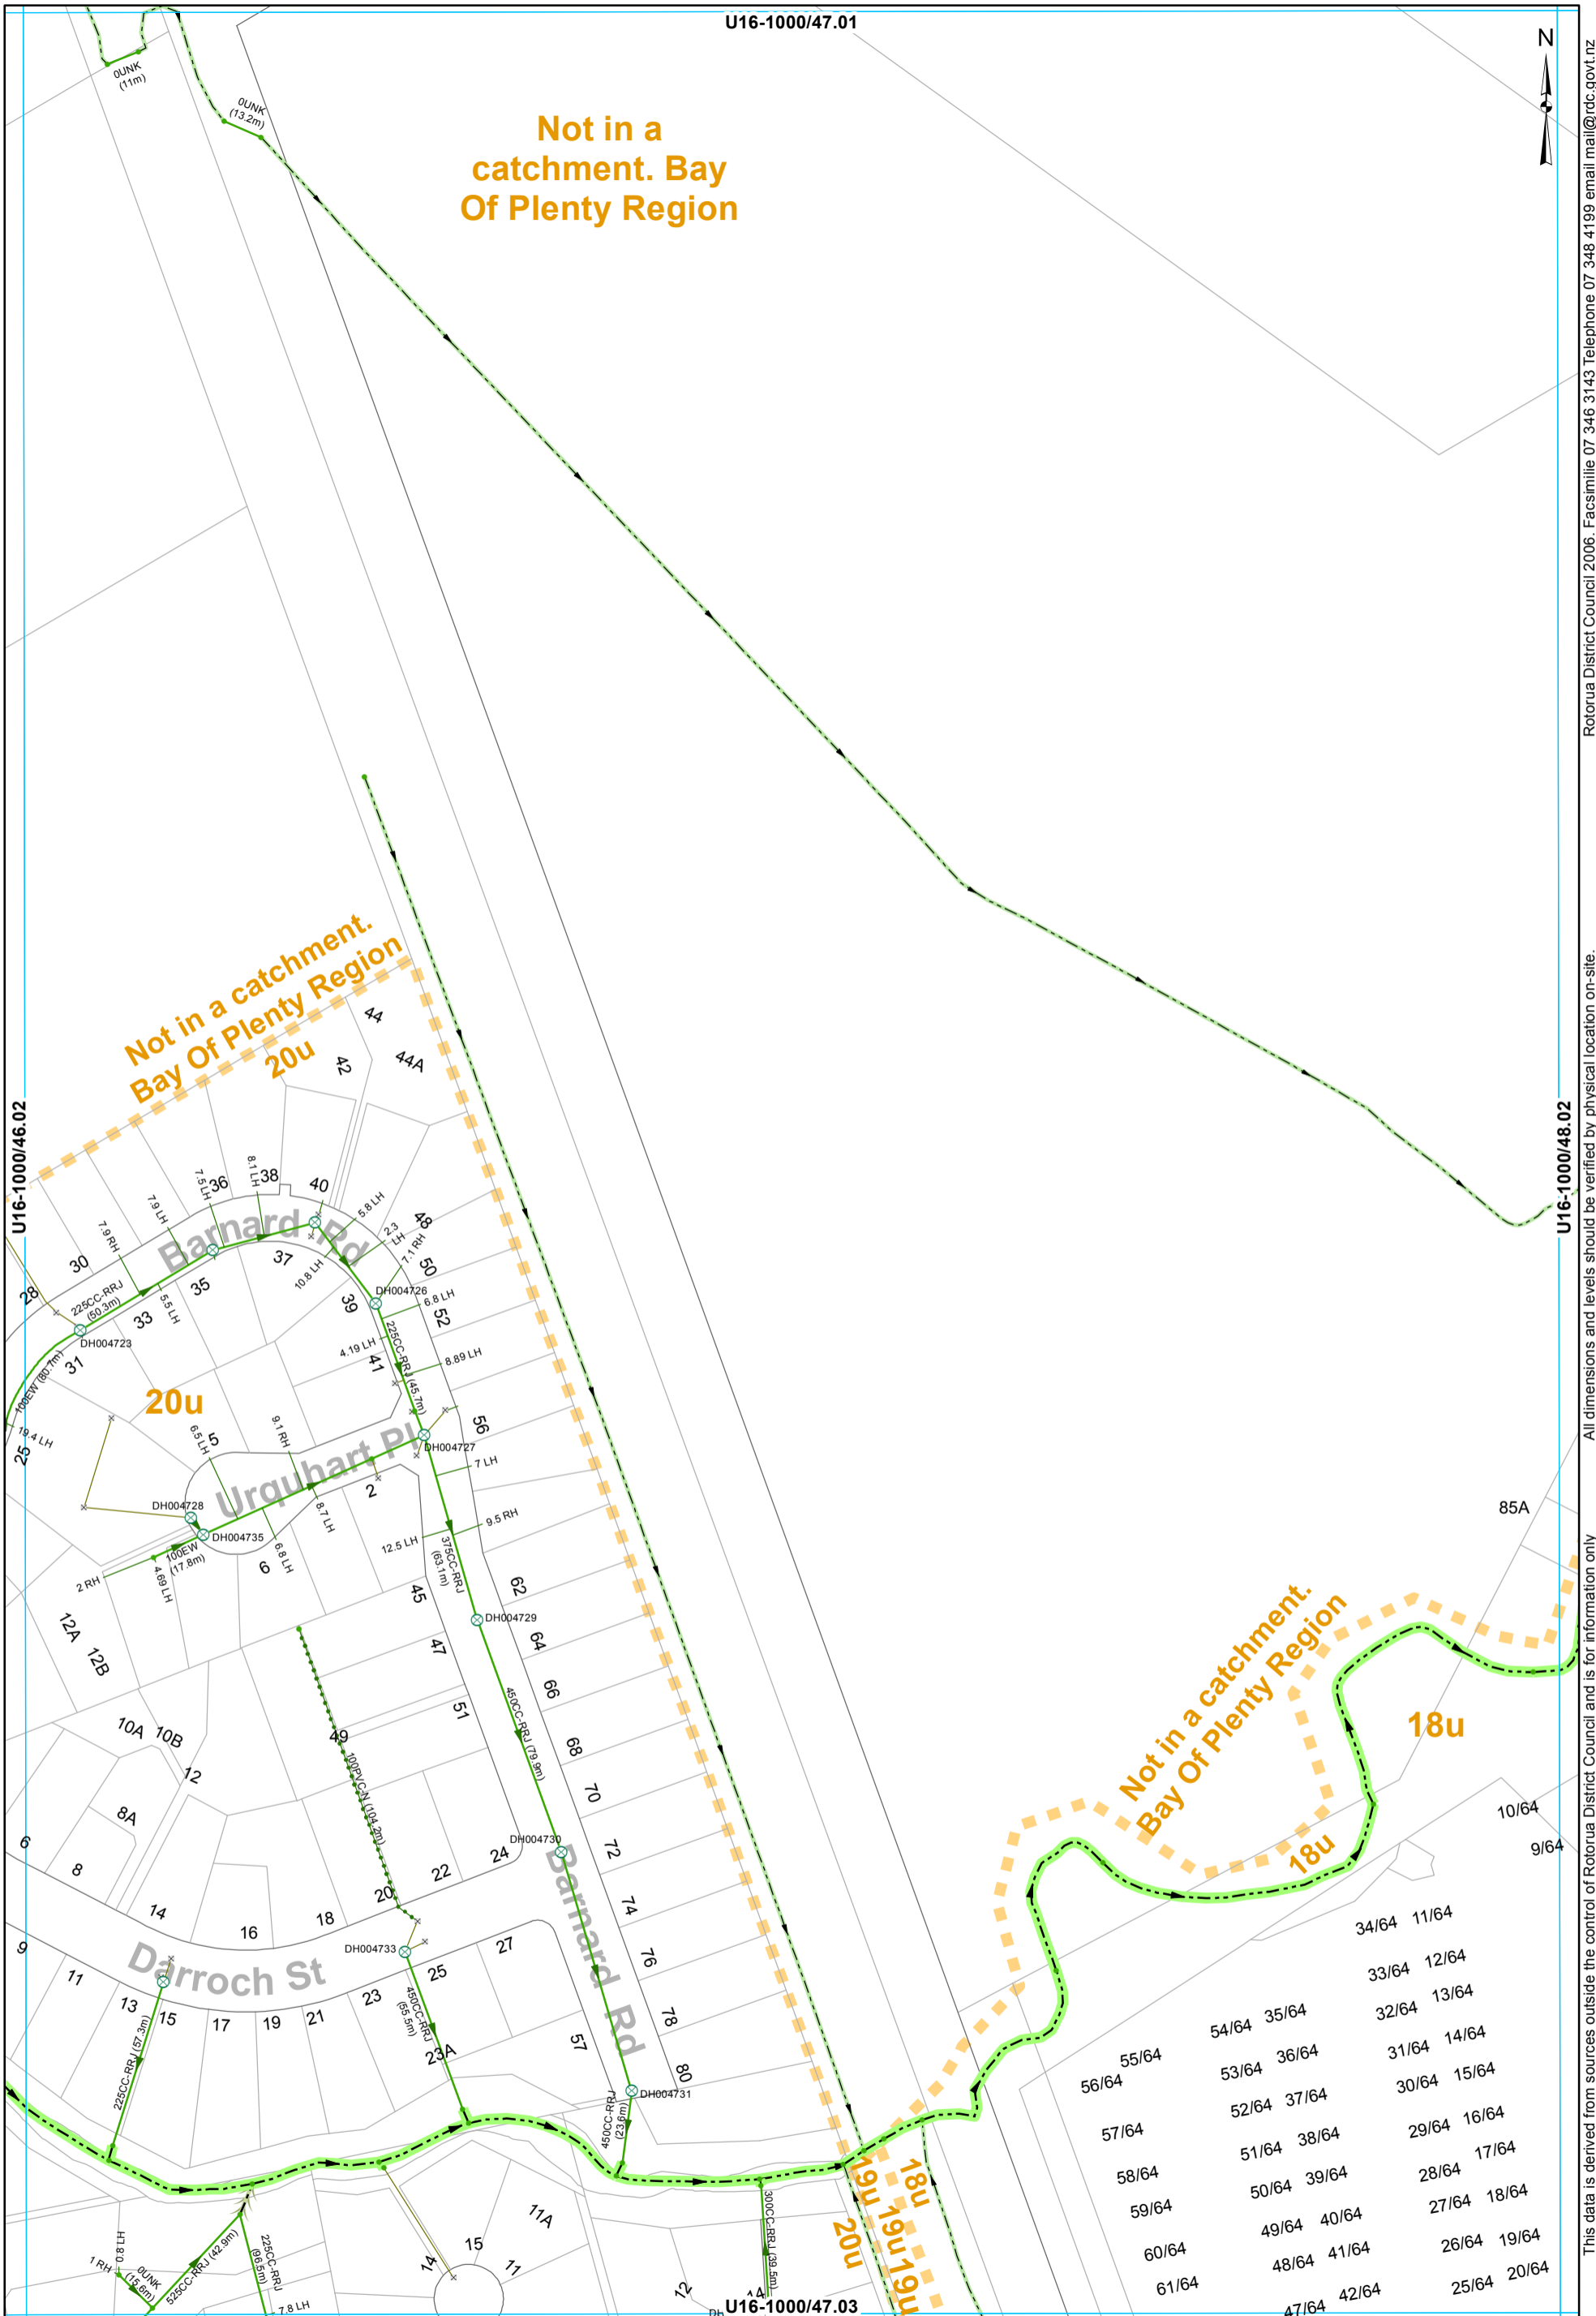

U16-1000/46.02

U16-1000/48.02

U16-1000/47.03

- ⊗ SWManhole
- × SWInlet
- Node
- Open Drain
- Overland Flow
- Stream
- Culvert
- Gravity Main
- Subsoil Drain
- SWServiceline
- SWServiceline
- SWLead
- Catchment Boundary

STORMWATER SERVICES
1:2000 @ A3 - (U16-1000/47.02)

This data is derived from sources outside the control of Rotorua District Council and is for information only. All dimensions and levels should be verified by physical location on-site.

Rotorua District Council 2006. Facsimile 07 346 3143 Telephone 07 348 4199 email mail@rdc.govt.nz

U16-1000/48.01



Not in a catchment. Bay Of Plenty Region

Not in a catchment. Bay Of Plenty Region

18u

17u

18u

17u

U16-1000/47.02


U16-1000/49.02


U16-1000/48.03

- SWManhole
- Open Drain
- Gravity Main
- SWServiceline
- SWServiceline
- SWLead
- Node
- Stream
- Catchment Boundary

STORMWATER SERVICES
1:2000 @ A3 - (U16-1000/48.02)

Rotorua District Council 2006. Facsimile 07 346 3143 Telephone 07 348 4199 email mail@rdc.govt.nz
All dimensions and levels outside the control of Rotorua District Council and is for information only
This data is derived from sources outside the control of Rotorua District Council and is for information only

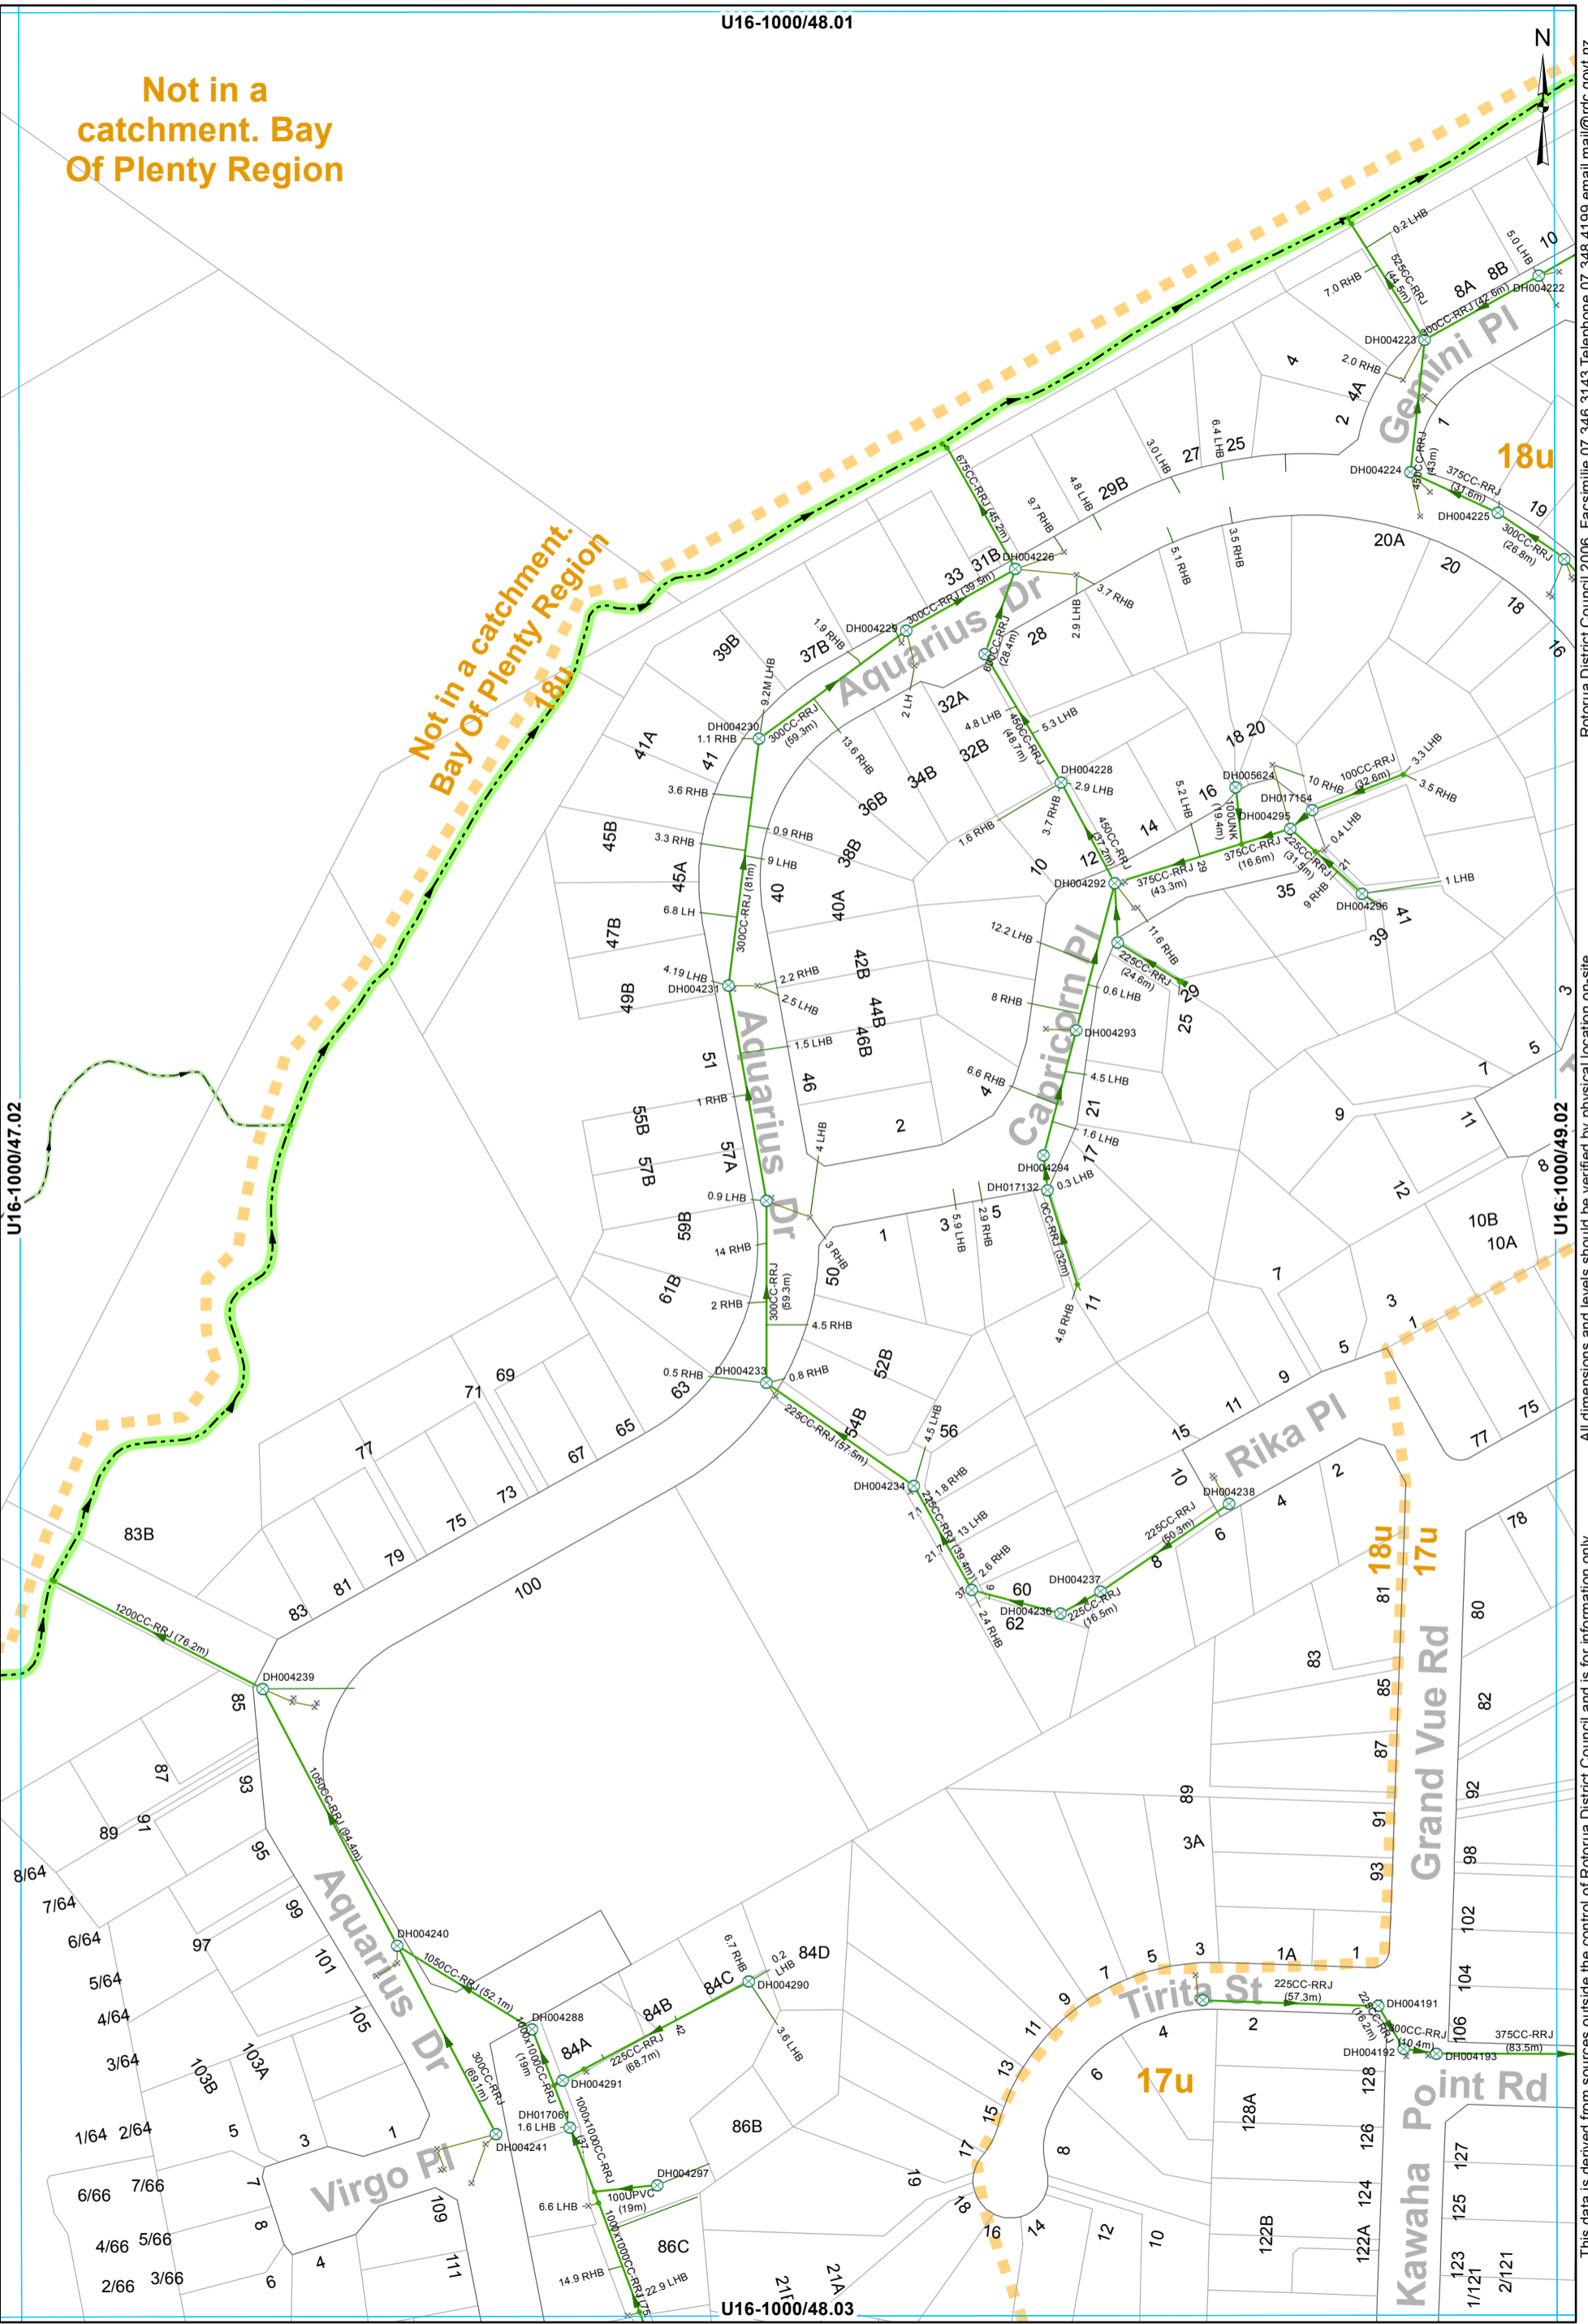

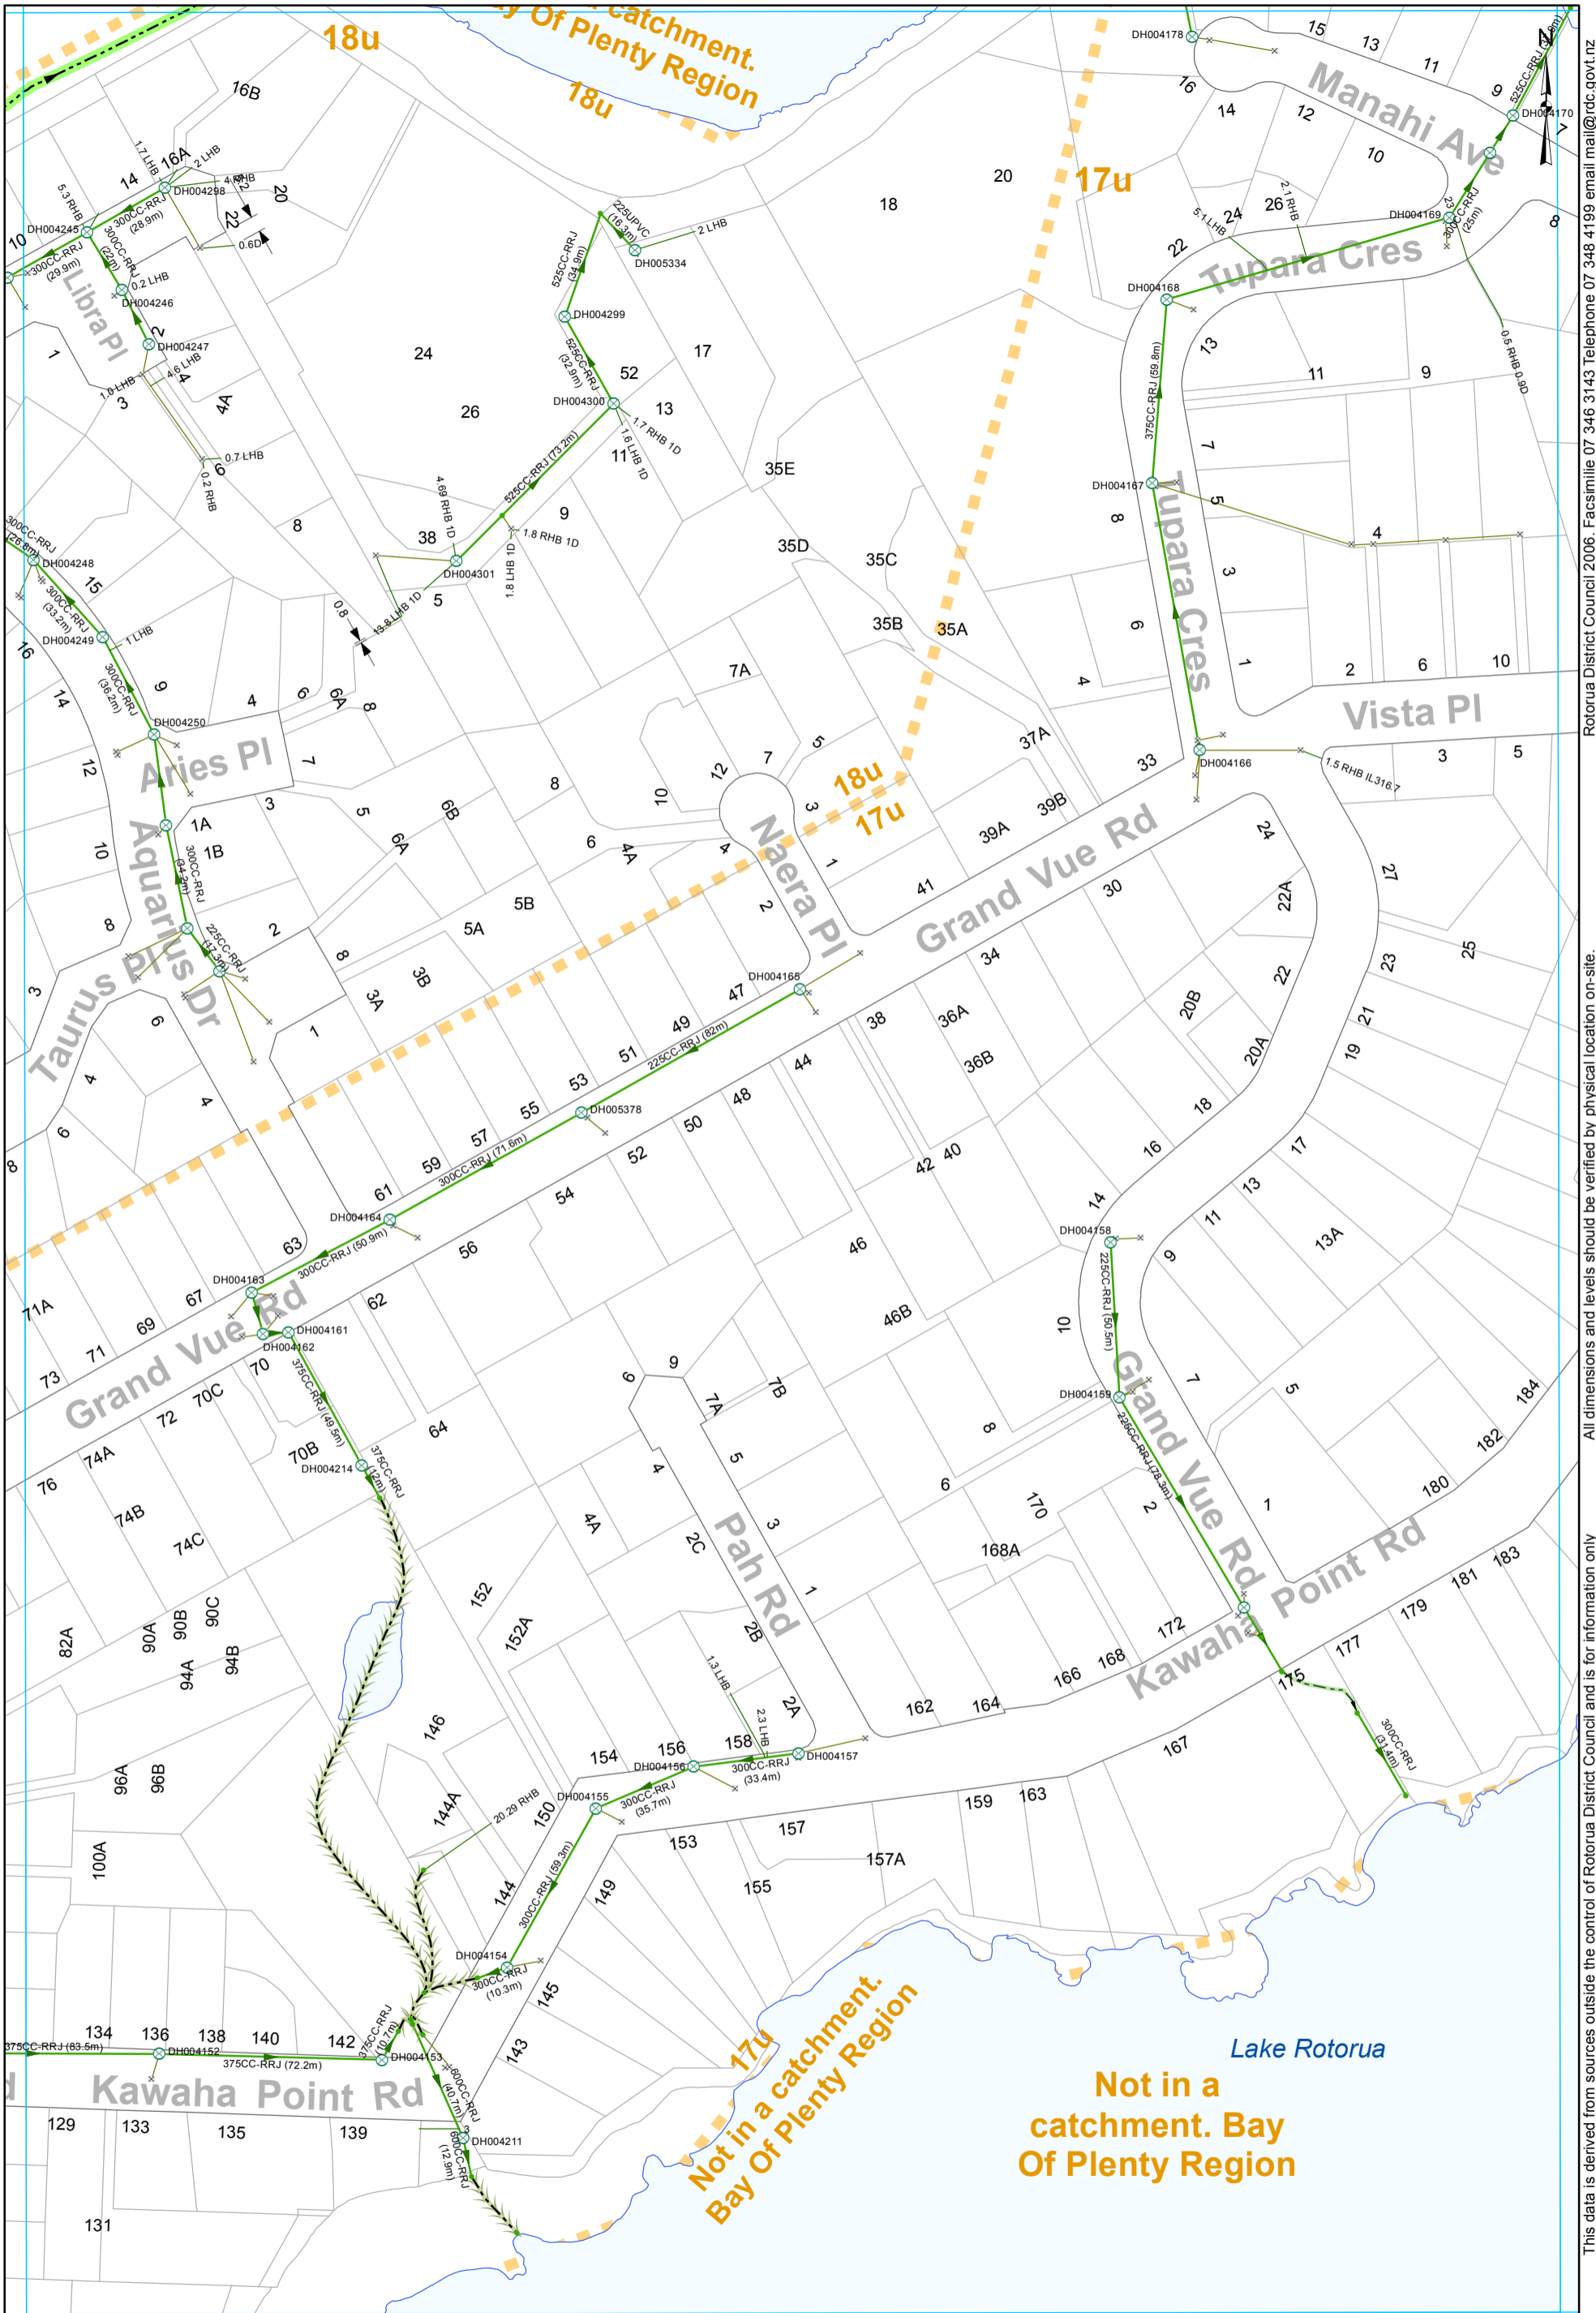


- ⊗ SWManhole
- × SWInlet
- Node
- Open Drain
- Overland Flow
- Stream
- Gravity Main
- SWServiceline
- SWServiceline
- SWLead
- Catchment Boundary

STORMWATER SERVICES
1:2000 @ A3 - (U16-1000/49.02)

This data is derived from sources outside the control of Rotorua District Council and is for information only

All dimensions and levels should be verified by physical location on-site.

Rotorua District Council 2006. Facsimile 07 346 3143 Telephone 07 348 4199 email mail@rdc.govt.nz

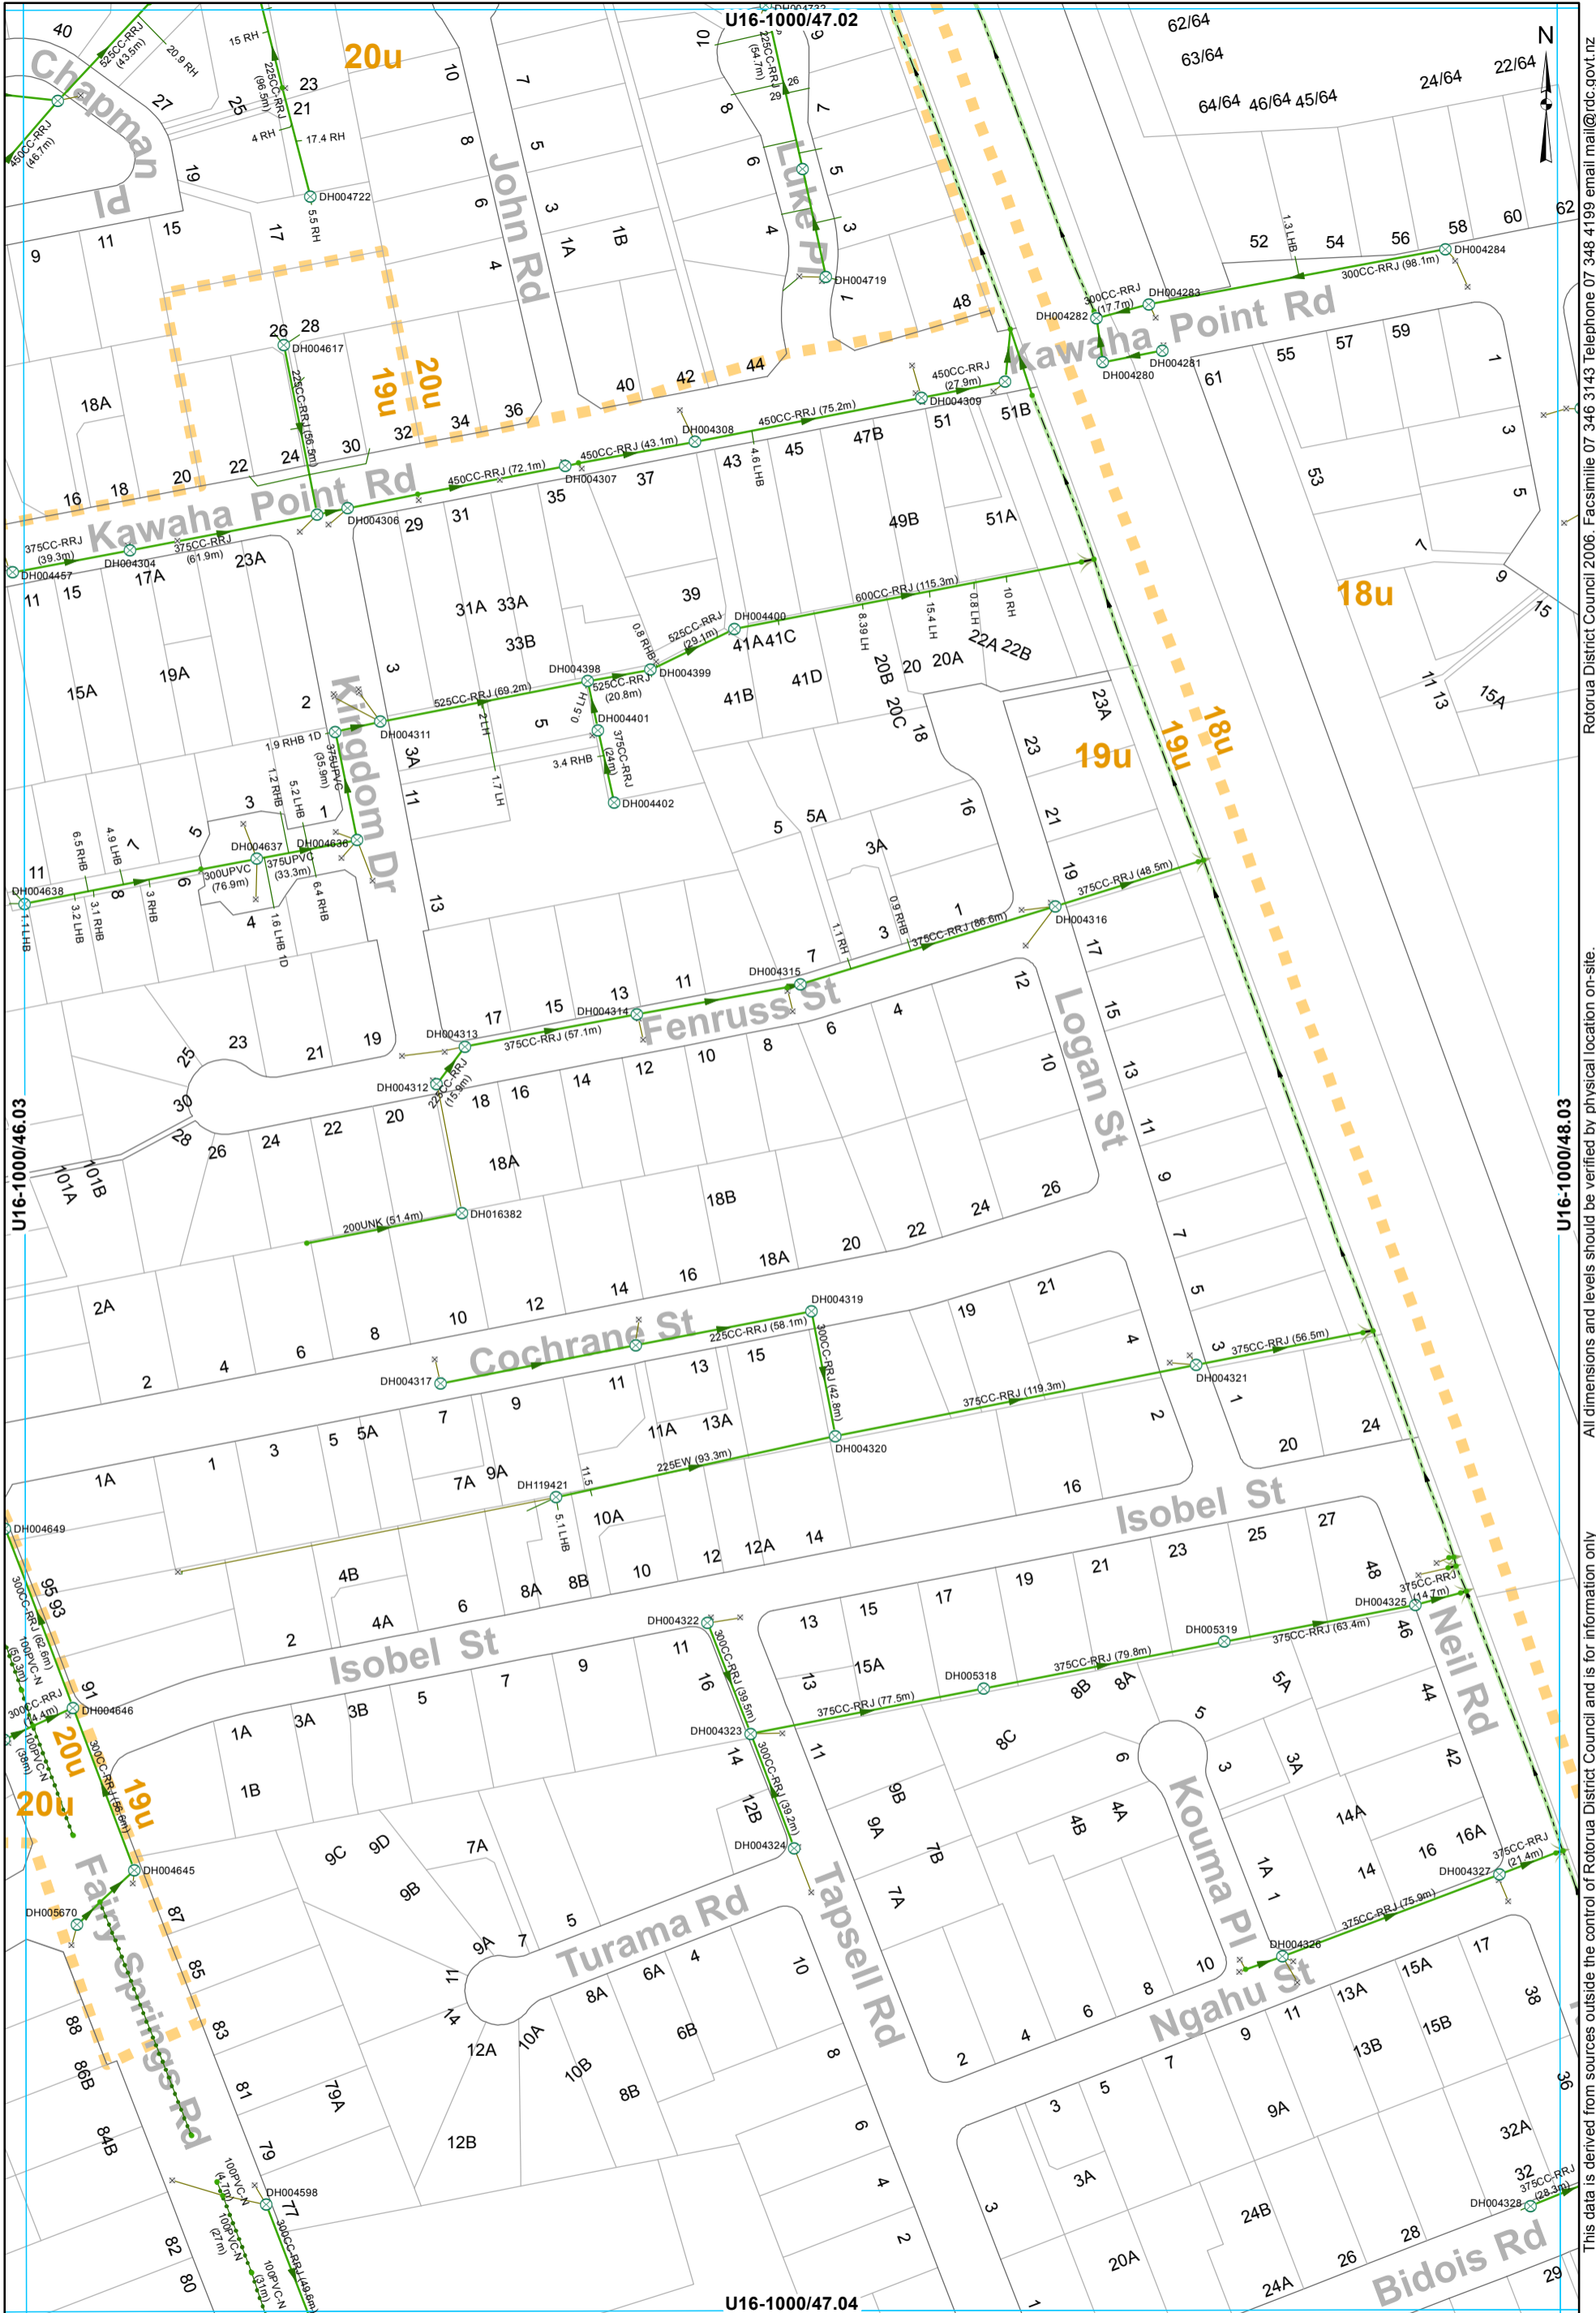

Rotorua District Council 2006. Facsimile 07 348 3143 Telephone 07 348 4199 email mail@rdc.govt.nz

All dimensions and levels should be verified by physical location on-site.

This data is derived from sources outside the control of Rotorua District Council and is for information only


- ⊗ SWManhole
- ⊗ SWInlet
- Node
- Open Drain
- Overland Flow
- Gravity Main
- Subsoil Drain
- SWServiceline
- SWServiceline
- SWLead
- Catchment Boundary

STORMWATER SERVICES
1:2000 @ A3 - (U16-1000/47.03)

U16-1000/47.04

U16-1000/46.03

U16-1000/48.03

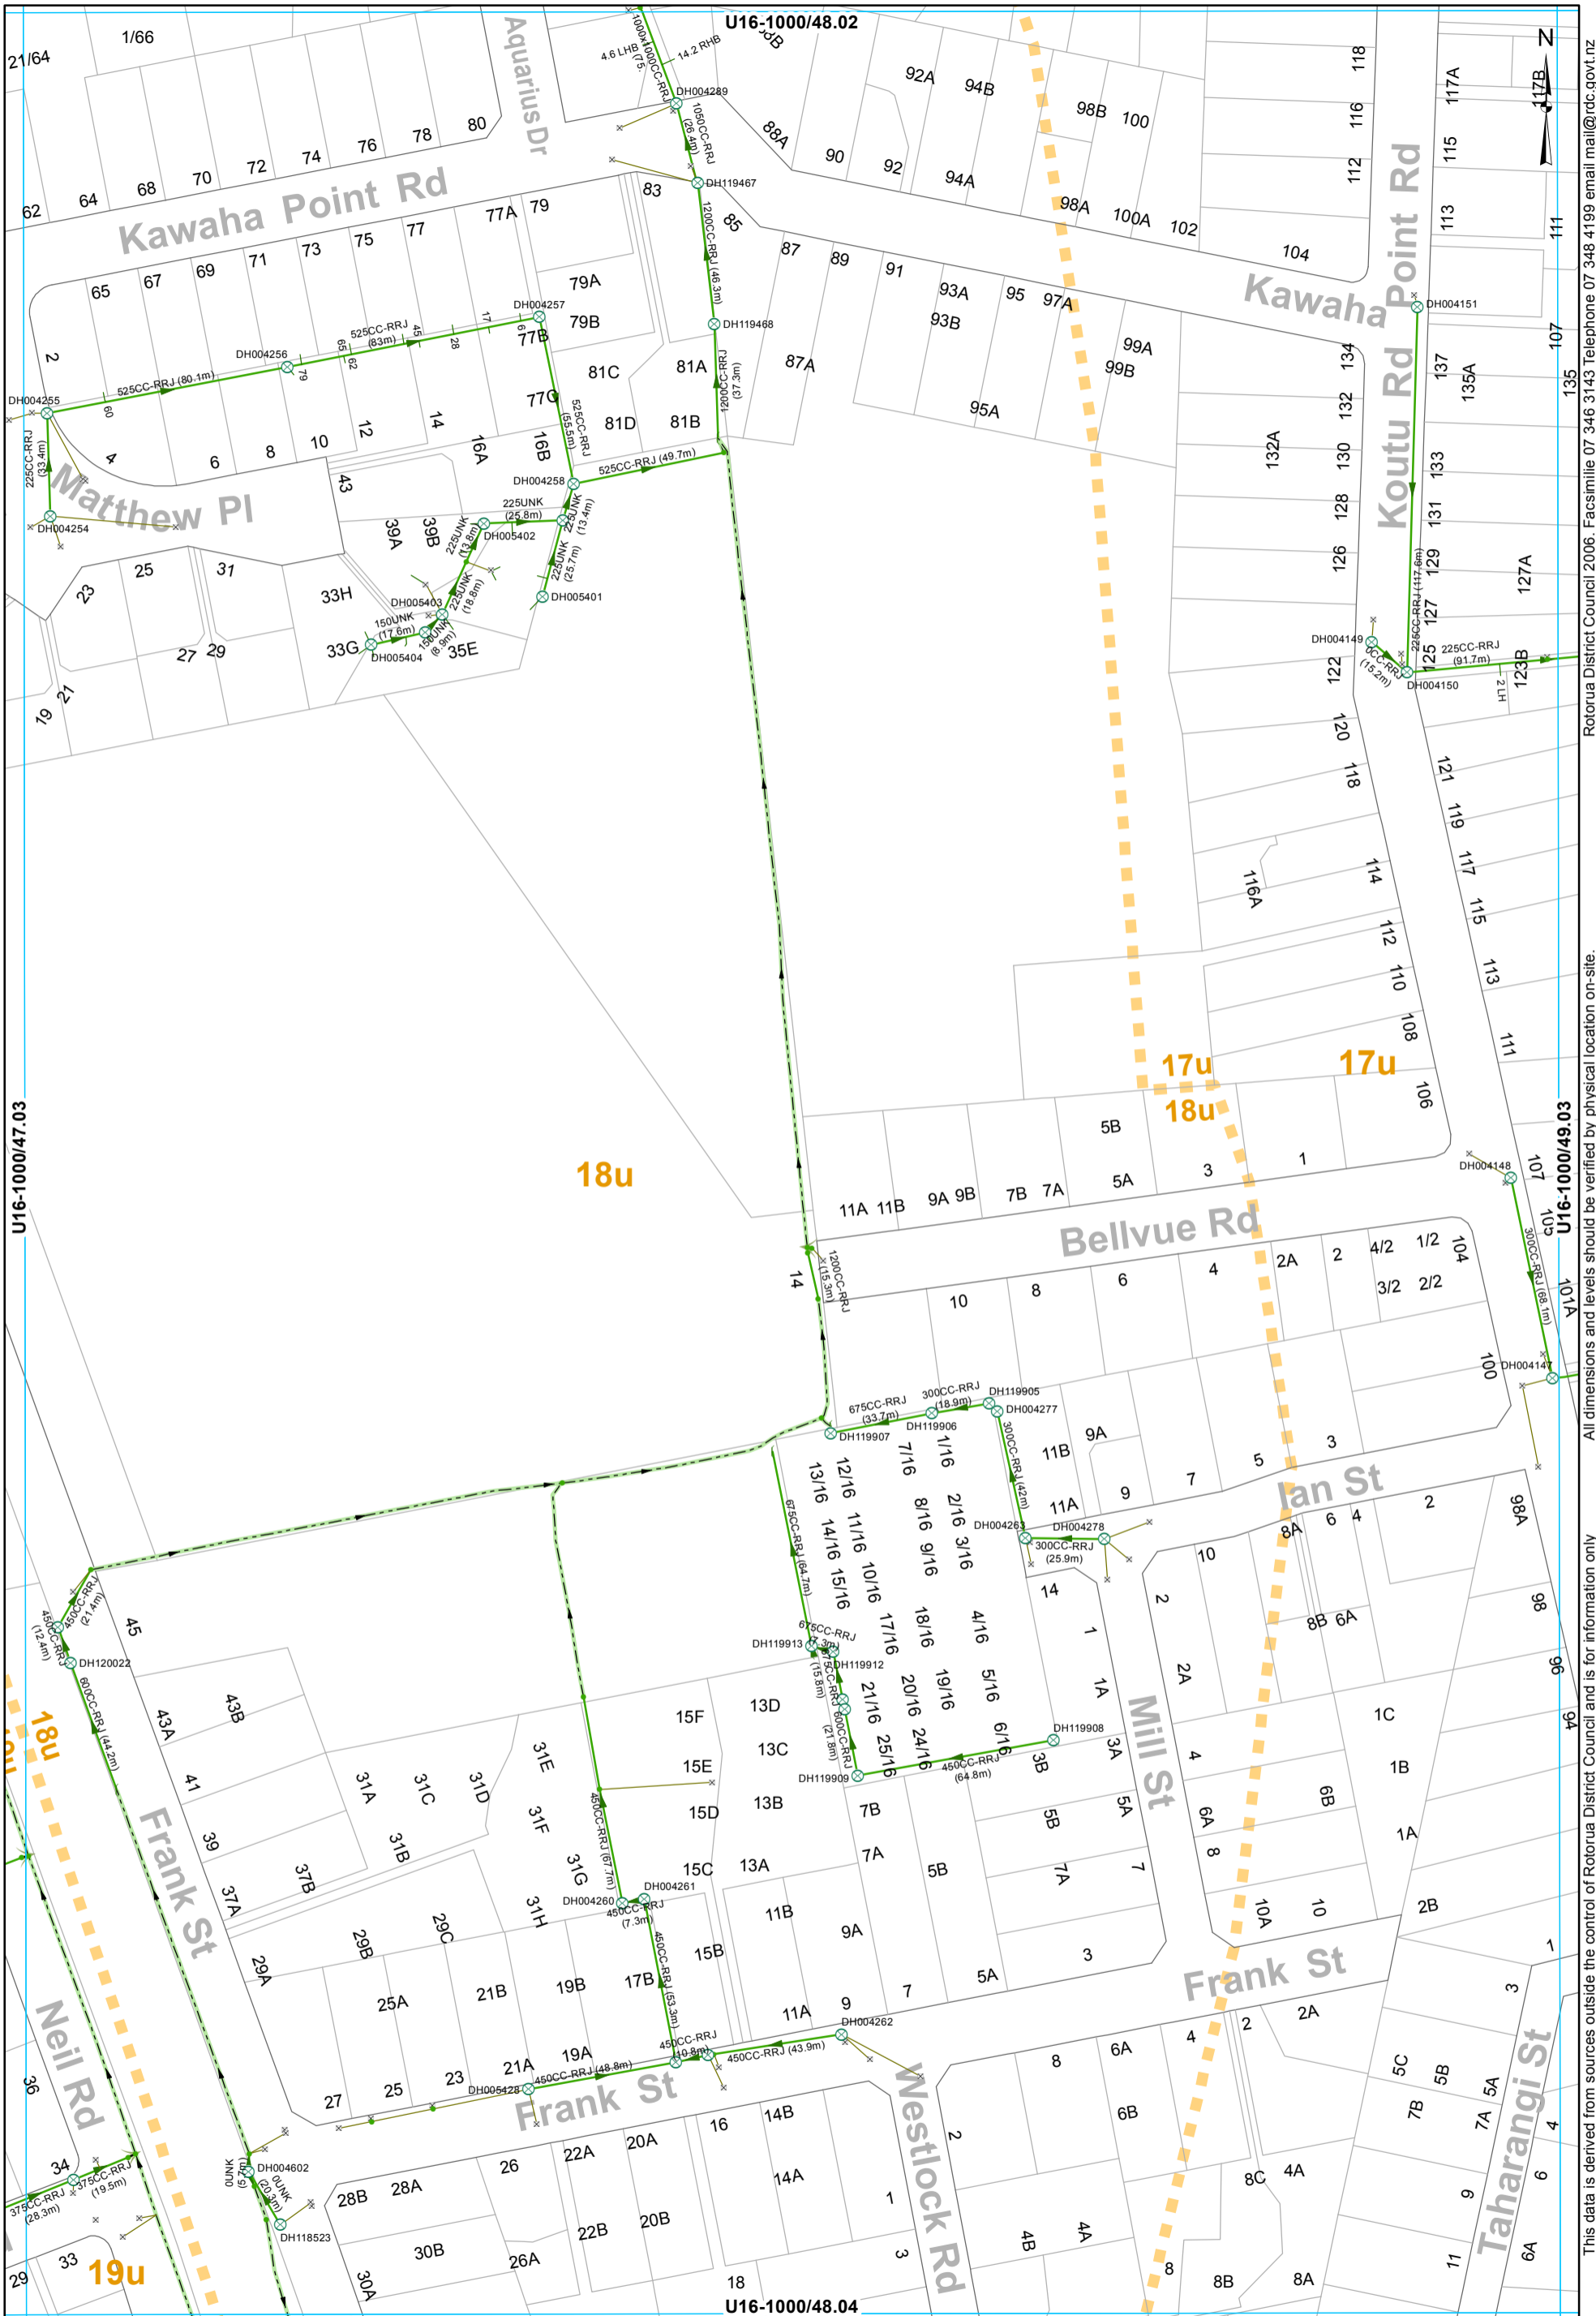


- ⊗ SWManhole
- ⊗ SWInlet
- Node
- Headwall Structure
- Open Drain
- Overland Flow
- Culvert
- Gravity Main
- SWServiceline
- SWServiceline
- SWLead
- Catchment Boundary

STORMWATER SERVICES
1:2000 @ A3 - (U16-1000/48.03)

This data is derived from sources outside the control of Rotorua District Council and is for information only

All dimensions and levels should be verified by physical location on-site.

Rotorua District Council 2006. Facsimile 07 346 3143 Telephone 07 348 4199 email mail@rdc.govt.nz

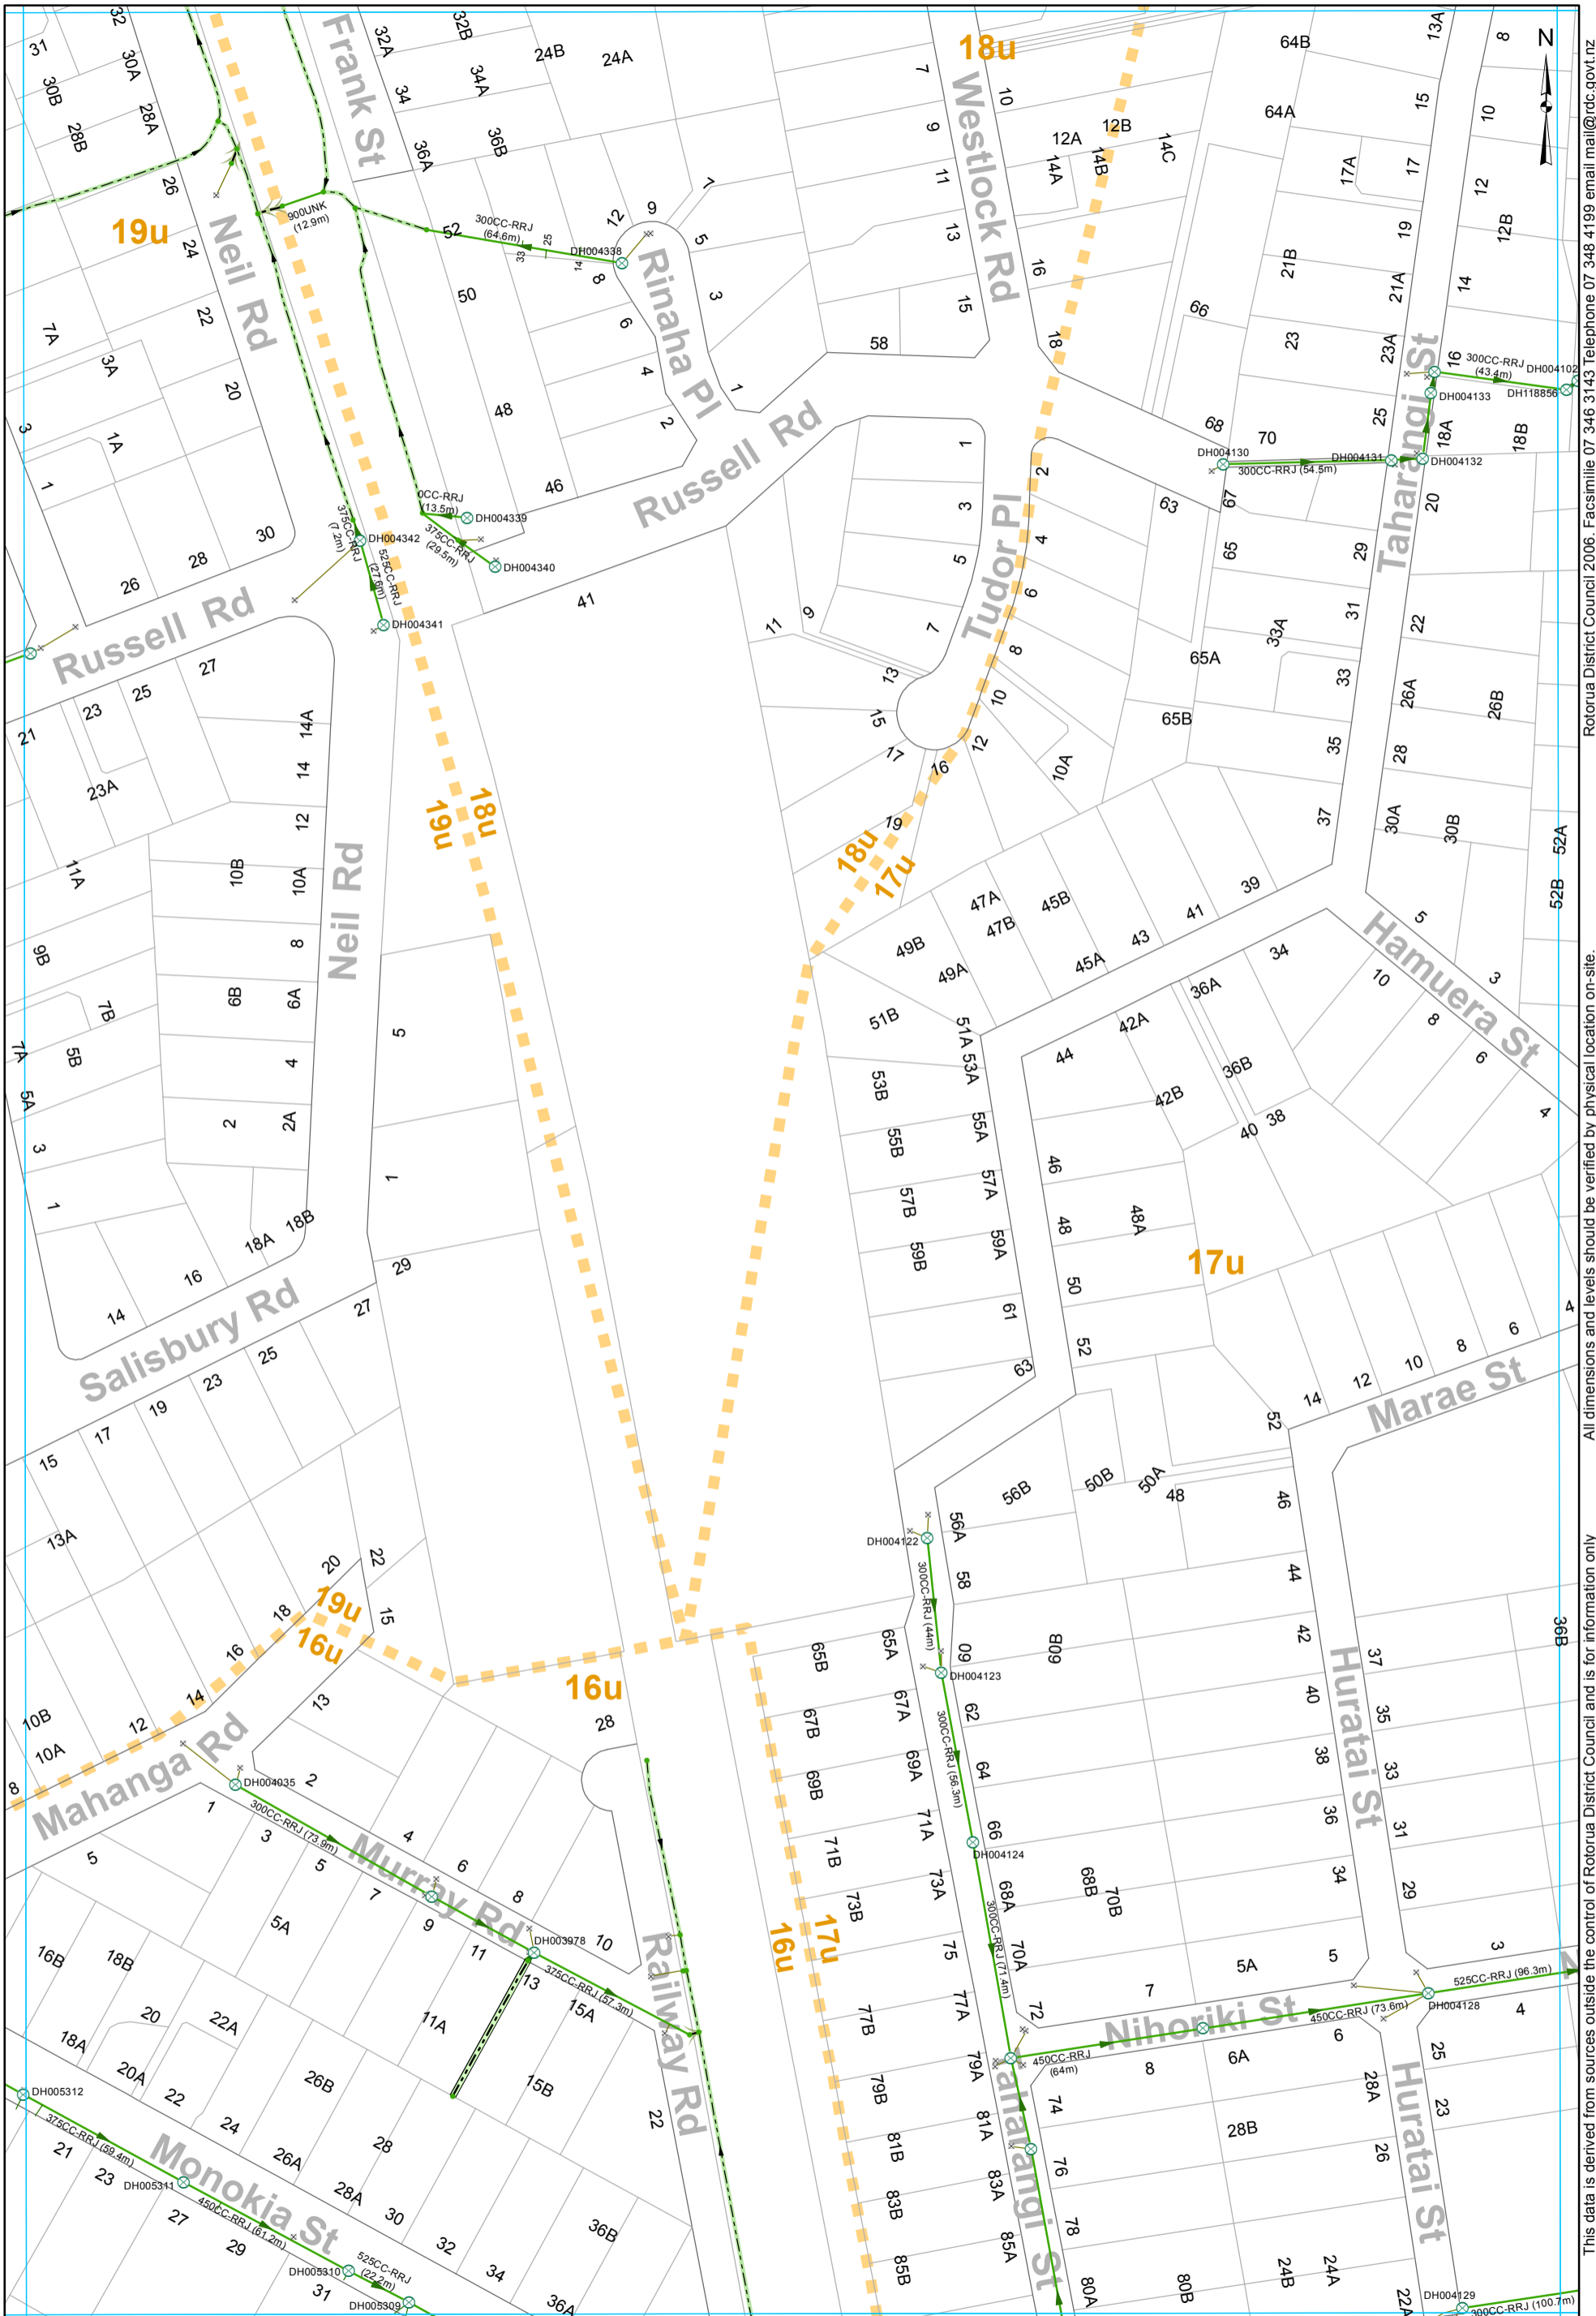

- ⊗ SWManhole
- × SWInlet
- Node
- Lined Channel
- Open Drain
- Overland Flow
- Culvert
- Gravity Main
- SWServiceline
- SWServiceline
- SWLead
- Catchment Boundary

STORMWATER SERVICES
1:2000 @ A3 - (U16-1000/48.04)

All dimensions and levels should be verified by physical location on-site. Rotorua District Council 2006. Facsimile 07 346 3143 Telephone 07 348 4199 email mail@rdc.govt.nz