


Storm Water Asbuilt Sheet Index  
 SWCatchment 19r

Compiled on 2023-05-02 from as-buils of various dates. For up to date as-buils please visit [http://geo.rdc.govt.nz/images/plotfiles/3waters\\_mobile\\_asbuils/](http://geo.rdc.govt.nz/images/plotfiles/3waters_mobile_asbuils/)

U16-1000/43.03

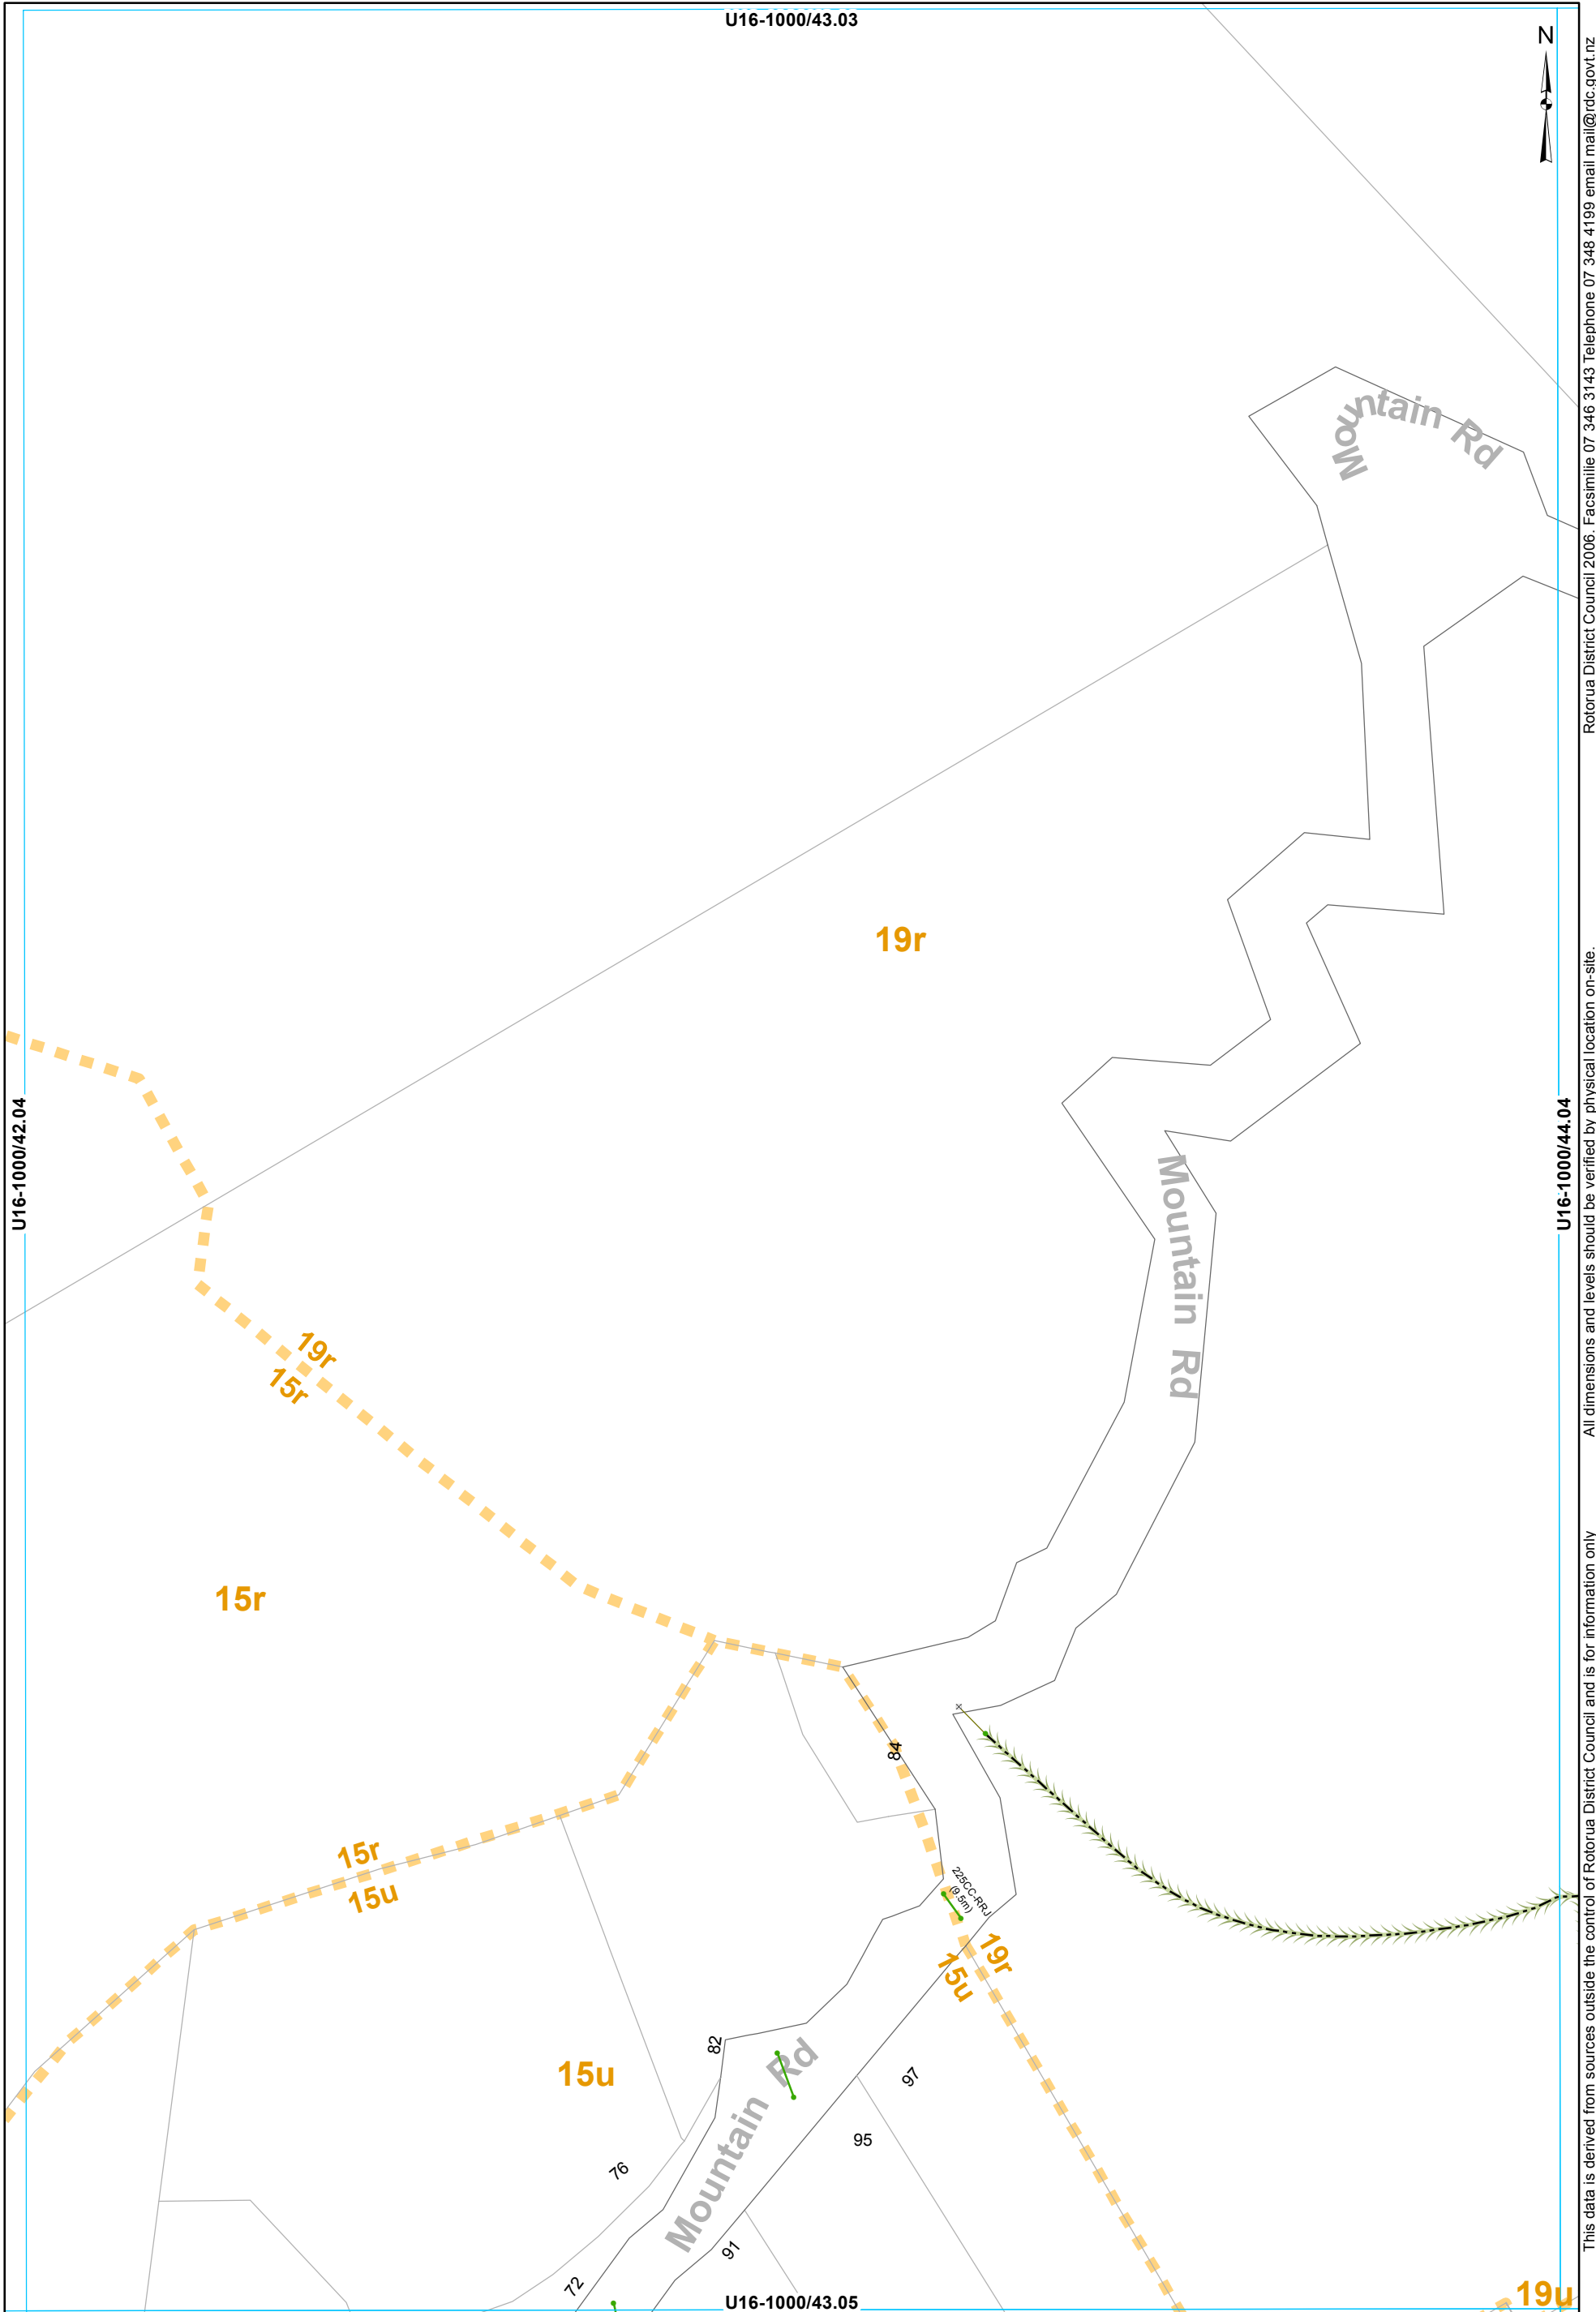


- × SWInlet
- Node
- Overland Flow
- Culvert
- SWLead
- ▬ Catchment Boundary

**STORMWATER SERVICES**  
1:2000 @ A3 - (U16-1000/43.04)

This data is derived from sources outside the control of Rotorua District Council and is for information only

Rotorua District Council 2006. Facsimile 07 346 3143 Telephone 07 348 4199 email mail@rdc.govt.nz

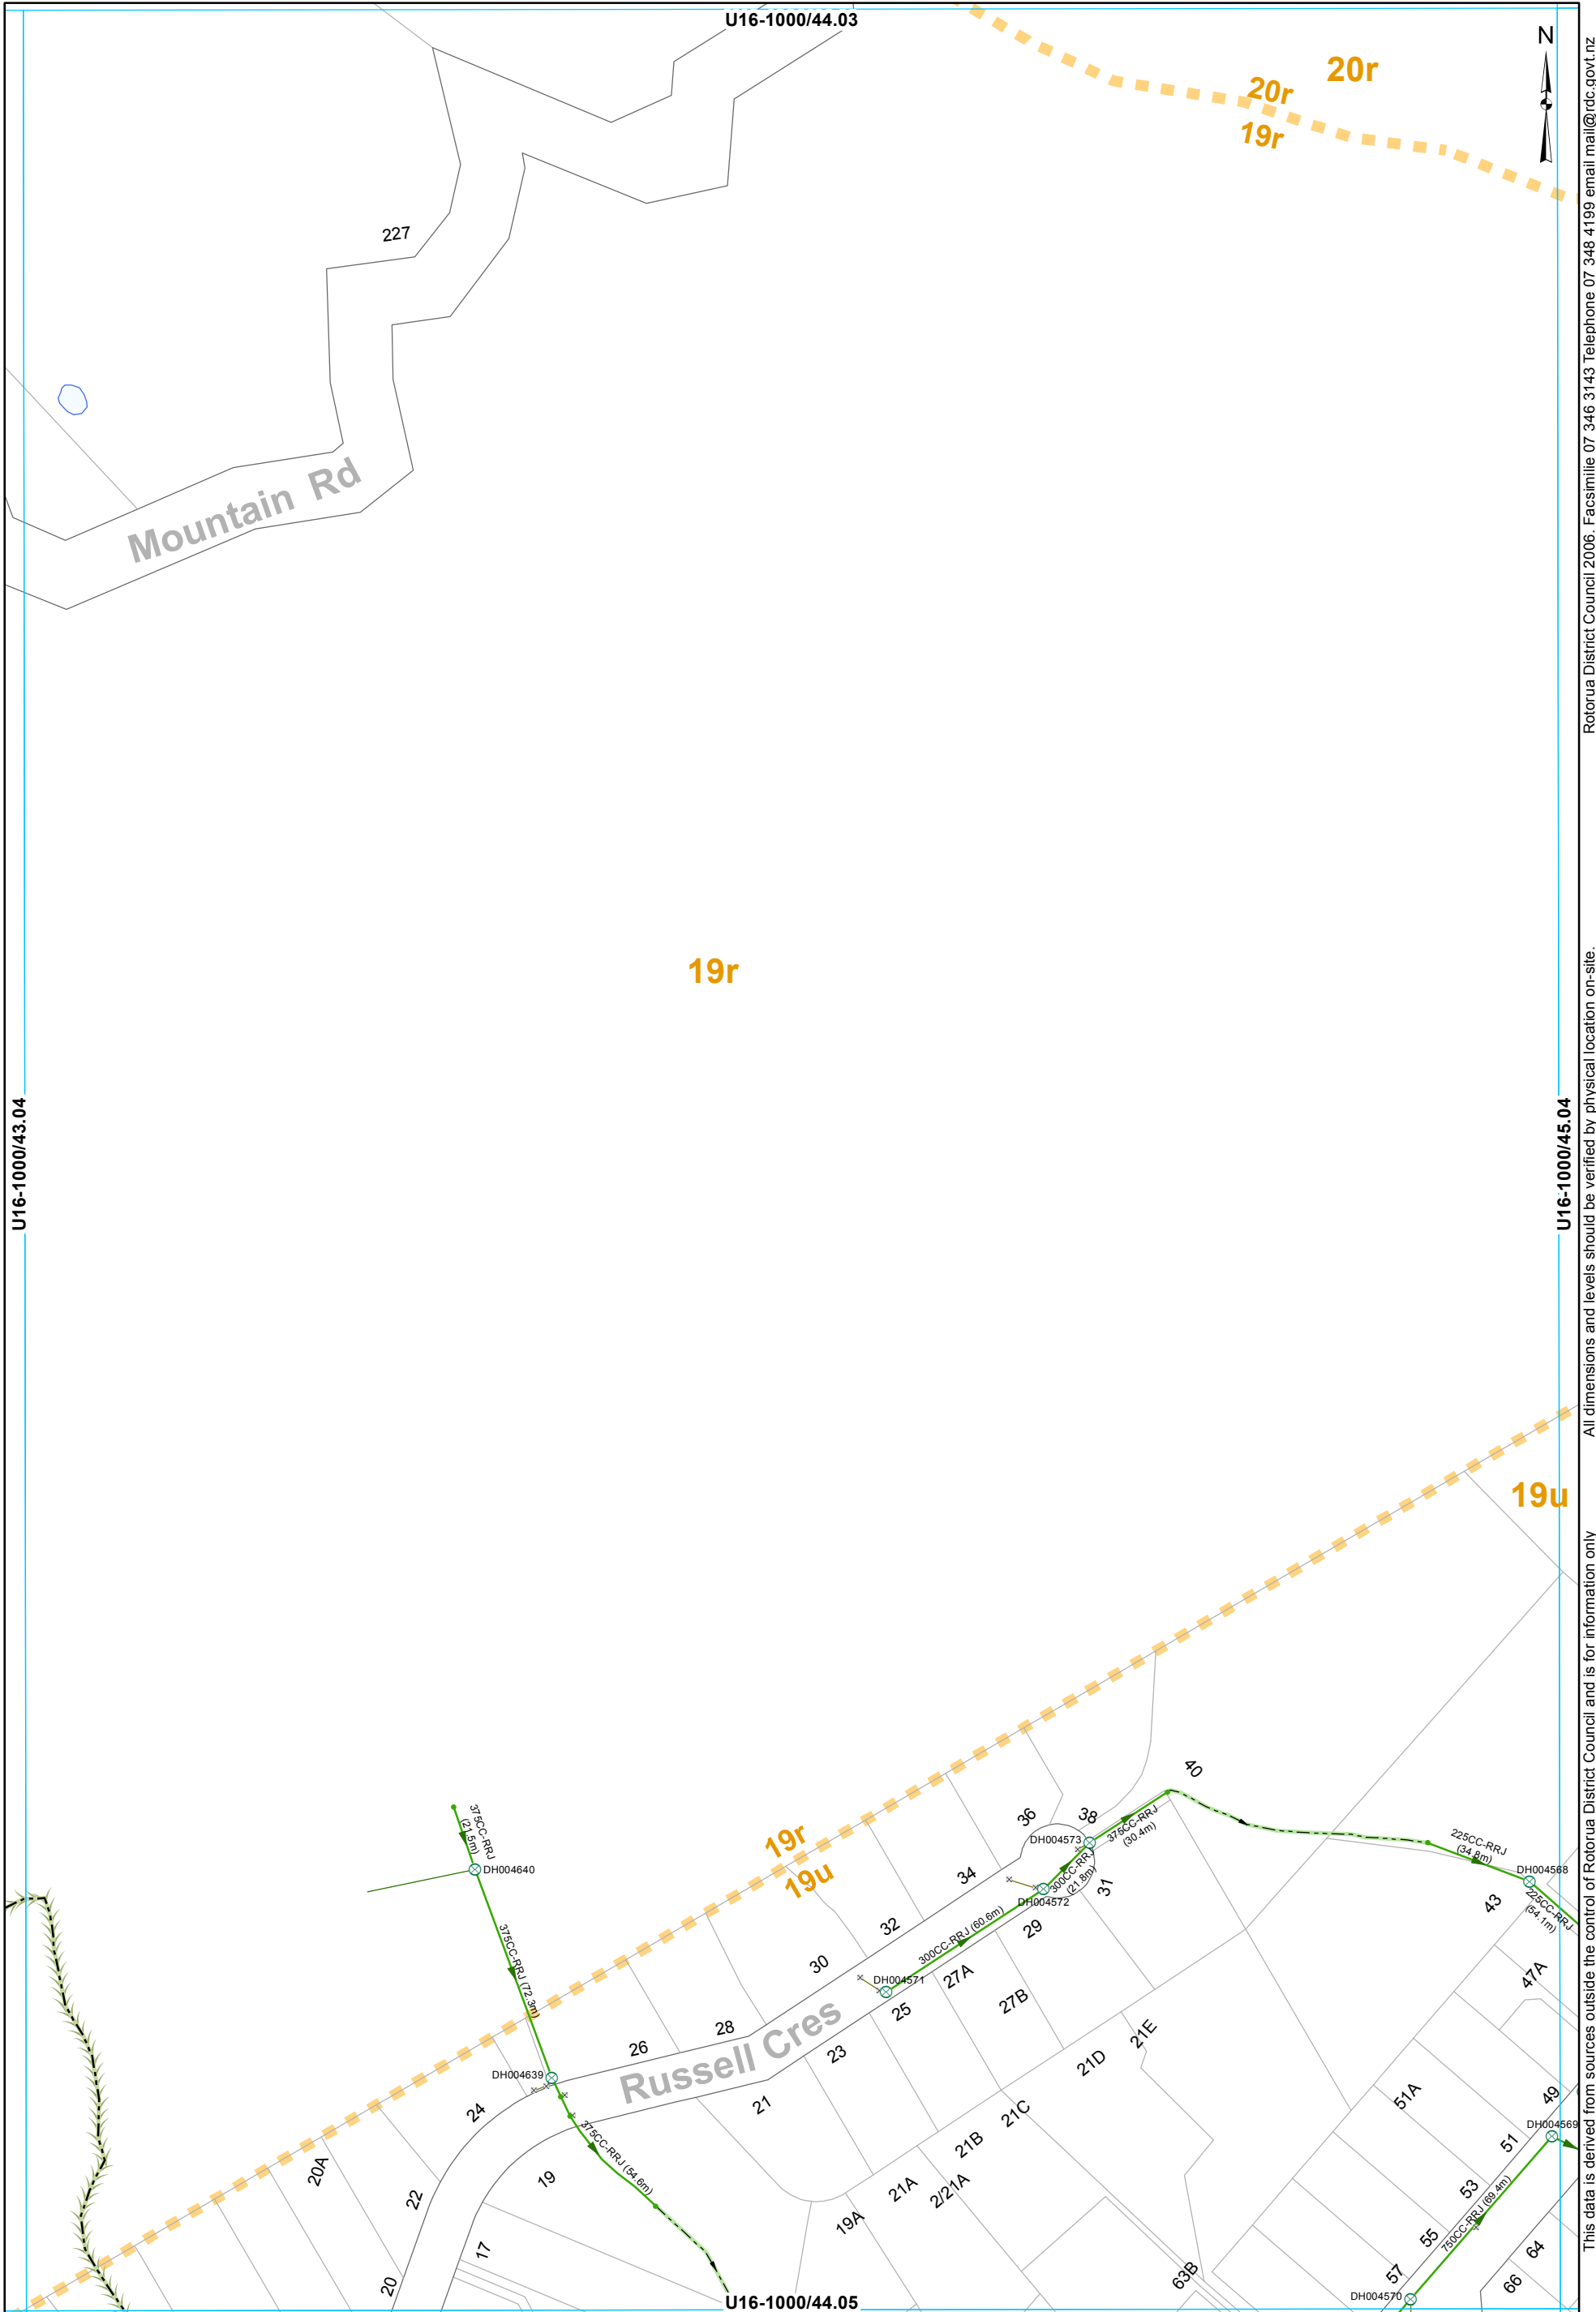

- ⊗ SWManhole
- × SWInlet
- Node
- Open Drain
- Overland Flow
- Gravity Main
- SWServiceline
- SWLead
- Catchment Boundary

**STORMWATER SERVICES**  
**1:2000 @ A3 - (U16-1000/44.04)**

U16-1000/43.04

U16-1000/45.04


U16-1000/44.03

U16-1000/44.05

Rotorua District Council 2006. Facsimile 07 346 3143 Telephone 07 348 4199 email mail@rdc.govt.nz

All dimensions and levels should be verified by physical location on-site.

This data is derived from sources outside the control of Rotorua District Council and is for information only

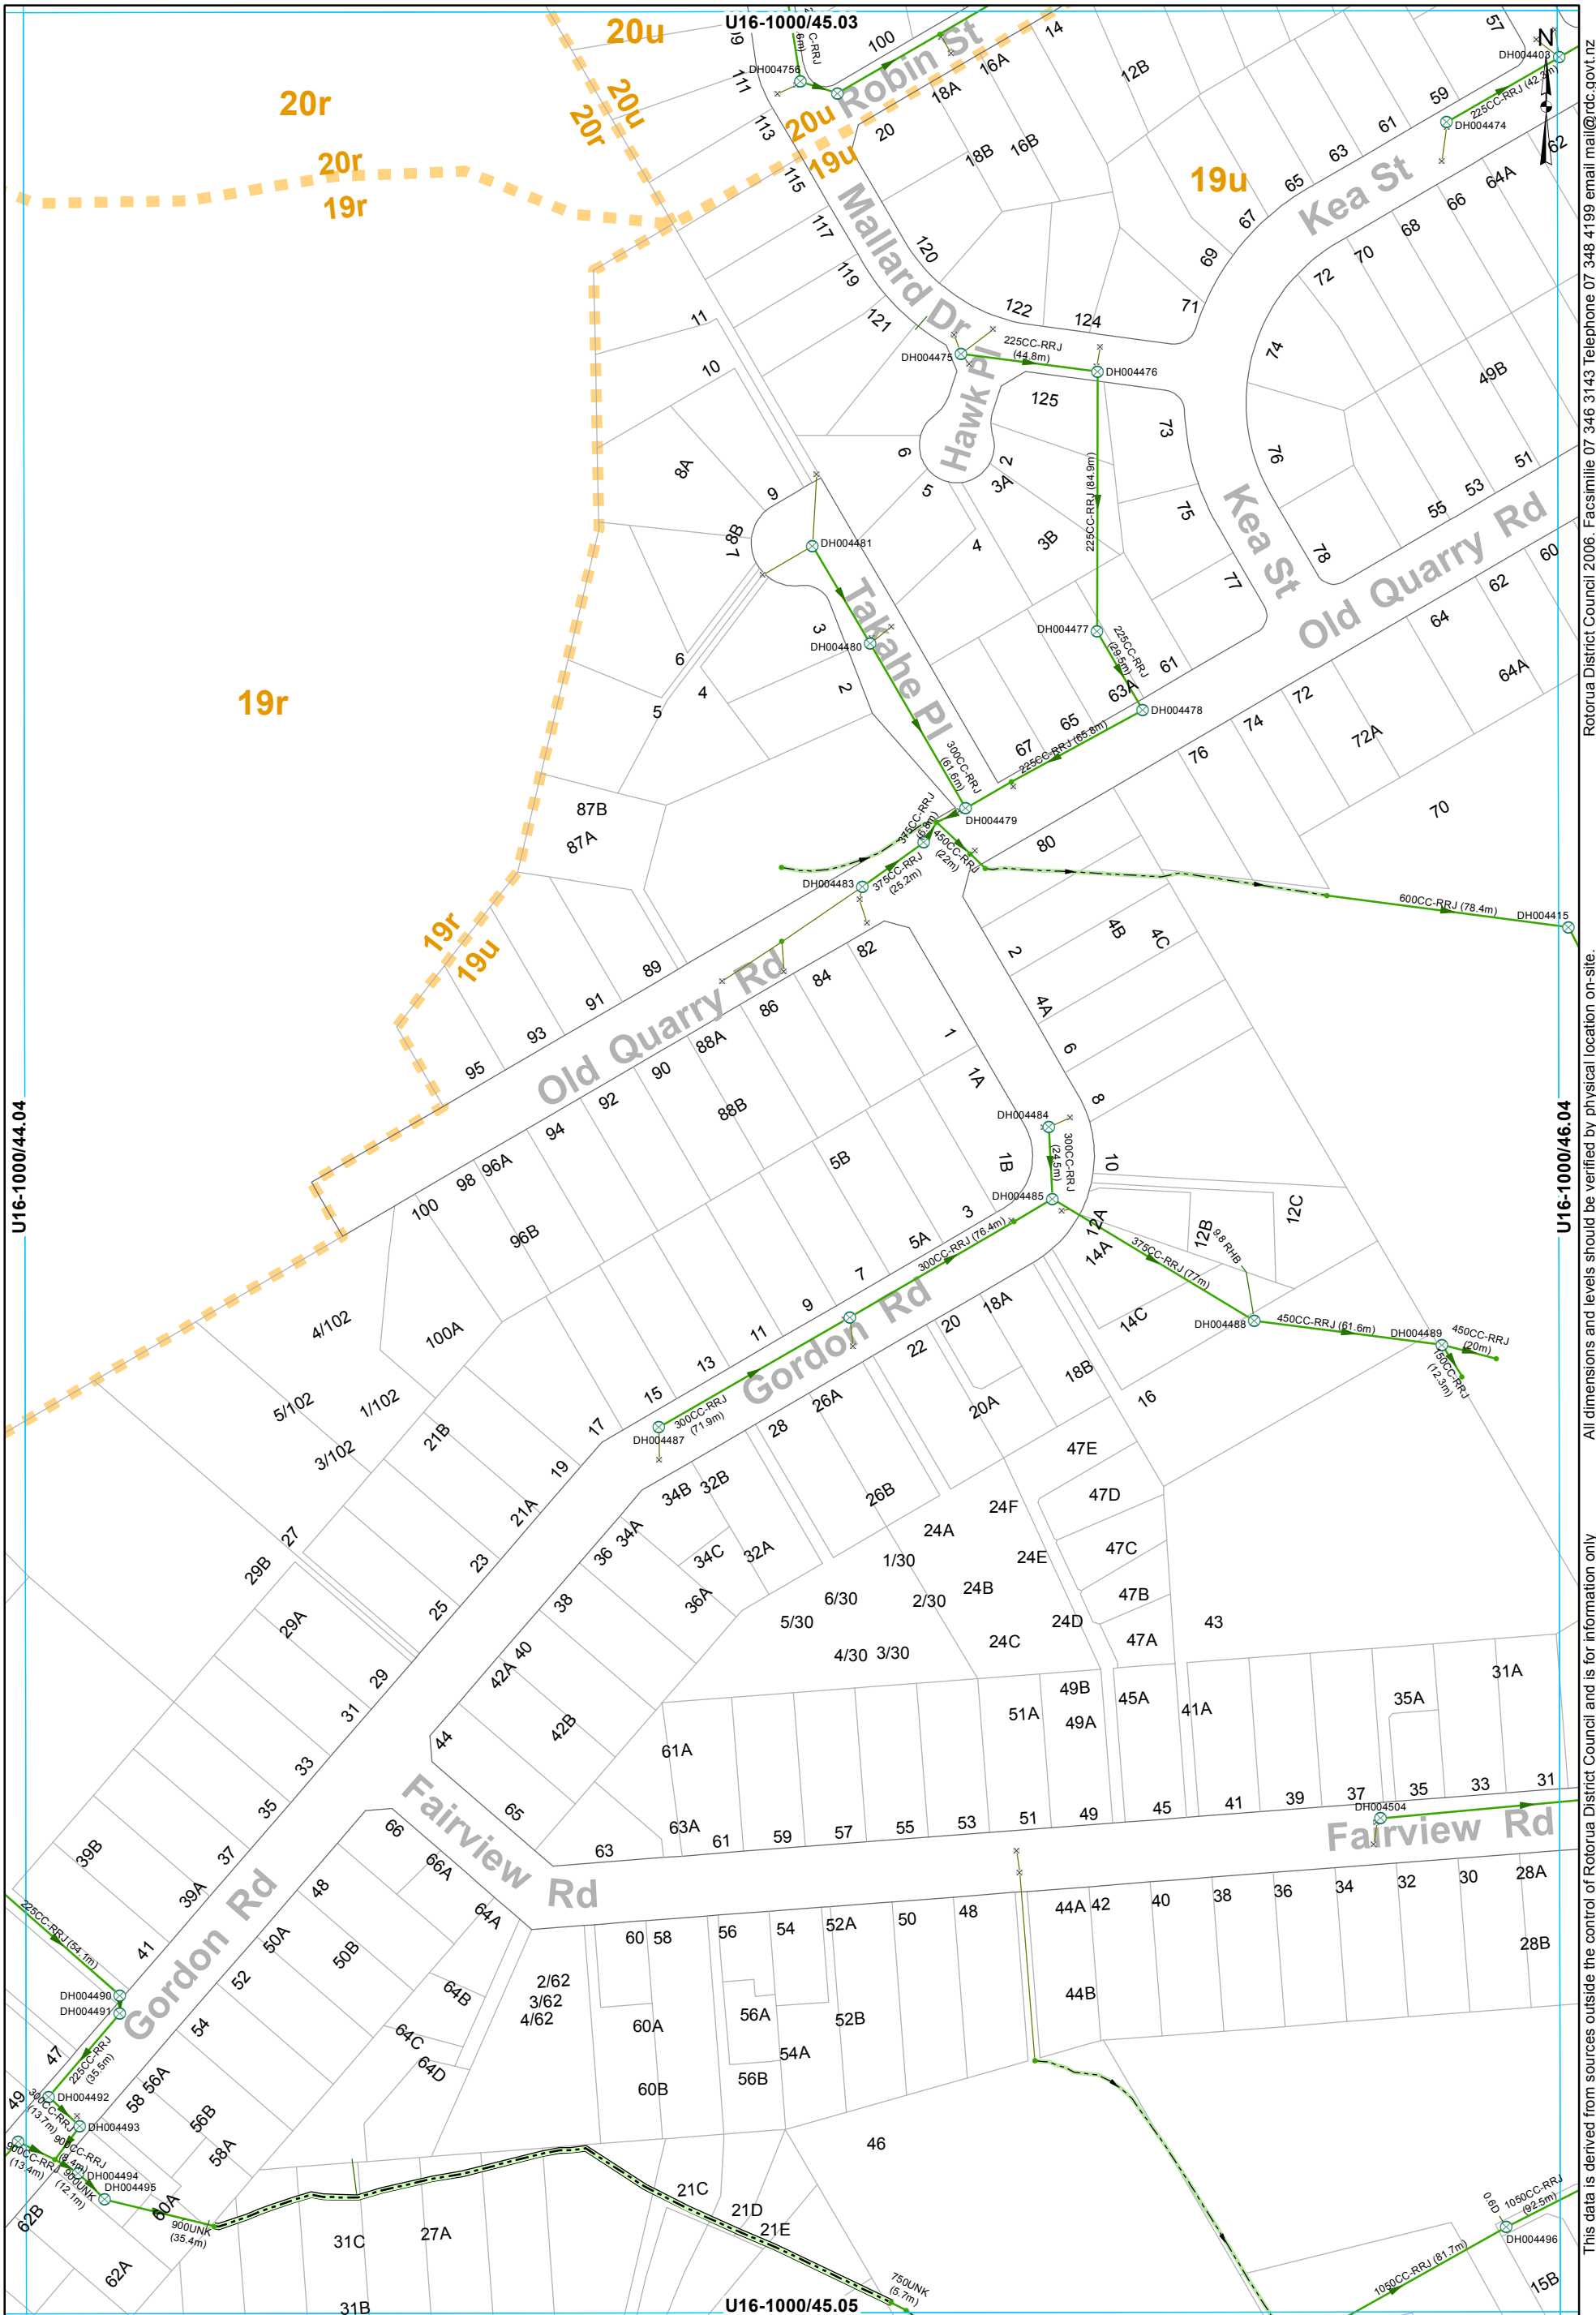

U16-1000/44.04

U16-1000/46.04

- ⊗ SWManhole
- × SWInlet
- Node
- Lined Channel
- Open Drain
- Culvert
- Gravity Main
- SWServiceline
- SWServiceline
- SWLead
- Catchment Boundary

**STORMWATER SERVICES**  
1:2000 @ A3 - (U16-1000/45.04)

All dimensions and levels outside the control of Rotorua District Council and is for information only. Rotorua District Council 2006. Facsimile 07 348 3143 Telephone 07 348 4199 email mail@rdc.govt.nz





- ⊗ SWManhole
- × SWInlet
- Node
- Open Drain
- Culvert
- Gravity Main
- SWServiceline
- SWServiceline
- SWLead
- Catchment Boundary

**STORMWATER SERVICES**  
**1:2000 @ A3 - (U16-1000/43.05)**

This data is derived from sources outside the control of Rotorua District Council and is for information only

All dimensions and levels should be verified by physical location on-site.

Rotorua District Council 2006. Facsimile 07 346 3143 Telephone 07 348 4199 email mail@rdc.govt.nz