




Storm Water Asbuilt Sheet Index
 SWCatchment 1r-2r

Compiled on 2023-05-02 from as-builts of various dates. For up to date as-builts please visit http://geo.rdc.govt.nz/images/plotfiles/3waters_mobile_asbuilts/

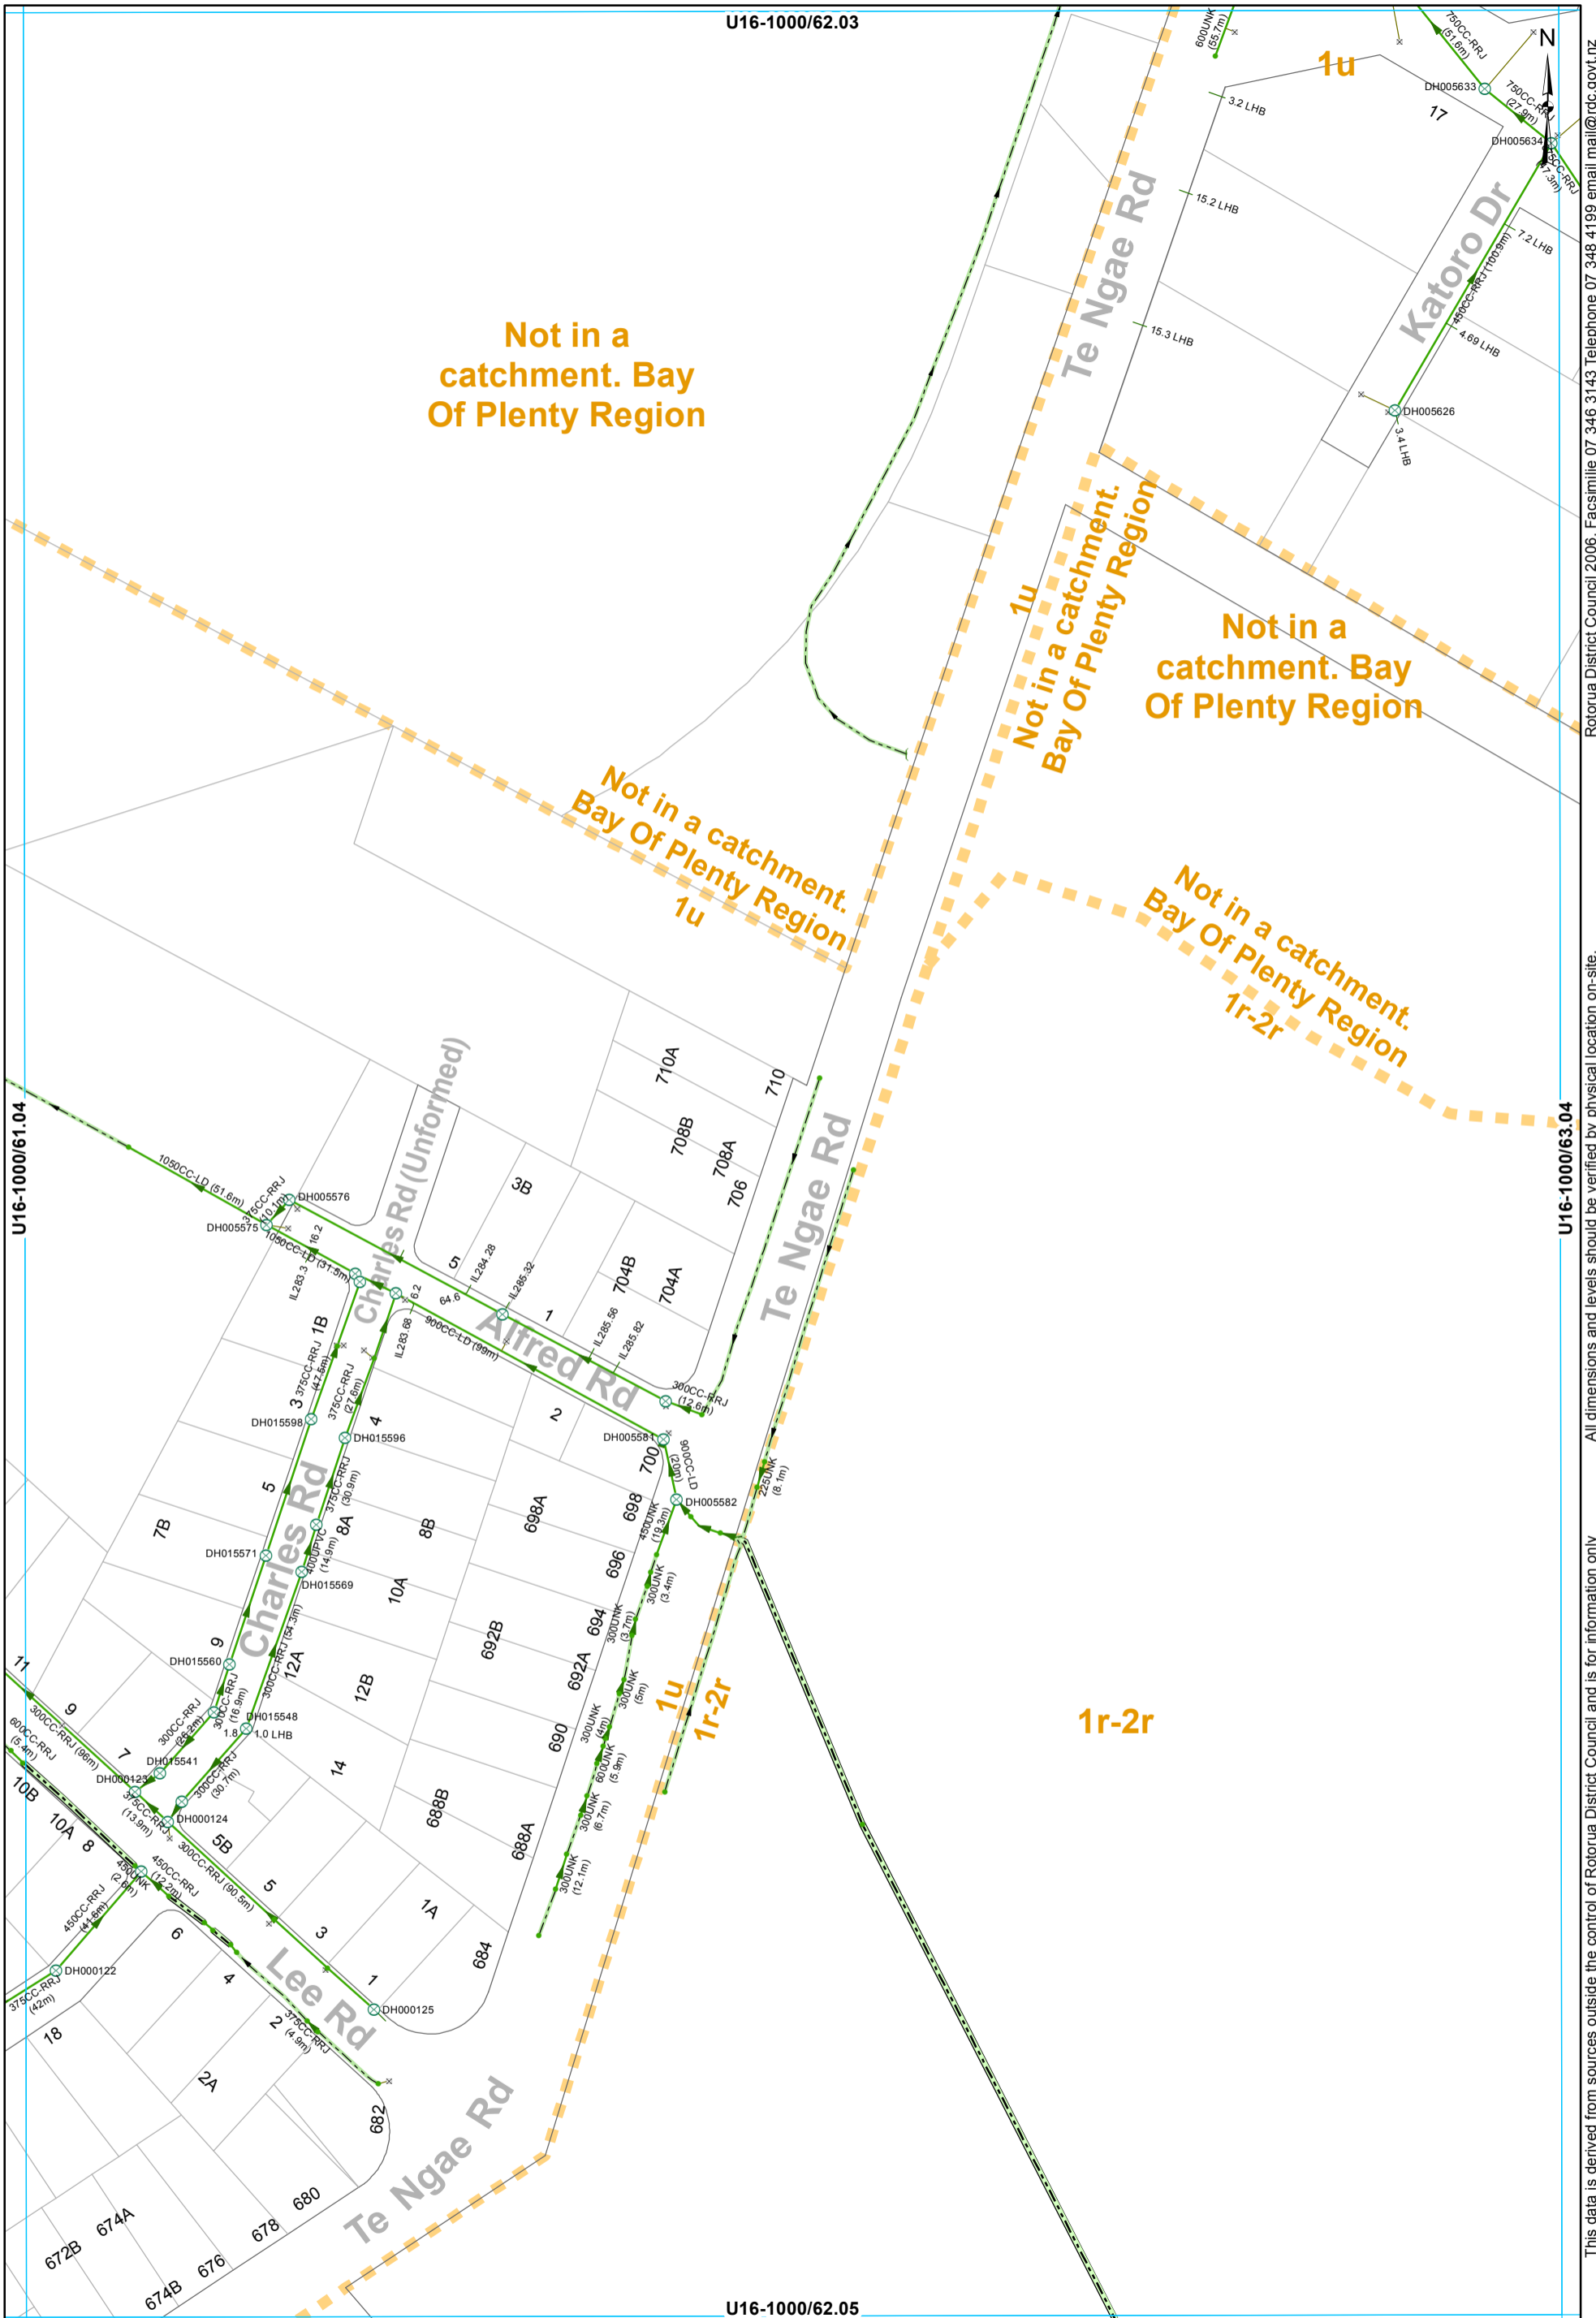

Not in a catchment. Bay Of Plenty Region

Not in a catchment. Bay Of Plenty Region


Not in a catchment. Bay Of Plenty Region

Not in a catchment. Bay Of Plenty Region

1r-2r

- ⊗ SWManhole
- × SWInlet
- Node
- Headwall Structure
- Lined Channel
- Open Drain
- Culvert
- Gravity Main
- SWServiceline
- SWServiceline
- SWLead
- Catchment Boundary

STORMWATER SERVICES
1:2000 @ A3 - (U16-1000/62.04)

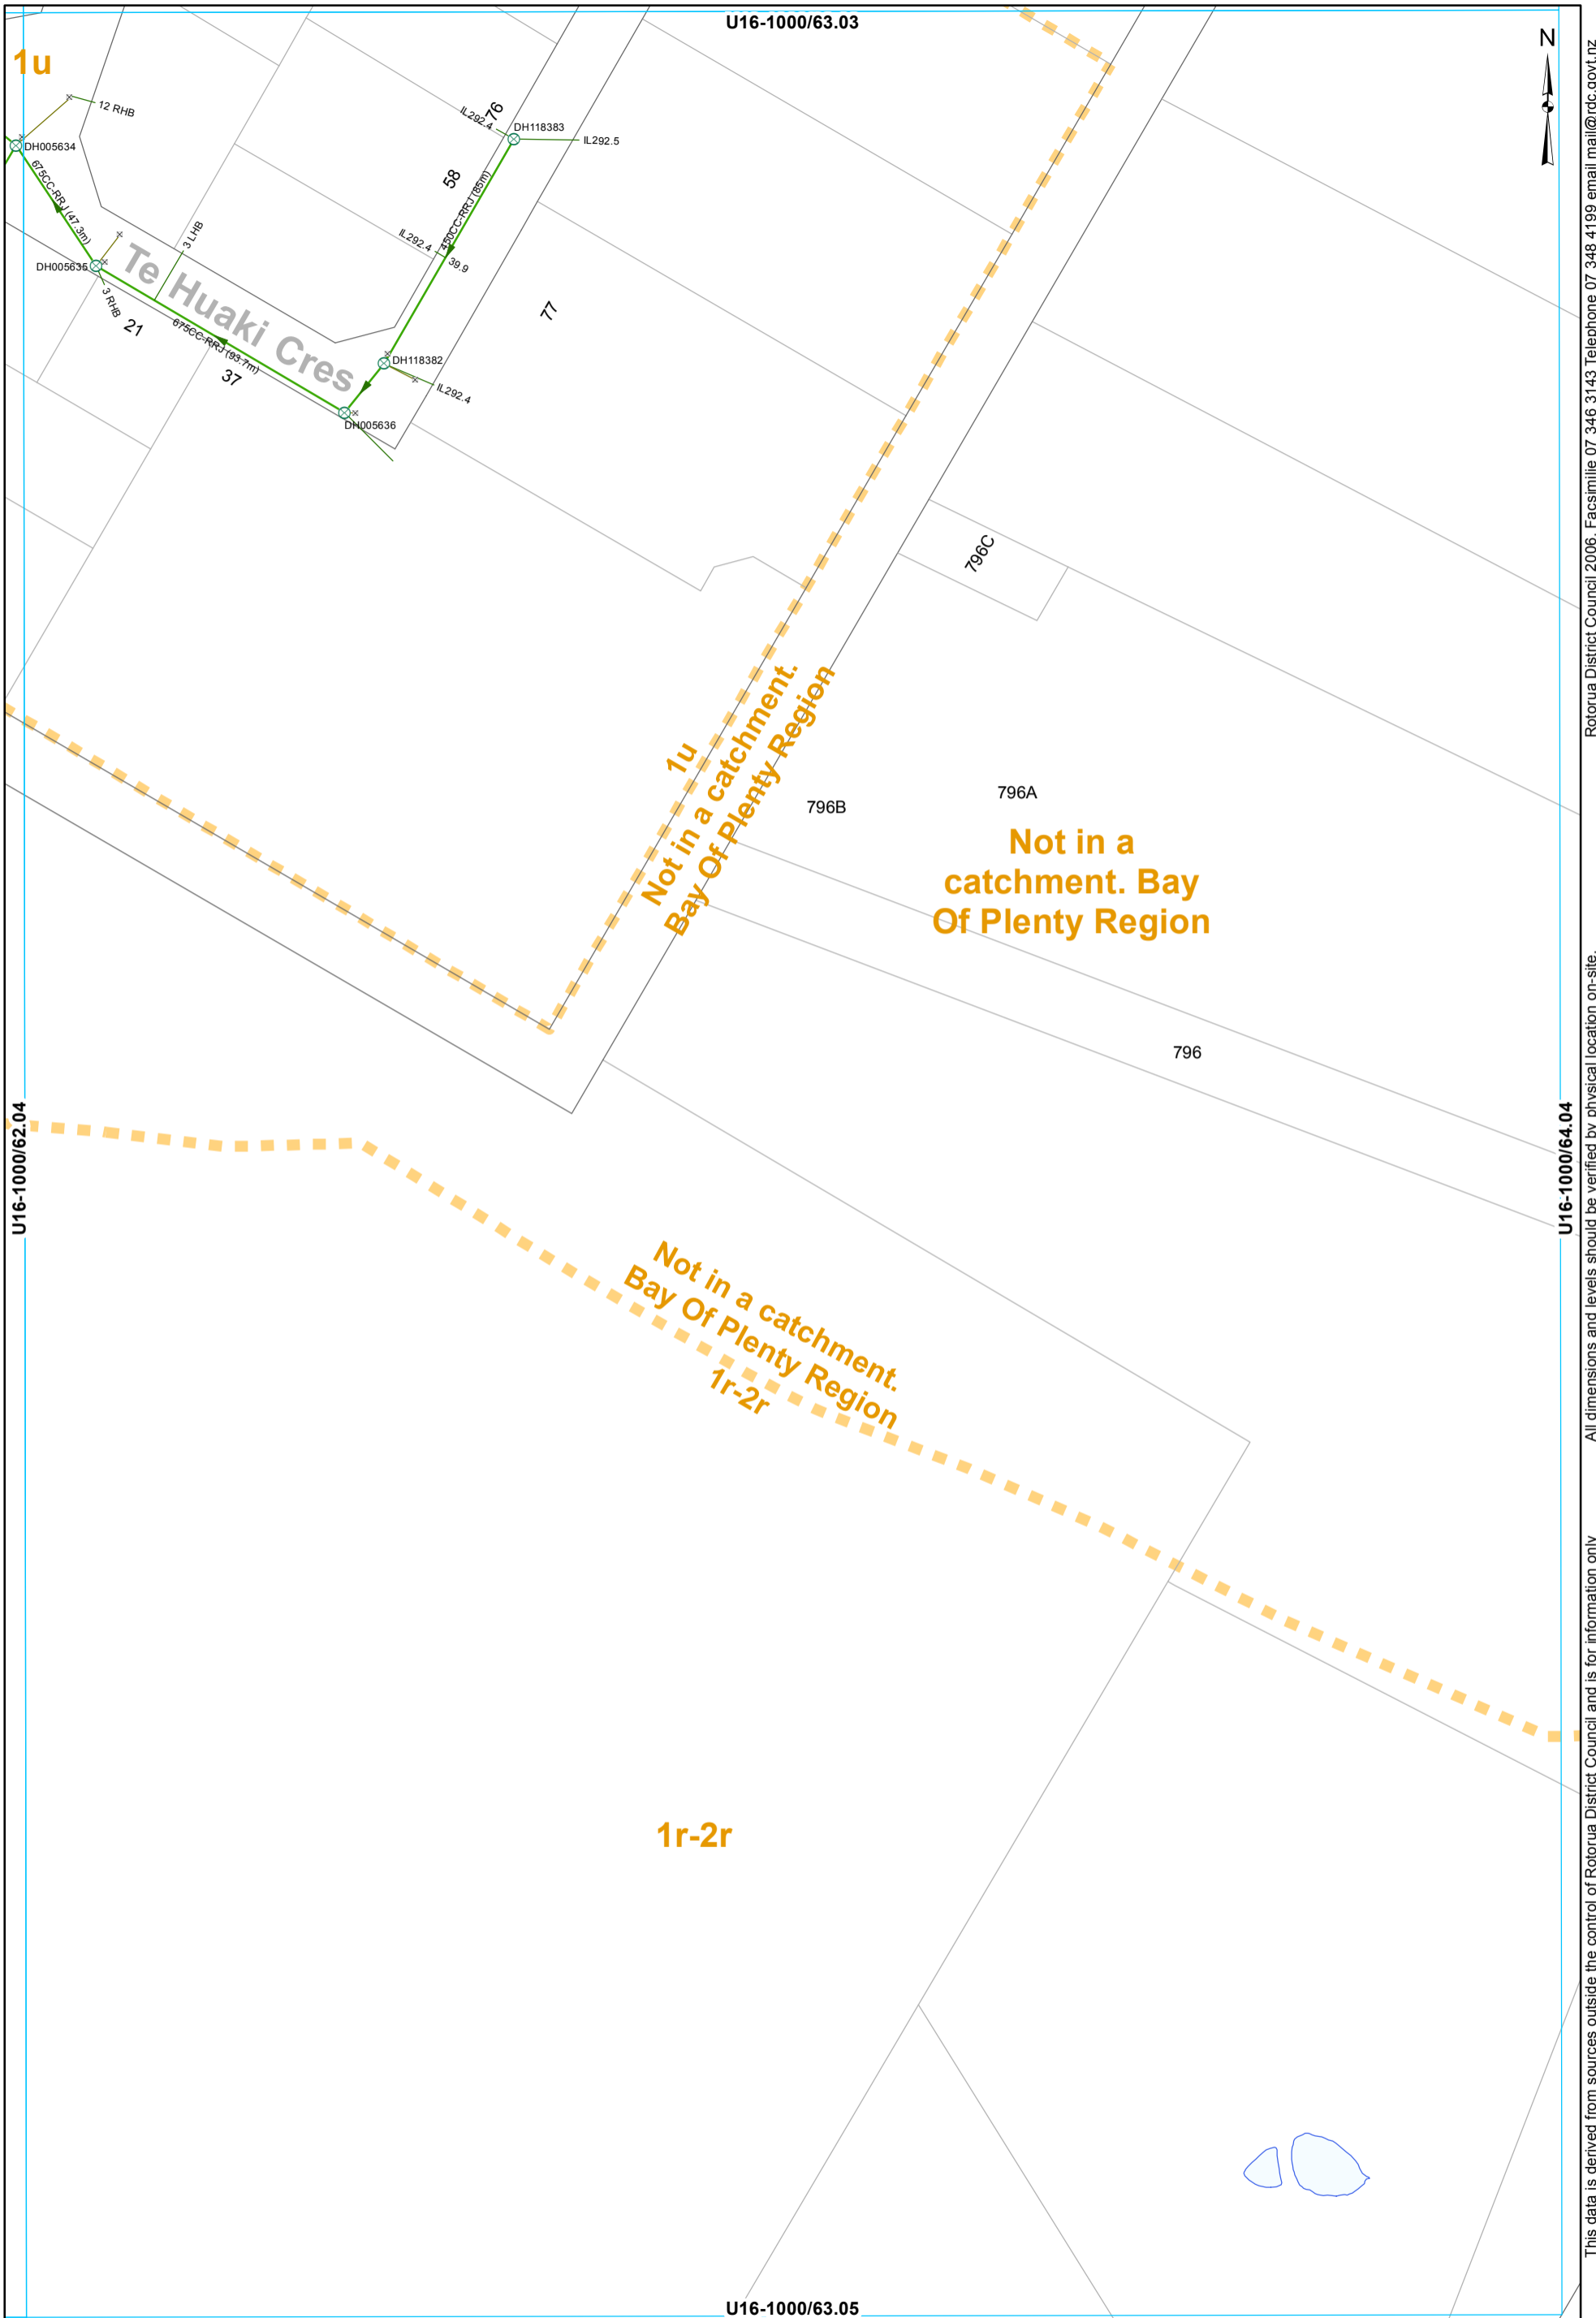


- ⊗ SWManhole — Gravity Main SWServiceline
- × SWInlet — SWServiceline
- SWLead
- Catchment Boundary

STORMWATER SERVICES
 1:2000 @ A3 - (U16-1000/63.04)

This data is derived from sources outside the control of Rotorua District Council and is for information only

All dimensions and levels should be verified by physical location on-site.

Rotorua District Council 2006. Facsimile 07 346 3143 Telephone 07 346 4199 email mail@rdc.govt.nz

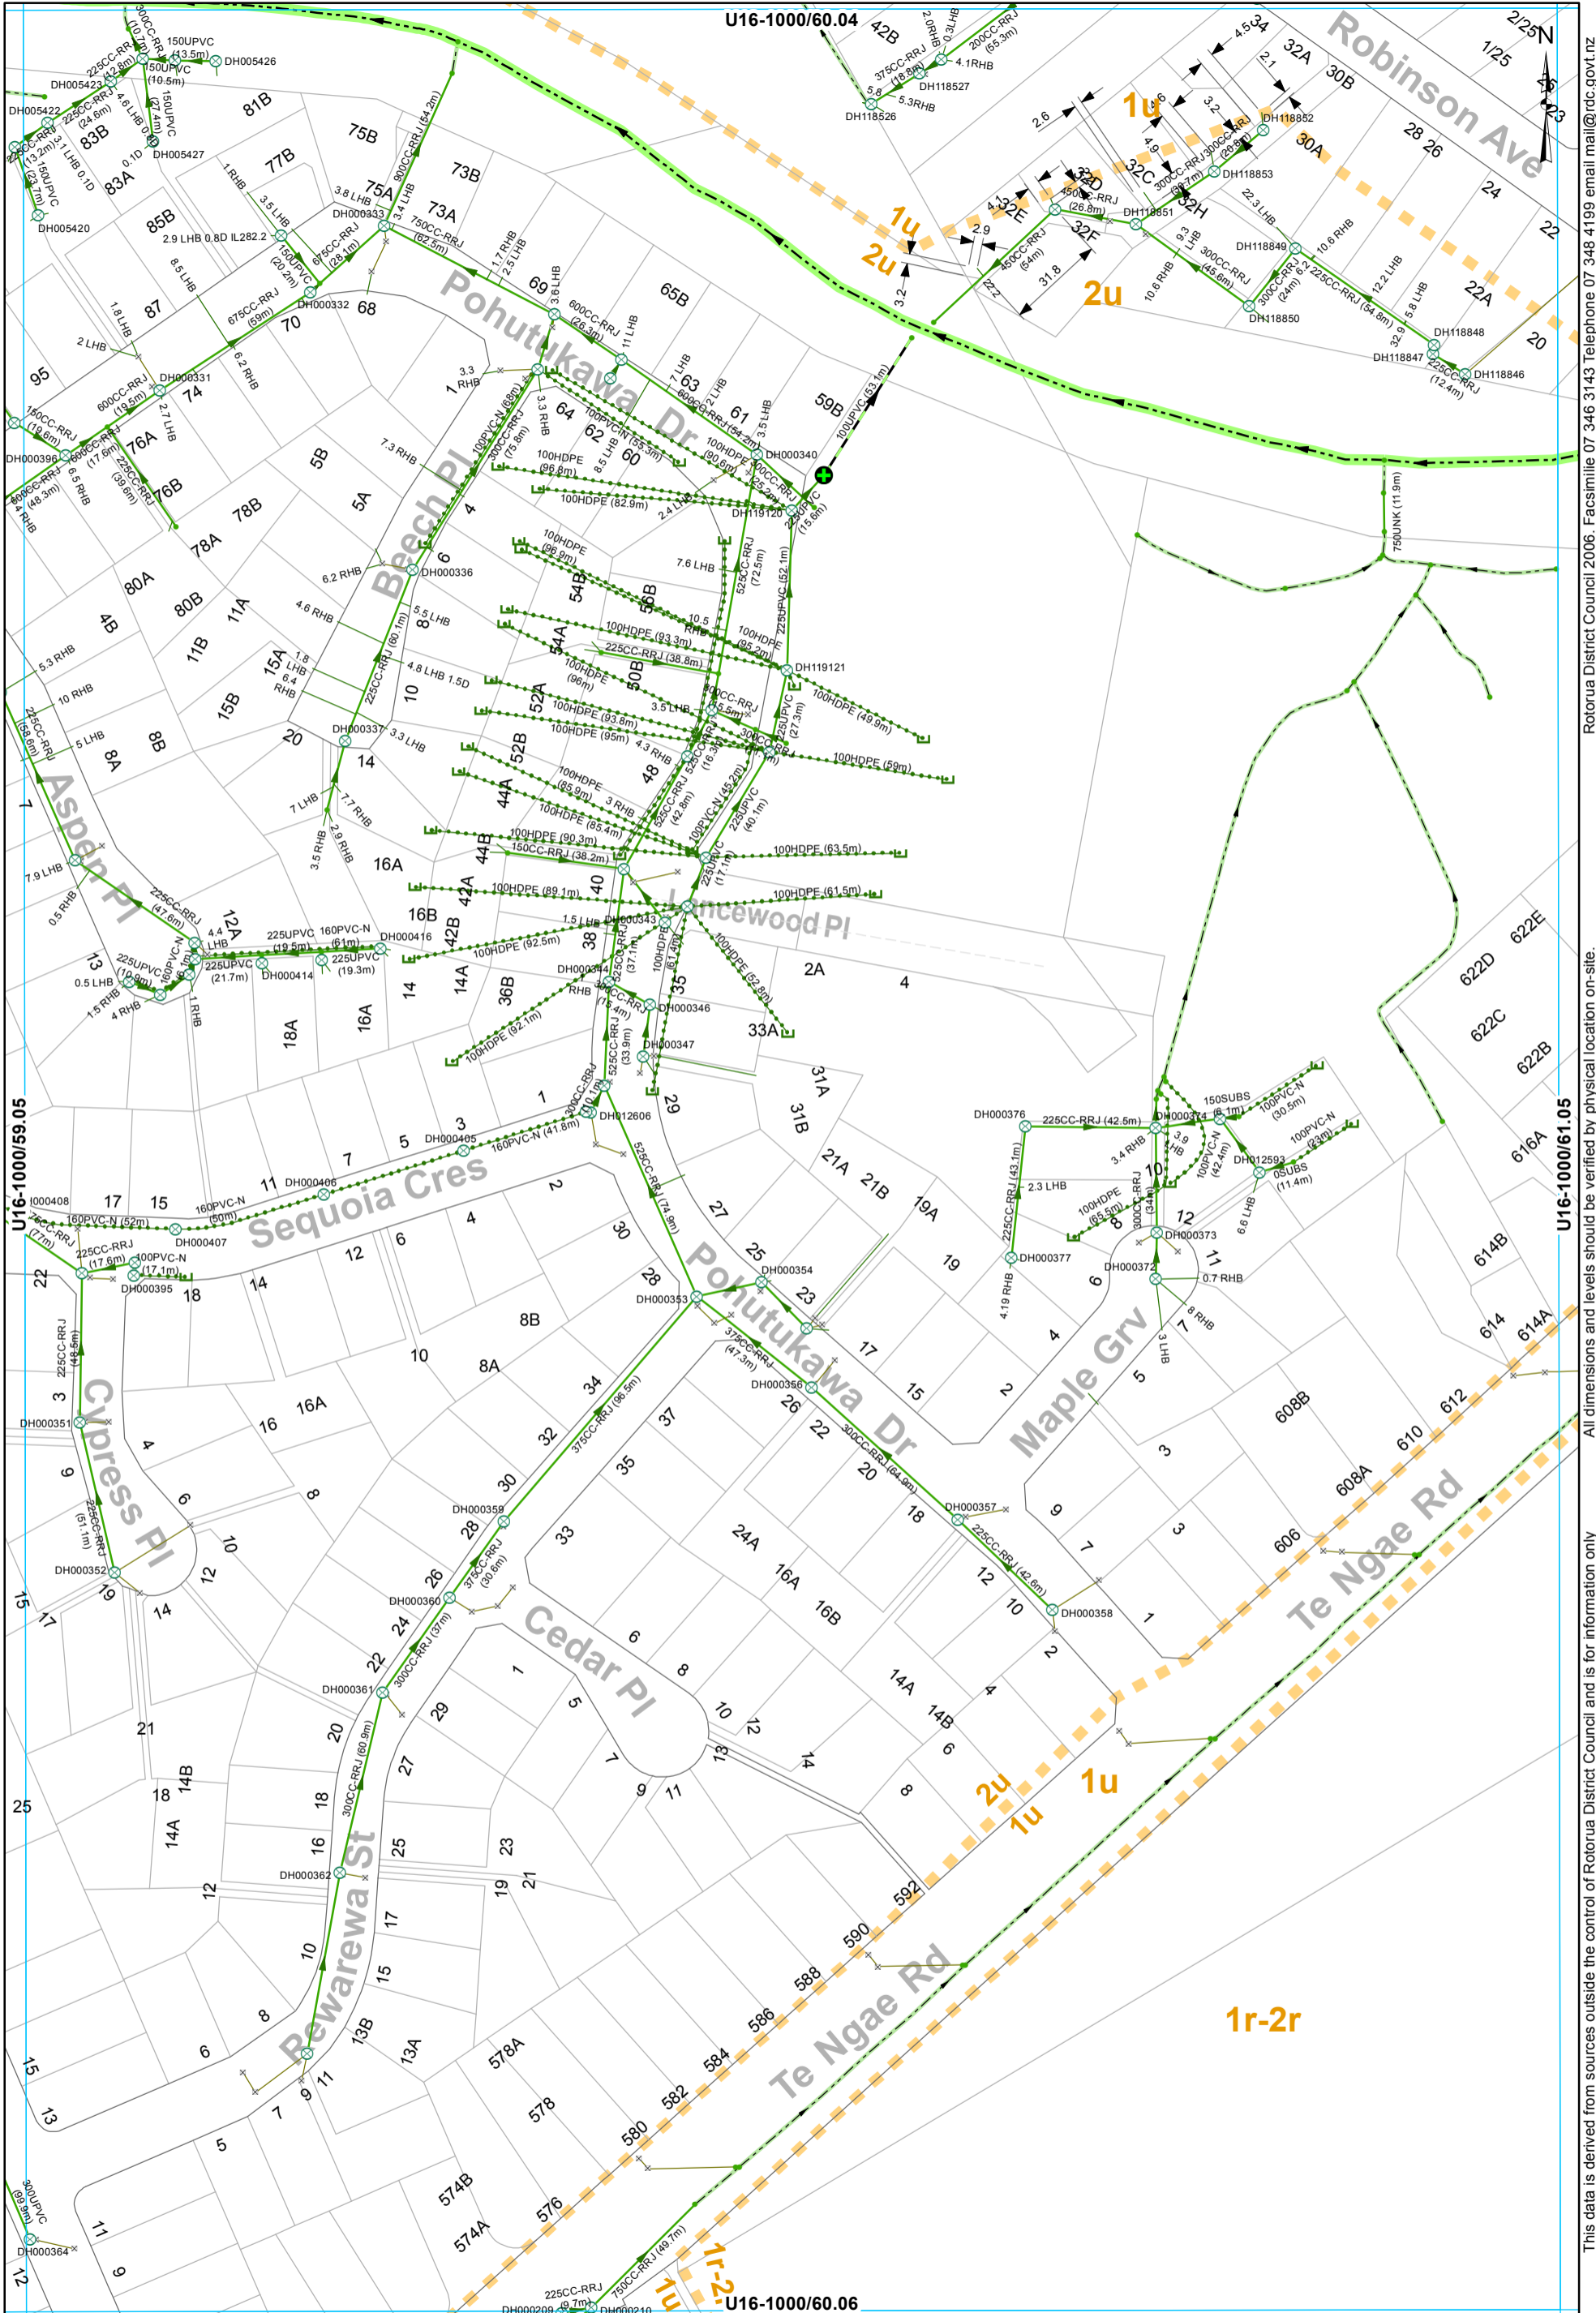


- SWManhole
- SWPumpStation
- SWInlet
- Node
- Capped End
- Open Drain
- Stream
- Culvert
- Gravity Main
- Rising Main
- Subsoil Drain
- SWServiceline
- SWServiceline
- SWLead
- Catchment Boundary

STORMWATER SERVICES
1:2000 @ A3 - (U16-1000/60.05)

This data is derived from sources outside the control of Rotorua District Council and is for information only.


Rotorua District Council 2006. Facsimile 07 346 3143 Telephone 07 348 4199 email mail@rdc.govt.nz

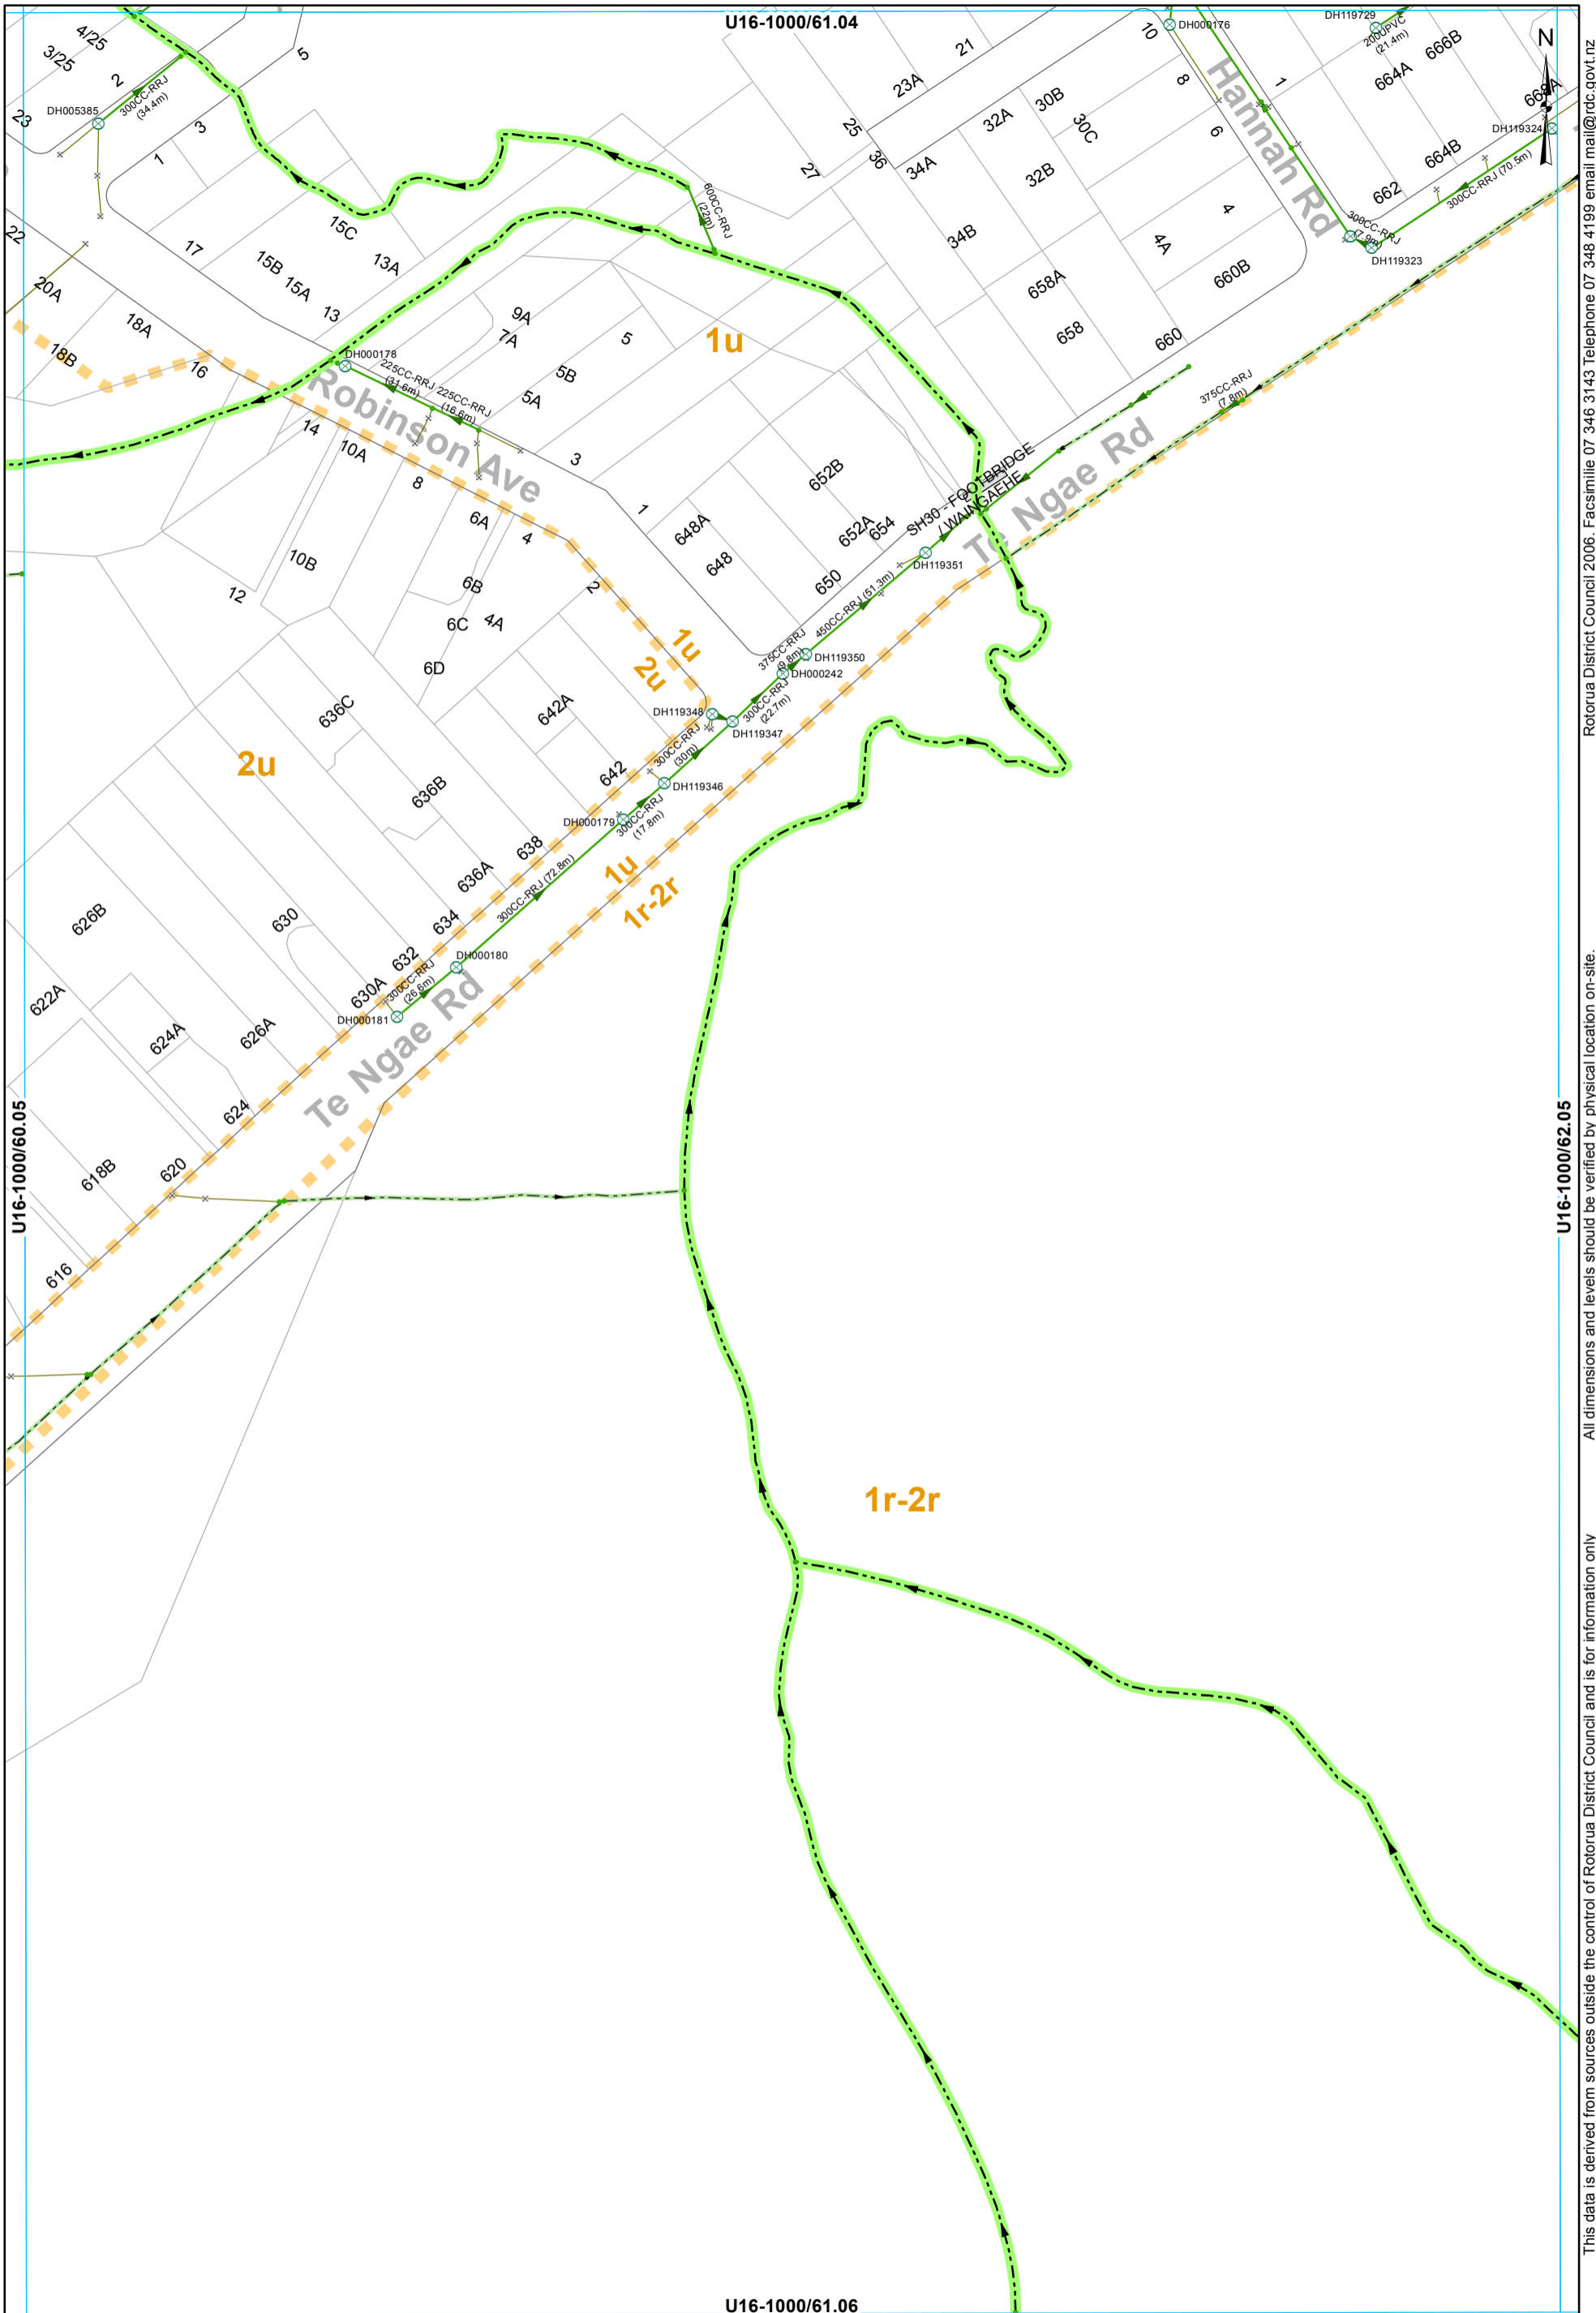

- ⊗ SWManhole
- × SWInlet
- Node
- Open Drain
- Stream
- Gravity Main
- SWServiceline
- SWServiceline
- SWLead
- ▭ Catchment Boundary

STORMWATER SERVICES
 1:2000 @ A3 - (U16-1000/61.05)

U16-1000/61.04
 U16-1000/60.05
 U16-1000/61.06
 Rotorua District Council 2006. Facsimile 07 346 3143 Telephone 07 348 4199 email mail@rdc.govt.nz
 All dimensions and levels should be verified by physical location on-site.
 This data is derived from sources outside the control of Rotorua District Council and is for information only

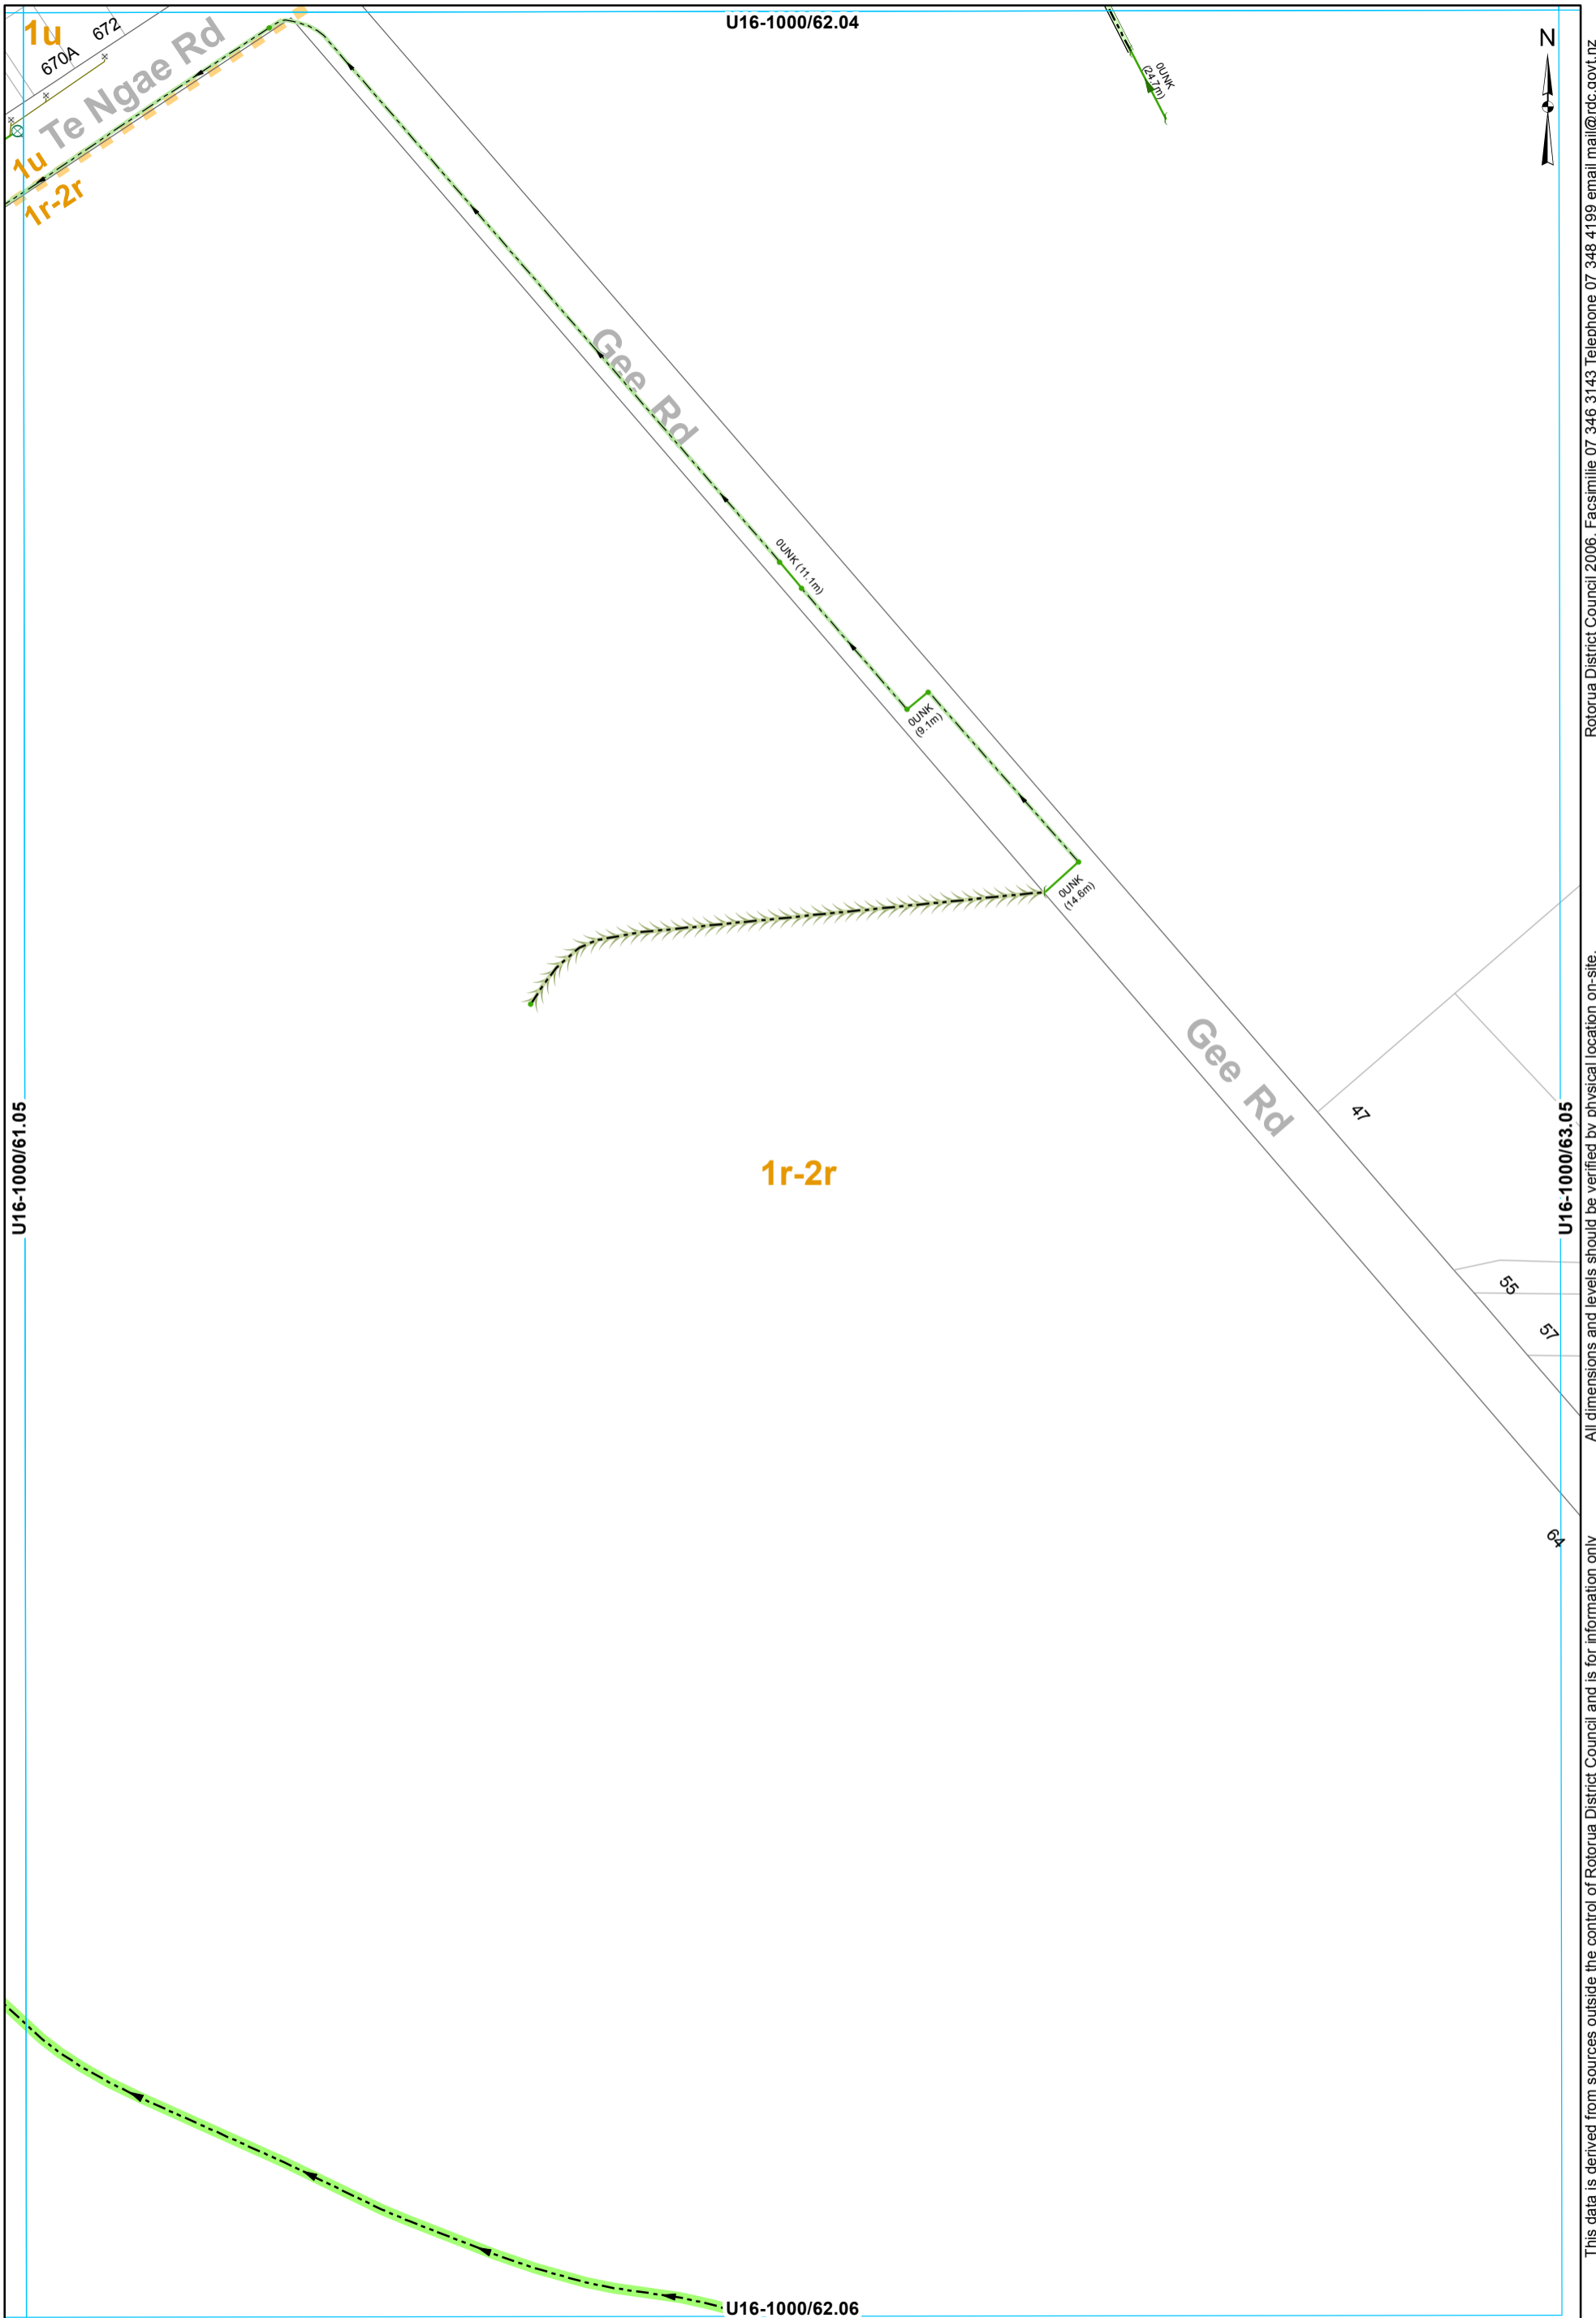


- ⊗ SWManhole
- × SWInlet
- Node
- Headwall Structure
- ▬ Lined Channel
- ▬ Open Drain
- ▬ Overland Flow
- ▬ Stream
- Culvert
- ▬ Gravity Main
- SWLead
- ▬ Catchment Boundary

STORMWATER SERVICES
1:2000 @ A3 - (U16-1000/62.05)

This data is derived from sources outside the control of Rotorua District Council and is for information only.

Rotorua District Council 2006. Facsimile 07 346 3143 Telephone 07 348 4199 email mail@rdc.govt.nz

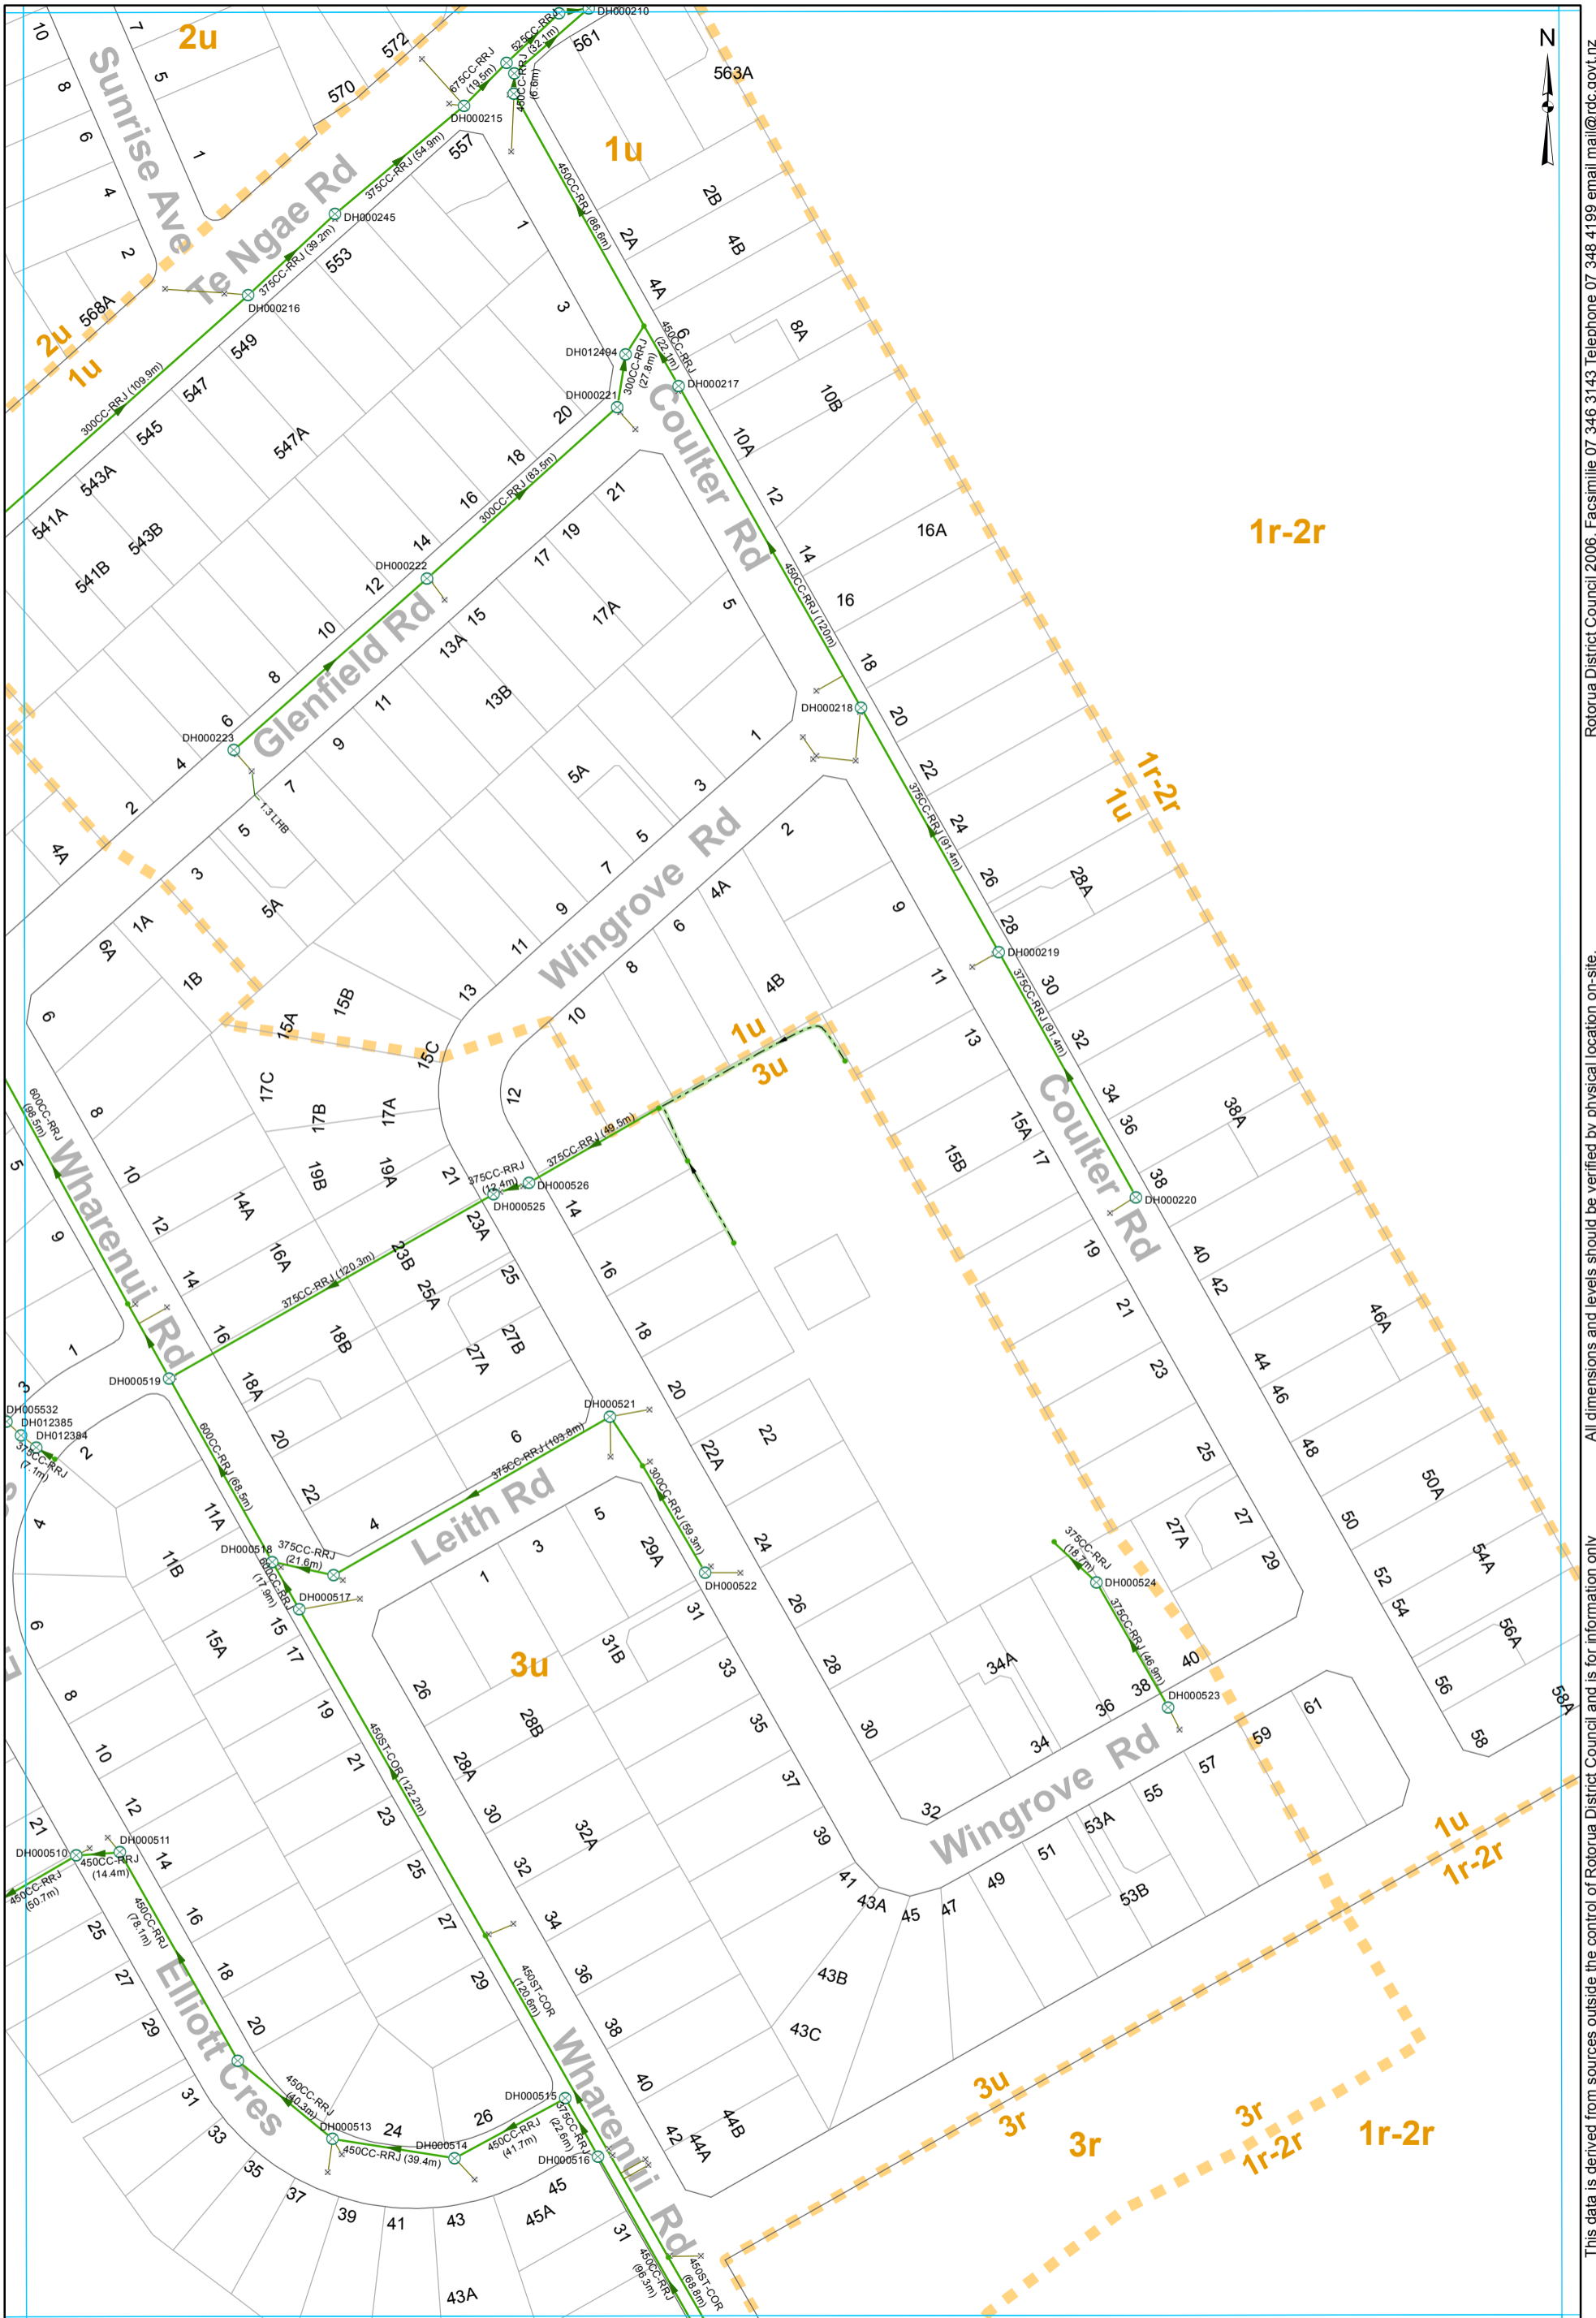


- ⊗ SWManhole
- × SWInlet
- Node
- Open Drain
- Gravity Main
- SWServiceline
- SWServiceline
- SWLead
- - - Catchment Boundary

STORMWATER SERVICES
1:2000 @ A3 - (U16-1000/60.06)

This data is derived from sources outside the control of Rotorua District Council and is for information only

All dimensions and levels should be verified by physical location on-site.

Rotorua District Council 2006. Facsimile 07 346 3143 Telephone 07 348 4199 email mail@rdc.govt.nz

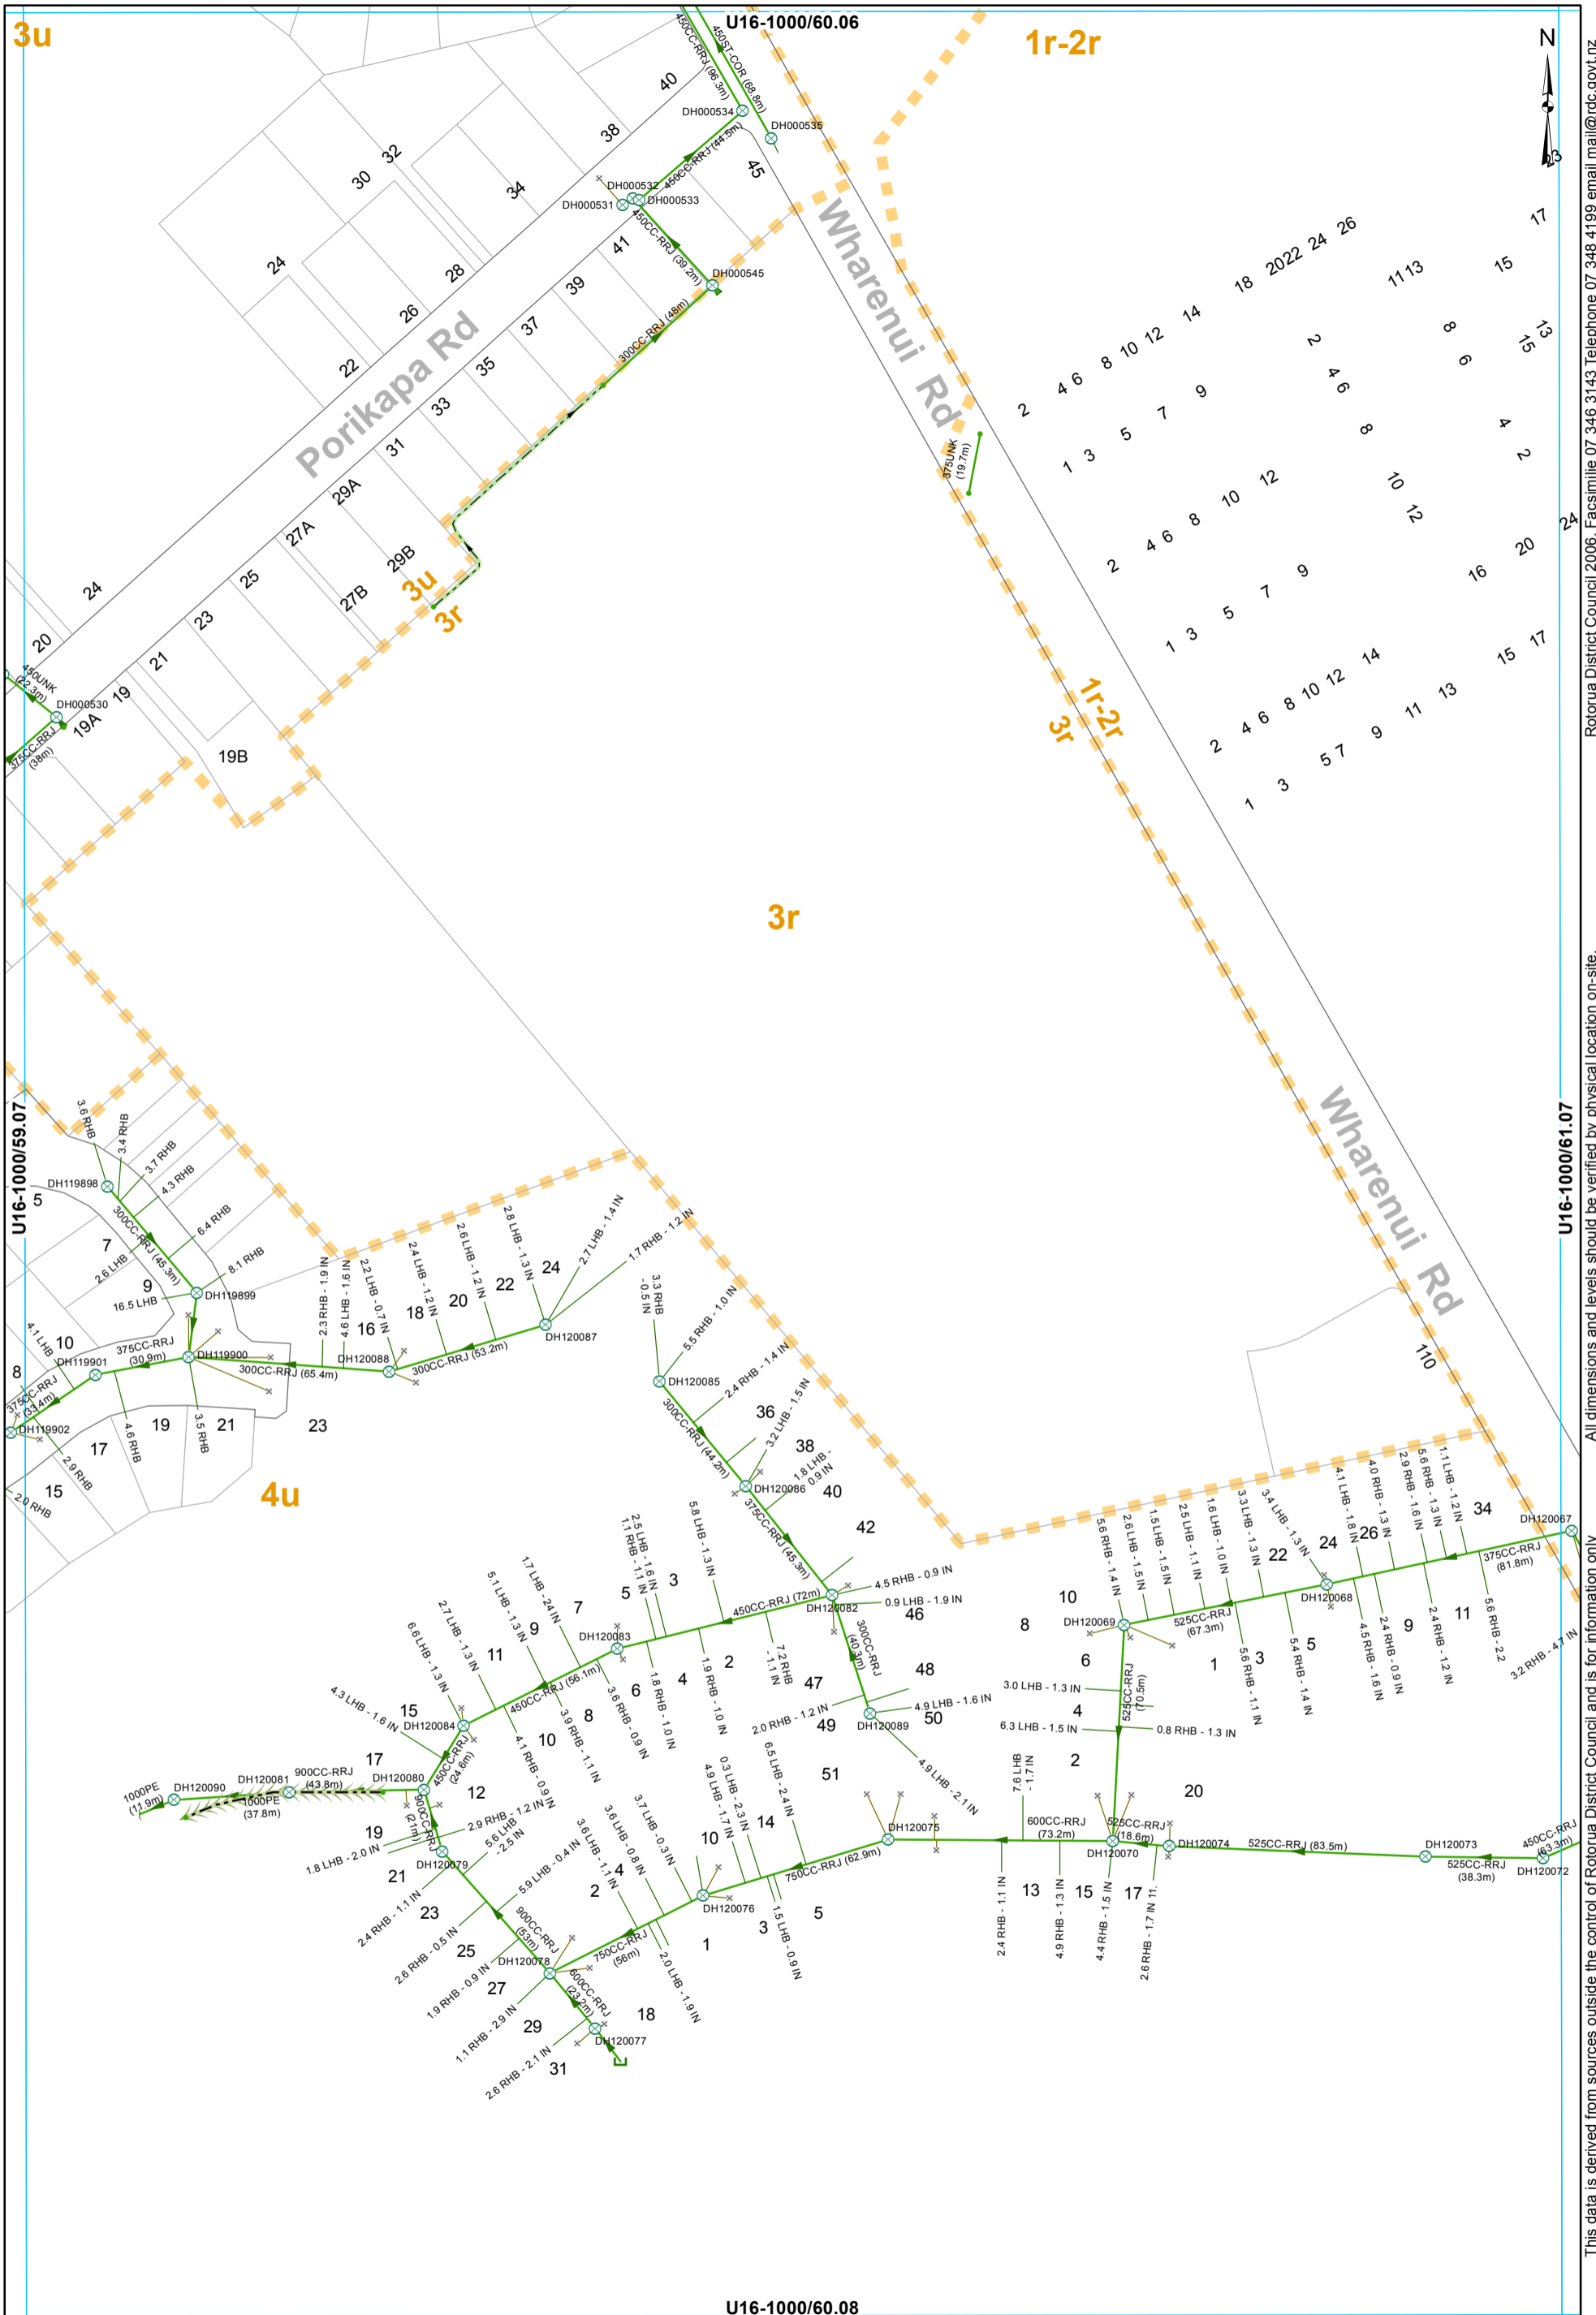

- ⊗ SWManhole
- × SWInlet
- Node
- ┌ Capped End
- └ Headwall Structure
- Open Drain
- Overland Flow
- Culvert
- Gravity Main
- SWServiceline
- SWServiceline
- SWLead
- ▭ Catchment Boundary

STORMWATER SERVICES
1:2000 @ A3 - (U16-1000/60.07)

This data is derived from sources outside the control of Rotorua District Council and is for information only.

Rotorua District Council 2006. Facsimile 07 346 3143 Telephone 07 348 4199 email mail@rdc.govt.nz

U16-1000/61.06




23
21
19
17
16
15
24
23
25
27
29
19

1r-2r

U16-1000/60.07

U16-1000/62.07

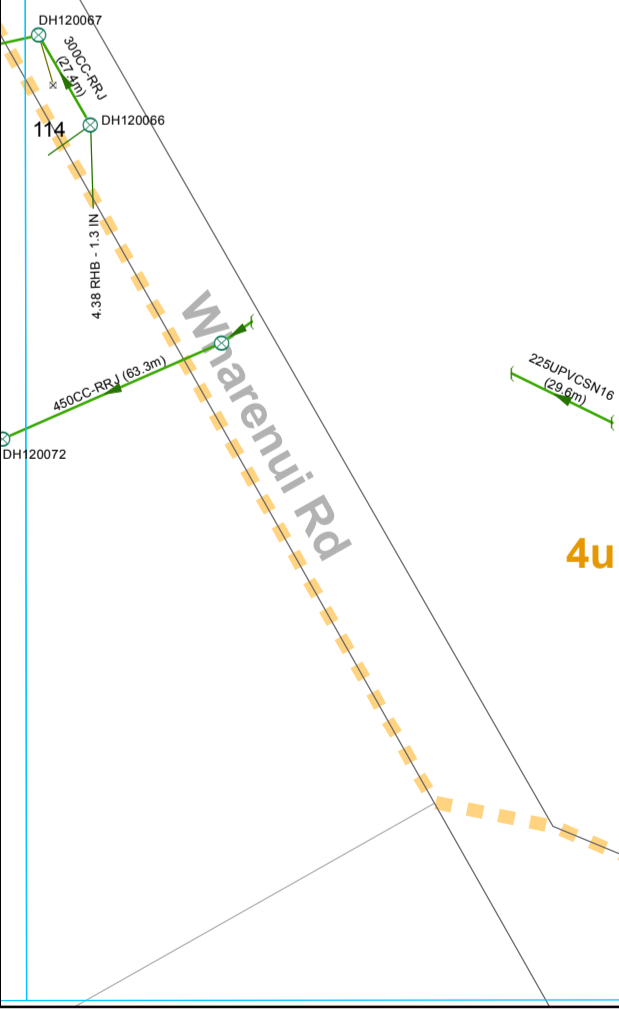

4u


1r-2r
U16-1000/61.08

- ⊗ SWManhole
- × SWInlet
- Headwall Structure
- Gravity Main
- SWServiceline
- SWServiceline
- SWLead
- Catchment Boundary

STORMWATER SERVICES
1:2000 @ A3 - (U16-1000/61.07)

This data is derived from sources outside the control of Rotorua District Council and is for information only

Rotorua District Council 2006. Facsimile 07 346 3143 Telephone 07 348 4199 email mail@rdc.govt.nz

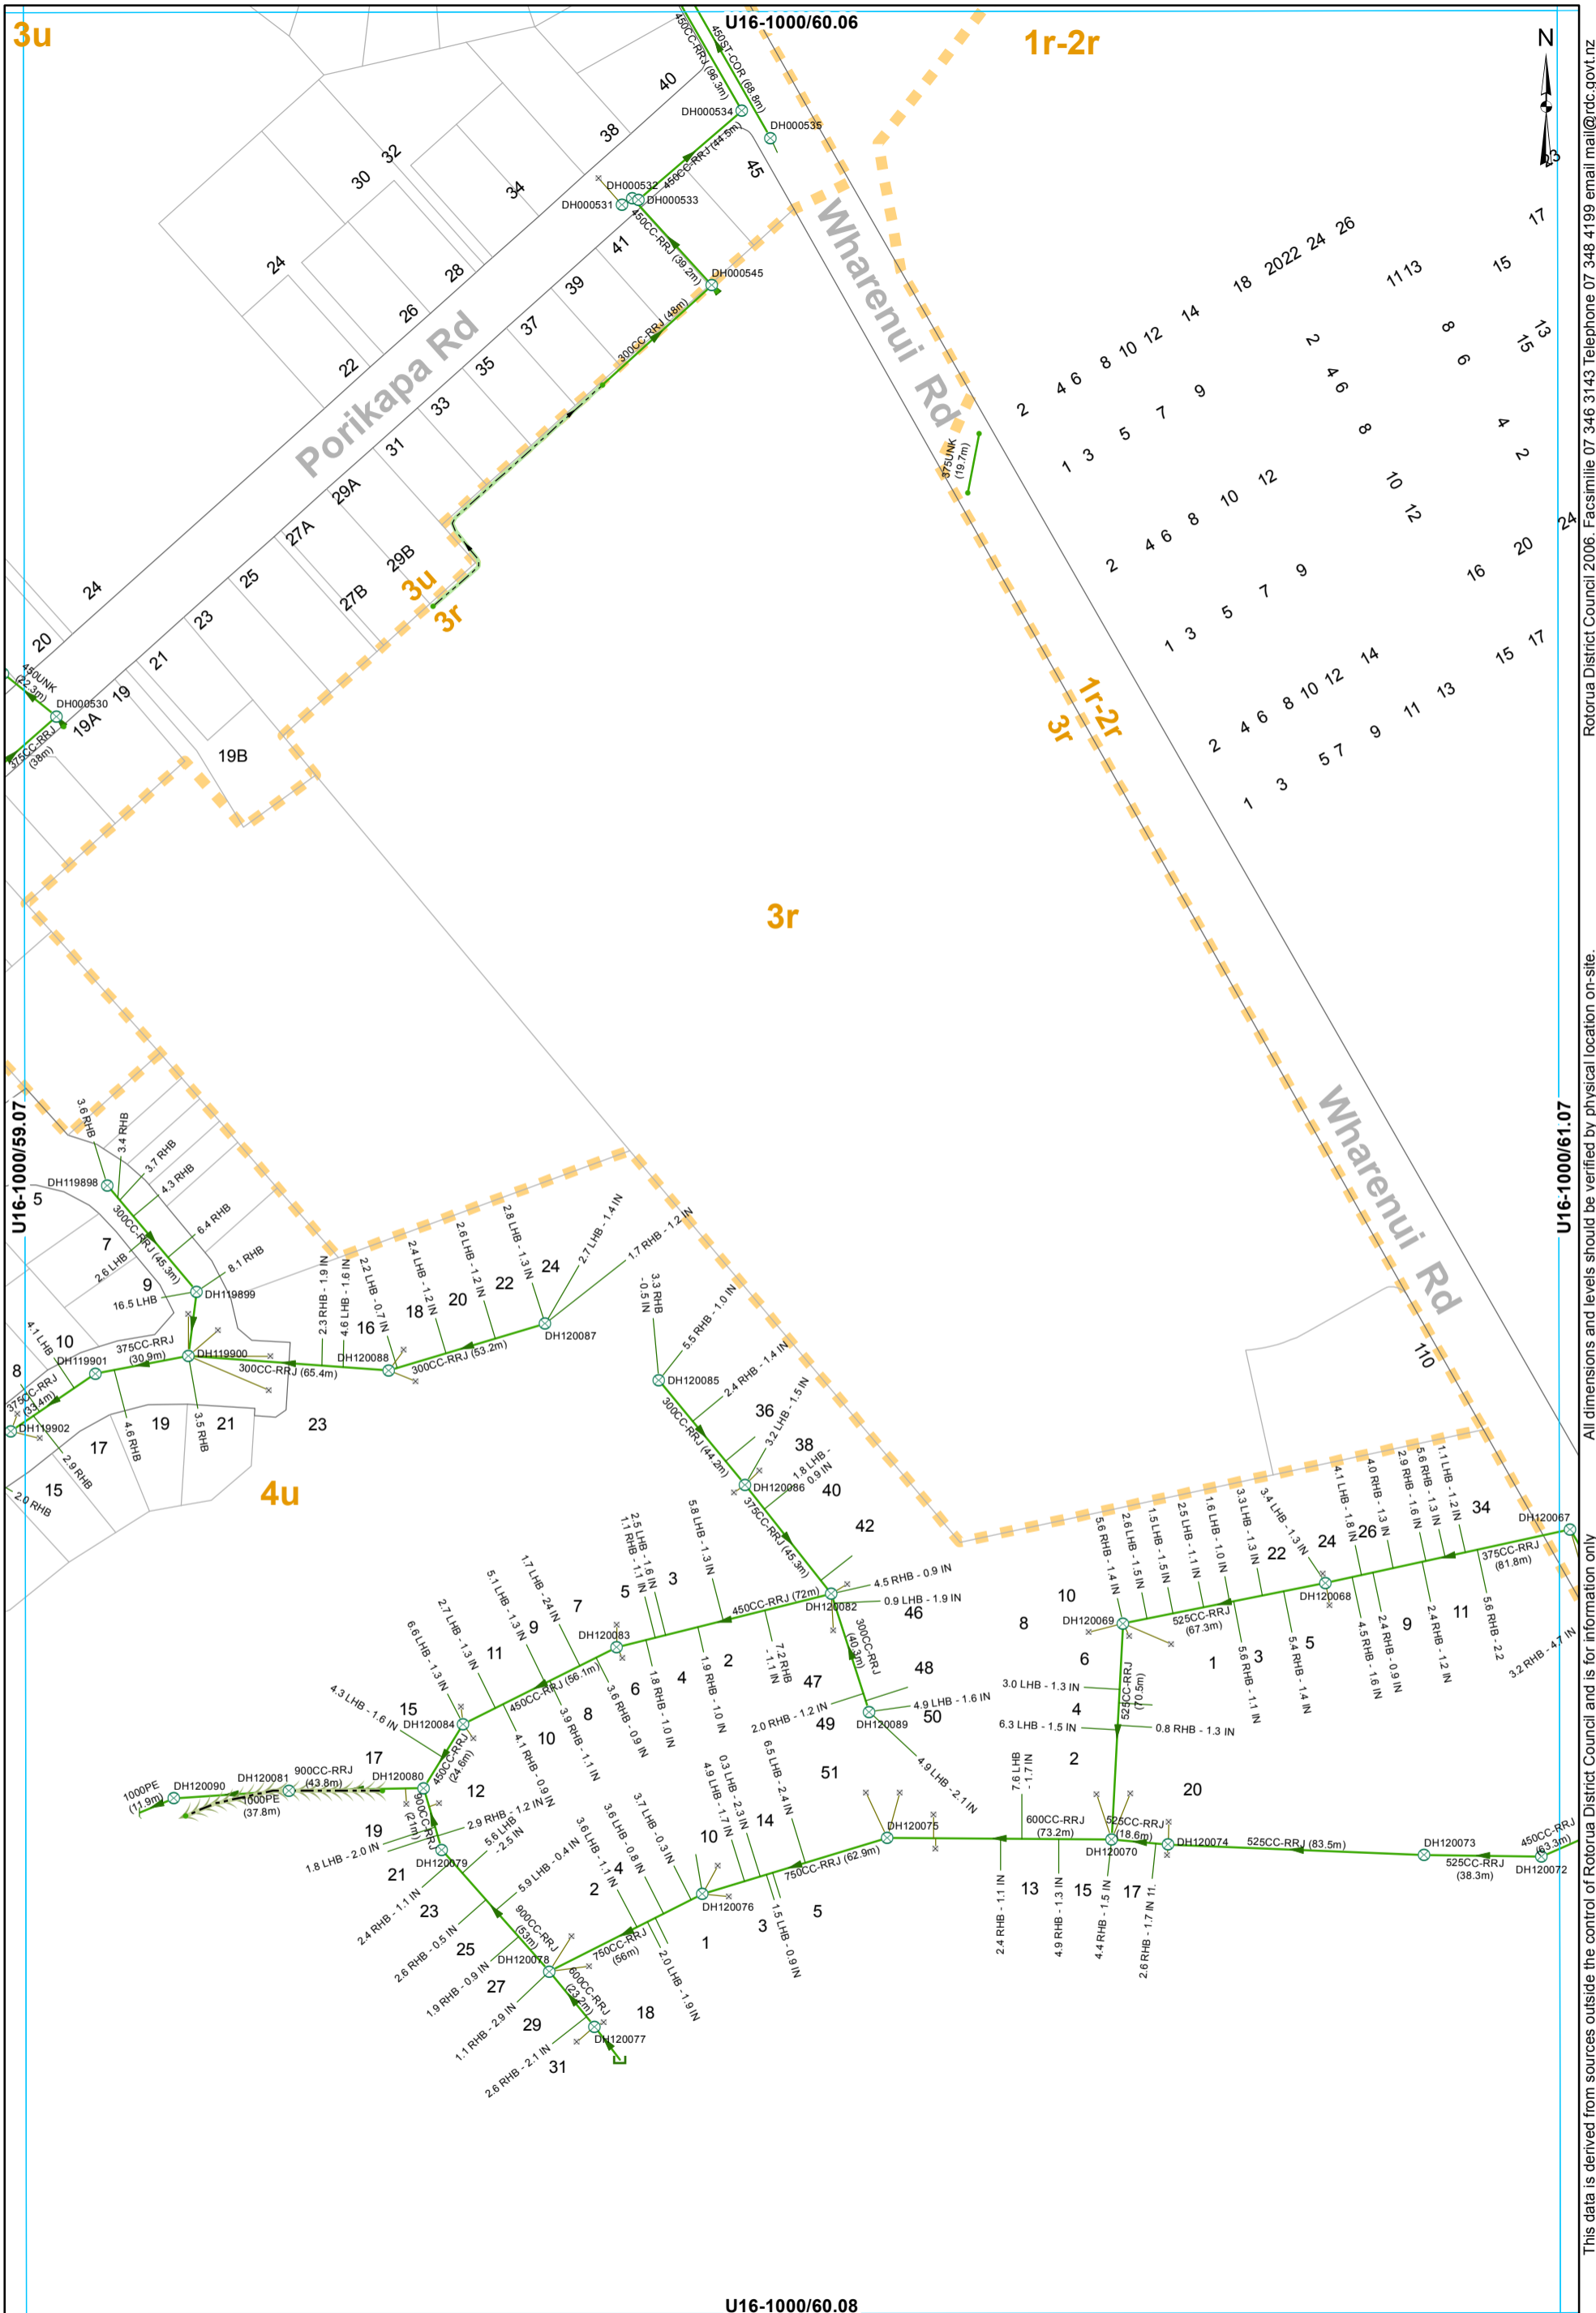

- ⊗ SWManhole
- × SWInlet
- Node
- ┌ Capped End
- └ Headwall Structure
- Open Drain
- Overland Flow
- Culvert
- Gravity Main
- SWServiceline
- SWServiceline
- SWLead
- Catchment Boundary

STORMWATER SERVICES
1:2000 @ A3 - (U16-1000/60.07)

All dimensions and levels outside the control of Rotorua District Council and is for information only.

Rotorua District Council 2006. Facsimile 07 346 3143 Telephone 07 348 4199 email mail@rdc.govt.nz

U16-1000/61.06



23
21
19
17
16
15
14
13
12
24
23
25
27
29
19

1r-2r

U16-1000/60.07

U16-1000/62.07



4u

U16-1000/61.08

- ⊗ SWManhole
- × SWInlet
- Headwall Structure
- Gravity Main
- SWServiceLine
- SWLead
- Catchment Boundary

STORMWATER SERVICES
1:2000 @ A3 - (U16-1000/61.07)

This data is derived from sources outside the control of Rotorua District Council and is for information only

Rotorua District Council 2006. Facsimile 07 346 3143 Telephone 07 348 4199 email mail@rdc.govt.nz