


Storm Water Asbuilt Sheet Index  
SW Catchment 21r



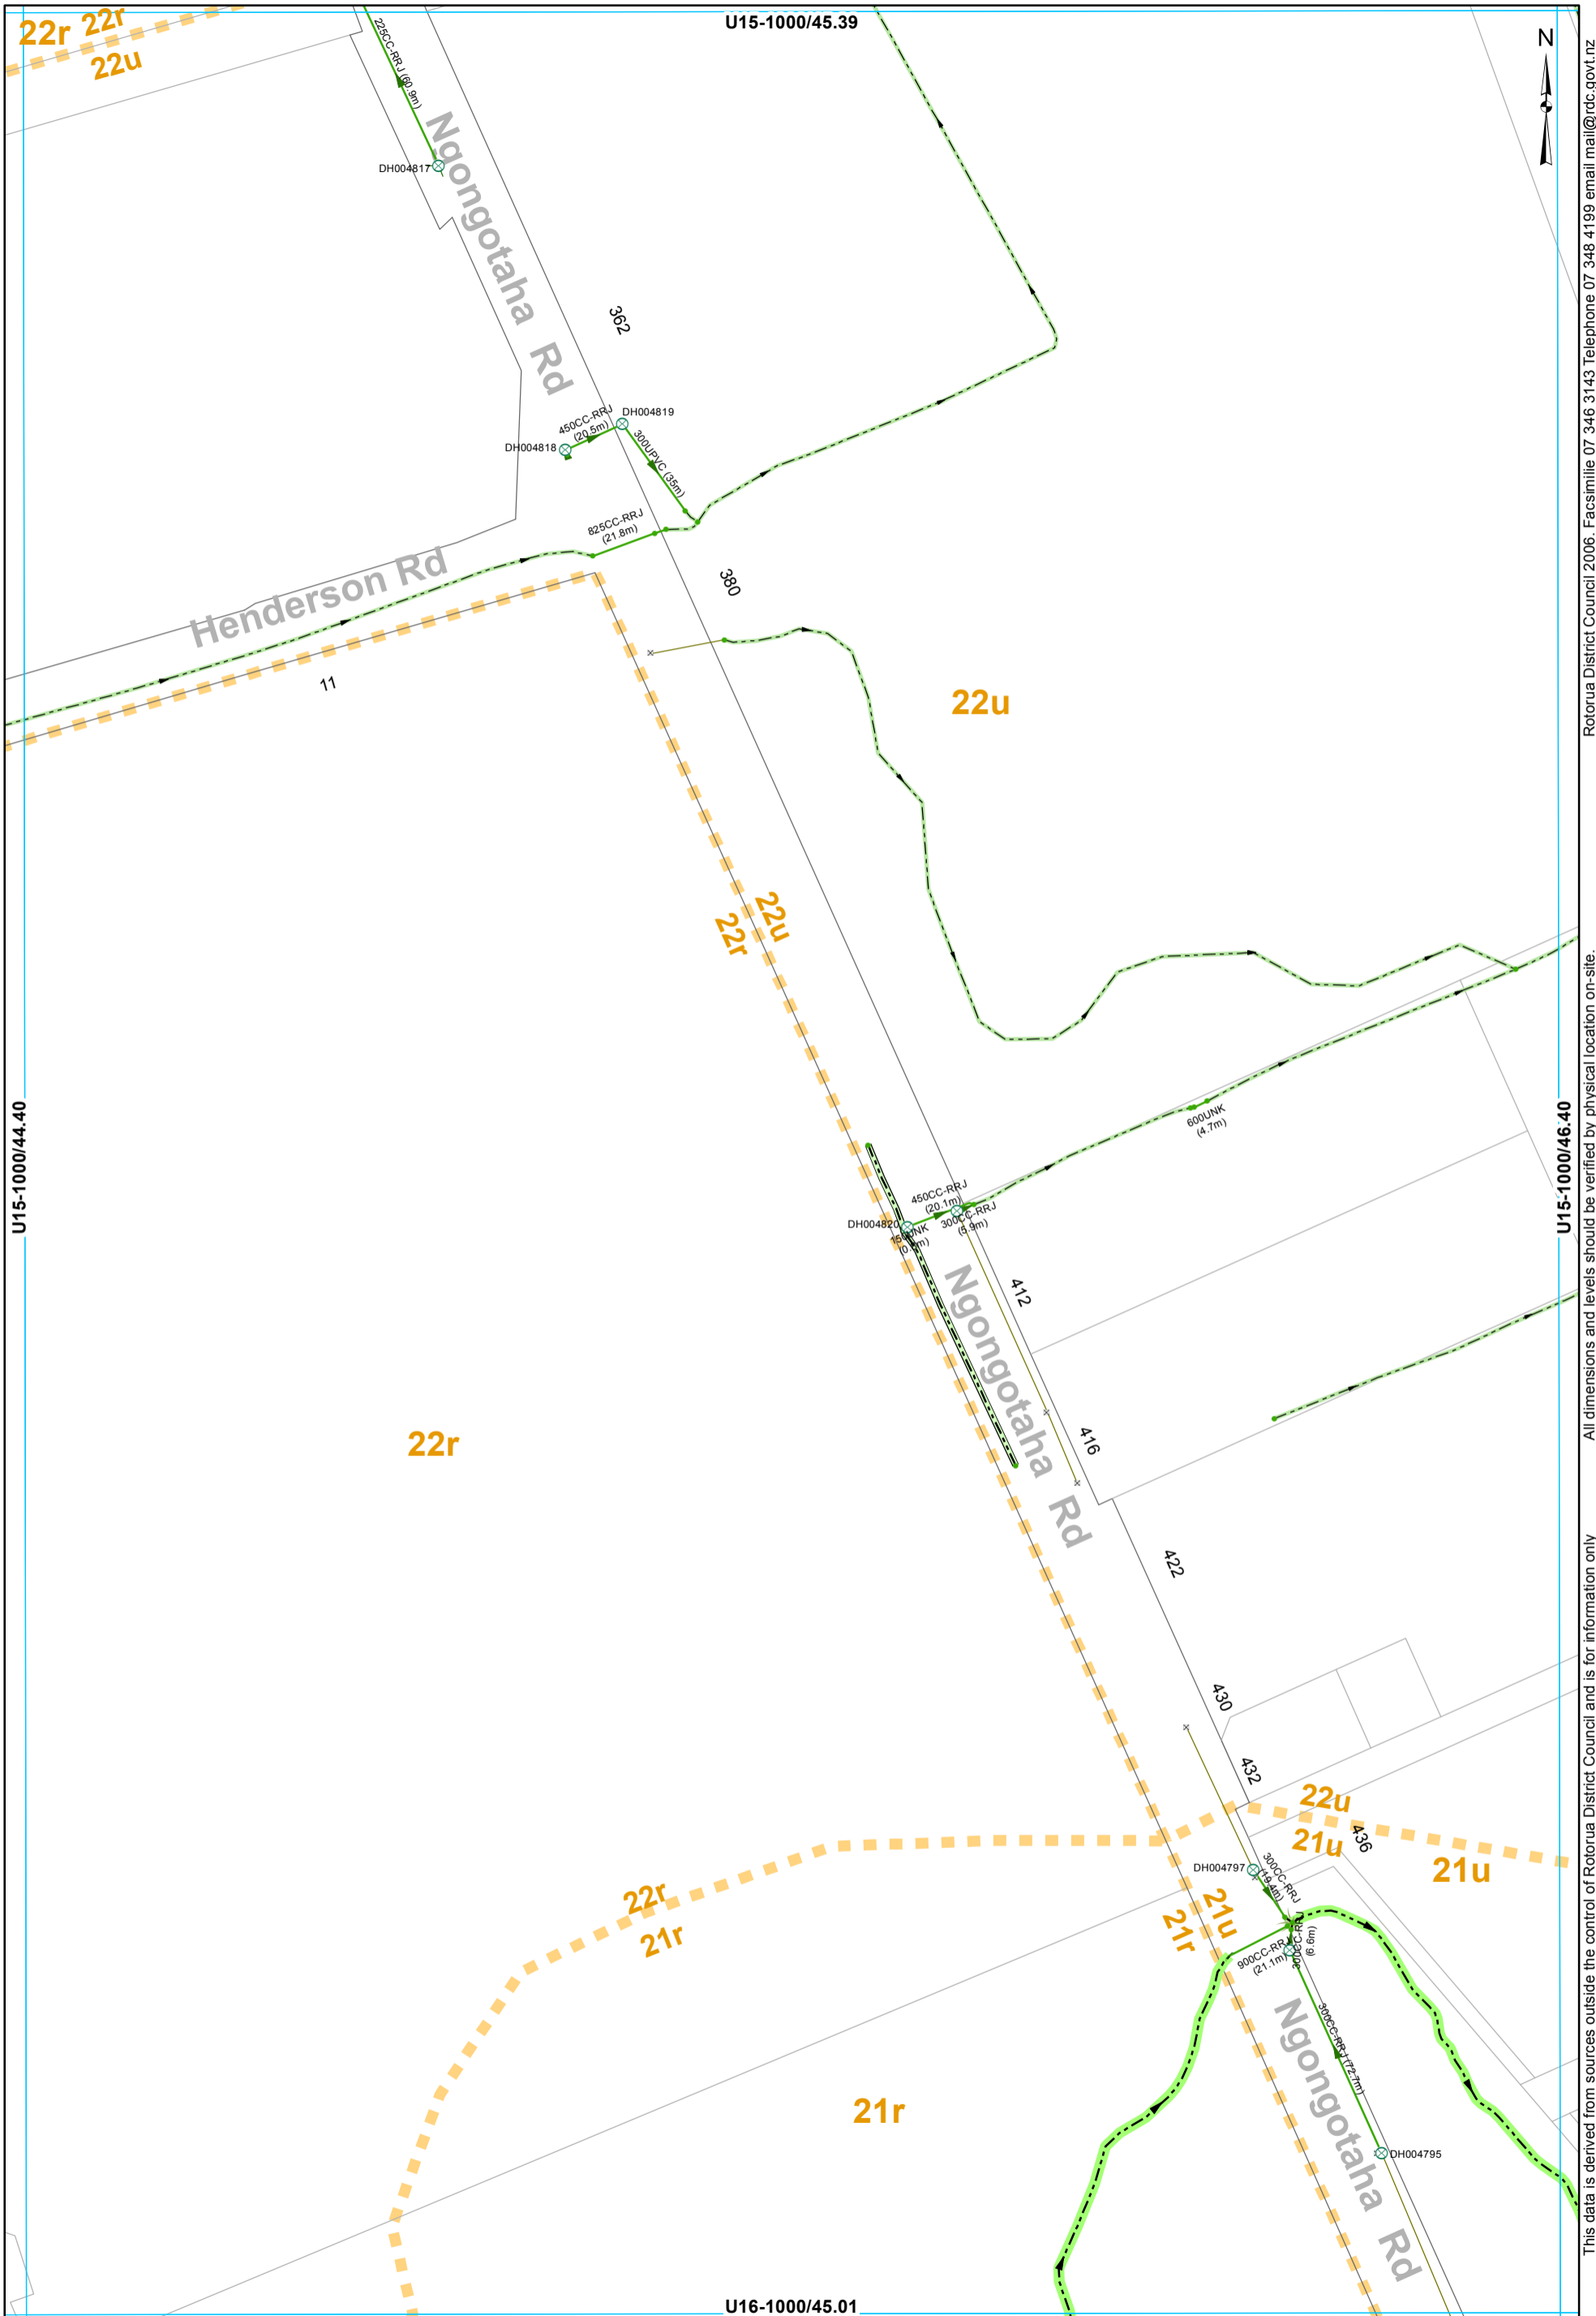


- ⊗ SWManhole
- × SWInlet
- Node
- Headwall Structure
- Lined Channel
- Open Drain
- Overland Flow
- Stream
- Culvert
- Gravity Main
- SWServiceline
- SWServiceline
- SWLead
- Catchment Boundary

**STORMWATER SERVICES**  
**1:2000 @ A3 - (U15-1000/45.40)**

This data is derived from sources outside the control of Rotorua District Council and is for information only

All dimensions and levels should be verified by physical location on-site.

Rotorua District Council 2006. Facsimile 07 346 3143 Telephone 07 348 4199 email mail@rdc.govt.nz

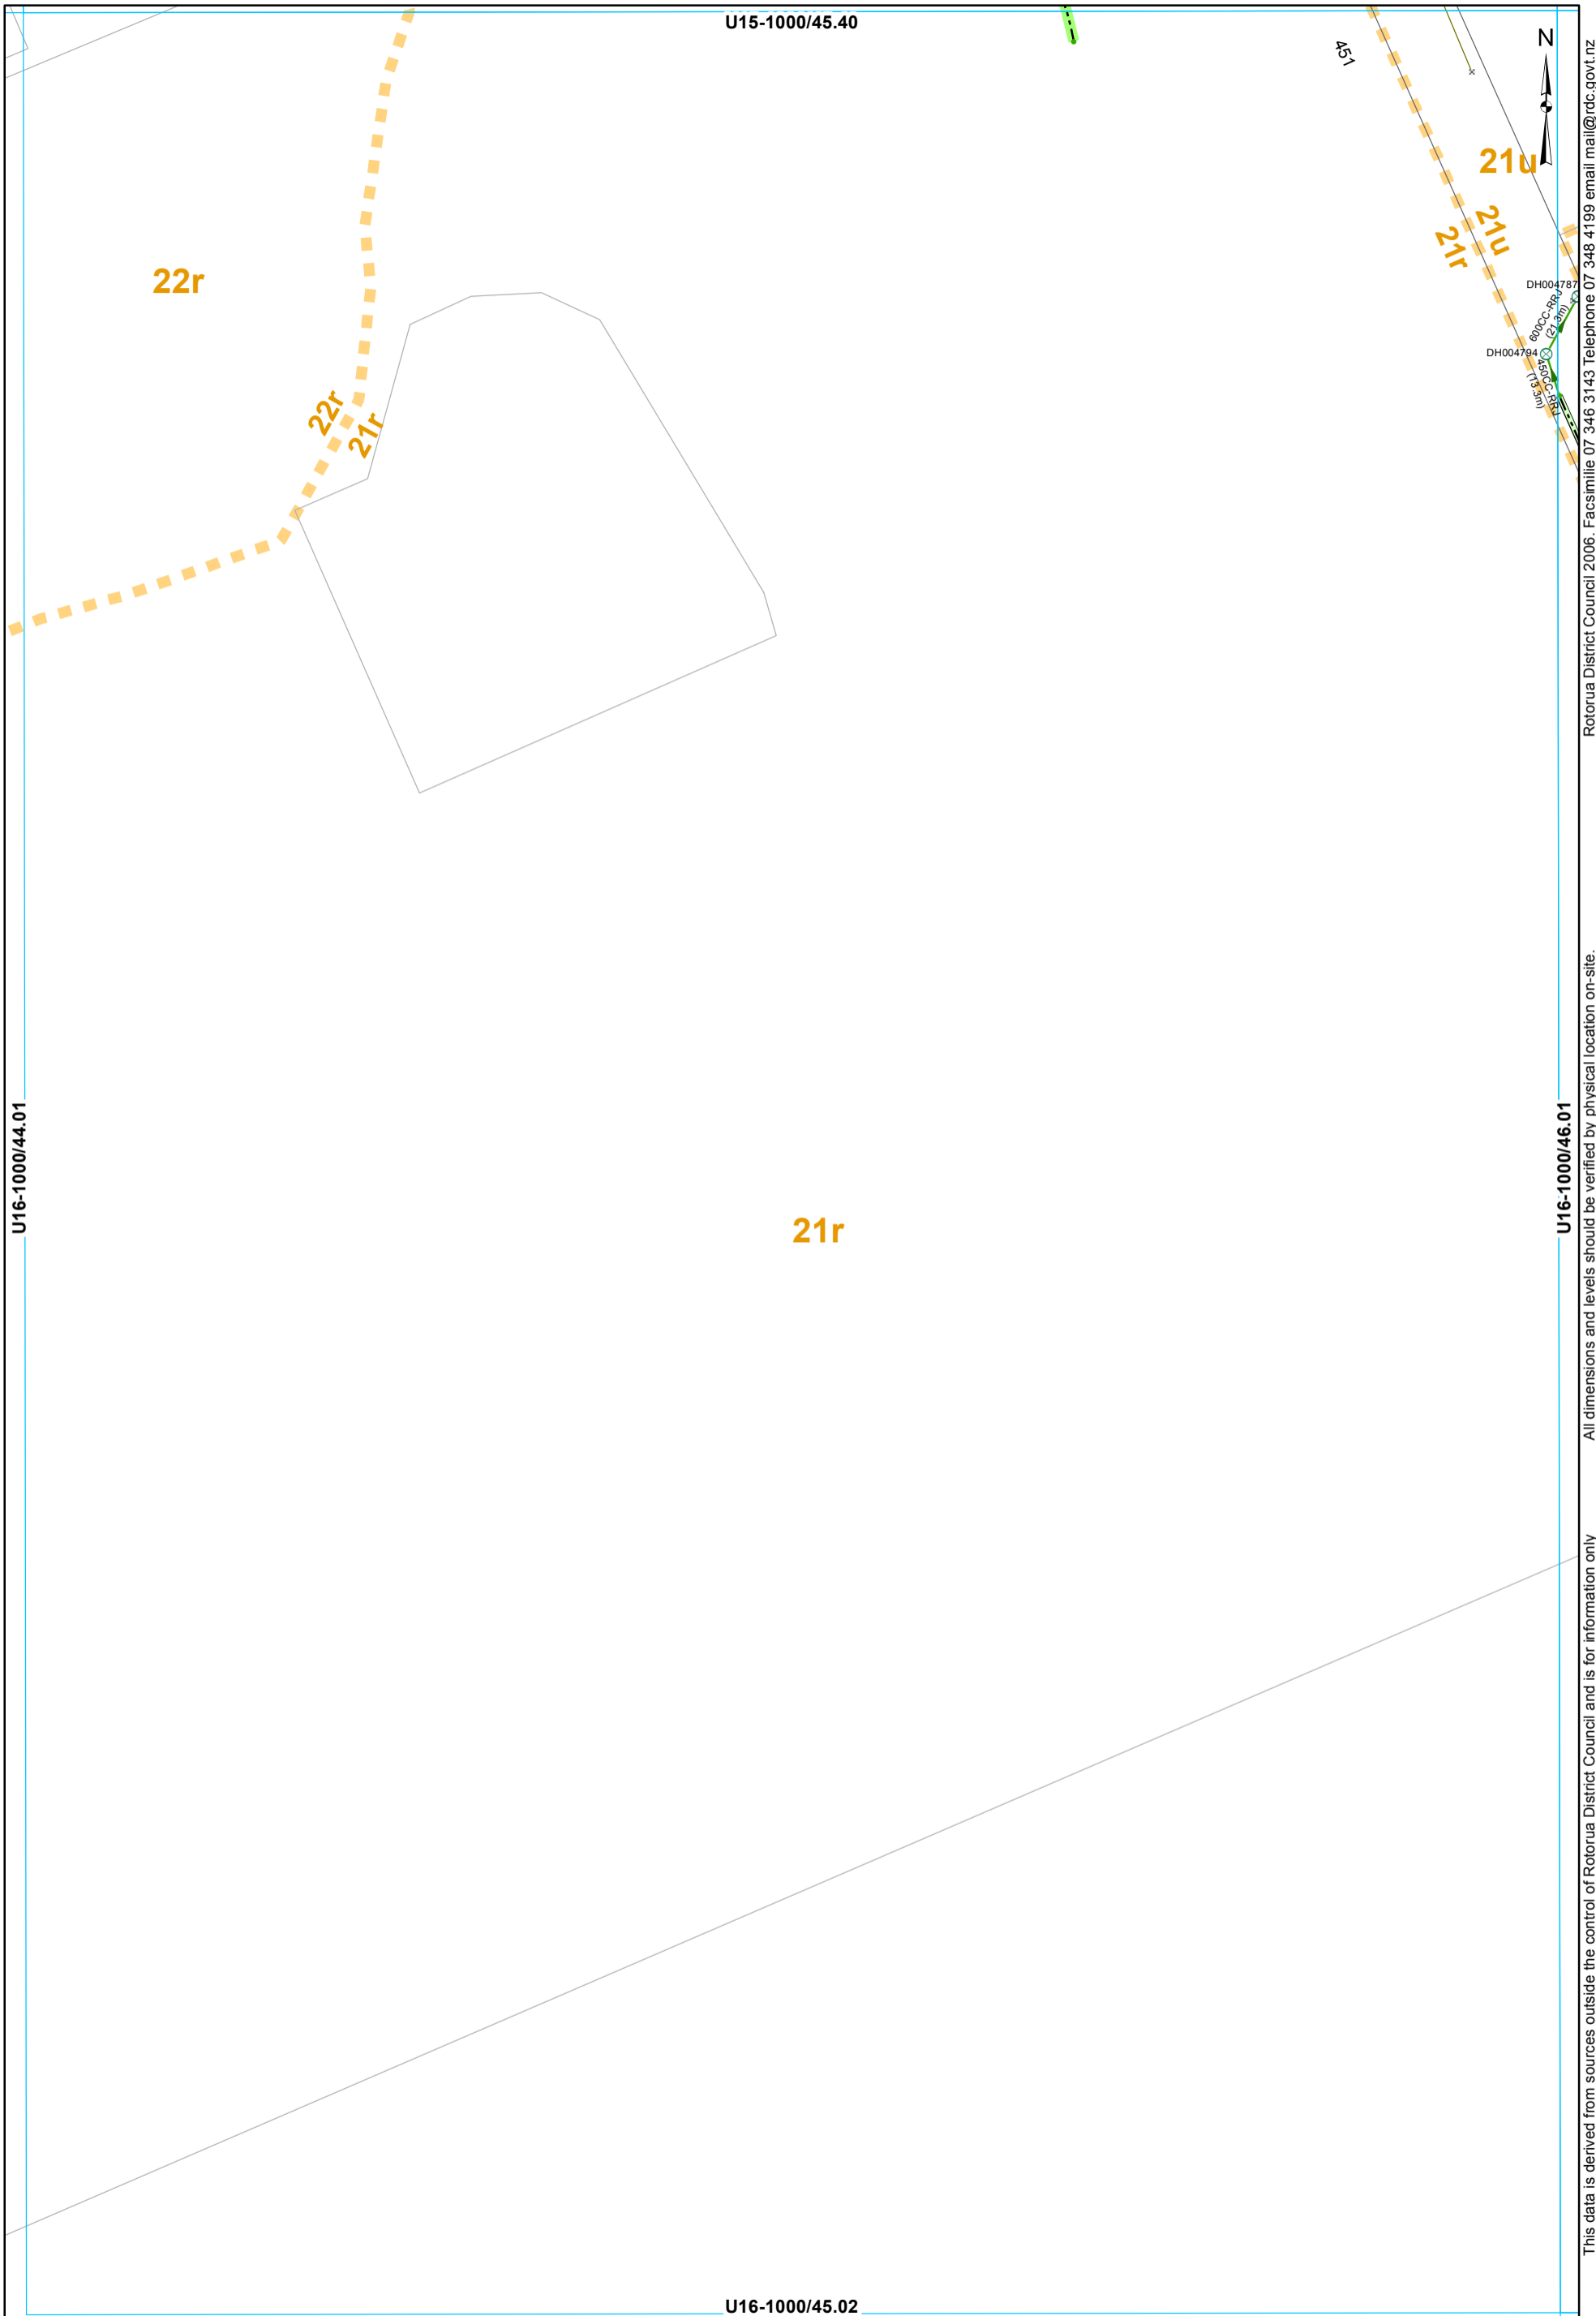


- ⊗ SWManhole
- × SWInlet
- Node
- == Lined Channel
- Stream
- Gravity Main
- SWLead
- Catchment Boundary

**STORMWATER SERVICES**  
 1:2000 @ A3 - (U16-1000/45.01)

This data is derived from sources outside the control of Rotorua District Council and is for information only. All dimensions and levels should be verified by physical location on-site.


Rotorua District Council 2006. Facsimile 07 346 3143 Telephone 07 348 4199 email mail@rdc.govt.nz

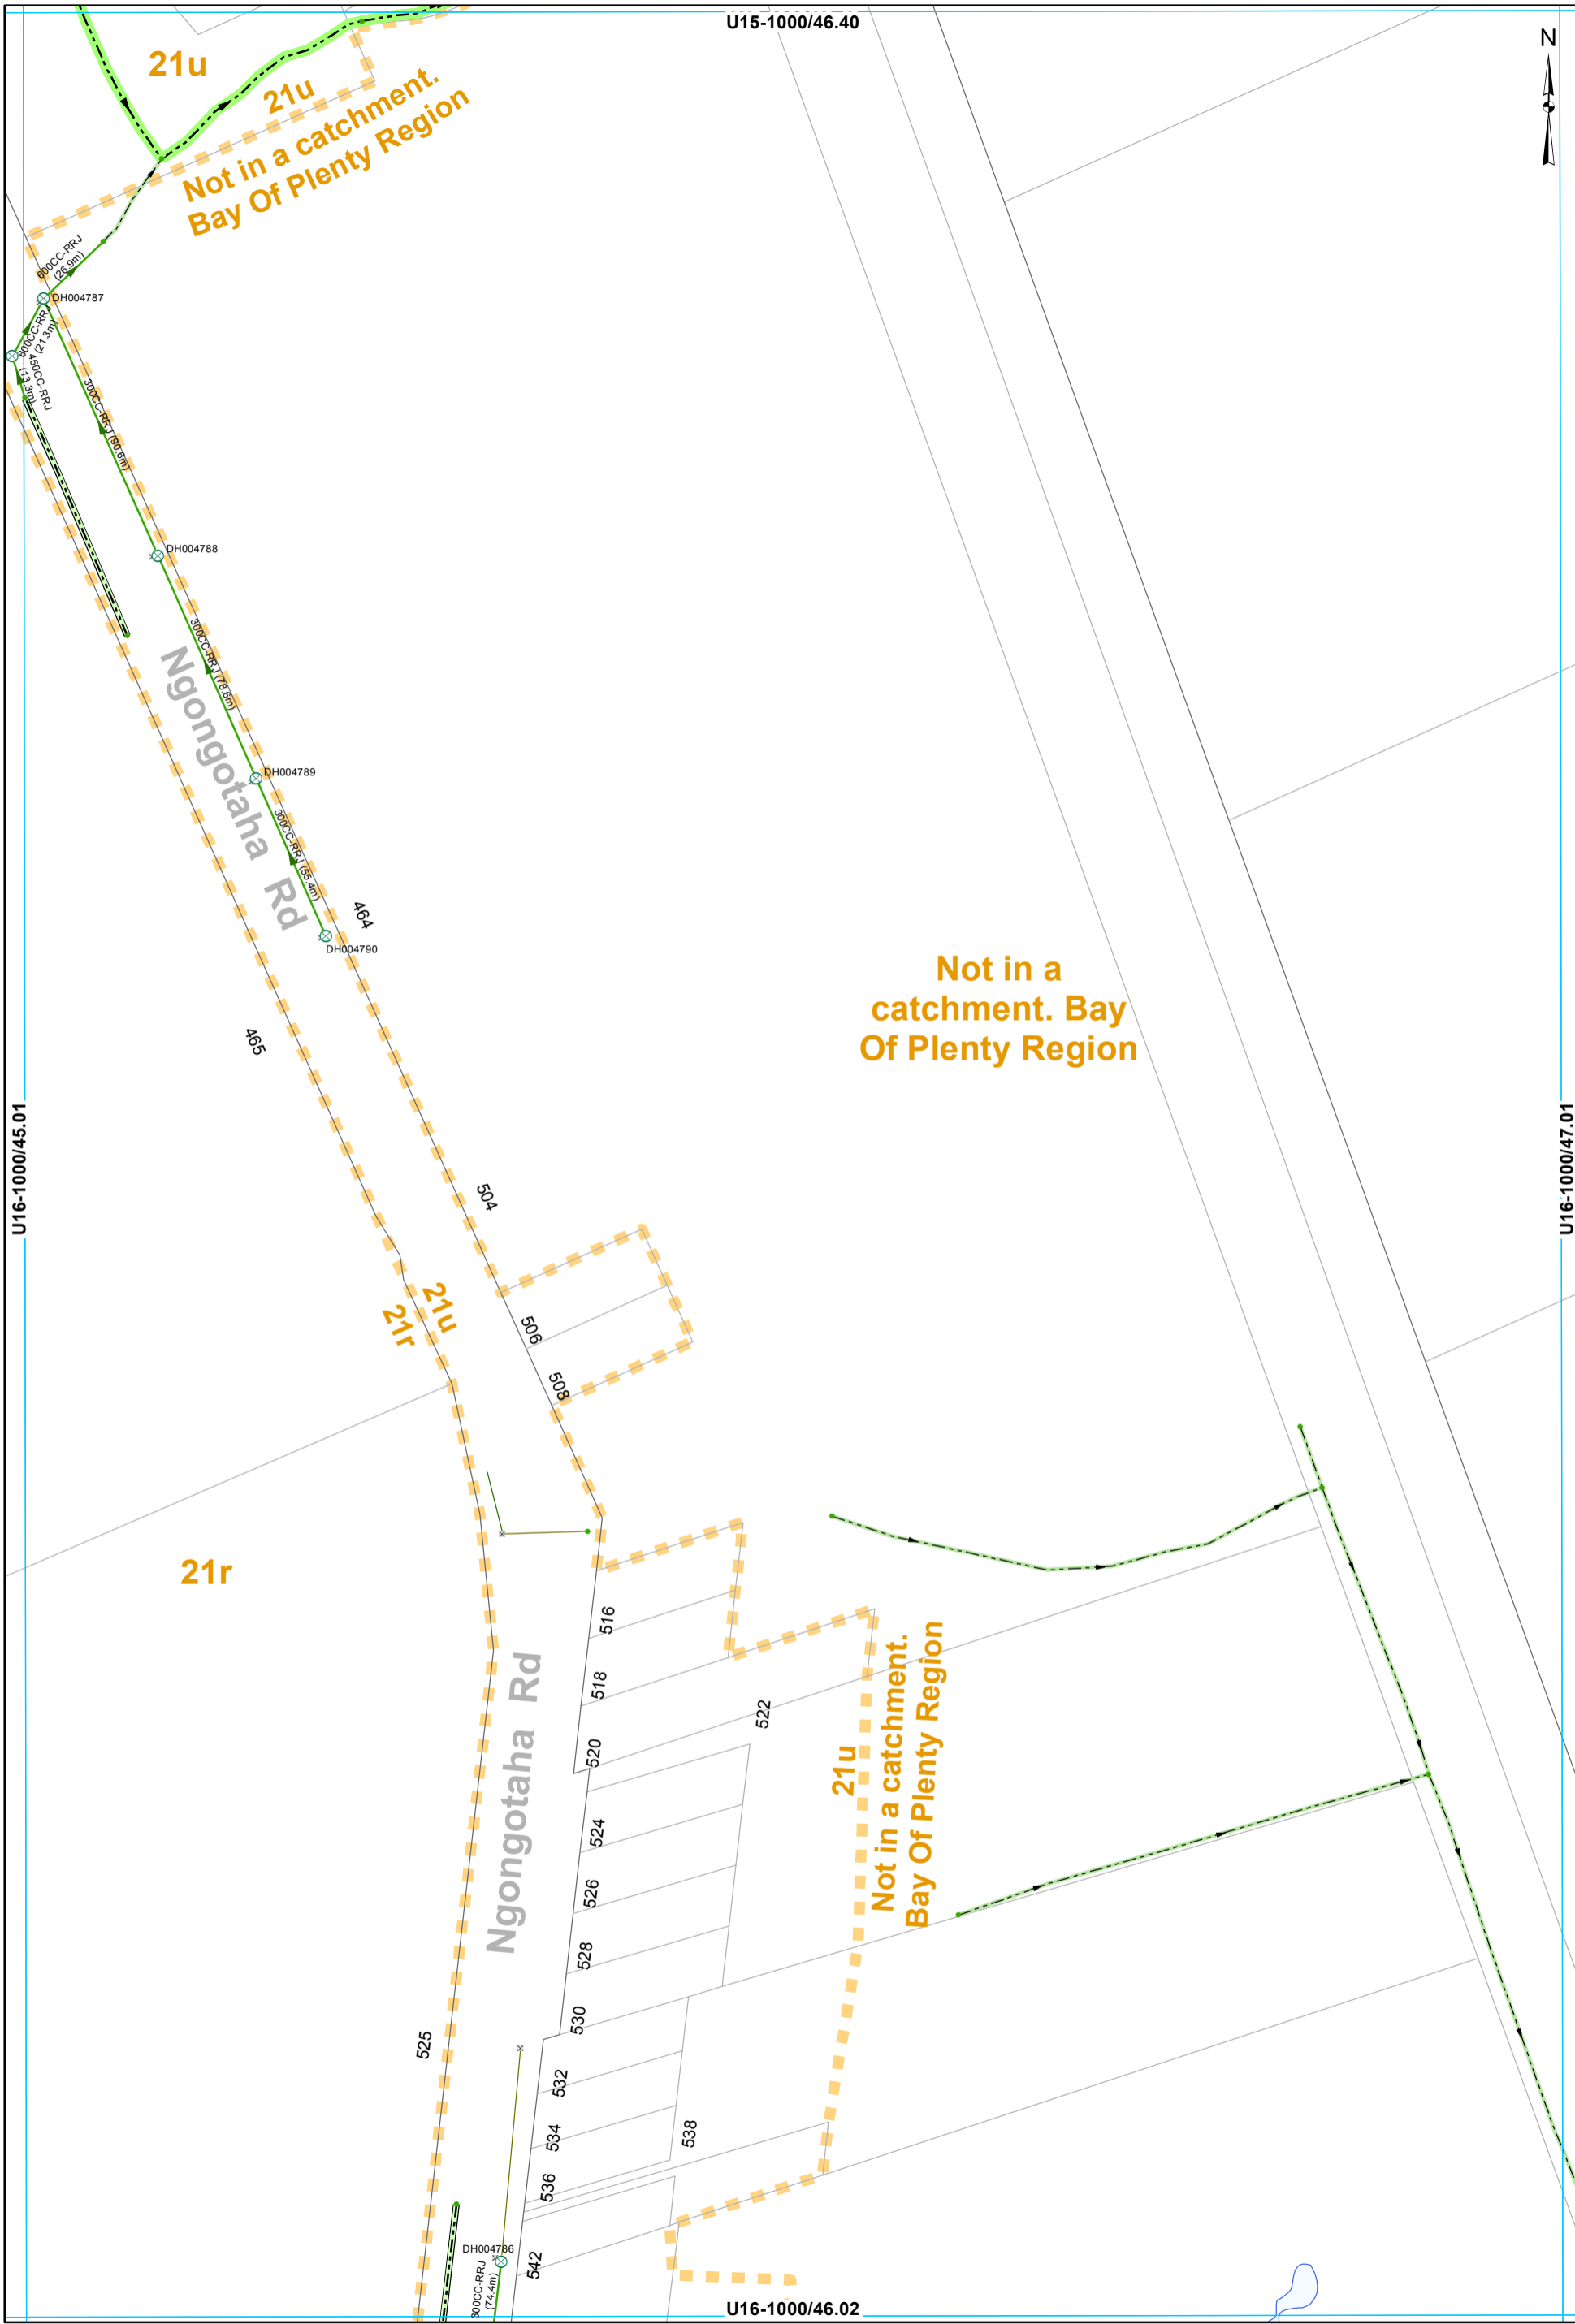

- ⊗ SWManhole
- × SWInlet
- Node
- ▬ Lined Channel
- ▬ Open Drain
- ▬ Stream
- ▬ Gravity Main
- ▬ SWServiceline
- ▬ SWServiceline
- ▬ SWLead
- ▬ Catchment Boundary

**STORMWATER SERVICES**  
1:2000 @ A3 - (U16-1000/46.01)

This data is derived from sources outside the control of Rotorua District Council and is for information only  
 All dimensions and levels should be verified by physical location on-site.  
 Rotorua District Council 2006. Facsimile 07 346 3143 Telephone 07 348 4199 email mail@rdc.govt.nz

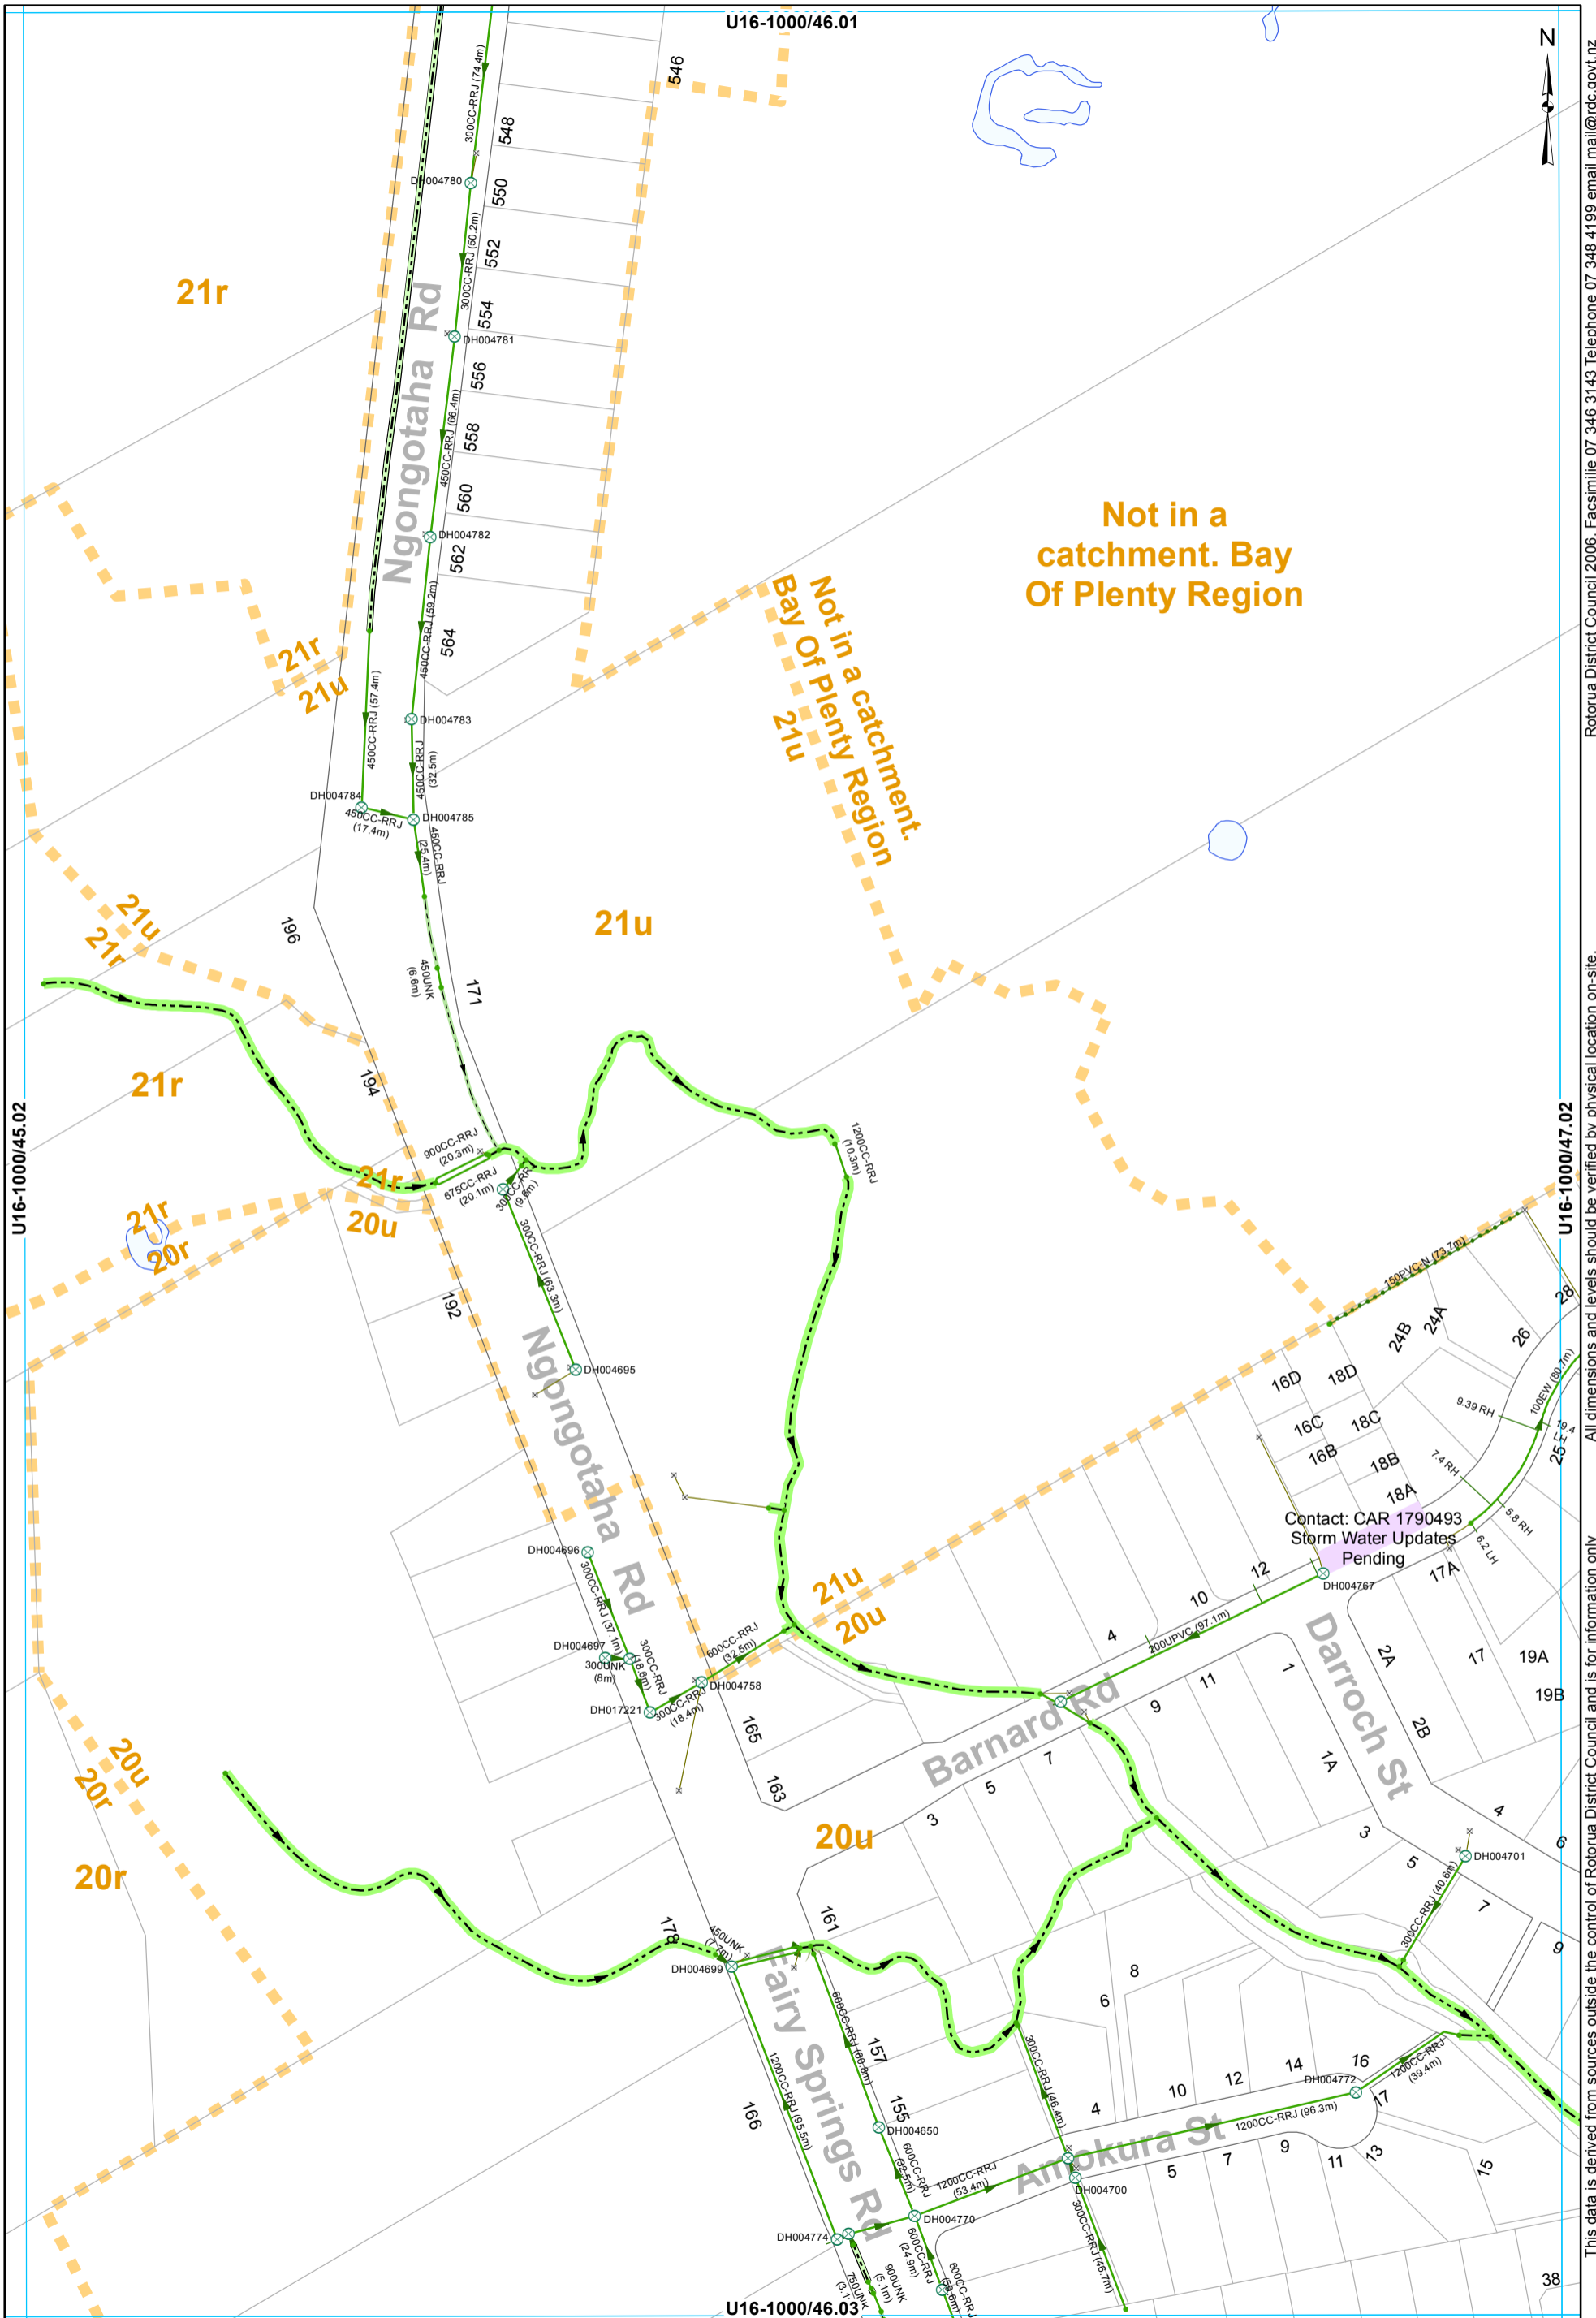

Not in a catchment. Bay Of Plenty Region

Contact: CAR 1790493  
Storm Water Updates  
Pending

- ⊗ SWManhole
- × SWInlet
- Node
- Lined Channel
- Open Drain
- Overland Flow
- Stream
- Culvert
- Gravity Main
- Subsoil Drain
- SWServiceline
- SWServiceline
- SWLead
- Catchment Boundary

**STORMWATER SERVICES**  
1:2000 @ A3 - (U16-1000/46.02)

This data is derived from sources outside the control of Rotorua District Council and is for information only

Rotorua District Council 2006. Facsimile 07 346 3143 Telephone 07 348 4199 email mail@rdc.govt.nz