




Storm Water Asbuilt Sheet Index  
SWCatchment 22r



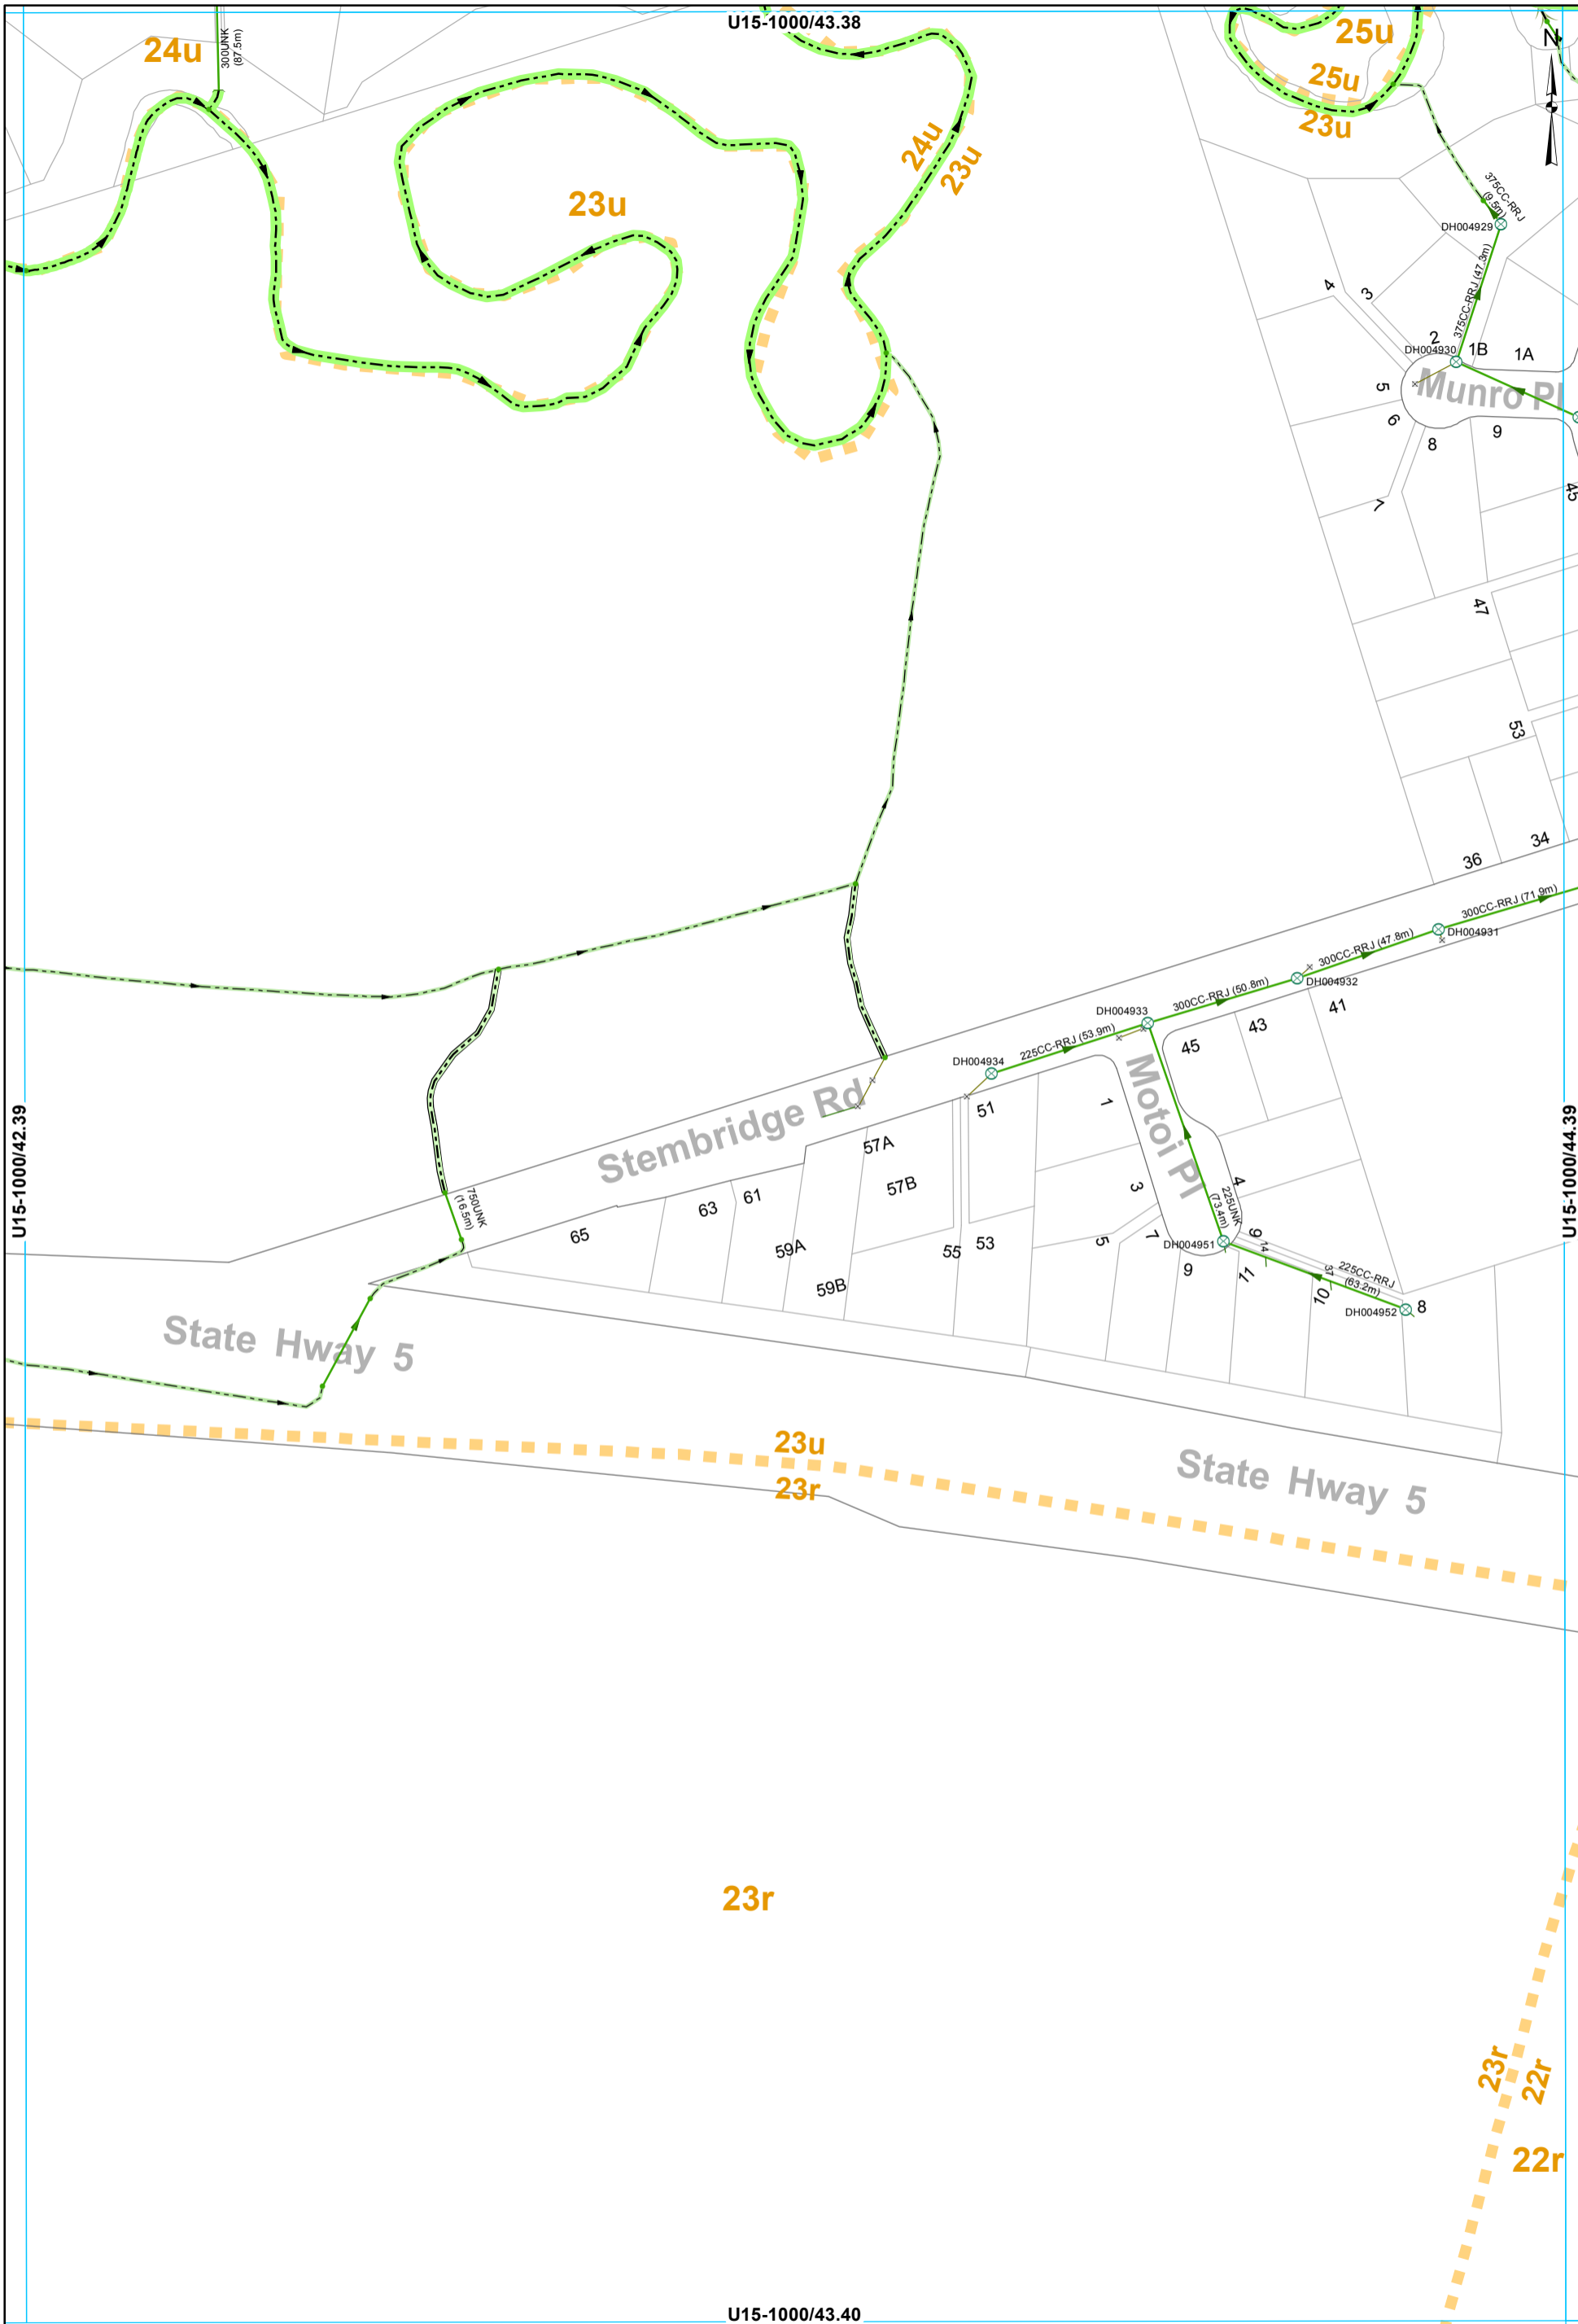


All dimensions and levels should be verified by physical location on-site. This data is derived from sources outside the control of Rotorua District Council and is for information only.

Rotorua District Council 2006. Facsimile 07 346 3143 Telephone 07 348 4199 email mail@rdc.govt.nz

- ⊗ SWManhole
- × SWInlet
- Node
- Headwall Structure
- ▬ Lined Channel
- Open Drain
- Overland Flow
- Stream
- Culvert
- Gravity Main
- SWServiceline
- SWServiceline
- SWLead
- ▬ Catchment Boundary

**STORMWATER SERVICES**  
1:2000 @ A3 - (U15-1000/43.39)

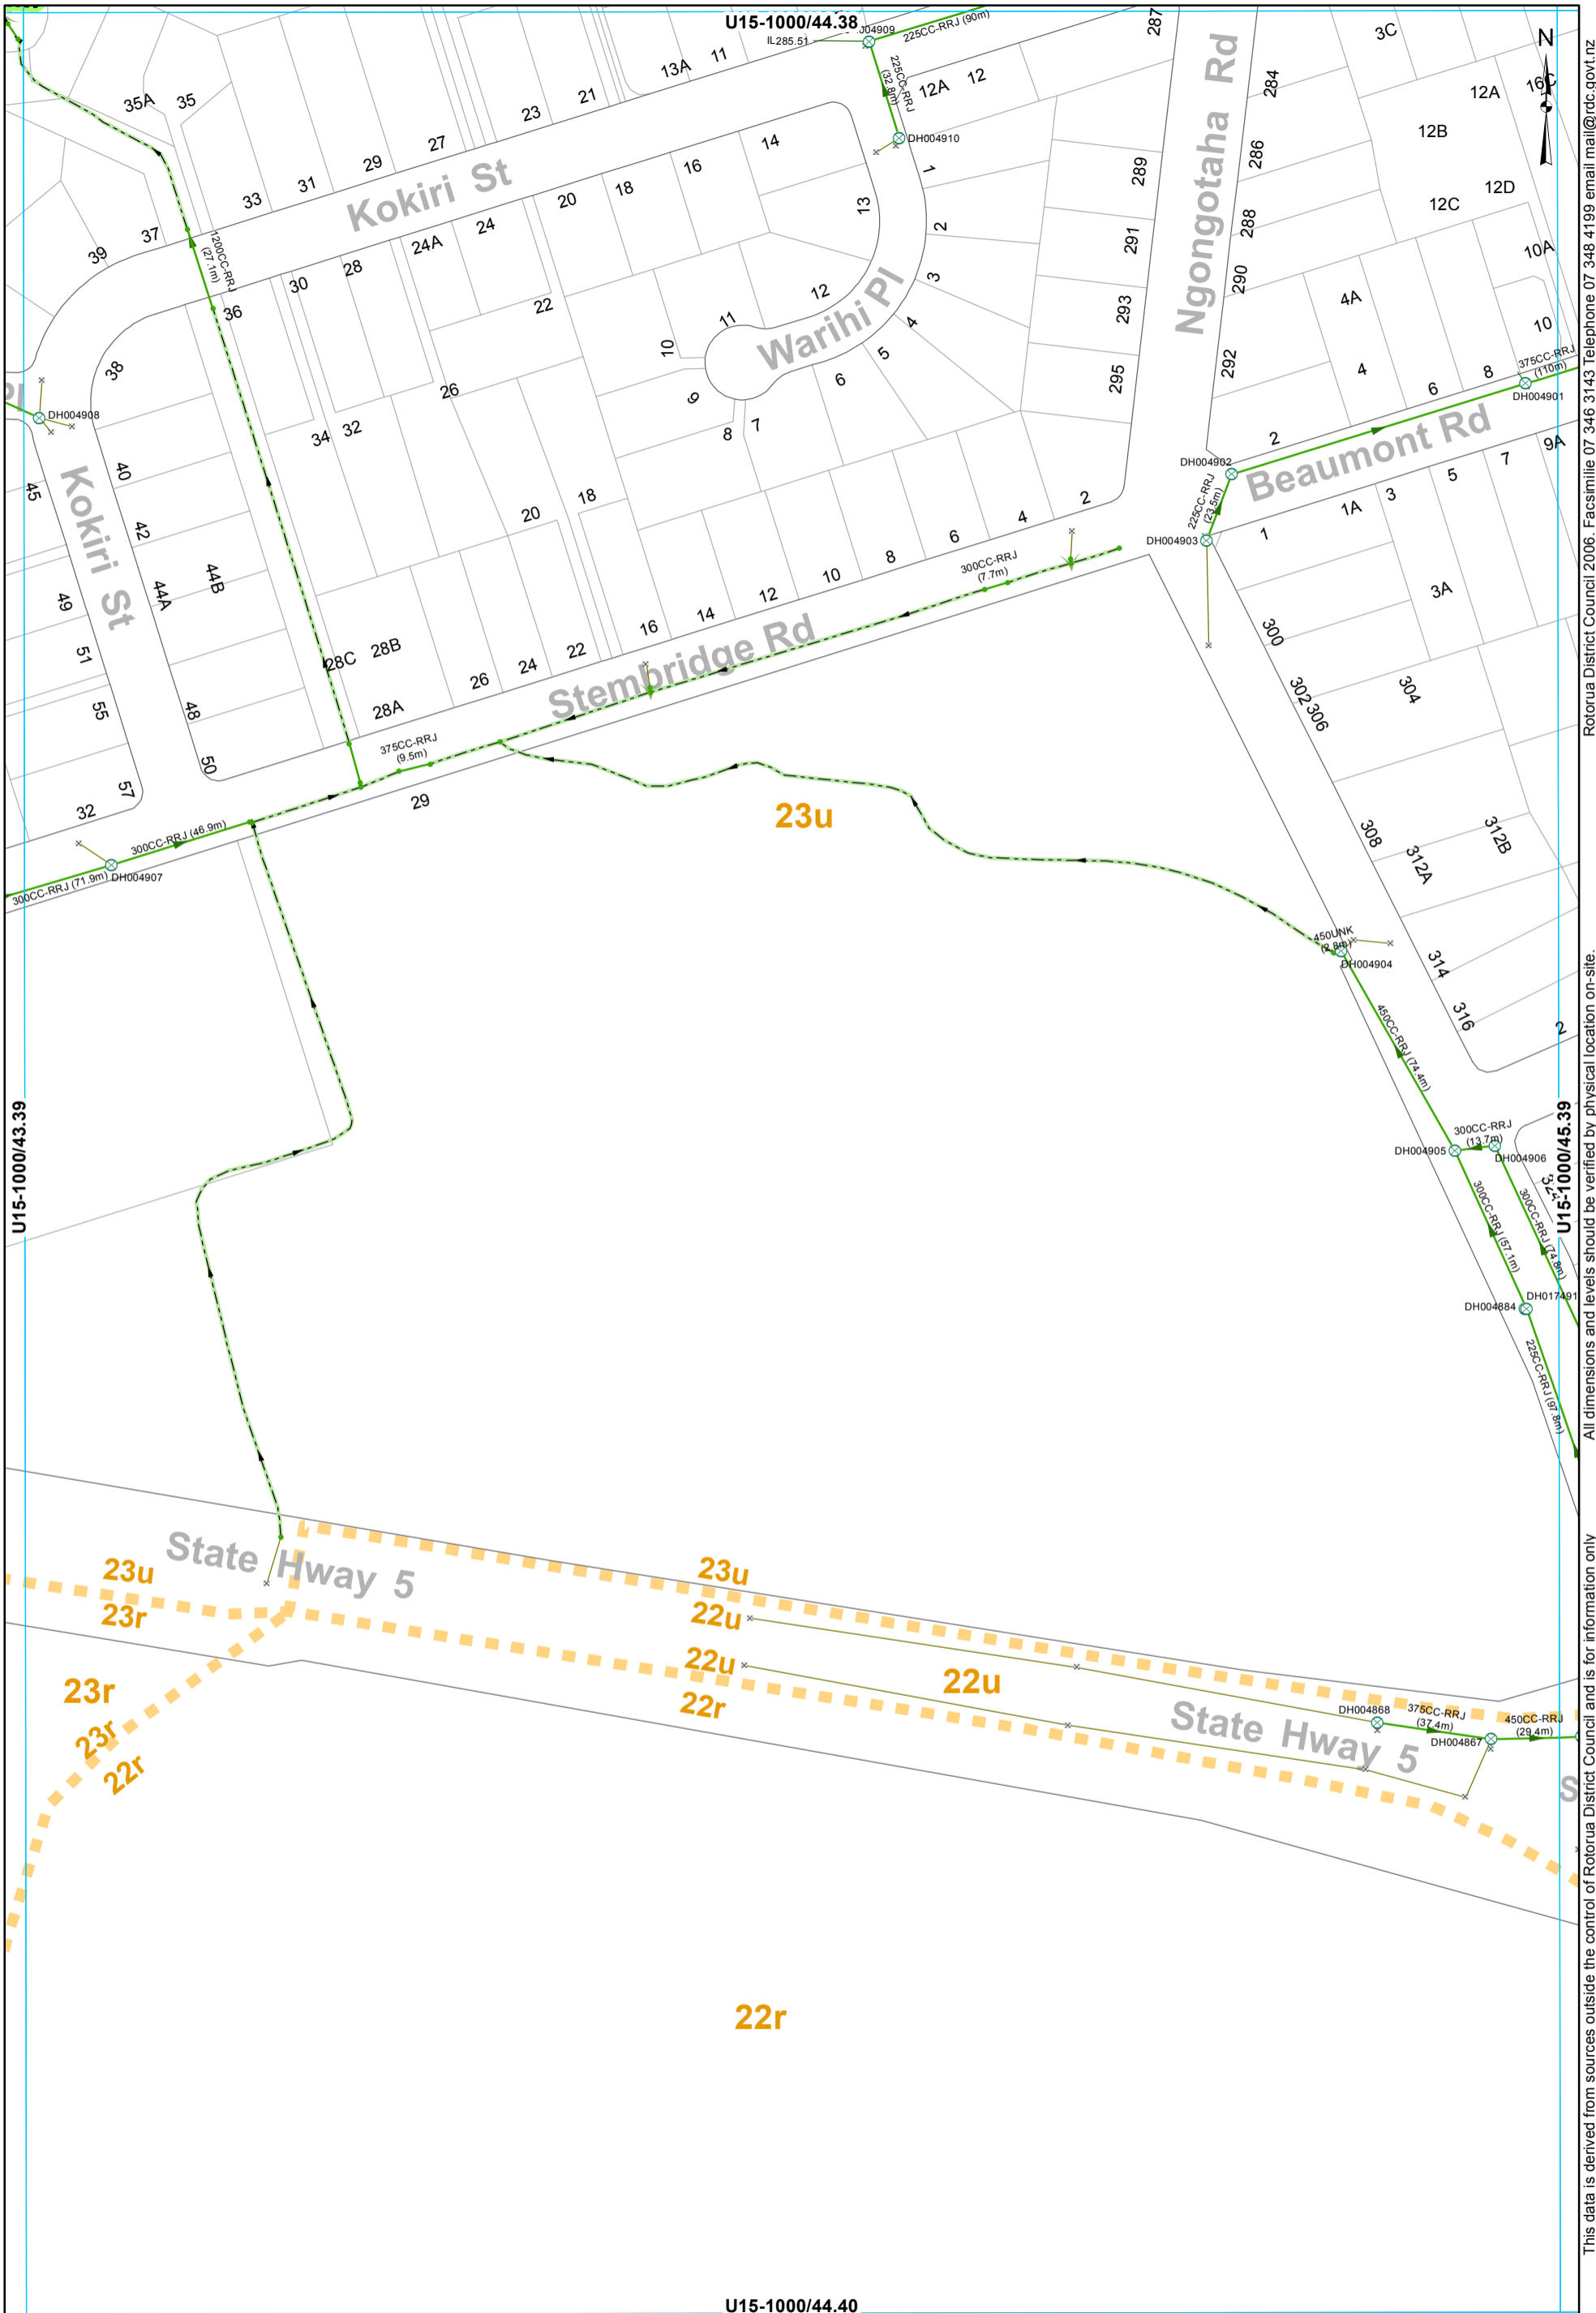


This data is derived from sources outside the control of Rotorua District Council and is for information only. All dimensions and levels should be verified by physical location on-site. Rotorua District Council 2006. Facsimile 07 348 3143 Telephone 07 348 4199 email mail@rdc.govt.nz

- ⊗ SWManhole
- × SWInlet
- Node
- Open Drain
- Overland Flow
- Stream
- Culvert
- Gravity Main
- SWServiceline
- SWLead
- Catchment Boundary

**STORMWATER SERVICES**  
1:2000 @ A3 - (U15-1000/44.39)

U15-1000/44.40

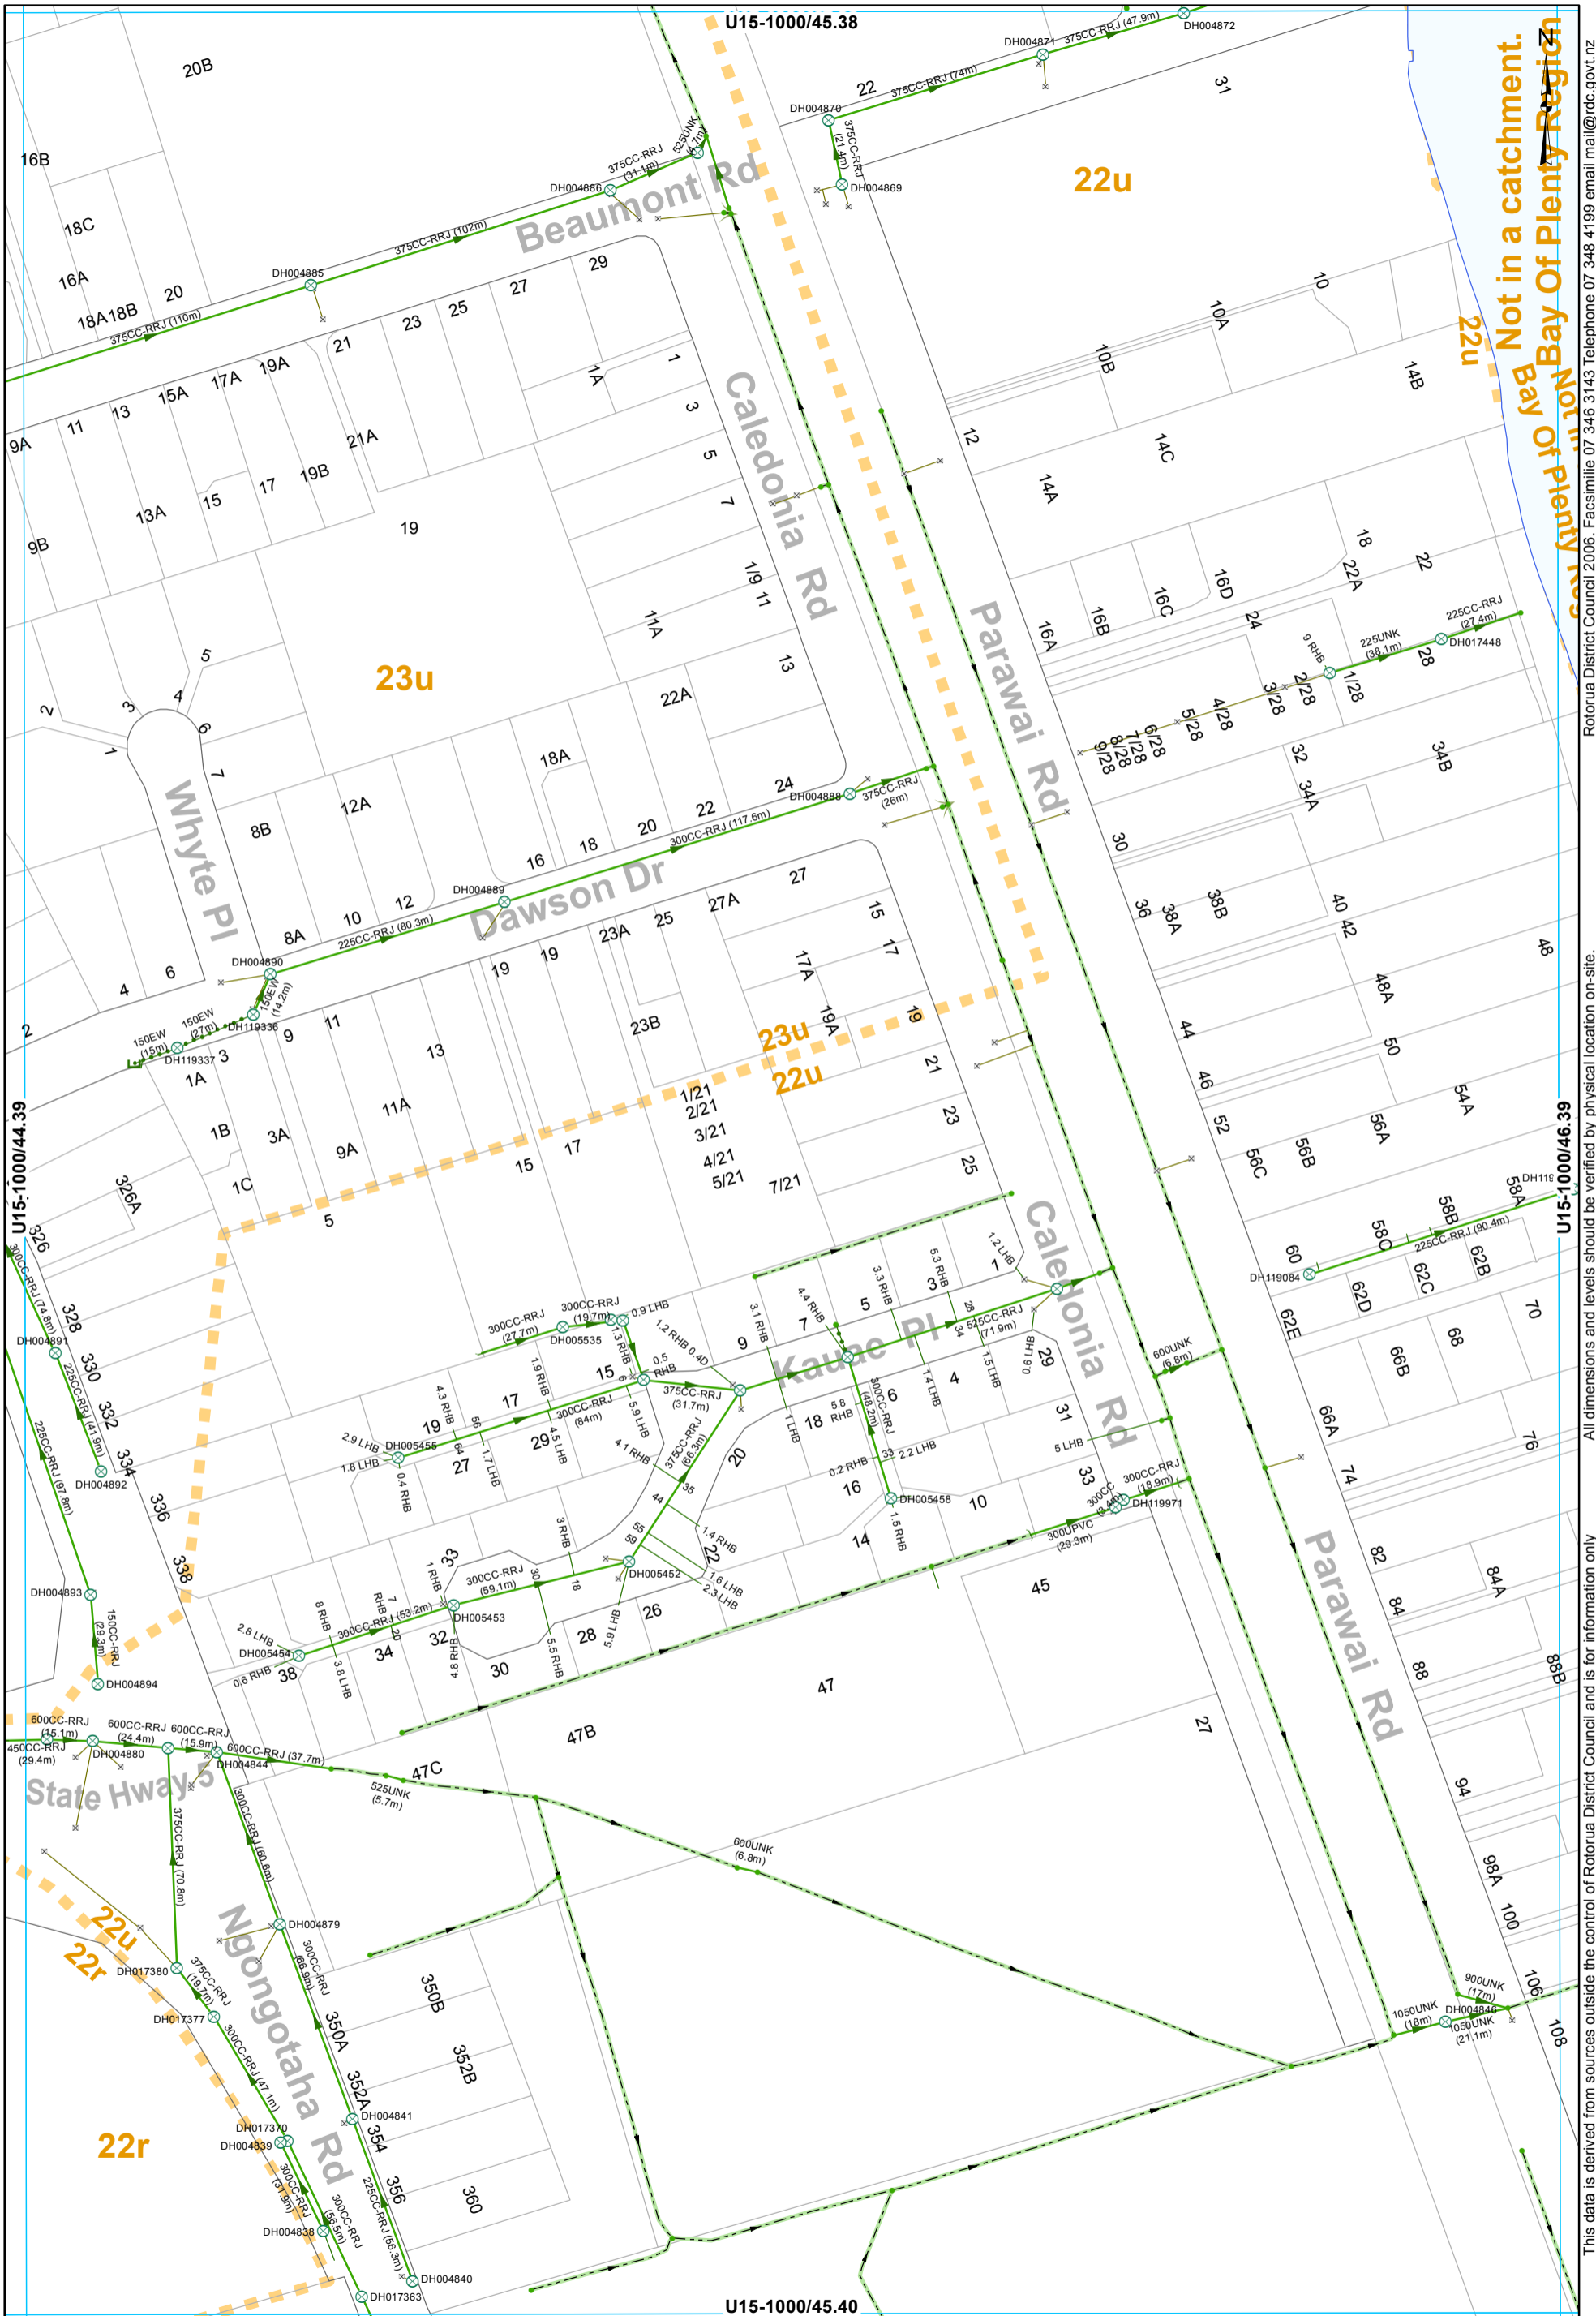


Not in a catchment.  
 Bay Of Plenty Region  
 Bay Of Plenty Region

- ⊗ SWManhole
- × SWInlet
- Node
- ⌈ Capped End
- Headwall Structure
- Open Drain
- Overland Flow
- Culvert
- Gravity Main
- Subsoil Drain
- SWServiceline
- SWServiceline
- SWLead
- ⬮ Catchment Boundary

**STORMWATER SERVICES**  
 1:2000 @ A3 - (U15-1000/45.39)

This data is derived from sources outside the control of Rotorua District Council and is for information only. All dimensions and levels should be verified by physical location on-site.

Rotorua District Council 2006. Facsimile 07 346 3143 Telephone 07 348 4199 email mail@rdc.govt.nz

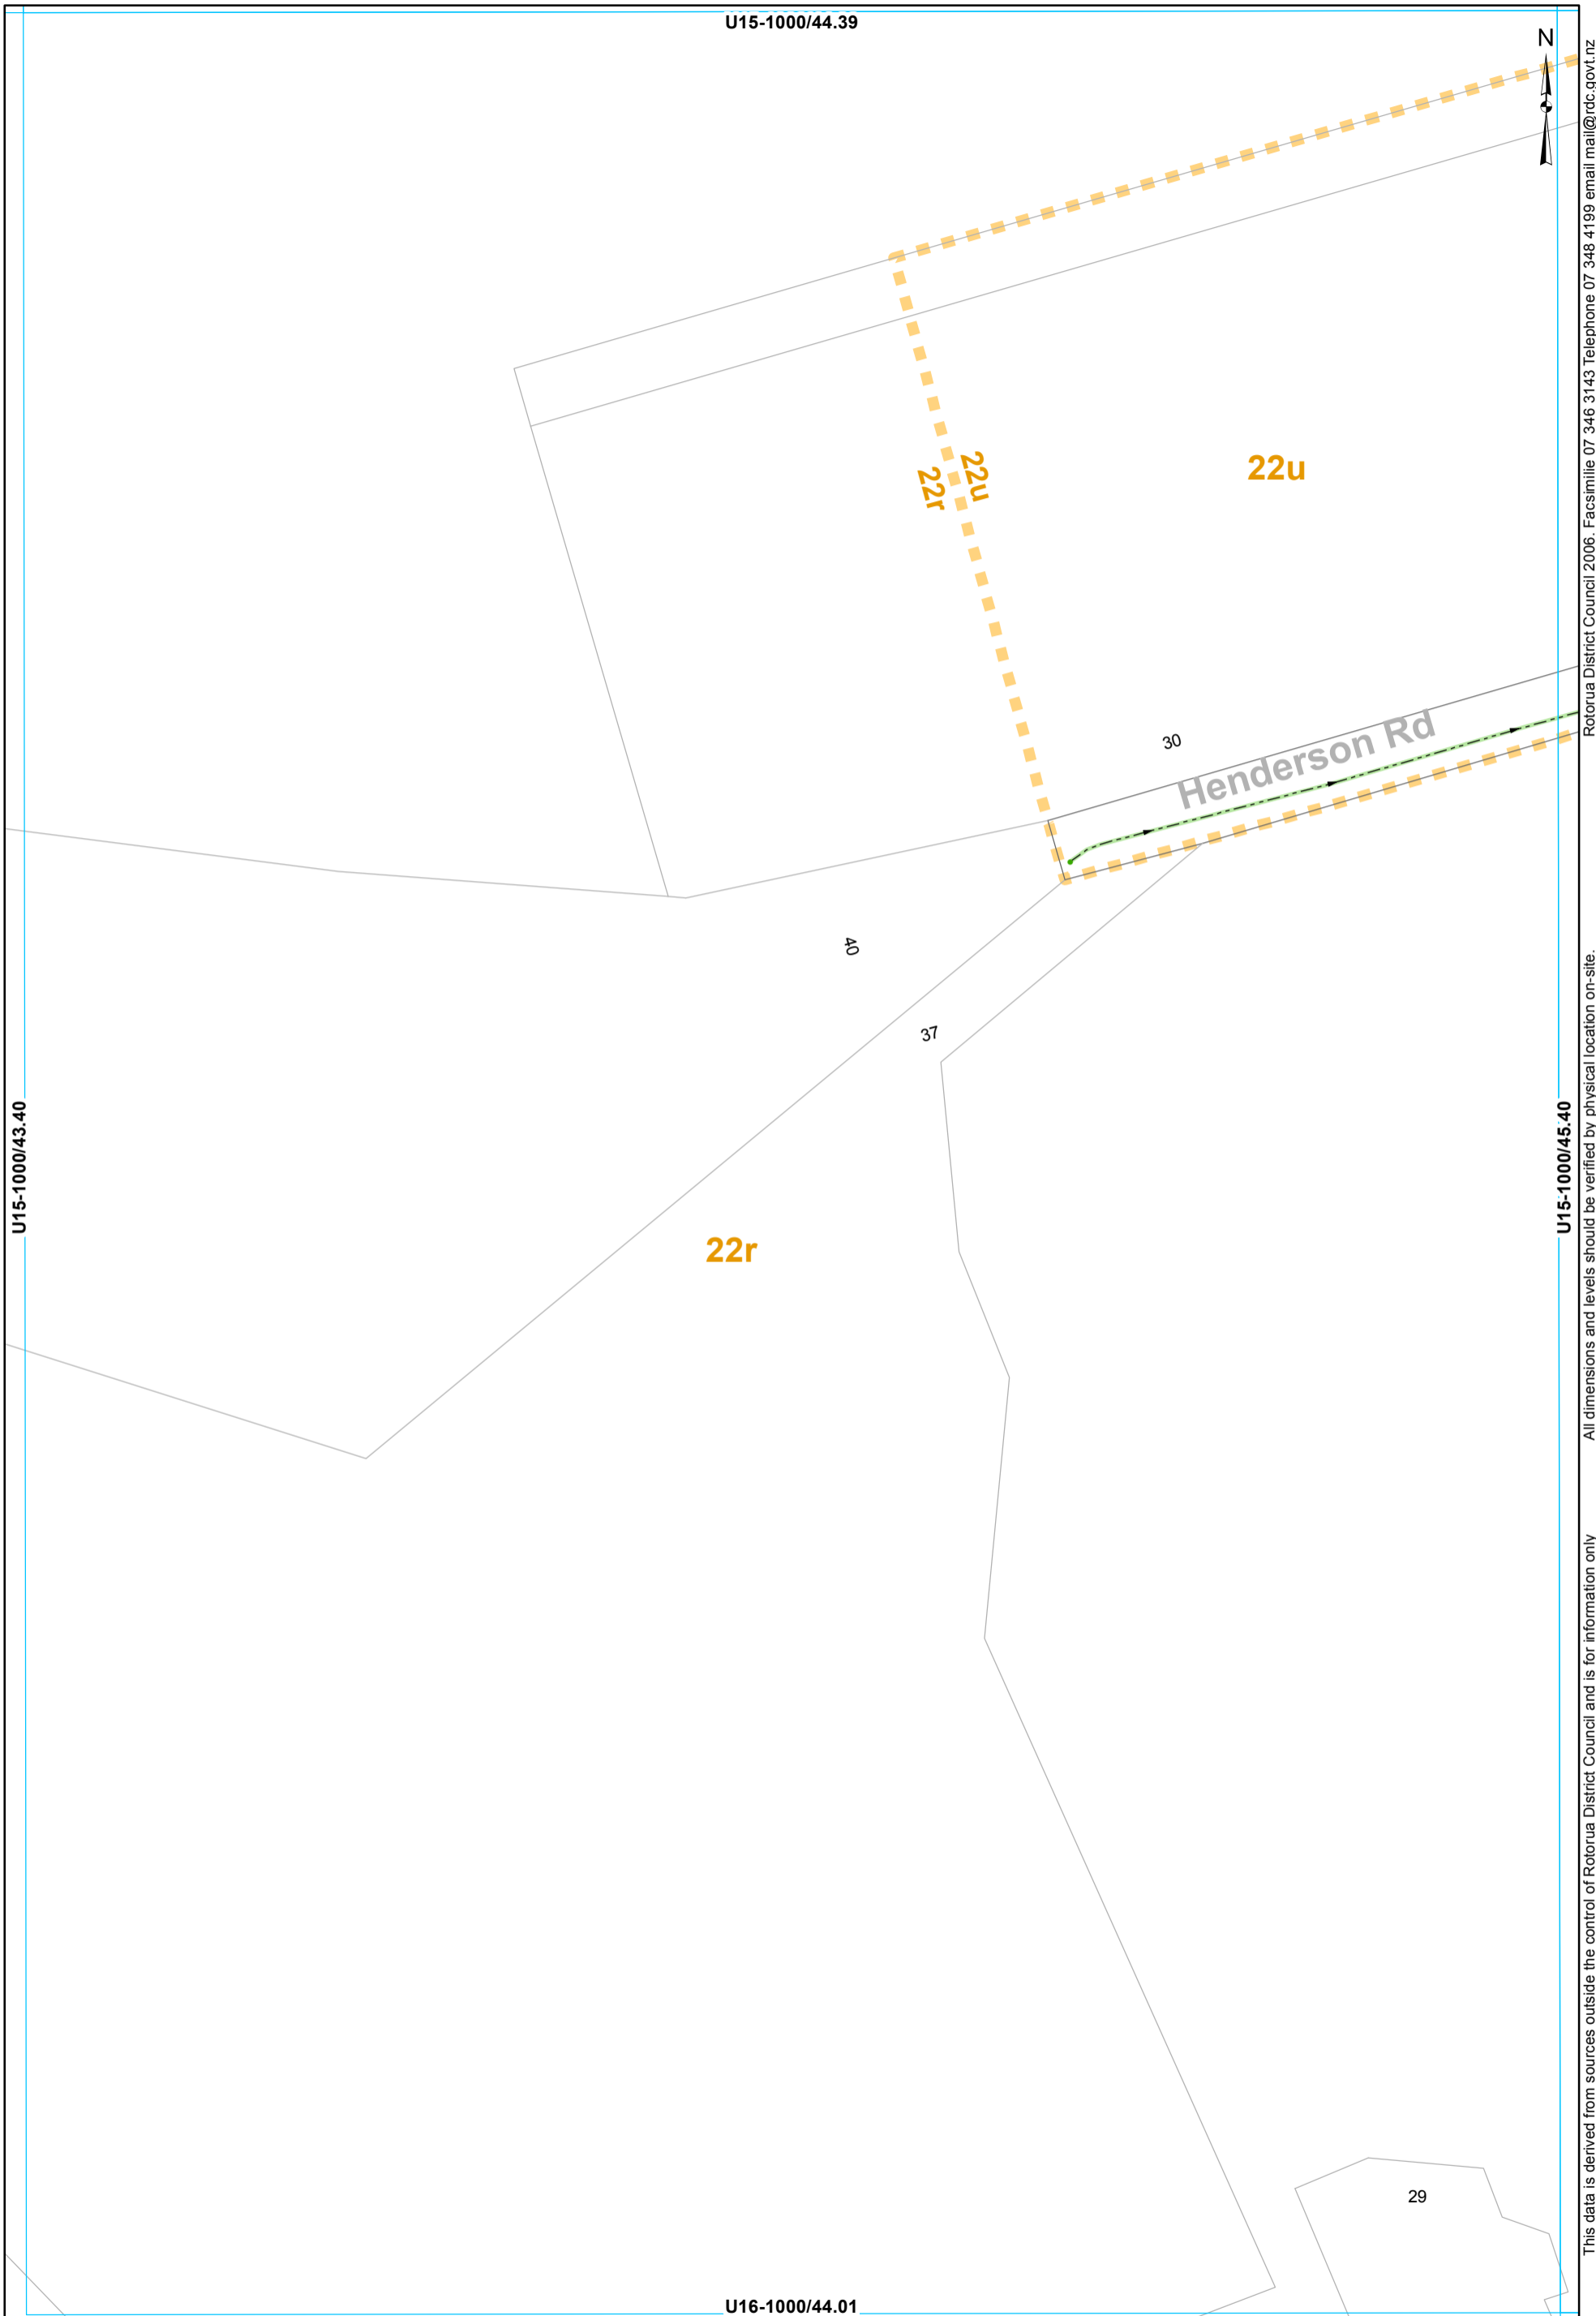

- Node
- Open Drain
- ▬ Catchment Boundary

**STORMWATER SERVICES**  
1:2000 @ A3 - (U15-1000/44.40)

U15-1000/43.40

U15-1000/44.39

22r

22u  
22r

22u

30

Henderson Rd

40

37


29

U16-1000/44.01

U15-1000/45.40

This data is derived from sources outside the control of Rotorua District Council and is for information only

Rotorua District Council 2006. Facsimile 07 346 3143 Telephone 07 348 4199 email mail@rdc.govt.nz

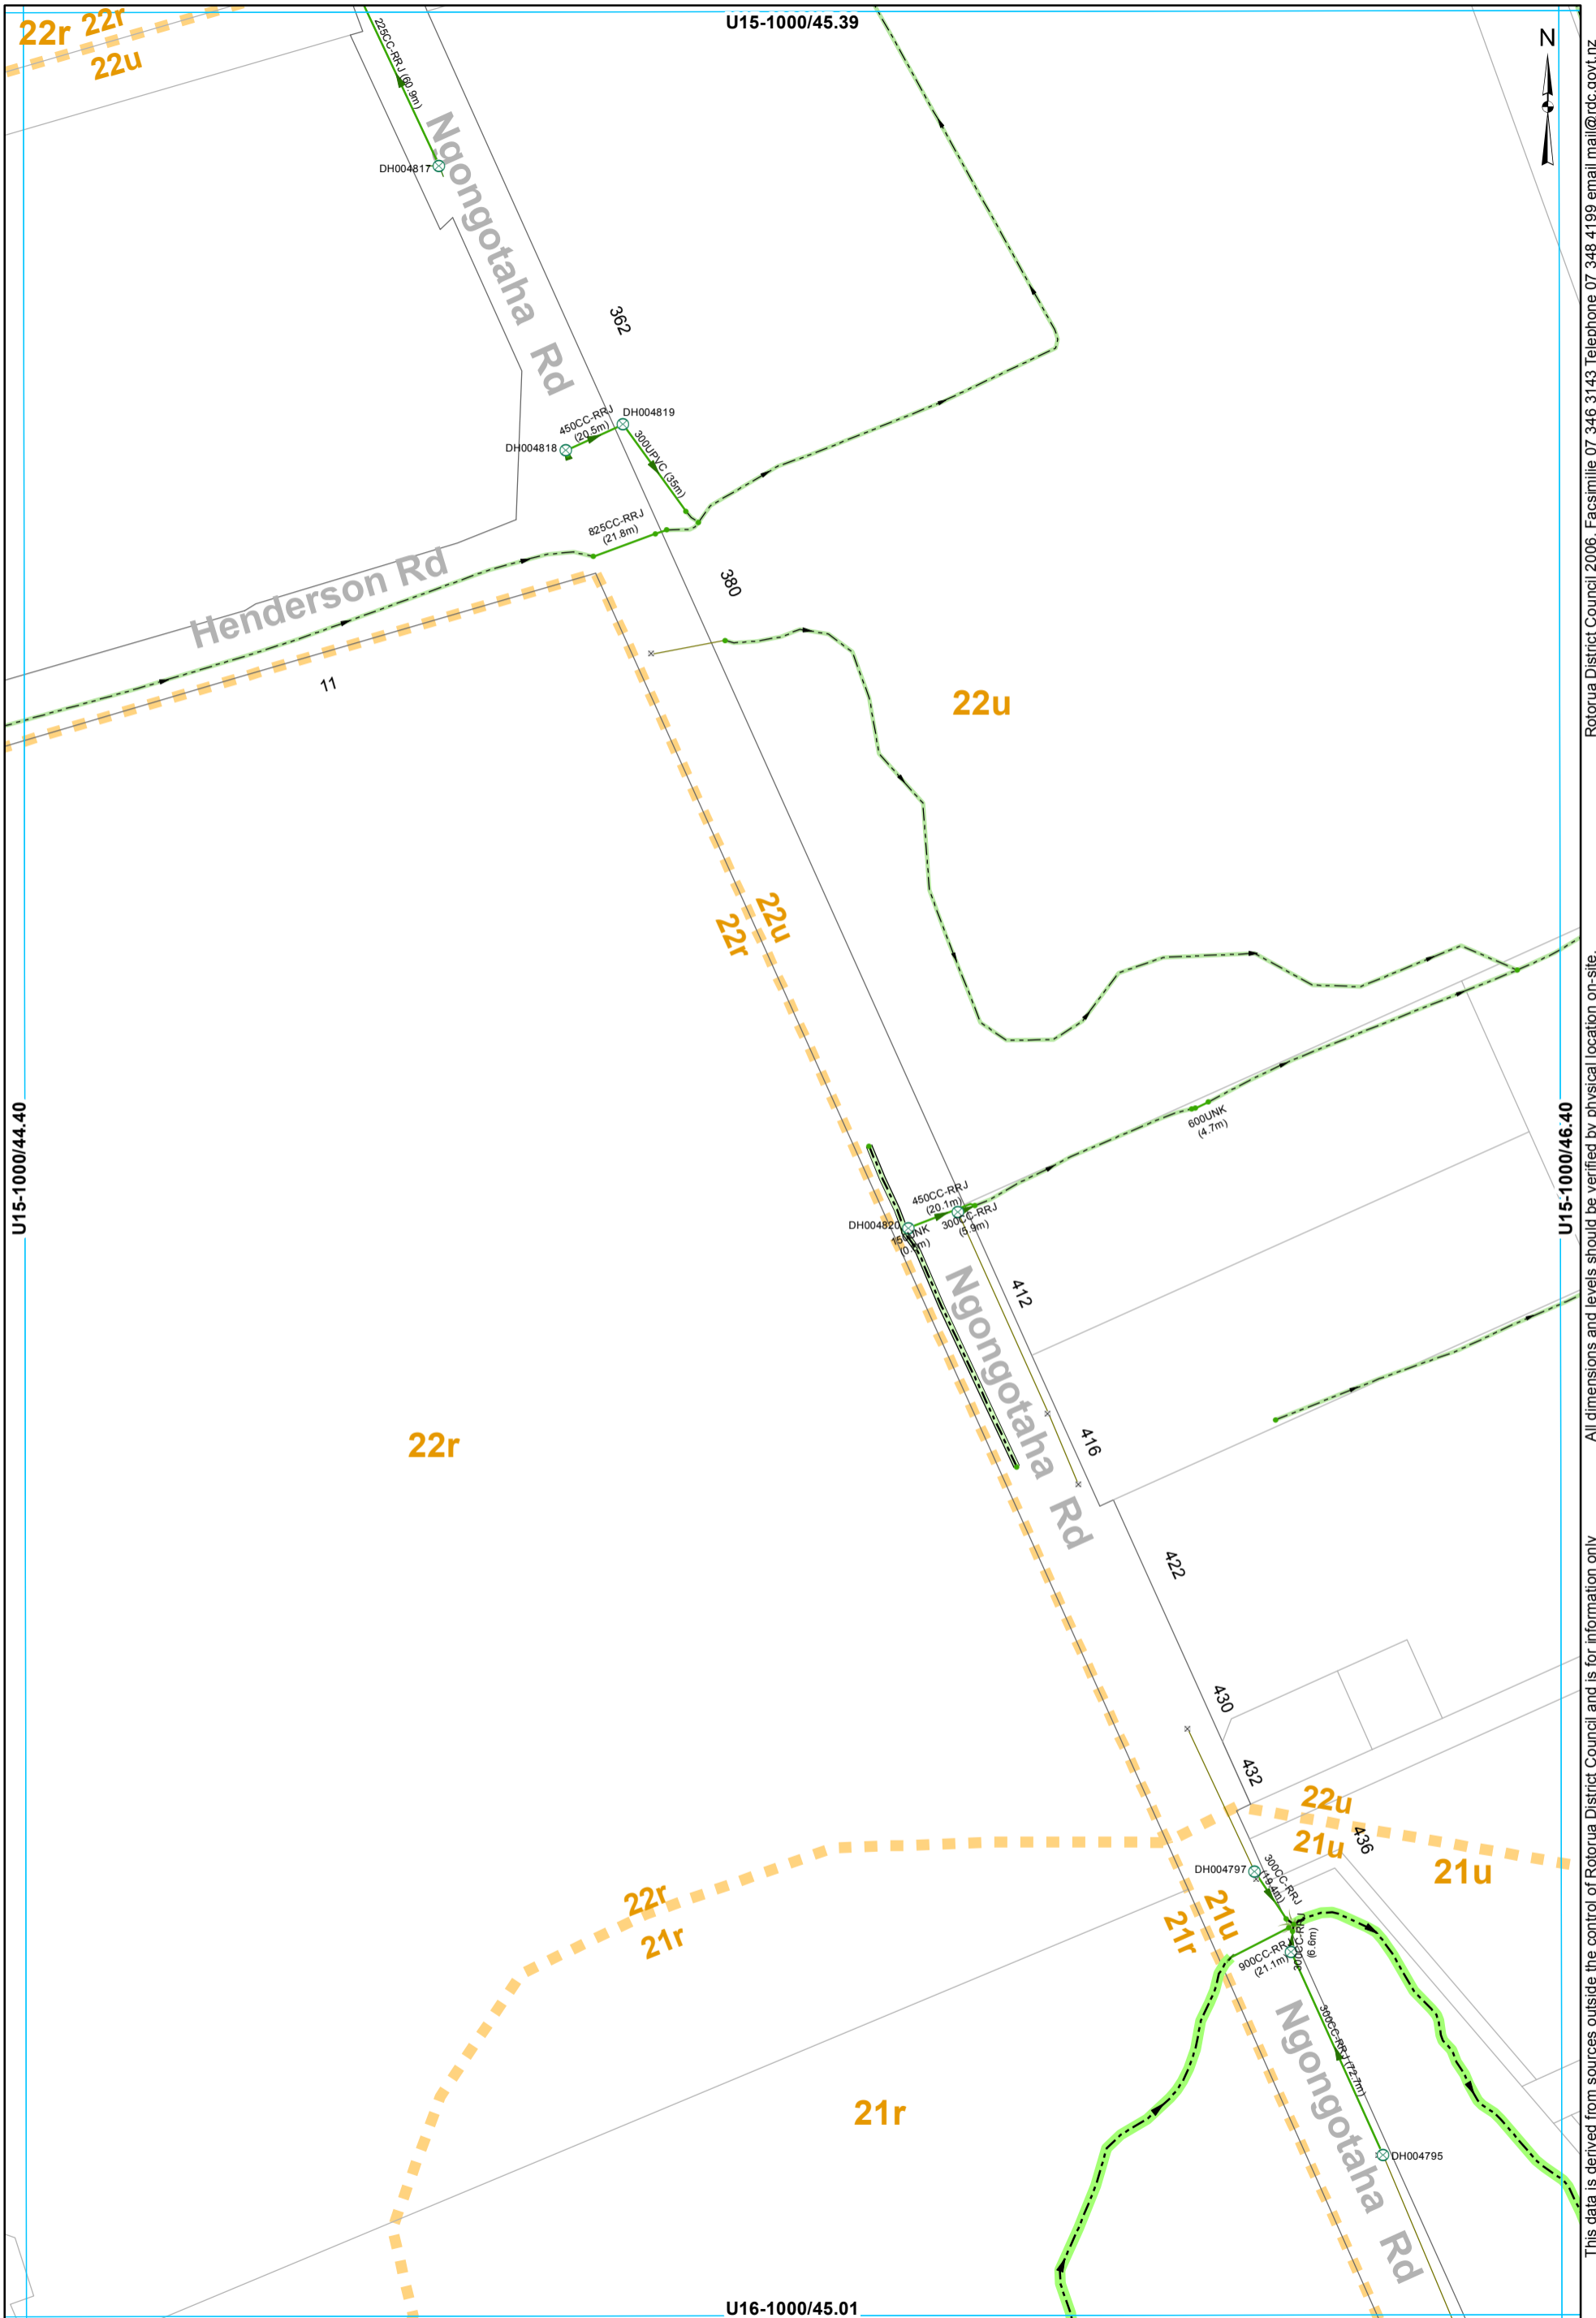


- ⊗ SWManhole
- × SWInlet
- Node
- Headwall Structure
- Lined Channel
- ... Open Drain
- Overland Flow
- Stream
- Culvert
- Gravity Main
- SWServiceline
- SWServiceline
- SWLead
- Catchment Boundary

**STORMWATER SERVICES**  
**1:2000 @ A3 - (U15-1000/45.40)**

This data is derived from sources outside the control of Rotorua District Council and is for information only

All dimensions and levels should be verified by physical location on-site.

Rotorua District Council 2006. Facsimile 07 346 3143 Telephone 07 348 4199 email mail@rdc.govt.nz

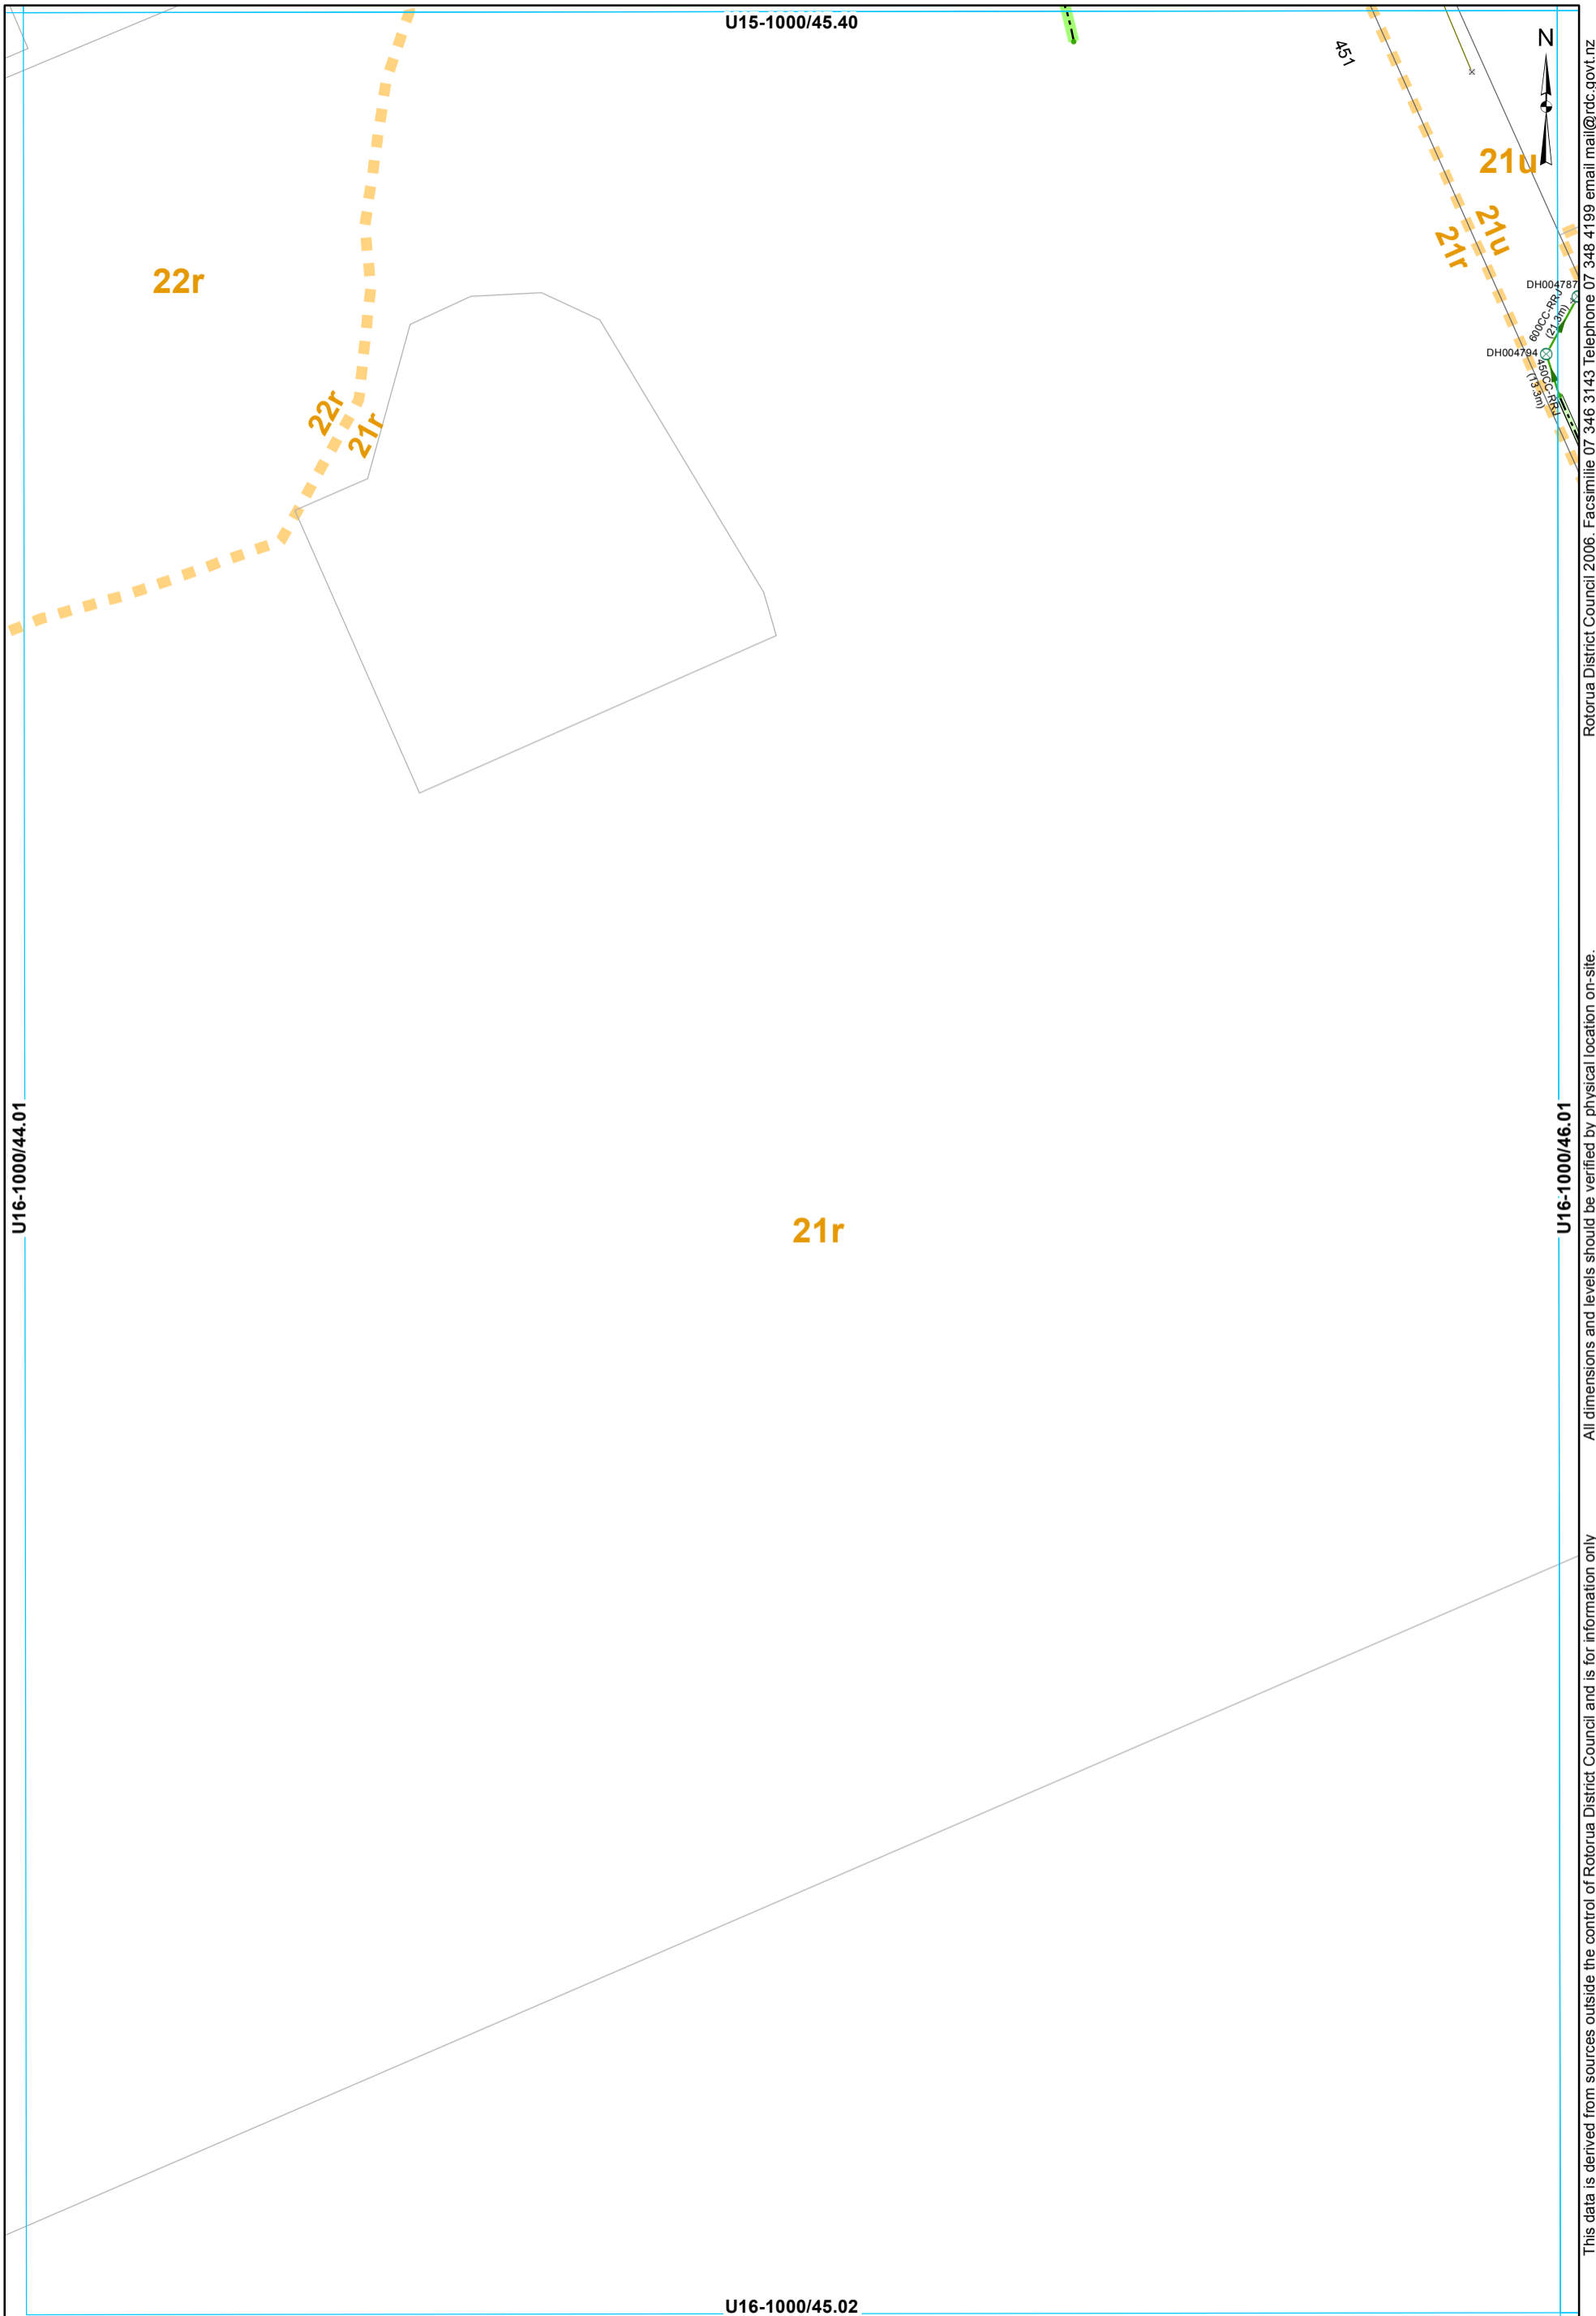

- ⊗ SWManhole
- × SWInlet
- Node
- ▬ Lined Channel
- ▬ Stream
- Gravity Main
- SWLead
- ▬ Catchment Boundary

**STORMWATER SERVICES**  
 1:2000 @ A3 - (U16-1000/45.01)

This data is derived from sources outside the control of Rotorua District Council and is for information only. All dimensions and levels should be verified by physical location on-site.

Rotorua District Council 2006. Facsimile 07 346 3143 Telephone 07 348 4199 email mail@rdc.govt.nz