

Storm Water Asbuilt Sheet Index
 SWCatchment 22u



U15-1000/46.37



Lake Rotorua

Not in a catchment. Bay Of Plenty Region

U15-1000/45.38

27u

27u

23u

23u

23u


22u

Not in a catchment. Bay Of Plenty Region

U15-1000/47.38

U15-1000/46.39

- Node
- Stream
- Catchment Boundary

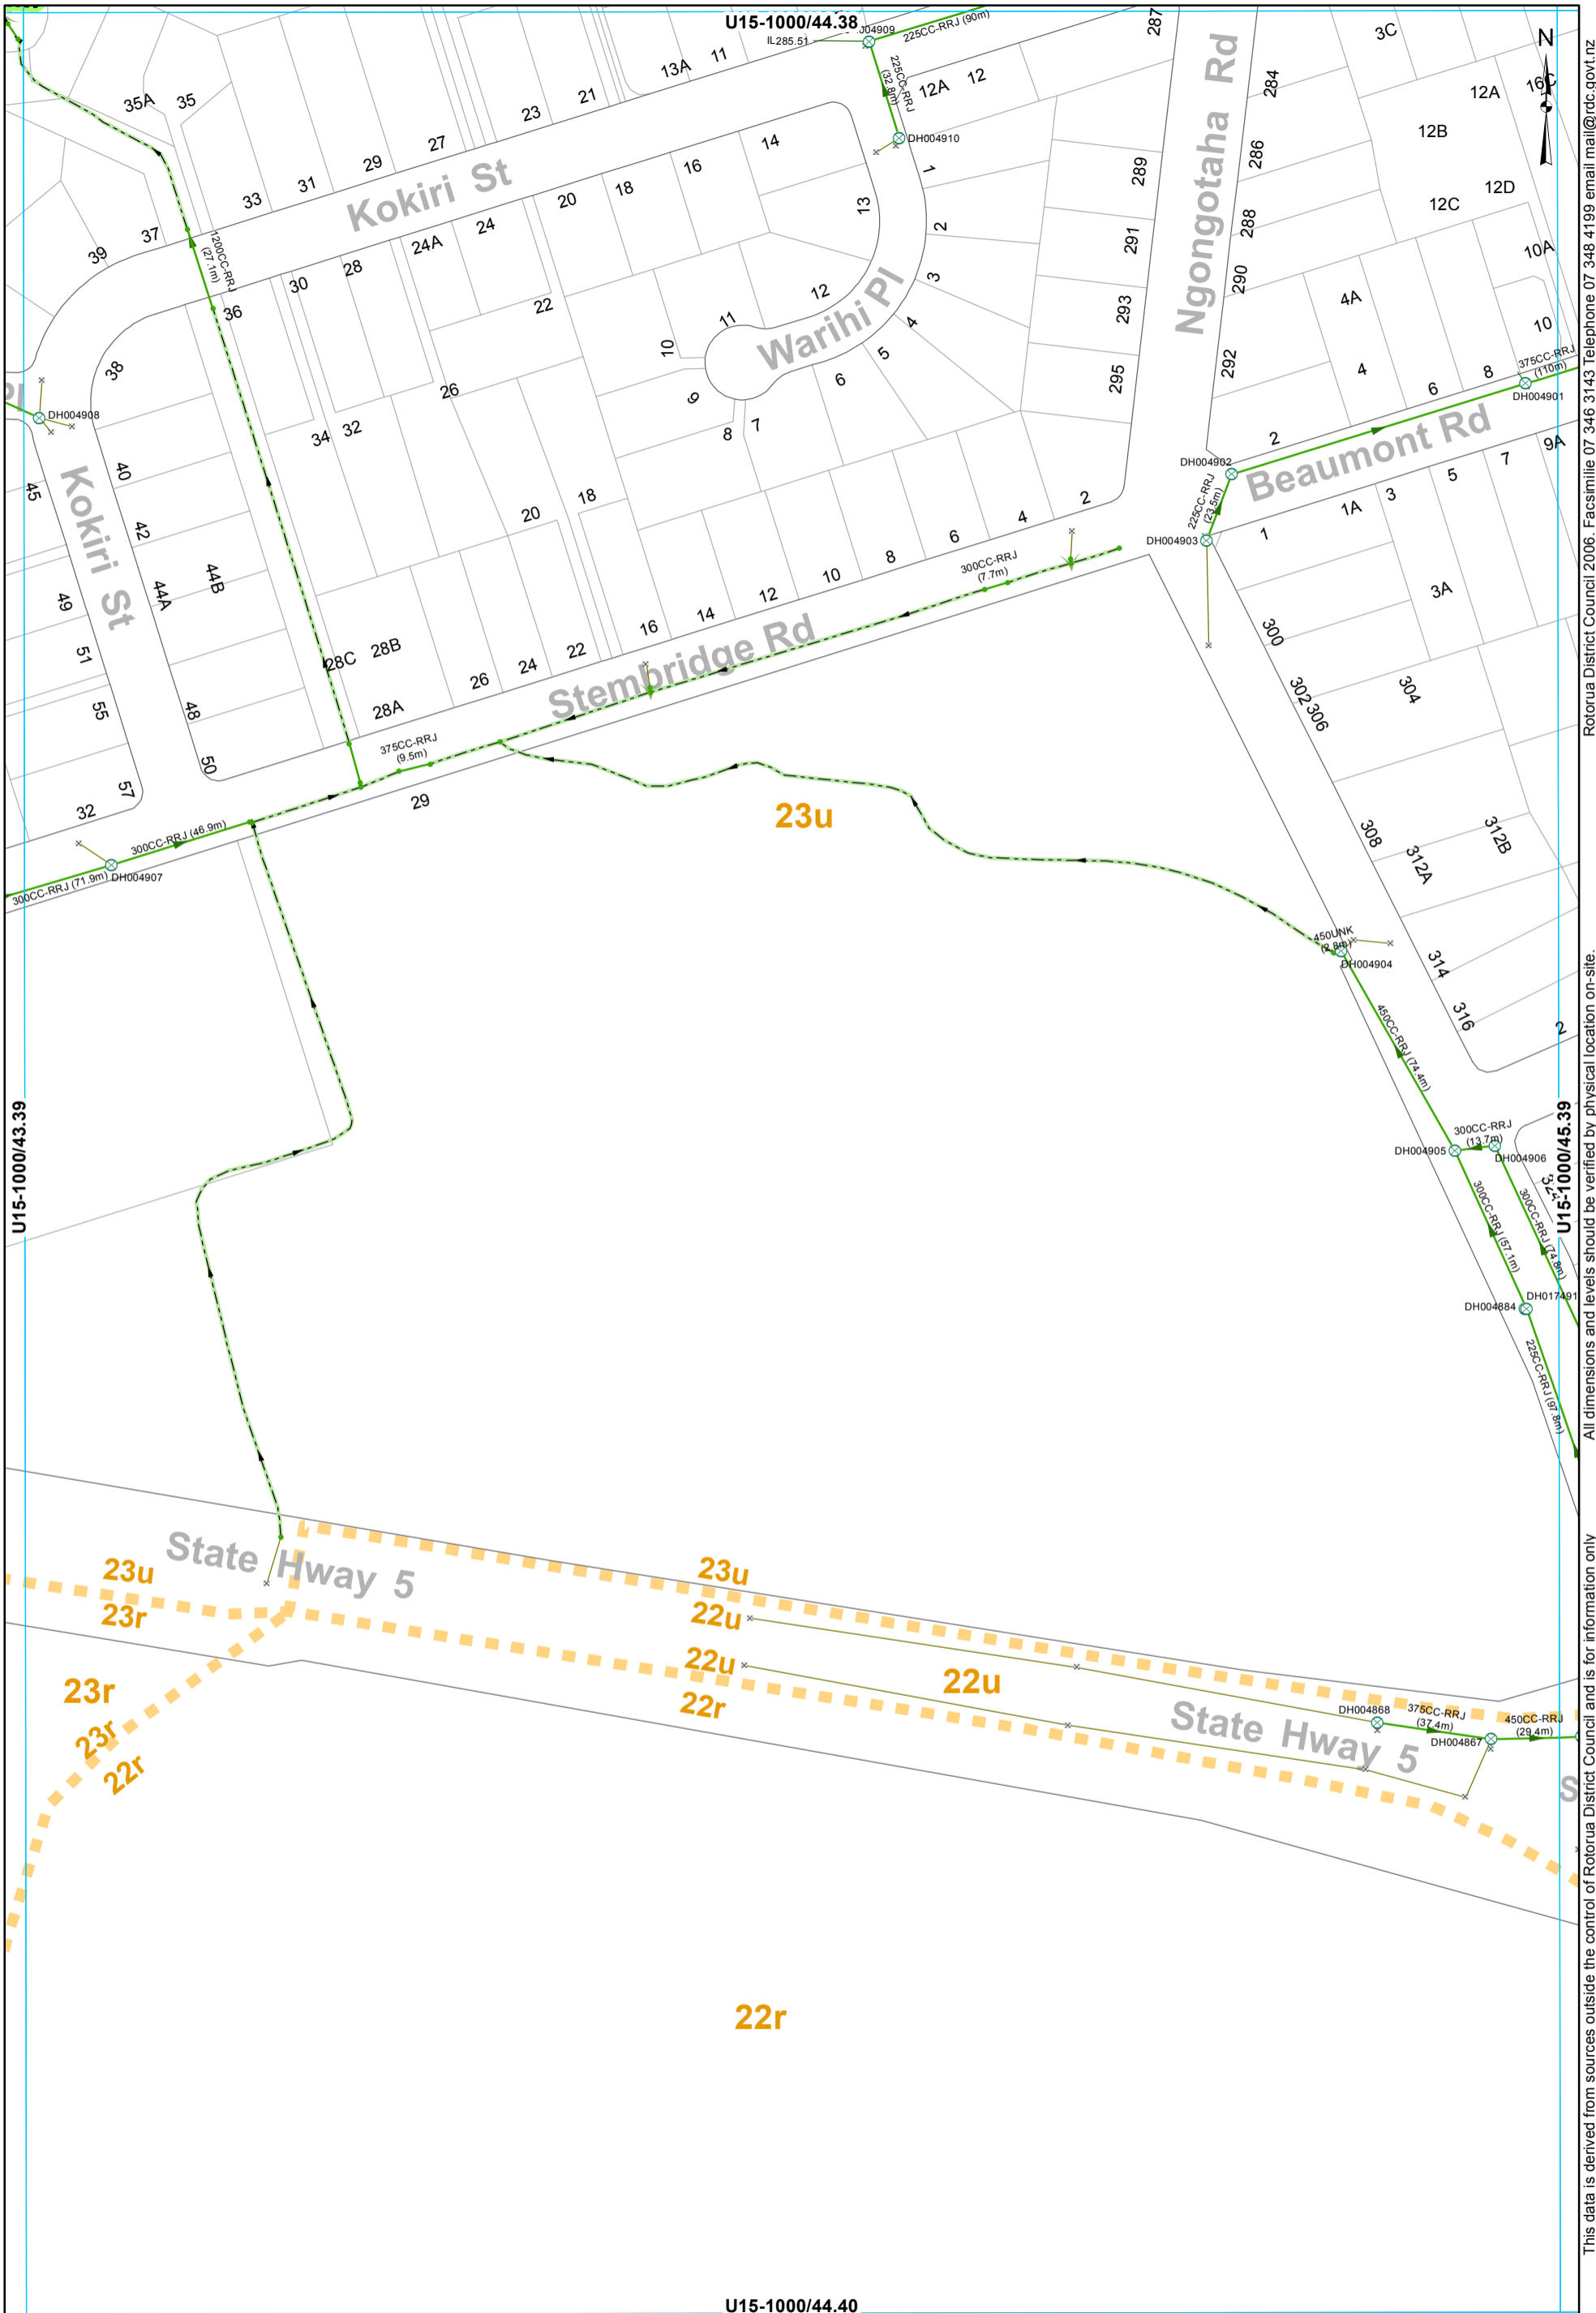


This data is derived from sources outside the control of Rotorua District Council and is for information only. All dimensions and levels should be verified by physical location on-site. Rotorua District Council 2006. Facsimile 07 348 3143 Telephone 07 348 4199 email mail@rdc.govt.nz

- ⊗ SWManhole
- × SWInlet
- Node
- Open Drain
- Overland Flow
- Stream
- Culvert
- Gravity Main
- SWServiceline
- SWLead
- Catchment Boundary

STORMWATER SERVICES
1:2000 @ A3 - (U15-1000/44.39)

U15-1000/44.40

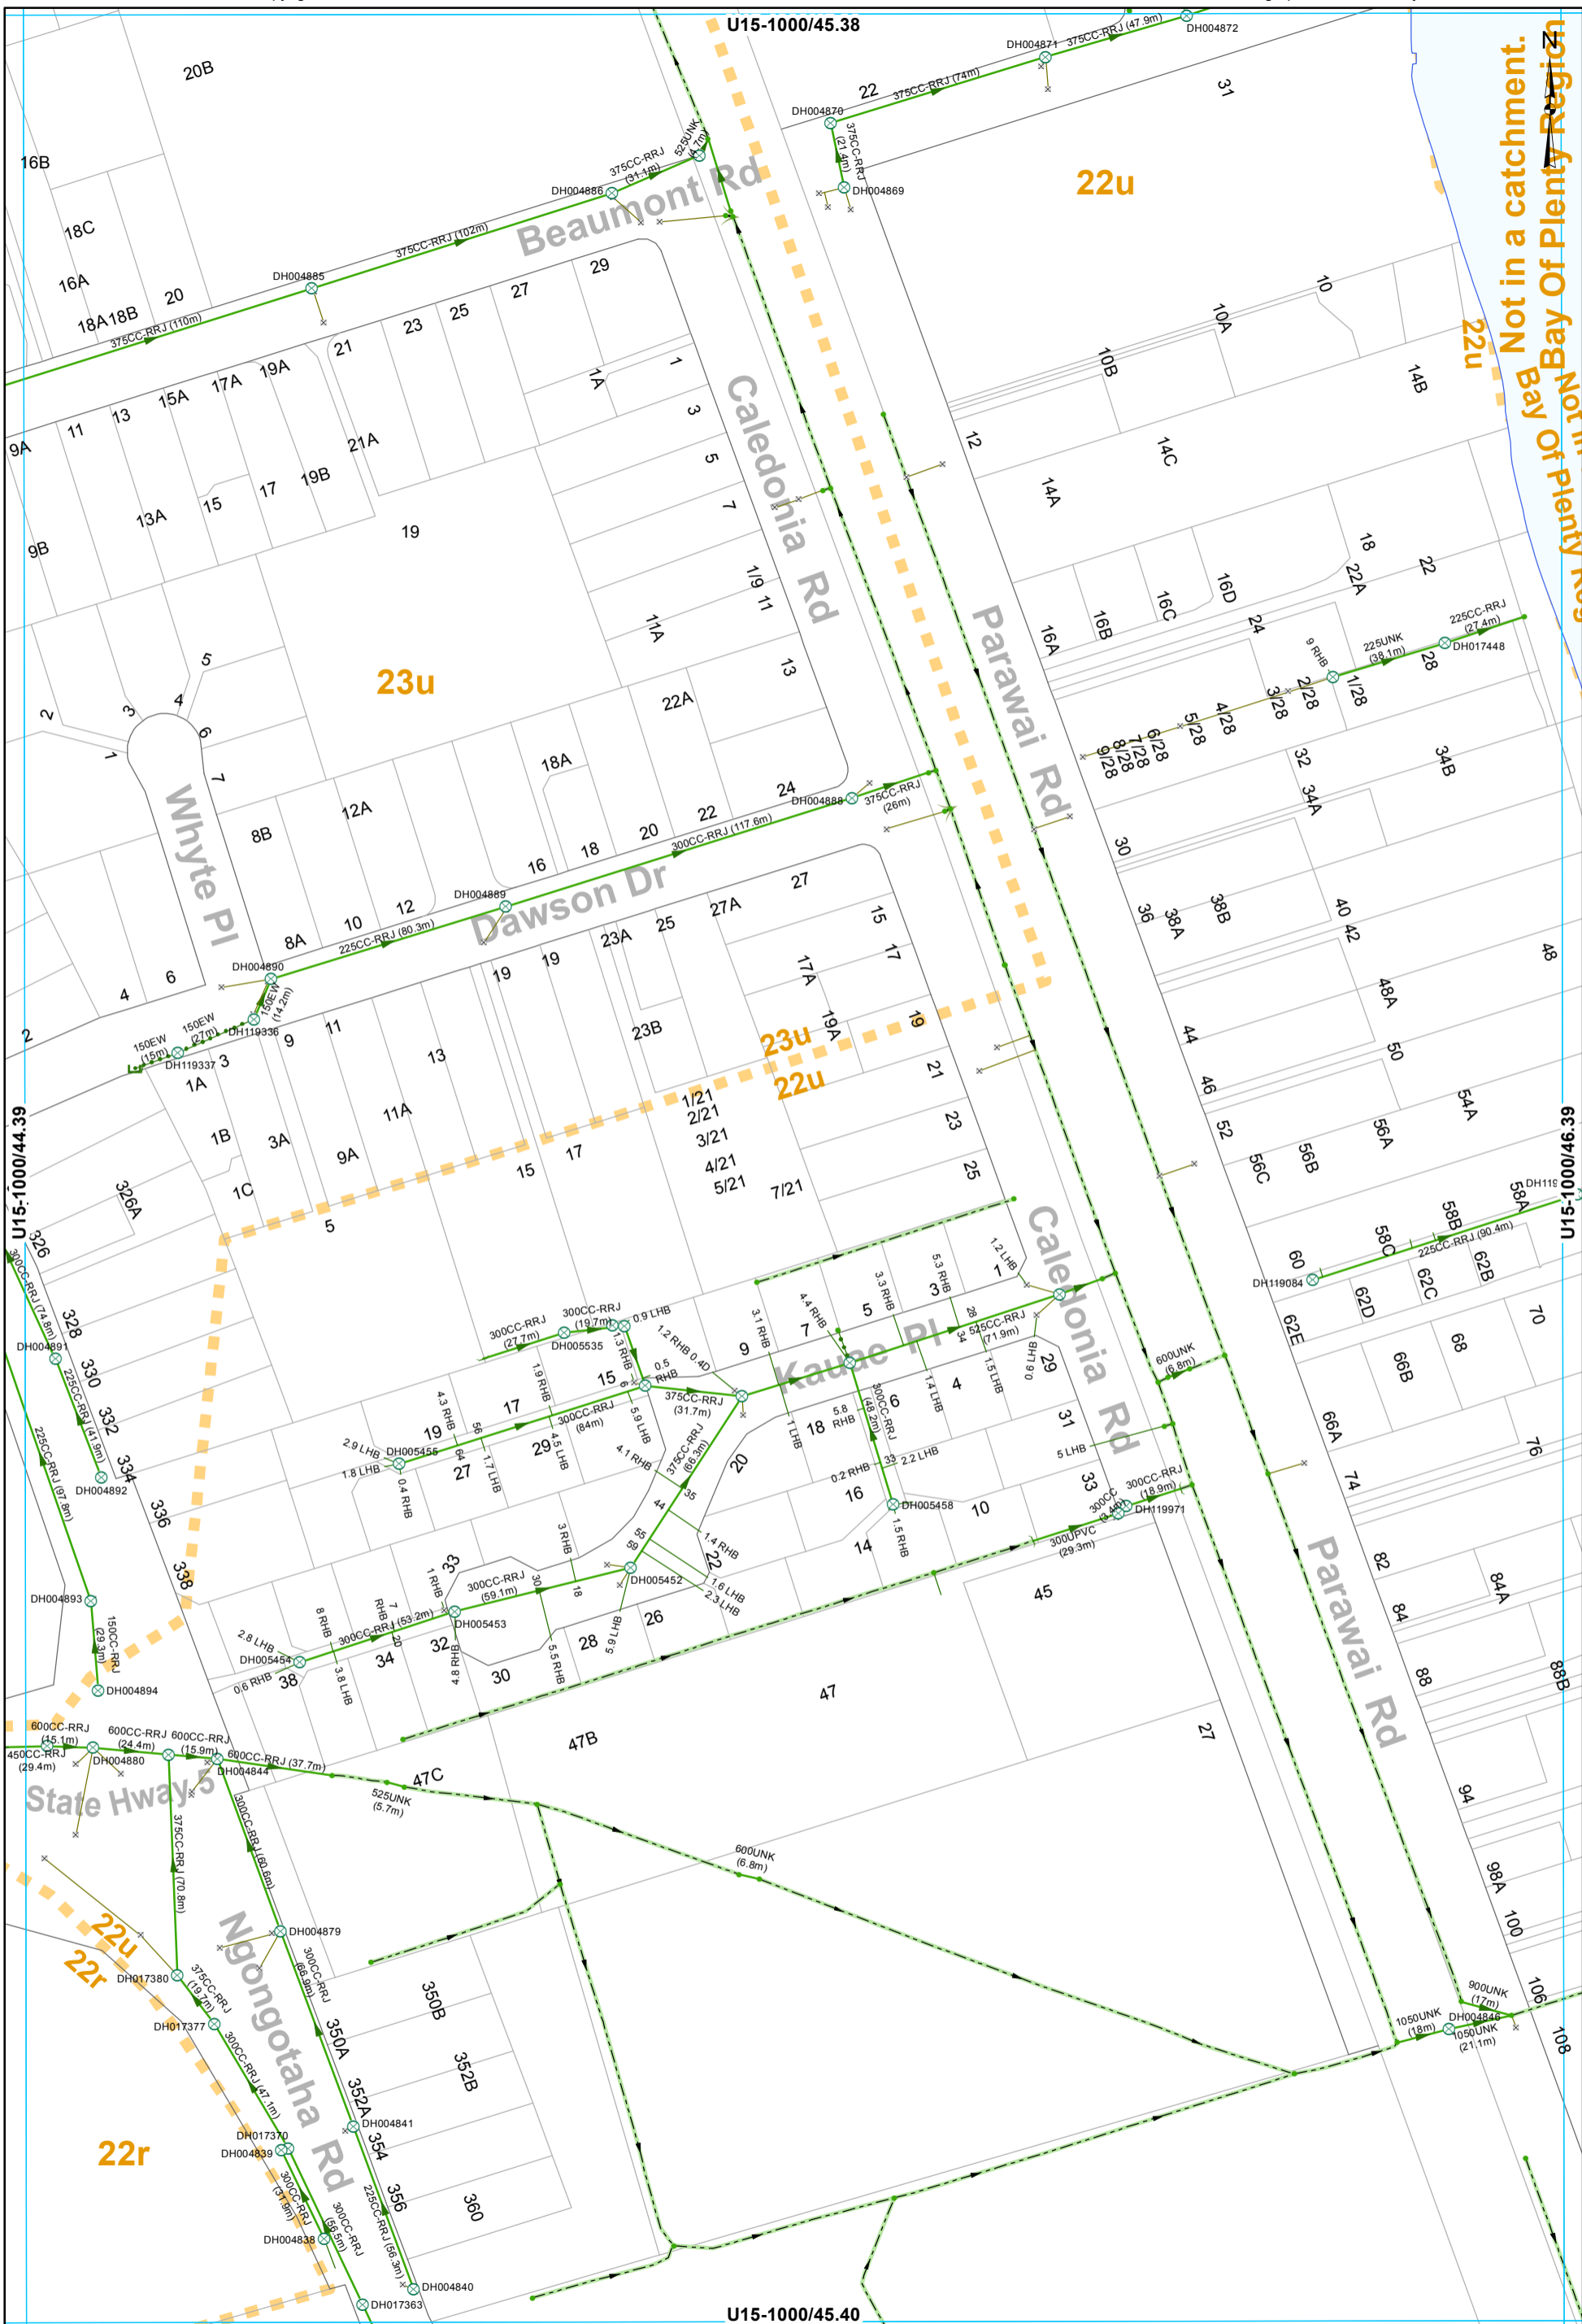


Not in a catchment.
 Bay Of Plenty Region
 Bay Of Plenty Region

- ⊗ SWManhole
- × SWInlet
- Node
- ▭ Capped End
- Headwall Structure
- Open Drain
- Overland Flow
- Culvert
- Gravity Main
- Subsoil Drain
- SWServiceline
- SWServiceline
- SWLead
- ▭ Catchment Boundary

STORMWATER SERVICES
 1:2000 @ A3 - (U15-1000/45.39)

This data is derived from sources outside the control of Rotorua District Council and is for information only. All dimensions and levels should be verified by physical location on-site.

U15-1000/46.38

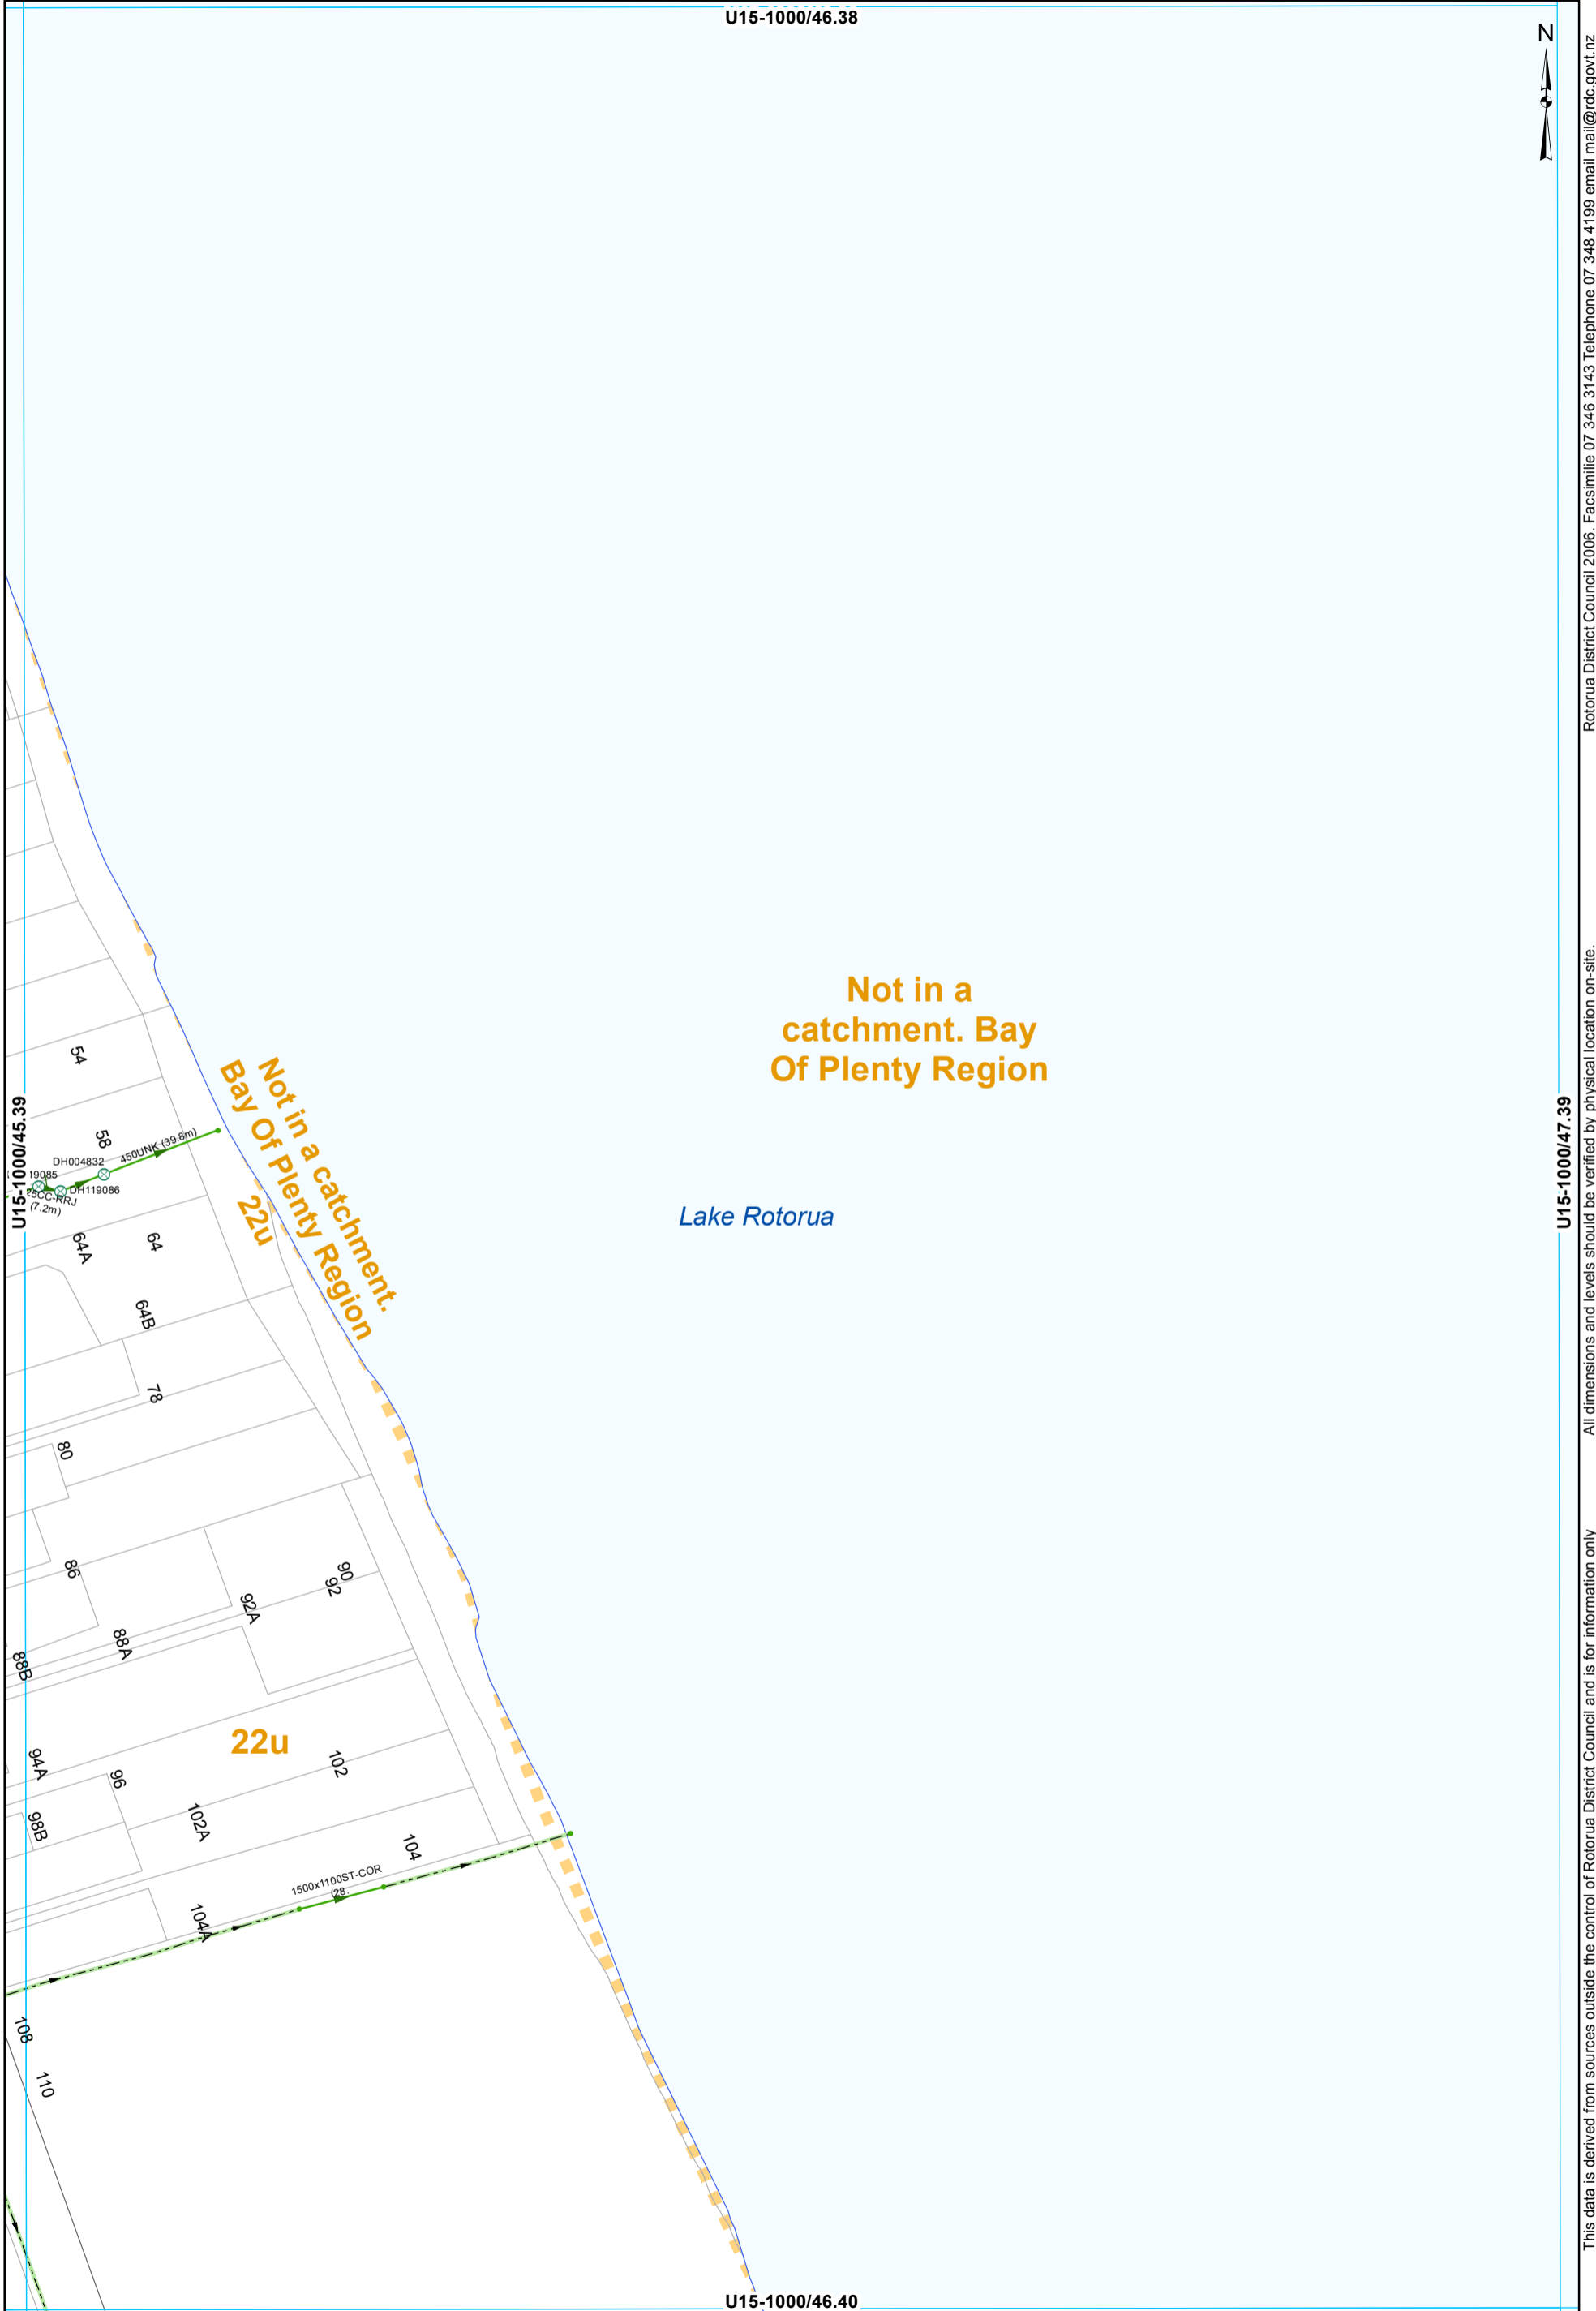

Not in a catchment. Bay Of Plenty Region

Not in a catchment. Bay Of Plenty Region

Lake Rotorua

U15-1000/45.39


U15-1000/47.39

U15-1000/46.40

- ⊗ SWManhole
- Node
- Open Drain
- Gravity Main
- SWServiceline
- SWServiceline
- Catchment Boundary

STORMWATER SERVICES
1:2000 @ A3 - (U15-1000/46.39)

All dimensions and levels should be verified by physical location on-site. Rotorua District Council 2006. Facsimile 07 346 3143 Telephone 07 348 4199 email mail@rdc.govt.nz

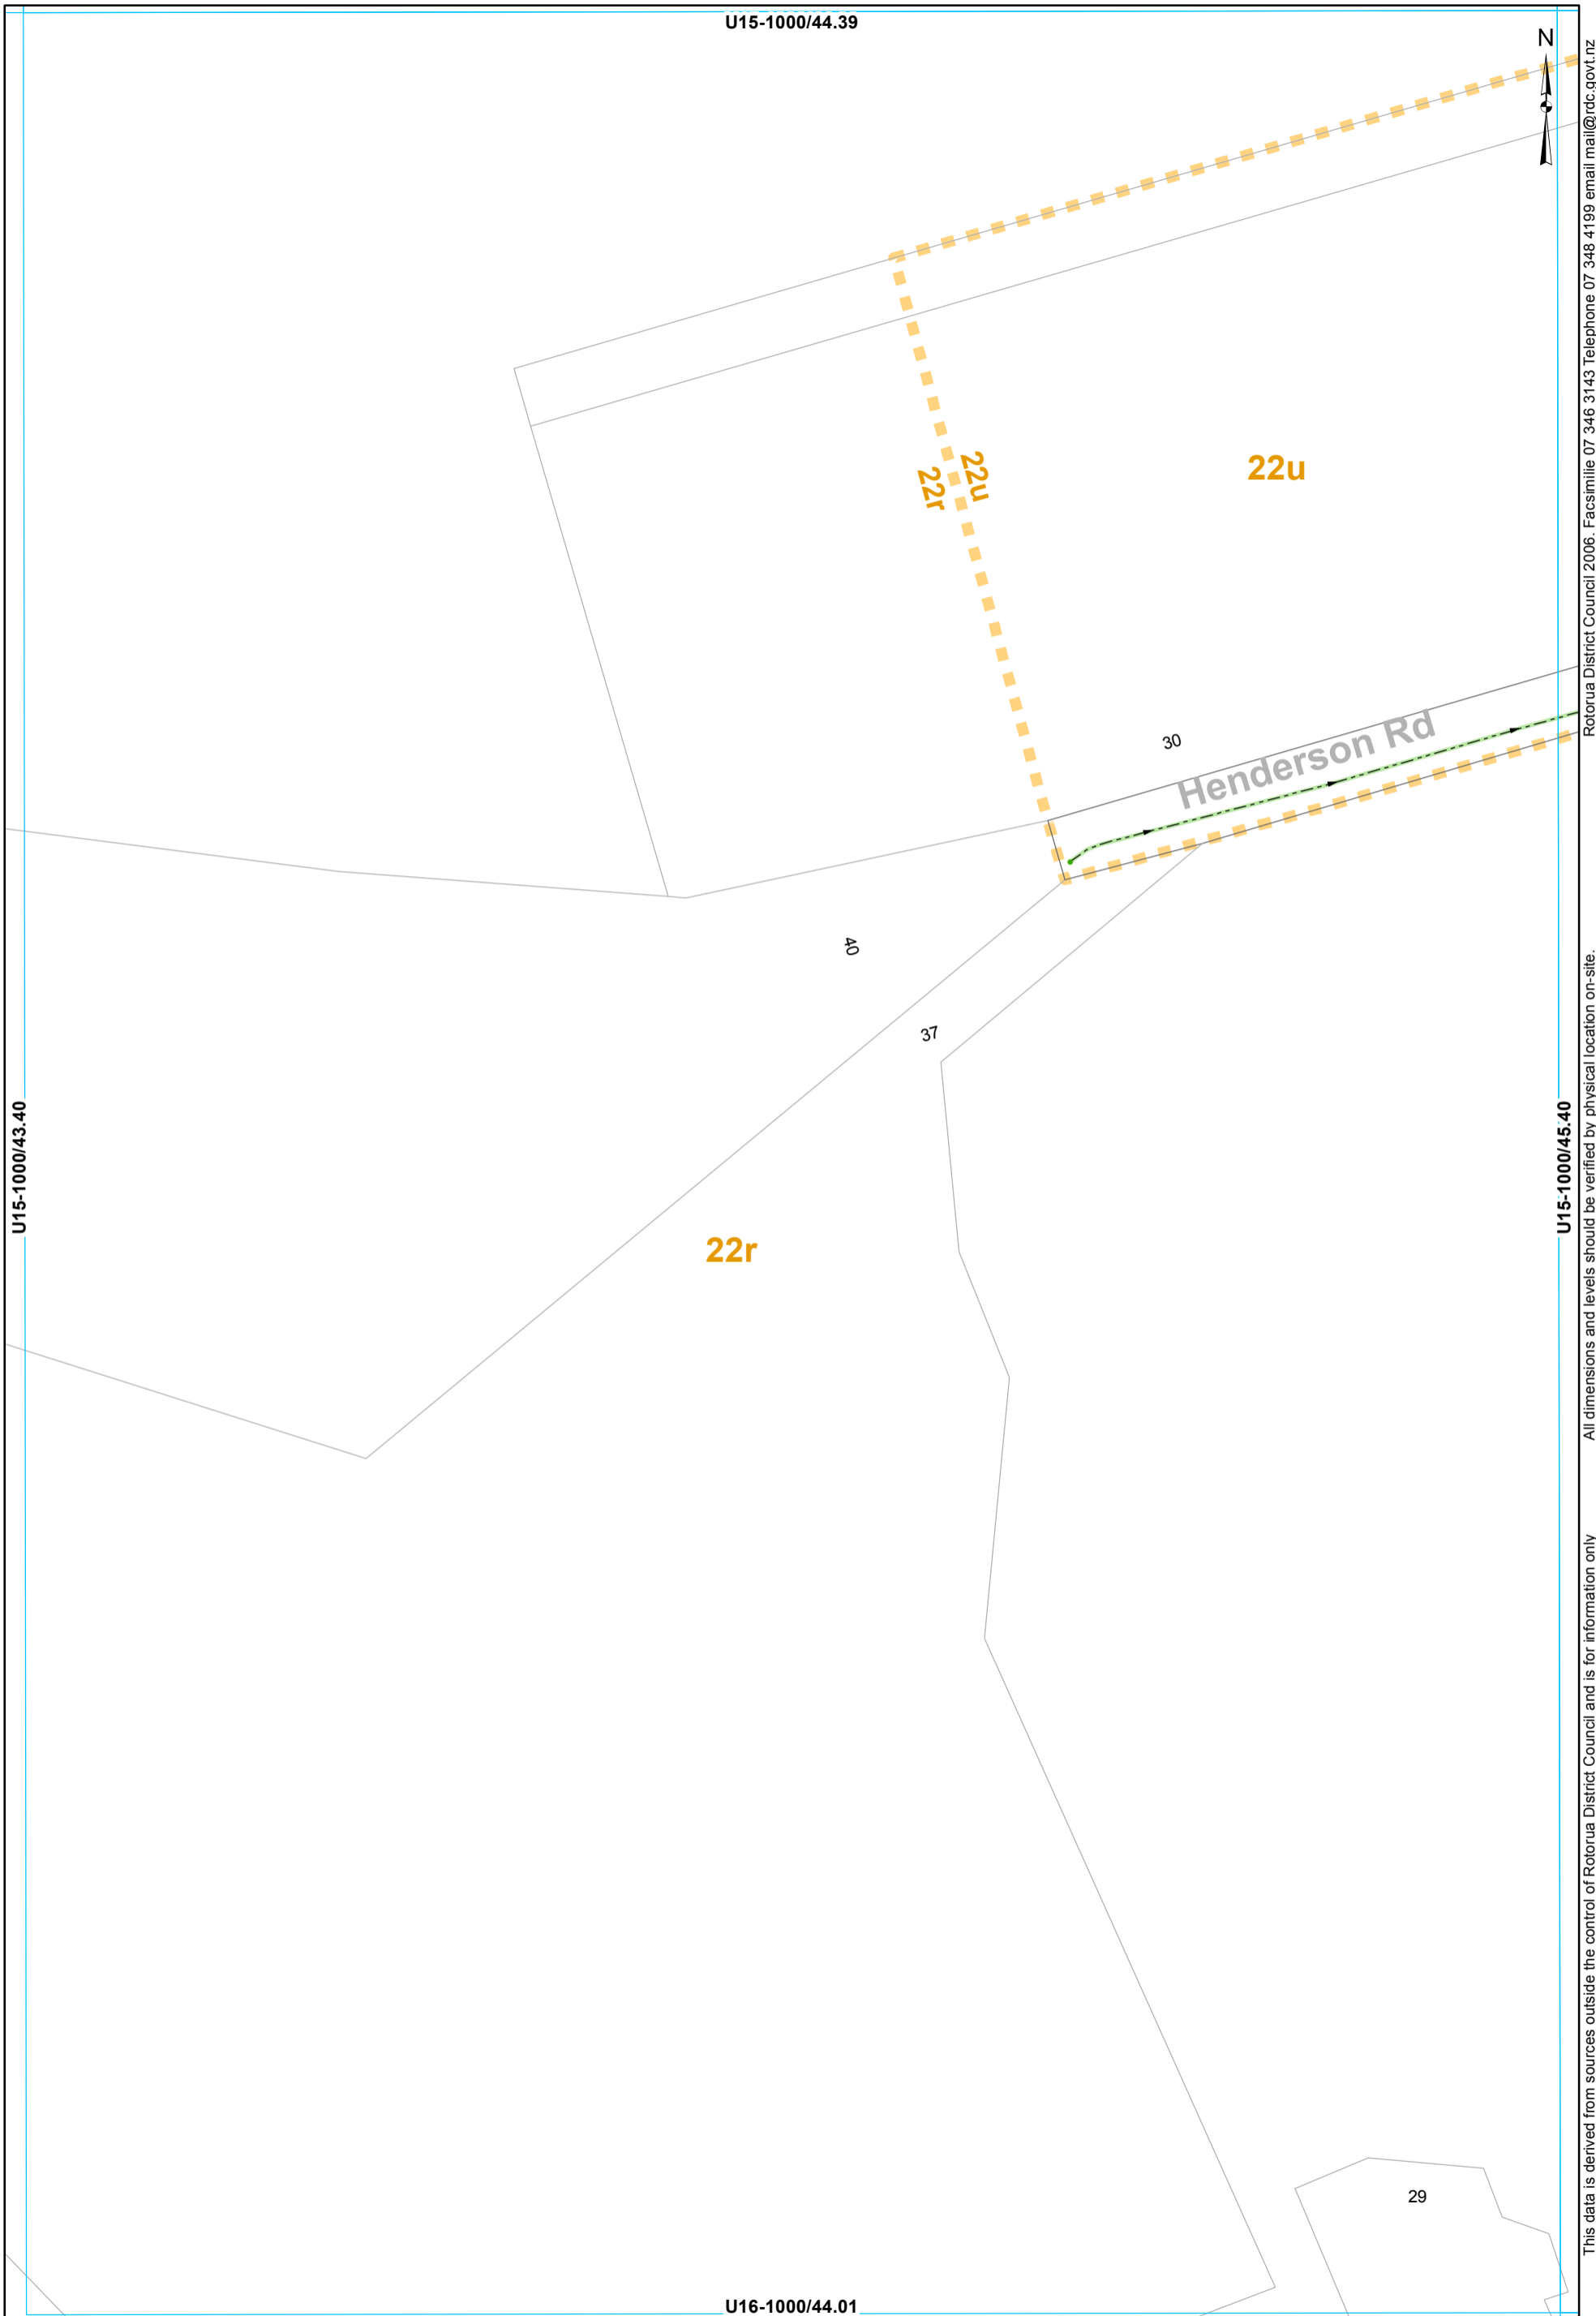


- Node
- Open Drain
- ▬ Catchment Boundary

STORMWATER SERVICES
1:2000 @ A3 - (U15-1000/44.40)

This data is derived from sources outside the control of Rotorua District Council and is for information only

Rotorua District Council 2006. Facsimile 07 346 3143 Telephone 07 348 4199 email mail@rdc.govt.nz

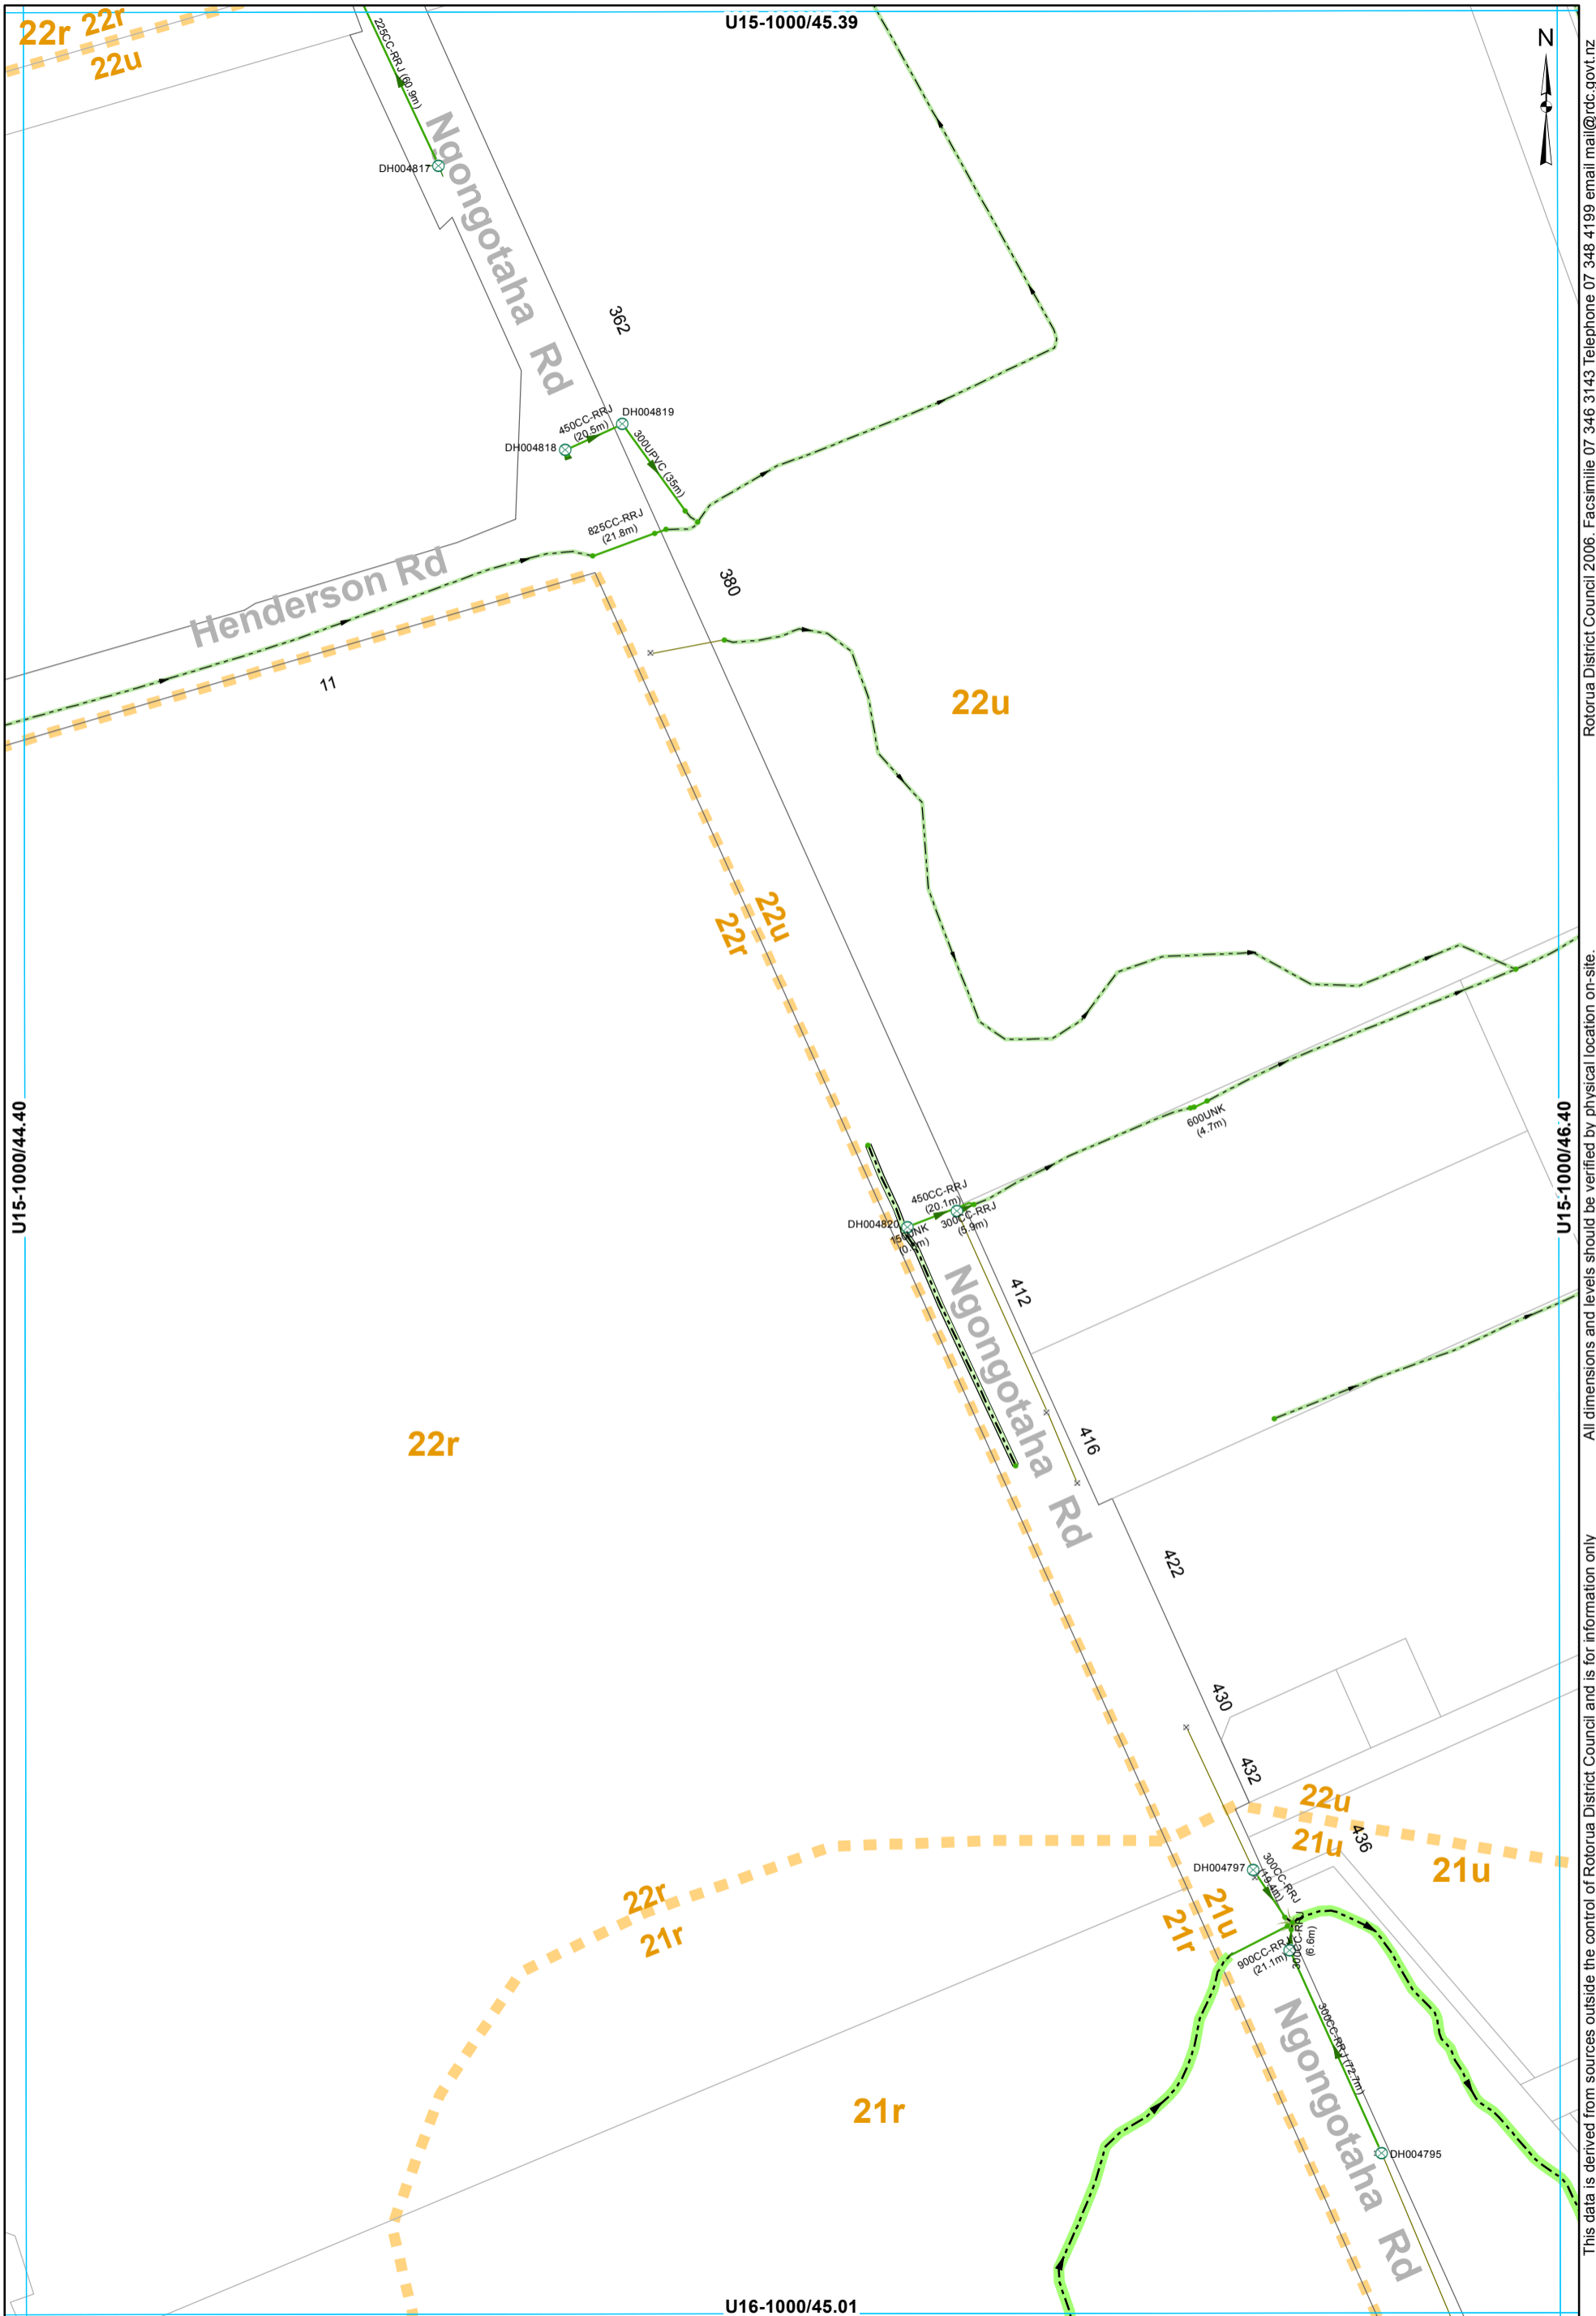


- ⊗ SWManhole
- × SWInlet
- Node
- Headwall Structure
- == Lined Channel
- - - Open Drain
- ≡ Overland Flow
- ≡ Stream
- Culvert
- Gravity Main
- SWServiceline
- SWServiceline
- SWLead
- ▬ Catchment Boundary

STORMWATER SERVICES
1:2000 @ A3 - (U15-1000/45.40)

This data is derived from sources outside the control of Rotorua District Council and is for information only

All dimensions and levels should be verified by physical location on-site.

Rotorua District Council 2006. Facsimile 07 346 3143 Telephone 07 348 4199 email mail@rdc.govt.nz

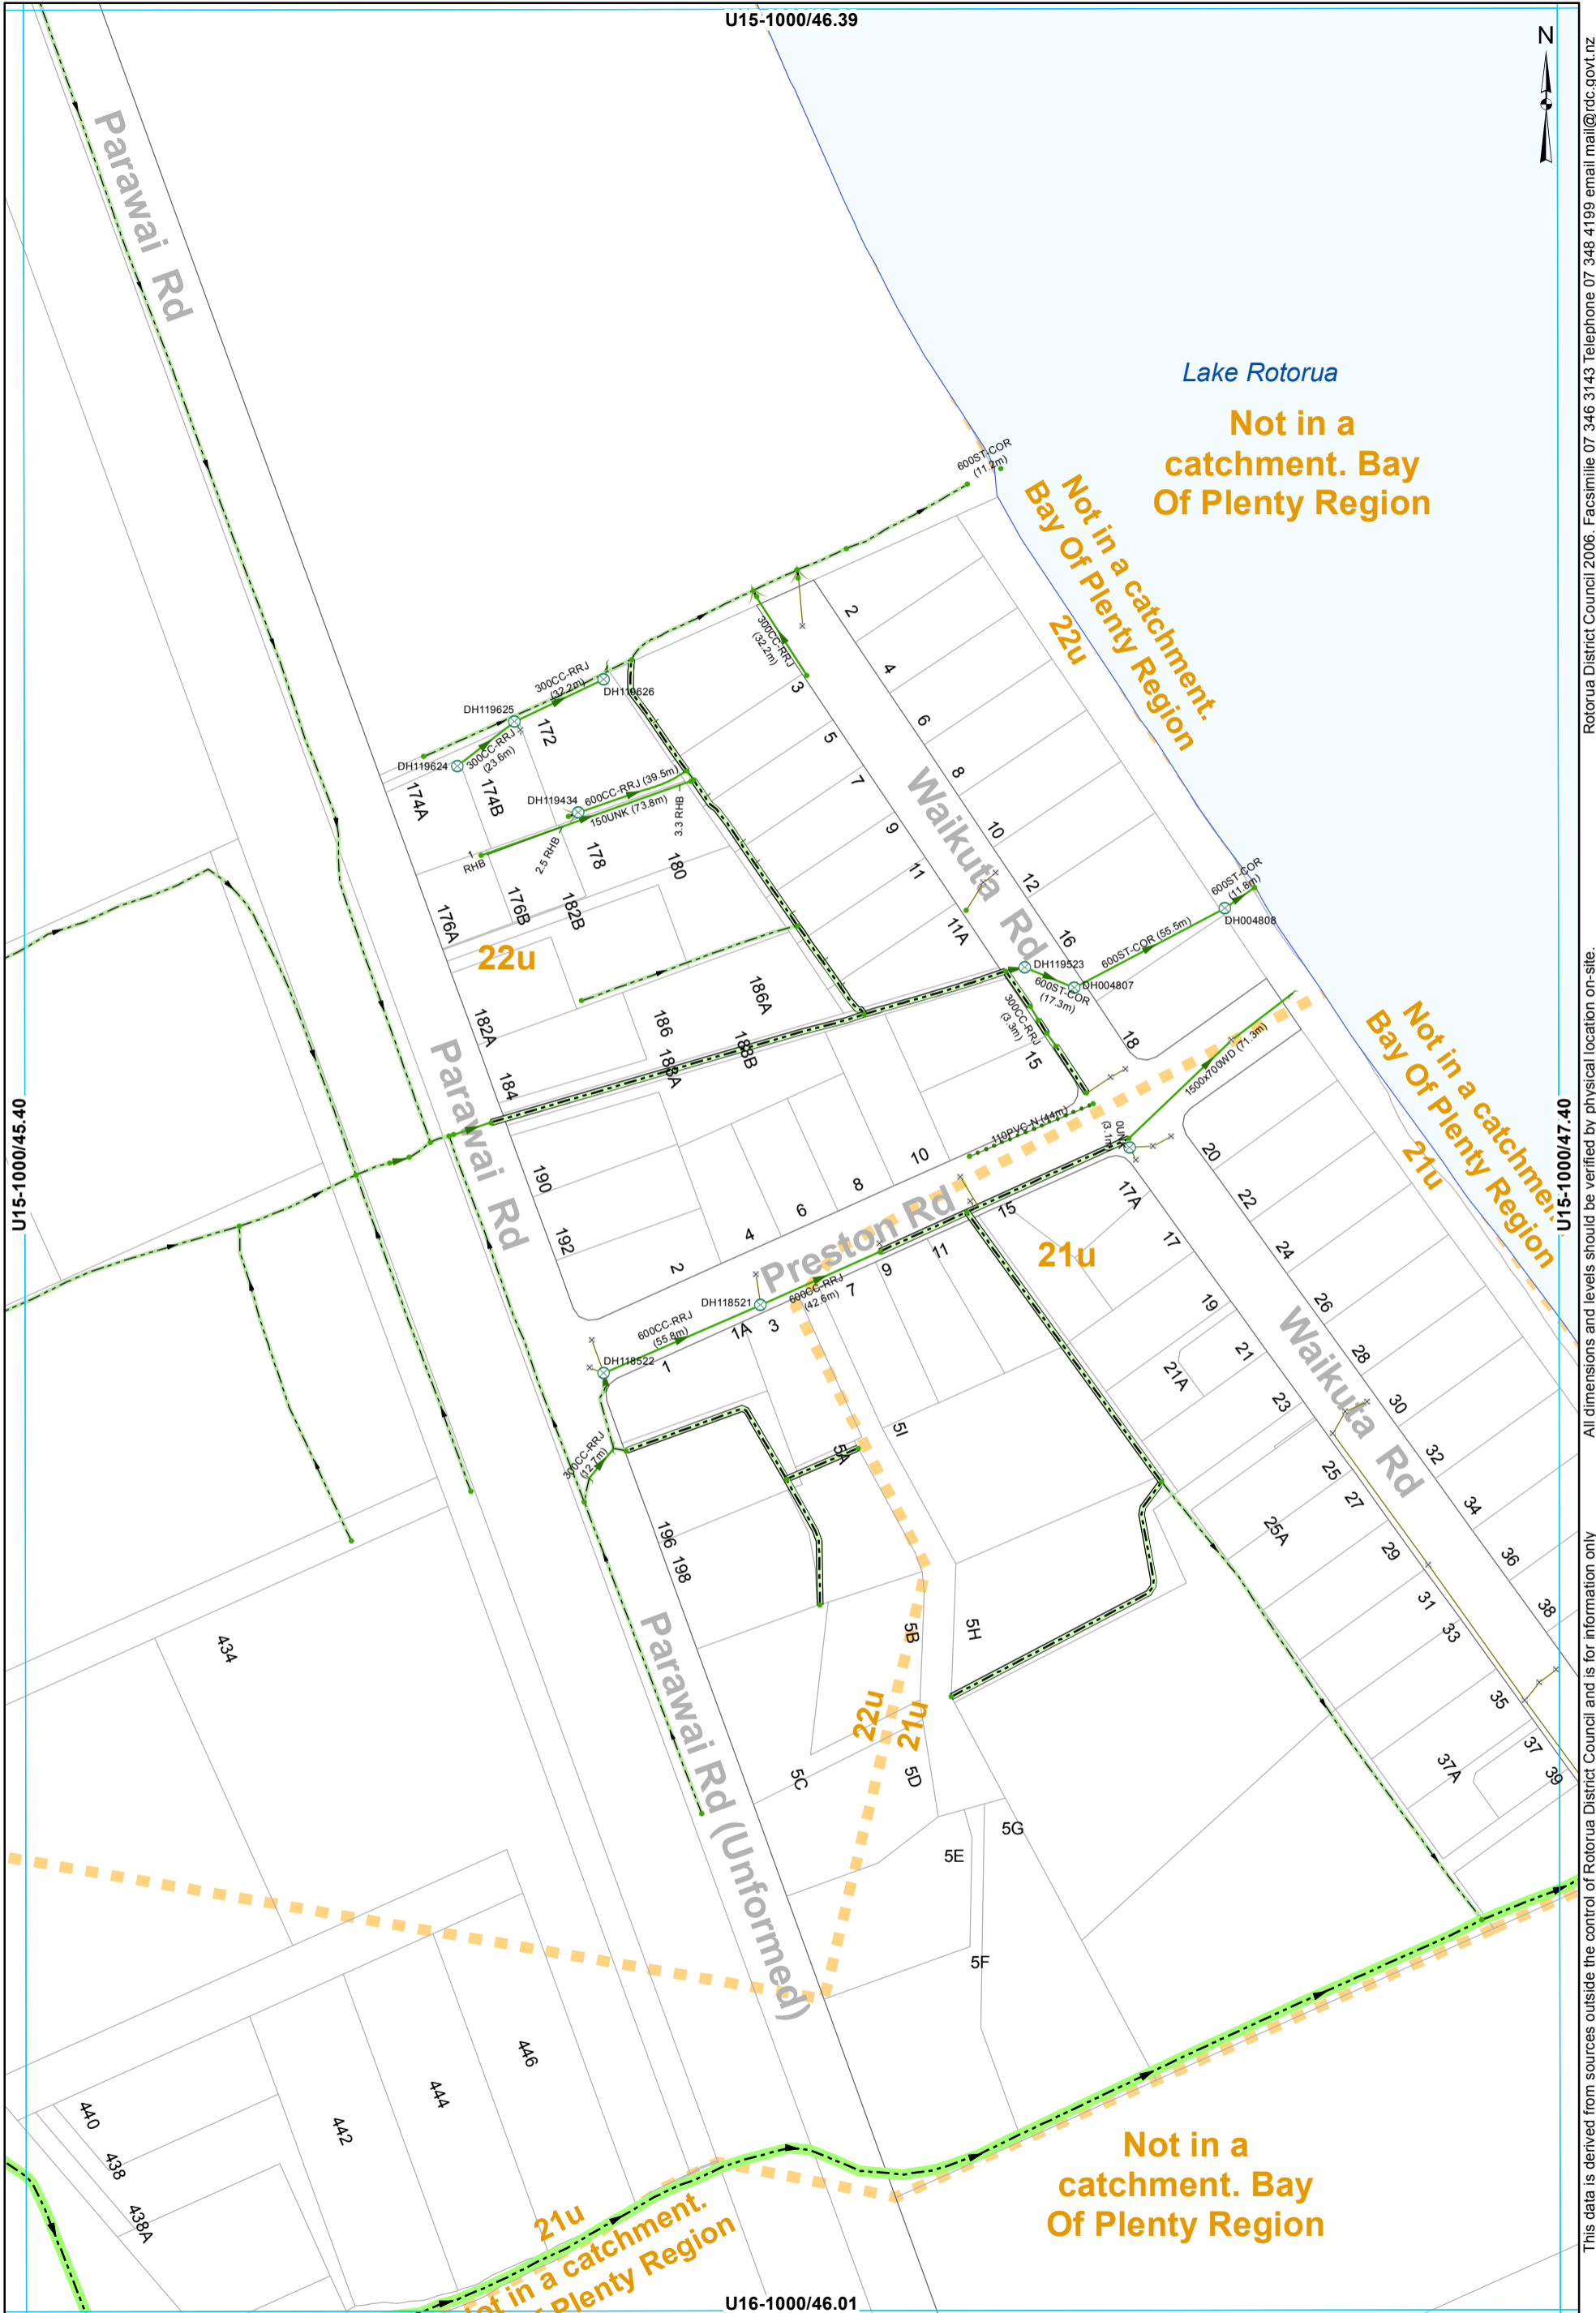

- ⊗ SWManhole
- × SWInlet
- Node
- Headwall Structure
- Lined Channel
- Open Drain
- Overland Flow
- Stream
- Culvert
- Gravity Main
- Subsoil Drain
- SWServiceline
- SWServiceline
- SWLead
- Catchment Boundary

STORMWATER SERVICES
1:2000 @ A3 - (U15-1000/46.40)

This data is derived from sources outside the control of Rotorua District Council and is for information only. All dimensions and levels should be verified by physical location on-site. Rotorua District Council 2006. Facsimile 07 346 3143 Telephone 07 348 4199 email mail@rdc.govt.nz



- ⊗ SWManhole
- ⊗ SWInlet
- Node
- Open Drain
- Stream
- Gravity Main
- Subsoil Drain
- SWServiceline
- SWServiceline
- SWLead
- Catchment Boundary

STORMWATER SERVICES
1:2000 @ A3 - (U15-1000/45.38)

This data is derived from sources outside the control of Rotorua District Council and is for information only

Rotorua District Council 2006. Facsimile 07 346 3143 Telephone 07 348 4199 email mail@rdc.govt.nz

U15-1000/46.37



Lake Rotorua

Not in a catchment. Bay Of Plenty Region

U15-1000/45.38

27u

27u

23u

23u

23u

22u

Not in a catchment. Bay Of Plenty Region

U15-1000/47.38

This data is derived from sources outside the control of Rotorua District Council and is for information only. All dimensions and levels should be verified by physical location on-site.

U15-1000/46.39

- Node
- Stream
- Catchment Boundary



- ⊗ SWManhole
- × SWInlet
- Node
- Open Drain
- Stream
- Gravity Main
- Subsoil Drain
- SWServiceline
- SWServiceline
- SWLead
- Catchment Boundary

STORMWATER SERVICES
1:2000 @ A3 - (U15-1000/45.38)

This data is derived from sources outside the control of Rotorua District Council and is for information only. Rotorua District Council 2006. Facsimile 07 346 3143 Telephone 07 348 4199 email mail@rdc.govt.nz