





Storm Water Asbuilt Sheet Index
SWCatchment 24u



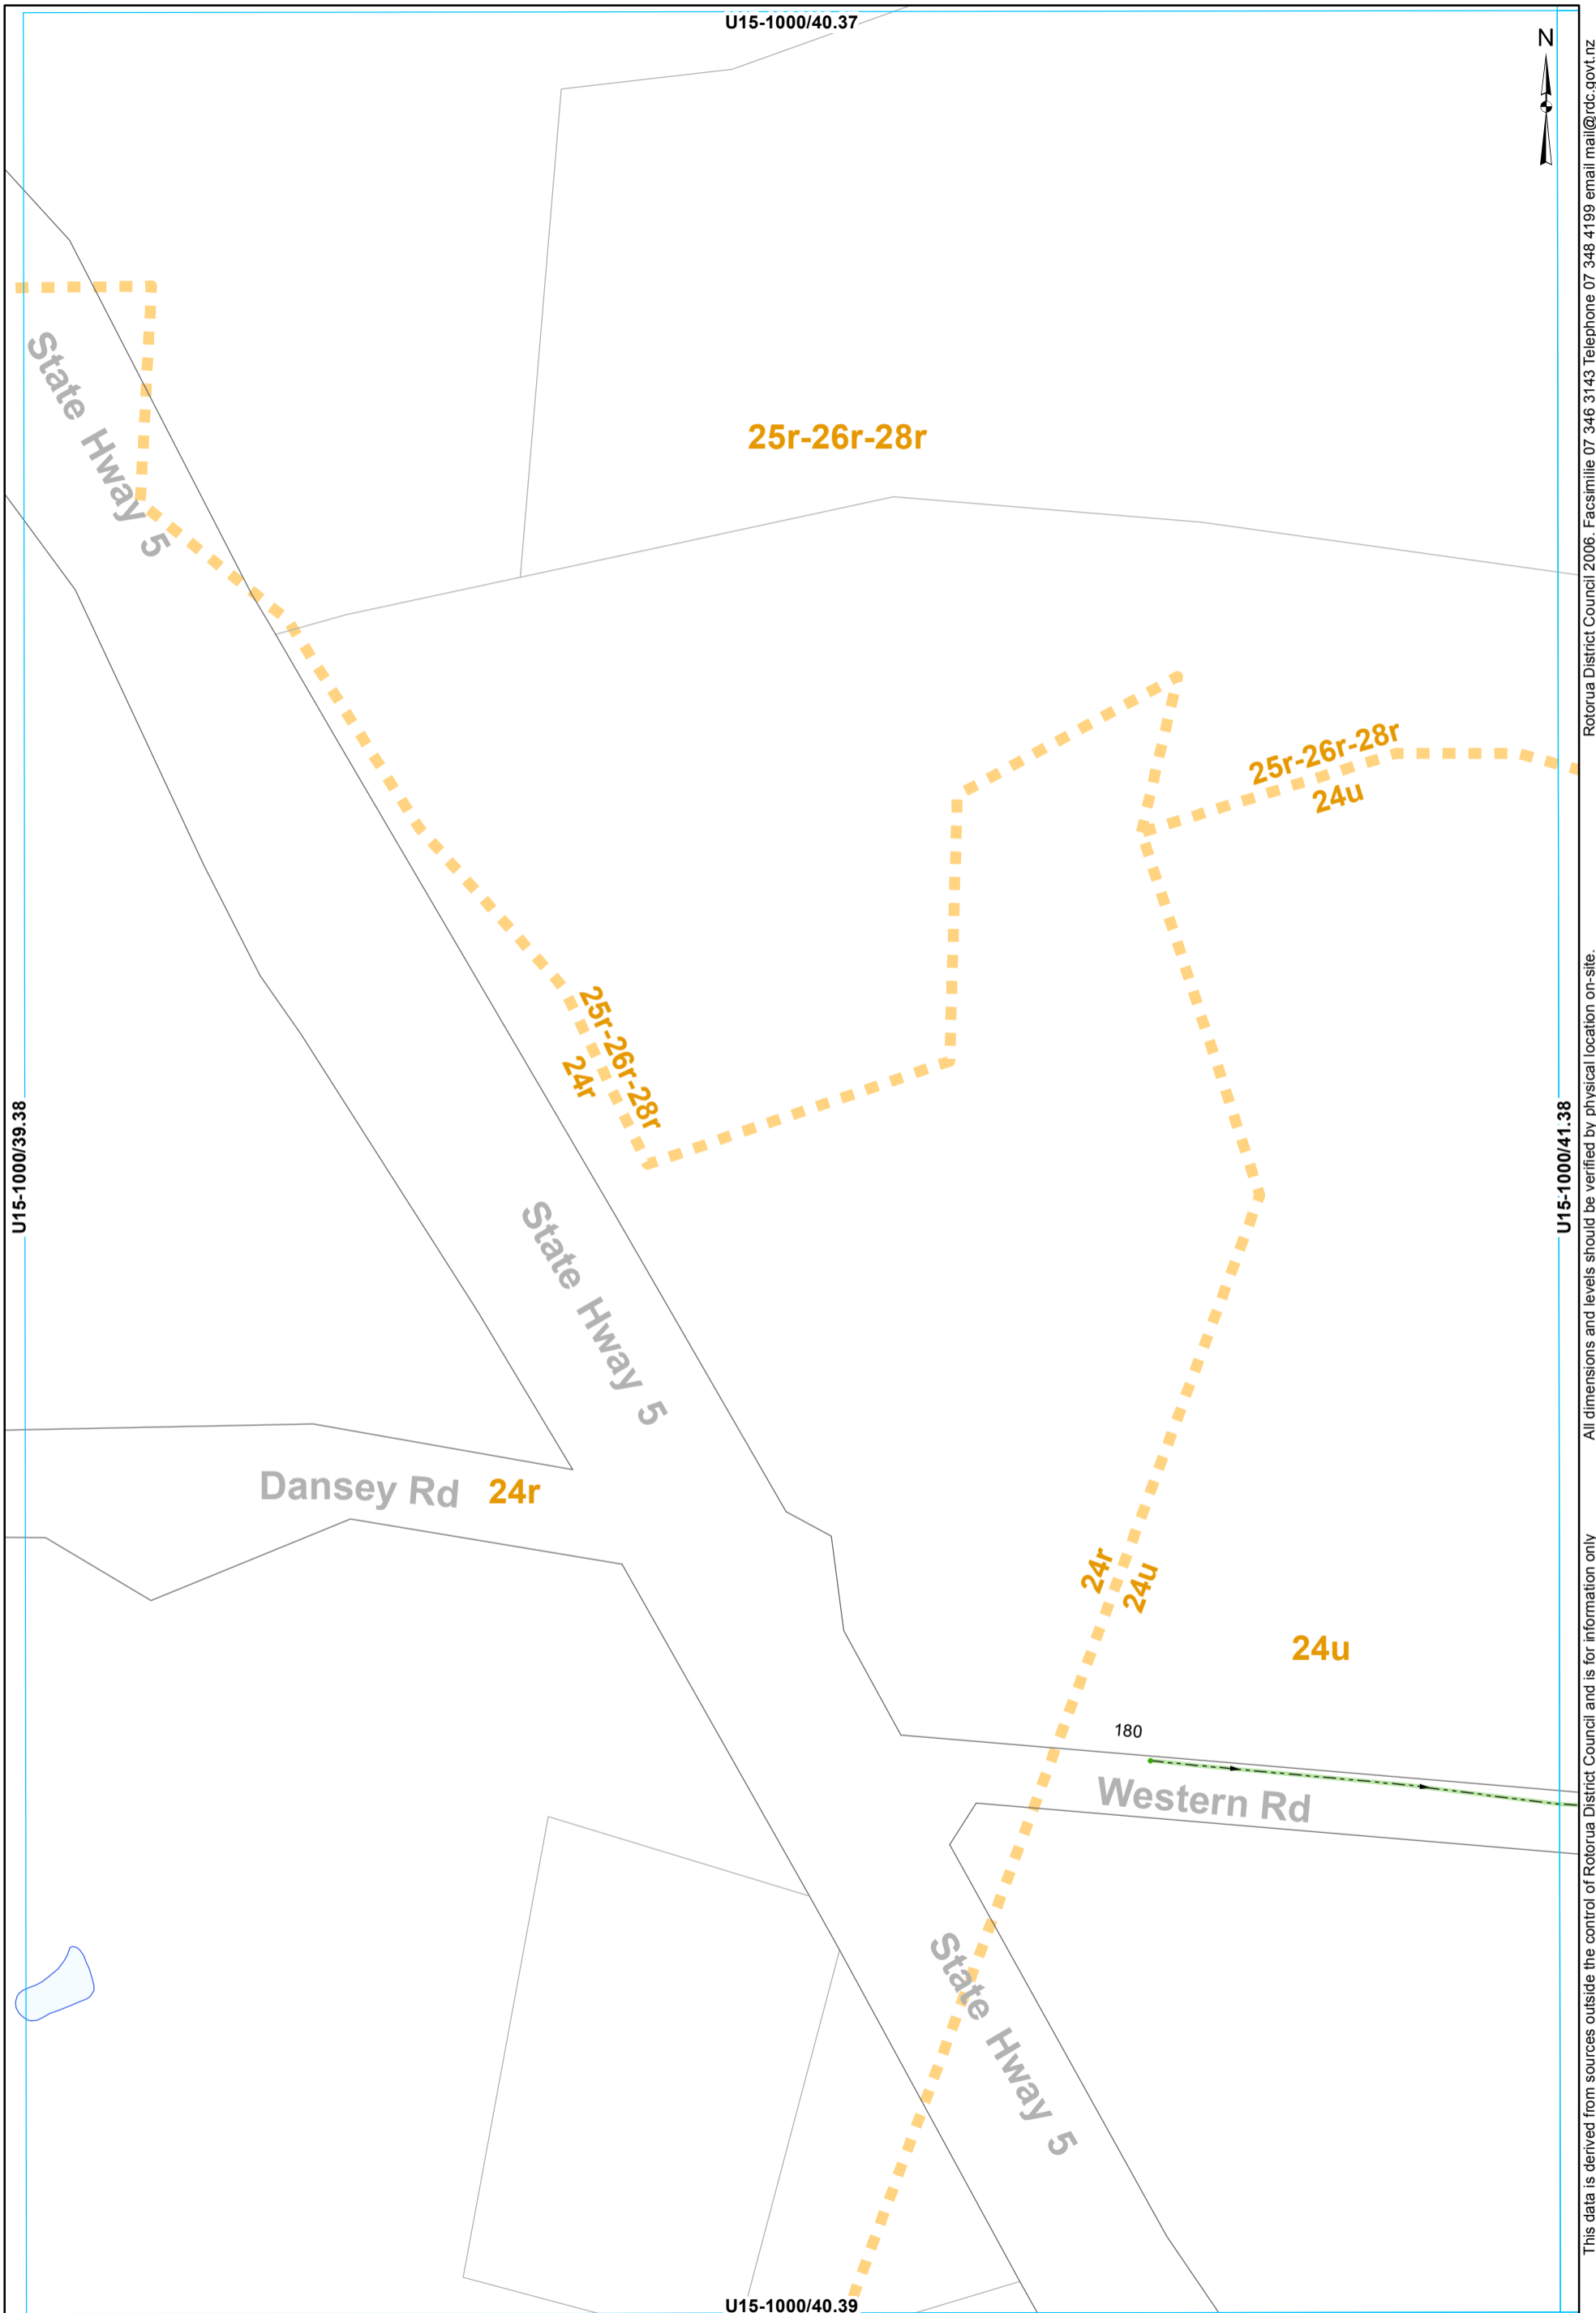

- Node
- Open Drain
- ▬ Catchment Boundary

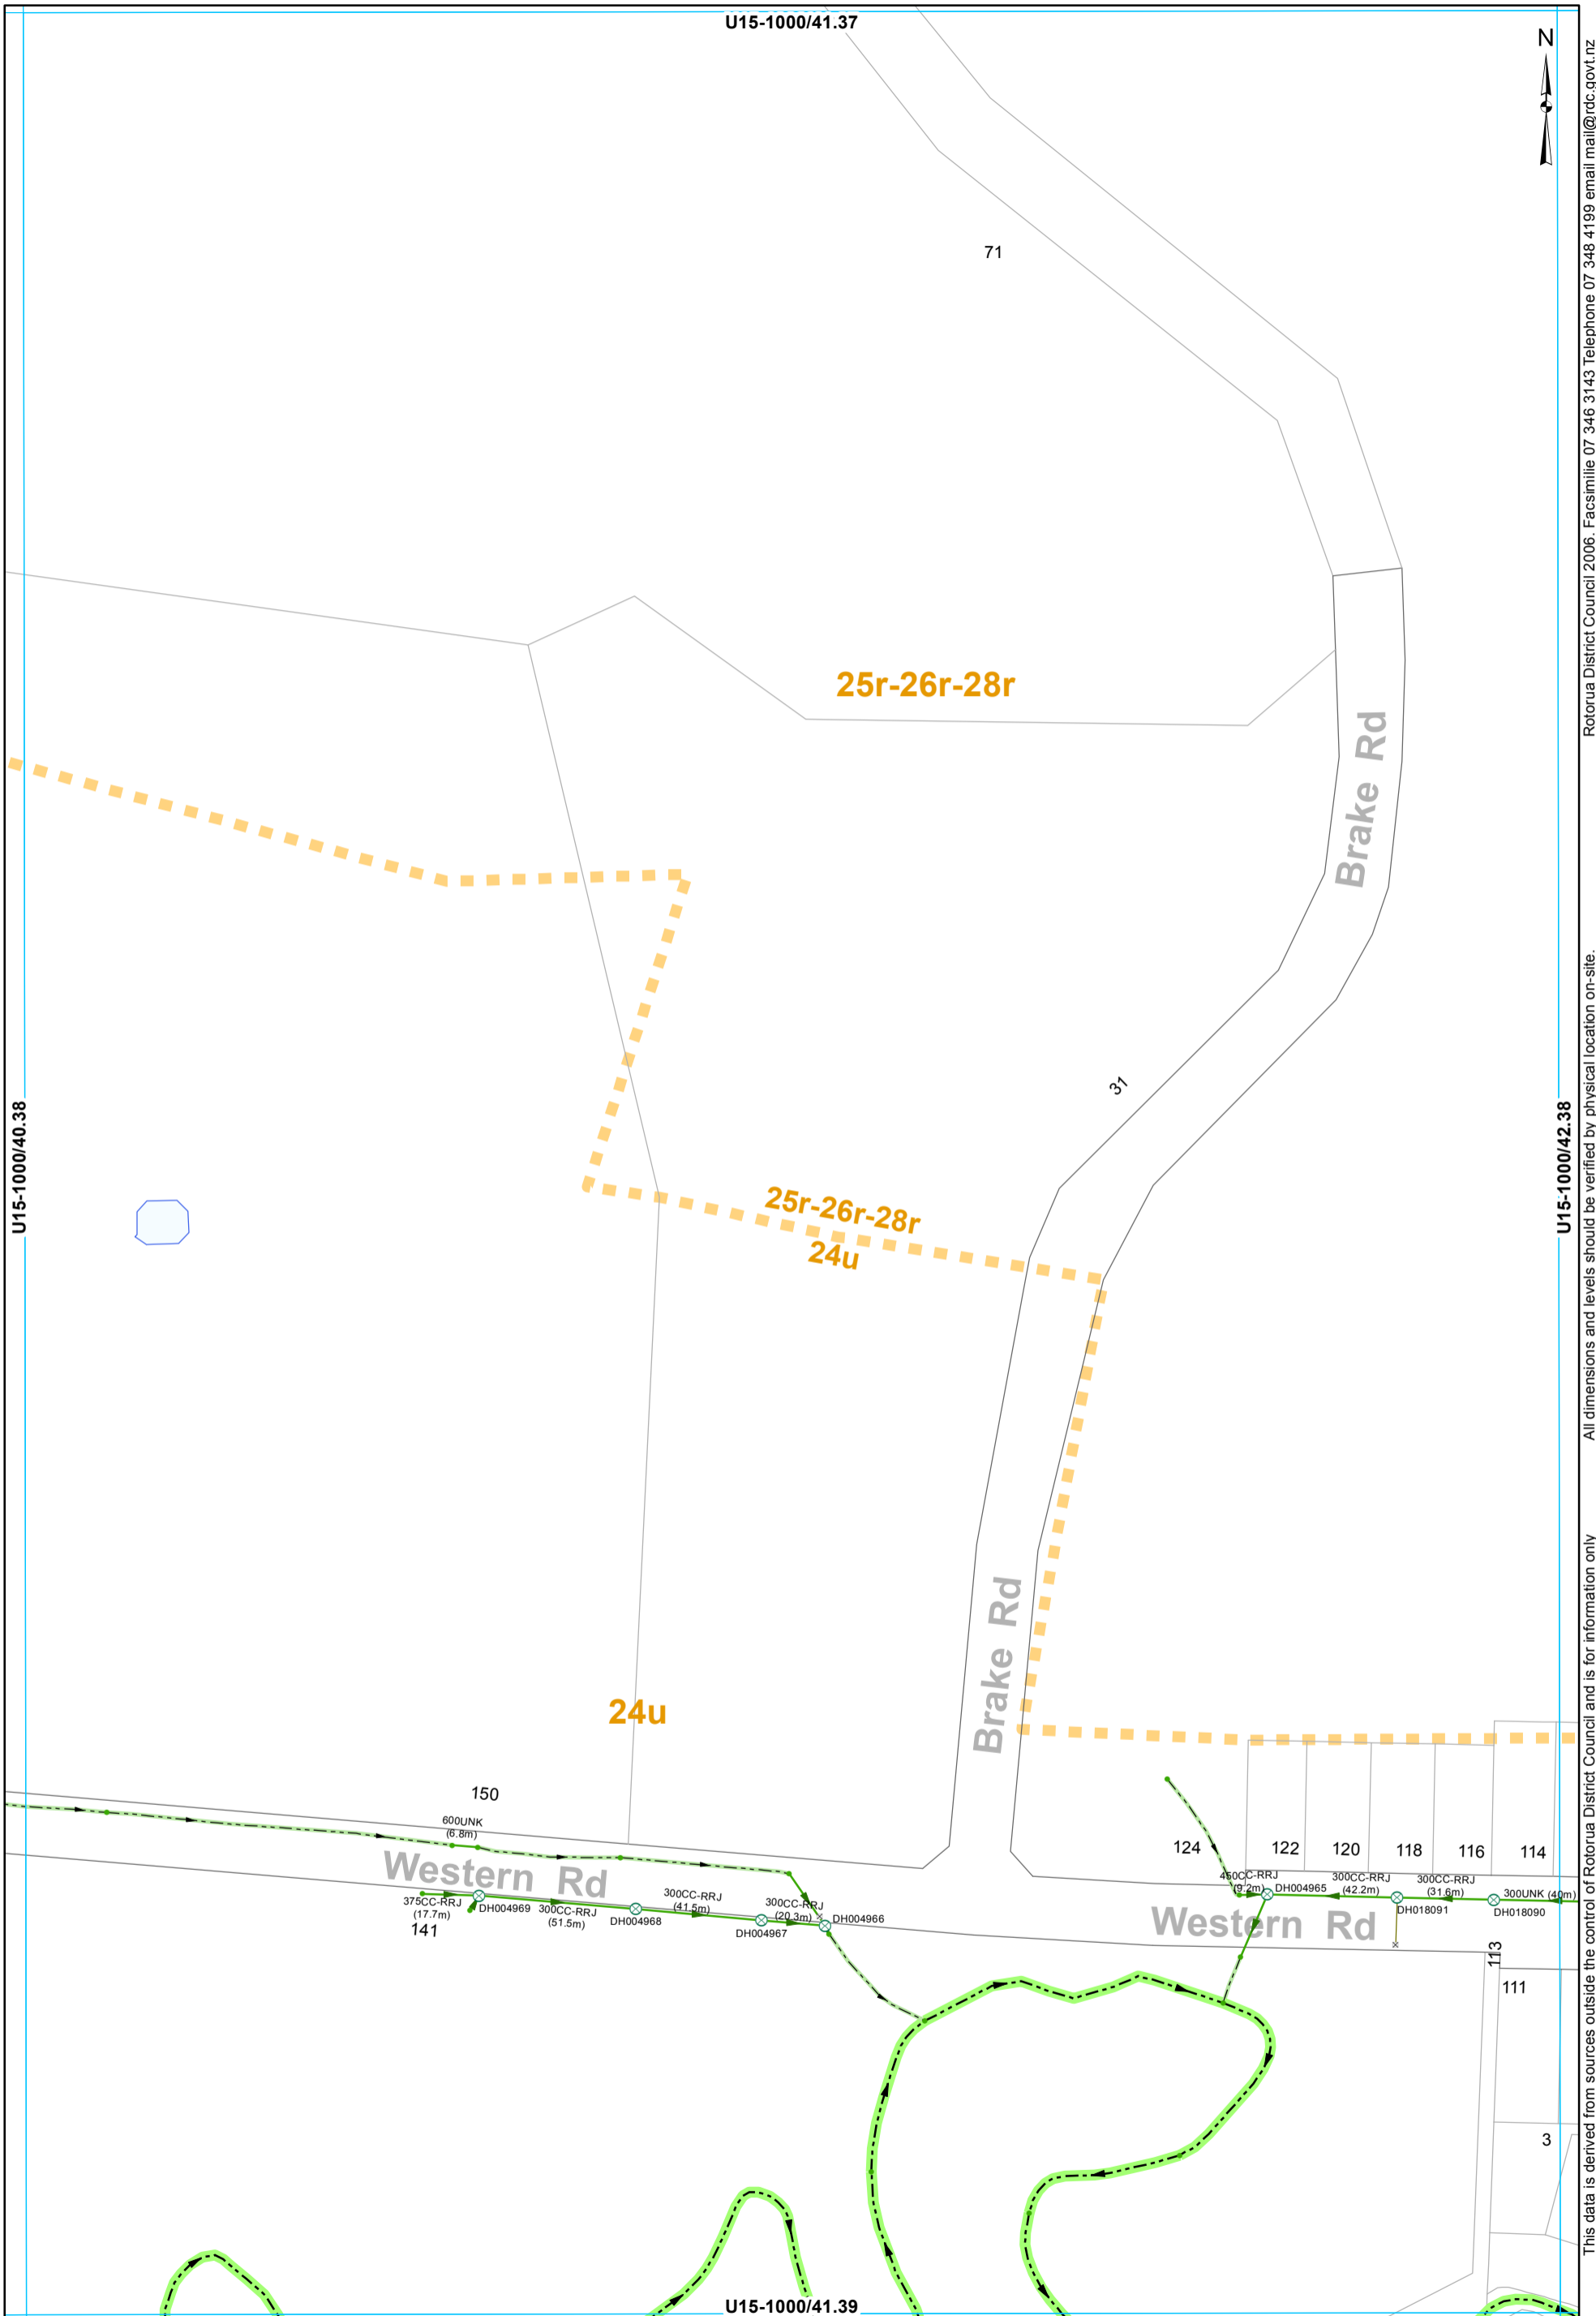


- ⊗ SWManhole
- × SWInlet
- Node
- Open Drain
- Stream
- Culvert
- Gravity Main
- SWLead
- Catchment Boundary

STORMWATER SERVICES
1:2000 @ A3 - (U15-1000/41.38)

This data is derived from sources outside the control of Rotorua District Council and is for information only

All dimensions and levels should be verified by physical location on-site.
 Rotorua District Council 2006. Facsimile 07 346 3143 Telephone 07 348 4199 email mail@rdc.govt.nz

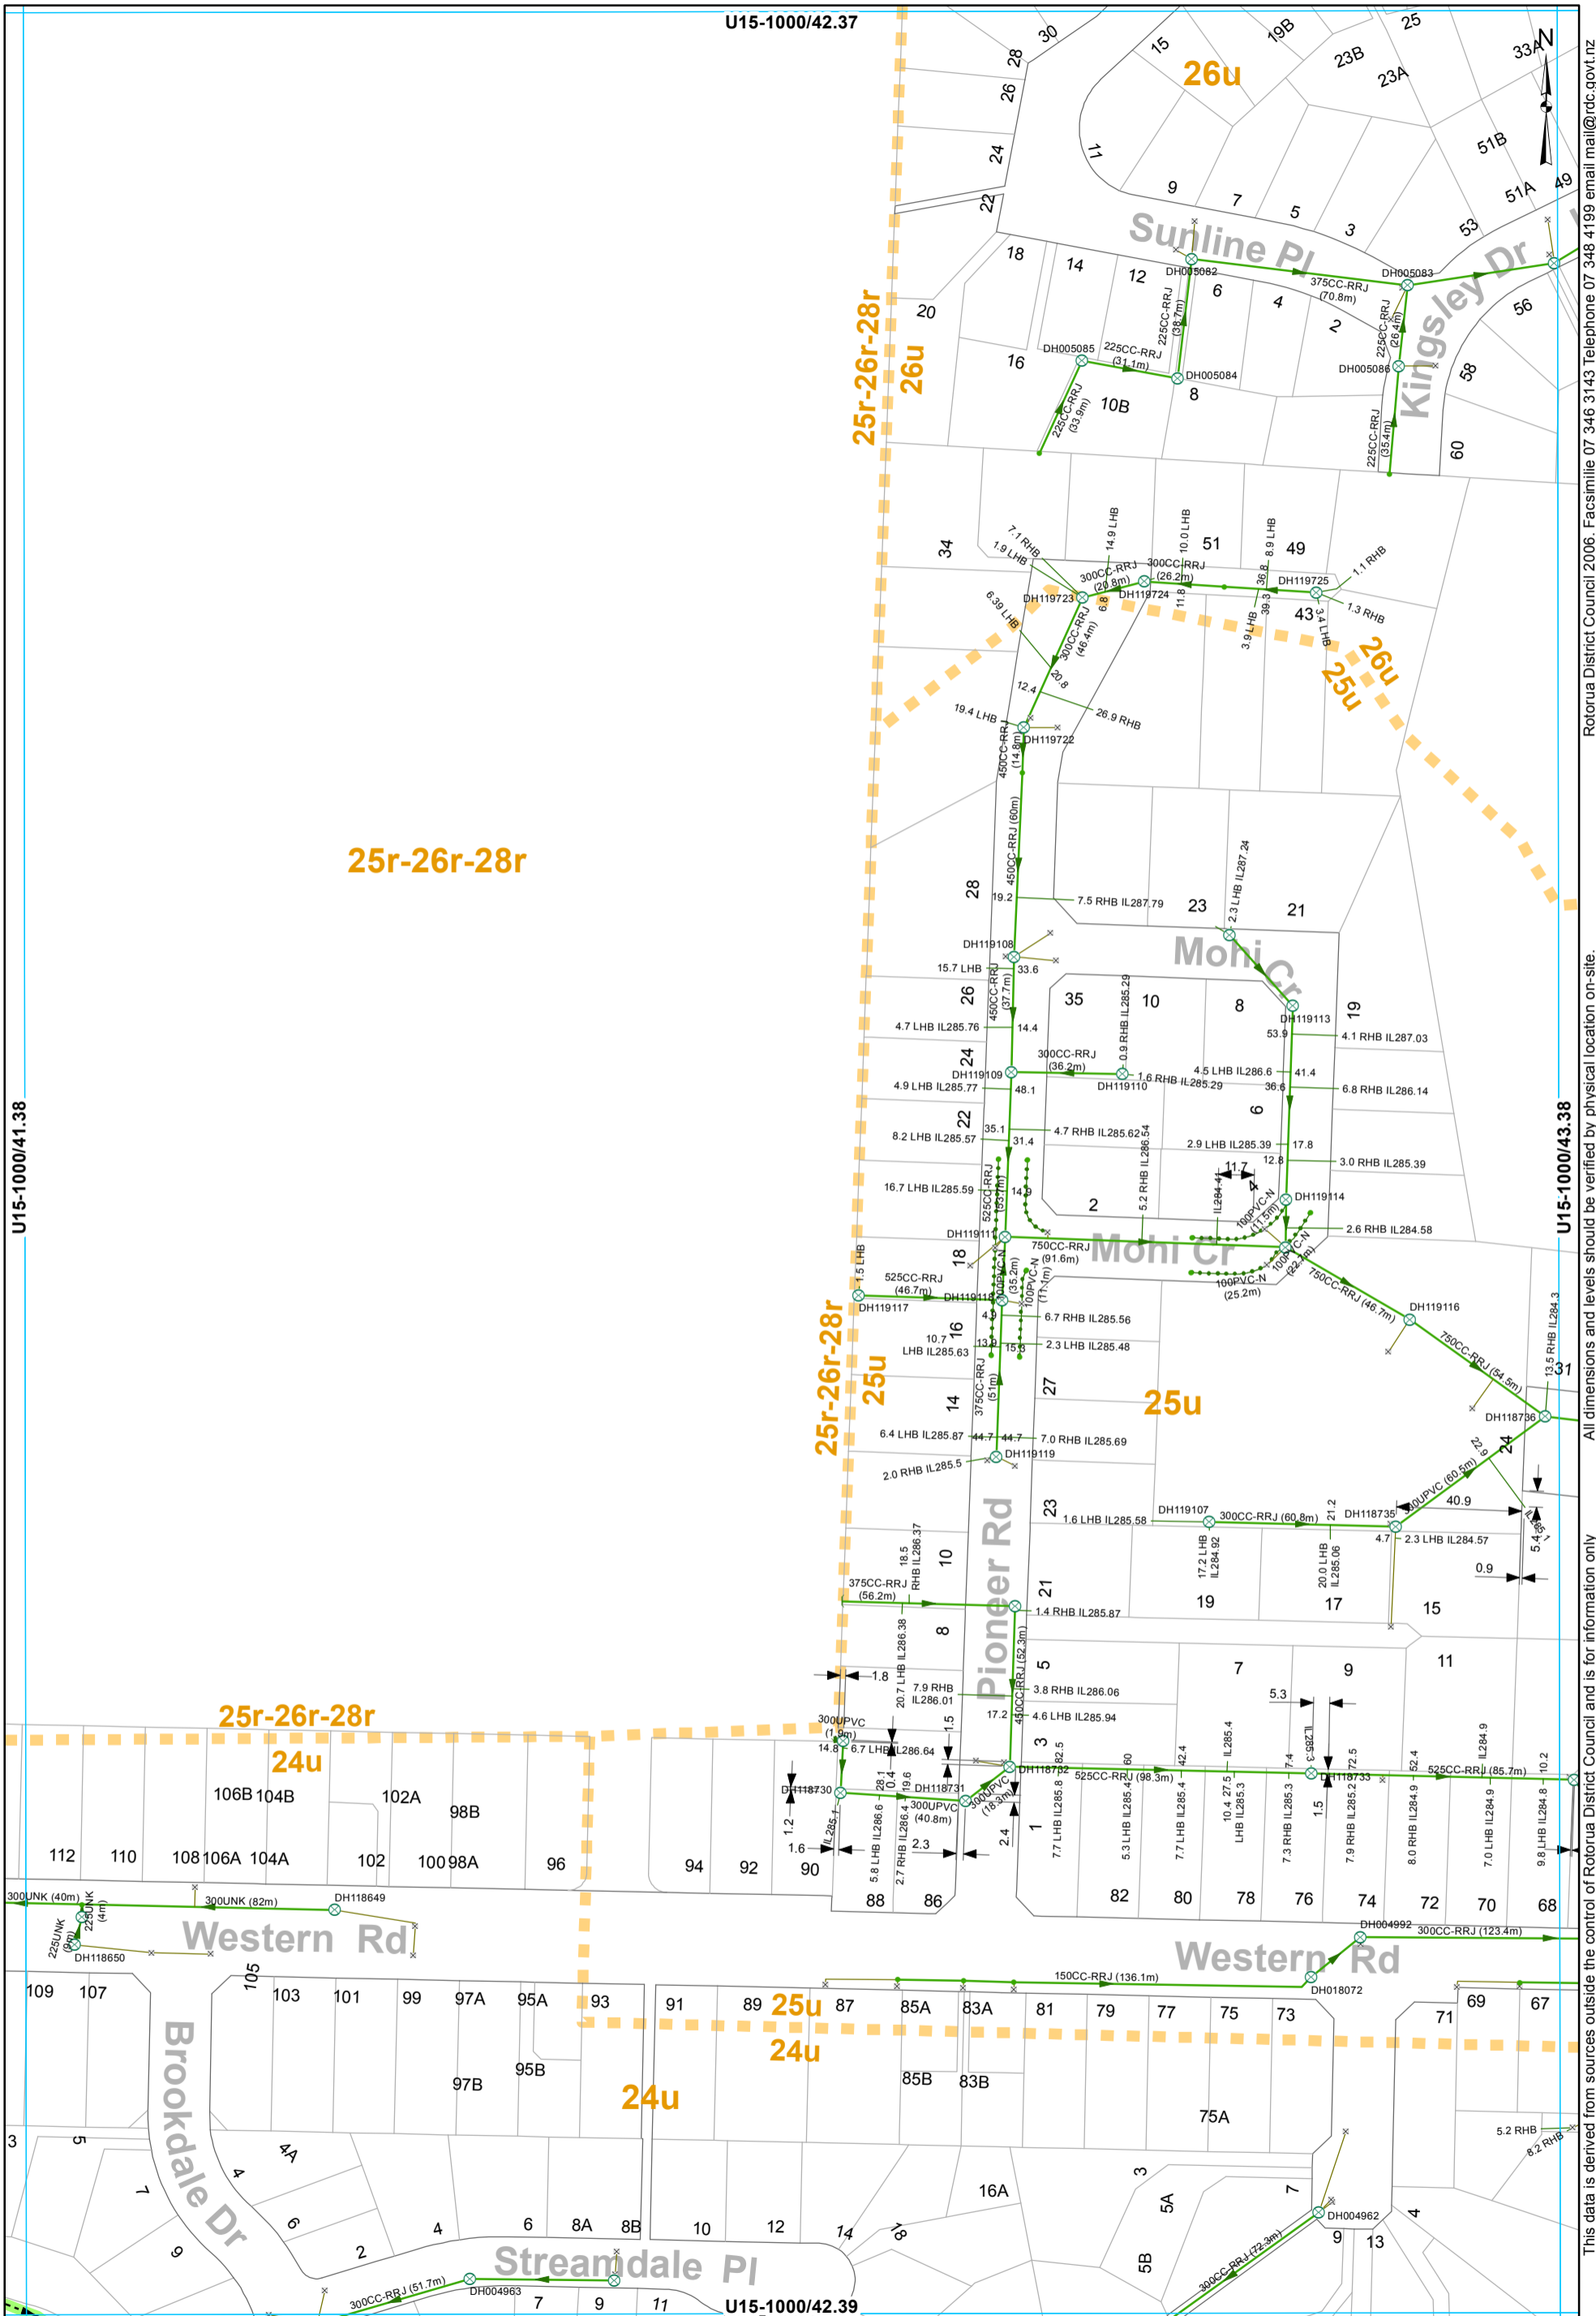


- ⊗ SWManhole
- ⊗ SWInlet
- Node
- Headwall Structure
- Stream
- Gravity Main
- ⋯ Subsoil Drain
- SWServiceline
- SWServiceline
- SWLead
- Catchment Boundary

STORMWATER SERVICES
1:2000 @ A3 - (U15-1000/42.38)

All dimensions and levels should be verified by physical location on-site.

Rotorua District Council 2006. Facsimile 07 346 3143 Telephone 07 348 4199 email mail@rdc.govt.nz

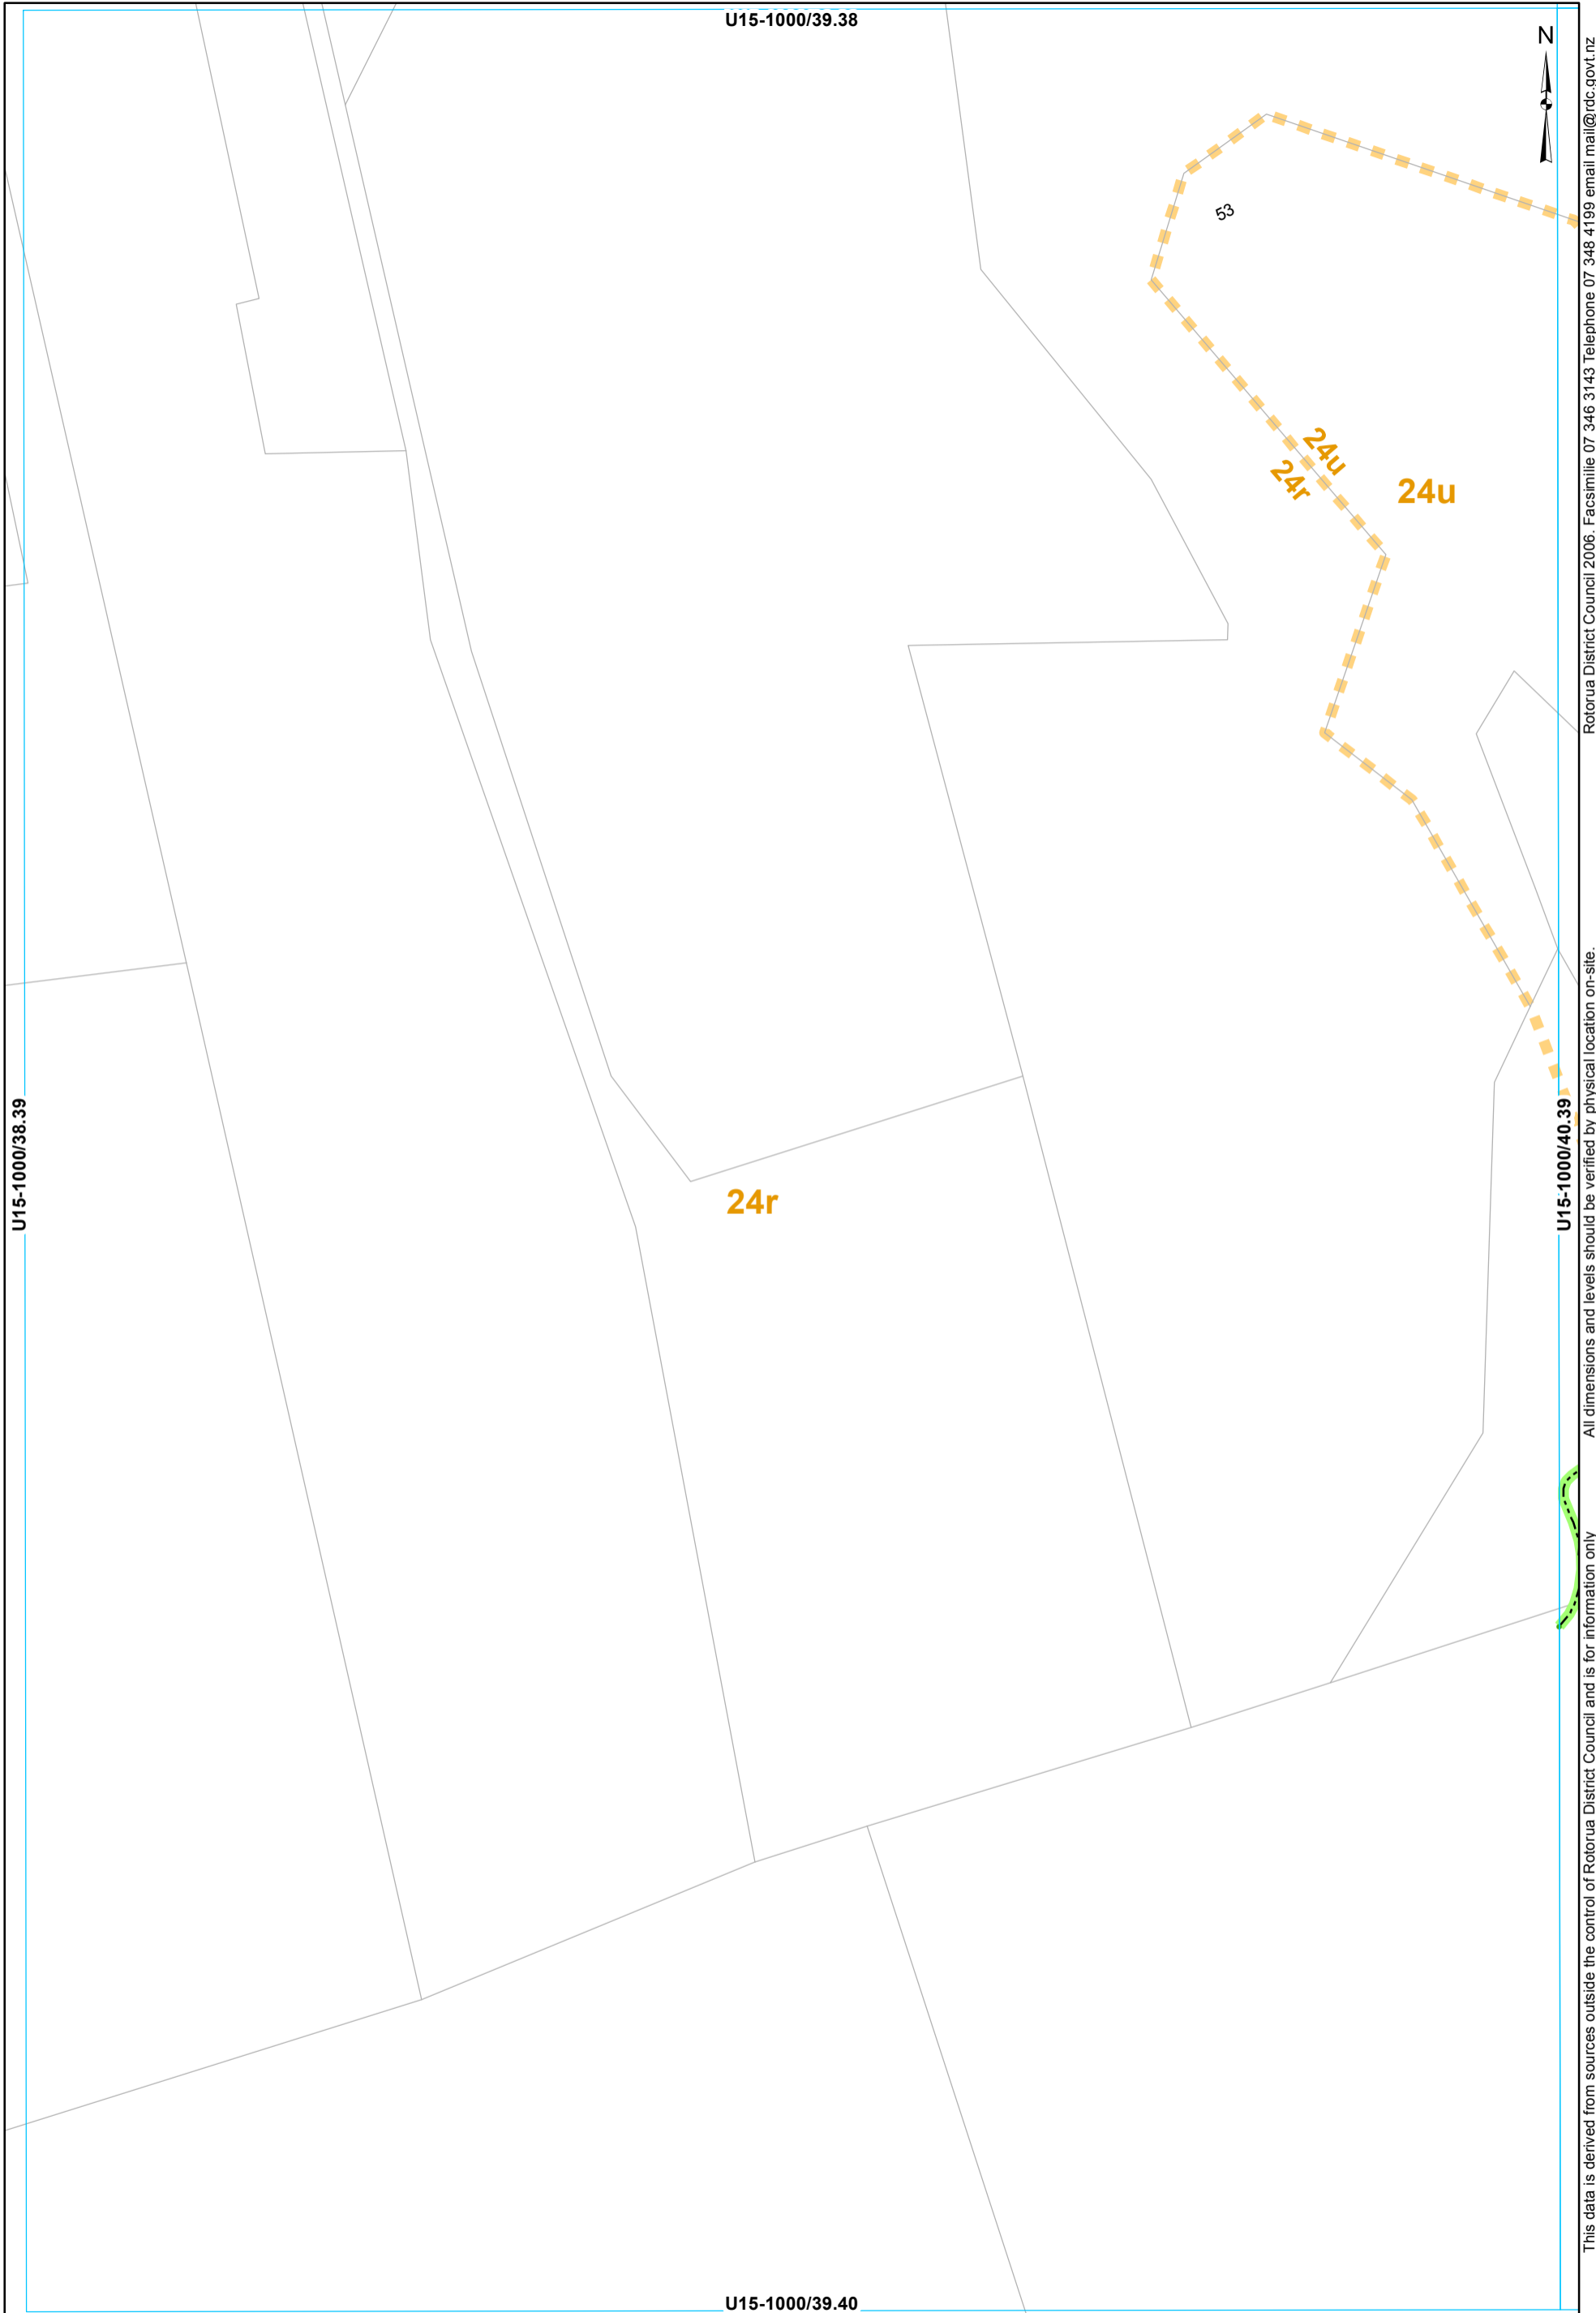


- Node
- Stream
- Catchment Boundary

STORMWATER SERVICES
 1:2000 @ A3 - (U15-1000/39.39)

This data is derived from sources outside the control of Rotorua District Council and is for information only



Rotorua District Council 2006. Facsimile 07 346 3143 Telephone 07 348 4199 email mail@rdc.govt.nz

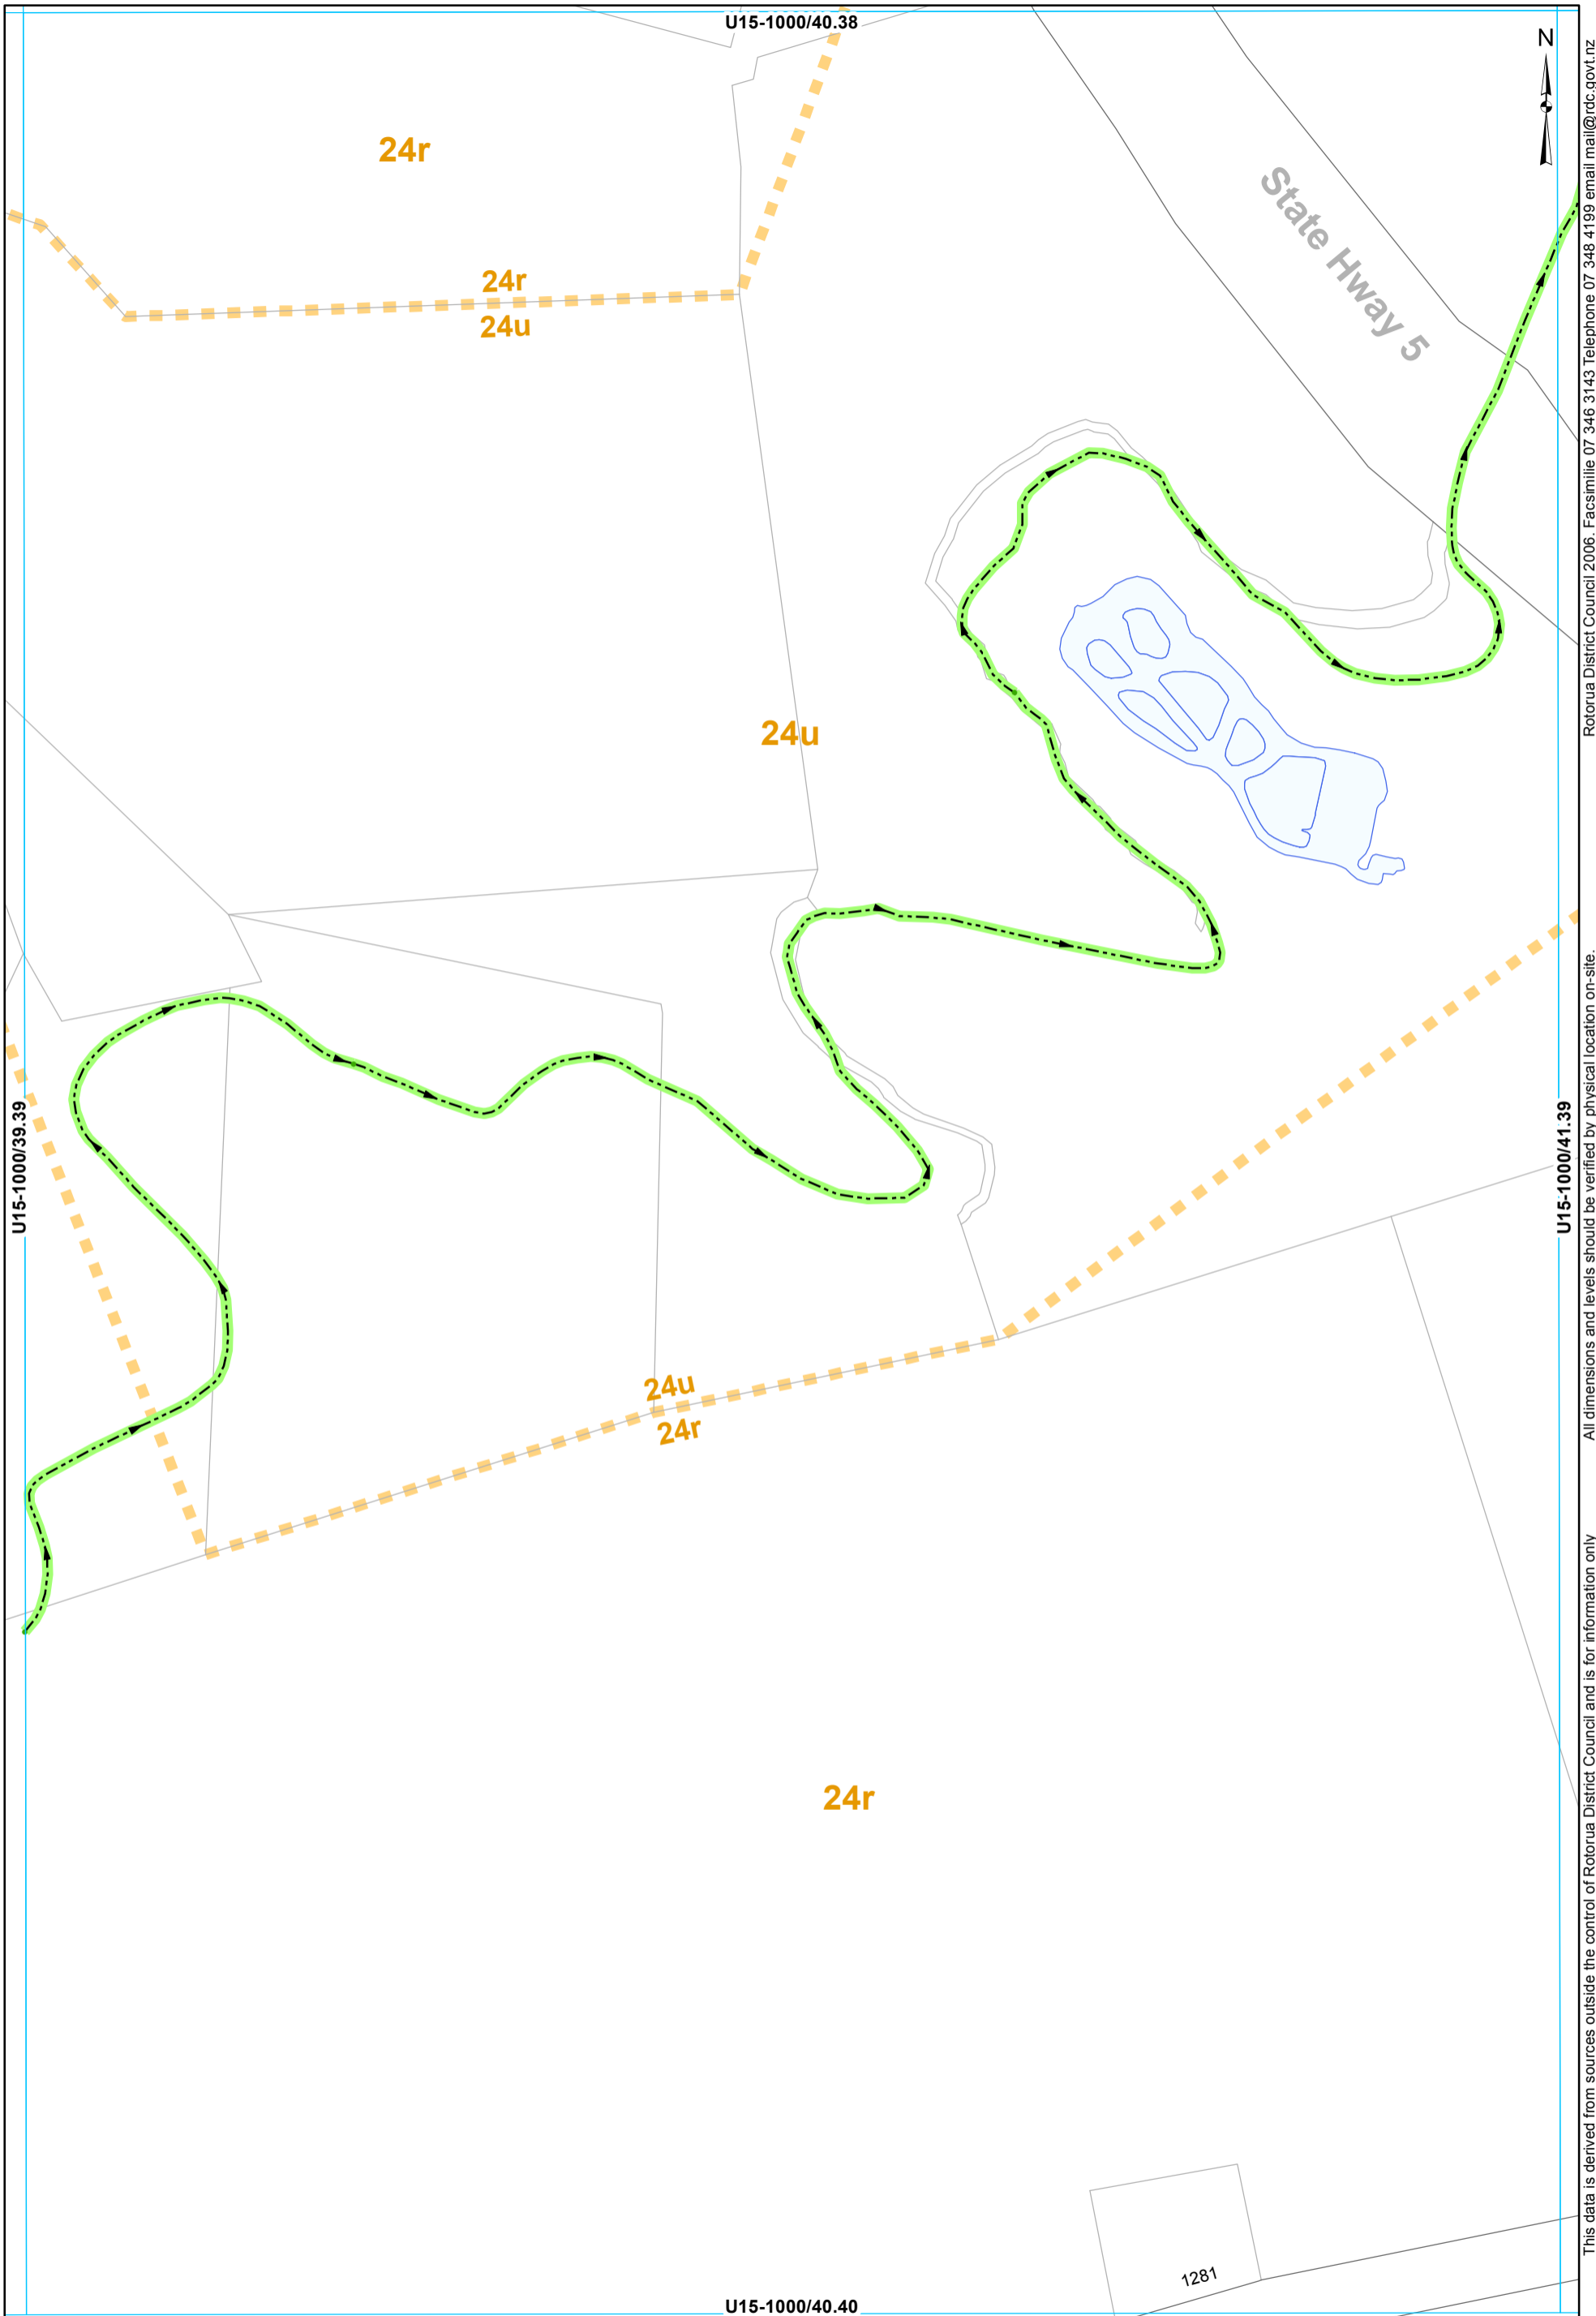


Rotorua District Council 2006. Facsimile 07 346 3143 Telephone 07 348 4199 email mail@rdc.govt.nz

All dimensions and levels should be verified by physical location on-site.

This data is derived from sources outside the control of Rotorua District Council and is for information only

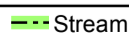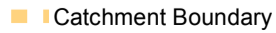• Node  Stream
  Catchment Boundary

STORMWATER SERVICES
1:2000 @ A3 - (U15-1000/40.39)

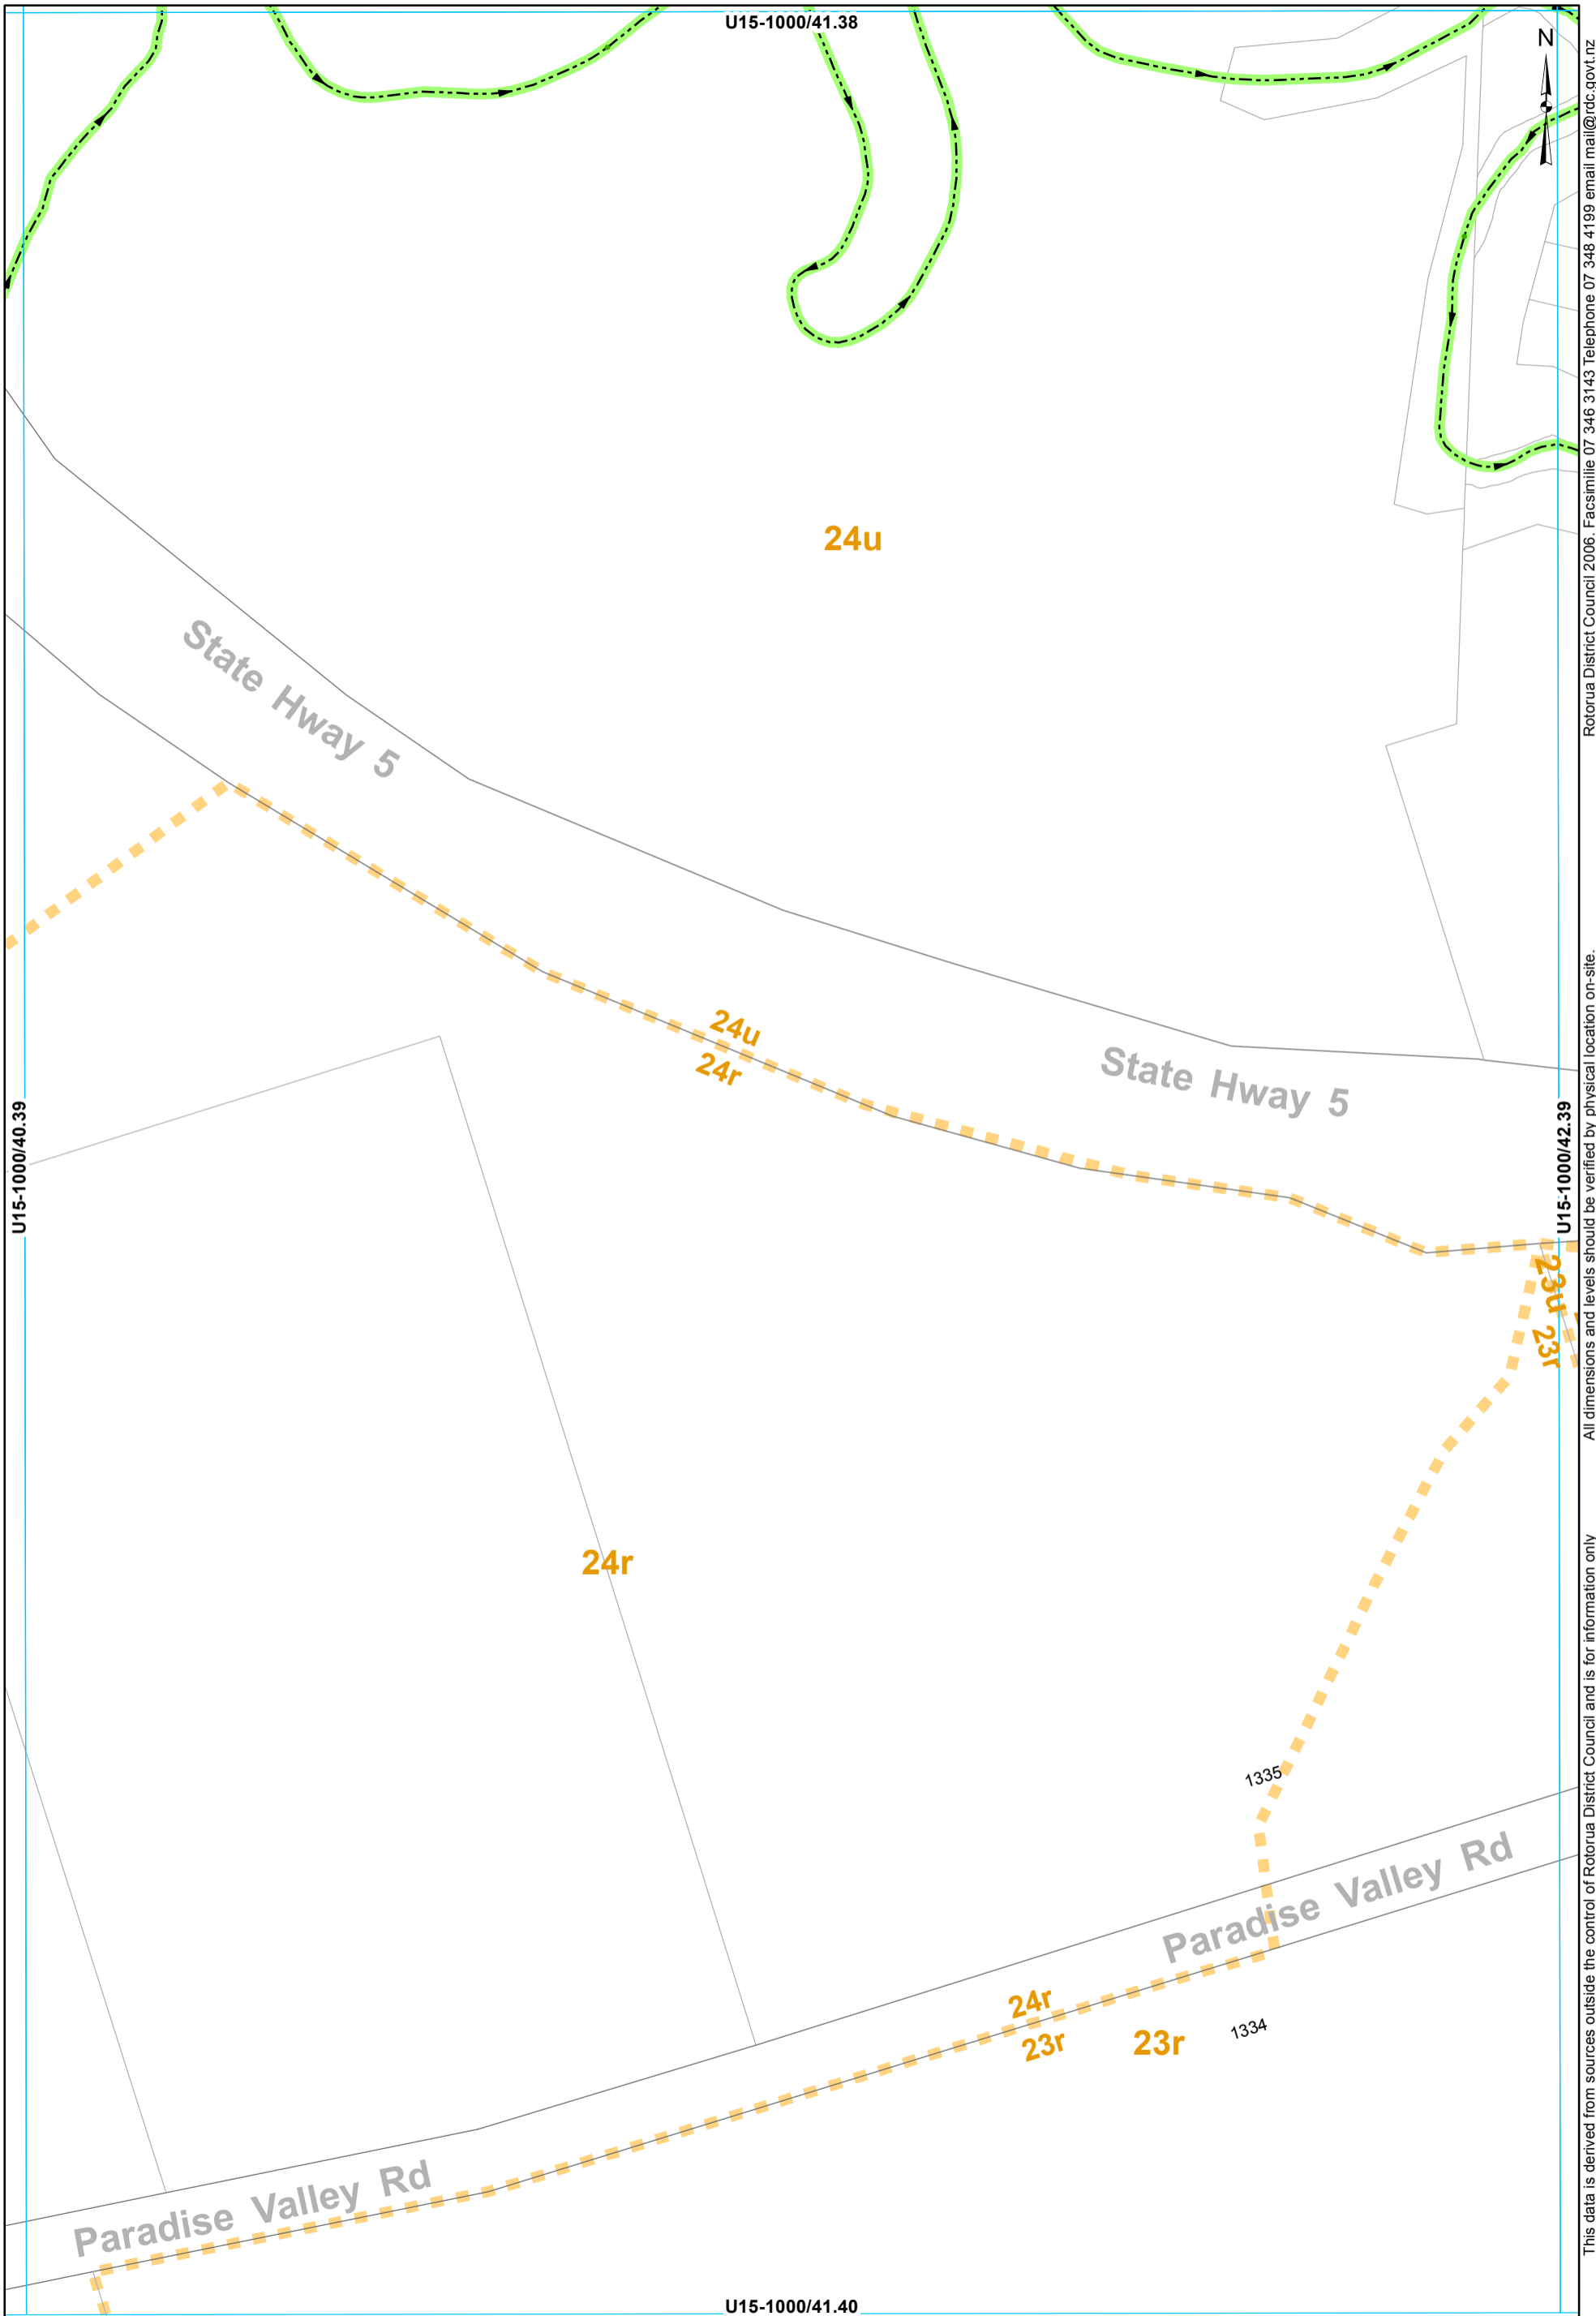


- Node
- Stream
- Catchment Boundary

STORMWATER SERVICES
 1:2000 @ A3 - (U15-1000/41.39)

This data is derived from sources outside the control of Rotorua District Council and is for information only

All dimensions and levels should be verified by physical location on-site.

Rotorua District Council 2006. Facsimile 07 346 3143 Telephone 07 348 4199 email mail@rdc.govt.nz

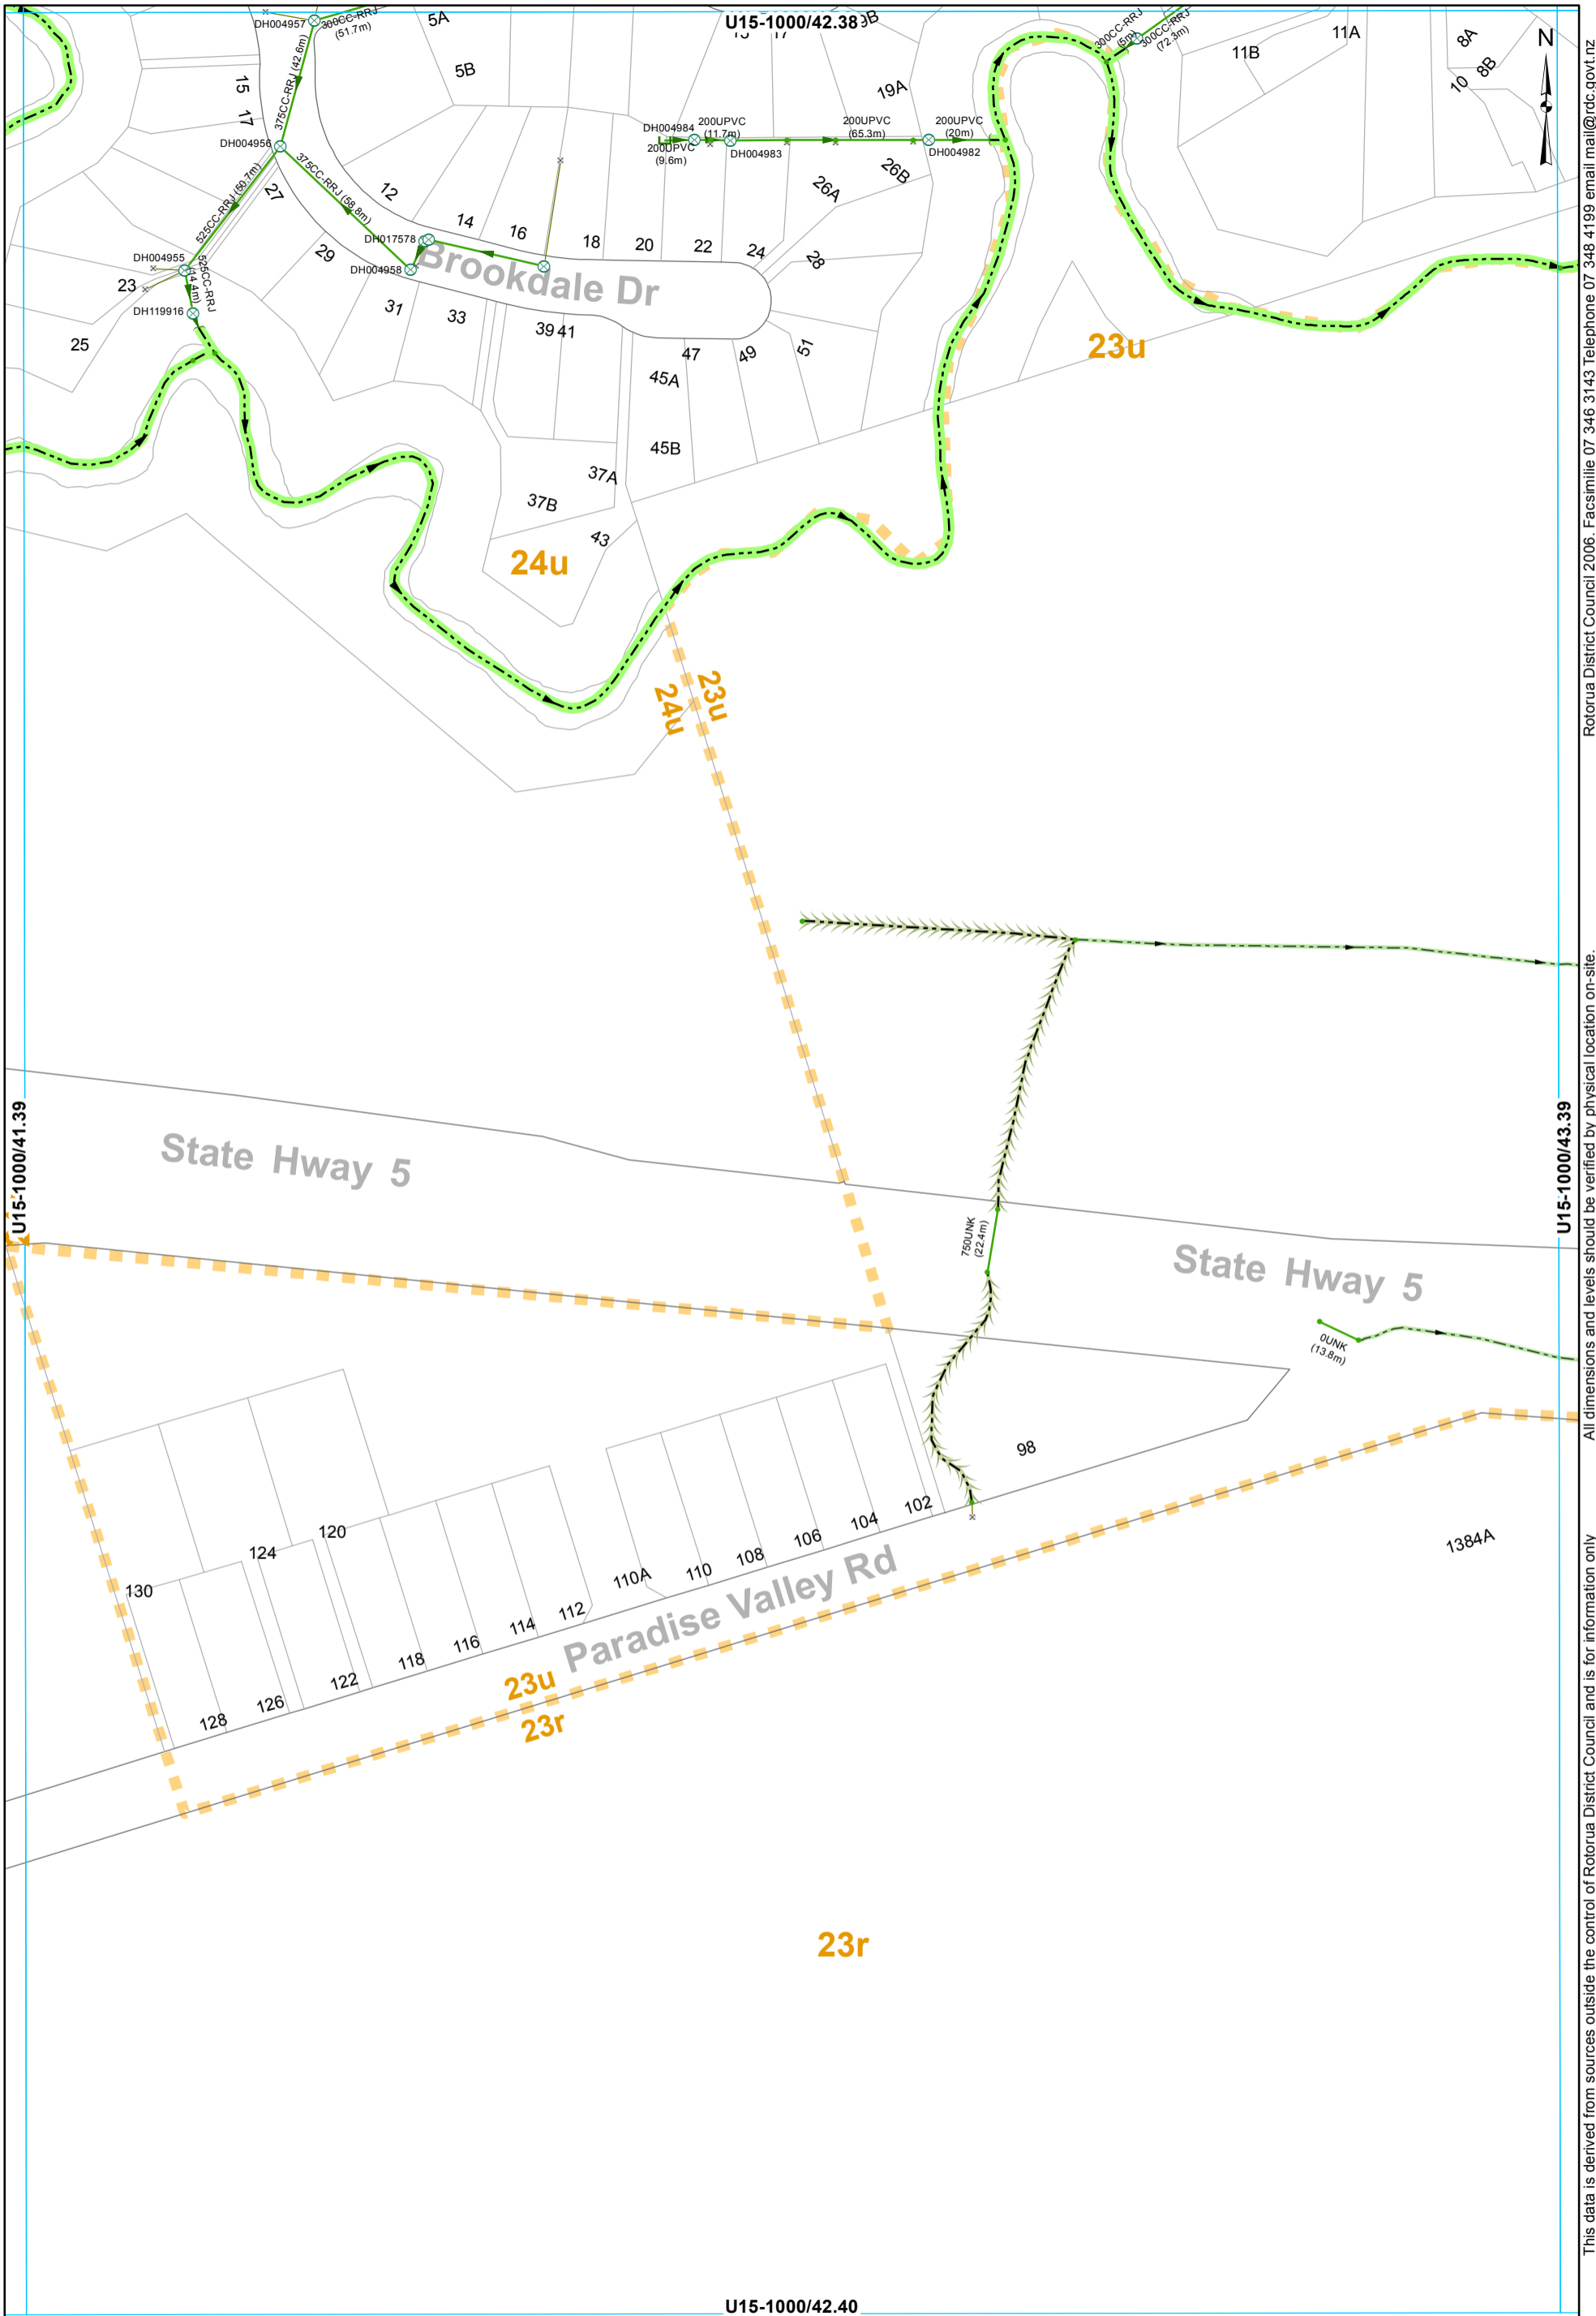


- ⊗ SWManhole
- × SWInlet
- Node
- ⌈ Capped End
- Headwall Structure
- Open Drain
- Overland Flow
- Stream
- Culvert
- Gravity Main
- SWLead
- ▭ Catchment Boundary

STORMWATER SERVICES
1:2000 @ A3 - (U15-1000/42.39)

This data is derived from sources outside the control of Rotorua District Council and is for information only

Rotorua District Council 2006. Facsimile 07 346 3143 Telephone 07 348 4199 email mail@rdc.govt.nz

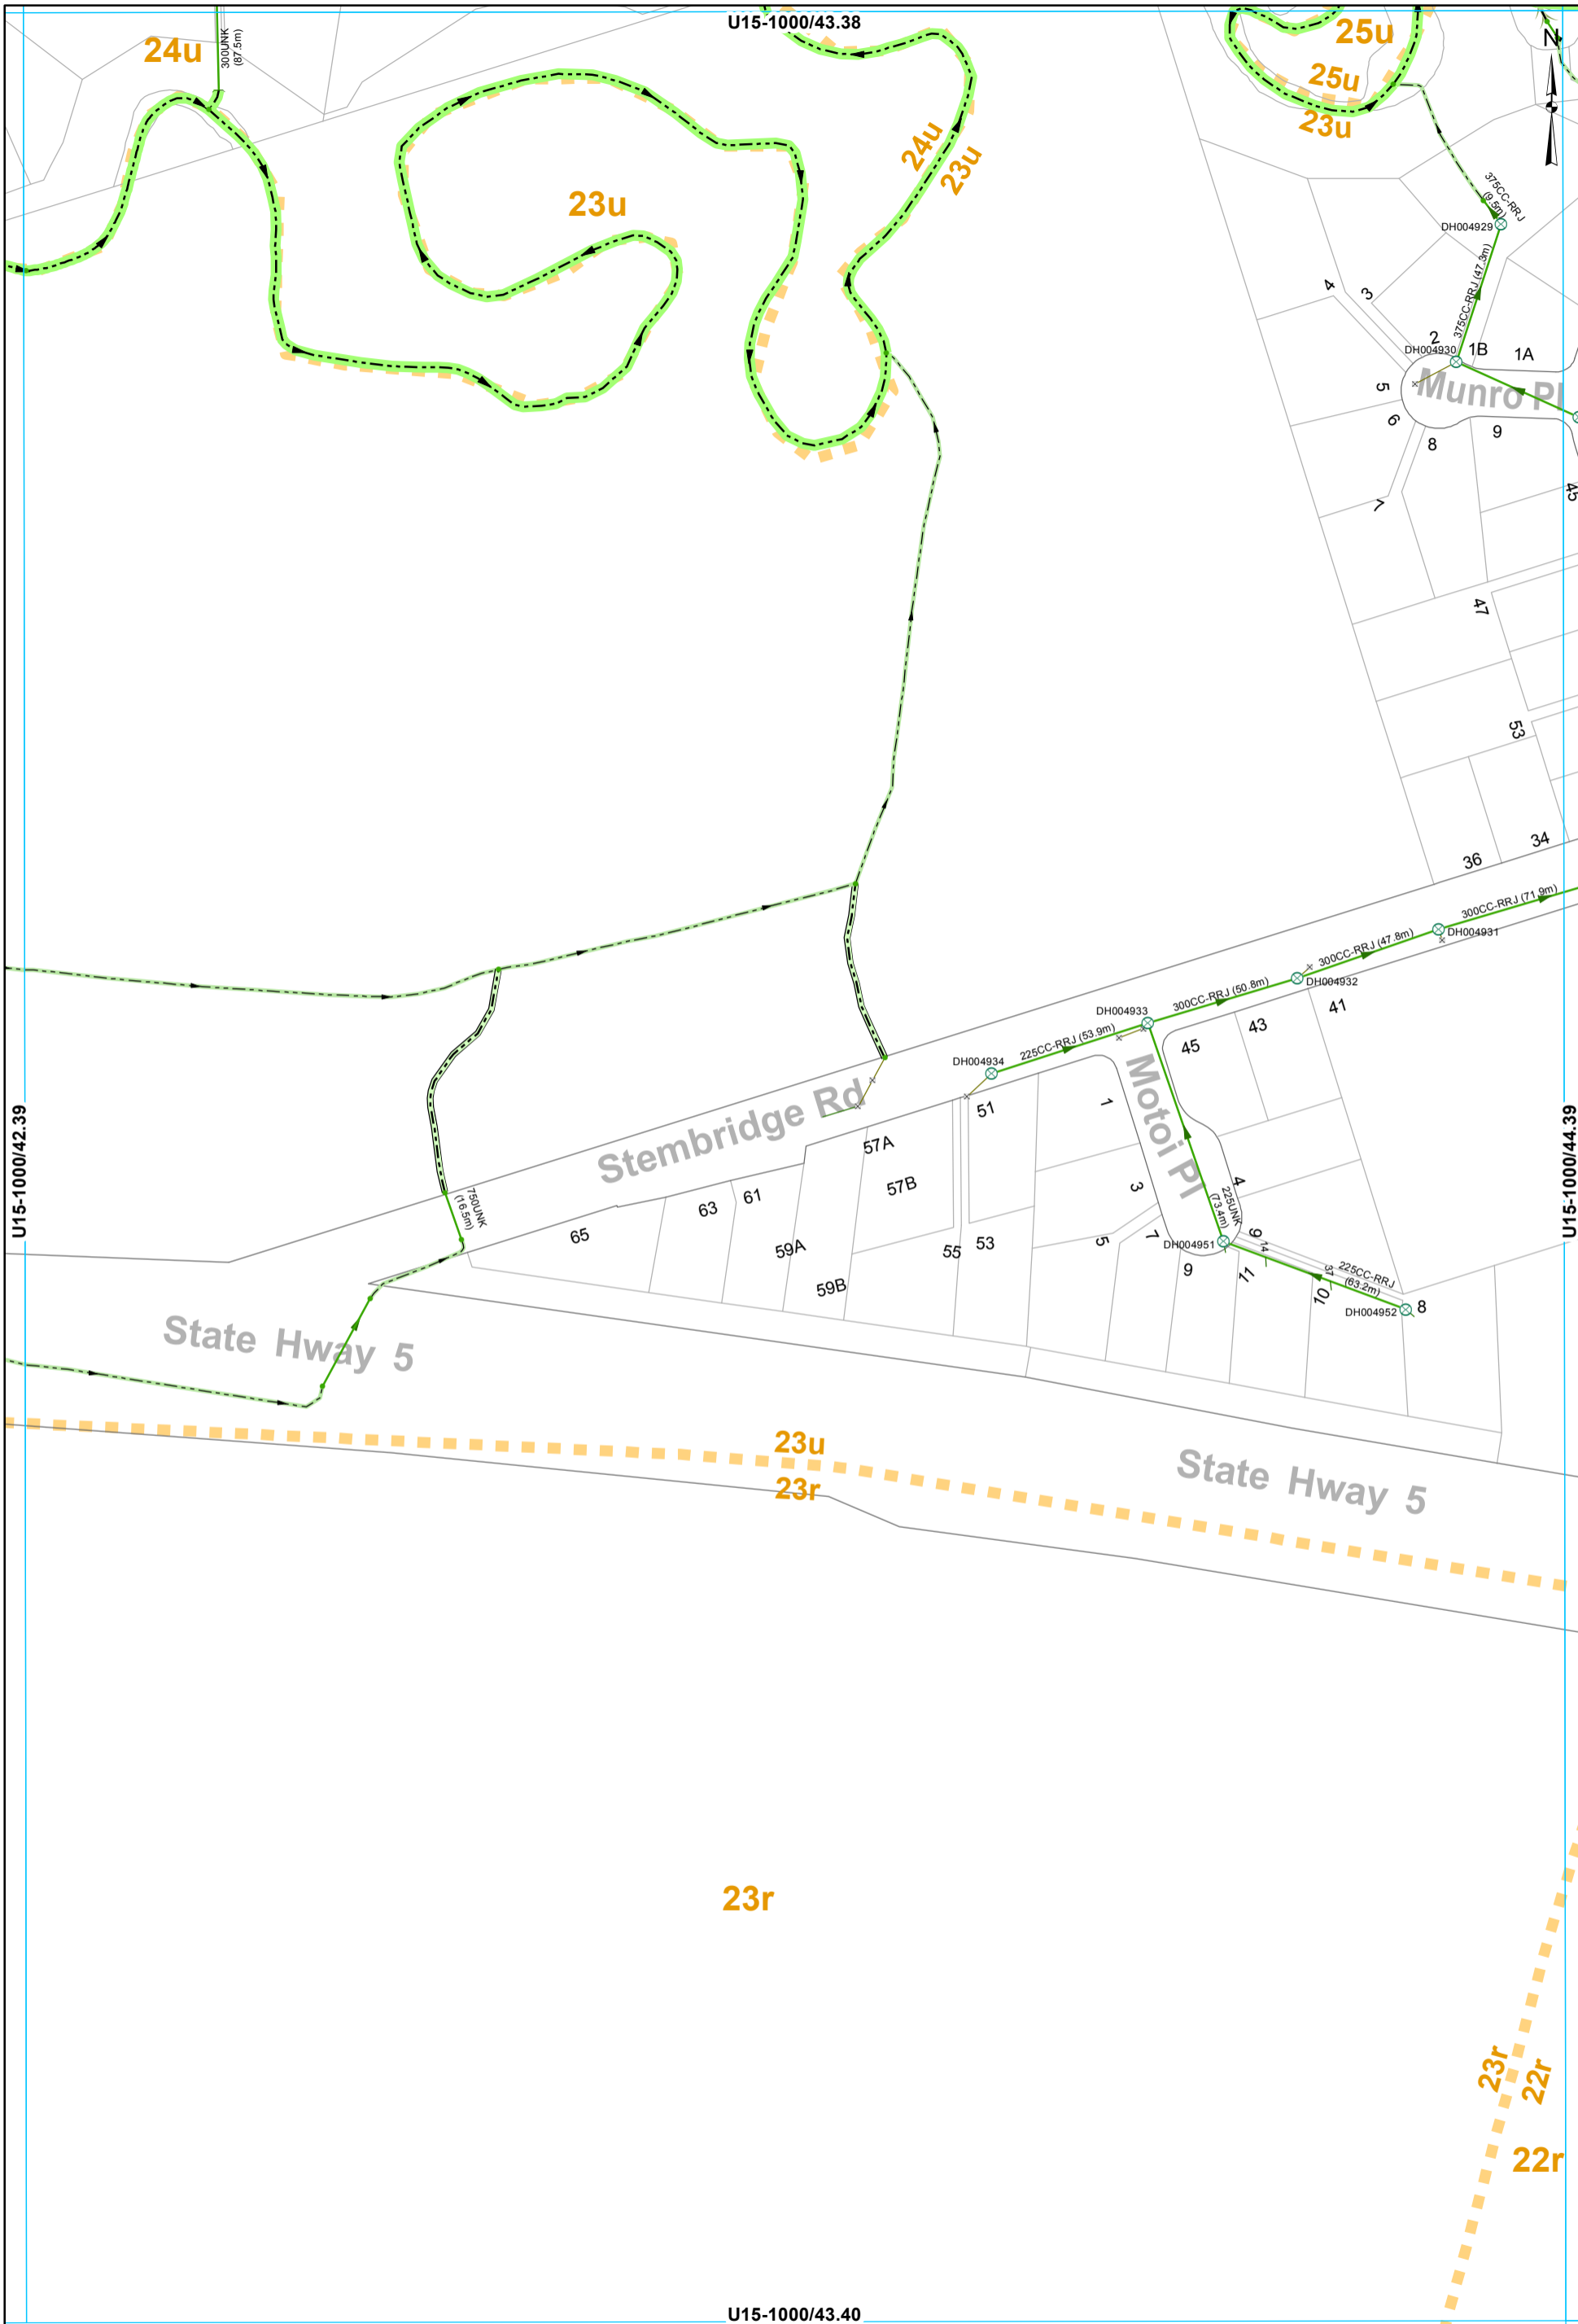

All dimensions and levels should be verified by physical location on-site.

Rotorua District Council 2006. Facsimile 07 346 3143 Telephone 07 348 4199 email mail@rdc.govt.nz

- | | | | |
|----------------------|-----------------|----------------------|-----------------|
| ⊗ SWManhole | ▬ Lined Channel | — Culvert | SWServiceline |
| × SWInlet | ▬ Open Drain | — Gravity Main | — SWServiceline |
| • Node | ▬ Overland Flow | — Headwall Structure | — SWLead |
| — Headwall Structure | ▬ Stream | ▬ Catchment Boundary | |

STORMWATER SERVICES
1:2000 @ A3 - (U15-1000/43.39)