

U15  
41.35

U15  
42.35

U15  
43.35

U15  
46.35

U15  
41.36

U15  
46.36

U15  
44.37

U15  
46.37

U15  
42.38

U15  
43.38

U15  
44.38

U15  
45.38

U15  
43.39

U15  
41.40

U15  
42.40

U15  
43.40

U16  
41.01

U16  
42.01

U16  
43.01


U16  
44.01

Storm Water Asbuilt Sheet Index

SWCatchment 25u

Compiled on 2023-05-02 from as-builts of various dates. For up to date as-builts please visit [http://geo.rdc.govt.nz/images/plotfiles/3waters\\_mobile\\_asbuilts/](http://geo.rdc.govt.nz/images/plotfiles/3waters_mobile_asbuilts/)



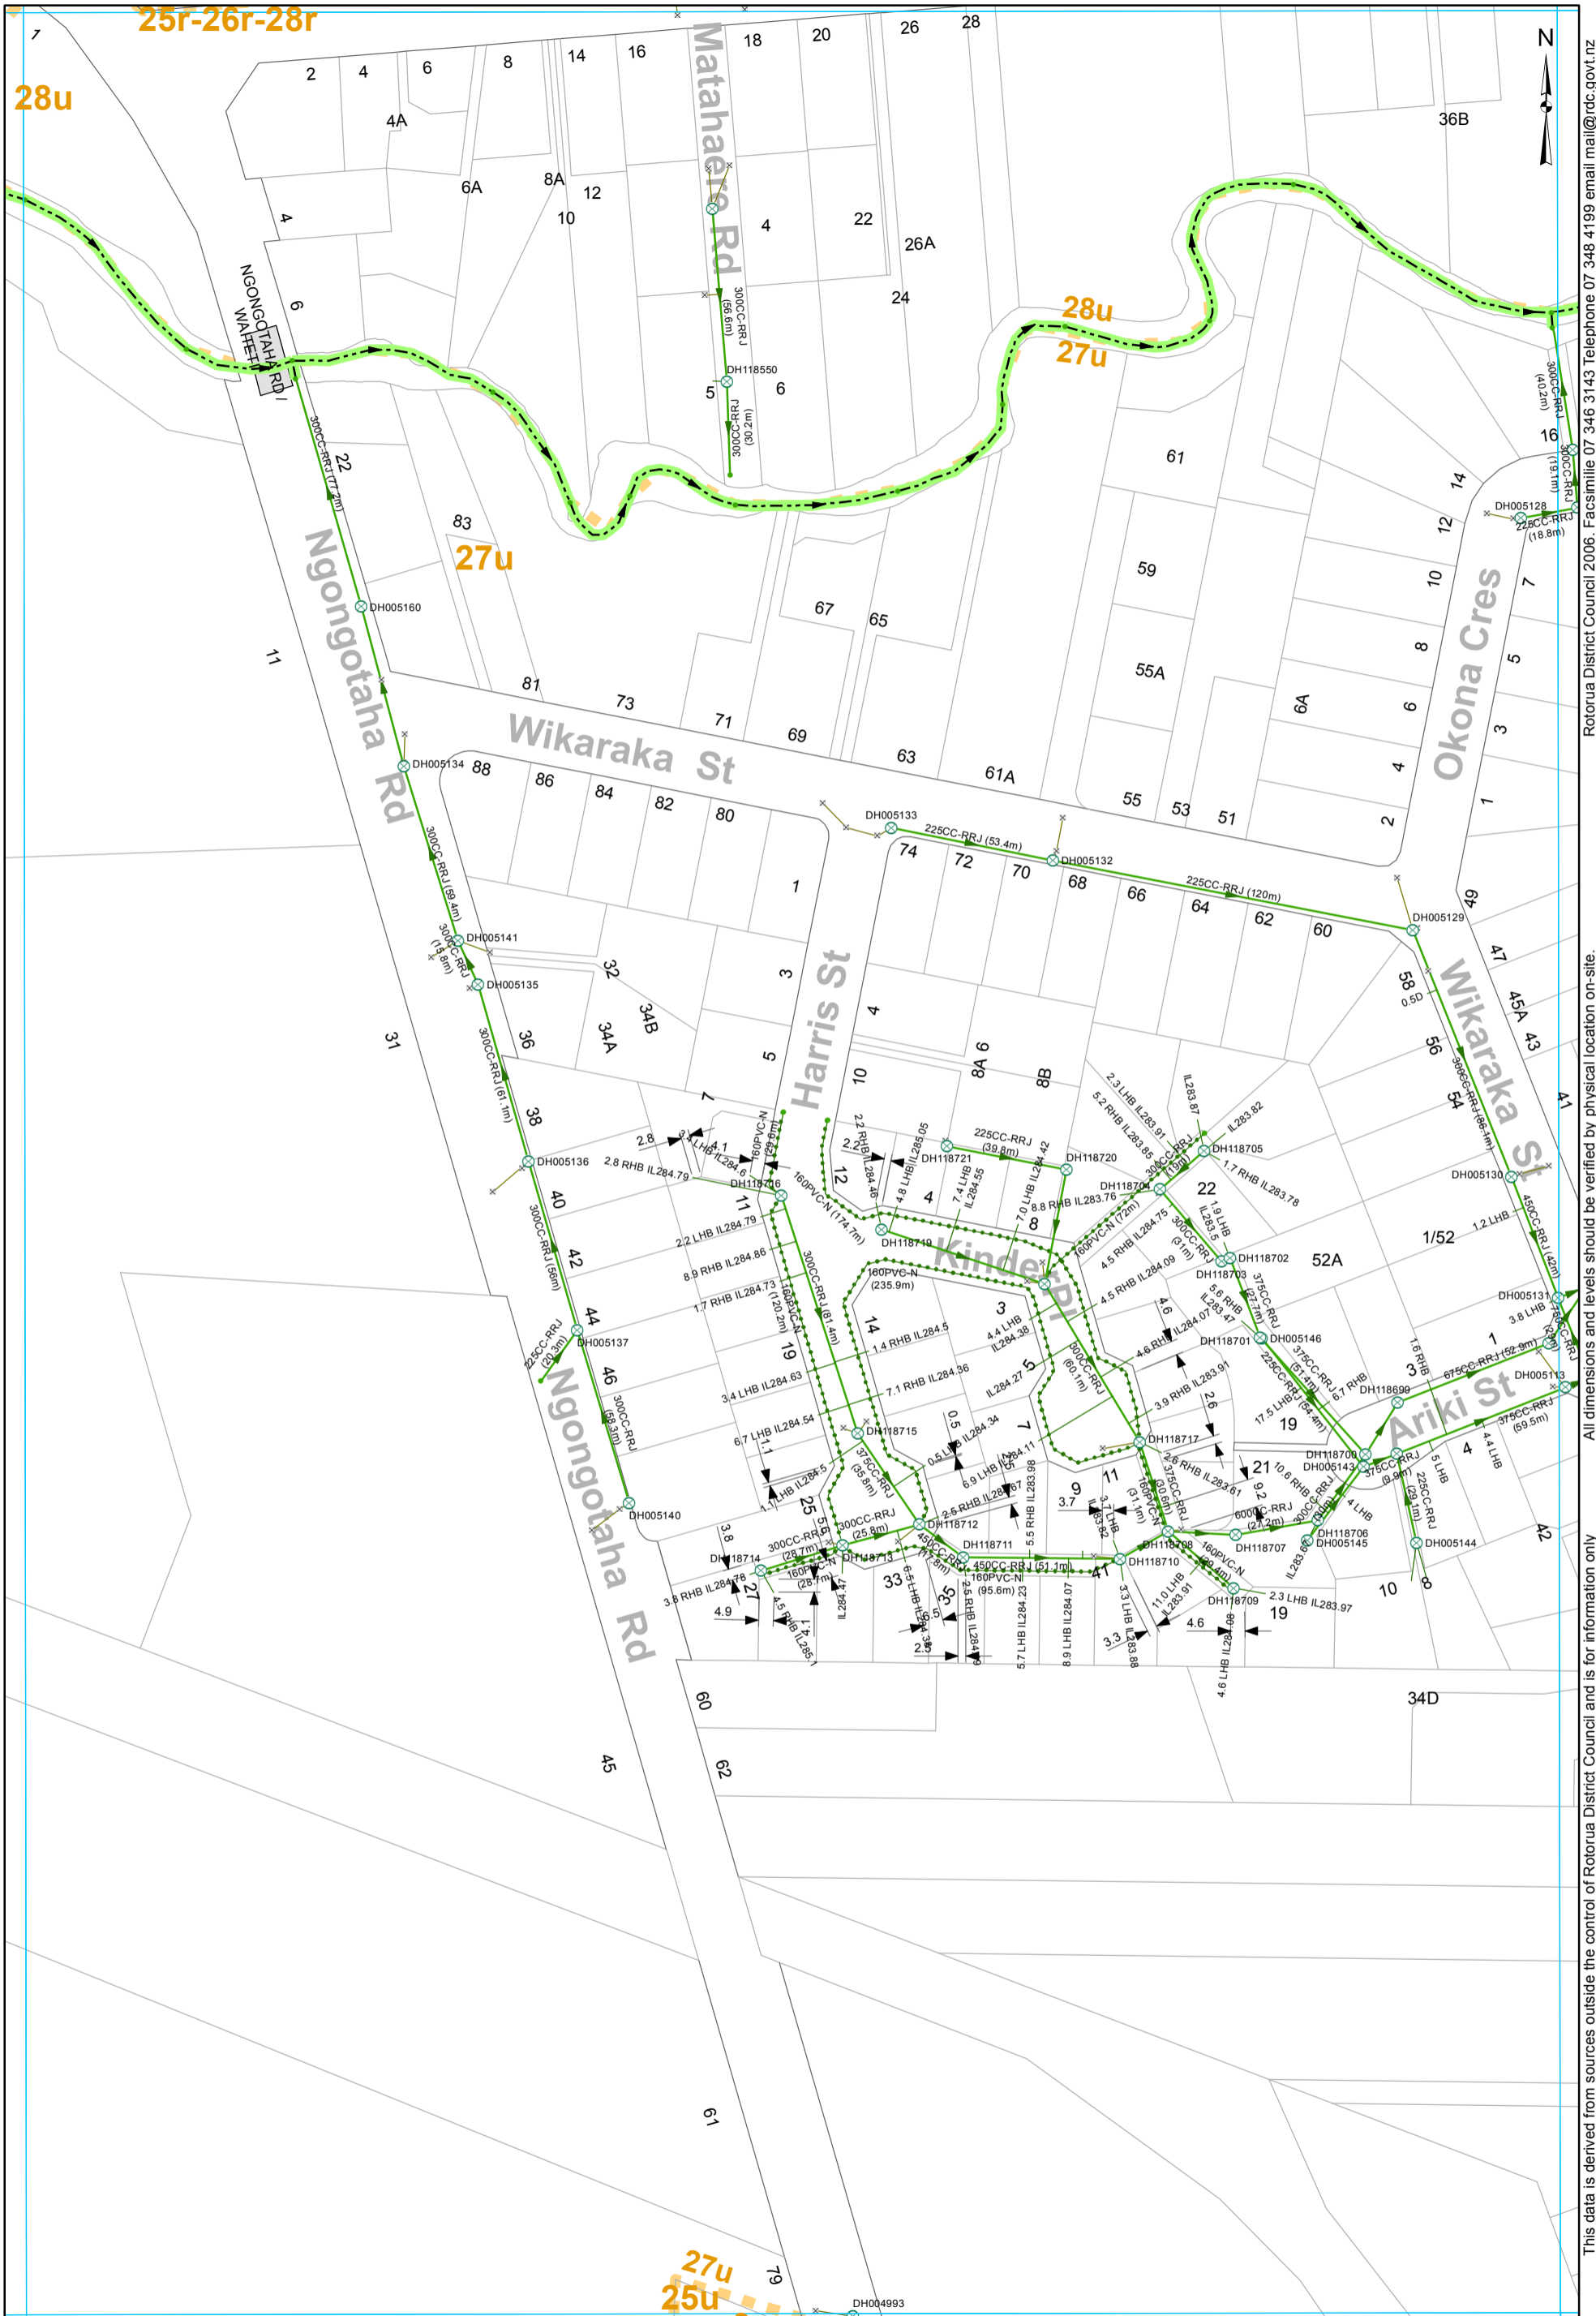


- ⊗ SWManhole
- × SWInlet
- Node
- Stream
- Gravity Main
- Subsoil Drain
- SWServiceLine
- SWServiceLine
- SWLead
- Catchment Boundary

**STORMWATER SERVICES**  
**1:2000 @ A3 - (U15-1000/44.37)**

This data is derived from sources outside the control of Rotorua District Council and is for information only

All dimensions and levels should be verified by physical location on-site.

Rotorua District Council 2006. Facsimile 07 346 3143 Telephone 07 348 4199 email mail@rdc.govt.nz

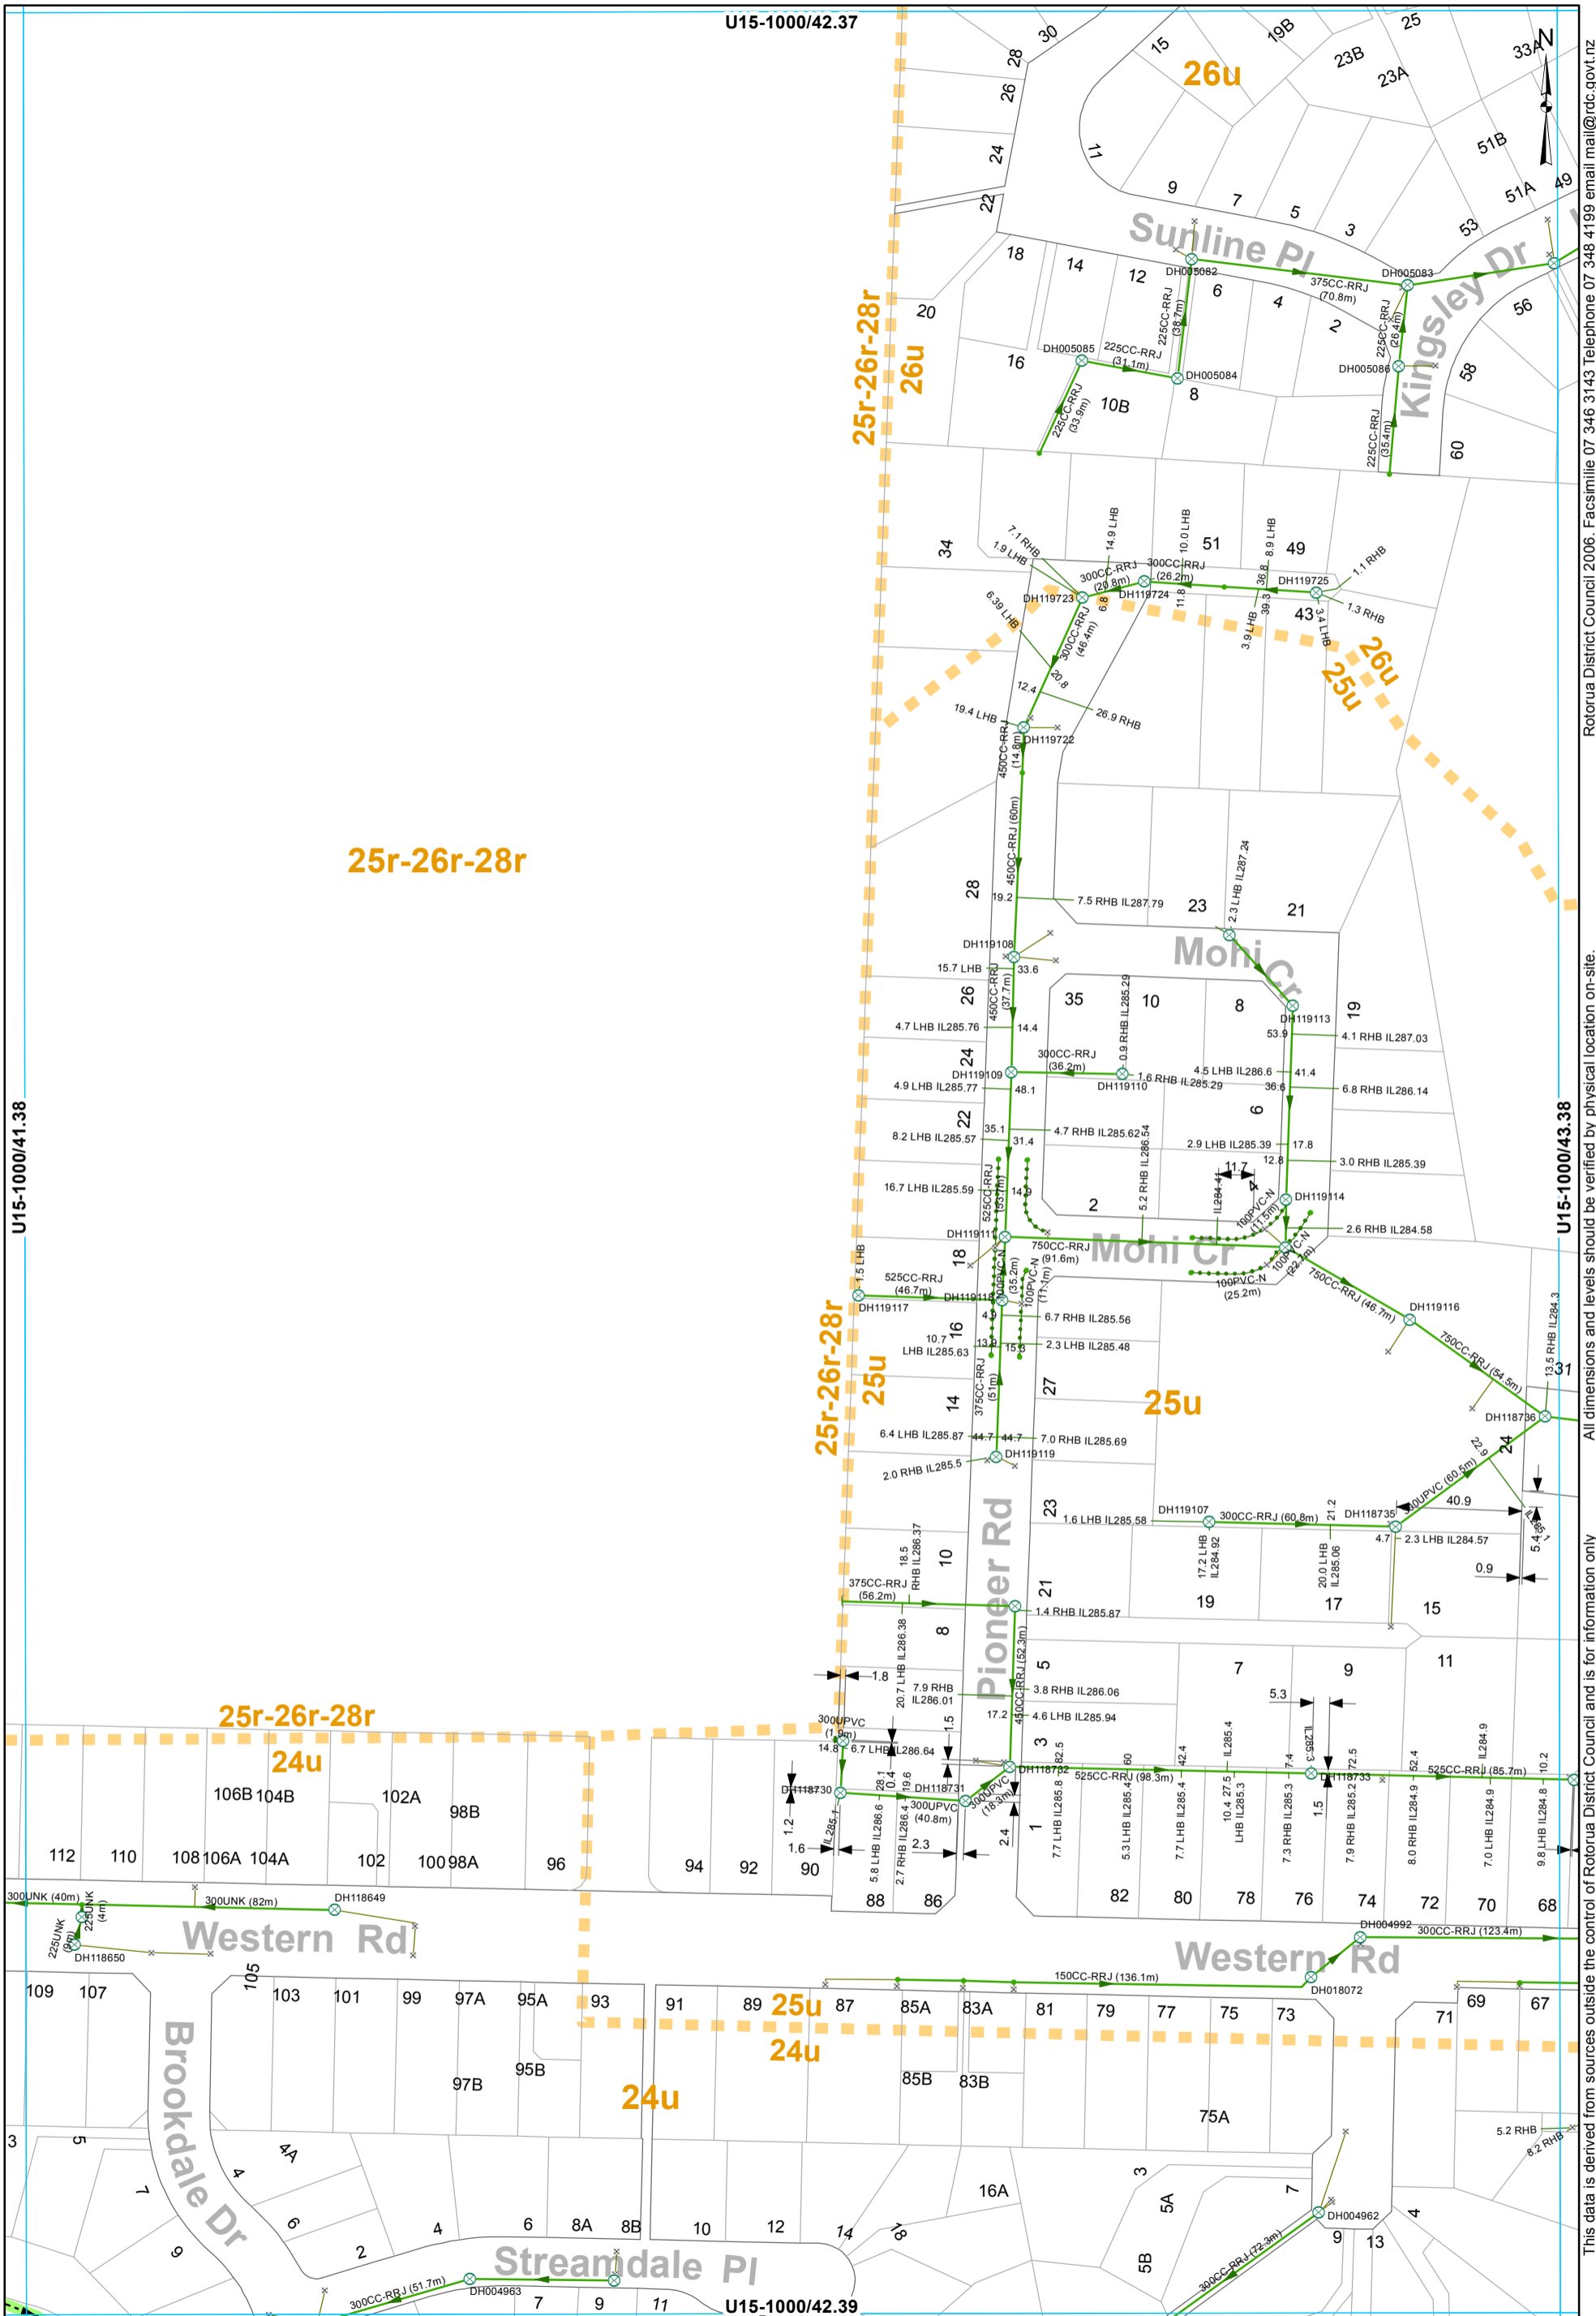


- ⊗ SWManhole
- × SWInlet
- Node
- Headwall Structure
- Stream
- Gravity Main
- ⋯ Subsoil Drain
- SWServiceline
- SWServiceline
- SWLead
- Catchment Boundary

**STORMWATER SERVICES**  
**1:2000 @ A3 - (U15-1000/42.38)**

All dimensions and levels should be verified by physical location on-site.

Rotorua District Council 2006. Facsimile 07 346 3143 Telephone 07 348 4199 email mail@rdc.govt.nz



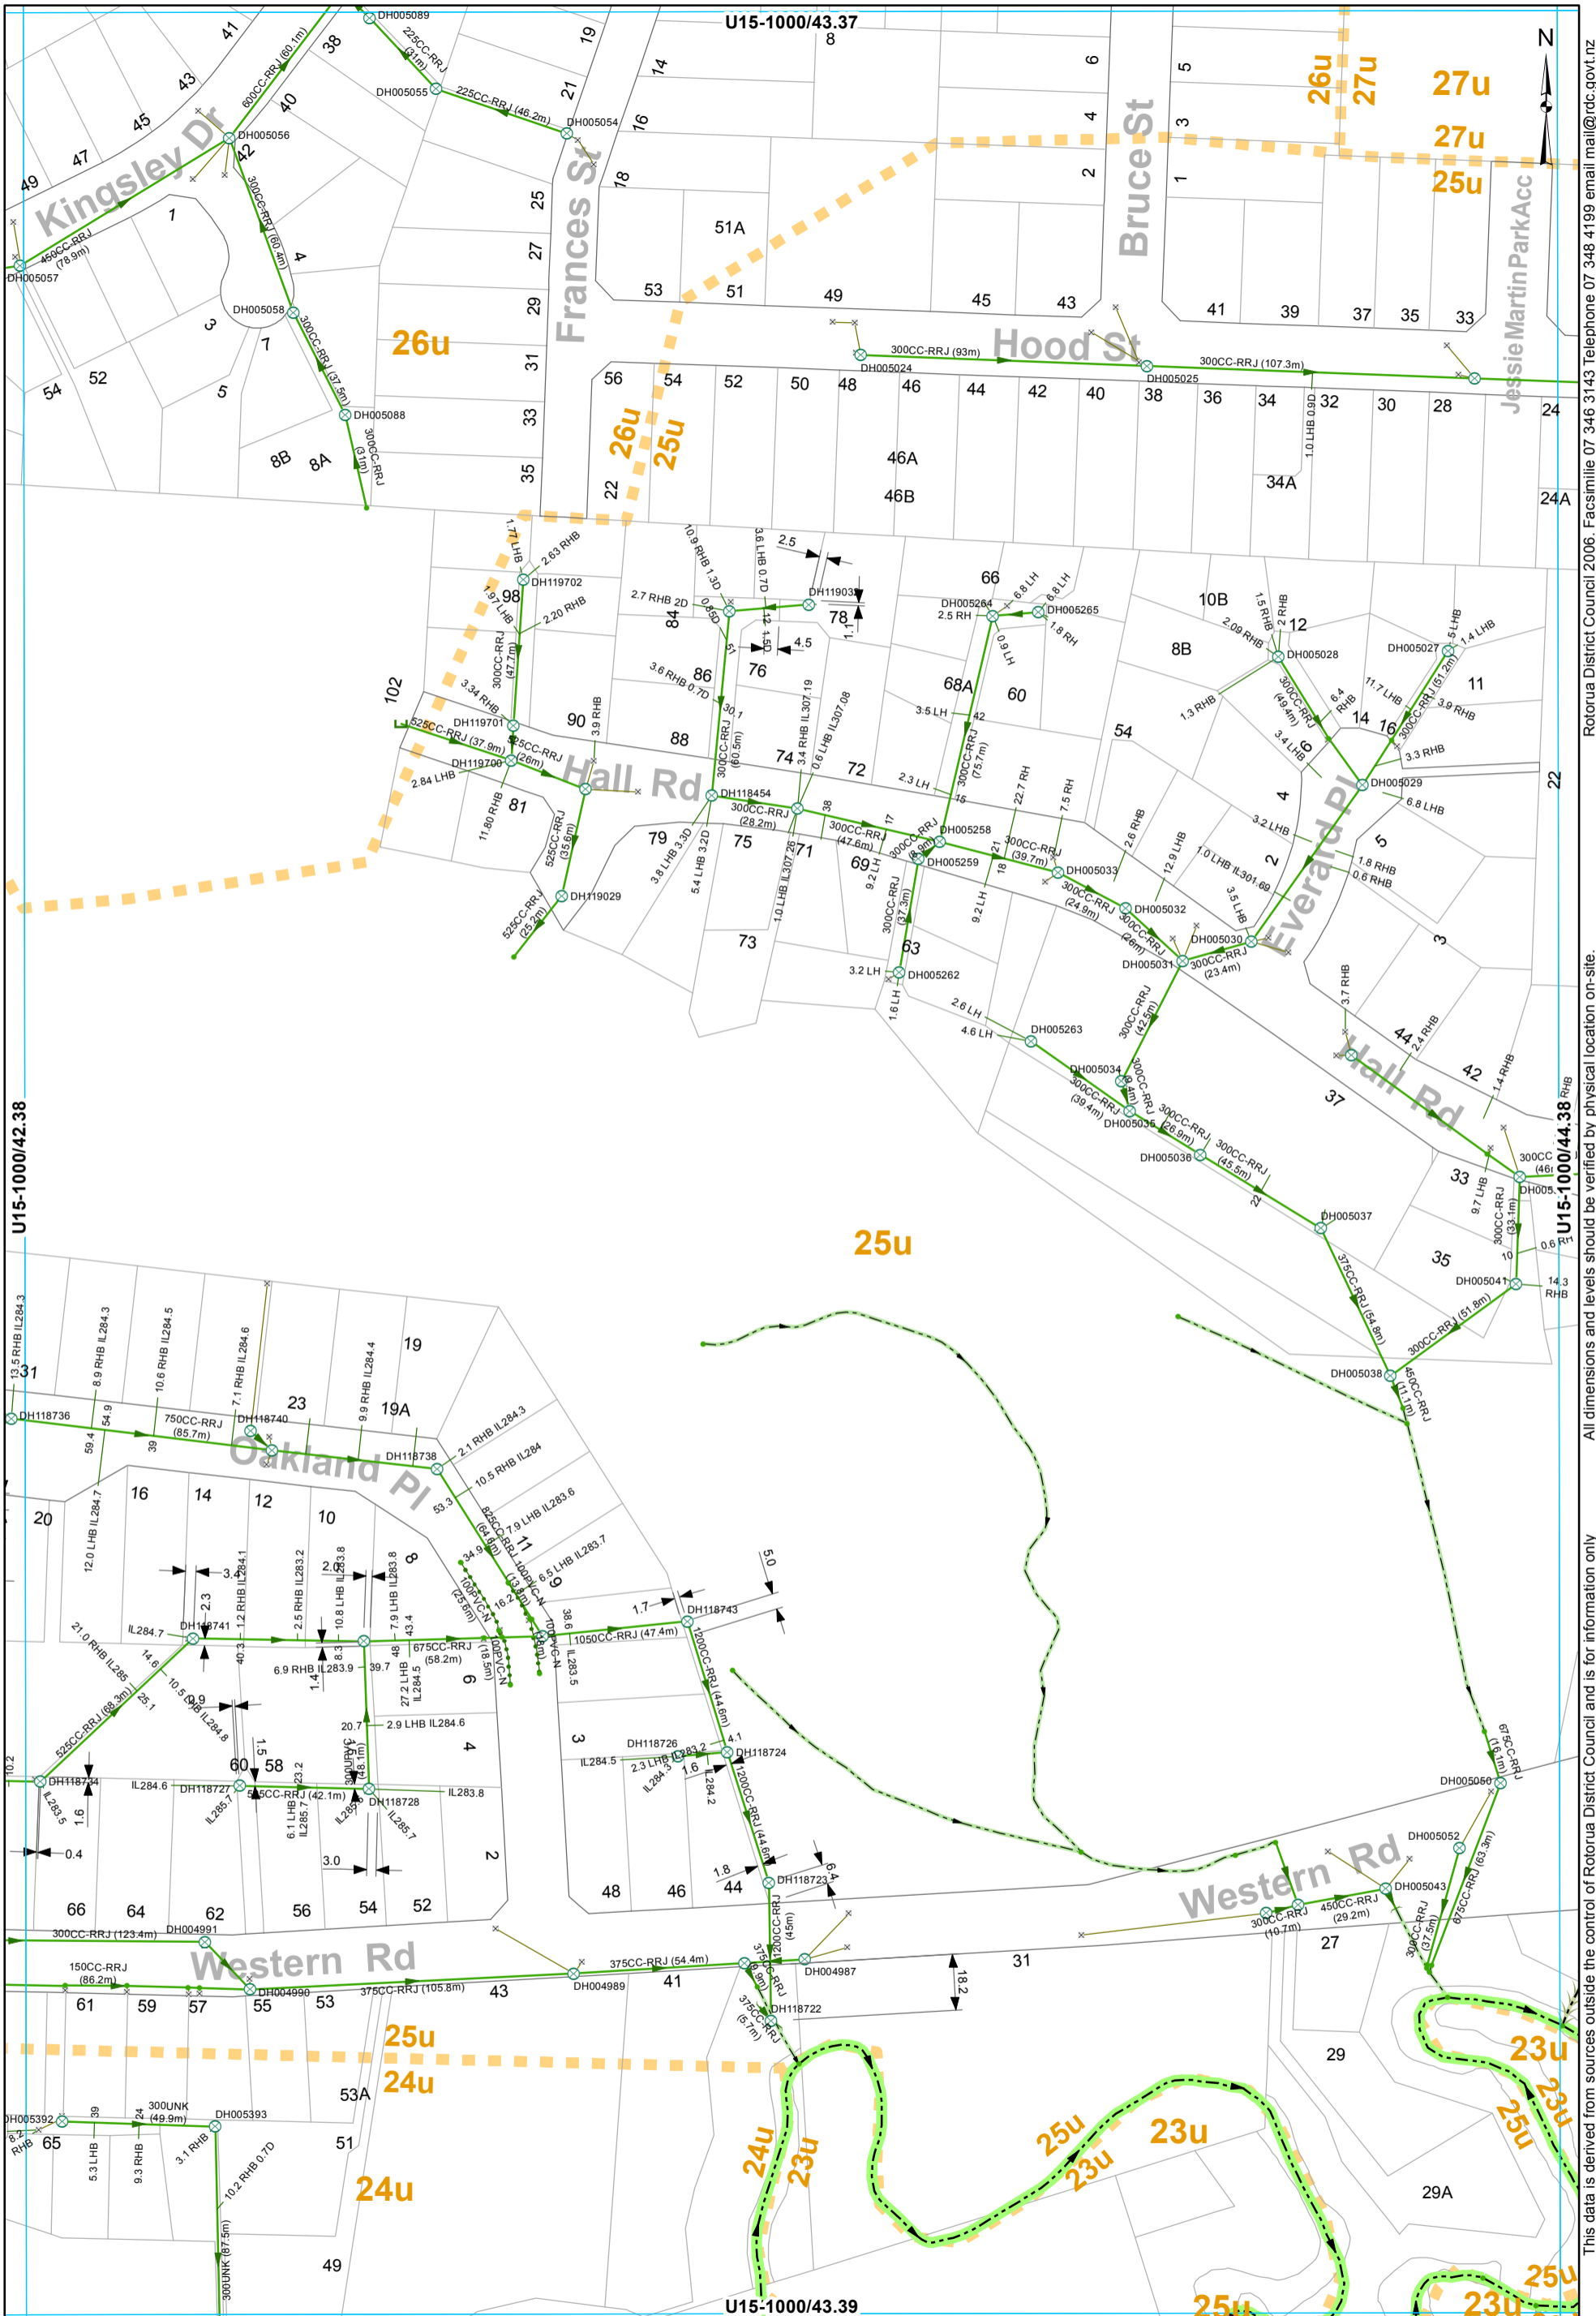


- ⊗ SWManhole
- ⊗ SWInlet
- Node
- ⊏ Capped End
- ⊏ Headwall Structure
- Open Drain
- Overland Flow
- Stream
- Gravity Main
- ⋯ Subsoil Drain
- SWServiceline
- SWServiceline
- SWLead
- ⊏ Catchment Boundary

**STORMWATER SERVICES**  
1:2000 @ A3 - (U15-1000/43.38)

All dimensions and levels outside the control of Rotorua District Council and is for information only

Rotorua District Council 2006. Facsimile 07 346 3143 Telephone 07 348 4199 email mail@rdc.govt.nz

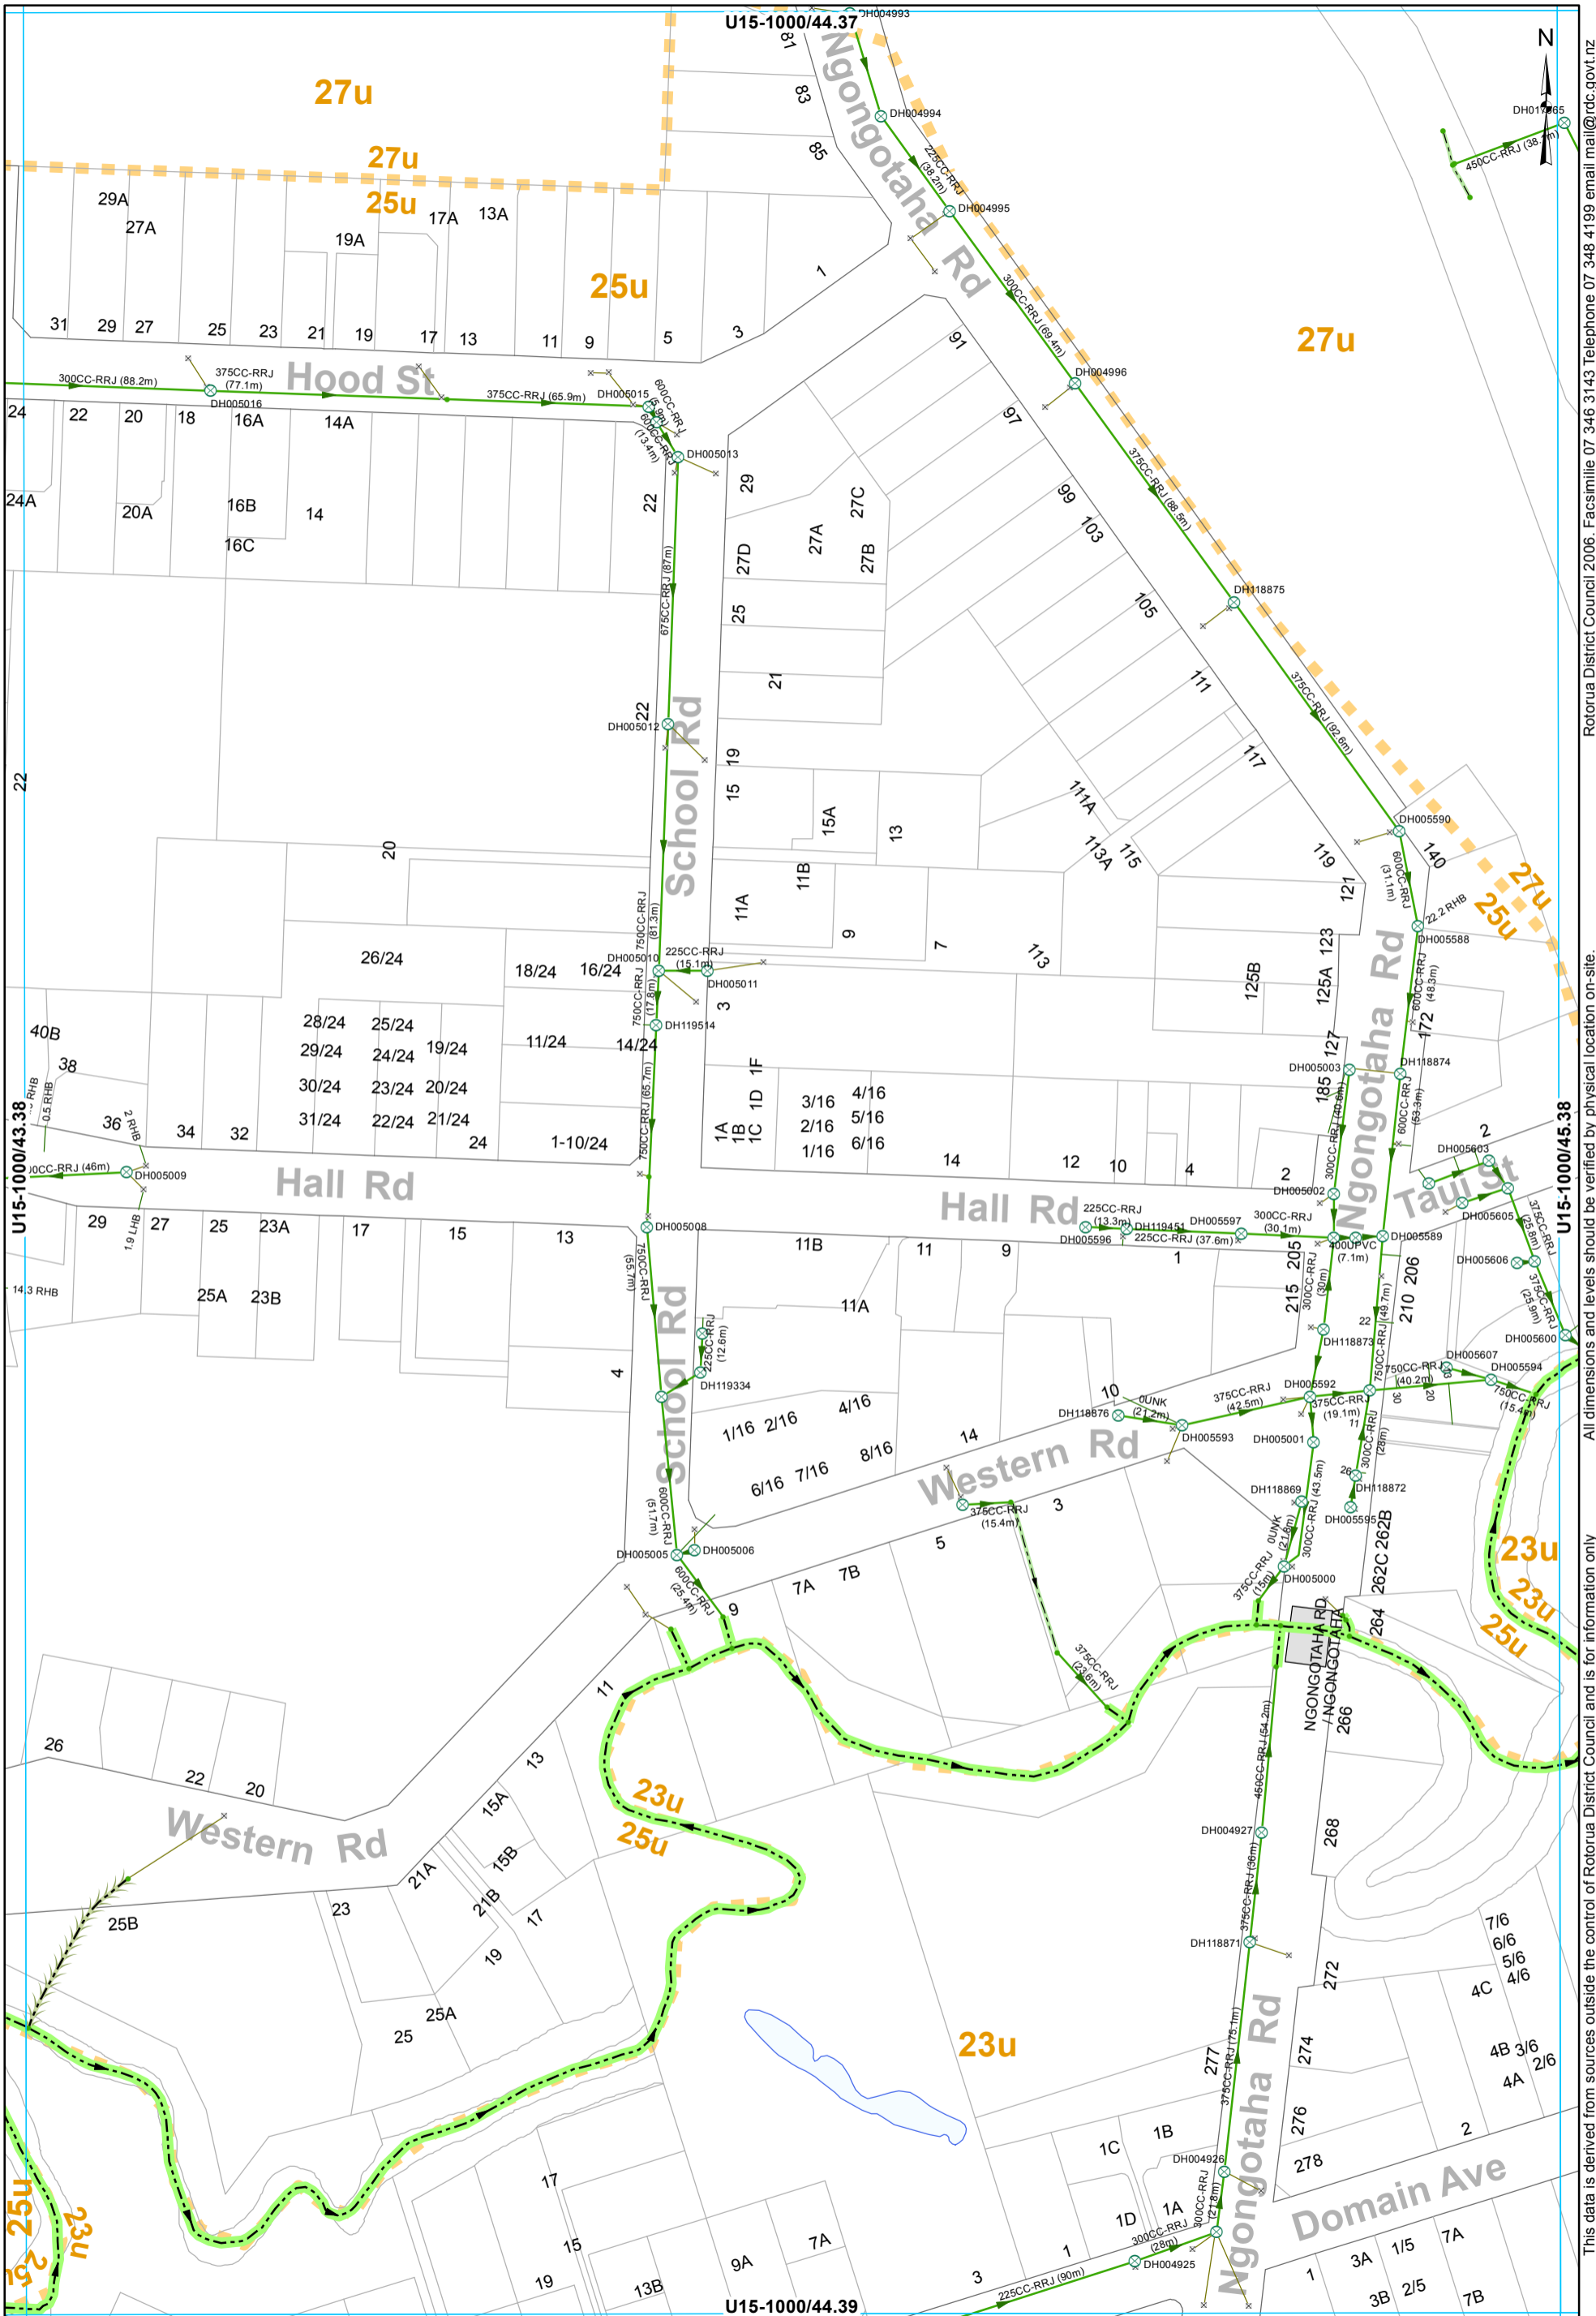

- ⊗ SWManhole
- × SWInlet
- Node
- Open Drain
- Overland Flow
- ... Stream
- Gravity Main
- SWServiceline
- SWLead
- Catchment Boundary

**STORMWATER SERVICES**  
**1:2000 @ A3 - (U15-1000/44.38)**

This data is derived from sources outside the control of Rotorua District Council and is for information only. All dimensions and levels should be verified by physical location on-site.

Rotorua District Council 2006. Facsimile 07 346 3143 Telephone 07 348 4199 email mail@rdc.govt.nz







Not in a catchment. Bay Of Plenty Region

Not in a catchment. Bay Of Plenty Region.

Lake Rotorua

Not in a catchment. Bay Of Plenty Region

- ⊗ SWManhole
- ⊗ SWInlet
- Node
- Open Drain
- Stream
- Gravity Main
- Subsoil Drain
- SWServiceline
- SWServiceline
- SWLead
- Catchment Boundary

STORMWATER SERVICES  
1:2000 @ A3 - (U15-1000/45.38)

This data is derived from sources outside the control of Rotorua District Council and is for information only

Rotorua District Council 2006. Facsimile 07 346 3143 Telephone 07 348 4199 email mail@rdc.govt.nz