

Storm Water Asbuilt Sheet Index
SWcatchment 2u

Compiled on 2023-05-02 from as-builts of various dates. For up to date as-builts please visit http://geo.rdc.govt.nz/images/plotfiles/3waters_mobile_asbuilts/



U16-1000/59.03



Lake Rotorua


Not in a catchment. Bay Of Plenty Region

Not in a catchment. Bay Of Plenty Region

Not in a catchment. Bay Of Plenty Region

U16-1000/58.04

U16-1000/60.04

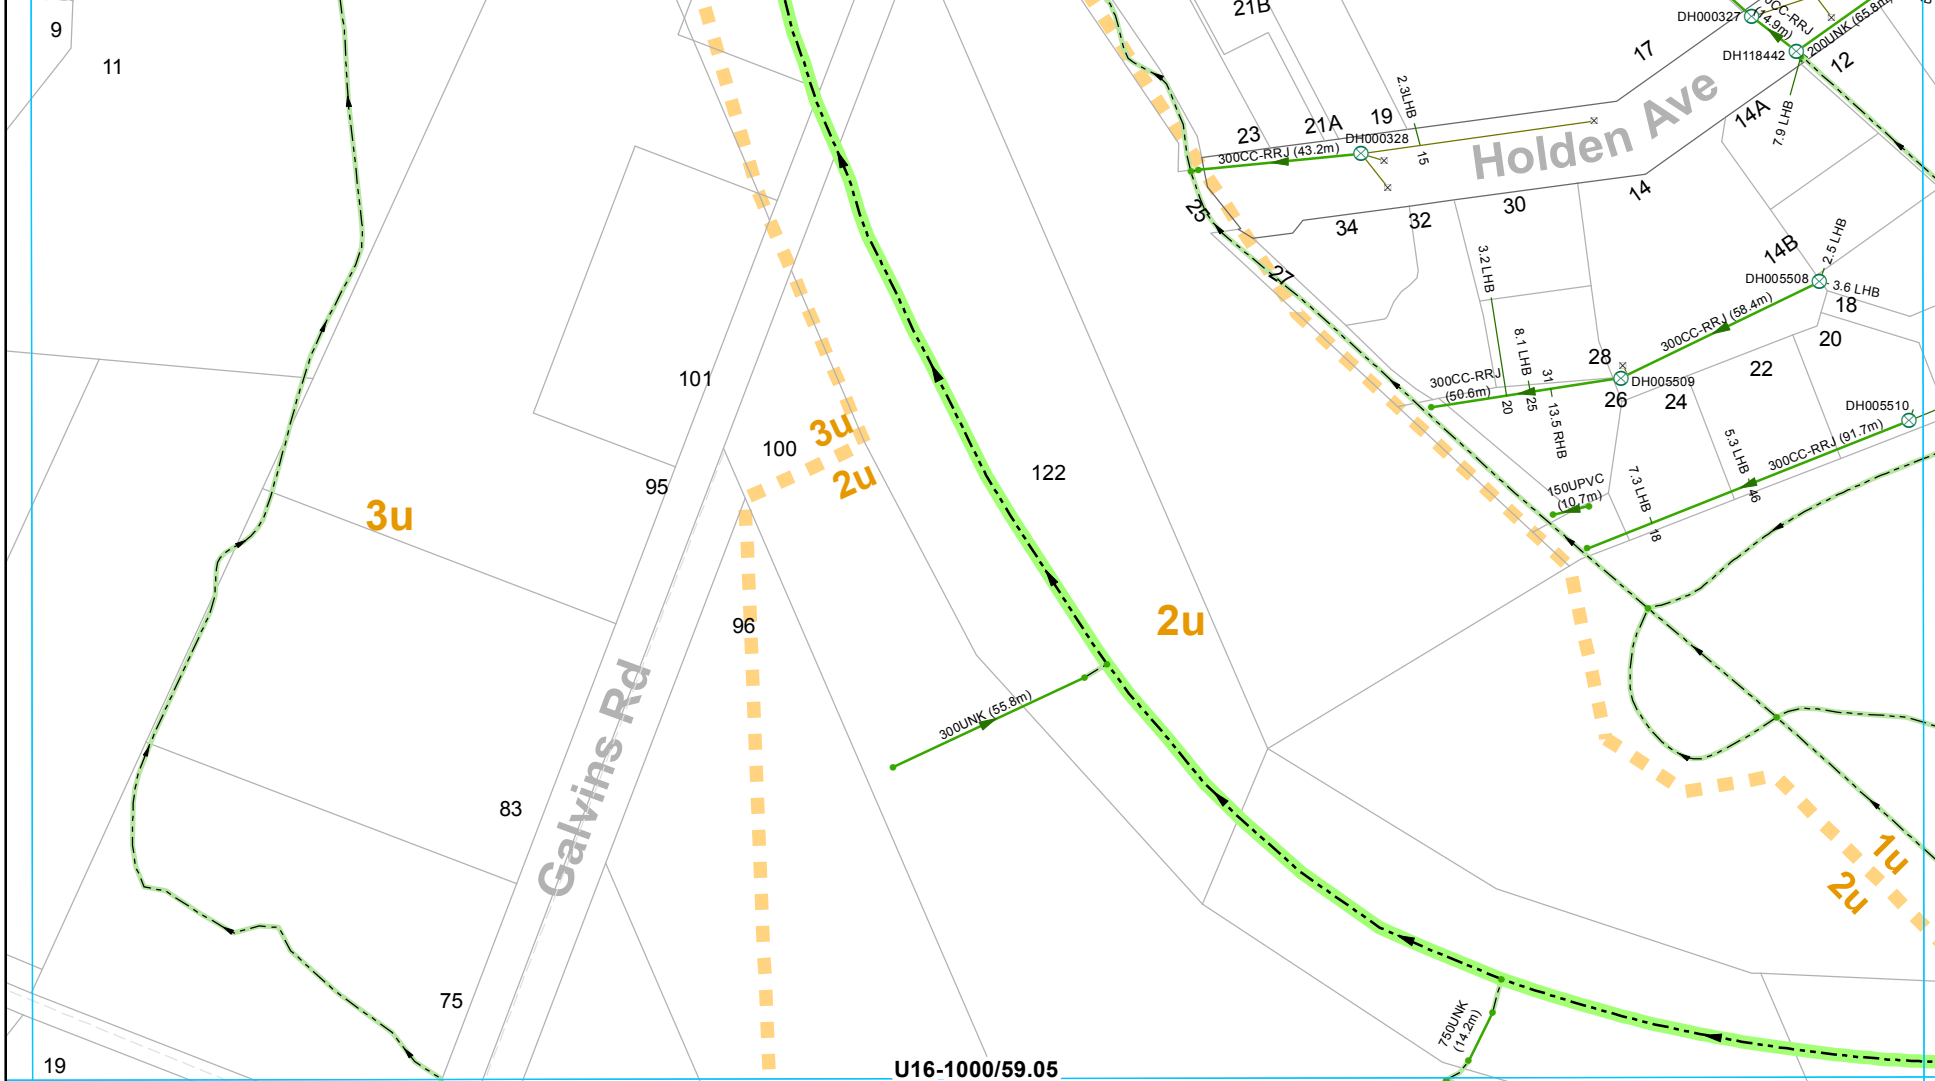

- ⊗ SWManhole
- × SWInlet
- Node
- Open Drain
- Stream
- Culvert
- Gravity Main
- SWServiceline
- SWServiceline
- SWLead
- Catchment Boundary

STORMWATER SERVICES
1:2000 @ A3 - (U16-1000/59.04)


This data is derived from sources outside the control of Rotorua District Council and is for information only. All dimensions and levels should be verified by physical location on-site.

Rotorua District Council 2006. Facsimile 07 346 3143 Telephone 07 348 4199 email mail@rdc.govt.nz

U16-1000/60.03

Lake Rotorua
Not in a catchment. Bay Of Plenty Region

Not in a catchment. Bay Of Plenty Region
1u

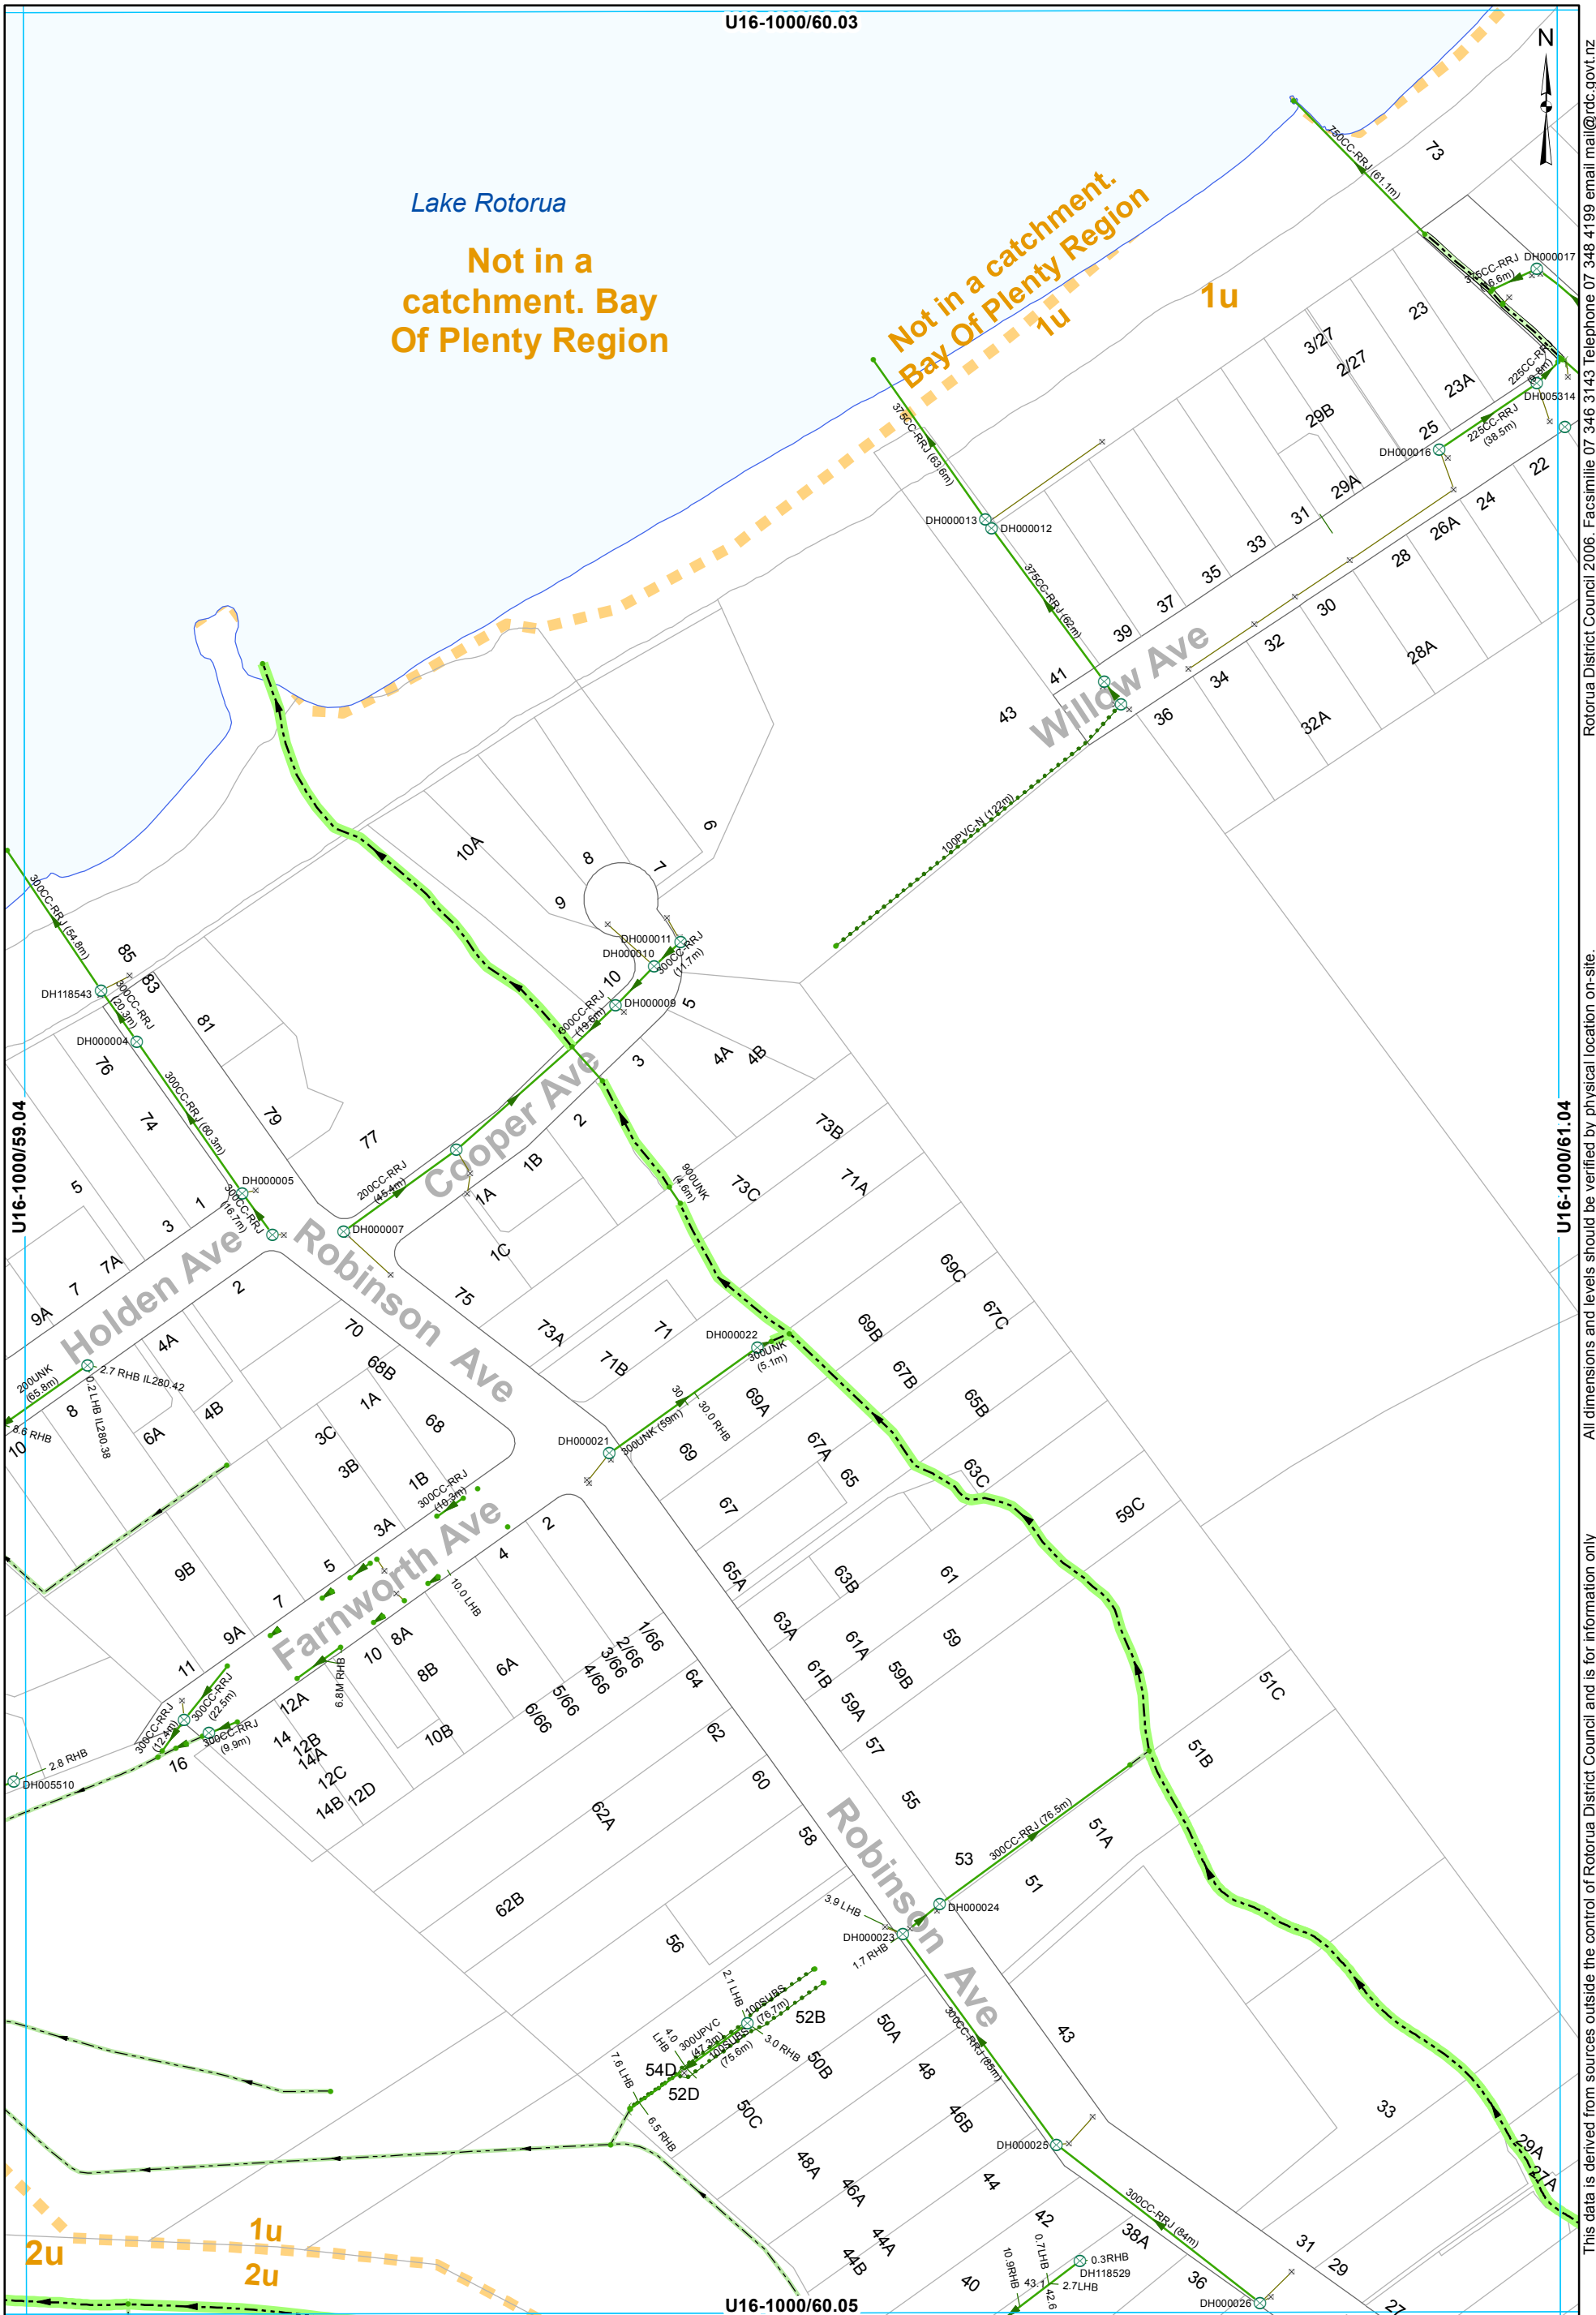

U16-1000/69.04

U16-1000/61.04


U16-1000/60.05

- ⊗ SWManhole
- ⊗ SWInlet
- Node
- Headwall Structure
- ▬ Lined Channel
- Open Drain
- Stream
- Culvert
- Gravity Main
- Subsoil Drain
- SWServiceline
- SWServiceline
- SWLead
- ▬ Catchment Boundary

STORMWATER SERVICES
1:2000 @ A3 - (U16-1000/60.04)

This data is derived from sources outside the control of Rotorua District Council and is for information only

Rotorua District Council 2006. Facsimile 07 346 3143 Telephone 07 348 4199 email mail@rdc.govt.nz

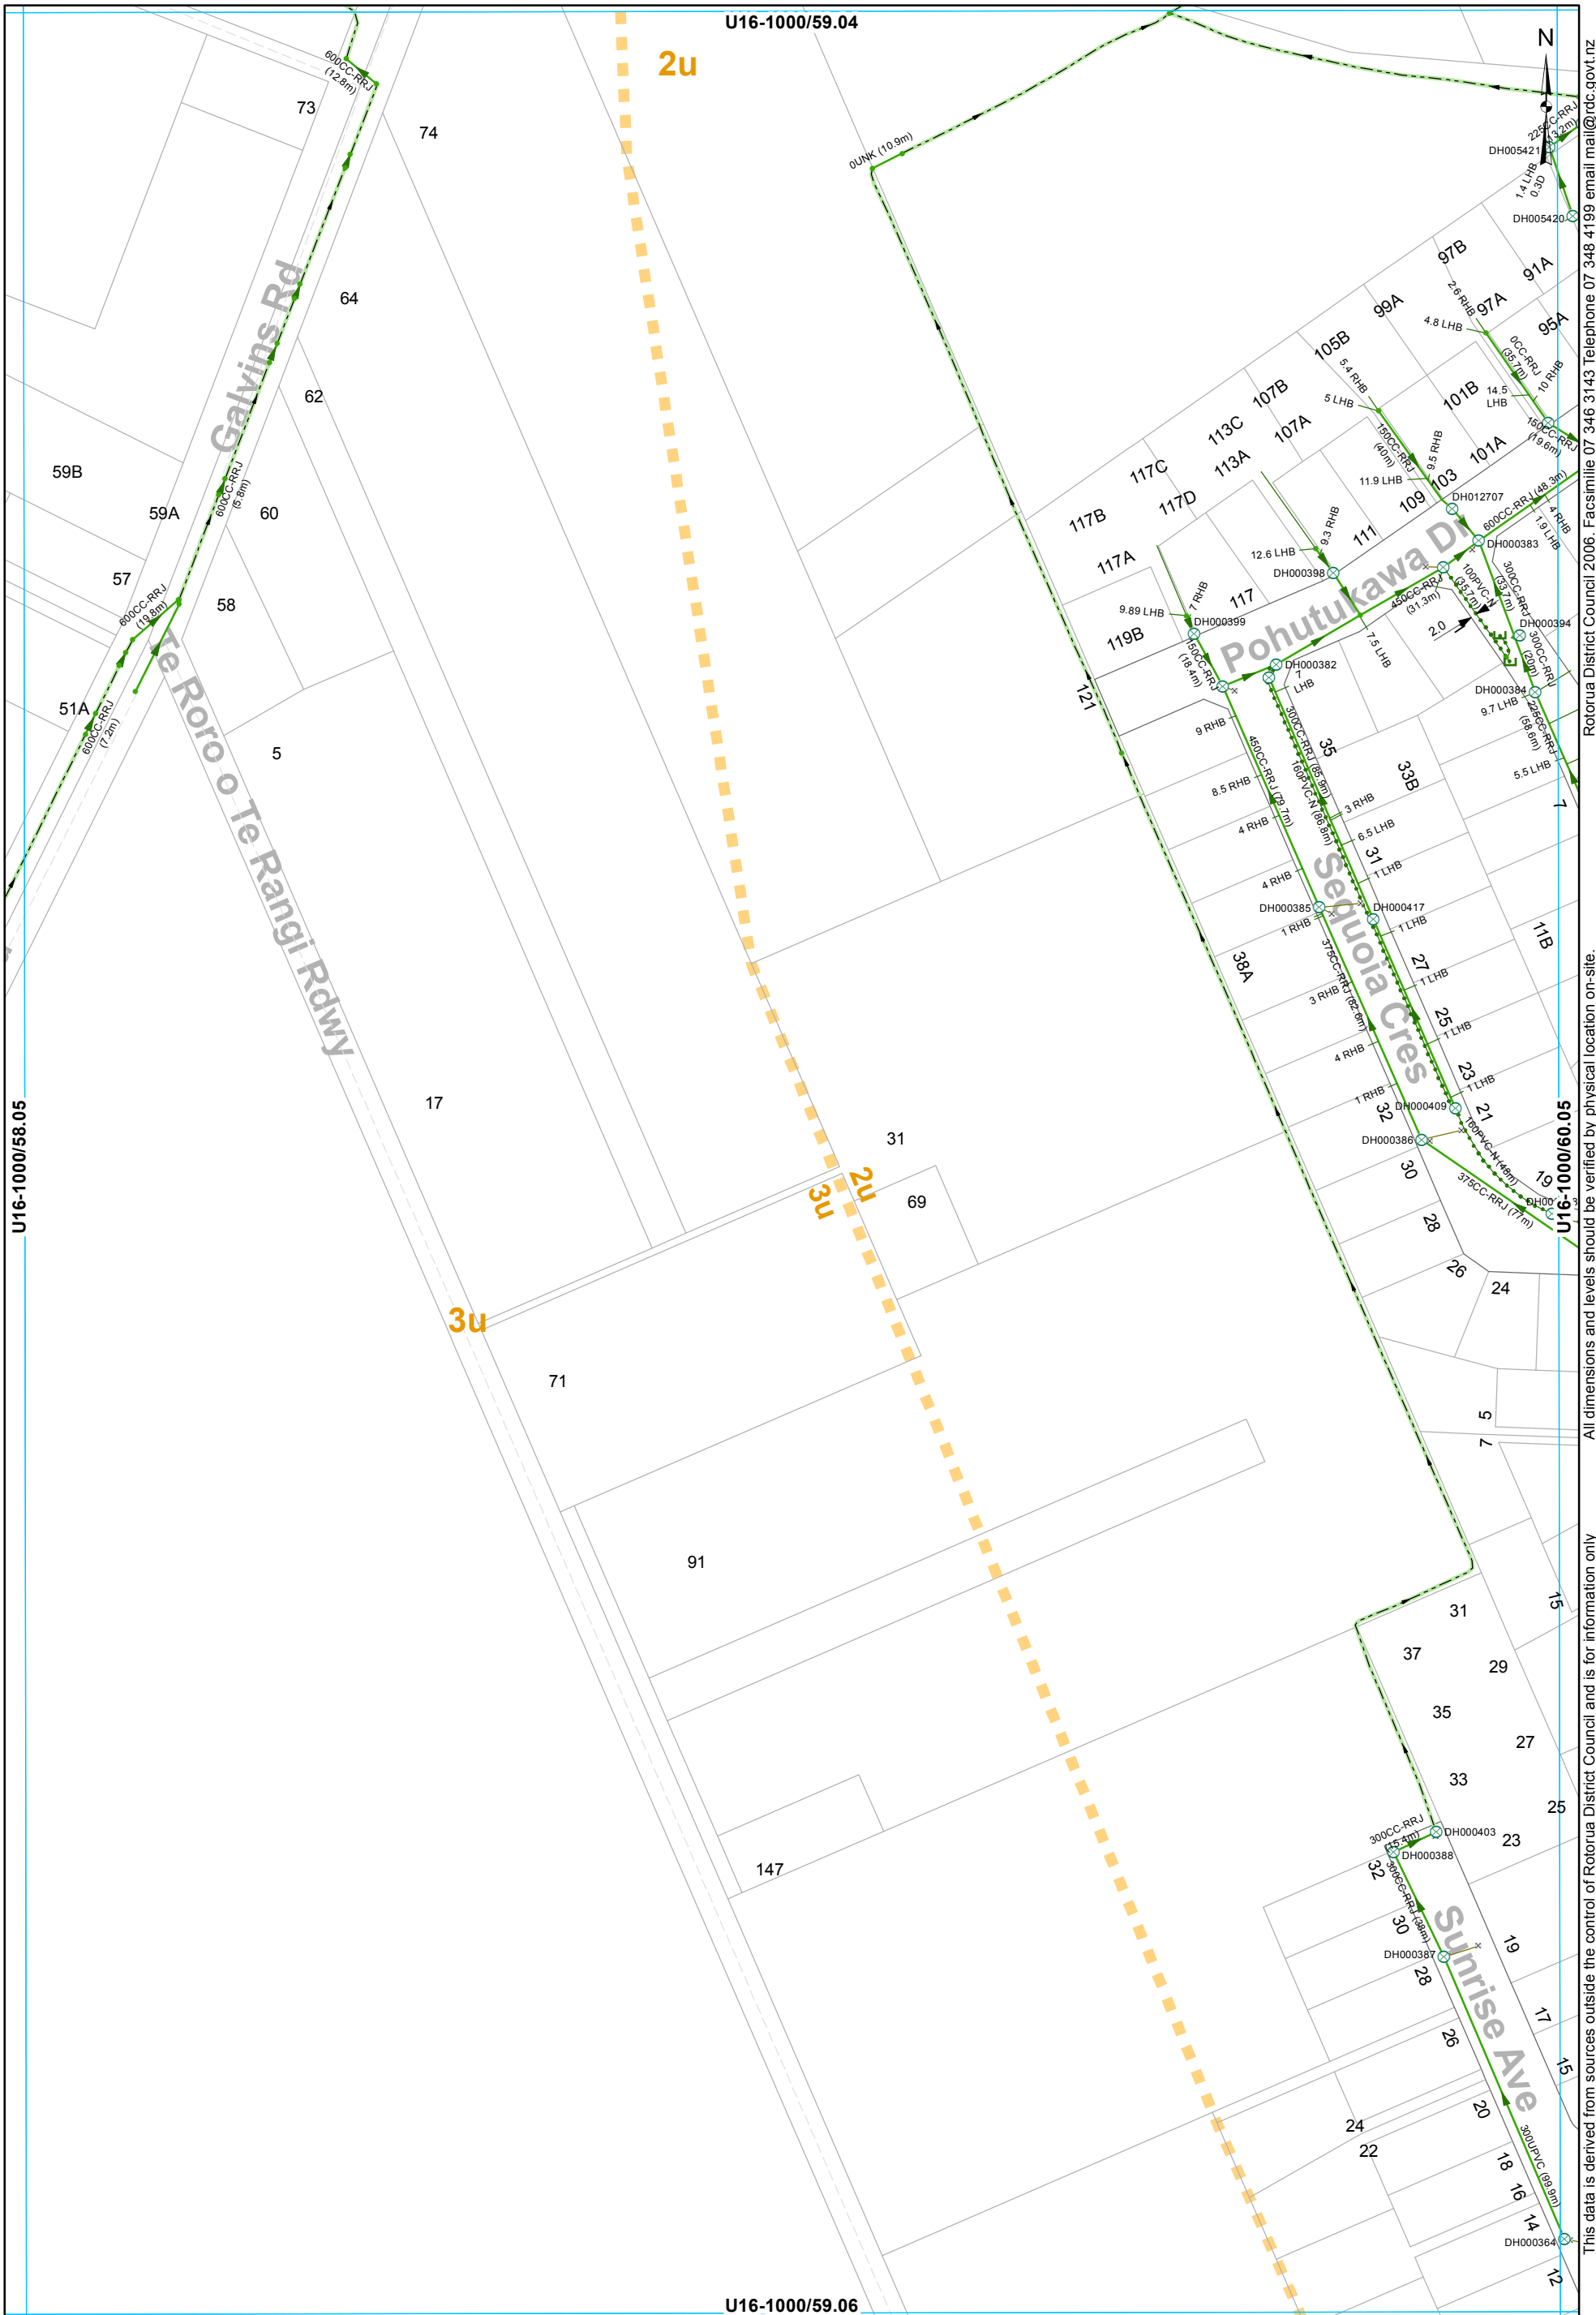


All dimensions and levels outside the control of Rotorua District Council and is for information only

Rotorua District Council 2006. Facsimile 07 346 3143 Telephone 07 348 4199 email mail@rdc.govt.nz

- ⊗ SWManhole
- × SWInlet
- Node
- ▭ Capped End
- Open Drain
- Culvert
- Gravity Main
- Subsoil Drain
- SWServiceline
- SWServiceline
- SWLead
- Catchment Boundary

STORMWATER SERVICES
1:2000 @ A3 - (U16-1000/59.05)

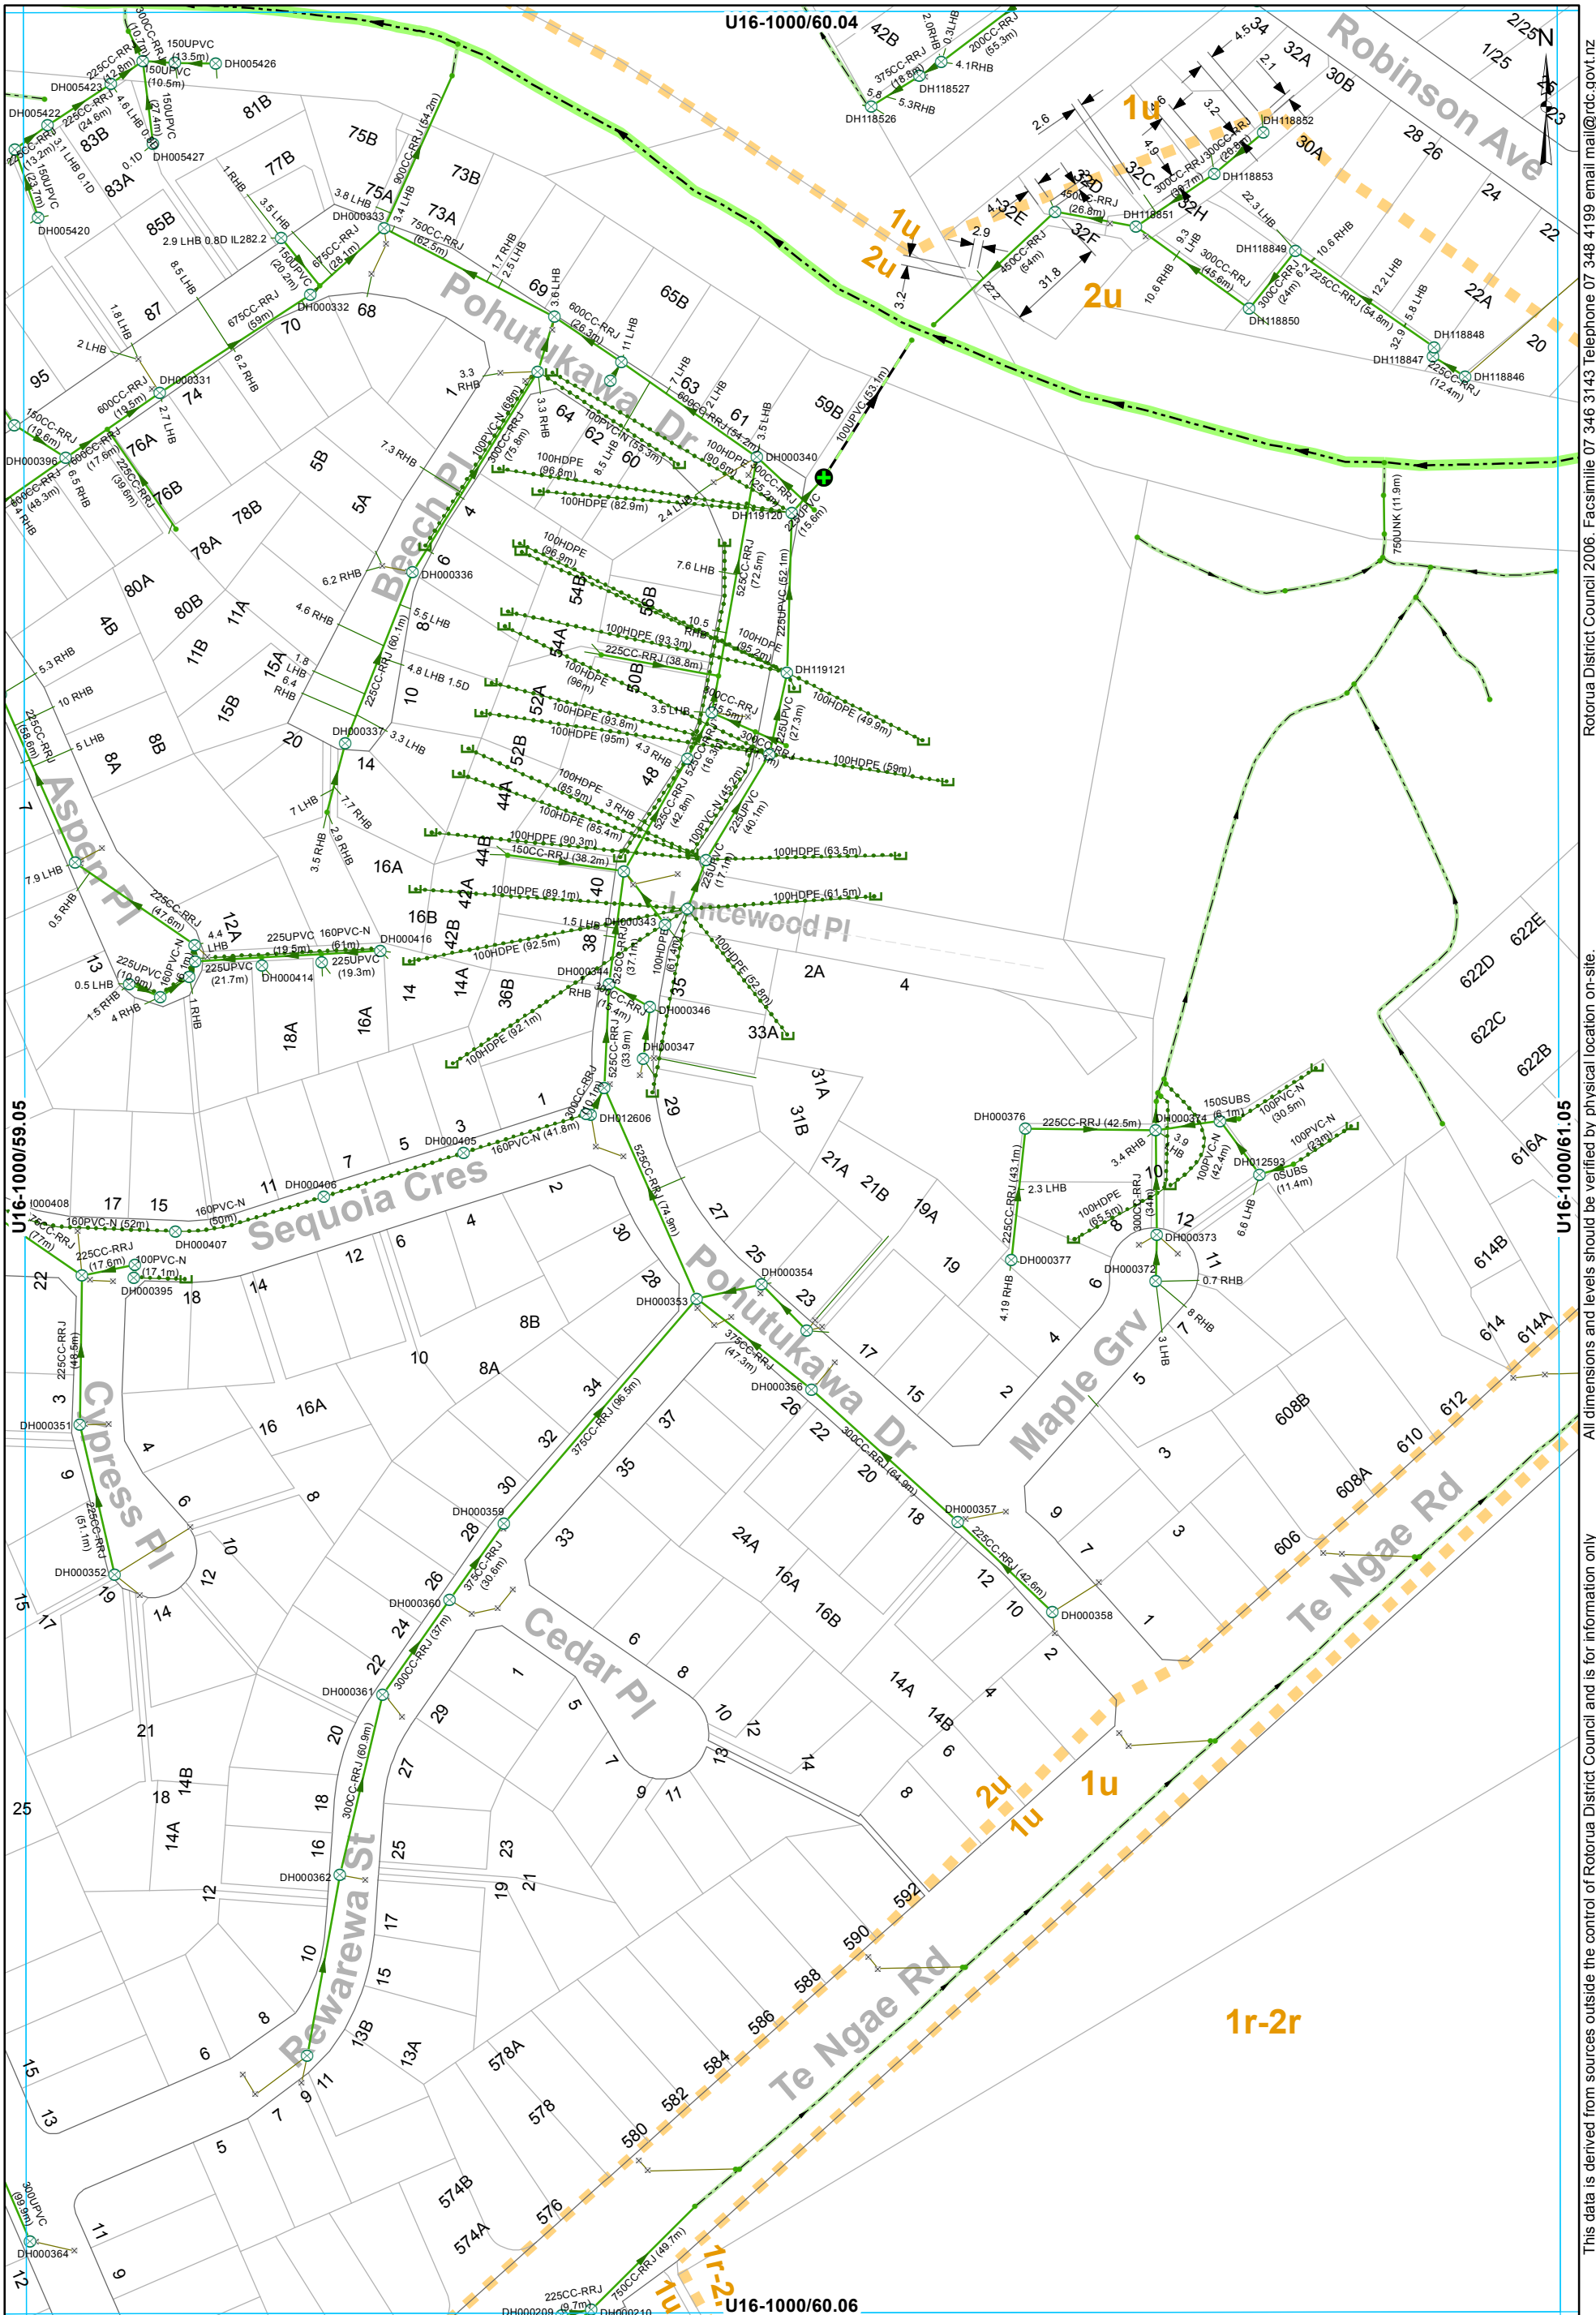


- SWManhole
- SWPumpStation
- SWInlet
- Node
- Capped End
- Open Drain
- Stream
- Culvert
- Gravity Main
- Rising Main
- Subsoil Drain
- SWServiceline
- SWServiceline
- SWLead
- Catchment Boundary

STORMWATER SERVICES
 1:2000 @ A3 - (U16-1000/60.05)


This data is derived from sources outside the control of Rotorua District Council and is for information only

Rotorua District Council 2006. Facsimile 07 346 3143 Telephone 07 348 4199 email mail@rdc.govt.nz

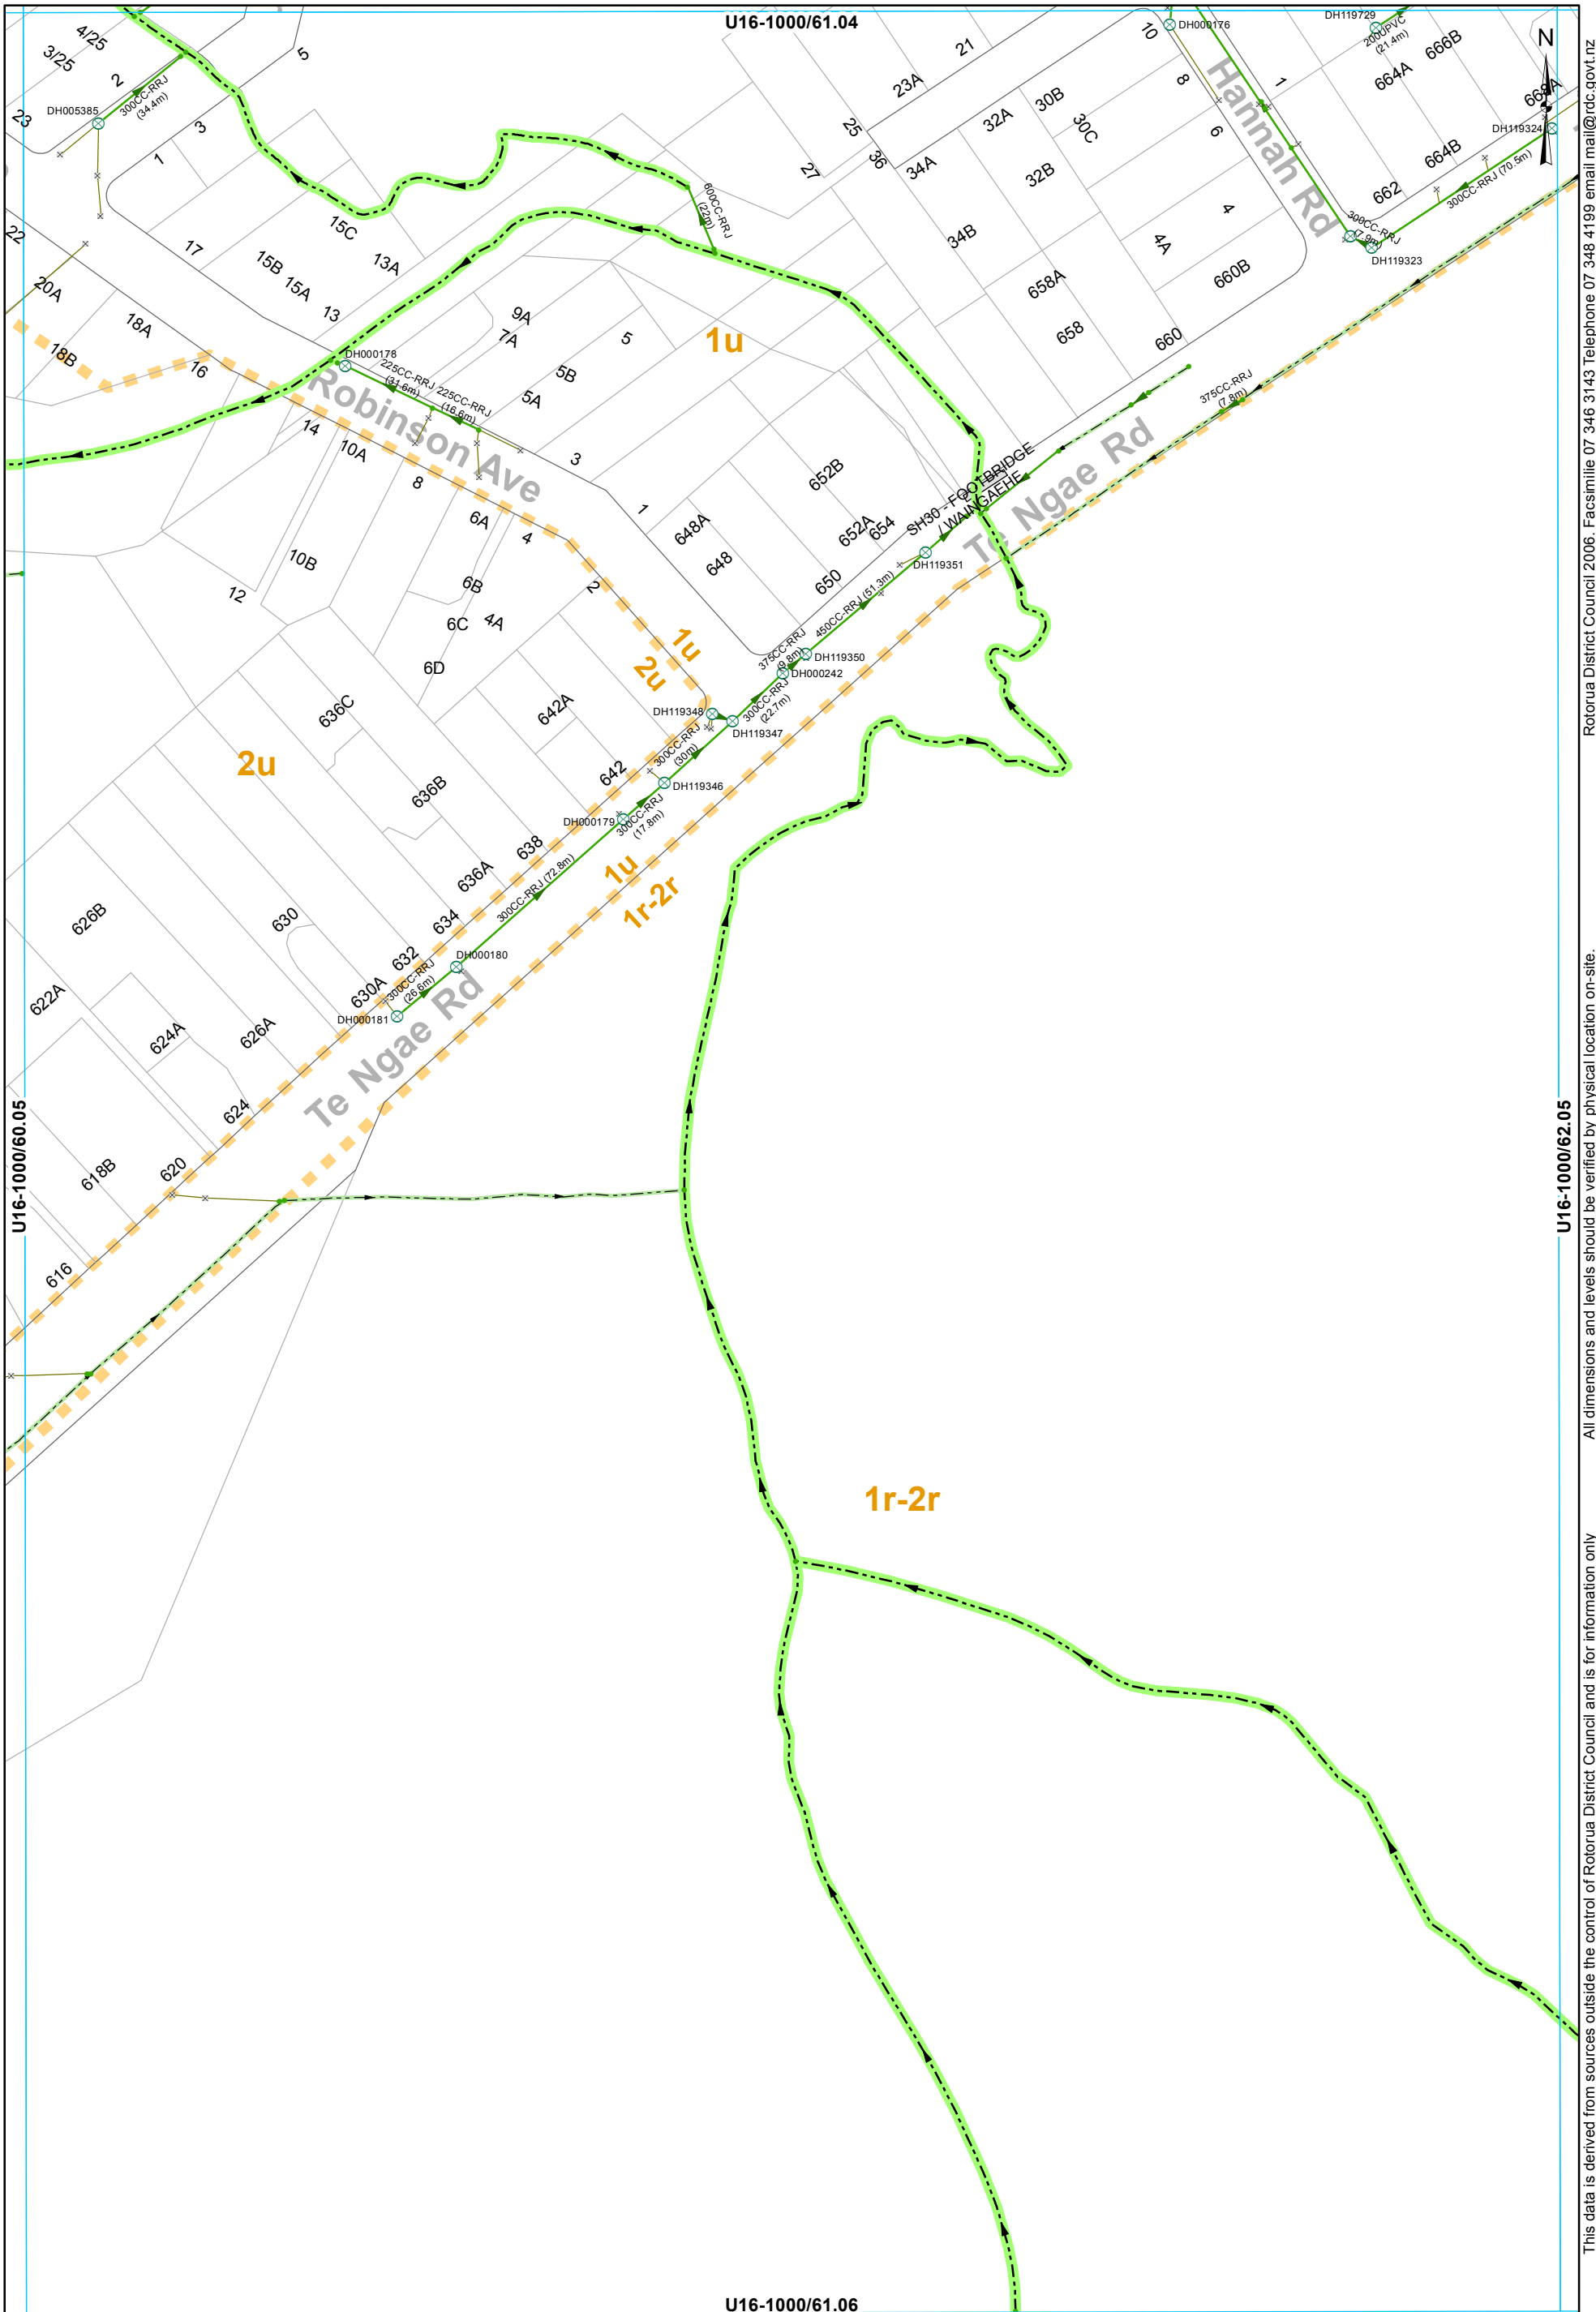

- ⊗ SWManhole
- × SWInlet
- Node
- Open Drain
- Stream
- Gravity Main
- SWServiceline
- SWServiceline
- SWLead
- Catchment Boundary

STORMWATER SERVICES
 1:2000 @ A3 - (U16-1000/61.05)

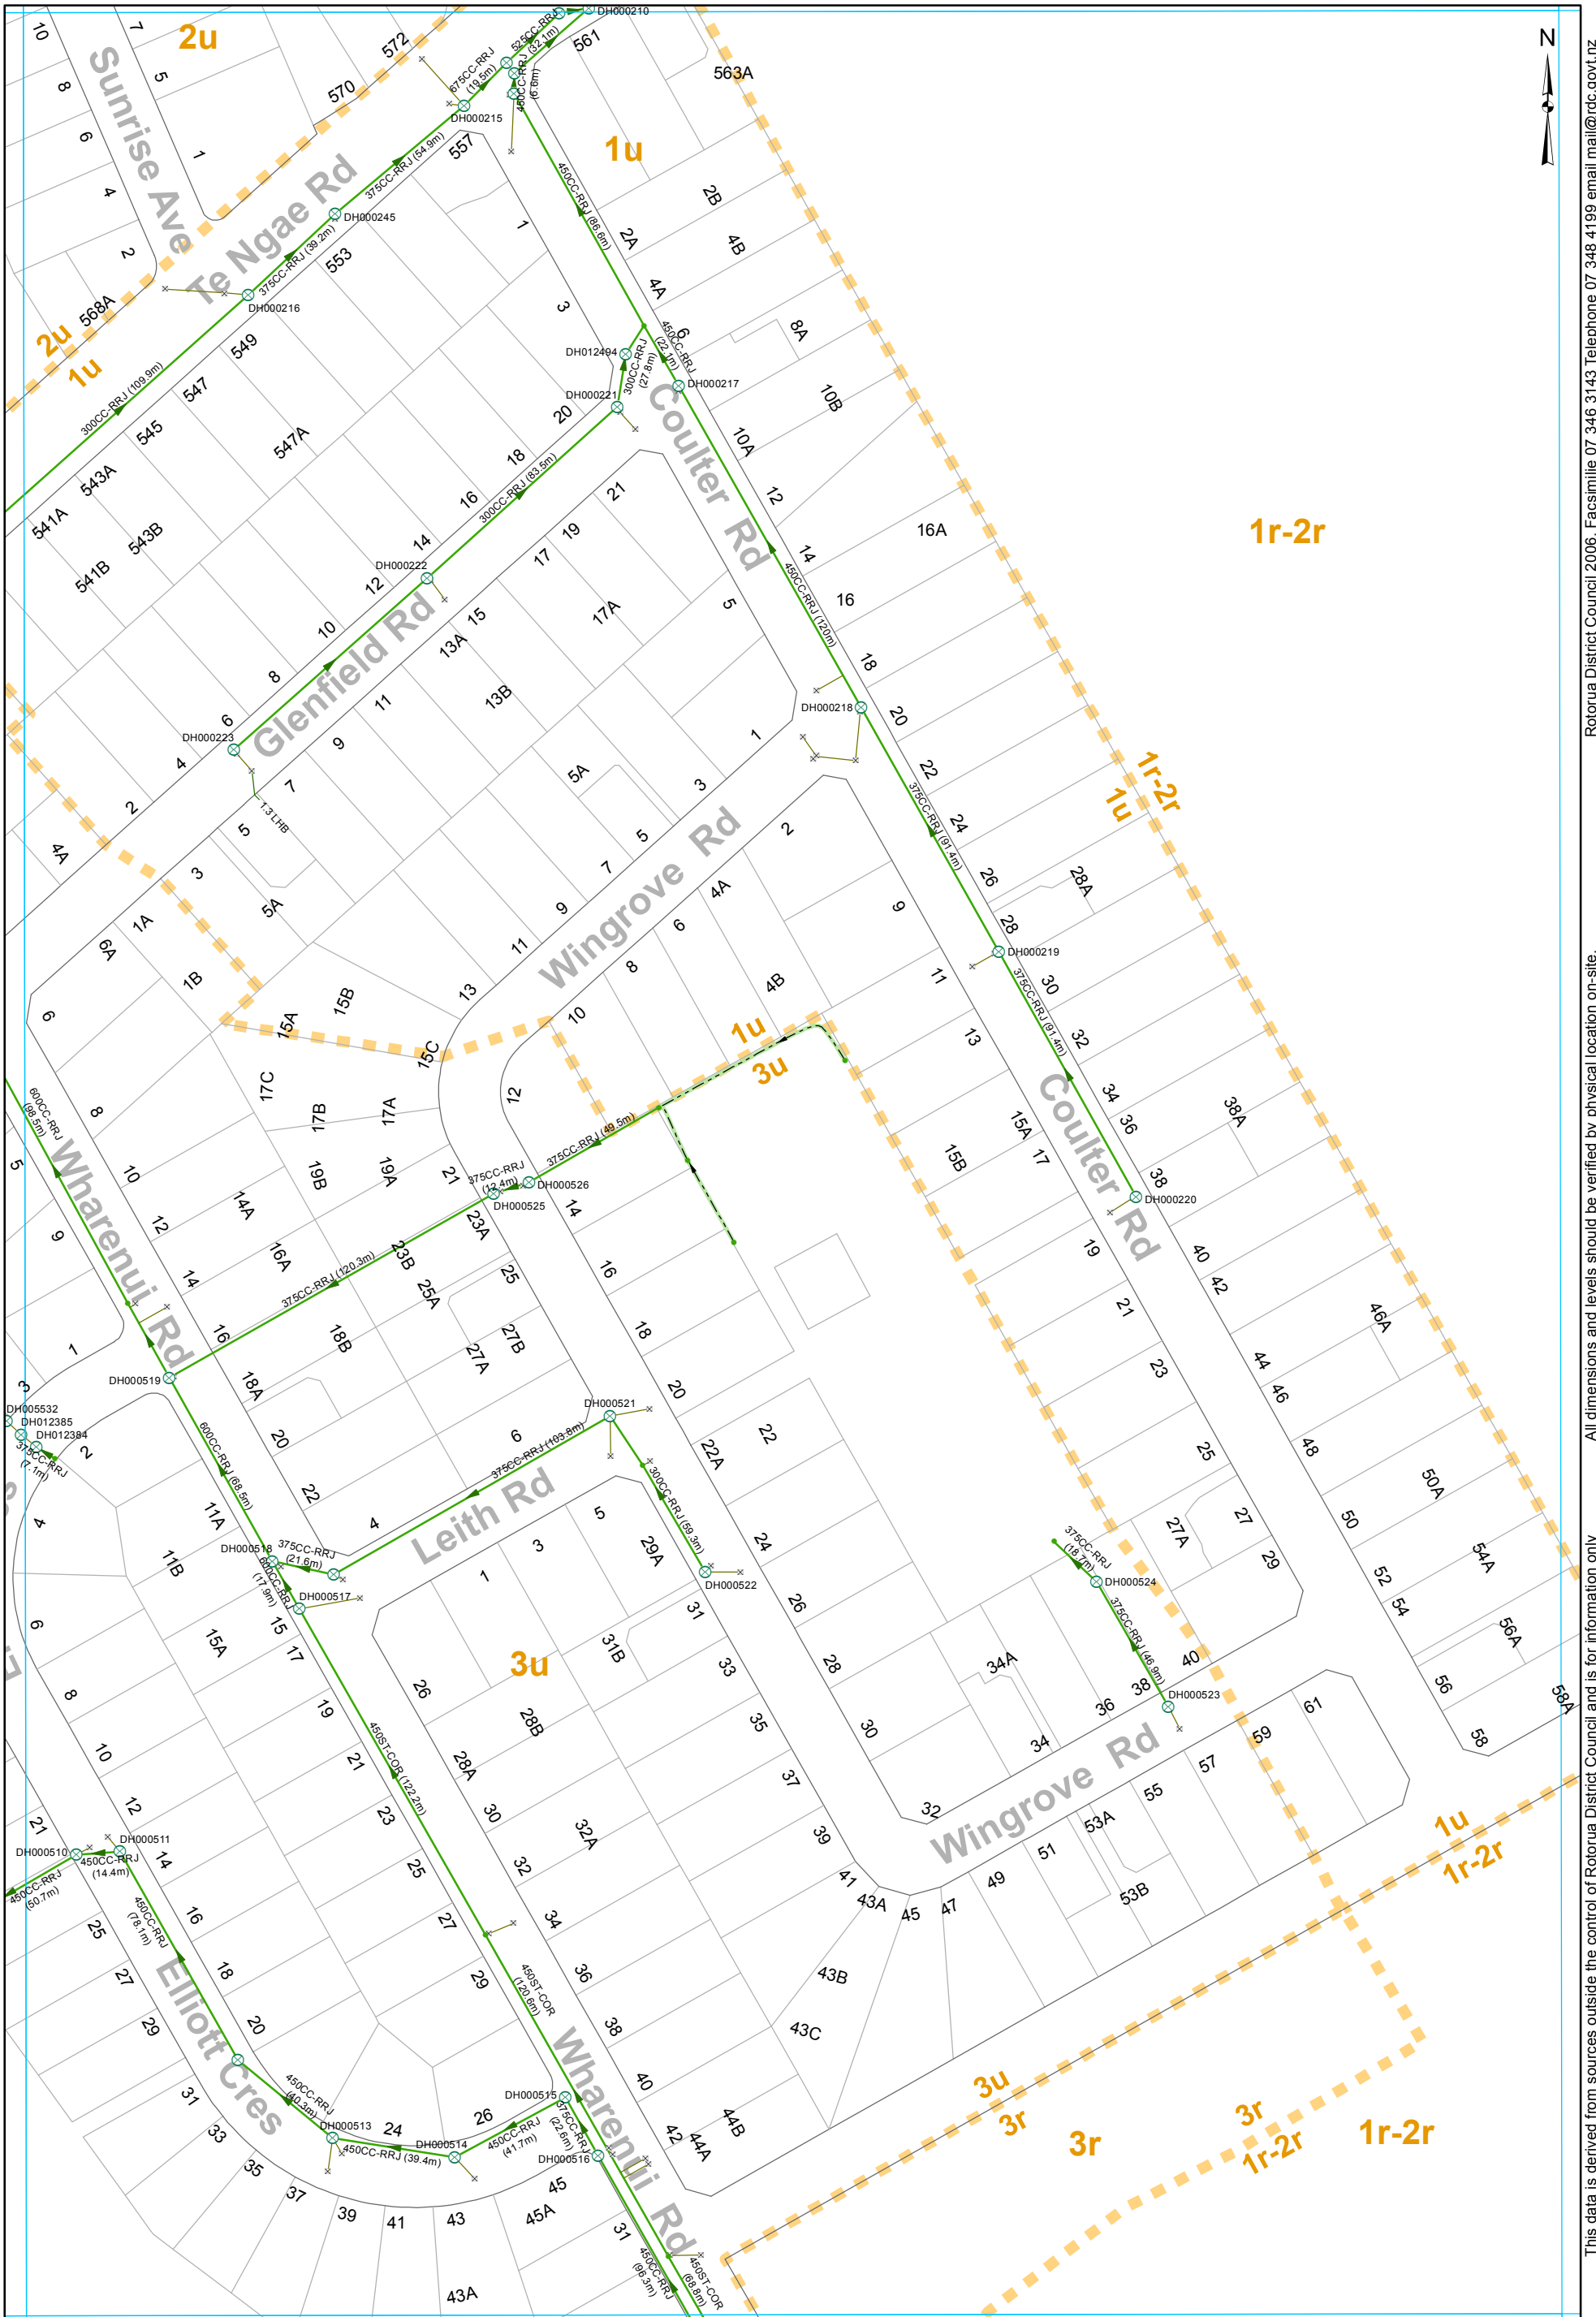

- ⊗ SWManhole
- × SWInlet
- Node
- Open Drain
- Gravity Main
- SWServiceline
- SWServiceline
- SWLead
- - - Catchment Boundary

STORMWATER SERVICES
1:2000 @ A3 - (U16-1000/60.06)

This data is derived from sources outside the control of Rotorua District Council and is for information only

All dimensions and levels should be verified by physical location on-site.

Rotorua District Council 2006. Facsimile 07 346 3143 Telephone 07 348 4199 email mail@rdc.govt.nz