

Storm Water Asbuilt Sheet Index  
SWcatchment 3u






Lake Rotorua

Not in a catchment. Bay Of Plenty Region

Not in a catchment. Bay Of Plenty Region

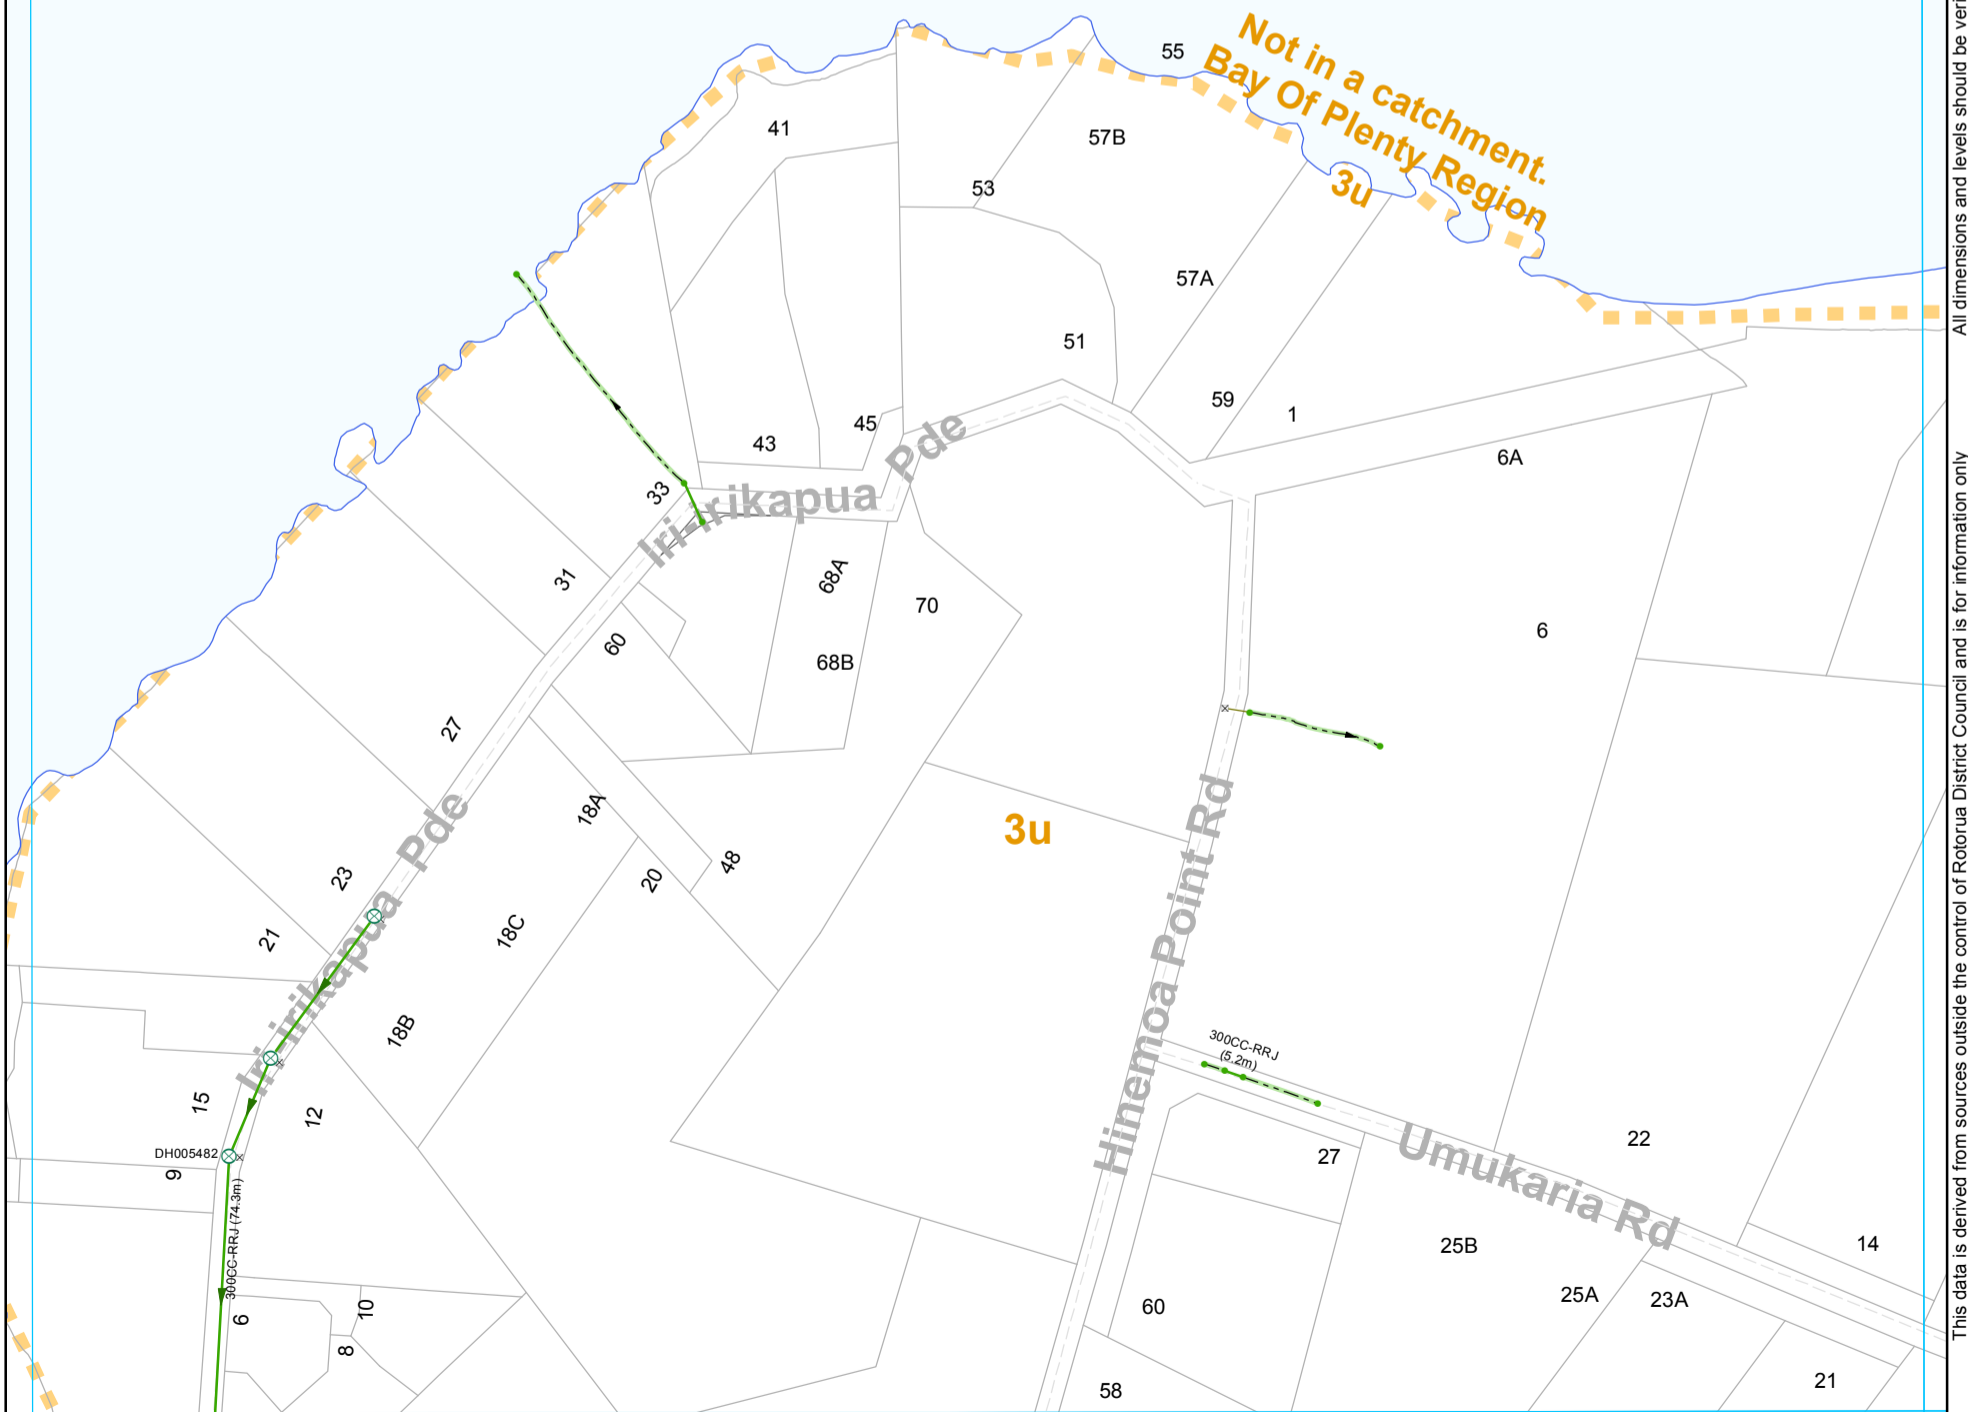

- ⊗ SWManhole
- × SWInlet
- Node
- Open Drain
- Culvert
- Gravity Main
- SWLead
- Catchment Boundary

STORMWATER SERVICES  
1:2000 @ A3 - (U16-1000/58.04)

This data is derived from sources outside the control of Rotorua District Council and is for information only

Rotorua District Council 2006. Facsimile 07 346 3143 Telephone 07 348 4199 email mail@rdc.govt.nz

U16-1000/59.03



Lake Rotorua


Not in a catchment. Bay Of Plenty Region

Not in a catchment. Bay Of Plenty Region

Not in a catchment. Bay Of Plenty Region

U16-1000/58.04

U16-1000/60.04

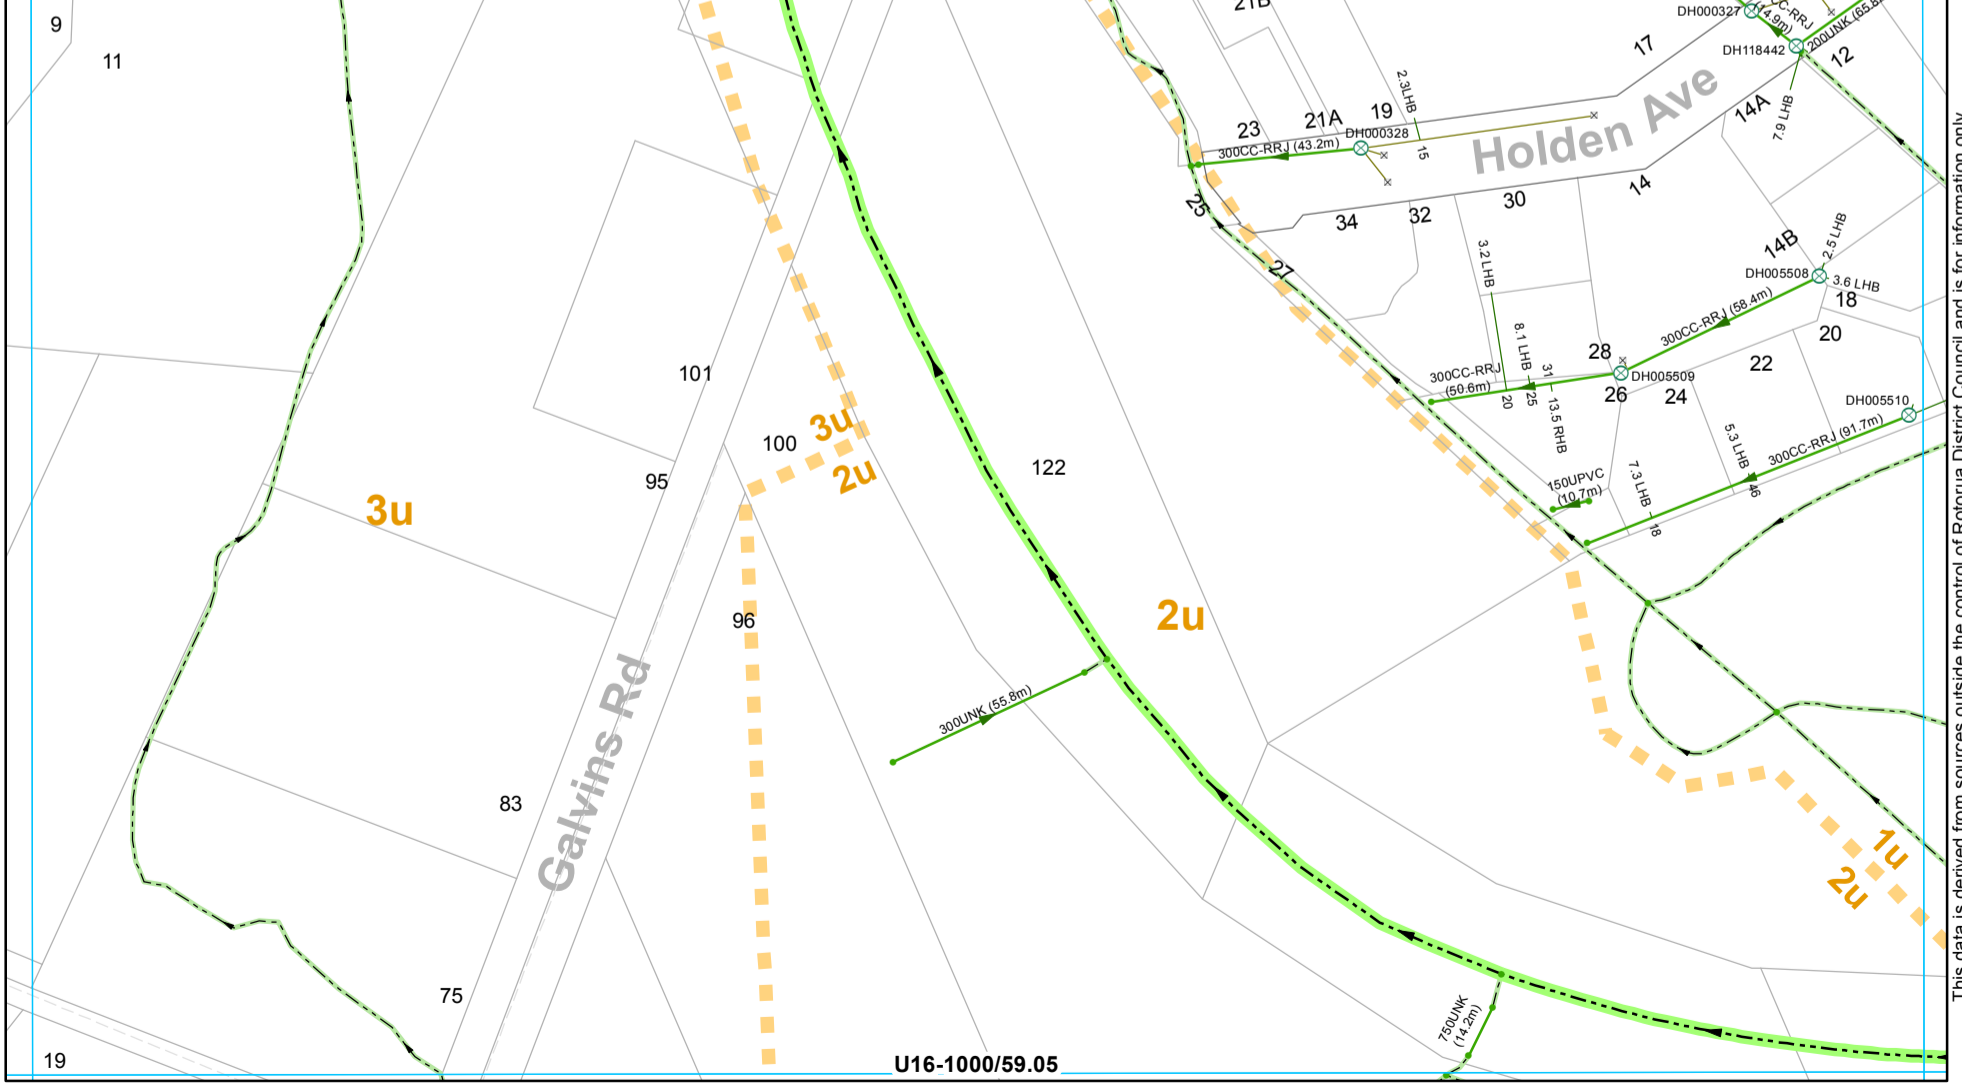

- ⊗ SWManhole
- × SWInlet
- Node
- Open Drain
- Stream
- Culvert
- Gravity Main
- SWServiceline
- SWServiceline
- SWLead
- Catchment Boundary

STORMWATER SERVICES  
1:2000 @ A3 - (U16-1000/59.04)

This data is derived from sources outside the control of Rotorua District Council and is for information only. All dimensions and levels should be verified by physical location on-site.

Rotorua District Council 2006. Facsimile 07 346 3143 Telephone 07 348 4199 email mail@rdc.govt.nz




- Node
- ▬ Lined Channel
- ▬ Open Drain
- ▬ Gravity Main
- ▬ Catchment Boundary

**STORMWATER SERVICES**  
 1:2000 @ A3 - (U16-1000/57.05)

This data is derived from sources outside the control of Rotorua District Council and is for information only

Rotorua District Council 2006. Facsimile 07 346 3143 Telephone 07 348 4199 email mail@rdc.govt.nz

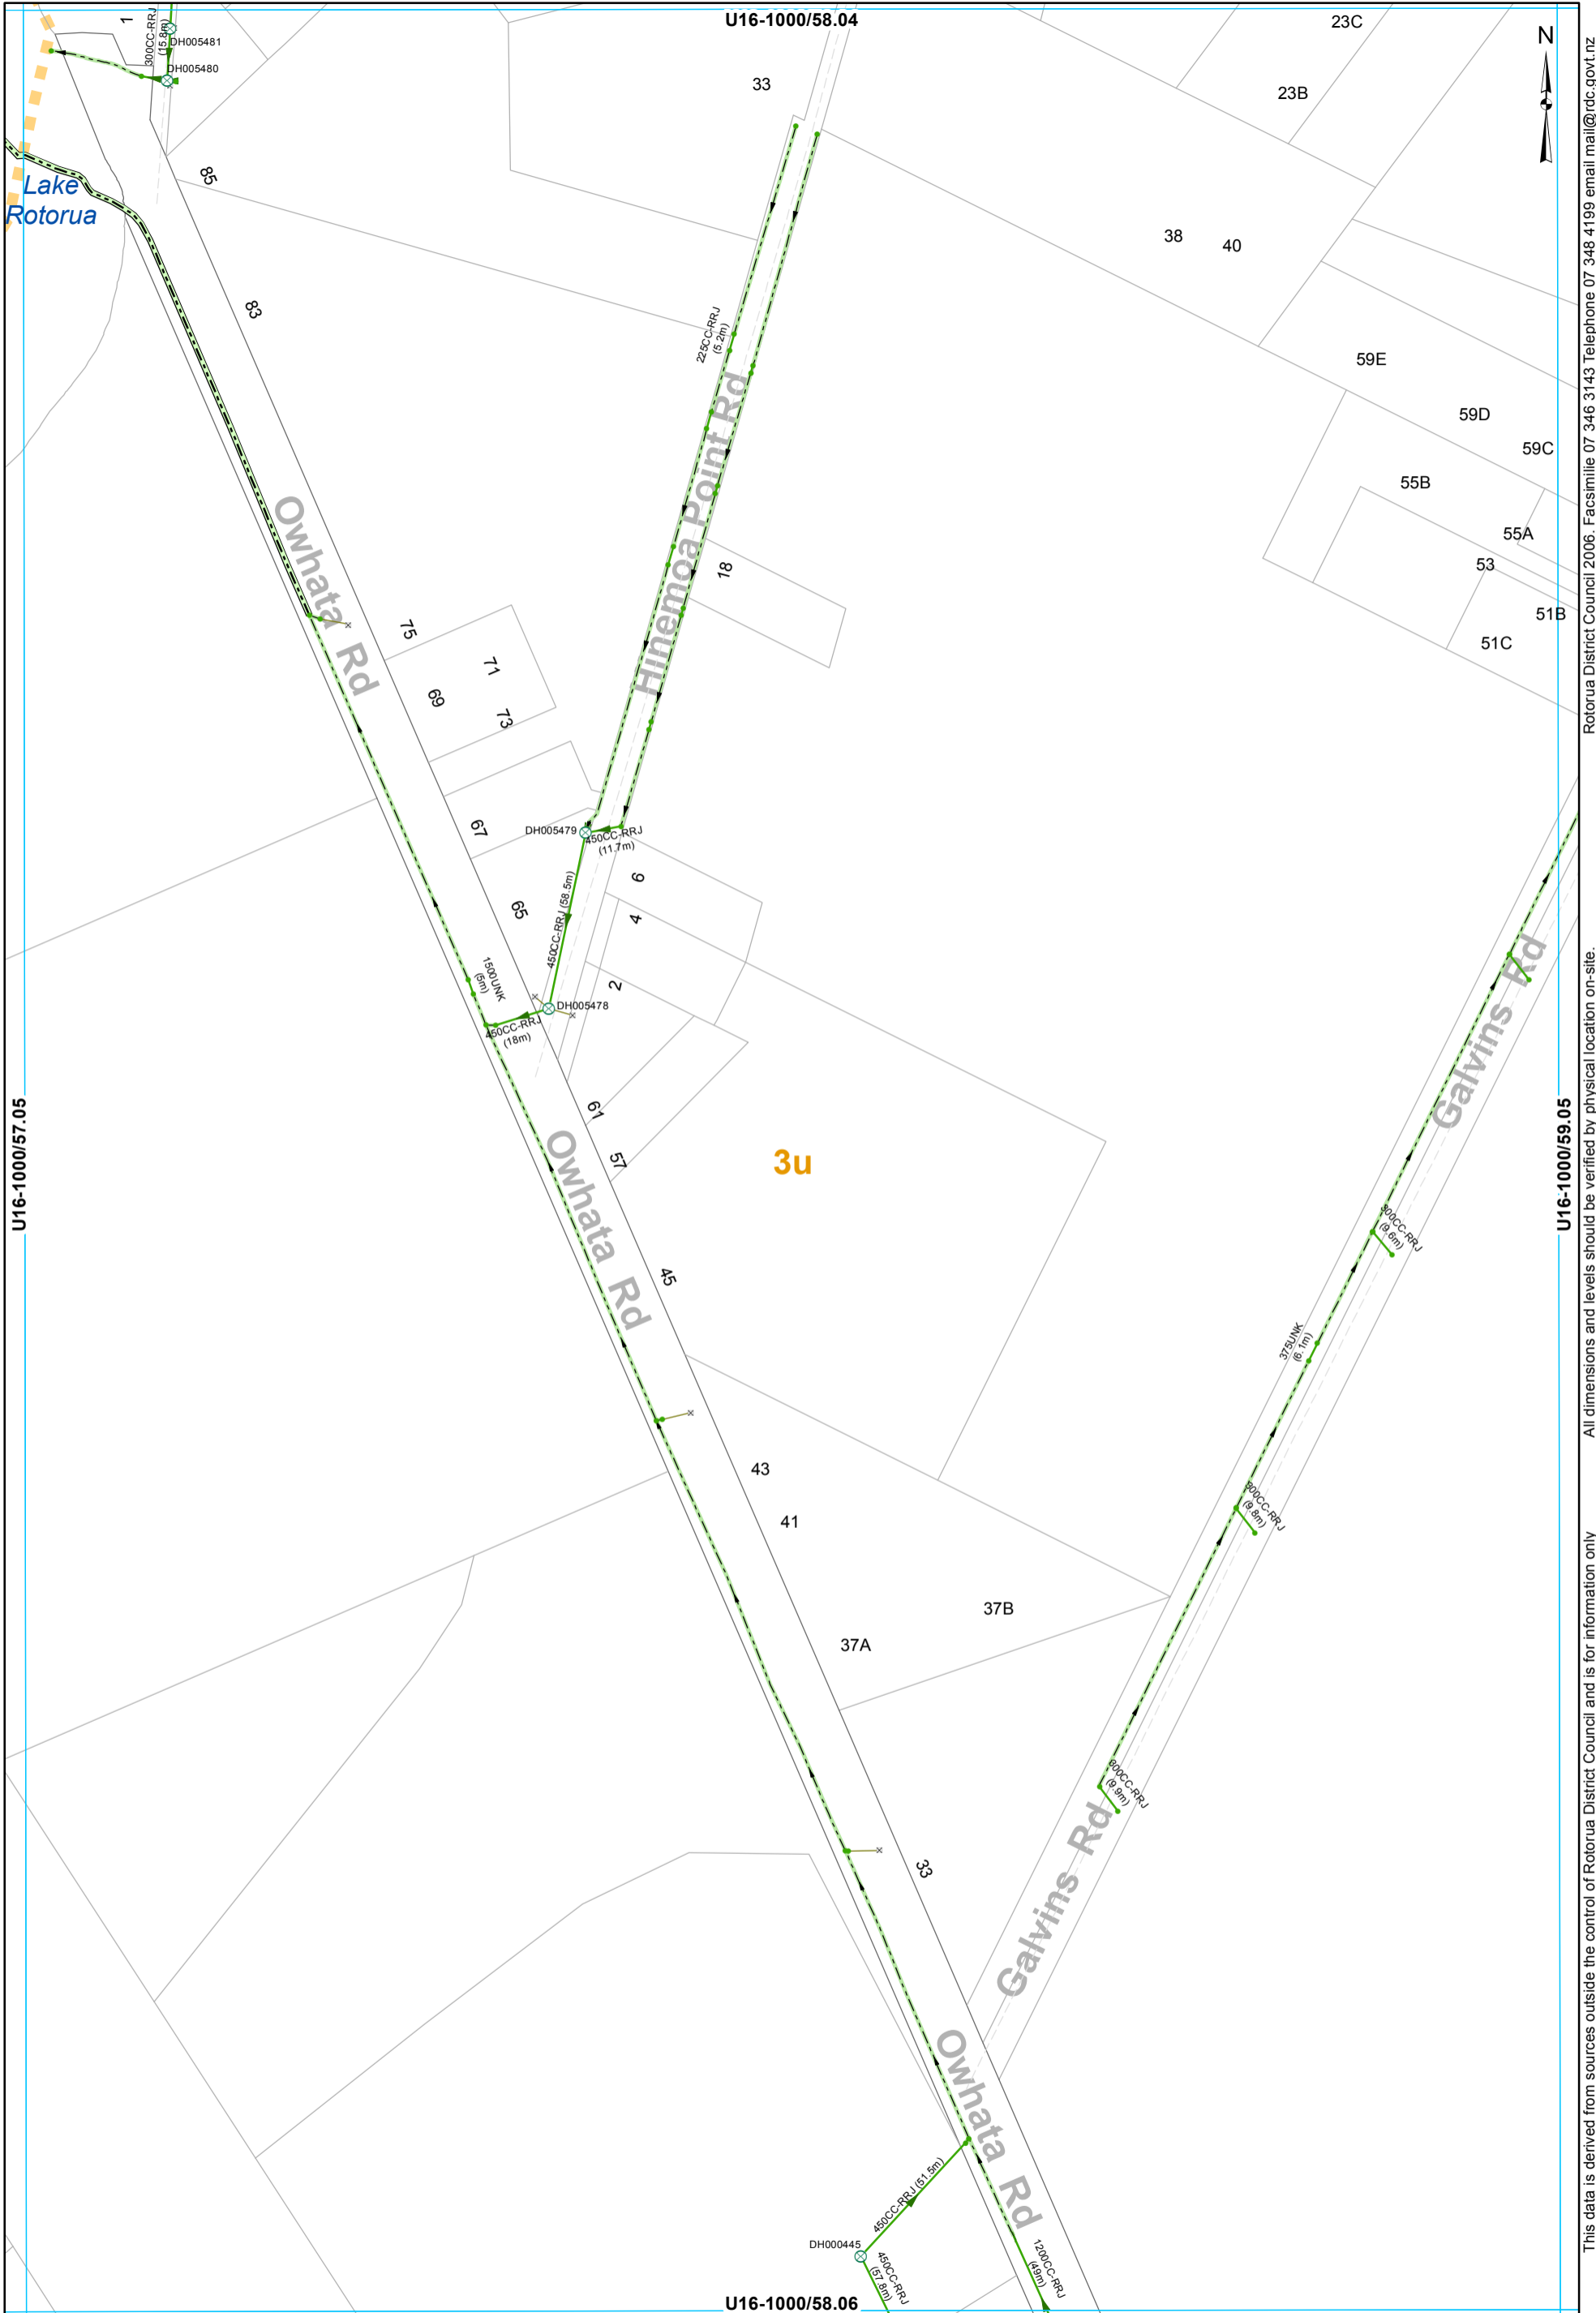


- ⊗ SWManhole
- ⊗ SWInlet
- Node
- Headwall Structure
- Lined Channel
- Open Drain
- Culvert
- Gravity Main
- SWLead
- Catchment Boundary

**STORMWATER SERVICES**  
**1:2000 @ A3 - (U16-1000/58.05)**

This data is derived from sources outside the control of Rotorua District Council and is for information only

All dimensions and levels should be verified by physical location on-site.

Rotorua District Council 2006. Facsimile 07 346 3143 Telephone 07 348 4199 email mail@rdc.govt.nz

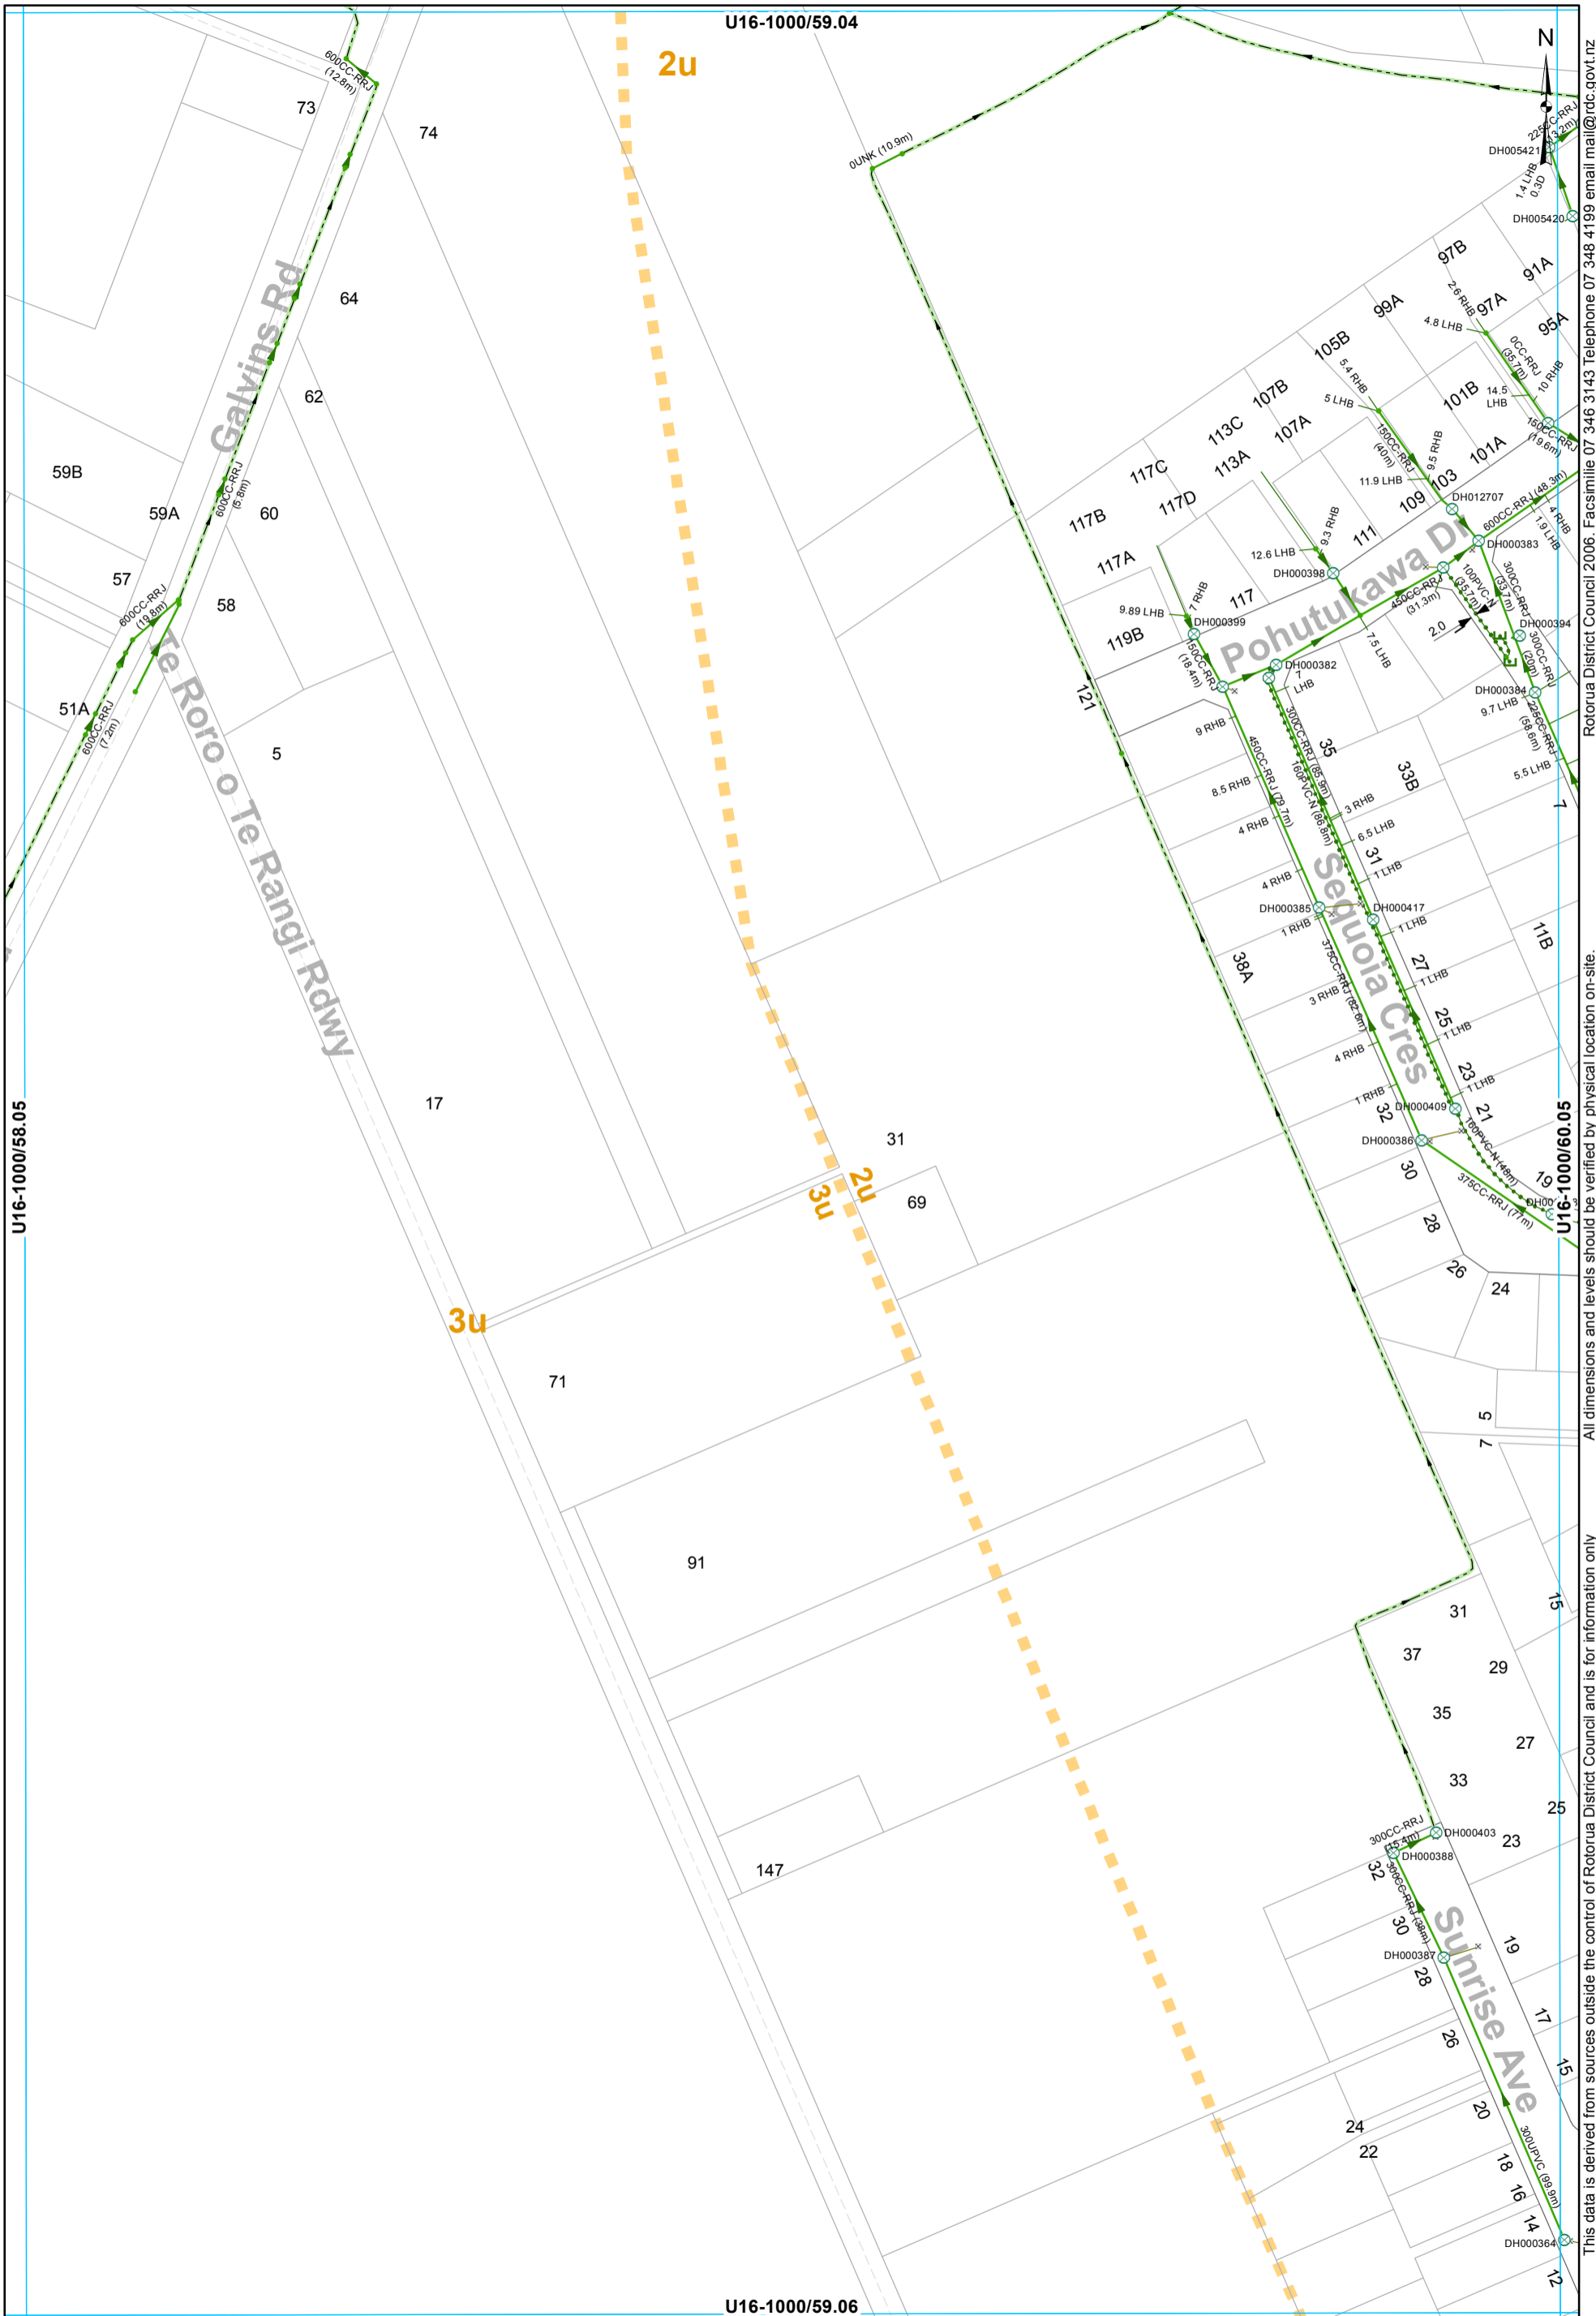


All dimensions and levels outside the control of Rotorua District Council and is for information only

Rotorua District Council 2006. Facsimile 07 346 3143 Telephone 07 348 4199 email mail@rdc.govt.nz

- ⊗ SWManhole
- × SWInlet
- Node
- ◻ Capped End
- Open Drain
- Culvert
- Gravity Main
- Subsoil Drain
- SWServiceline
- SWServiceline
- SWLead
- Catchment Boundary

**STORMWATER SERVICES**  
1:2000 @ A3 - (U16-1000/59.05)

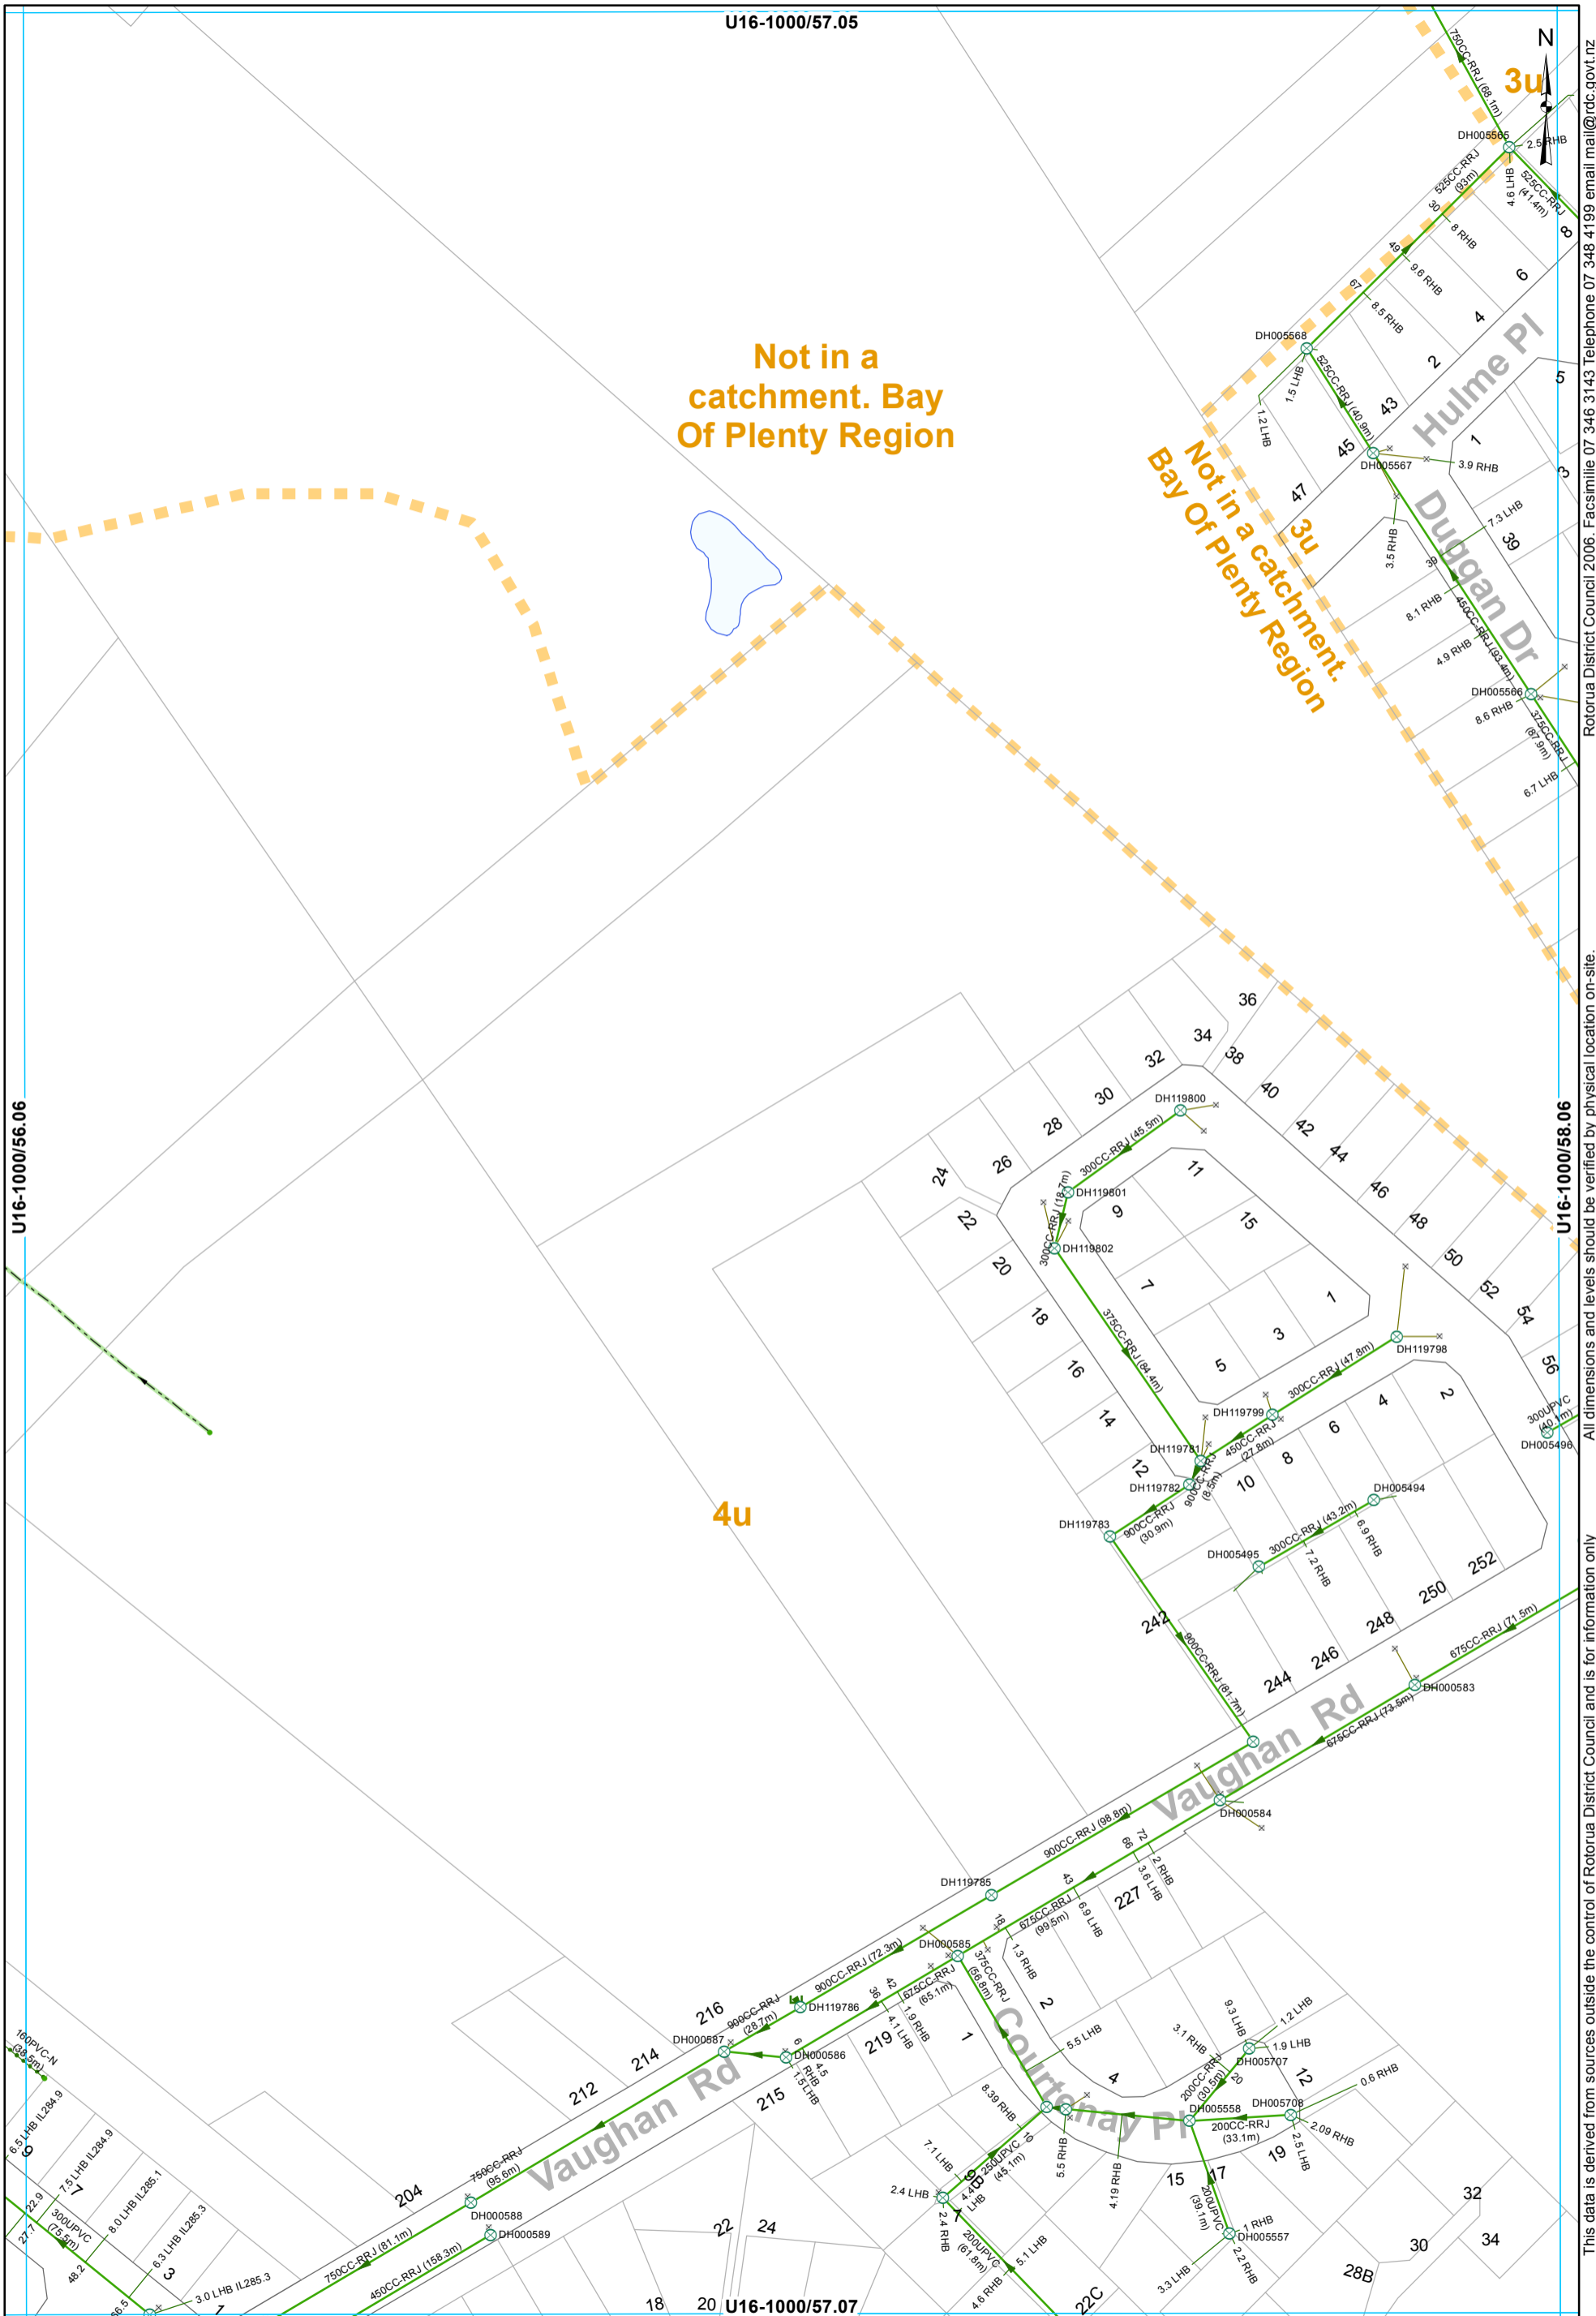

Not in a catchment. Bay Of Plenty Region

Not in a catchment. Bay Of Plenty Region.

4u


3u

- ⊗ SWManhole
- × SWInlet
- Node
- ┌ Capped End
- Open Drain
- Gravity Main
- Subsoil Drain
- SWServiceline
- SWServiceline
- SWLead
- Catchment Boundary

STORMWATER SERVICES  
1:2000 @ A3 - (U16-1000/57.06)

All dimensions and levels should be verified by physical location on-site.

Rotorua District Council 2006. Facsimile 07 346 3143 Telephone 07 348 4199 email mail@rdc.govt.nz

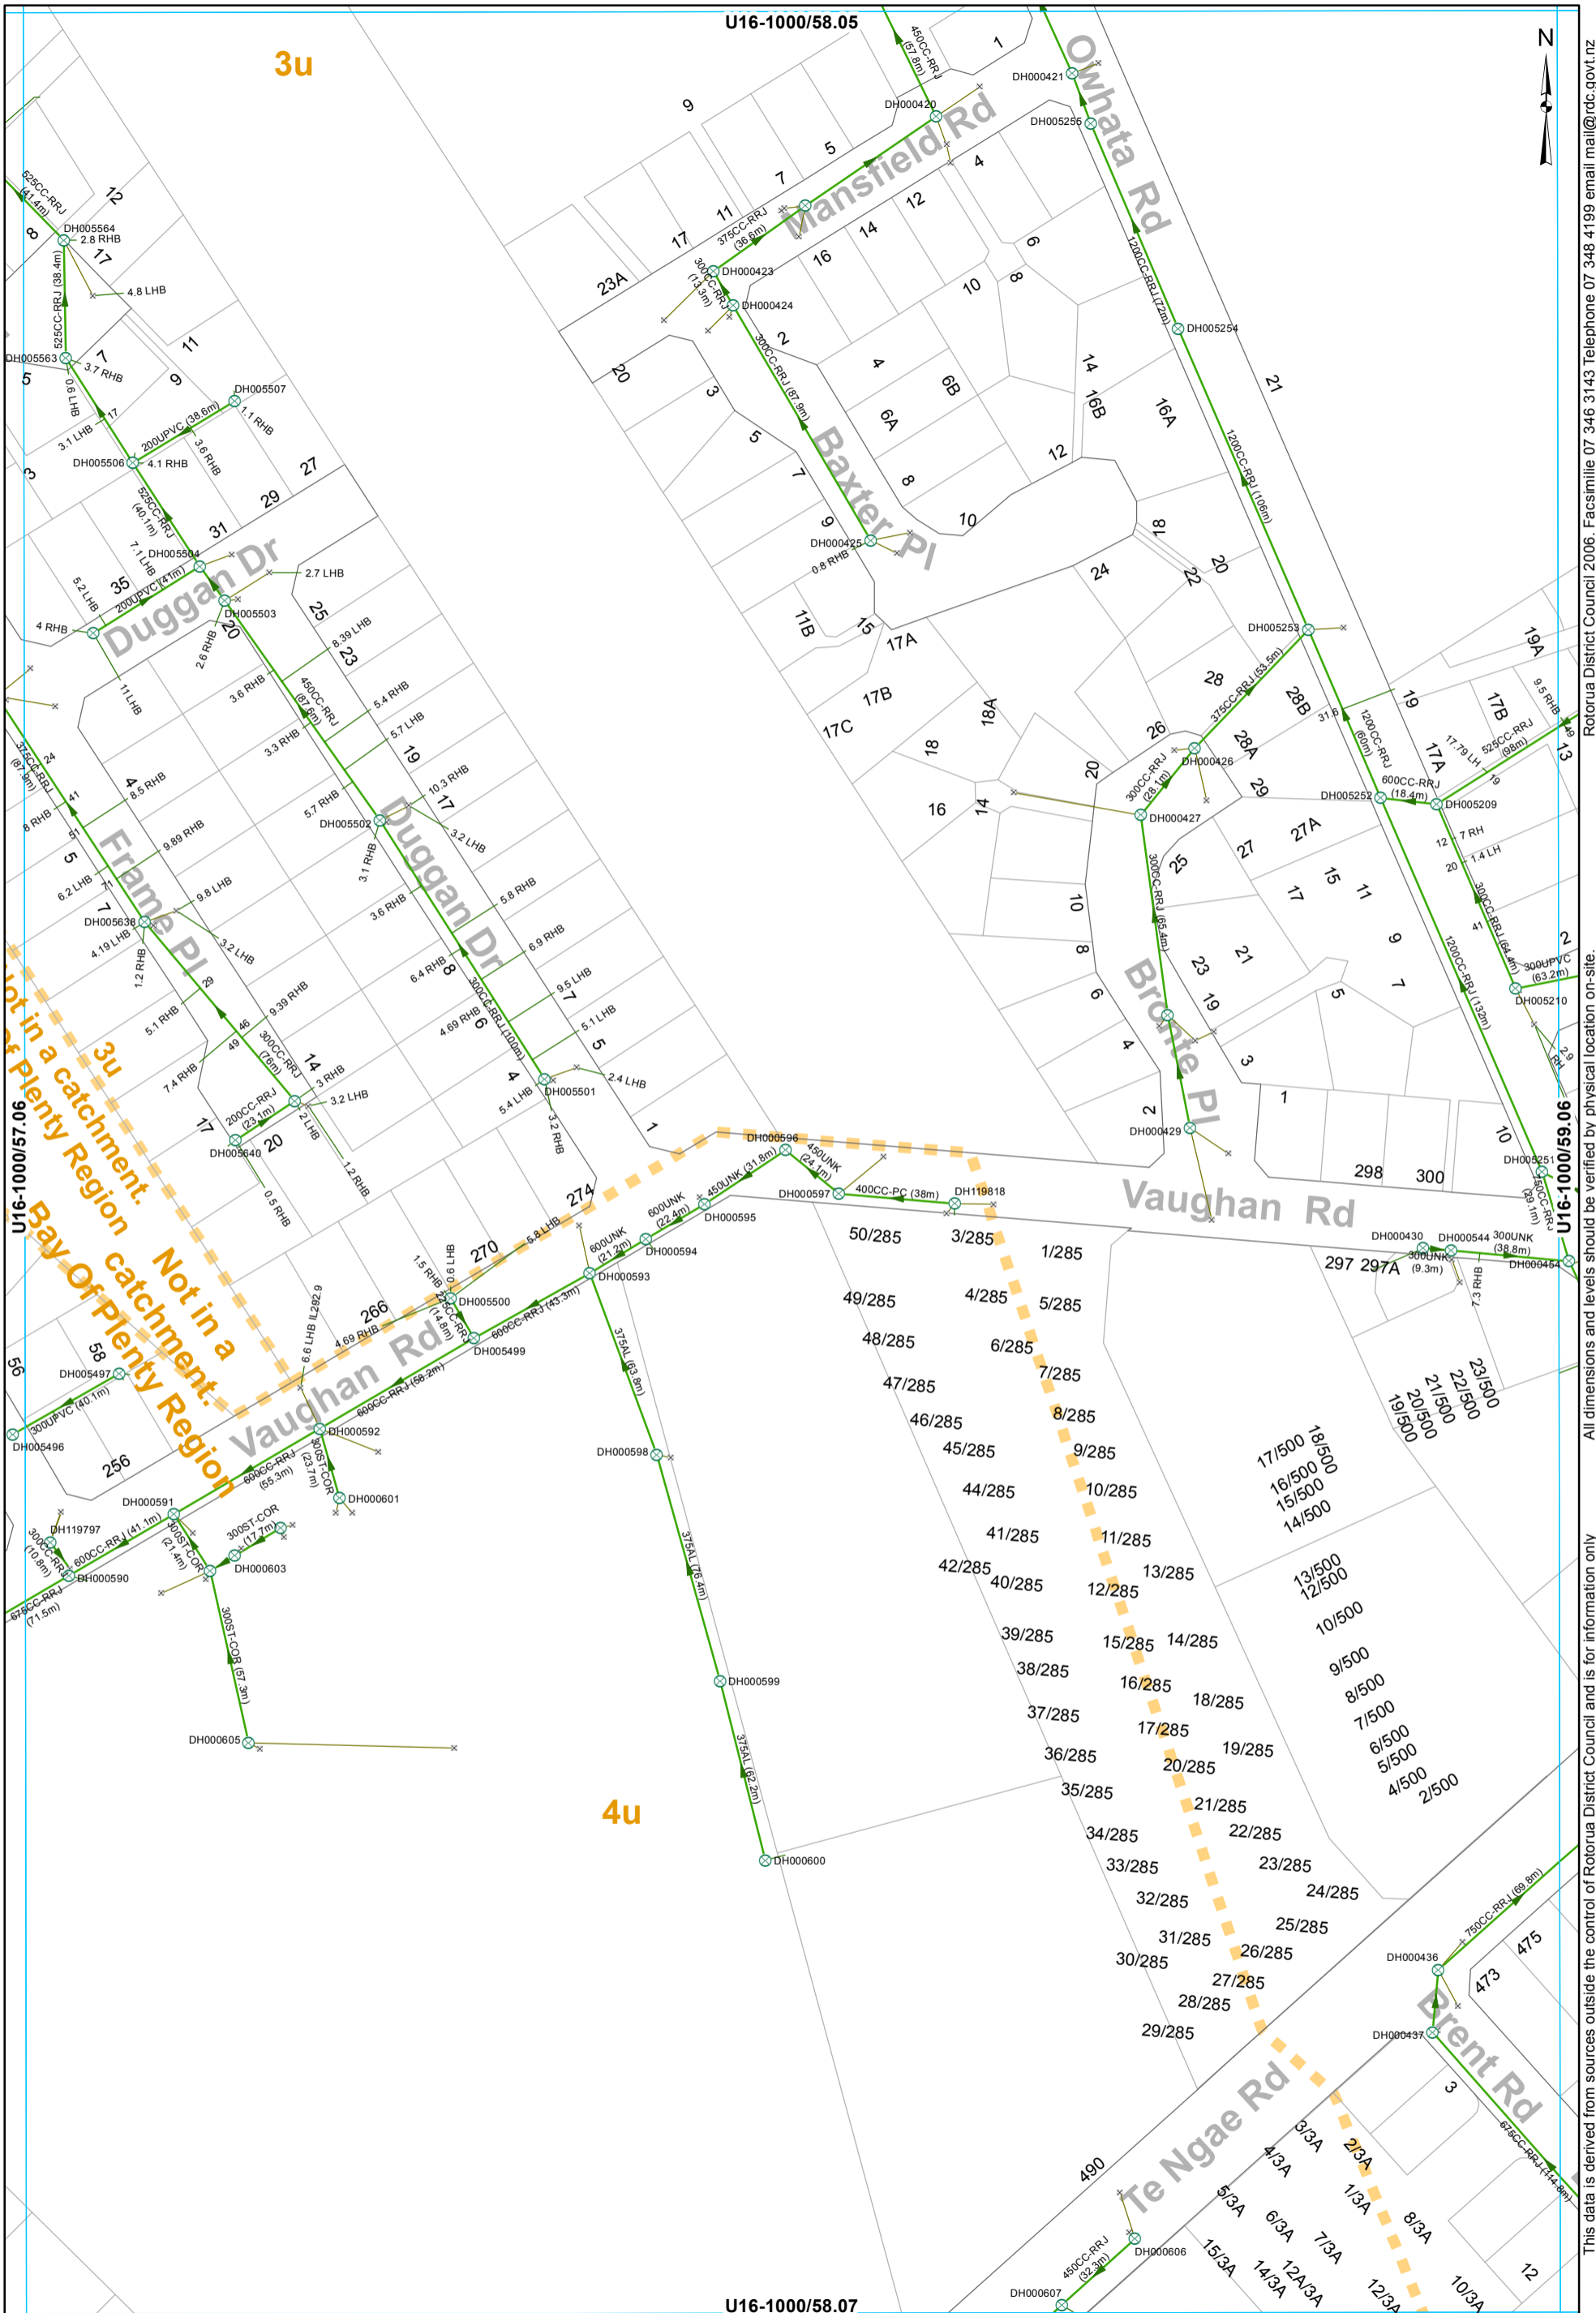


- ⊗ SWManhole
- × SWInlet
- Gravity Main
- SWServiceline
- SWLead
- Catchment Boundary

**STORMWATER SERVICES**  
 1:2000 @ A3 - (U16-1000/58.06)

All dimensions and levels outside the control of Rotorua District Council and is for information only. Rotorua District Council 2006. Facsimile 07 346 3143 Telephone 07 348 4199 email mail@rdc.govt.nz



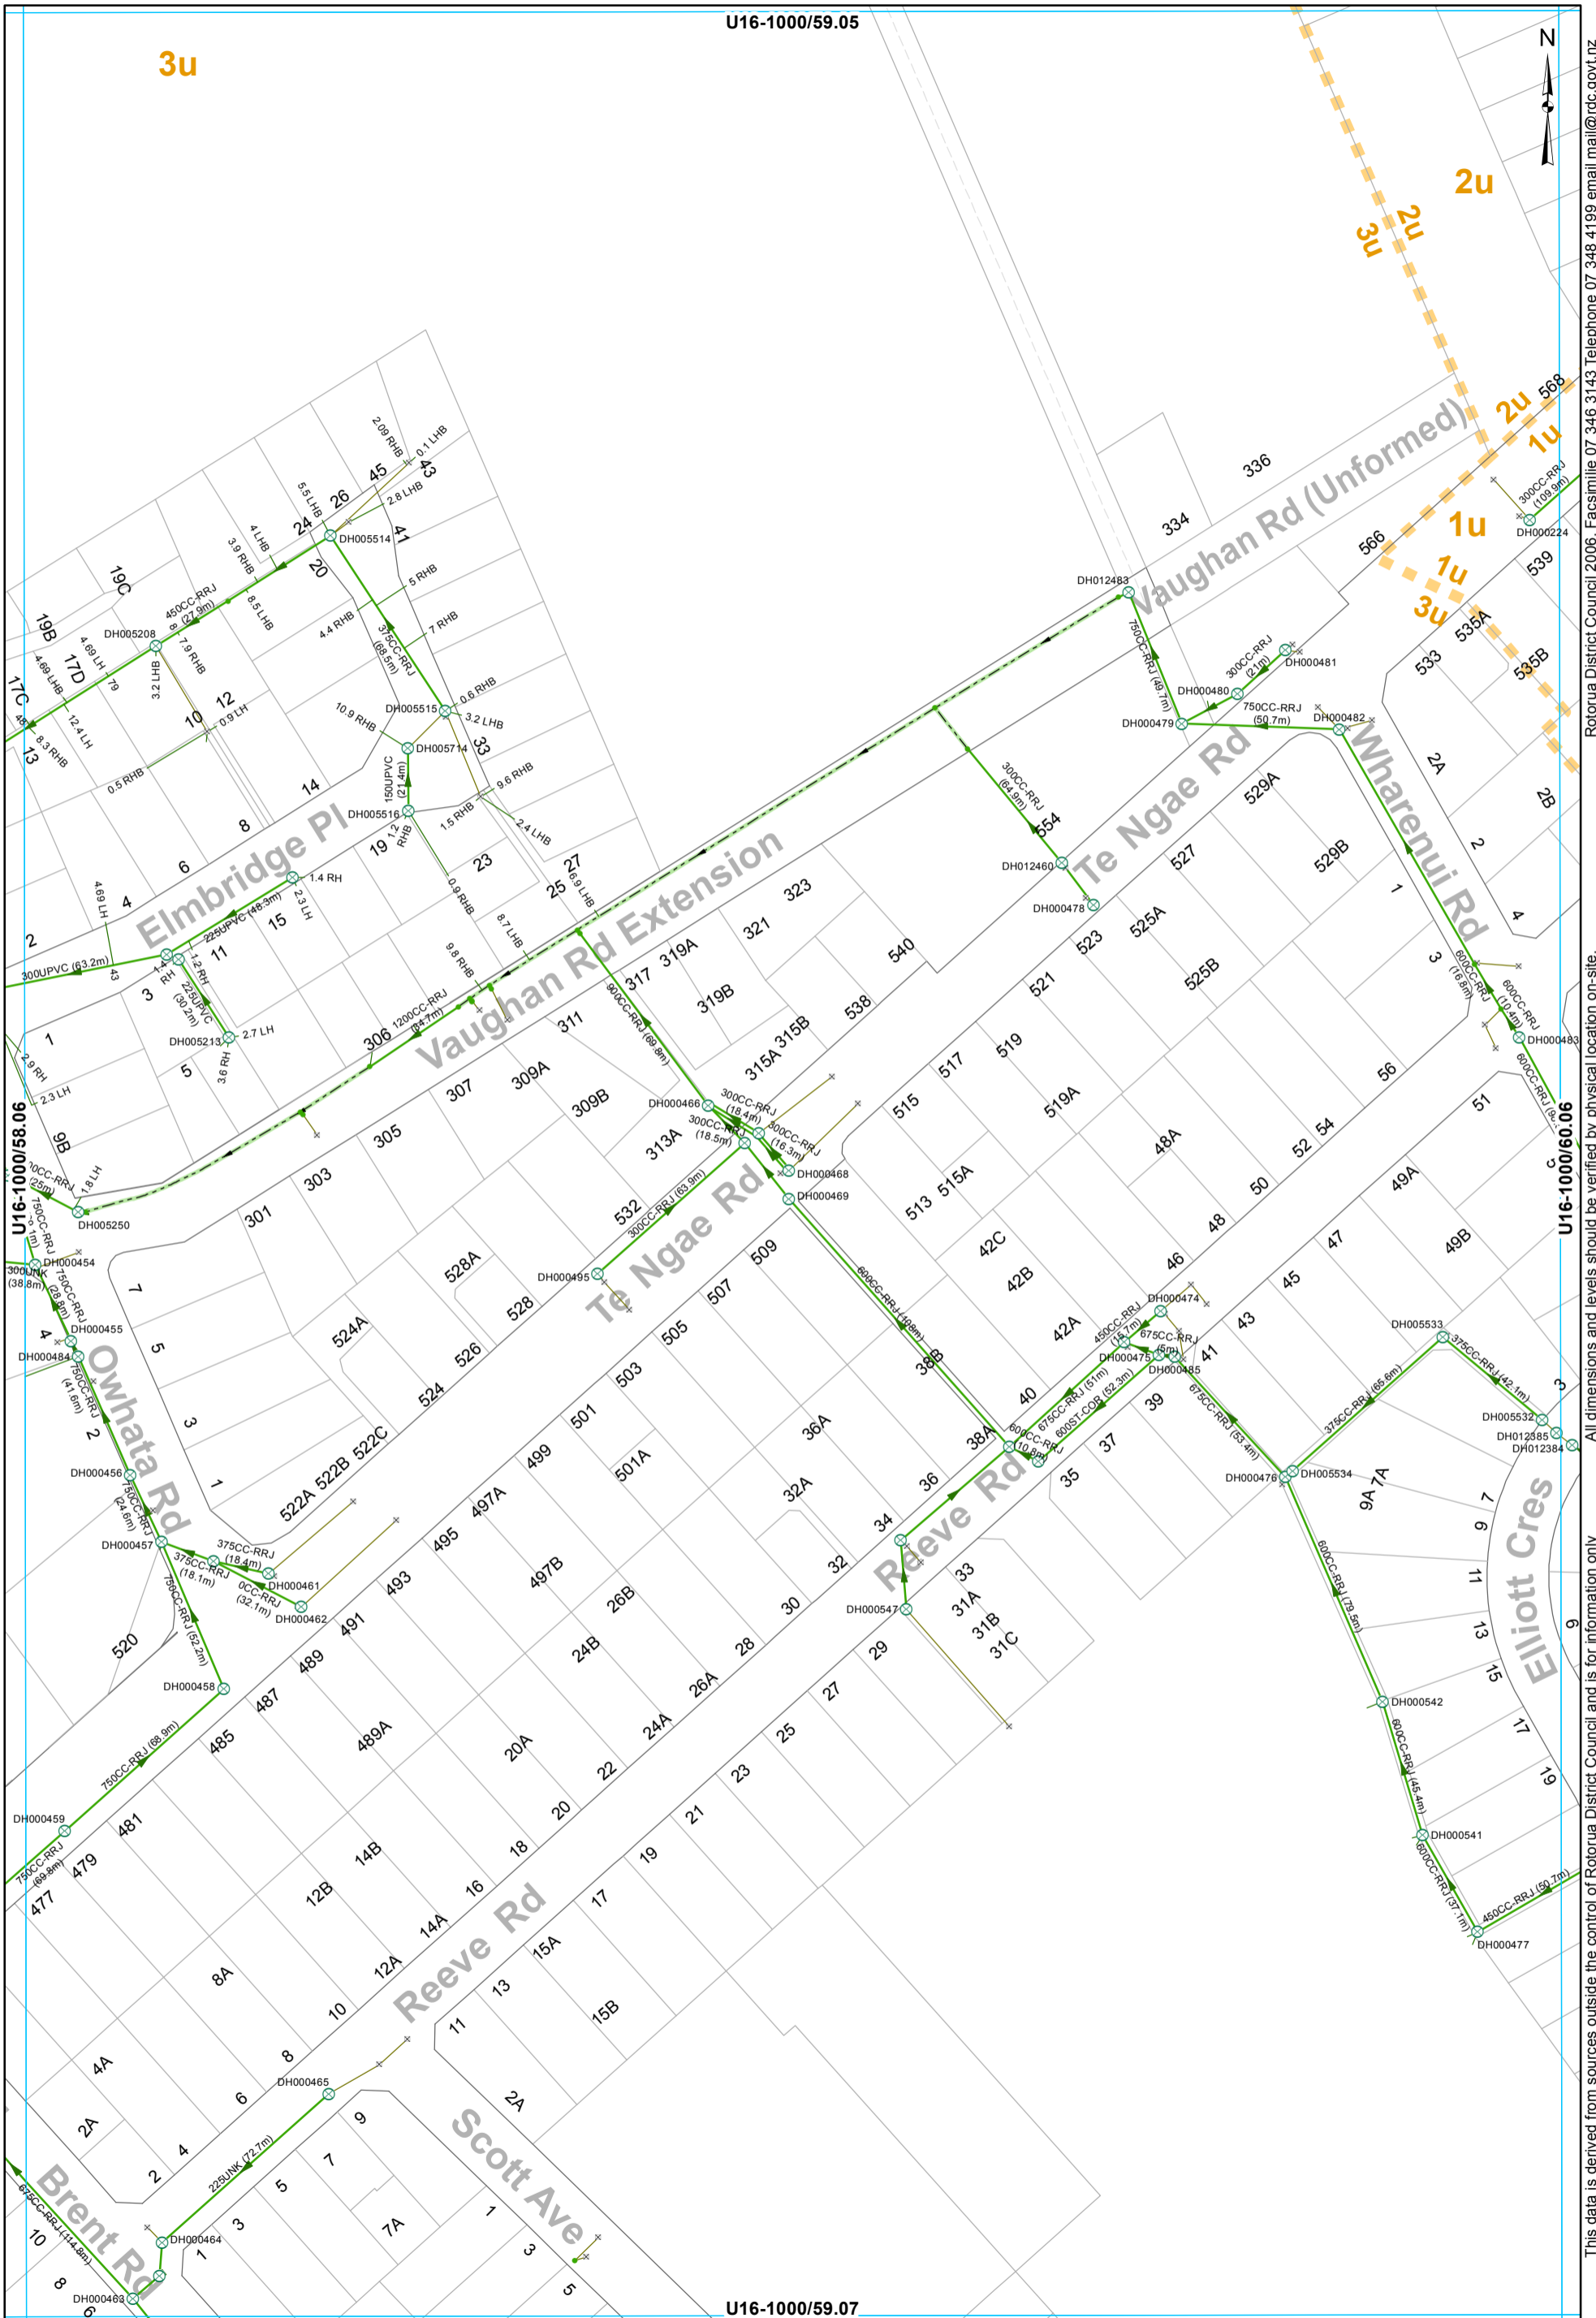


- ⊗ SWManhole
- ⊗ SWInlet
- Node
- Open Drain
- Gravity Main
- SWServiceline
- SWServiceline
- SWLead
- Catchment Boundary

**STORMWATER SERVICES**  
**1:2000 @ A3 - (U16-1000/59.06)**

All dimensions and levels should be verified by physical location on-site.

Rotorua District Council 2006. Facsimile 07 346 3143 Telephone 07 348 4199 email mail@rdc.govt.nz

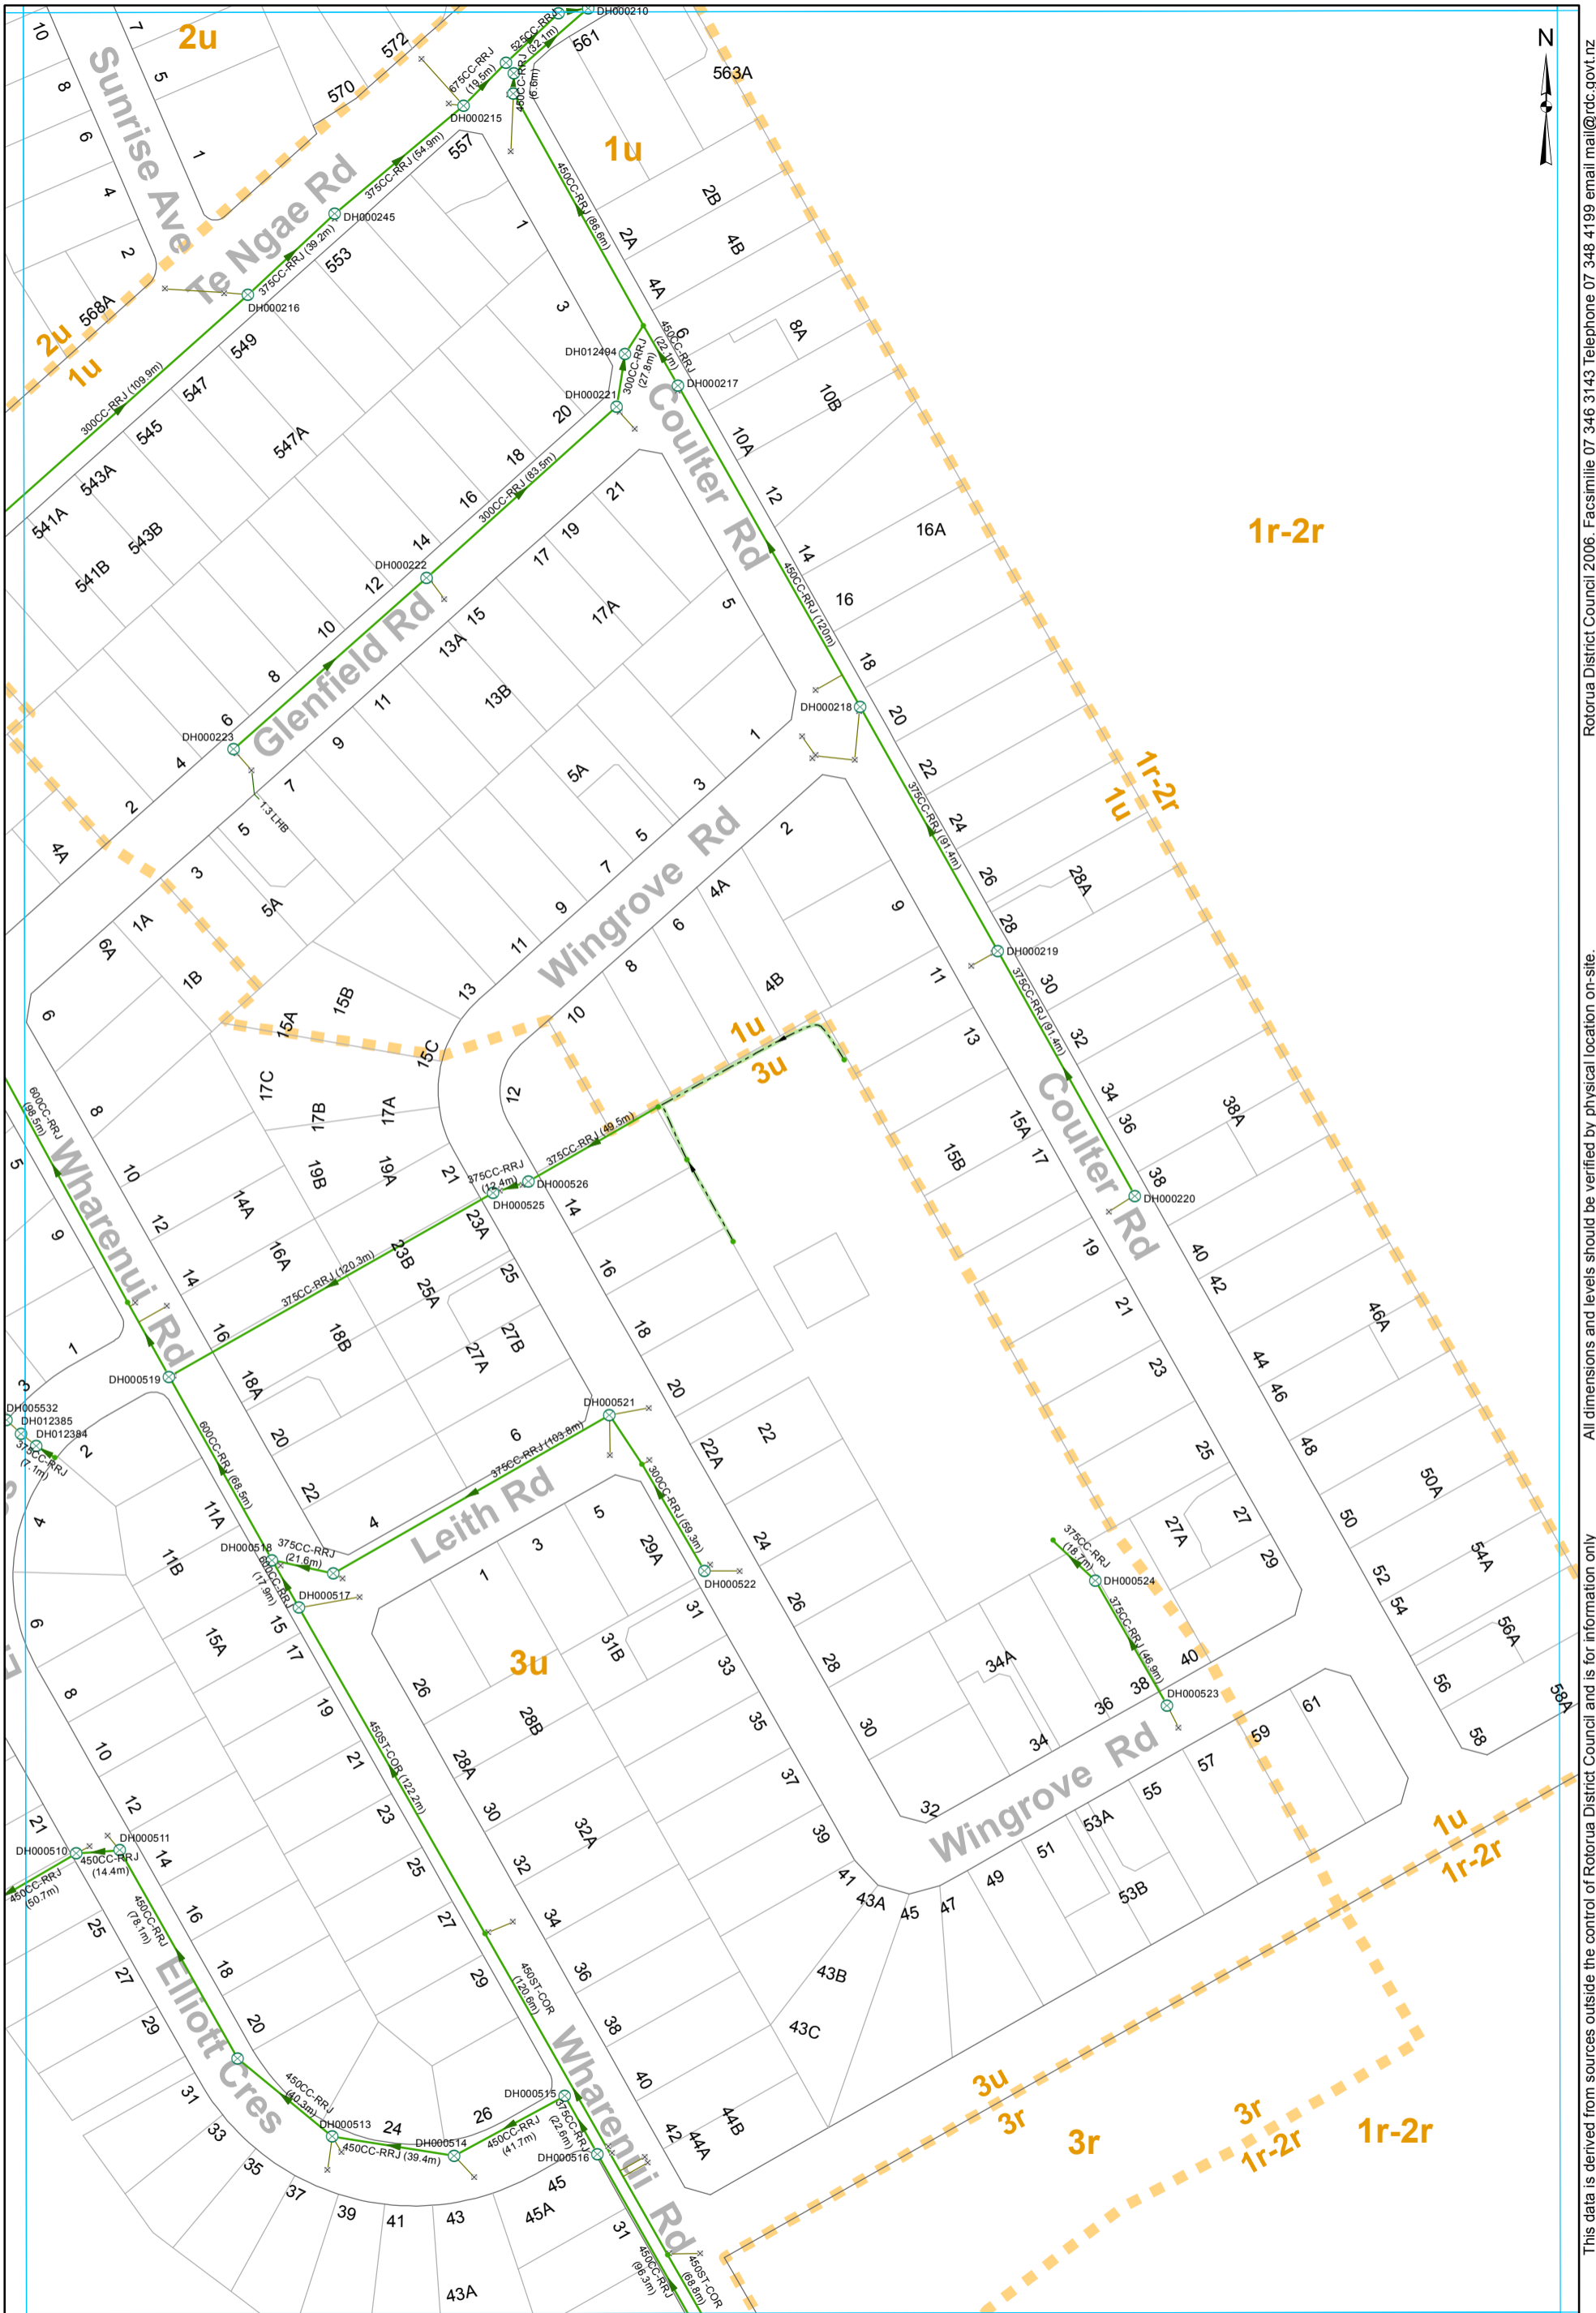


- ⊗ SWManhole
- ⊗ SWInlet
- Node
- Open Drain
- Gravity Main
- SWServiceline
- SWServiceline
- SWLead
- - - Catchment Boundary

**STORMWATER SERVICES**  
**1:2000 @ A3 - (U16-1000/60.06)**

This data is derived from sources outside the control of Rotorua District Council and is for information only

All dimensions and levels should be verified by physical location on-site.


Rotorua District Council 2006. Facsimile 07 346 3143 Telephone 07 348 4199 email mail@rdc.govt.nz

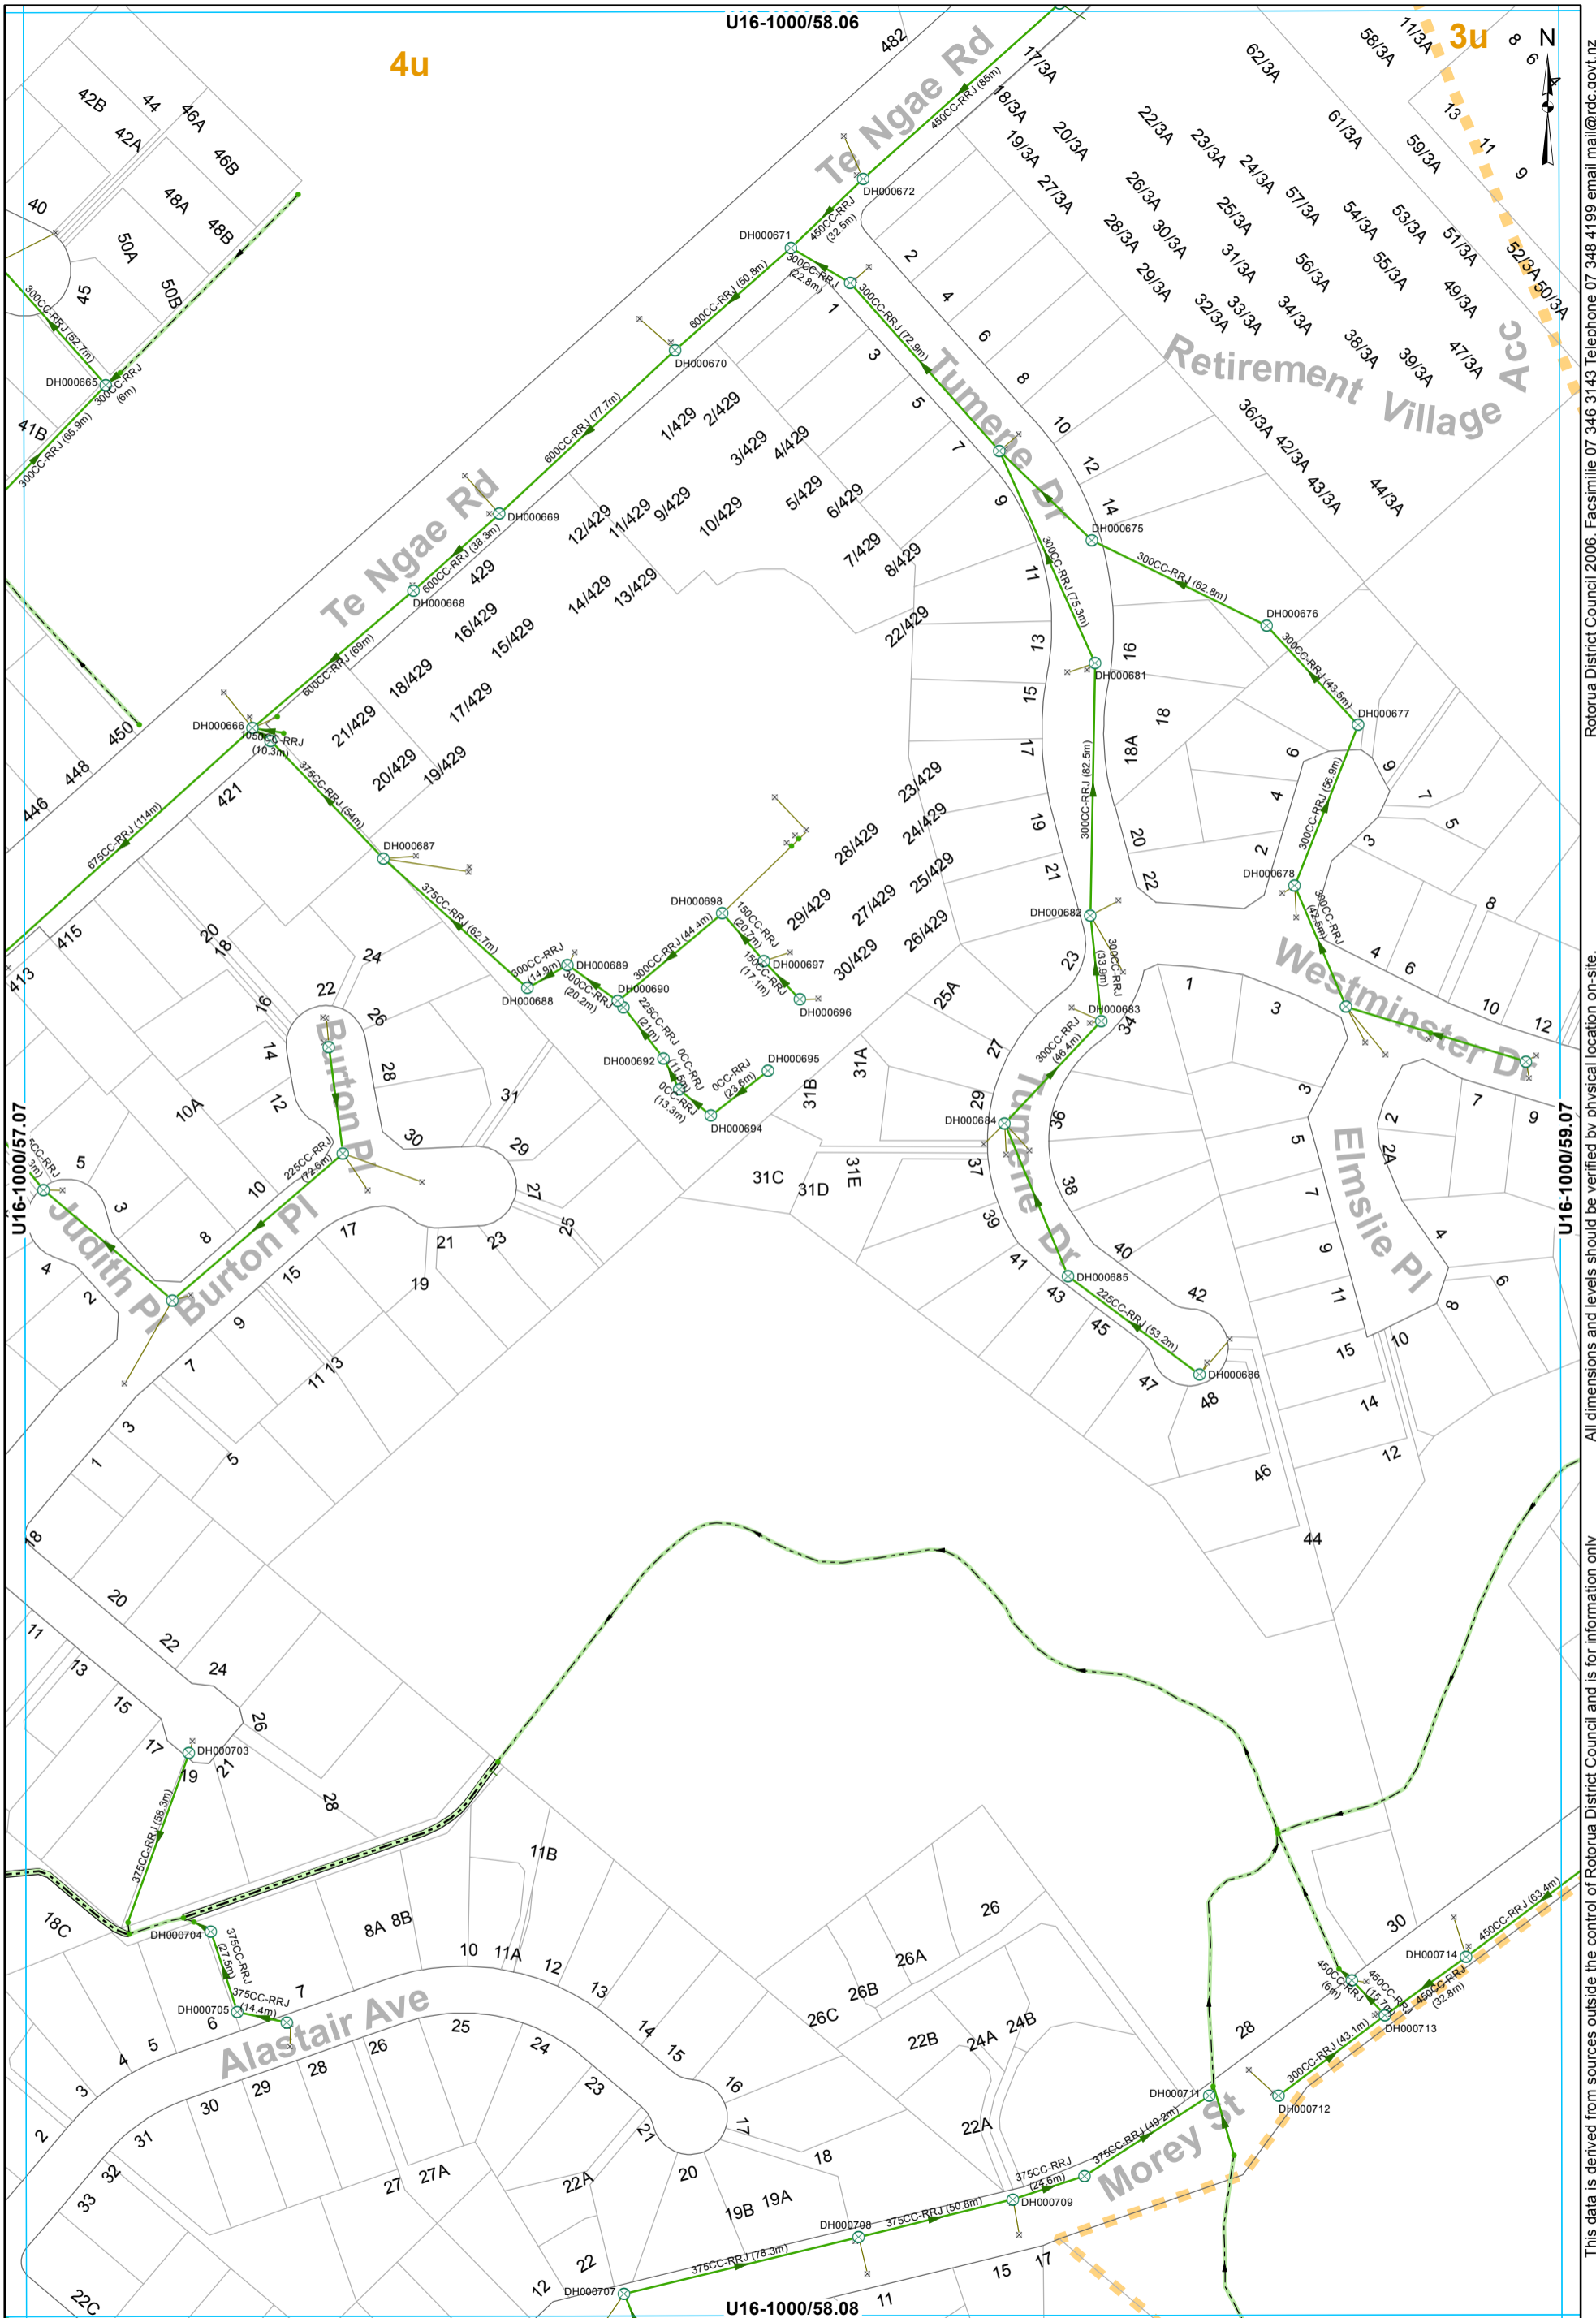

- ⊗ SWManhole
- × SWInlet
- Node
- ▬ Lined Channel
- ▬ Open Drain
- ▬ Gravity Main
- ▬ SWServiceline
- ▬ SWLead
- ▬ Catchment Boundary

**STORMWATER SERVICES**  
**1:2000 @ A3 - (U16-1000/58.07)**

This data is derived from sources outside the control of Rotorua District Council and is for information only. All dimensions and levels should be verified by physical location on-site. Rotorua District Council 2006. Facsimile 07 346 3143 Telephone 07 348 4199 email mail@rdc.govt.nz

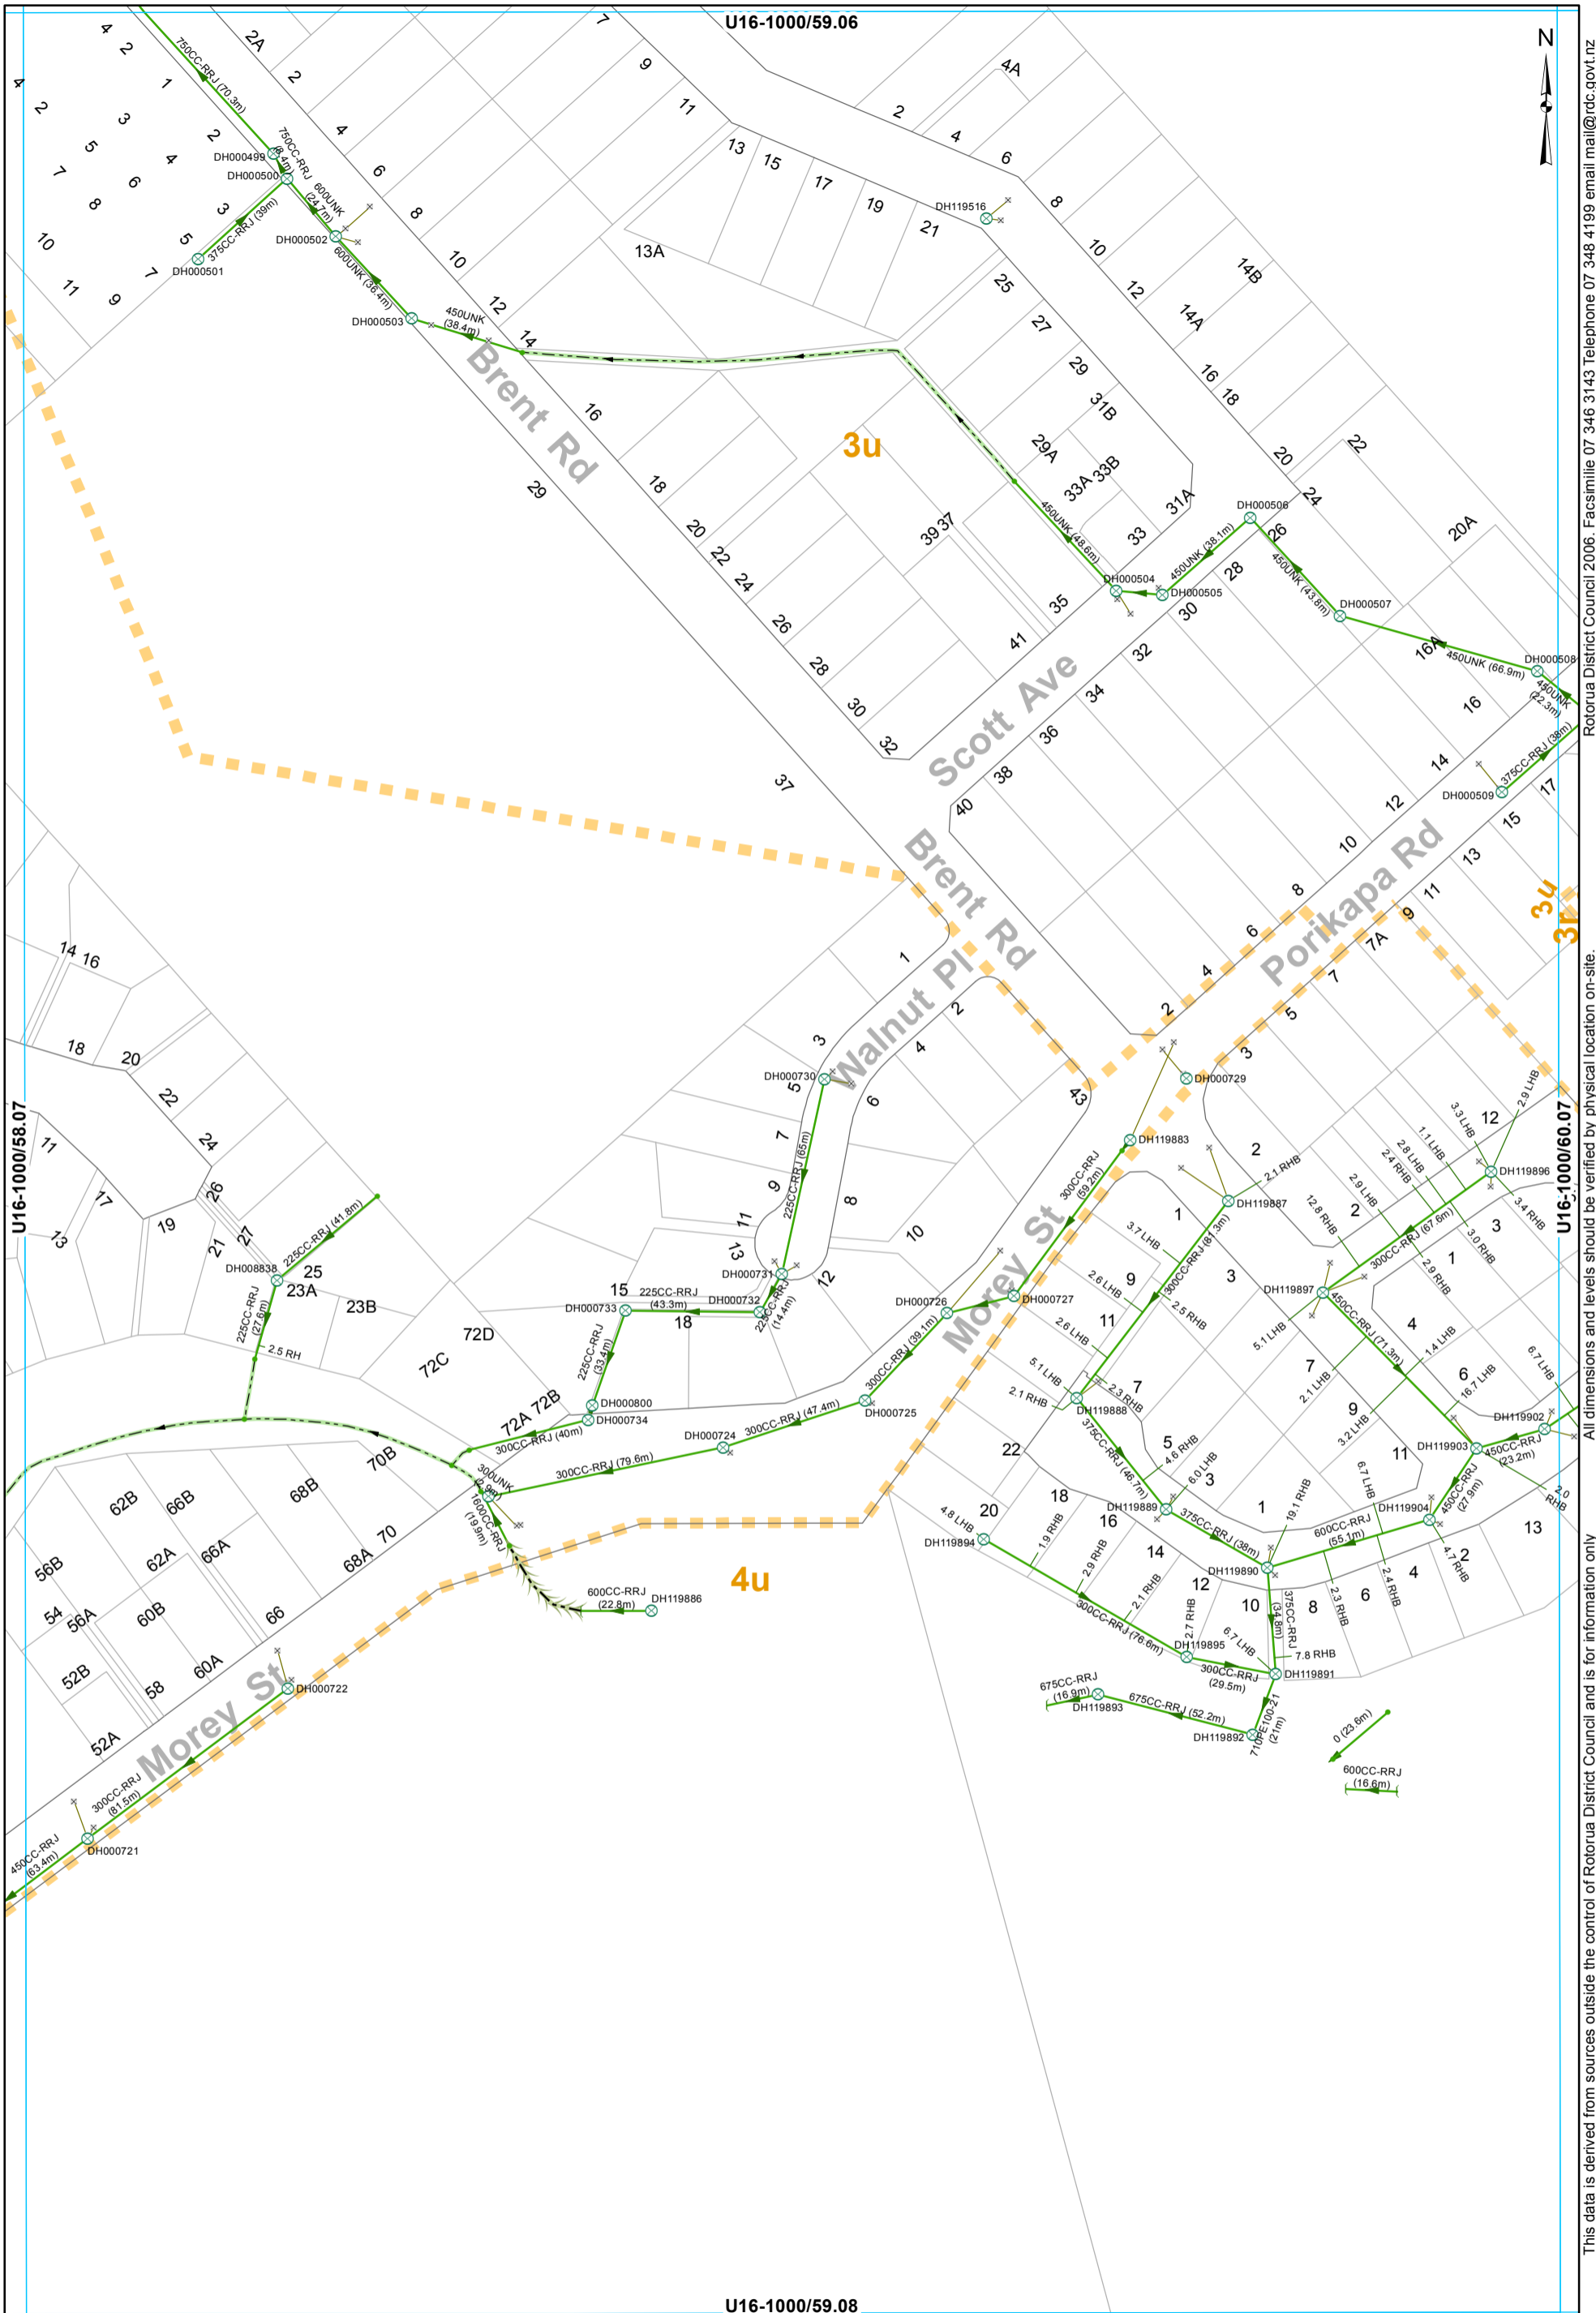

All dimensions and levels should be verified by physical location on-site. This data is derived from sources outside the control of Rotorua District Council and is for information only.

Rotorua District Council 2006. Facsimile 07 346 3143 Telephone 07 348 4199 email mail@rdc.govt.nz

- ⊗ SWManhole
- × SWInlet
- Node
- Headwall Structure
- Open Drain
- Overland Flow
- Culvert
- Gravity Main
- SWServiceline
- SWLead
- - - Catchment Boundary


**STORMWATER SERVICES**  
1:2000 @ A3 - (U16-1000/59.07)

U16-1000/59.08

U16-1000/59.06

U16-1000/58.07

U16-1000/60.07

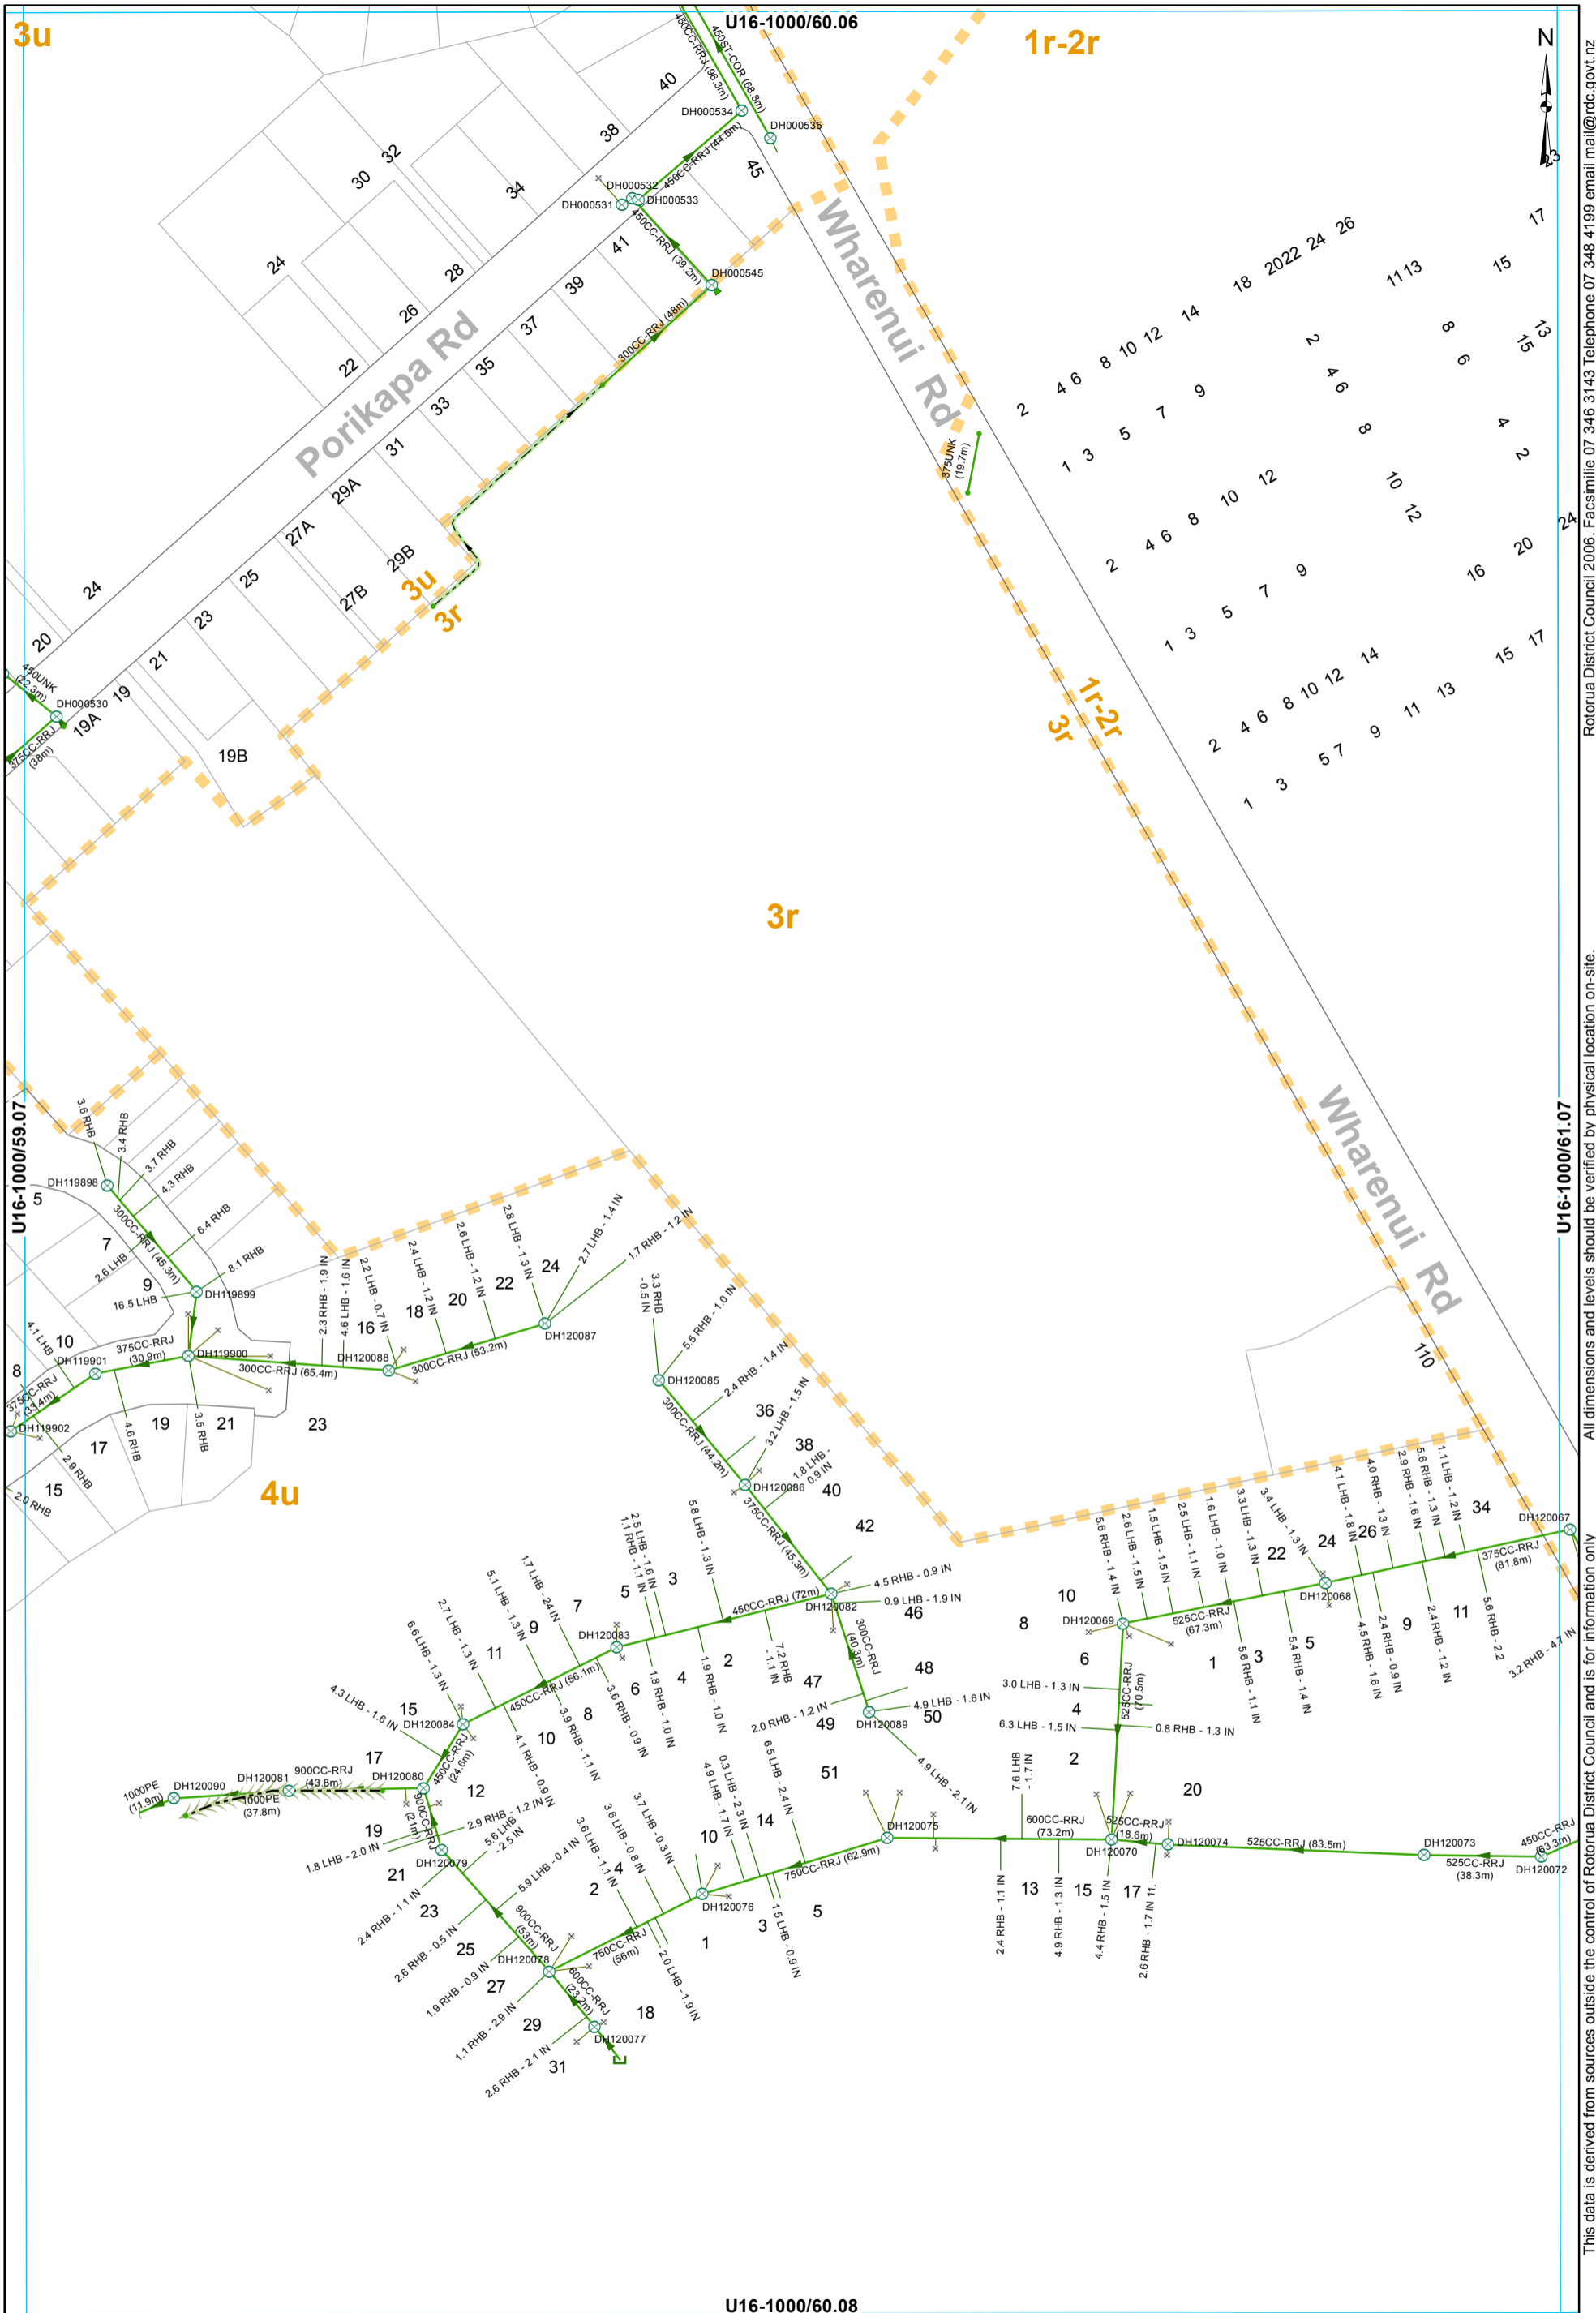


- ⊗ SWManhole
- ⊗ SWInlet
- Node
- ┌ Capped End
- └ Headwall Structure
- Open Drain
- Overland Flow
- Culvert
- Gravity Main
- SWServiceline
- SWServiceline
- SWLead
- ▭ Catchment Boundary

**STORMWATER SERVICES**  
**1:2000 @ A3 - (U16-1000/60.07)**

All dimensions and levels outside the control of Rotorua District Council and is for information only.


Rotorua District Council 2006. Facsimile 07 346 3143 Telephone 07 348 4199 email mail@rdc.govt.nz

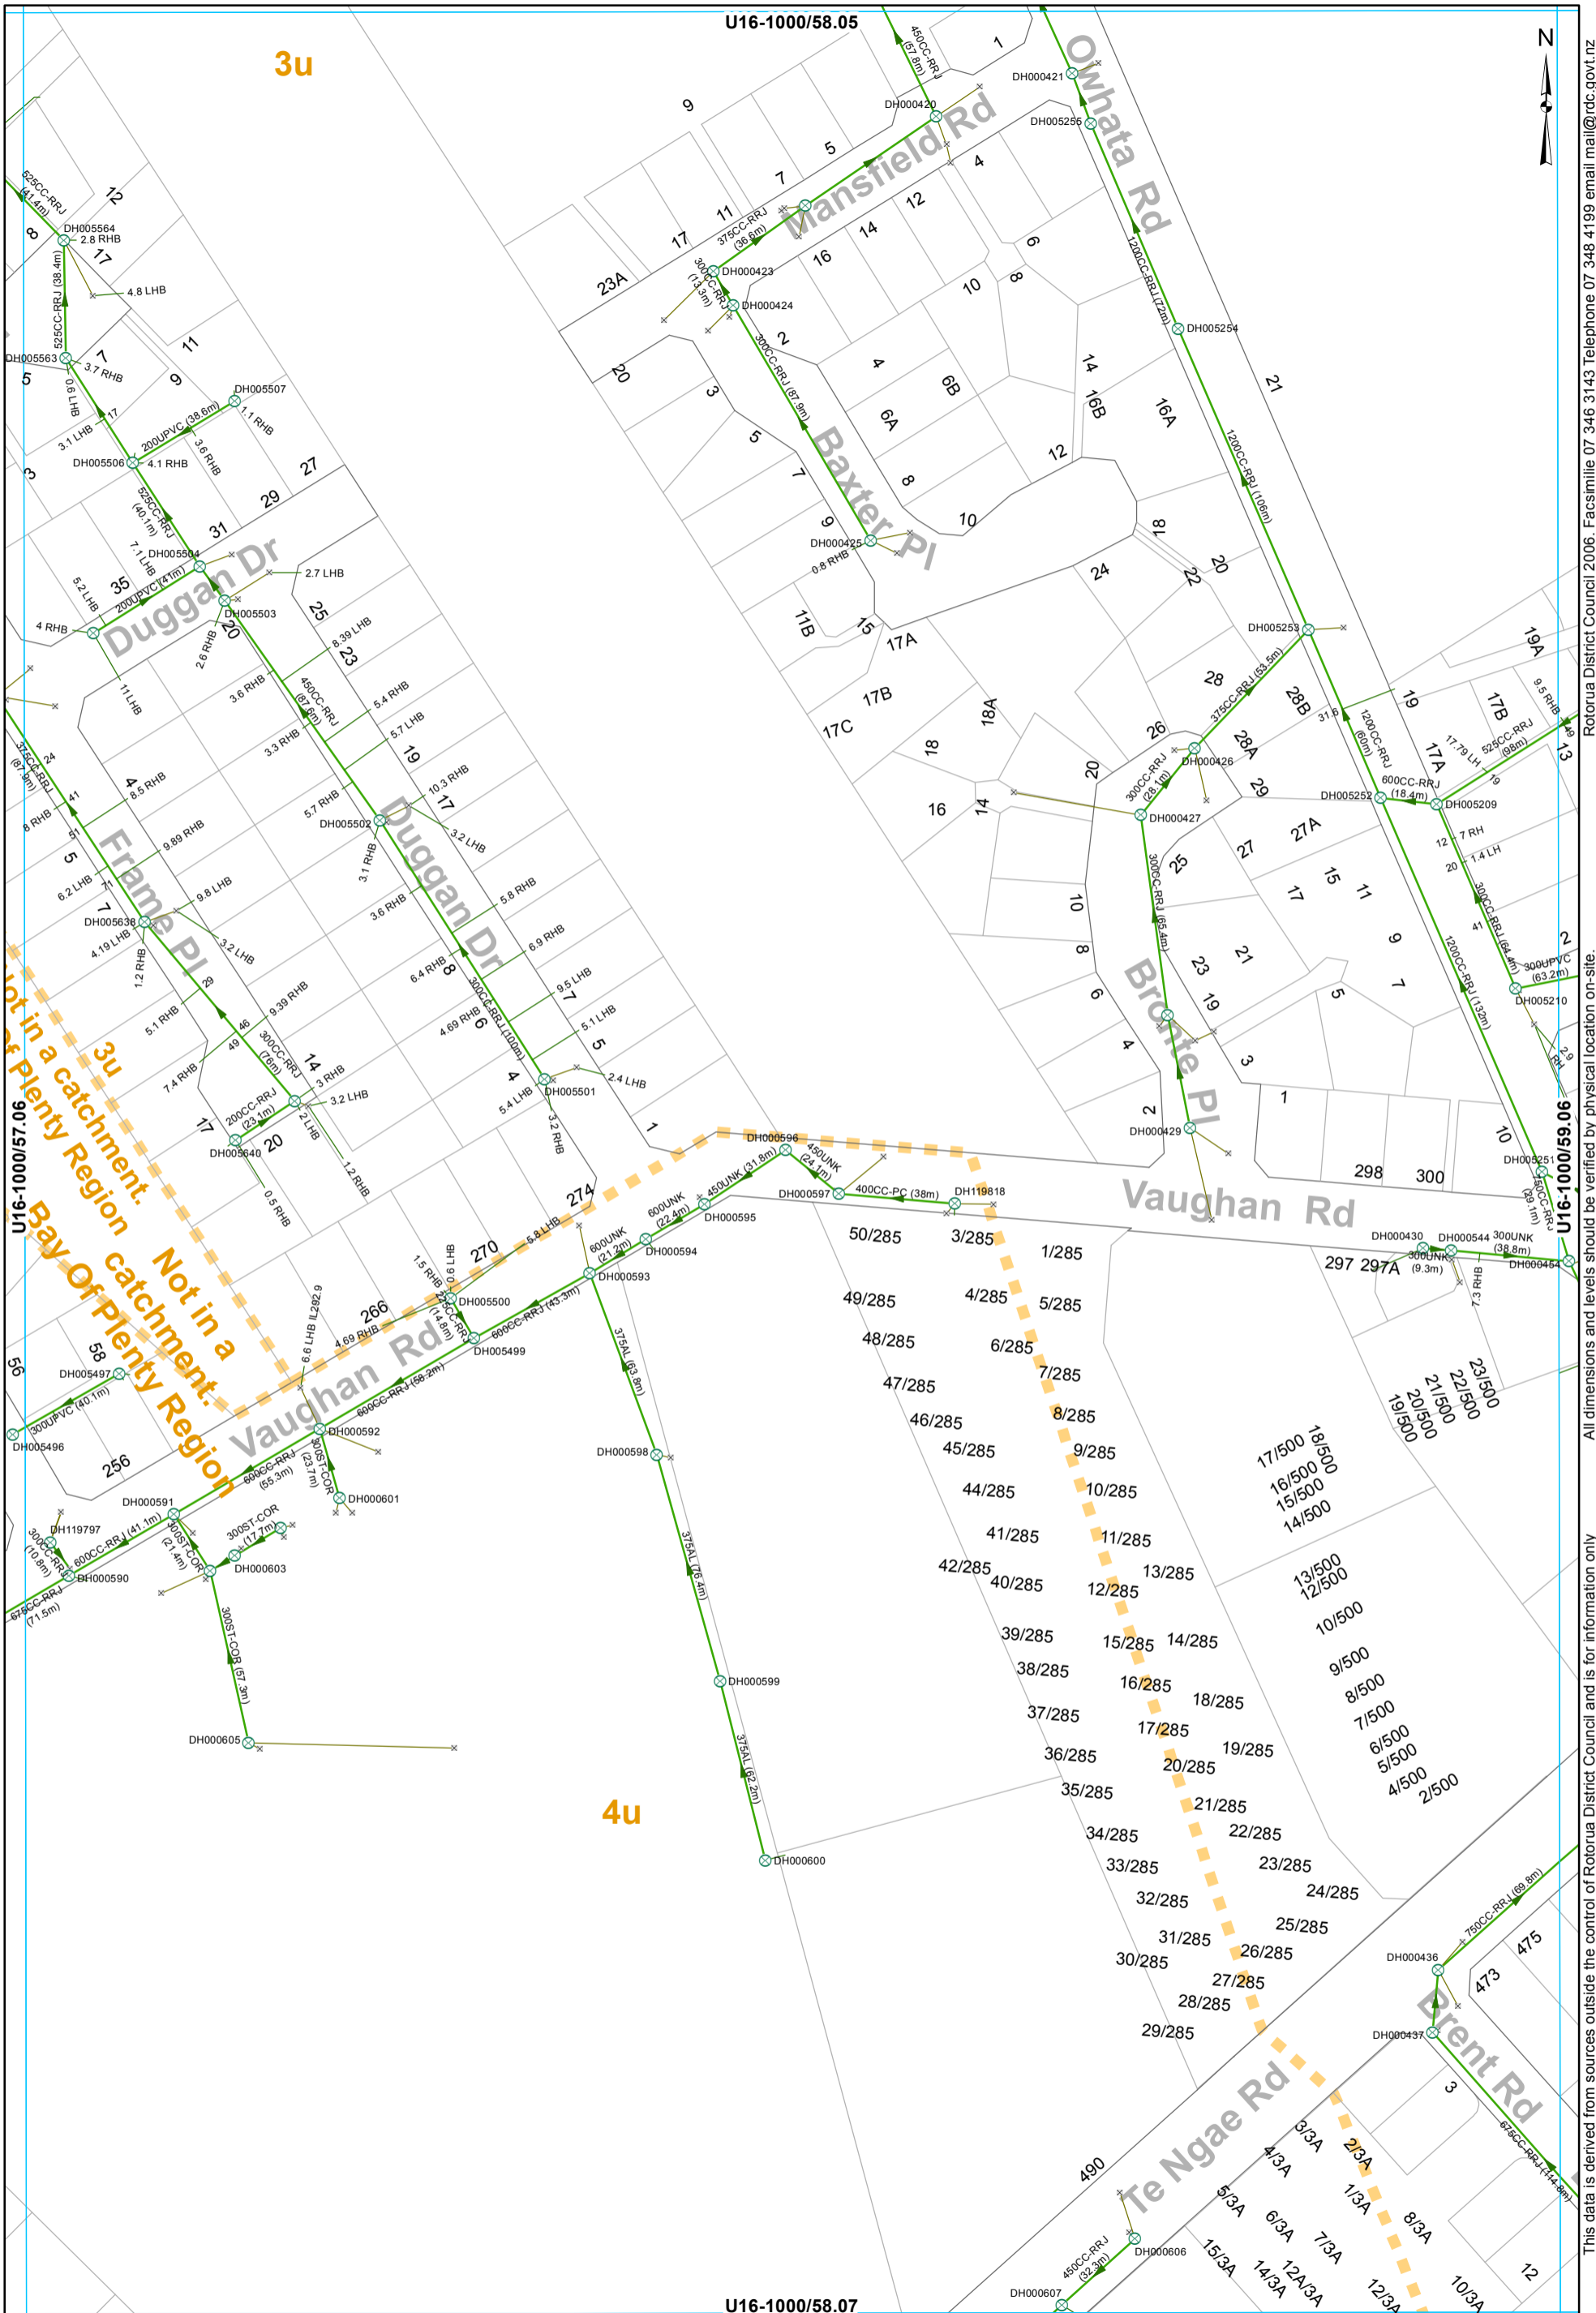

All dimensions and levels outside the control of Rotorua District Council and is for information only. This data is derived from sources outside the control of Rotorua District Council and is for information only. Rotorua District Council 2006. Facsimile 07 346 3143 Telephone 07 348 4199 email mail@rdc.govt.nz

- ⊗ SWManhole
- × SWInlet
- Gravity Main
- SWServiceline
- SWLead
- Catchment Boundary


**STORMWATER SERVICES**  
1:2000 @ A3 - (U16-1000/58.06)

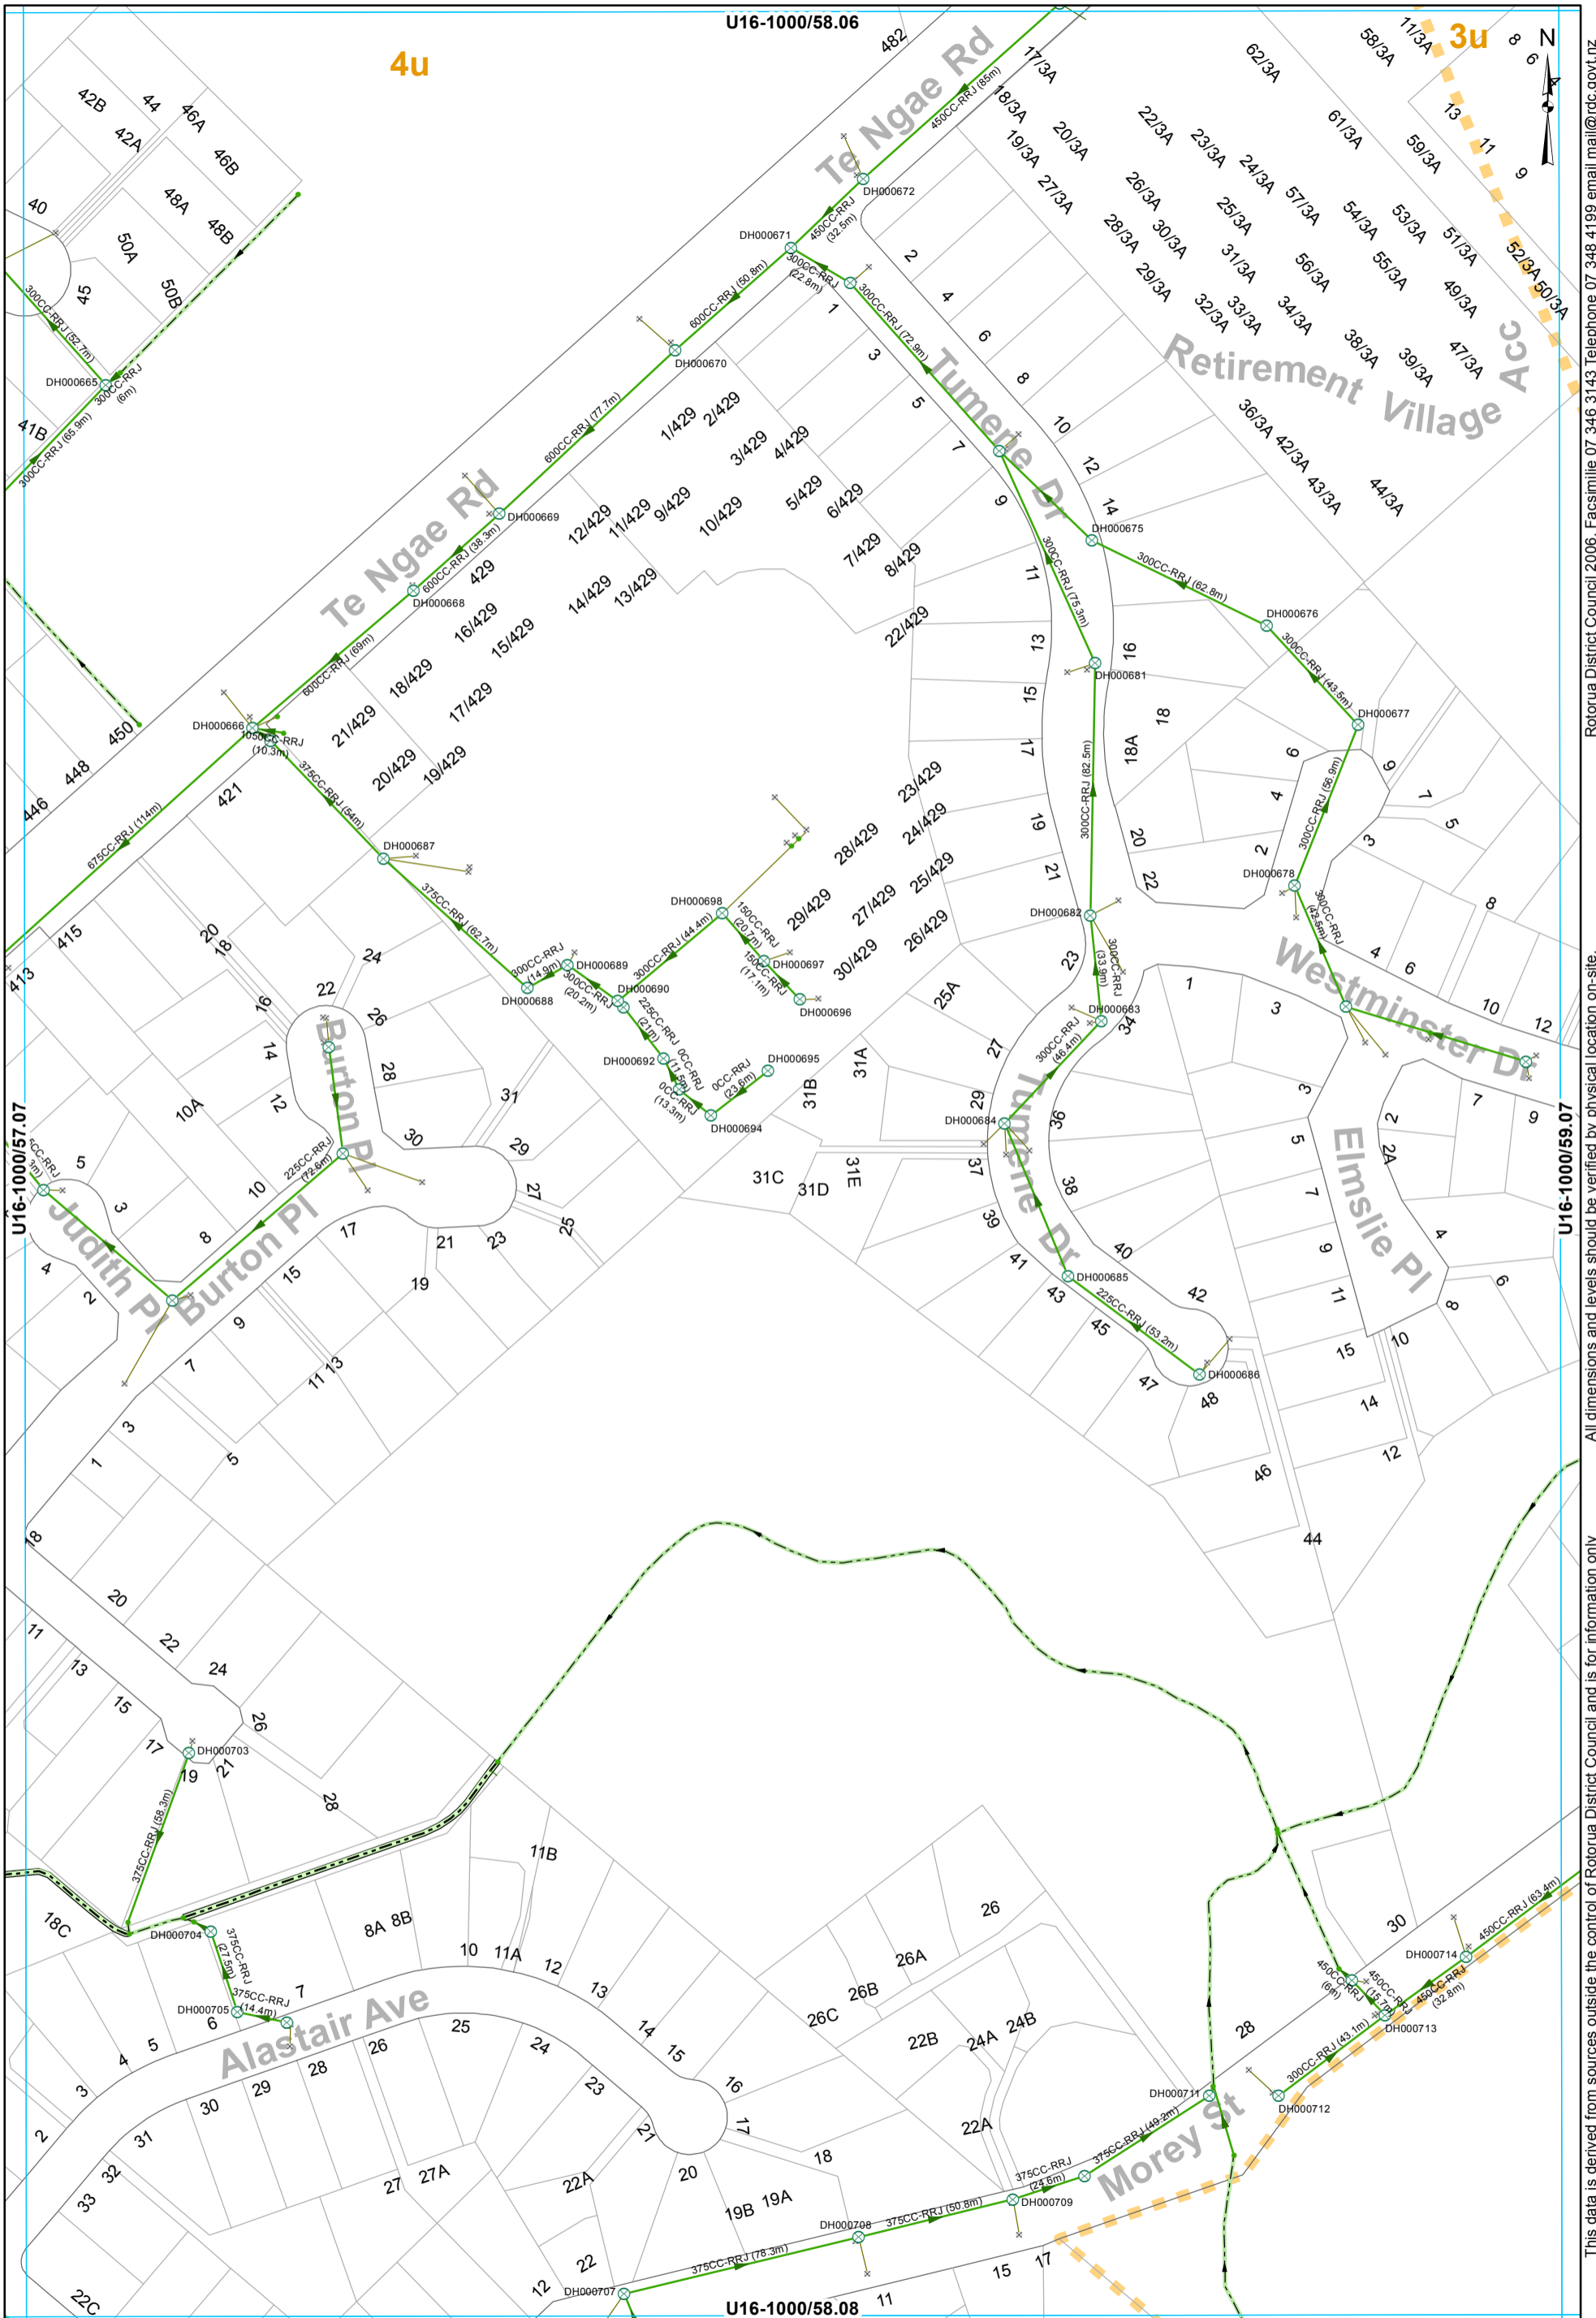

- ⊗ SWManhole
- × SWInlet
- Node
- Lined Channel
- Open Drain
- Gravity Main
- SWServiceline
- SWLead
- Catchment Boundary

**STORMWATER SERVICES**  
**1:2000 @ A3 - (U16-1000/58.07)**

This data is derived from sources outside the control of Rotorua District Council and is for information only. All dimensions and levels should be verified by physical location on-site. Rotorua District Council 2006. Facsimile 07 346 3143 Telephone 07 348 4199 email mail@rdc.govt.nz

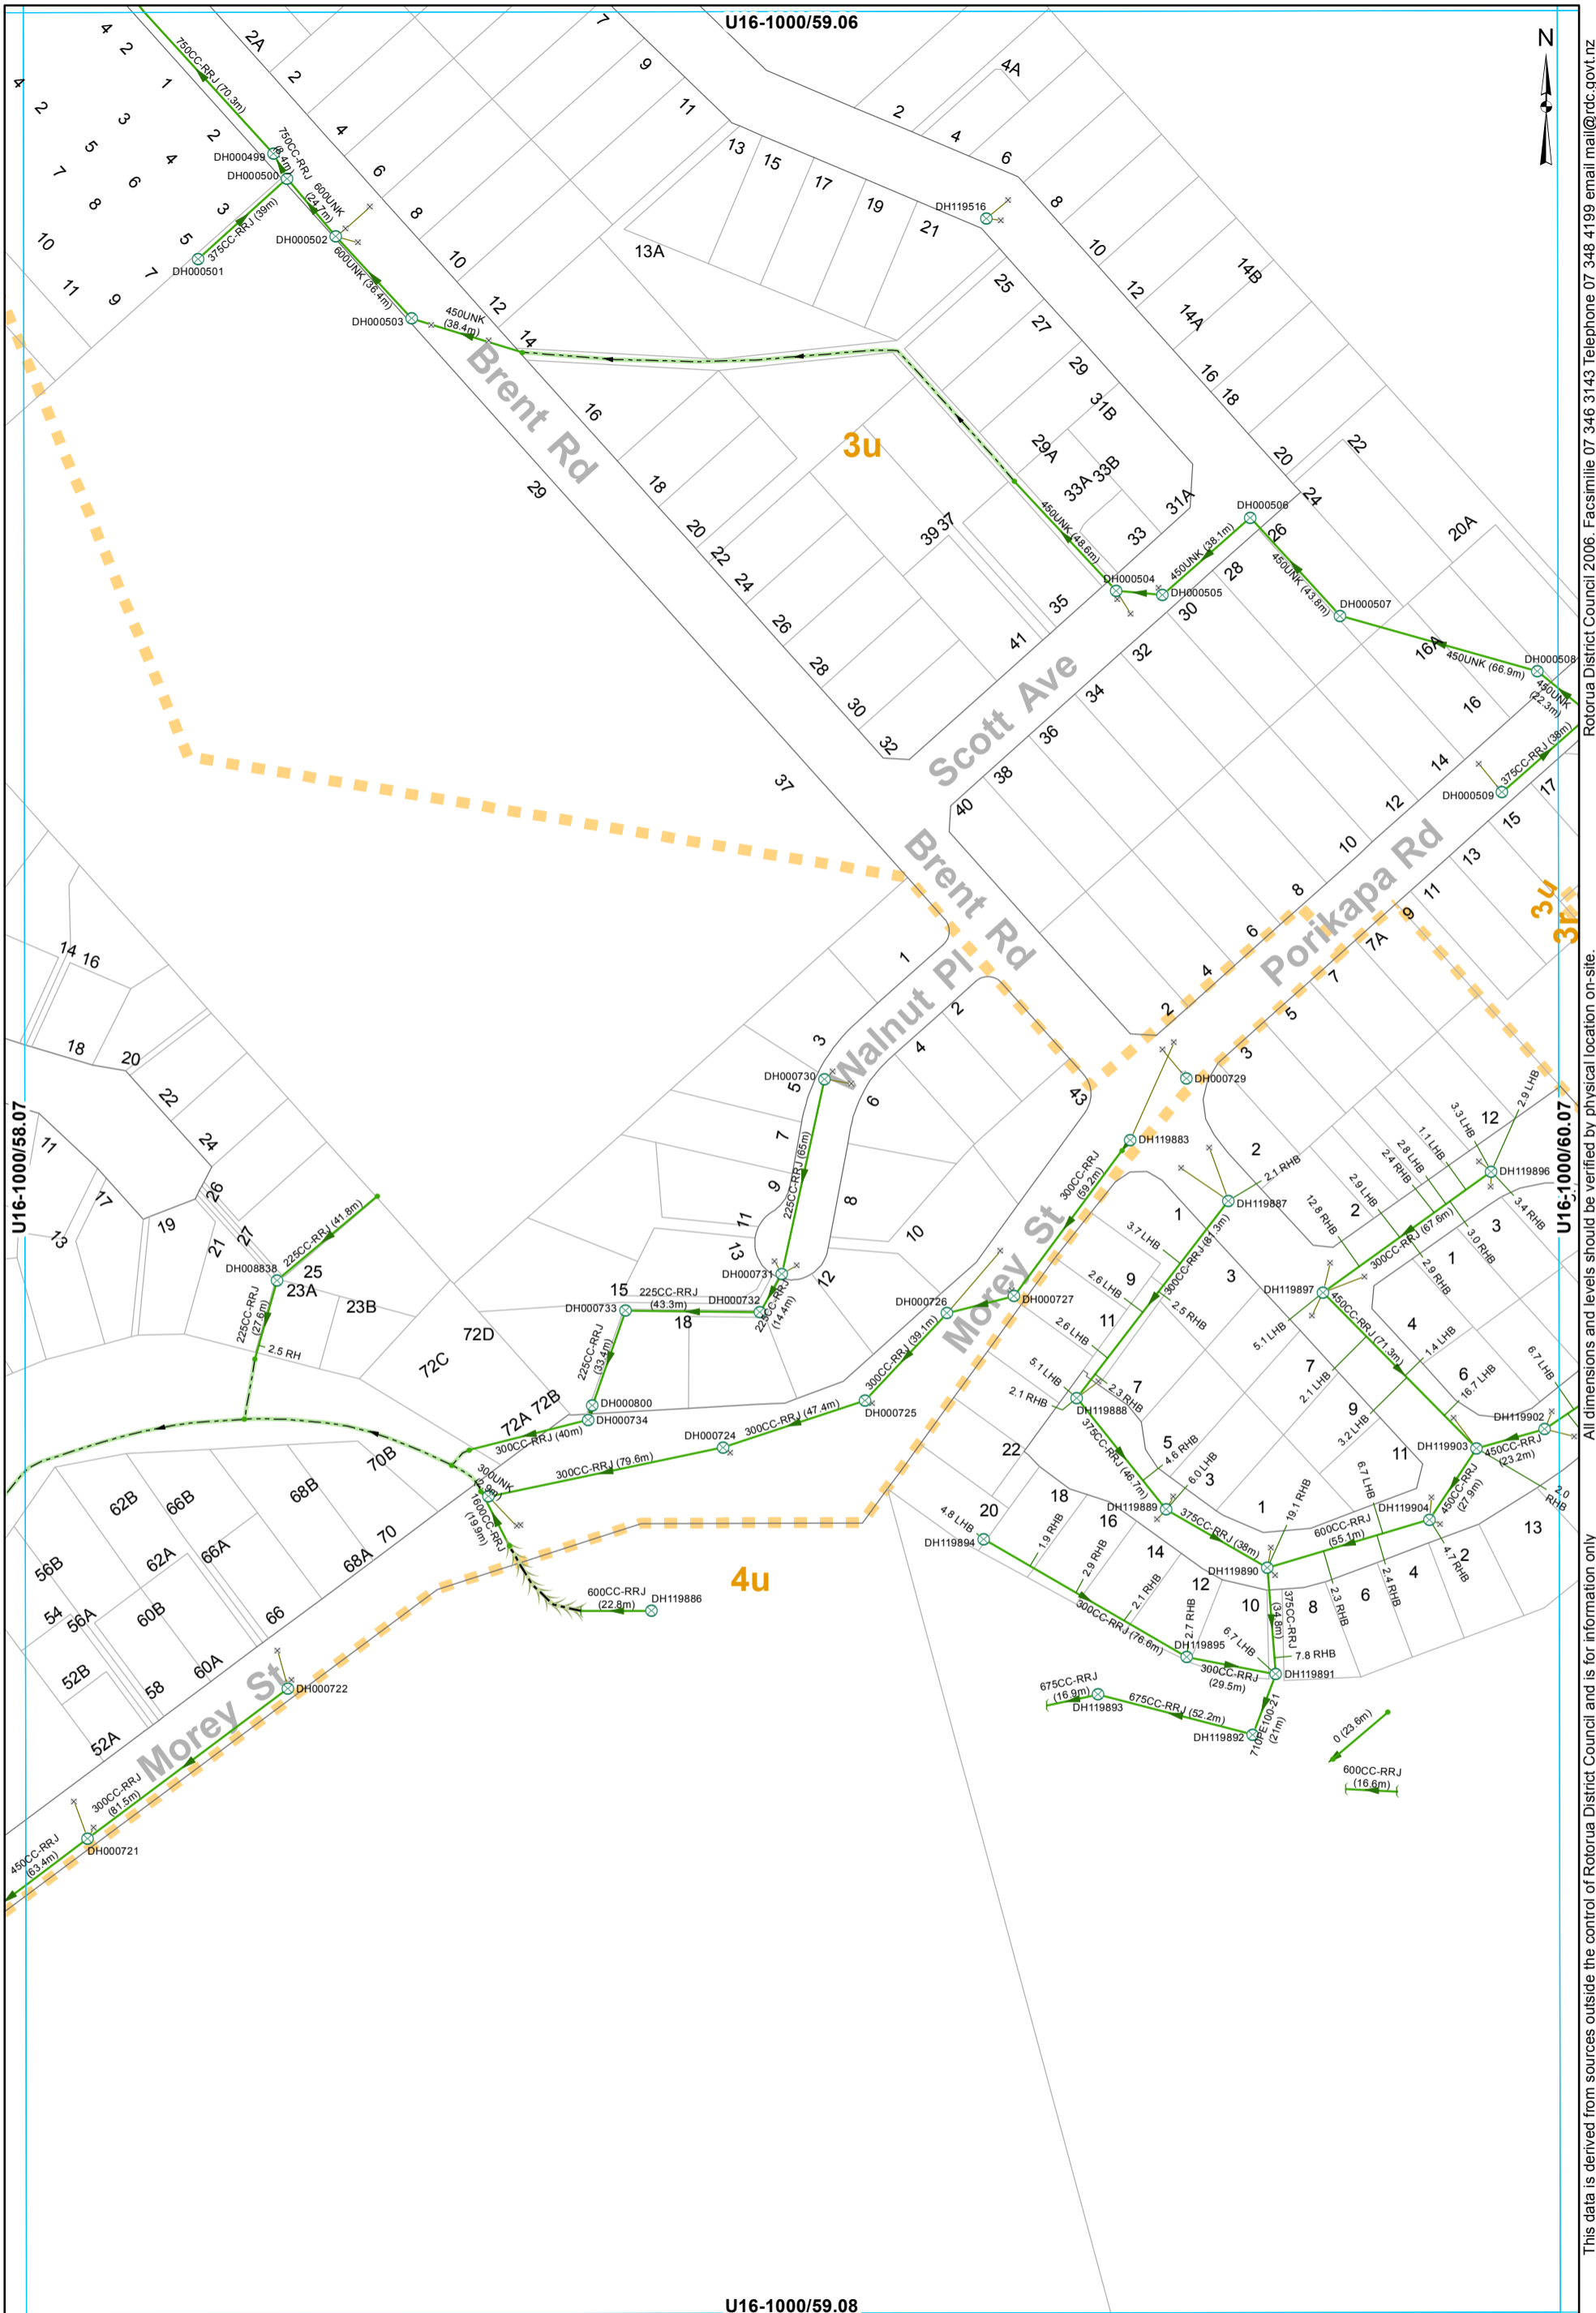

All dimensions and levels should be verified by physical location on-site. Rotorua District Council 2006. Facsimile 07 346 3143 Telephone 07 348 4199 email mail@rdc.govt.nz

- ⊗ SWManhole
- × SWInlet
- Node
- Headwall Structure
- Open Drain
- Overland Flow
- Culvert
- Gravity Main
- SWServiceline
- SWServiceline
- SWLead
- Catchment Boundary

**STORMWATER SERVICES**  
1:2000 @ A3 - (U16-1000/59.07)


U16-1000/59.08

U16-1000/59.06

U16-1000/58.07

U16-1000/60.07



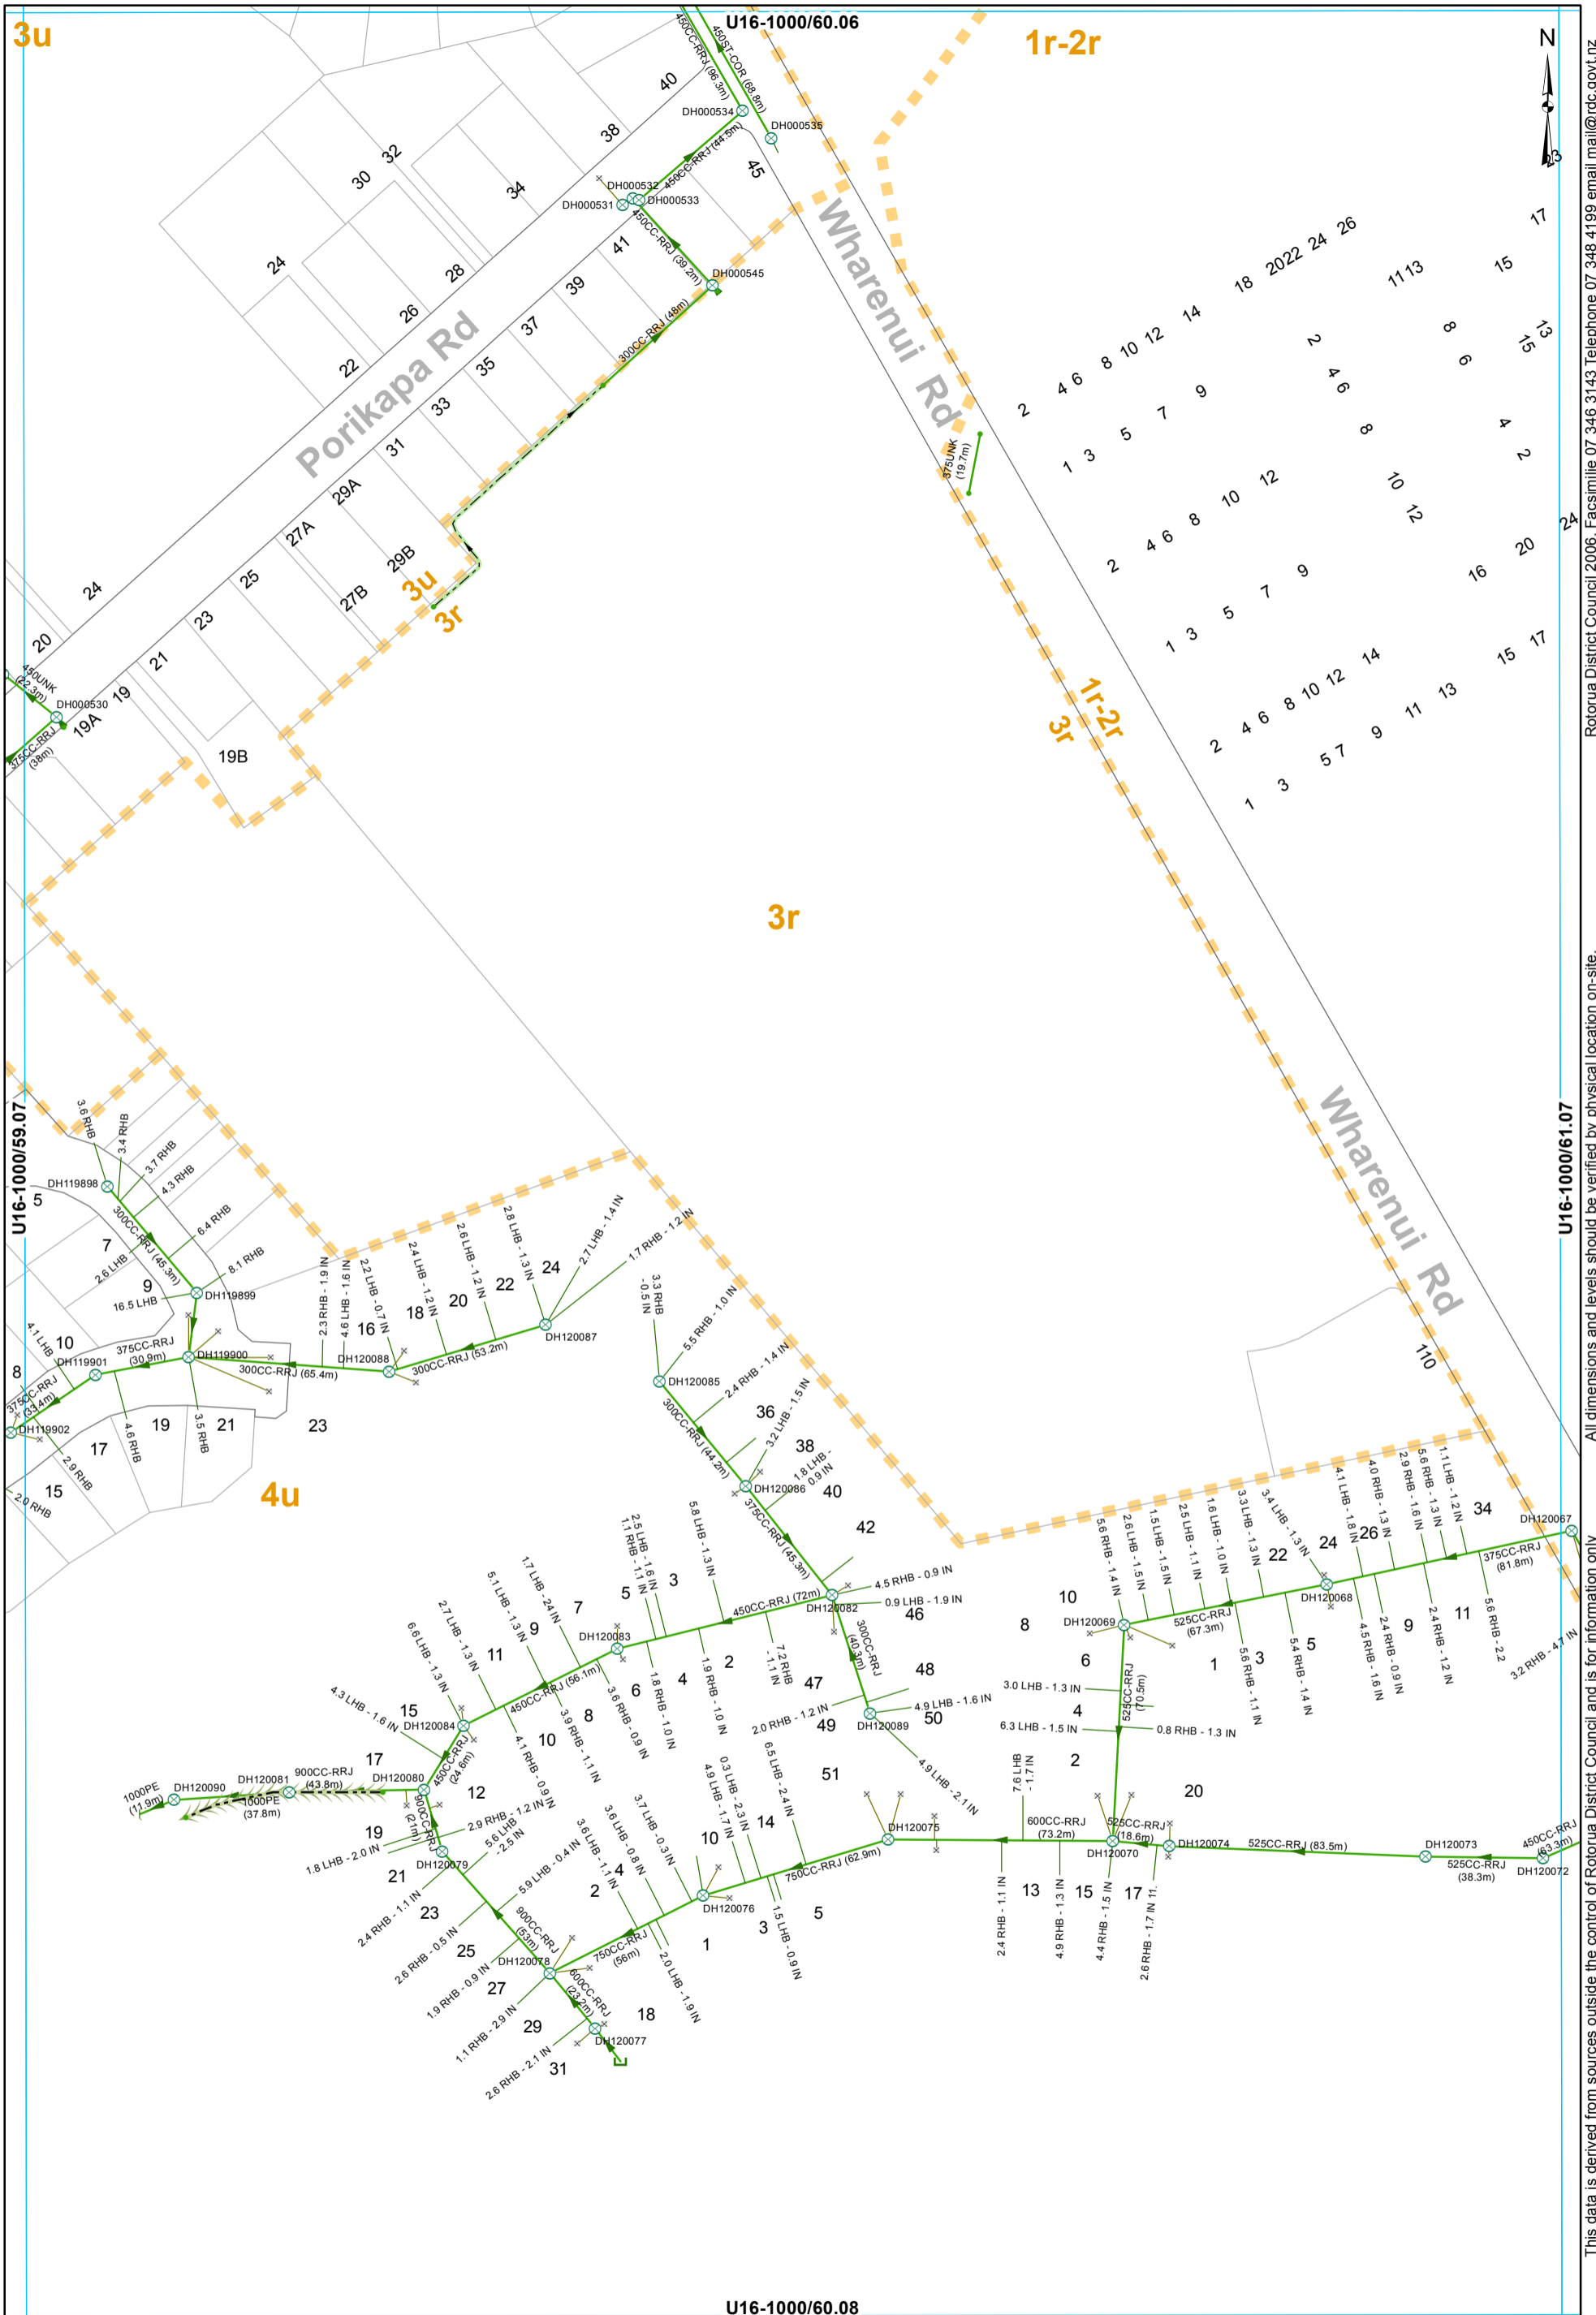

All dimensions and levels outside the control of Rotorua District Council and is for information only.

Rotorua District Council 2006. Facsimile 07 346 3143 Telephone 07 348 4199 email mail@rdc.govt.nz

- ⊗ SWManhole
- × SWInlet
- Node
- ┌ Capped End
- └ Headwall Structure
- Open Drain
- Overland Flow
- Culvert
- Gravity Main
- SWServiceline
- SWServiceline
- SWLead
- ▭ Catchment Boundary

**STORMWATER SERVICES**  
1:2000 @ A3 - (U16-1000/60.07)

U16-1000/60.08

3u

1r-2r

3r

4u

U16-1000/61.07

U16-1000/69.07

U16-1000/60.08