

U16-1000/61.06



23
21
19
17
15
13
11
9
7
5
3
1
24
23 25 27 29
19

U16-1000/60.07

U16-1000/62.07

1r-2r

1r-2r
4u

4u

4u
4r
4r

U16-1000/61.08




- ⊗ SWManhole
- × SWInlet
- Headwall Structure
- Gravity Main
- SWLead
- Catchment Boundary

STORMWATER SERVICES
1:2000 @ A3 - (U16-1000/61.07)

This data is derived from sources outside the control of Rotorua District Council and is for information only

Rotorua District Council 2006. Facsimile 07 346 3143 Telephone 07 348 4199 email mail@rdc.govt.nz

U16-1000/59.07

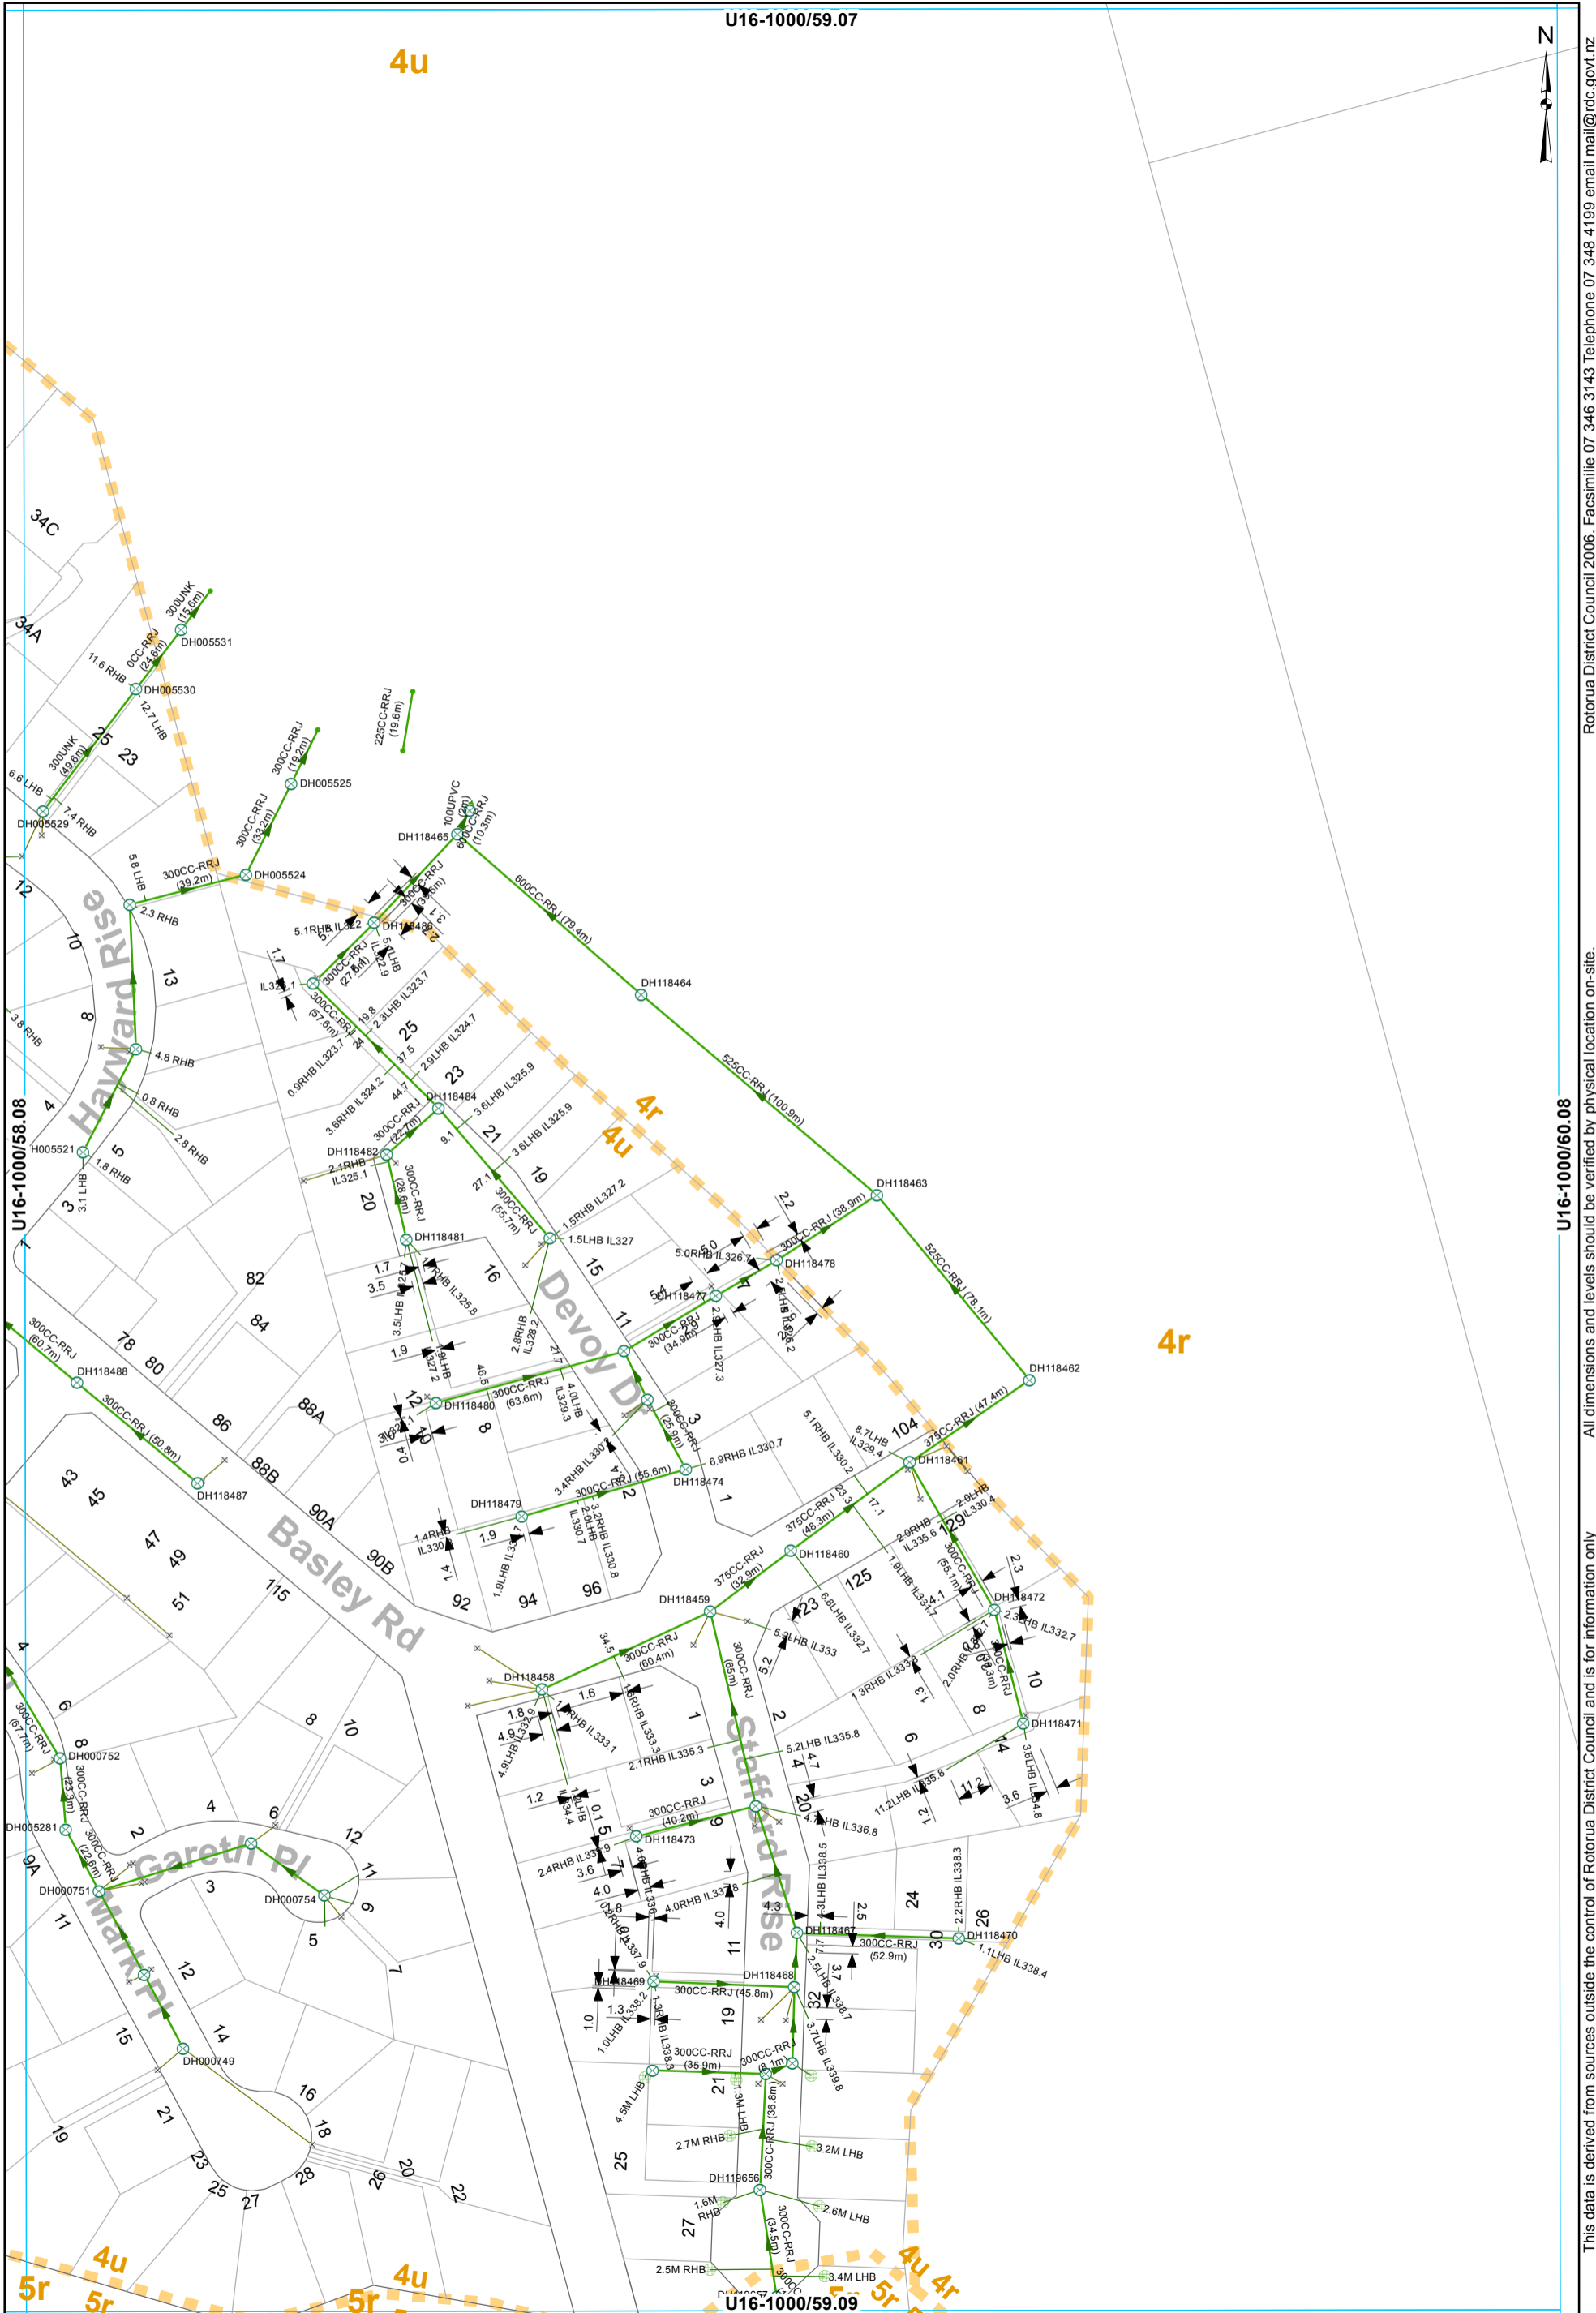


U16-1000/60.08

This data is derived from sources outside the control of Rotorua District Council and is for information only

Rotorua District Council 2006. Facsimile 07 346 3143 Telephone 07 346 4199 email mail@rdc.govt.nz

STORMWATER SERVICES
1:2000 @ A3 - (U16-1000/59.08)

- ⊗ SWManhole
- × SWInlet
- Node
- ⊕ Soak Hole
- Culvert
- Gravity Main
- SWServiceline
- SWServiceline
- SWLead
- Catchment Boundary

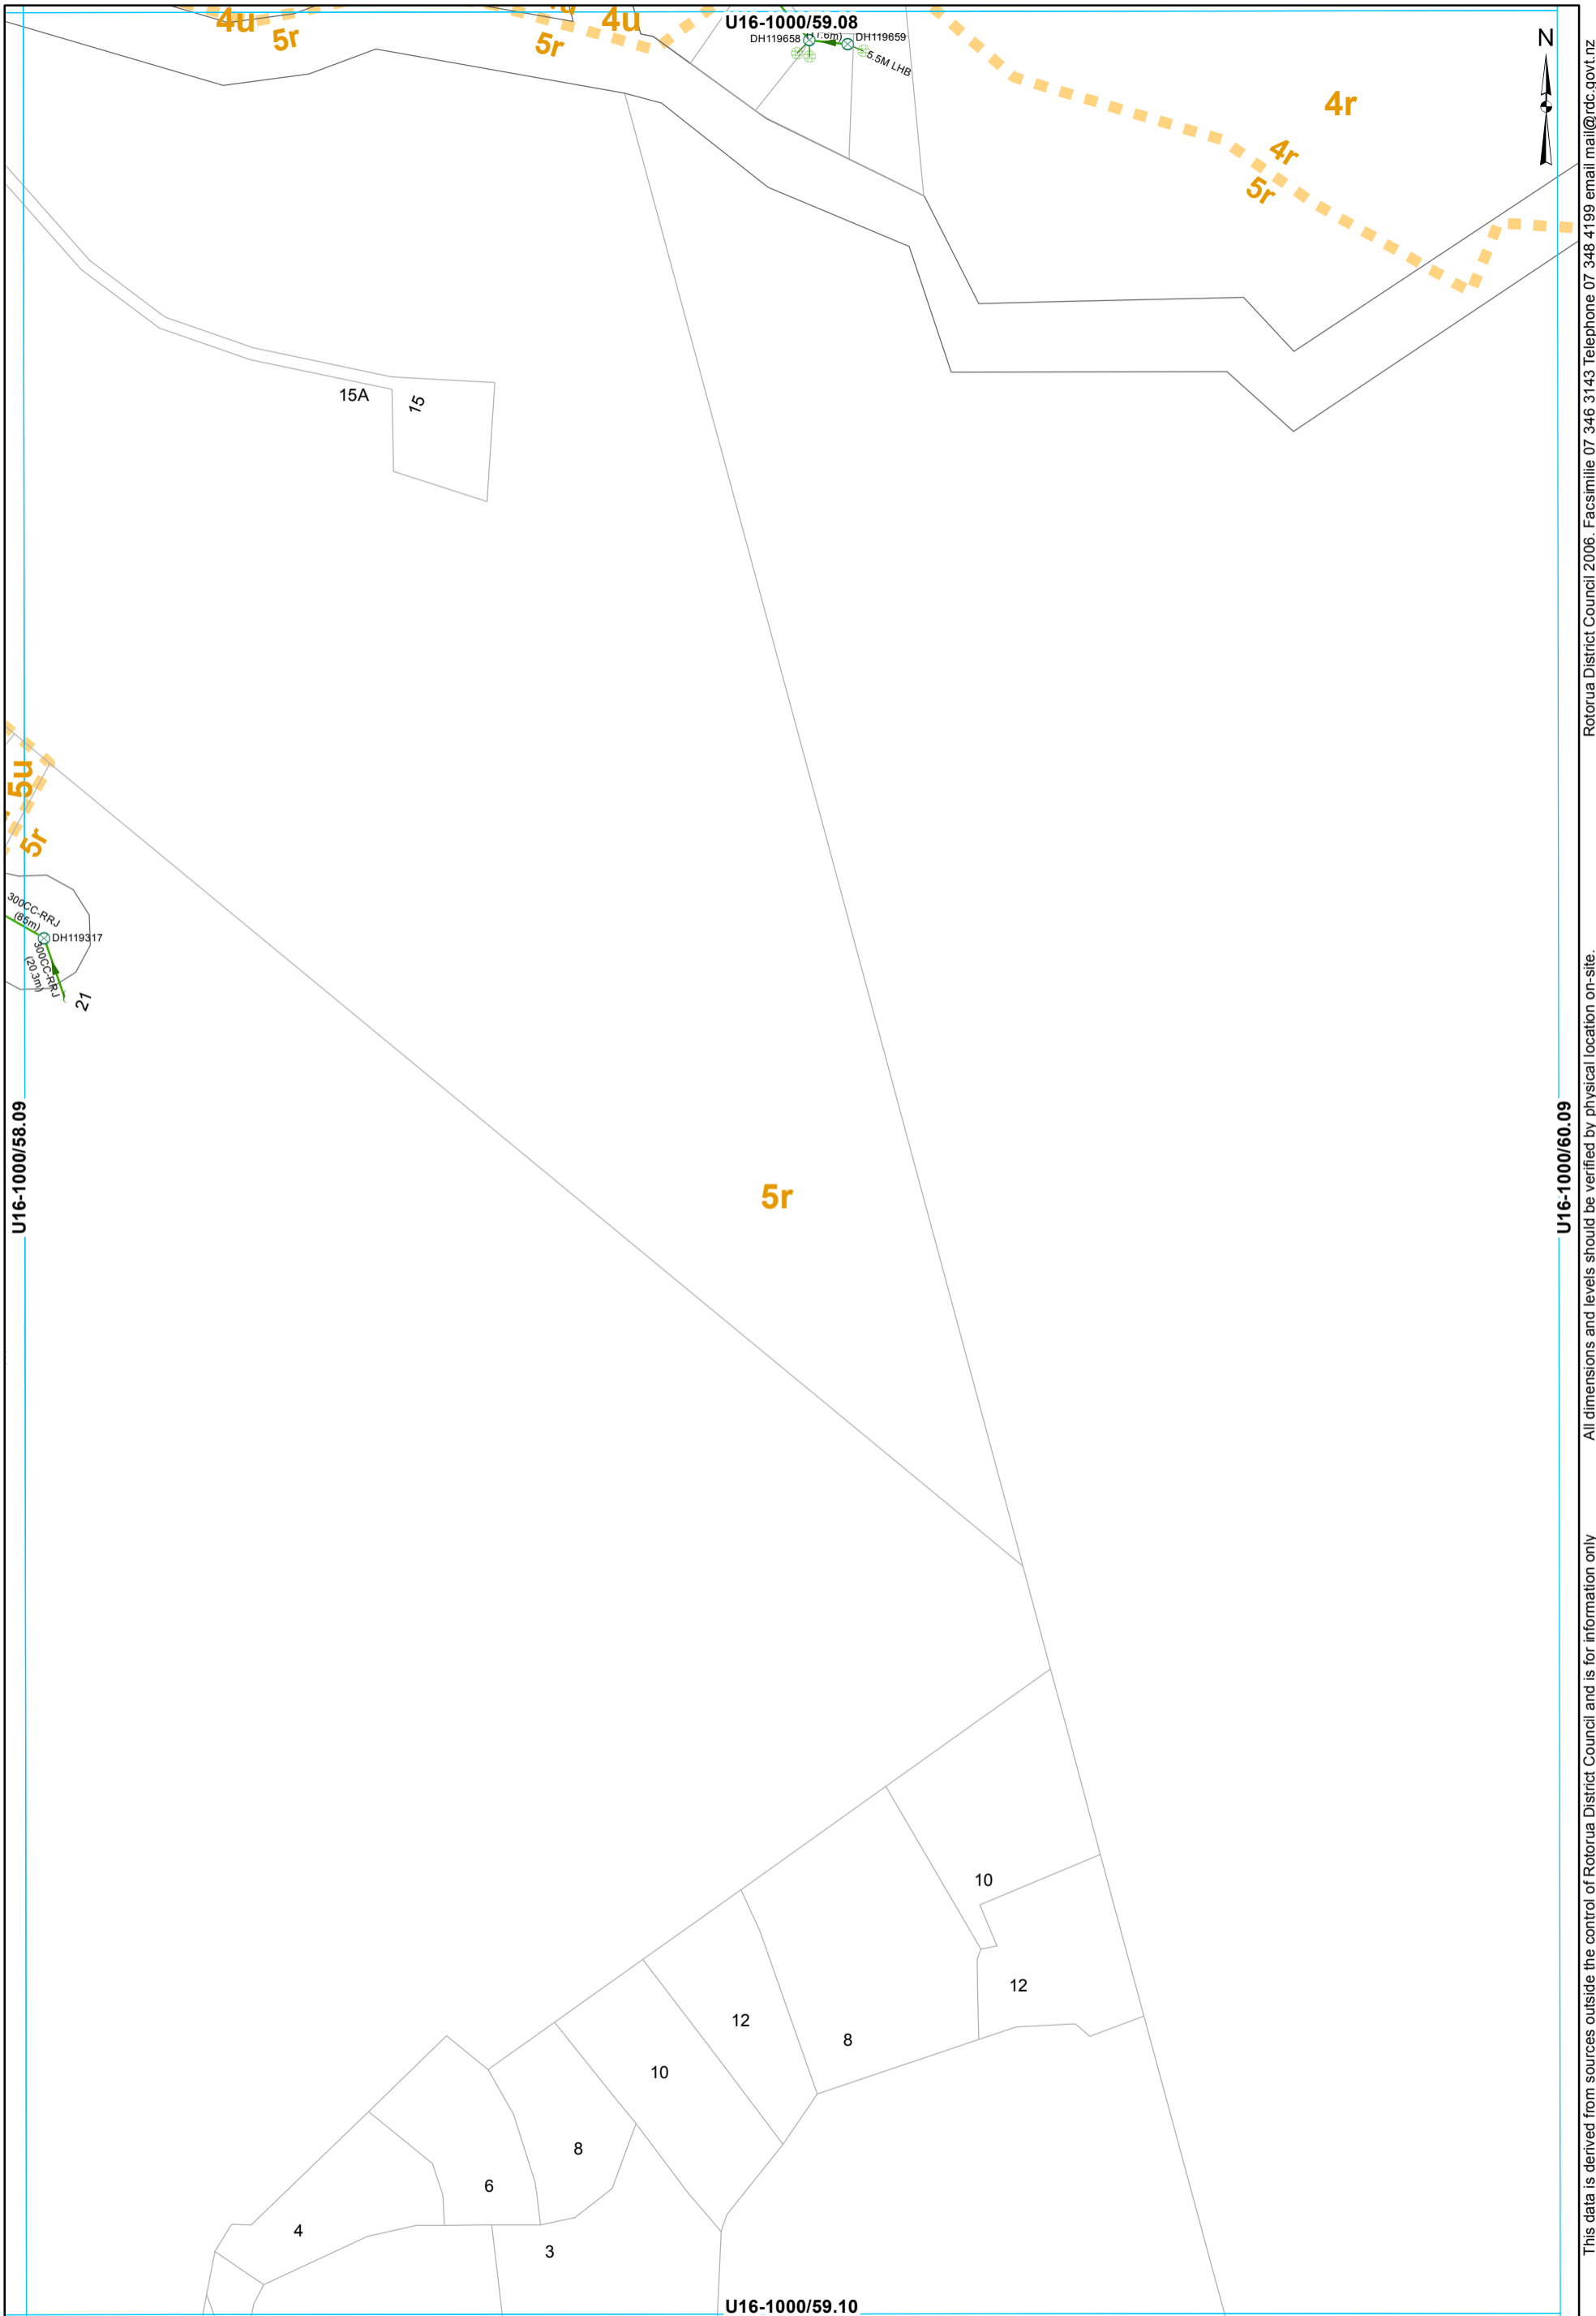

- ⊗ SWManhole
- × SWInlet
- Headwall Structure
- ⊕ Soak Hole
- Gravity Main
- SWServiceline
- SWServiceline
- Catchment Boundary

STORMWATER SERVICES
1:2000 @ A3 - (U16-1000/59.09)

This data is derived from sources outside the control of Rotorua District Council and is for information only

Rotorua District Council 2006. Facsimile 07 346 3143 Telephone 07 348 4199 email mail@rdc.govt.nz