




Storm Water Asbuilt Sheet Index  
SWcatchment 5r



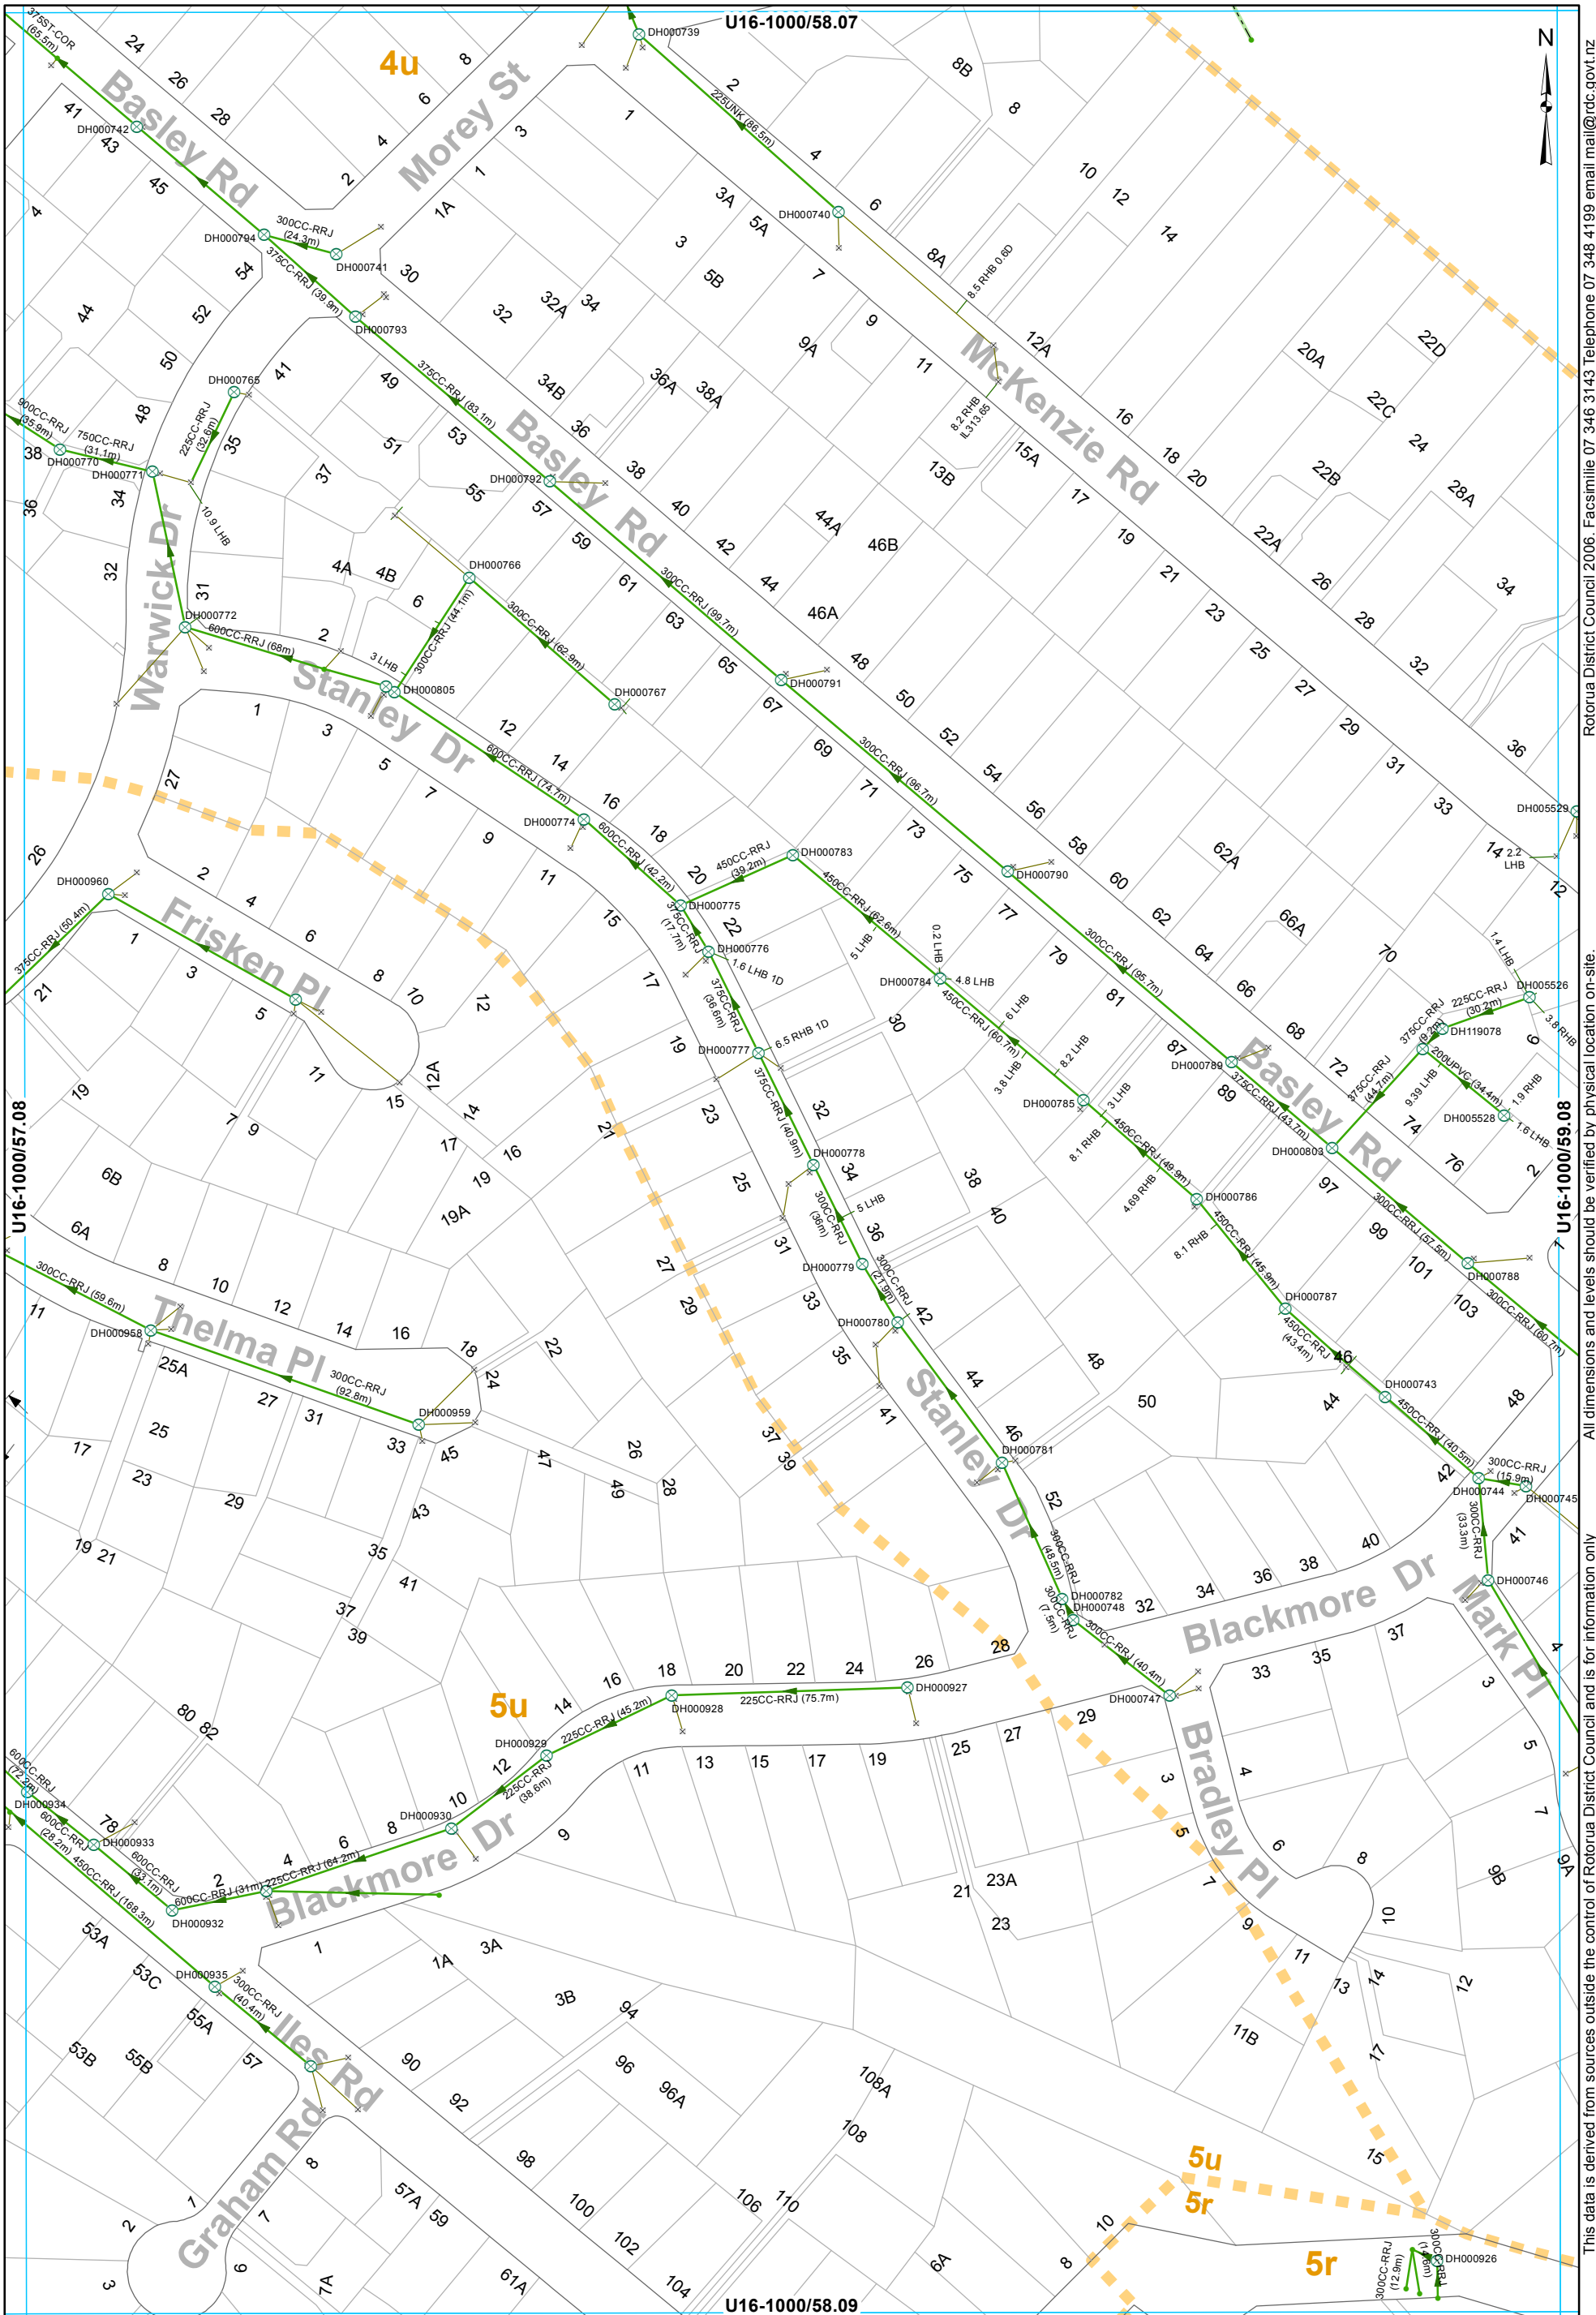

- SWManhole
- × SWInlet
- Node
- Open Drain
- Culvert
- Gravity Main
- SWServiceLine
- SWServiceLine
- SWLead
- - - Catchment Boundary


**STORMWATER SERVICES**  
**1:2000 @ A3 - (U16-1000/58.08)**

All dimensions and levels should be verified by physical location on-site. This data is derived from sources outside the control of Rotorua District Council and is for information only.

Rotorua District Council 2006. Facsimile 07 346 3143 Telephone 07 348 4199 email mail@rdc.govt.nz

U16-1000/59.07

4u

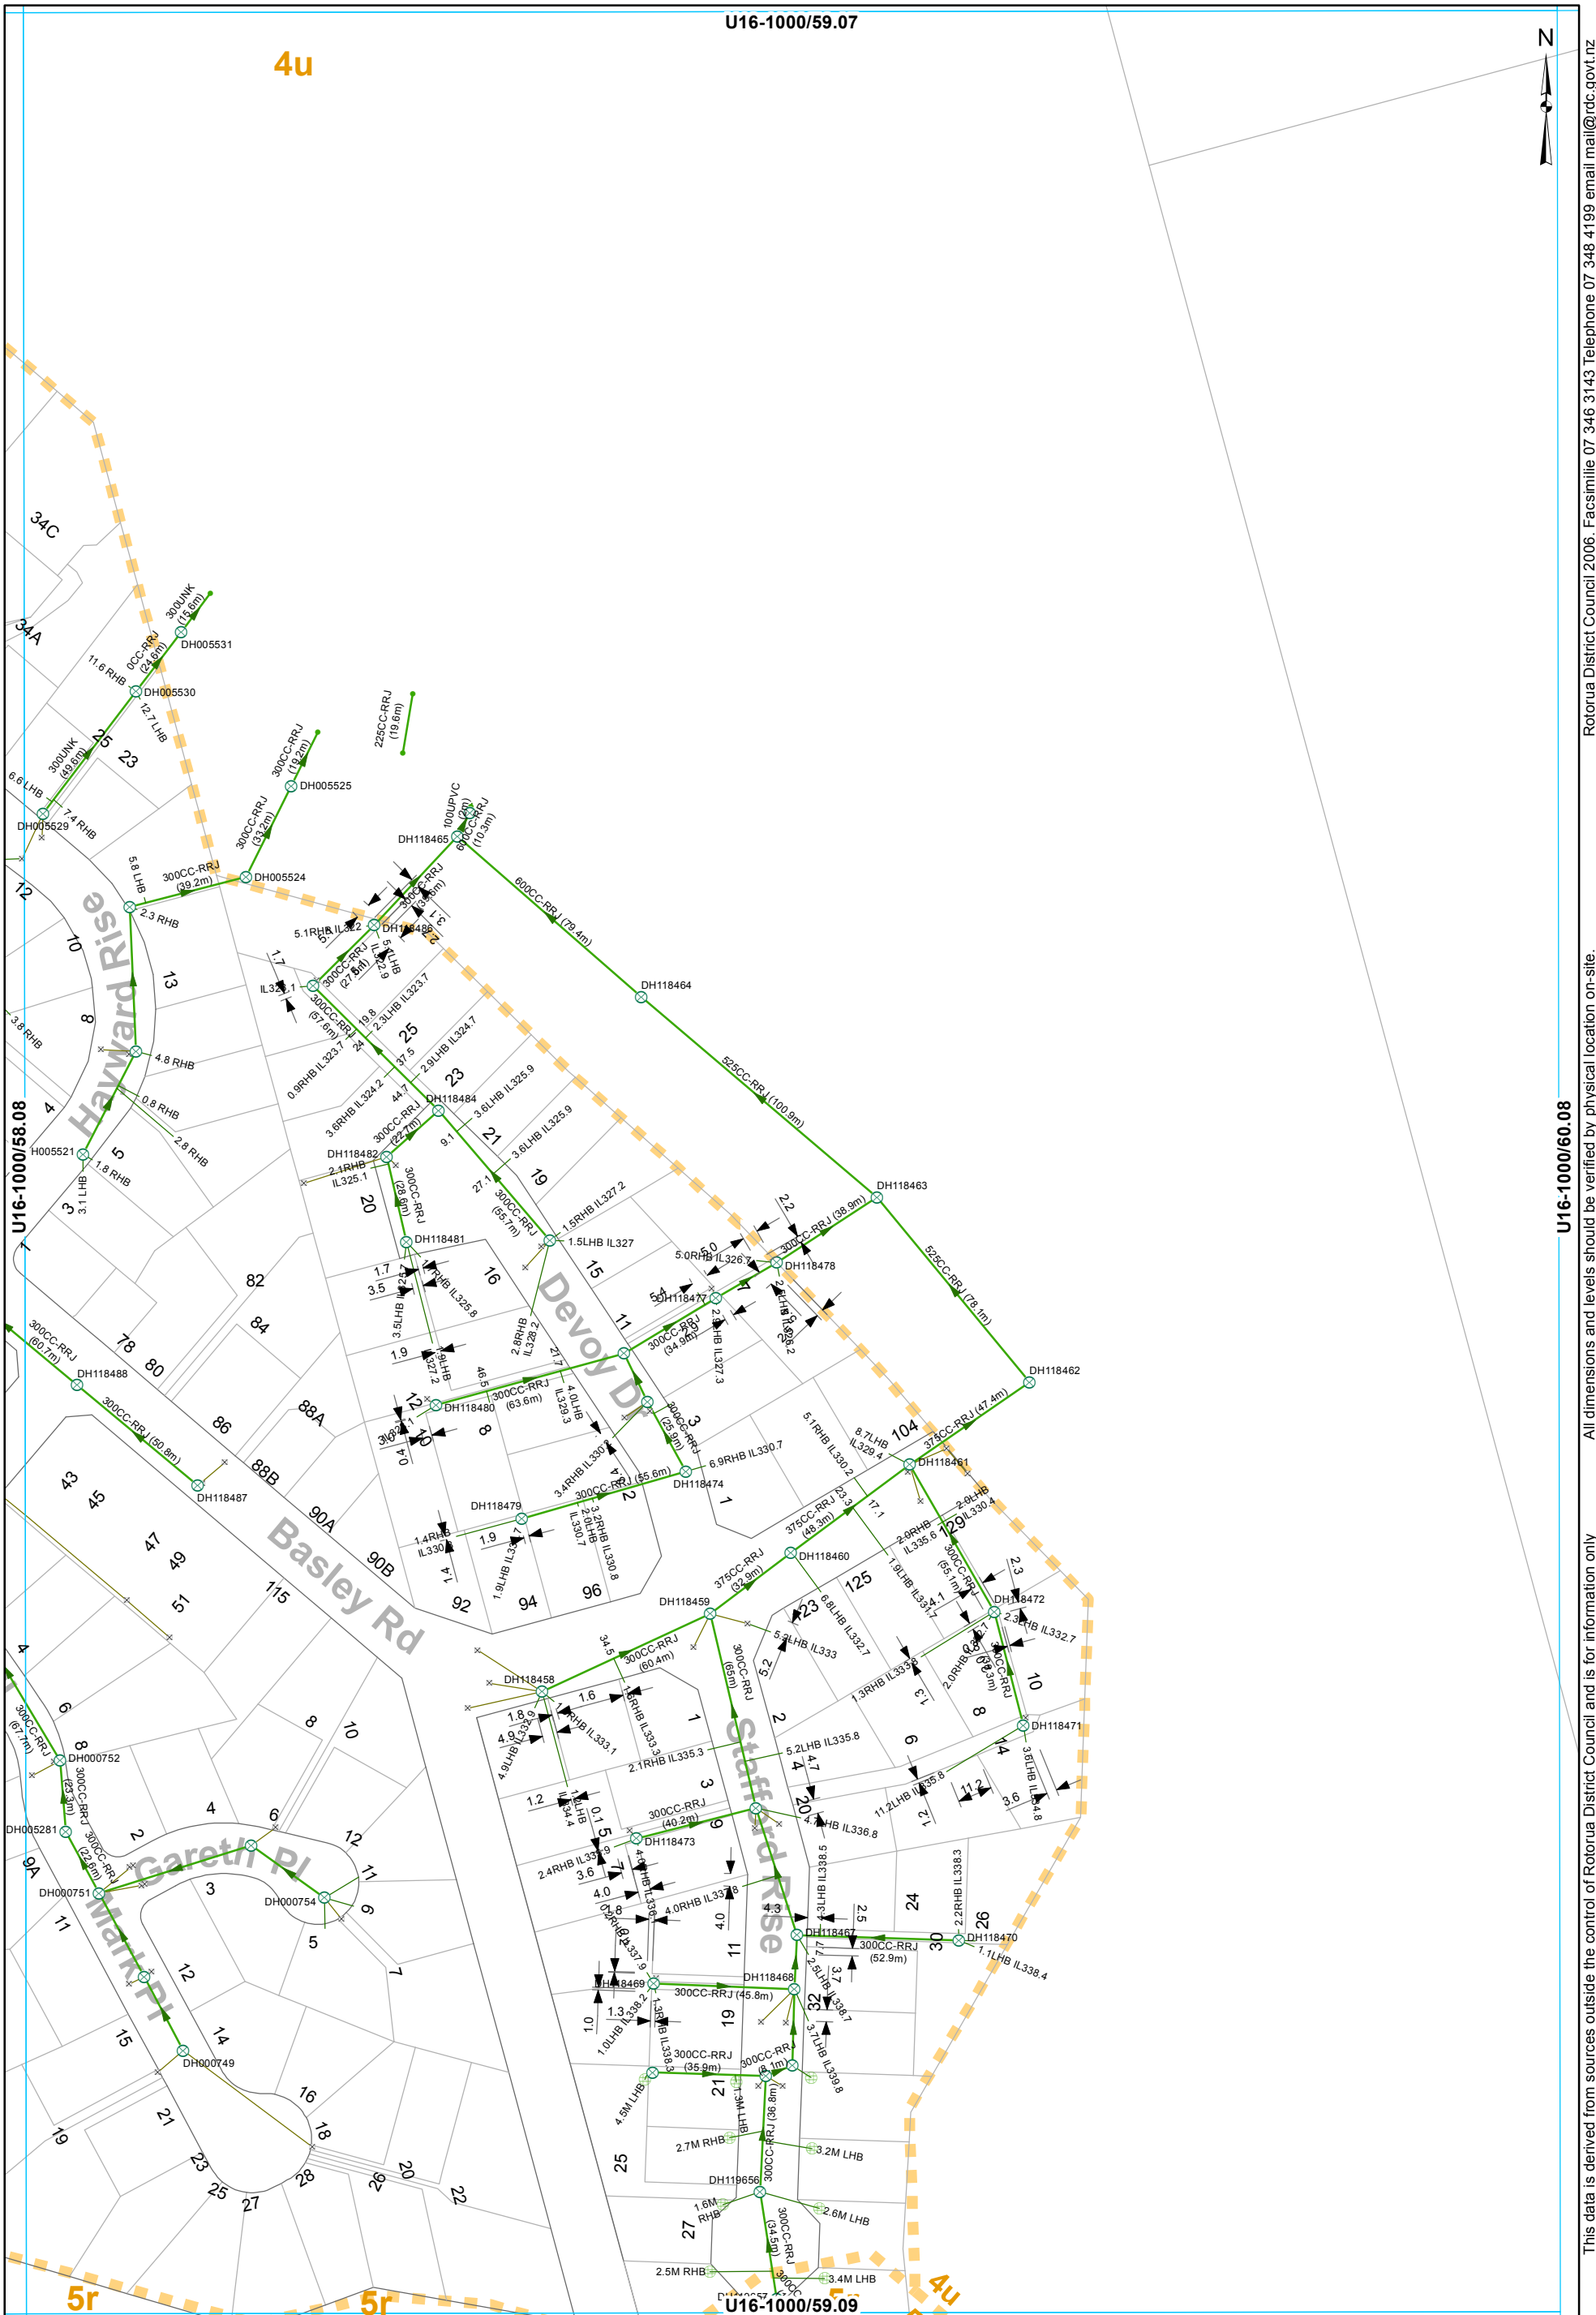

U16-1000/60.08


This data is derived from sources outside the control of Rotorua District Council and is for information only. All dimensions and levels should be verified by physical location on-site.

Rotorua District Council 2006. Facsimile 07 346 3143 Telephone 07 348 4199 email mail@rdc.govt.nz

- ⊗ SWManhole
- × SWInlet
- Node
- ⊕ Soak Hole
- Culvert
- Gravity Main
- SWServiceline
- SWLead
- Catchment Boundary

STORMWATER SERVICES  
1:2000 @ A3 - (U16-1000/59.08)



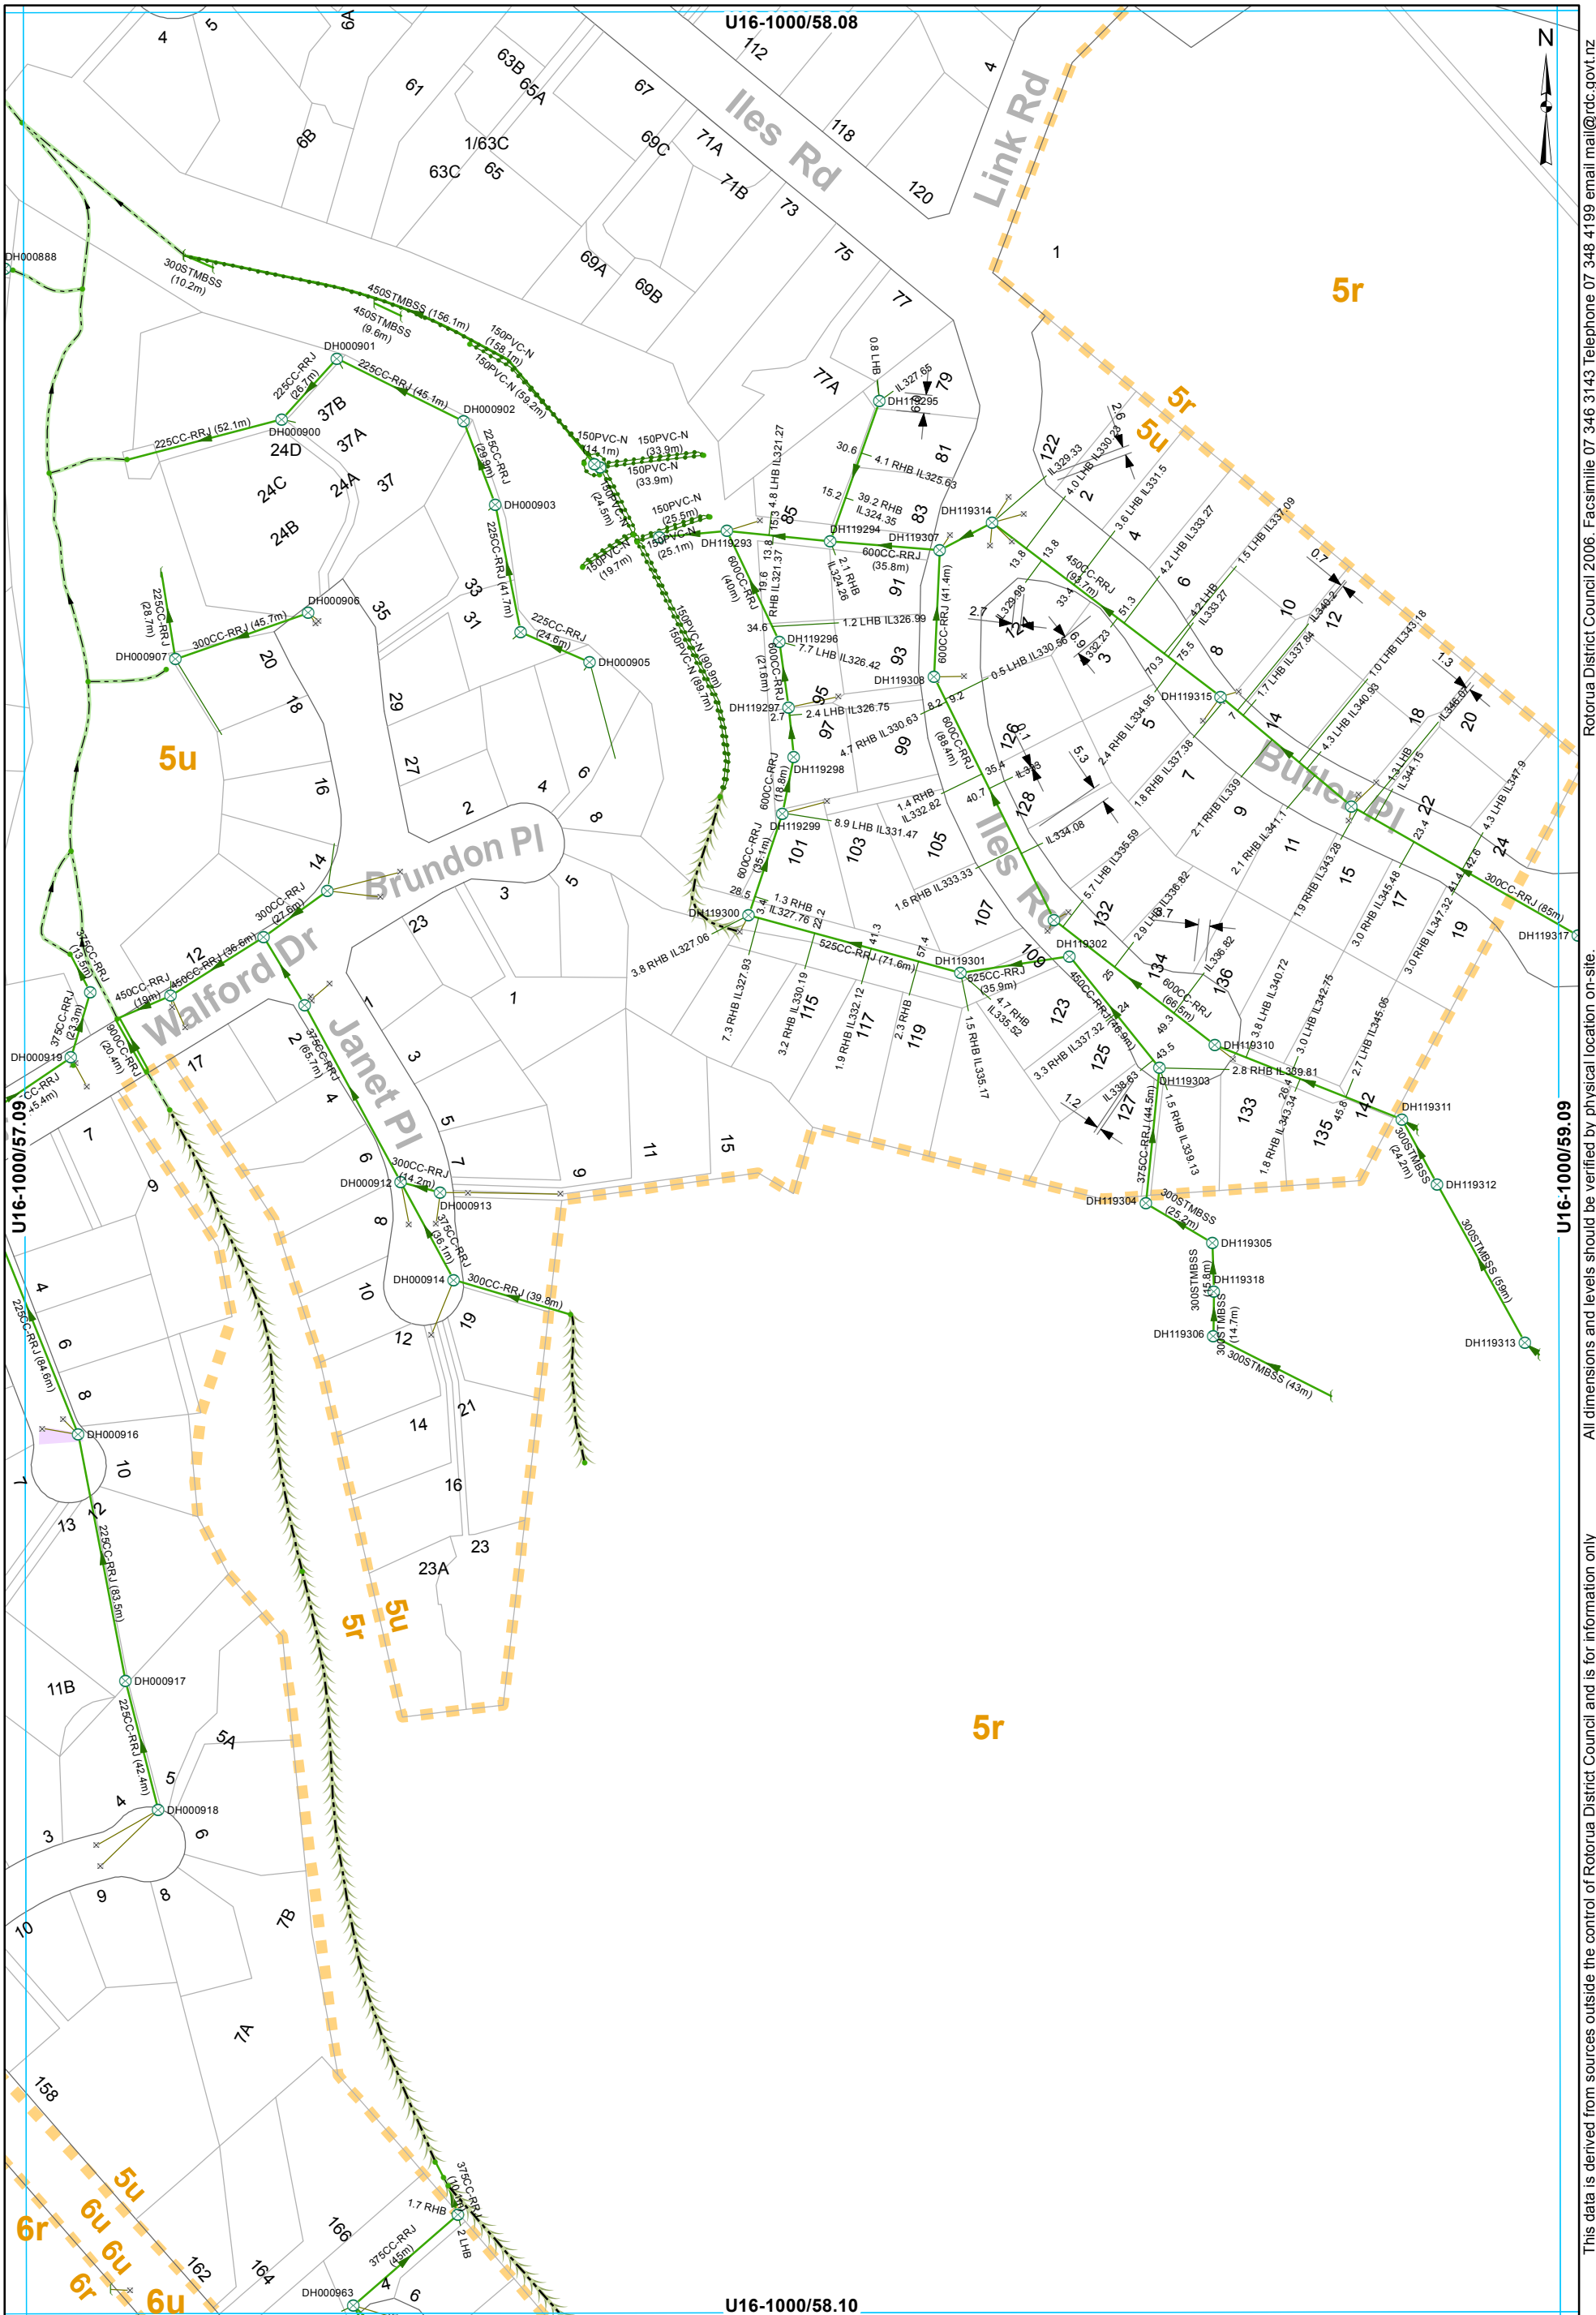


- ⊗ SWManhole
- × SWInlet
- Node
- Headwall Structure
- Open Drain
- Overland Flow
- Culvert
- Gravity Main
- Subsoil Drain
- SWServiceline
- SWServiceline
- SWLead
- Catchment Boundary

**STORMWATER SERVICES**  
**1:2000 @ A3 - (U16-1000/58.09)**

Rotorua District Council 2006. Facsimile 07 346 3143 Telephone 07 348 4199 email mail@rdc.govt.nz

All dimensions and levels outside the control of Rotorua District Council and is for information only

This data is derived from sources outside the control of Rotorua District Council and is for information only

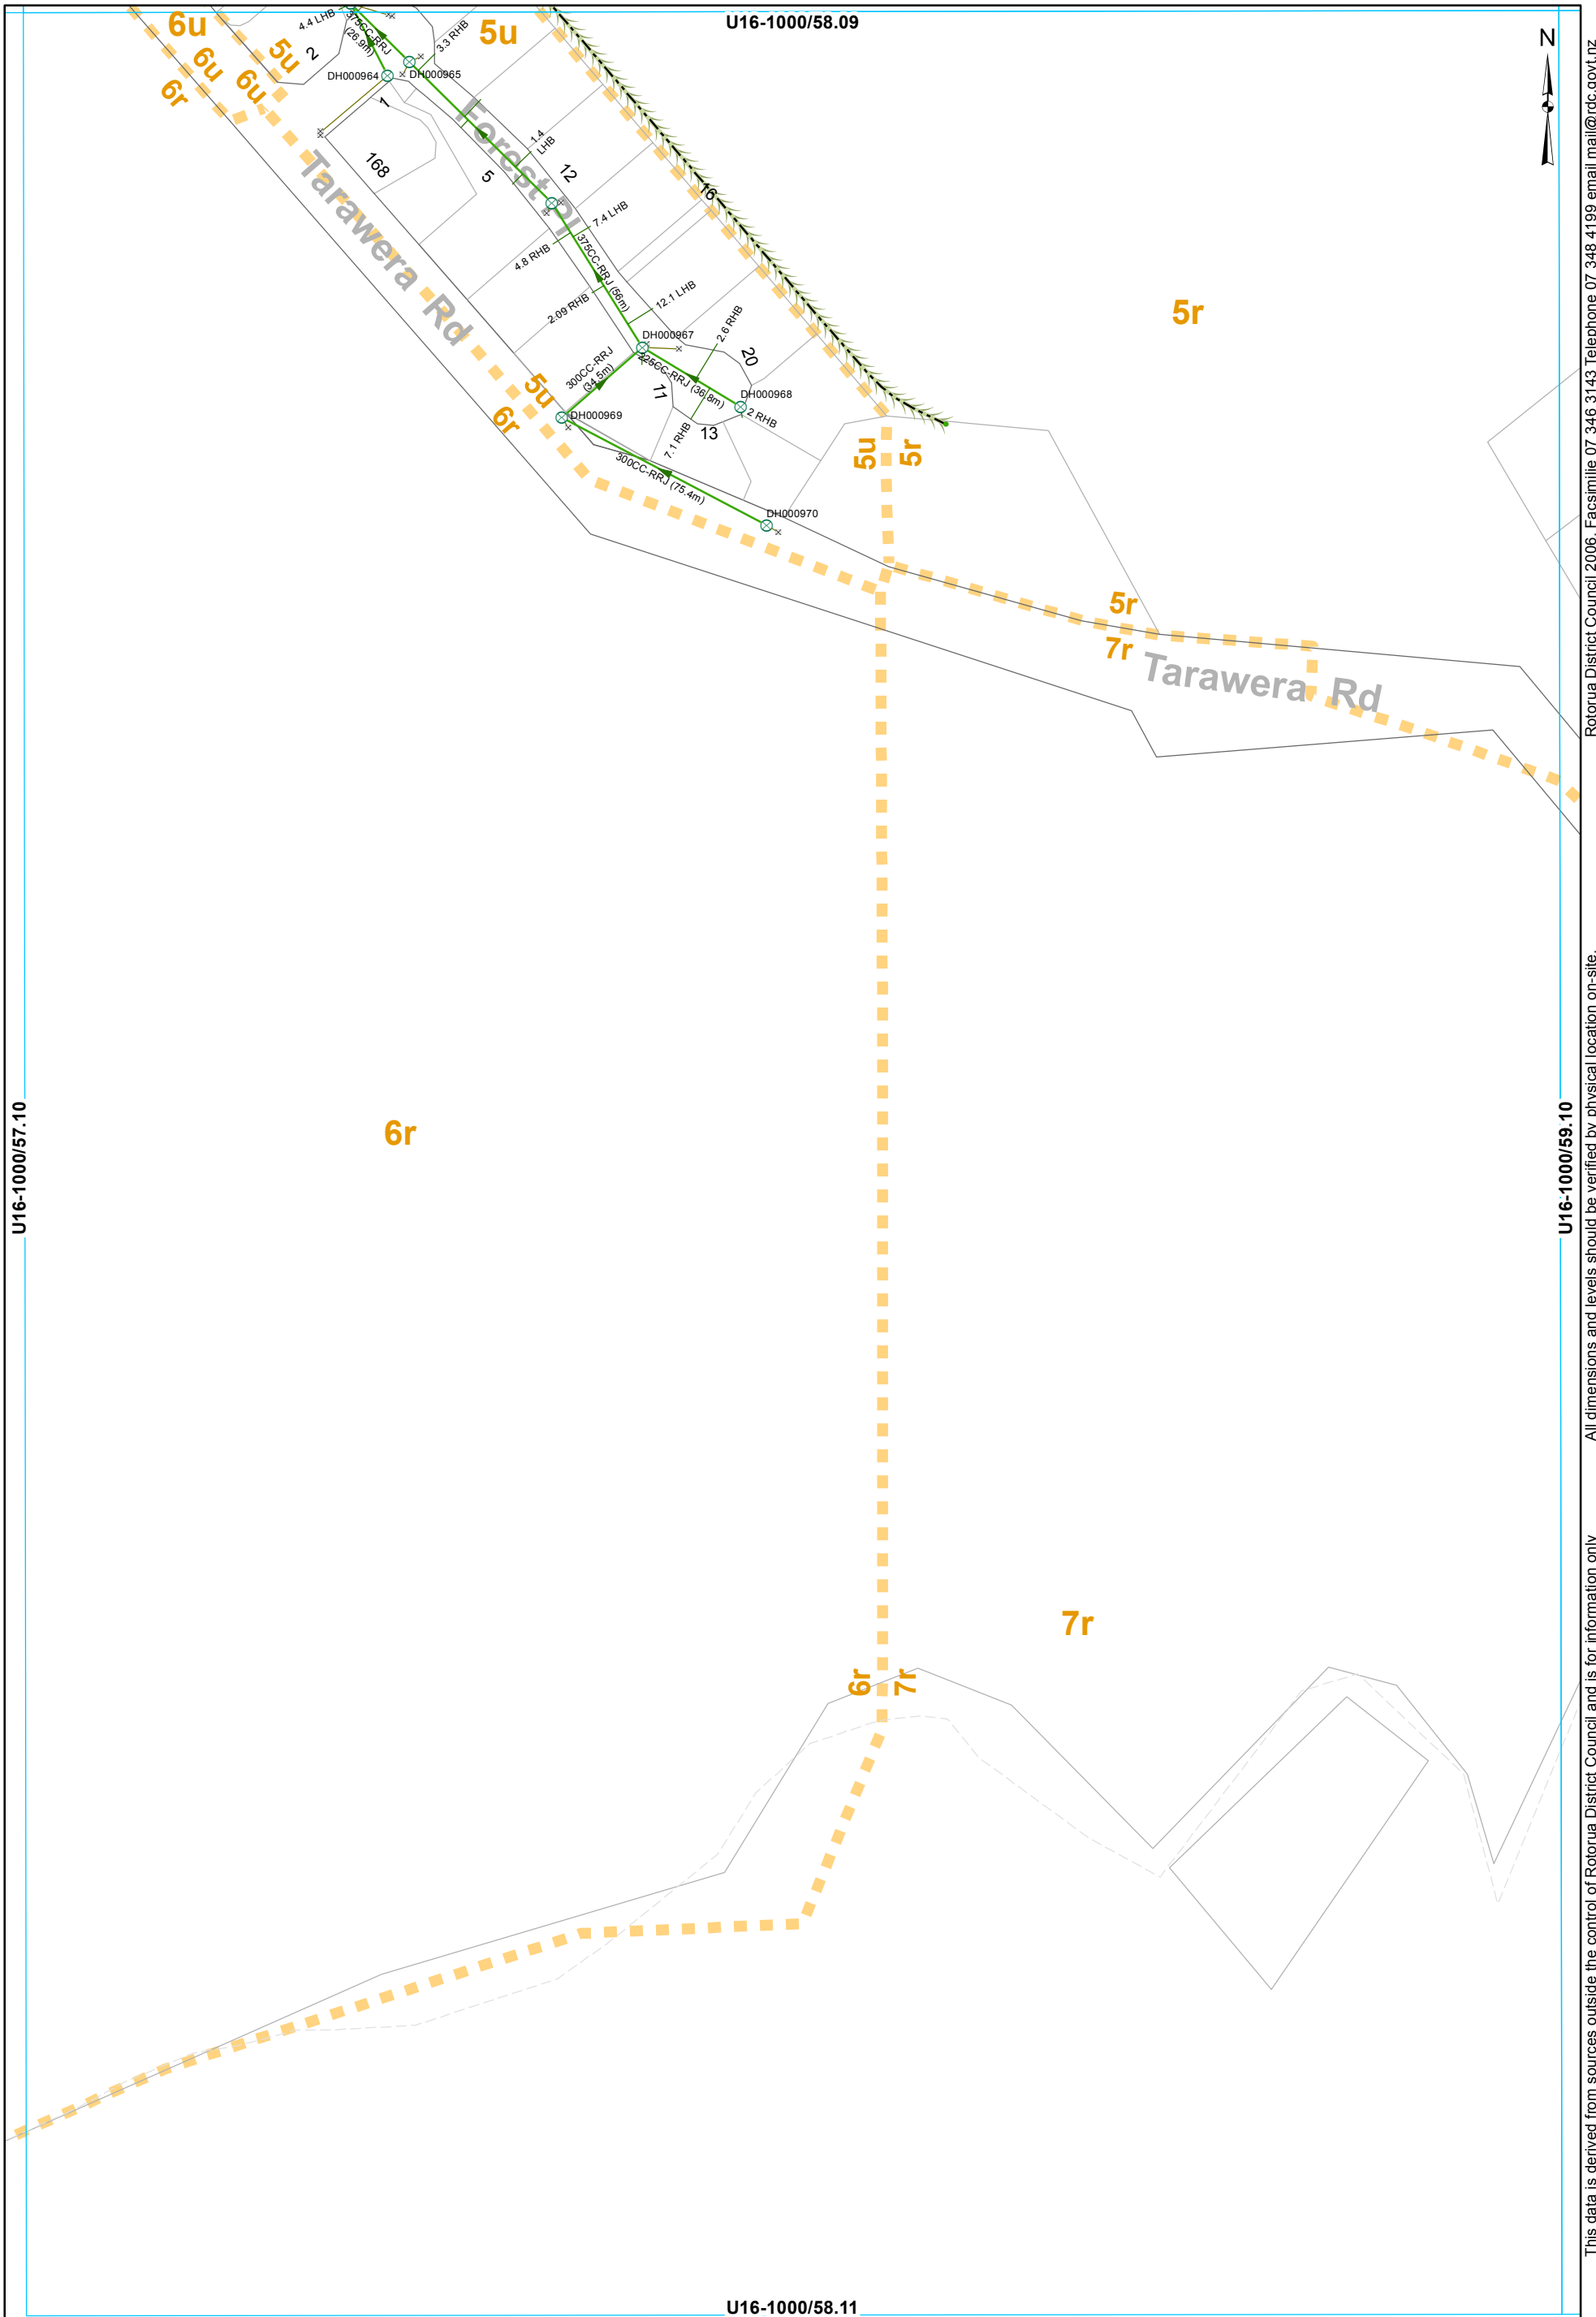


This data is derived from sources outside the control of Rotorua District Council and is for information only

Rotorua District Council 2006. Facsimile 07 346 3143 Telephone 07 348 4199 email mail@rdc.govt.nz

- ⊗ SWManhole
- × SWInlet
- Node
- Overland Flow
- Gravity Main
- SWServiceline
- SWLead
- Catchment Boundary

**STORMWATER SERVICES**  
1:2000 @ A3 - (U16-1000/58.10)

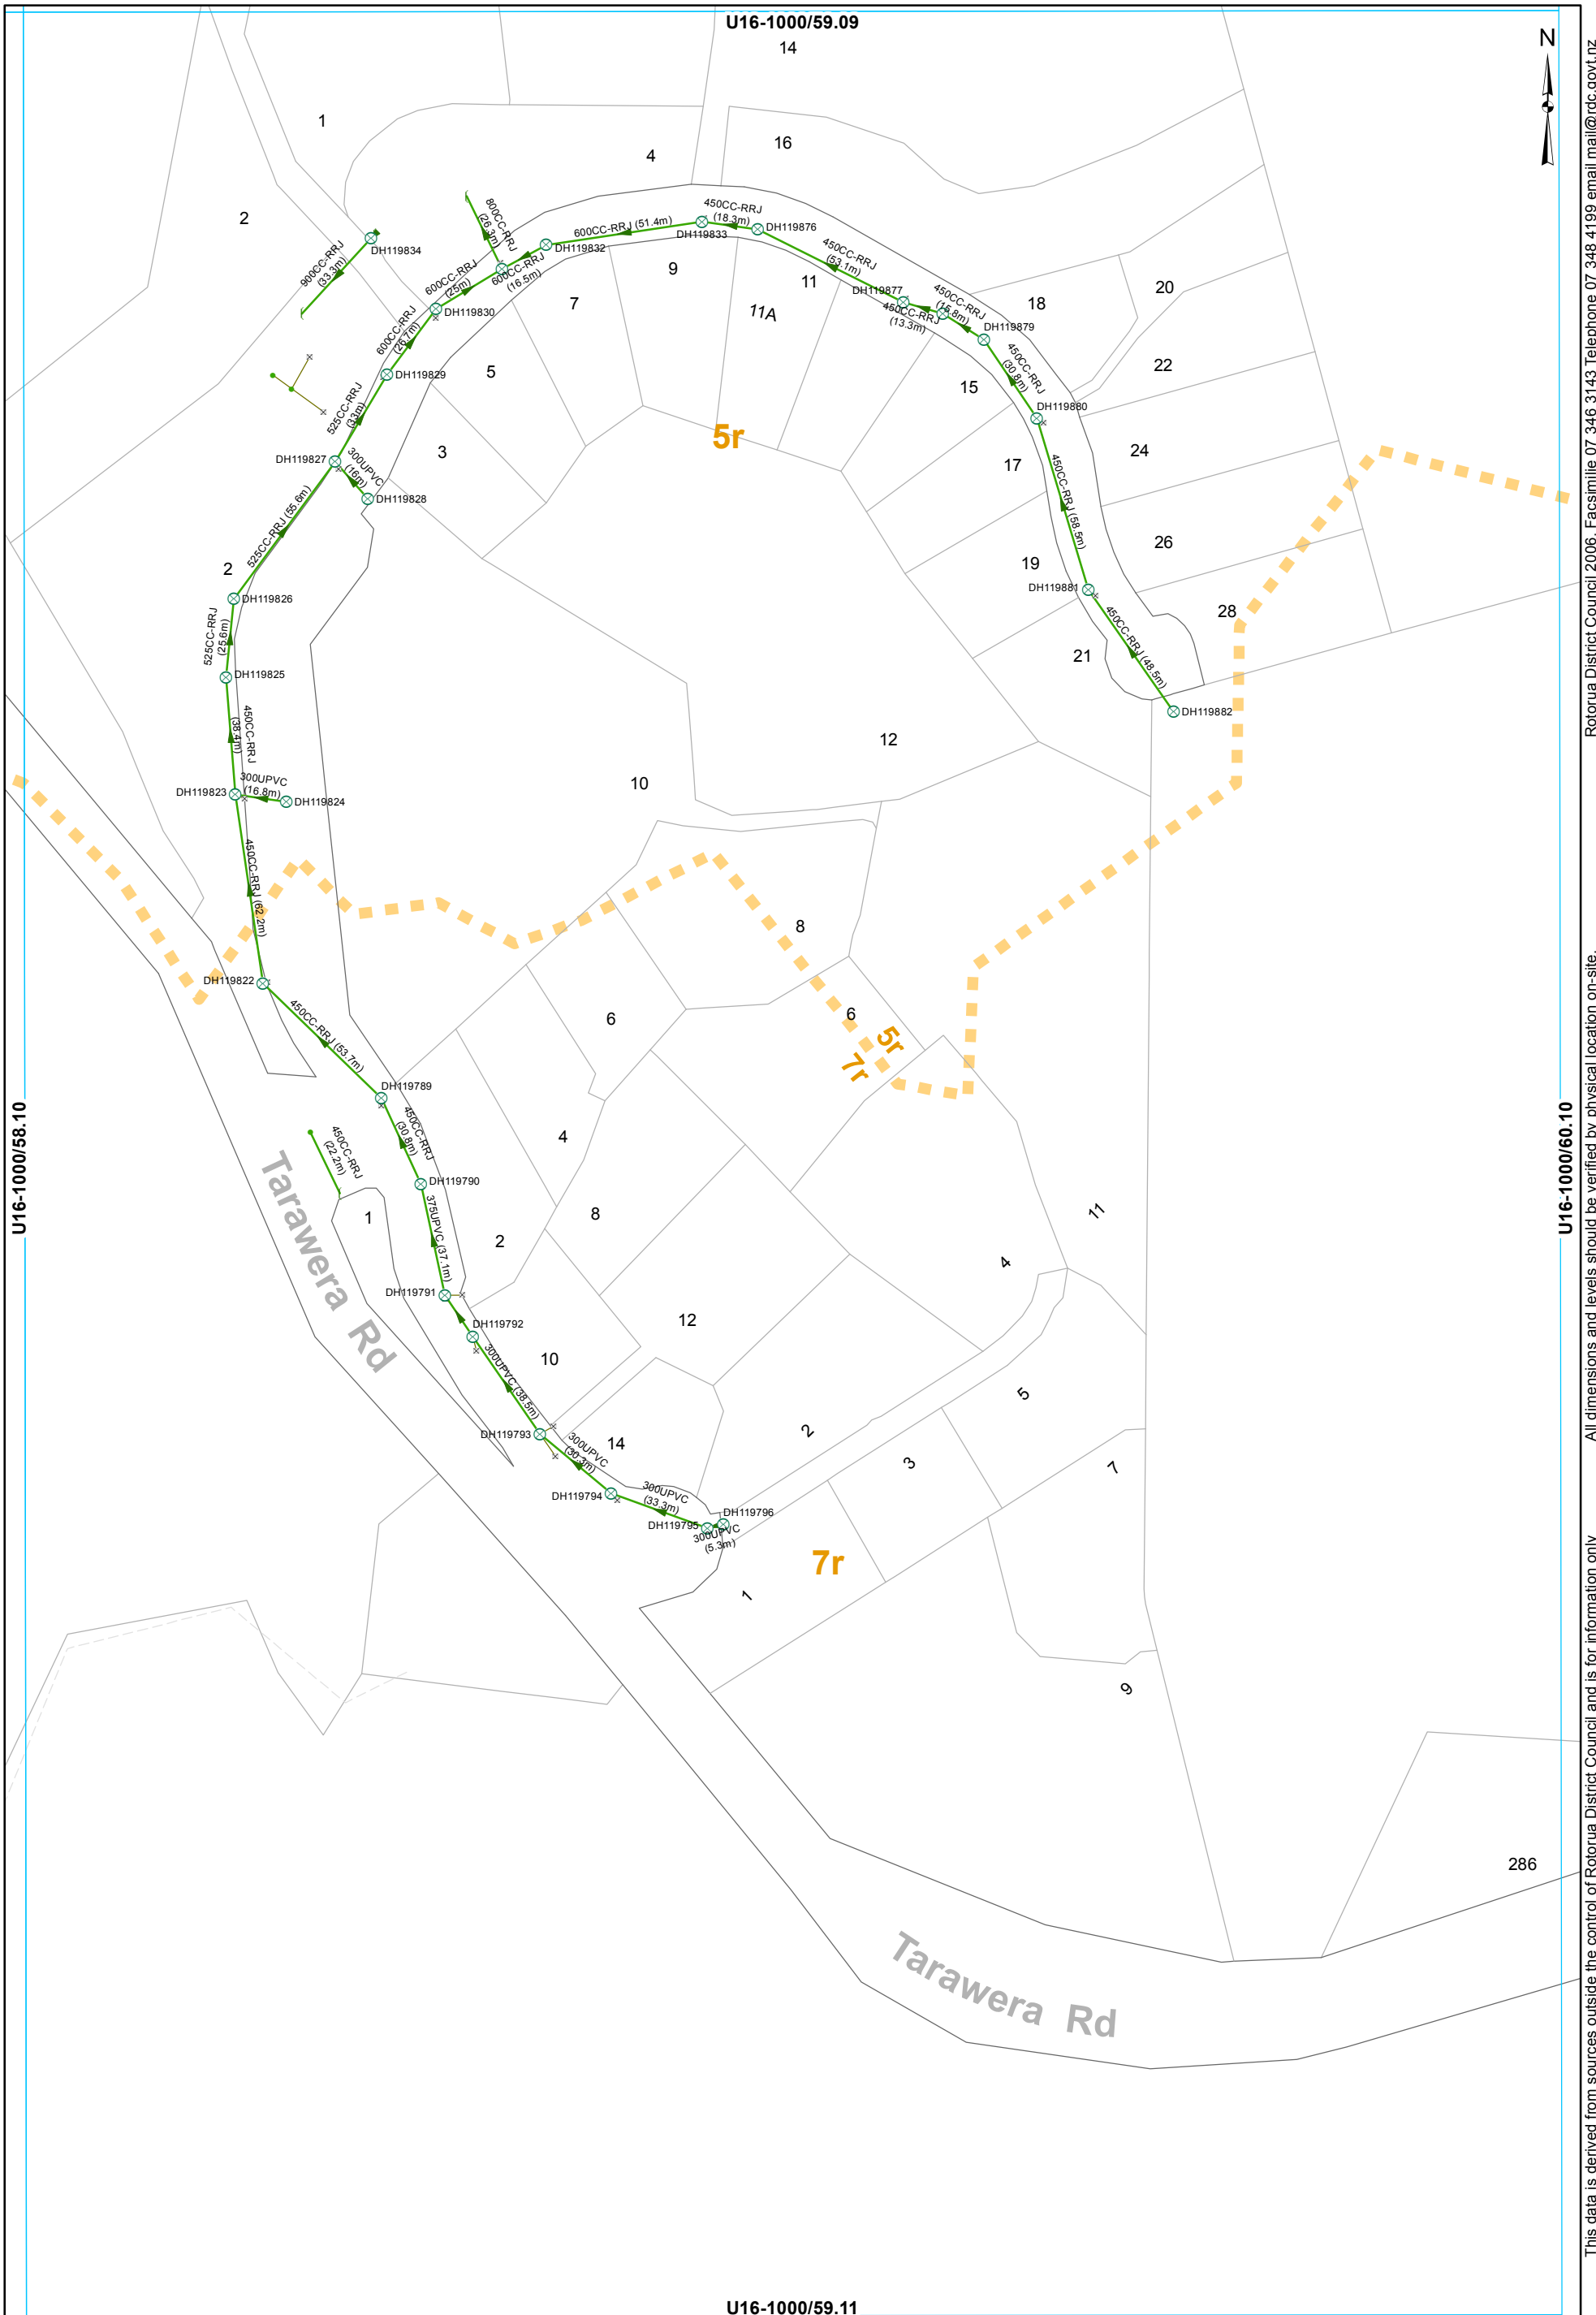


Rotorua District Council 2006. Facsimile 07 346 3143 Telephone 07 348 4199 email mail@rdc.govt.nz

All dimensions and levels should be verified by physical location on-site.

This data is derived from sources outside the control of Rotorua District Council and is for information only

- SWManhole
- SWInlet
- Node
- Headwall Structure
- Culvert
- Gravity Main
- SWLead
- Catchment Boundary

**STORMWATER SERVICES**  
1:2000 @ A3 - (U16-1000/59.10)

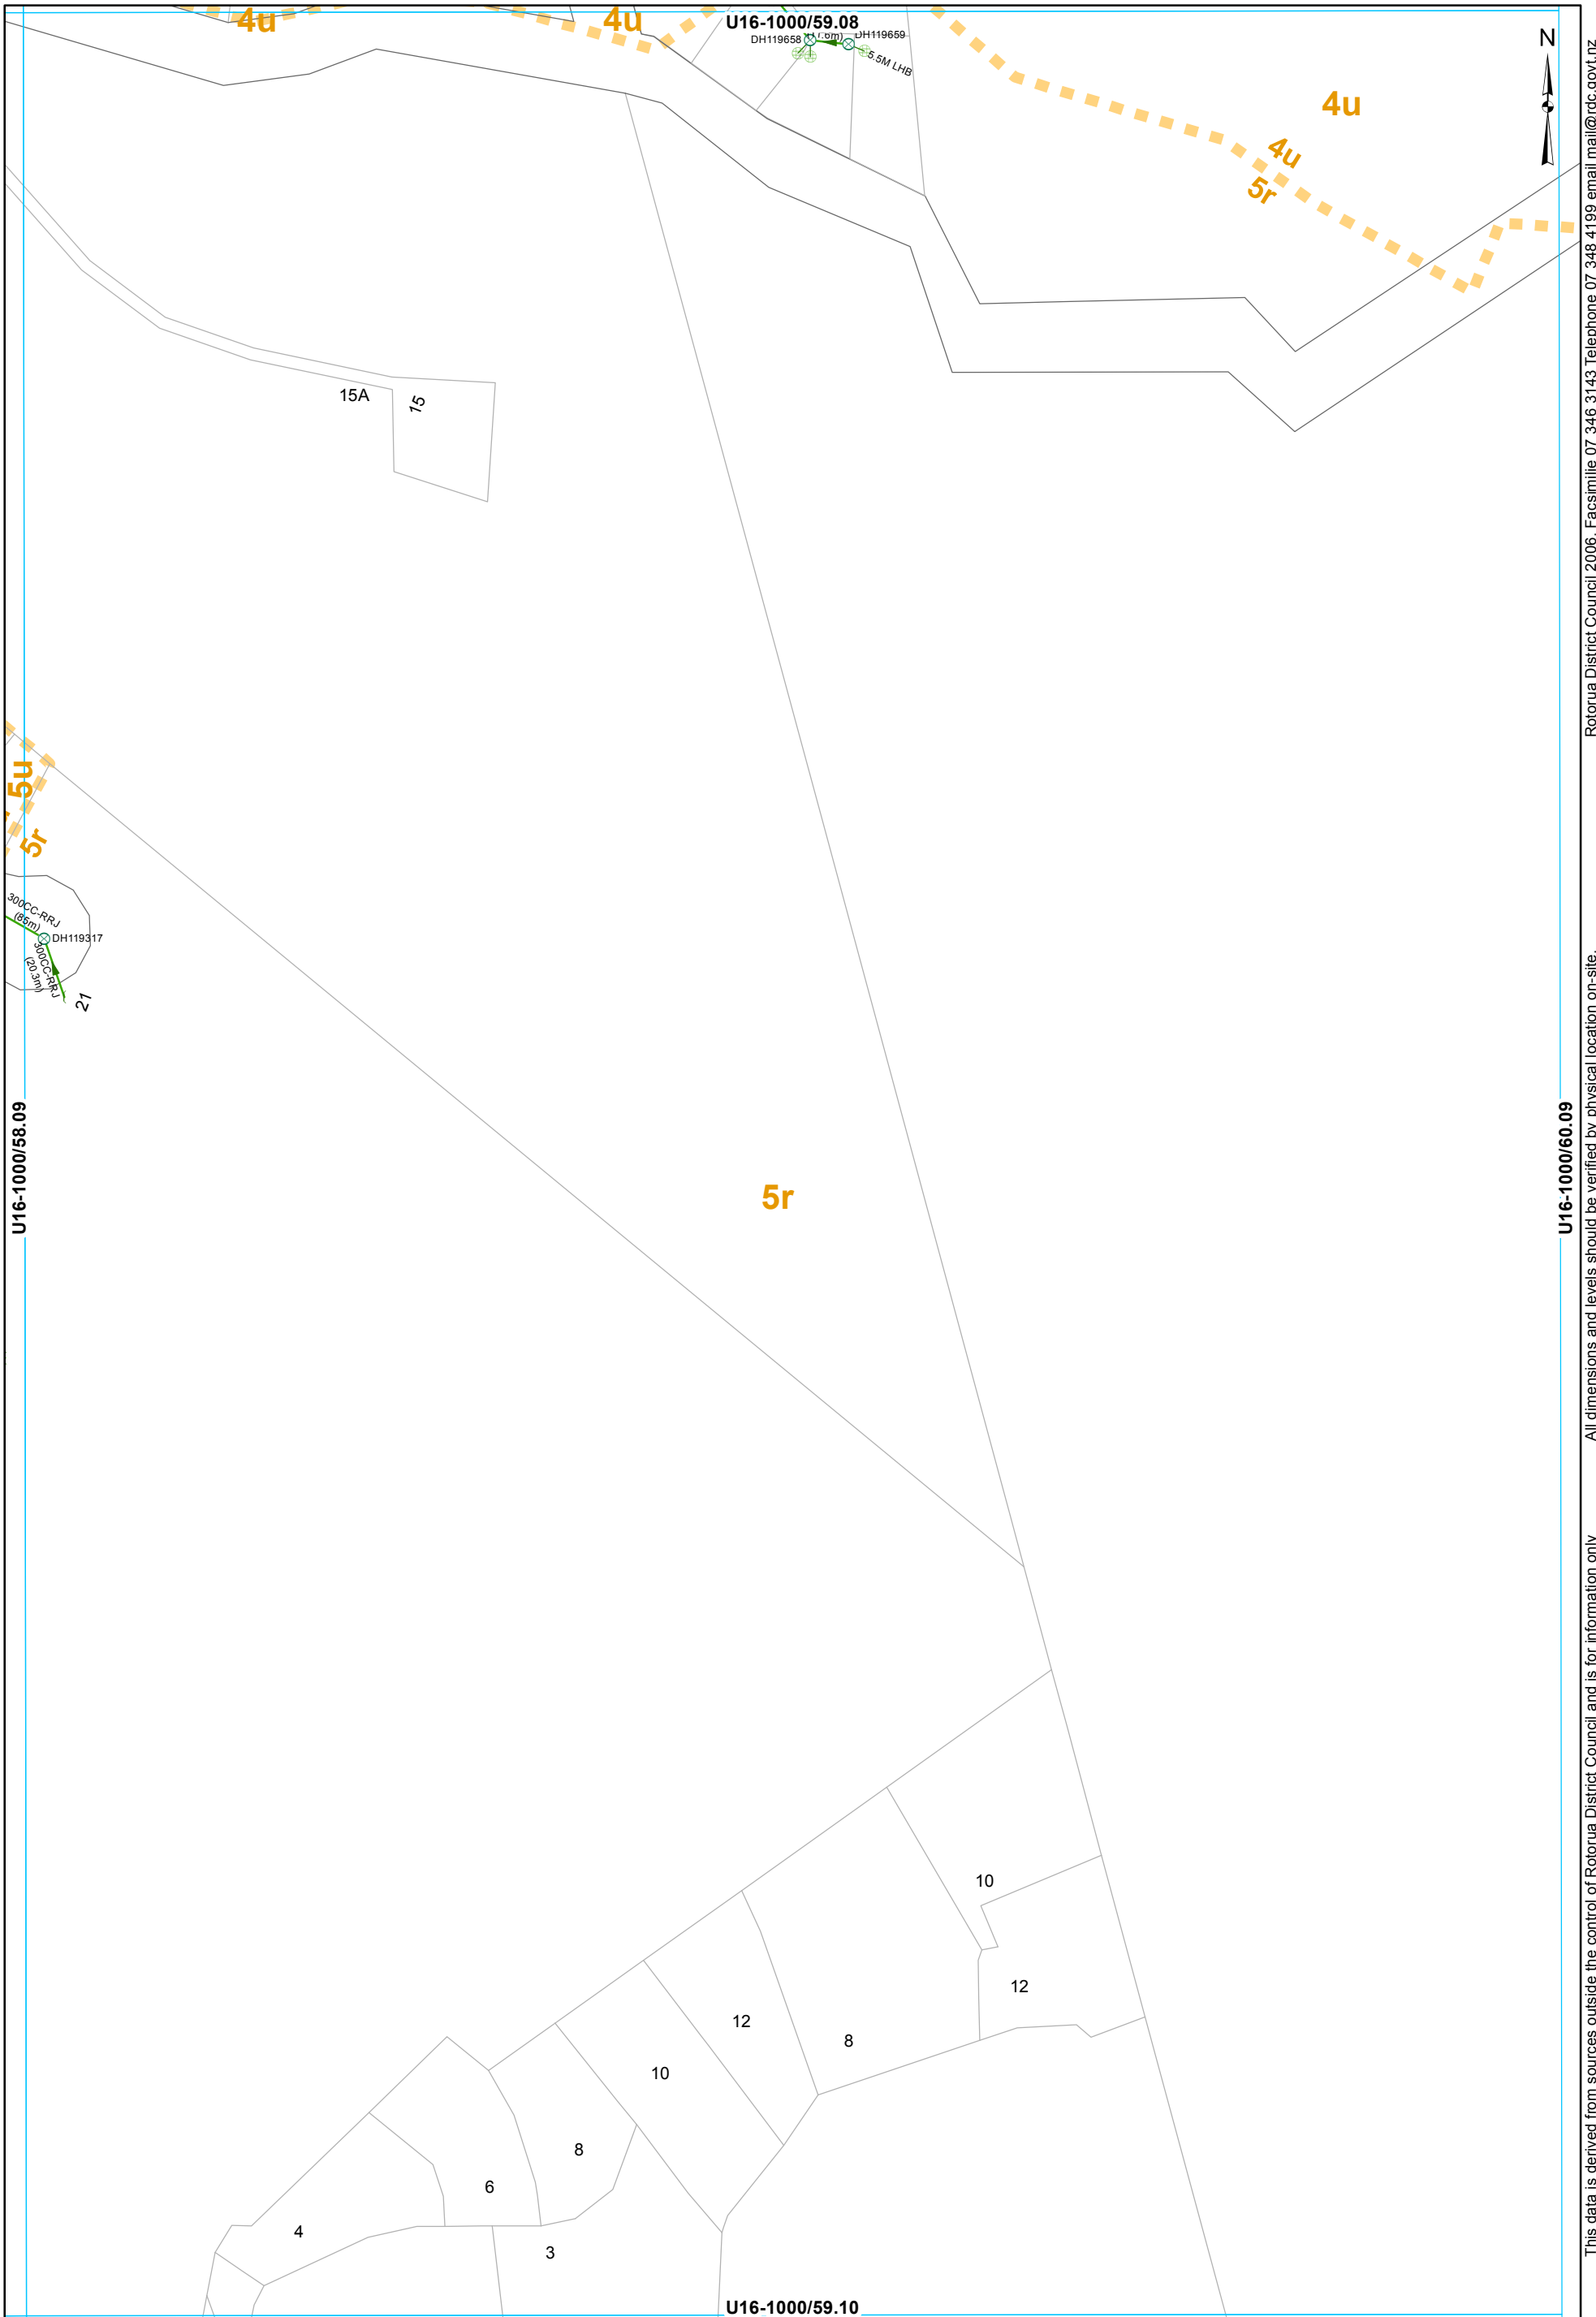

- ⊗ SWManhole
- × SWInlet
- Headwall Structure
- ⊕ Soak Hole
- Gravity Main
- SWServiceline
- SWServiceline
- Catchment Boundary

**STORMWATER SERVICES**  
**1:2000 @ A3 - (U16-1000/59.09)**

This data is derived from sources outside the control of Rotorua District Council and is for information only

Rotorua District Council 2006. Facsimile 07 346 3143 Telephone 07 348 4199 email mail@rdc.govt.nz