


Storm Water Asbuilt Sheet Index  
SWCatchment 7r

Compiled on 2023-05-02 from as-builts of various dates. For up to date as-builts please visit [http://geo.rdc.govt.nz/images/plotfiles/3waters\\_mobile\\_asbuilts/](http://geo.rdc.govt.nz/images/plotfiles/3waters_mobile_asbuilts/)

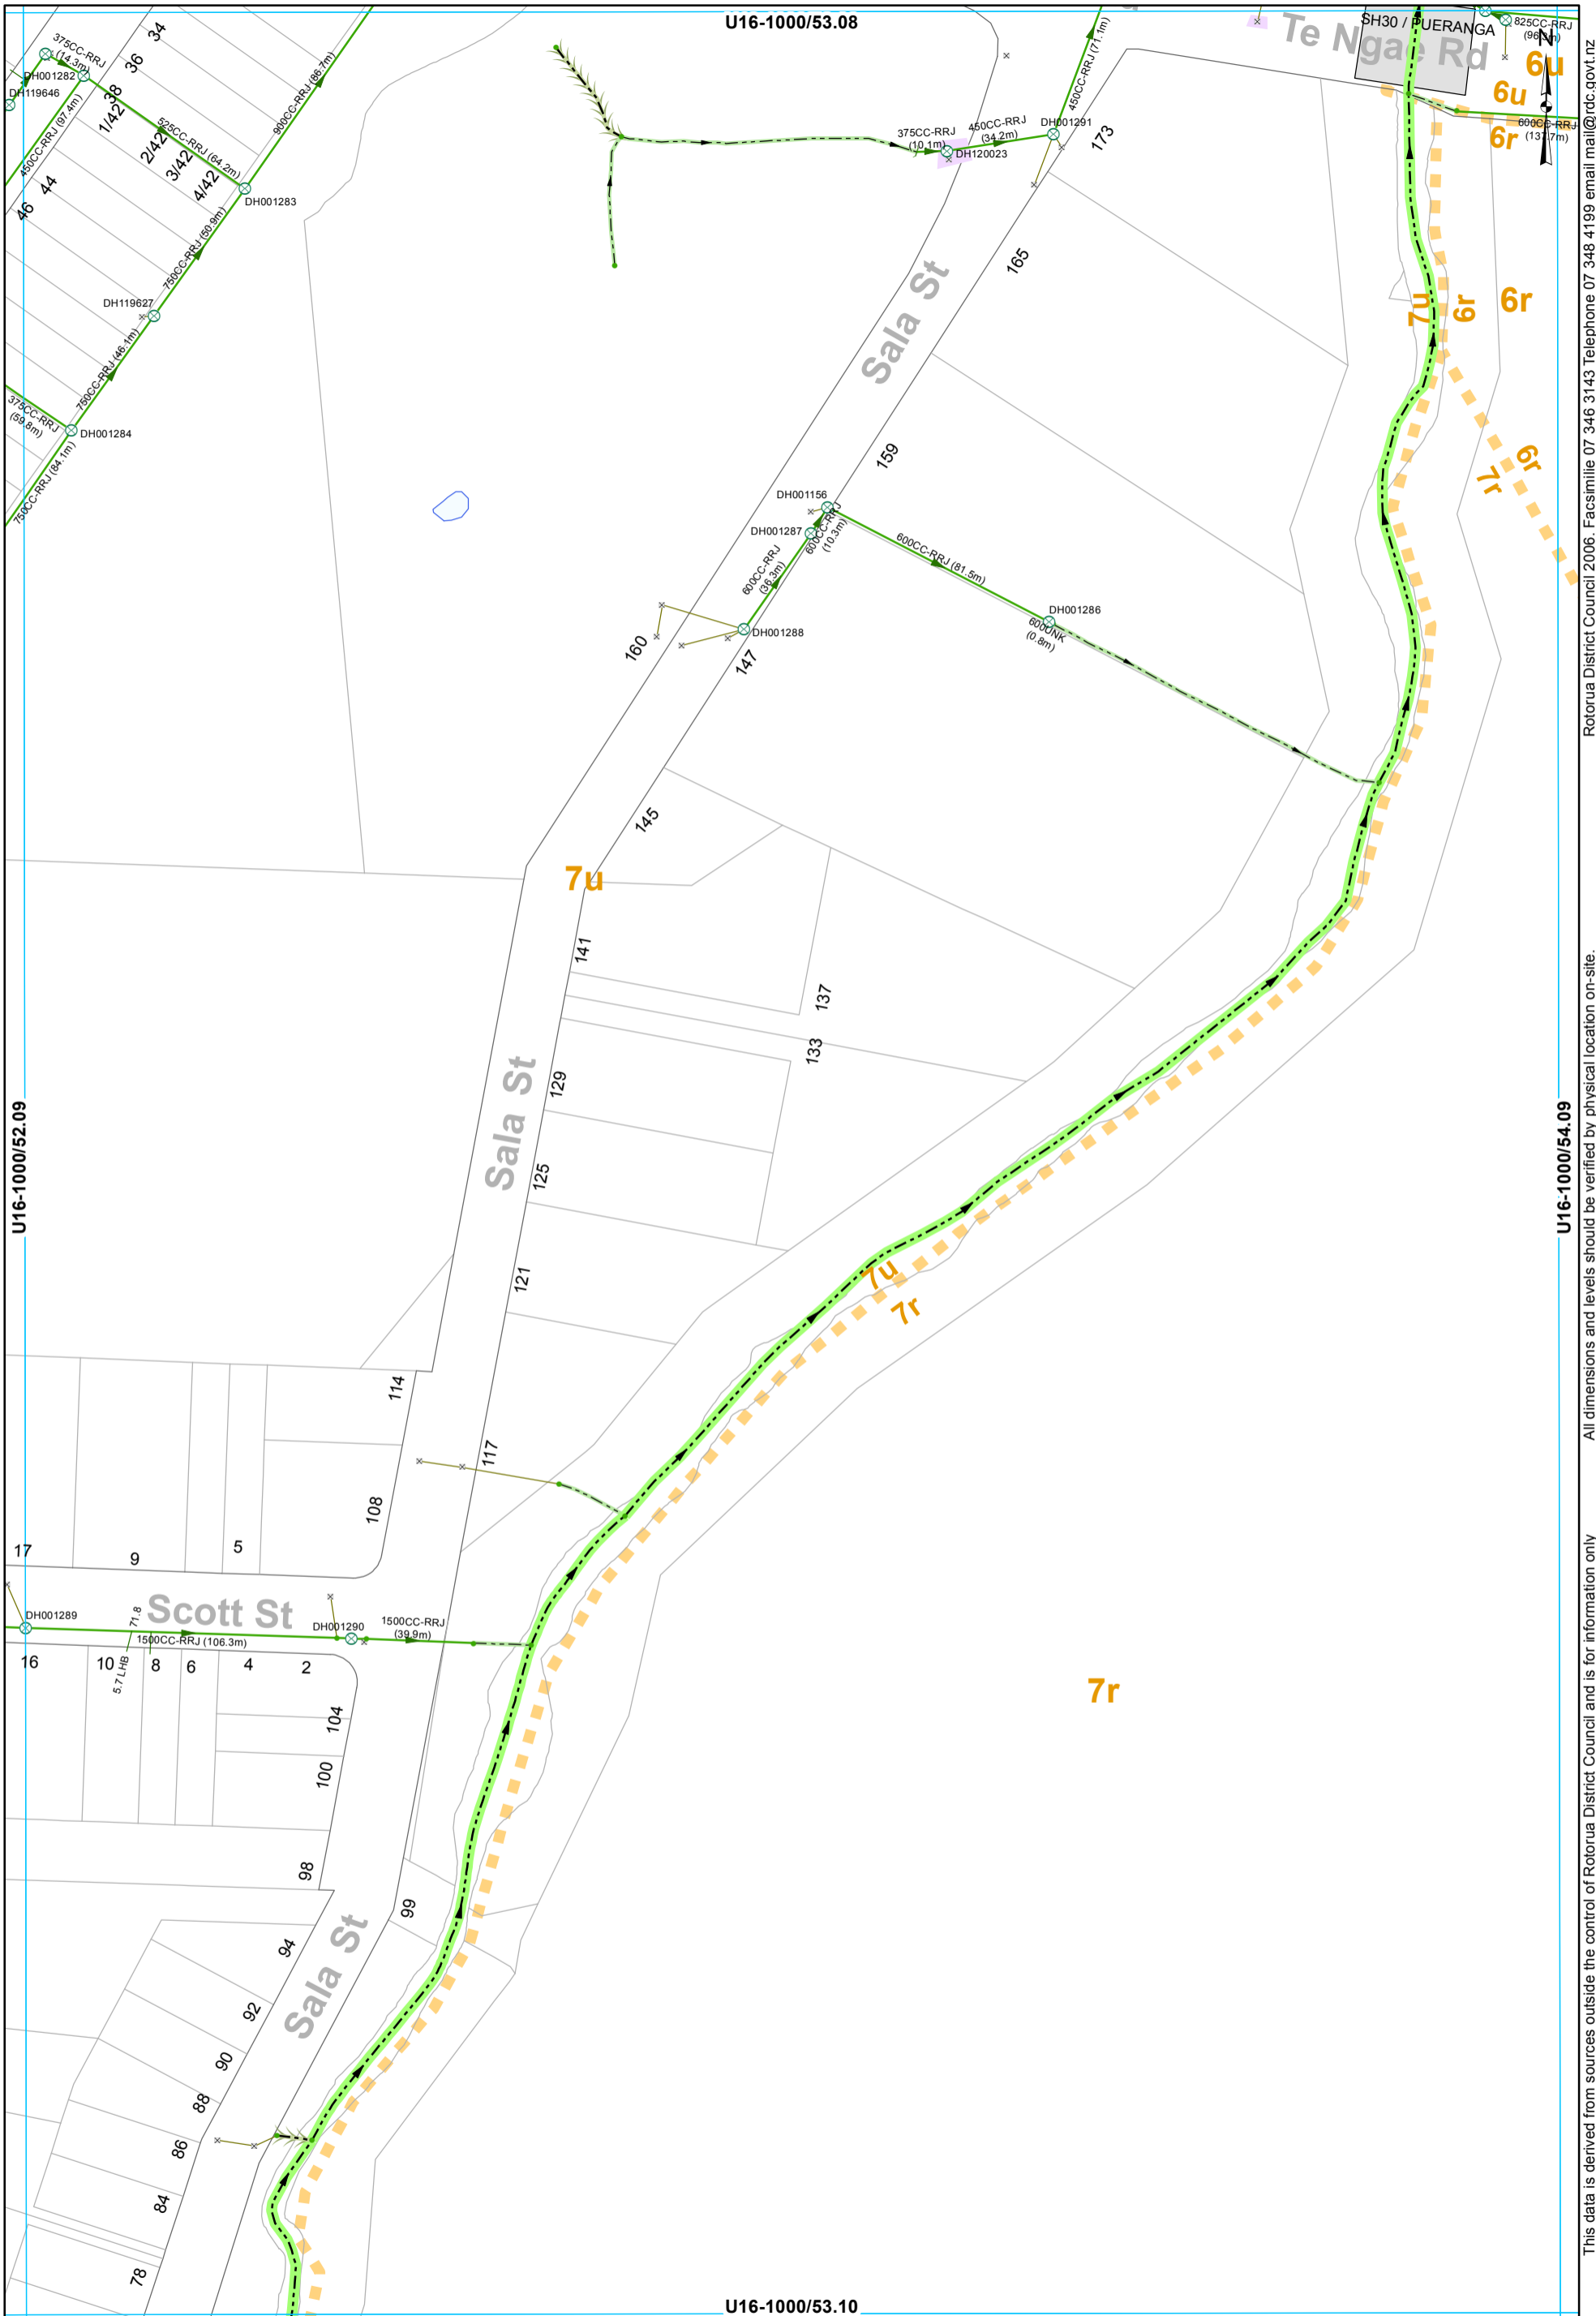


- ⊗ SWManhole
- × SWInlet
- Node
- Headwall Structure
- Open Drain
- Overland Flow
- Stream
- Gravity Main
- SWServiceline
- SWServiceline
- SWLead
- Catchment Boundary

**STORMWATER SERVICES**  
**1:2000 @ A3 - (U16-1000/53.09)**

This data is derived from sources outside the control of Rotorua District Council and is for information only

Rotorua District Council 2006. Facsimile 07 346 3143 Telephone 07 348 4199 email mail@rdc.govt.nz

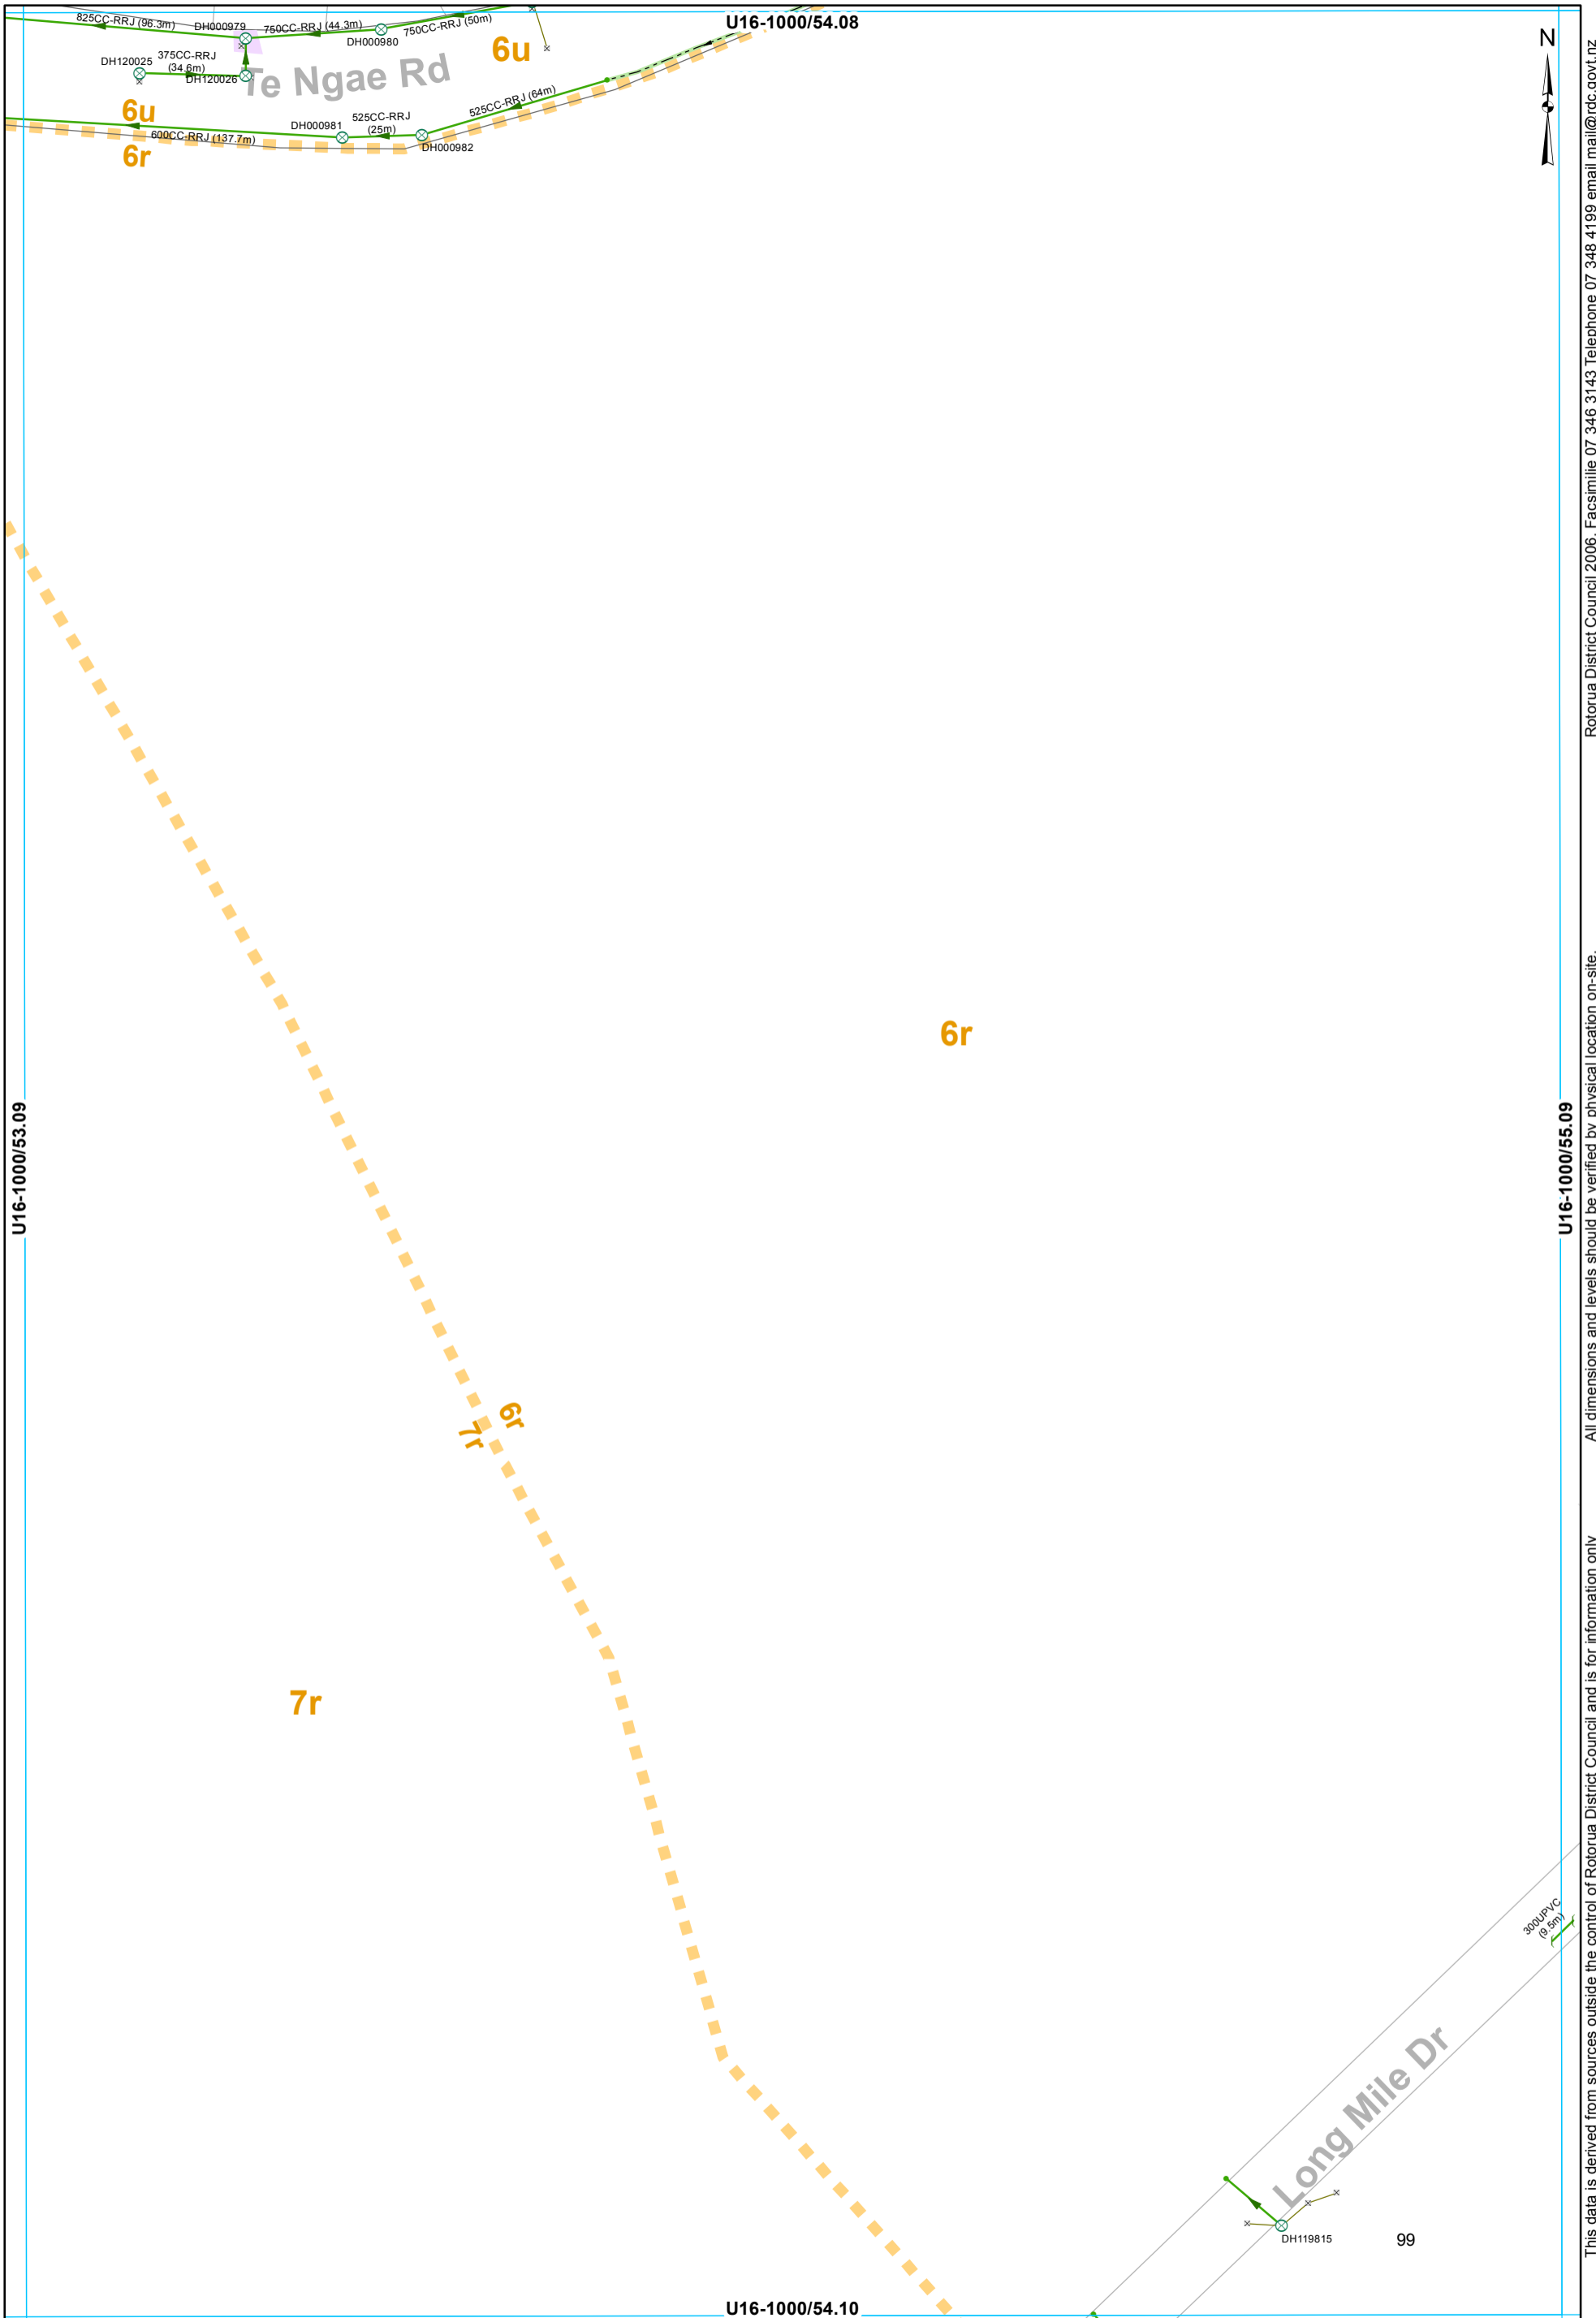

- ⊗ SWManhole
- × SWInlet
- Node
- Headwall Structure
- Open Drain
- Culvert
- Gravity Main
- SWLead
- Catchment Boundary


**STORMWATER SERVICES**  
**1:2000 @ A3 - (U16-1000/54.09)**

This data is derived from sources outside the control of Rotorua District Council and is for information only

All dimensions and levels should be verified by physical location on-site.

Rotorua District Council 2006. Facsimile 07 346 3143 Telephone 07 348 4199 email mail@rdc.govt.nz



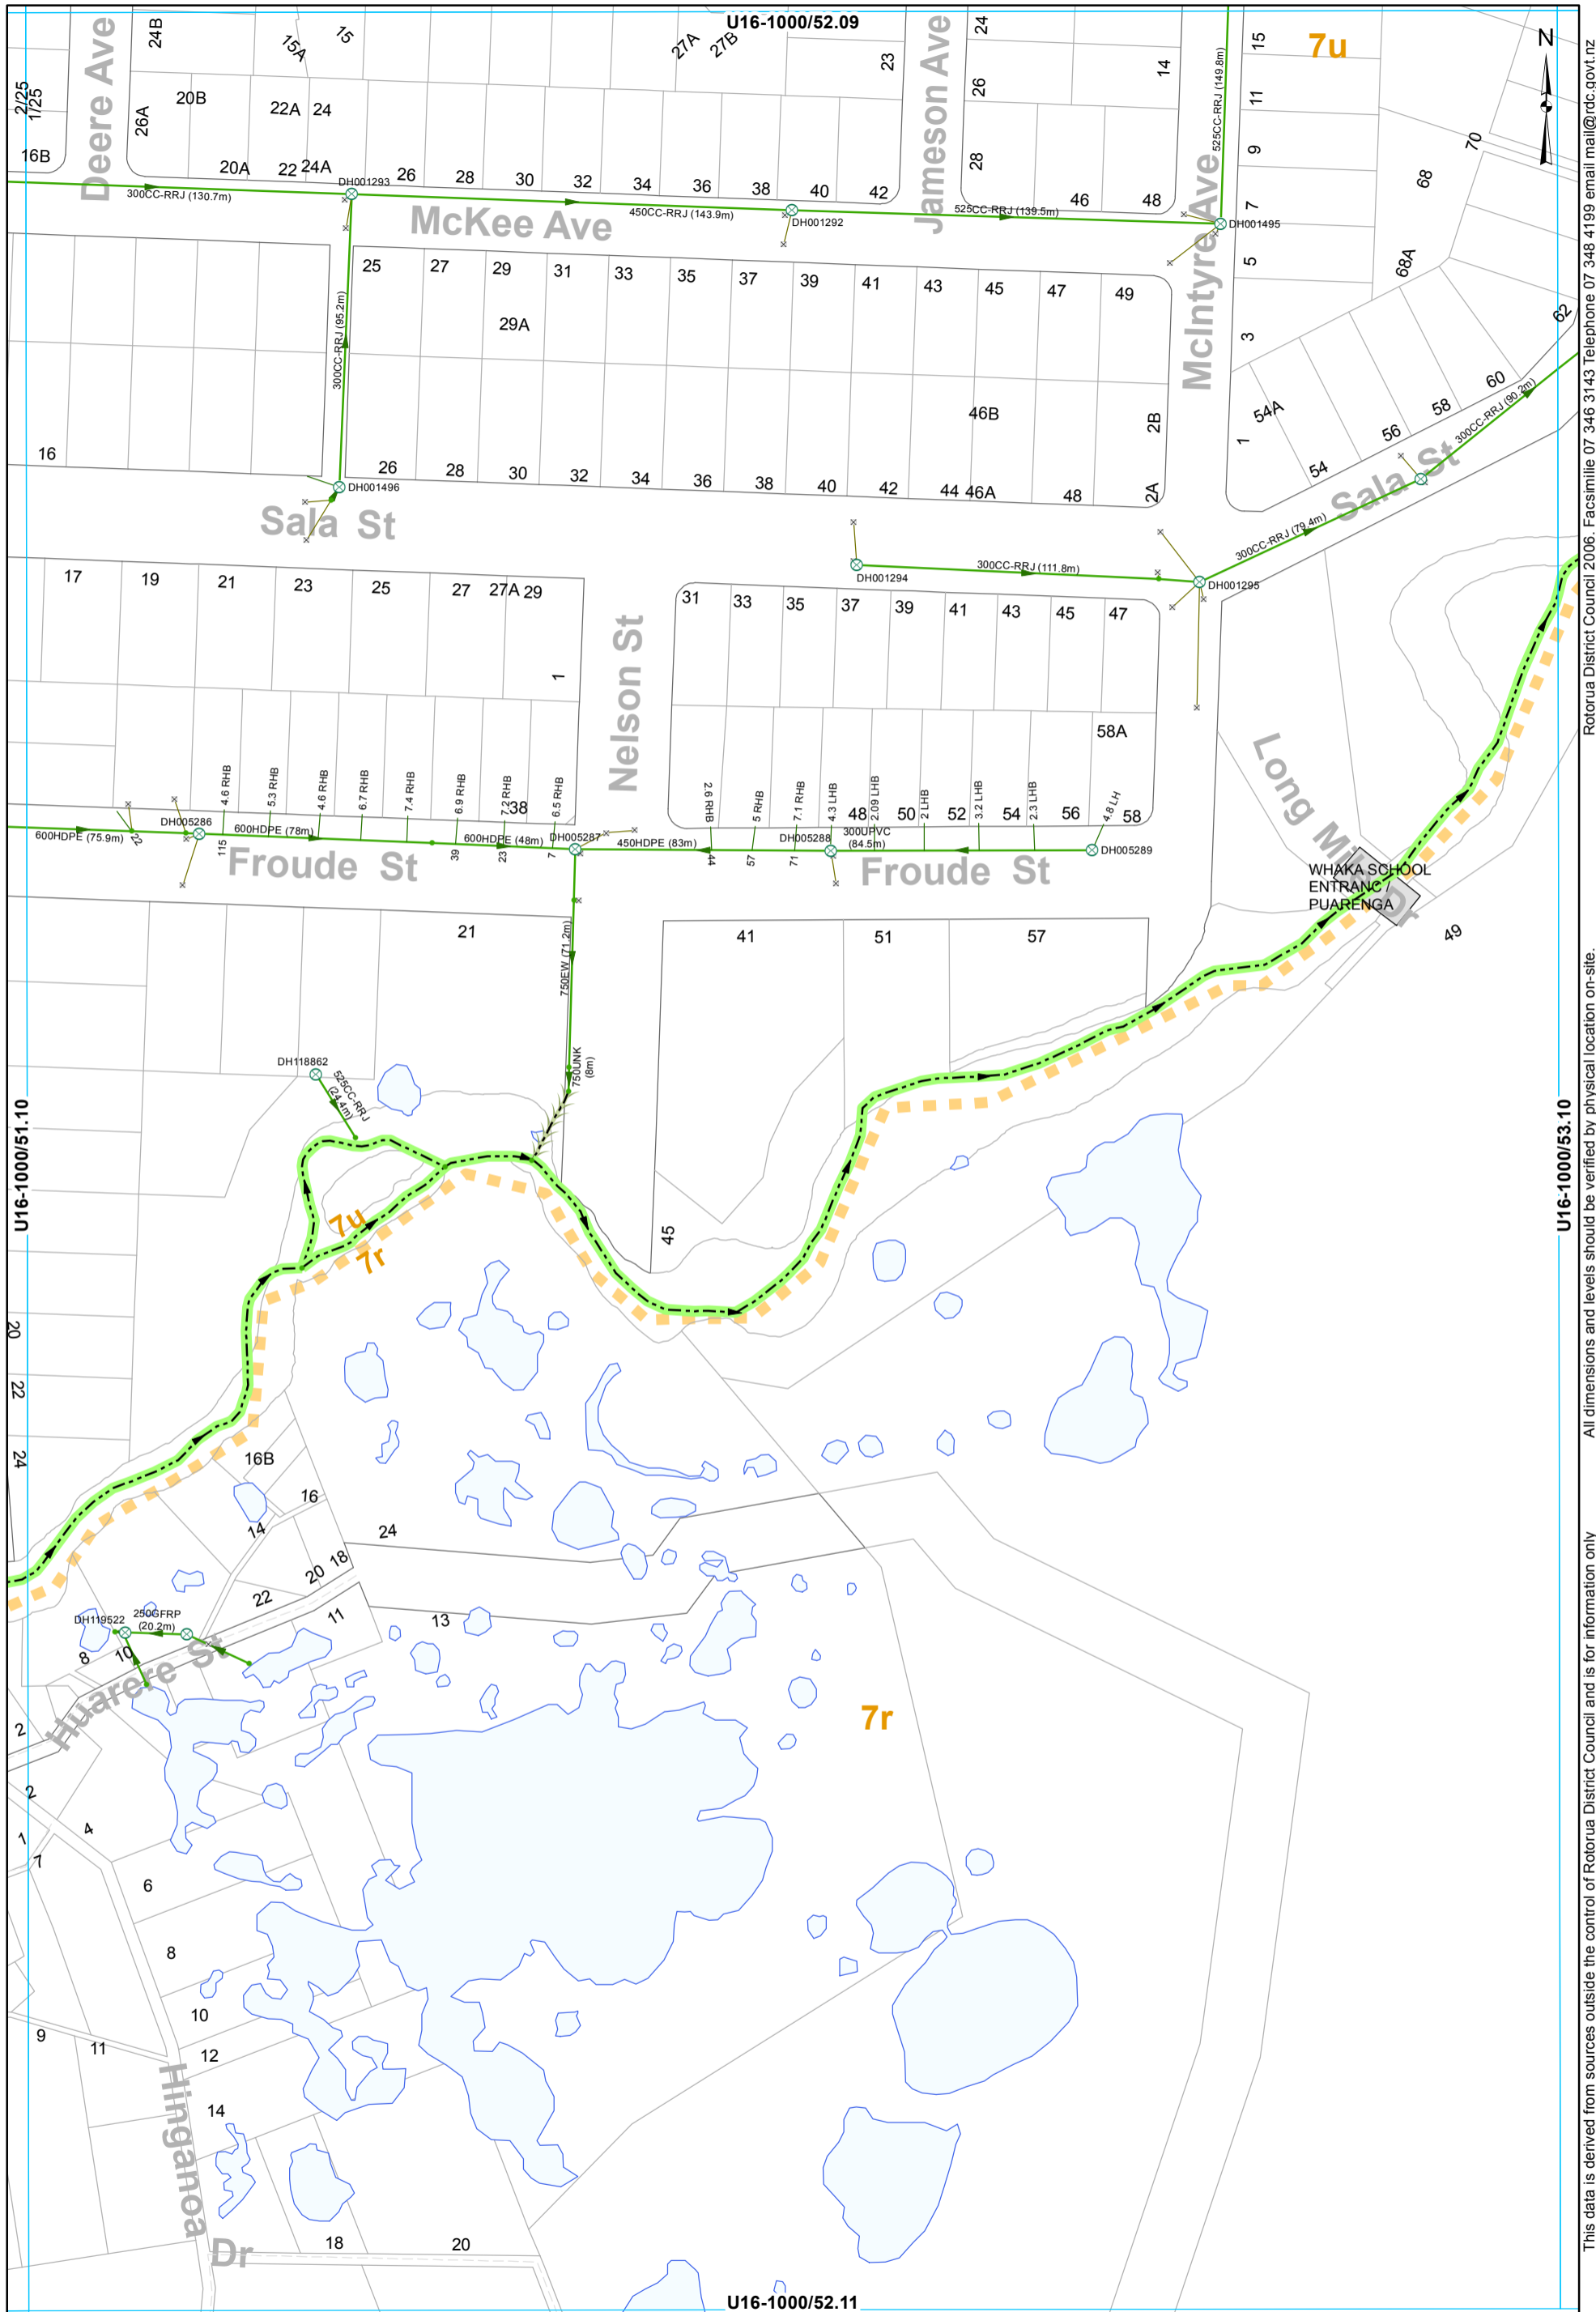

- ⊗ SWManhole
- × SWInlet
- Node
- Overland Flow
- Gravity Main
- SWServiceline
- SWServiceline
- SWLead
- Catchment Boundary

**STORMWATER SERVICES**  
**1:2000 @ A3 - (U16-1000/52.10)**


This data is derived from sources outside the control of Rotorua District Council and is for information only

Rotorua District Council 2006. Facsimile 07 346 3143 Telephone 07 348 4199 email mail@rdc.govt.nz

U16-1000/51.10

U16-1000/53.10


U16-1000/52.11

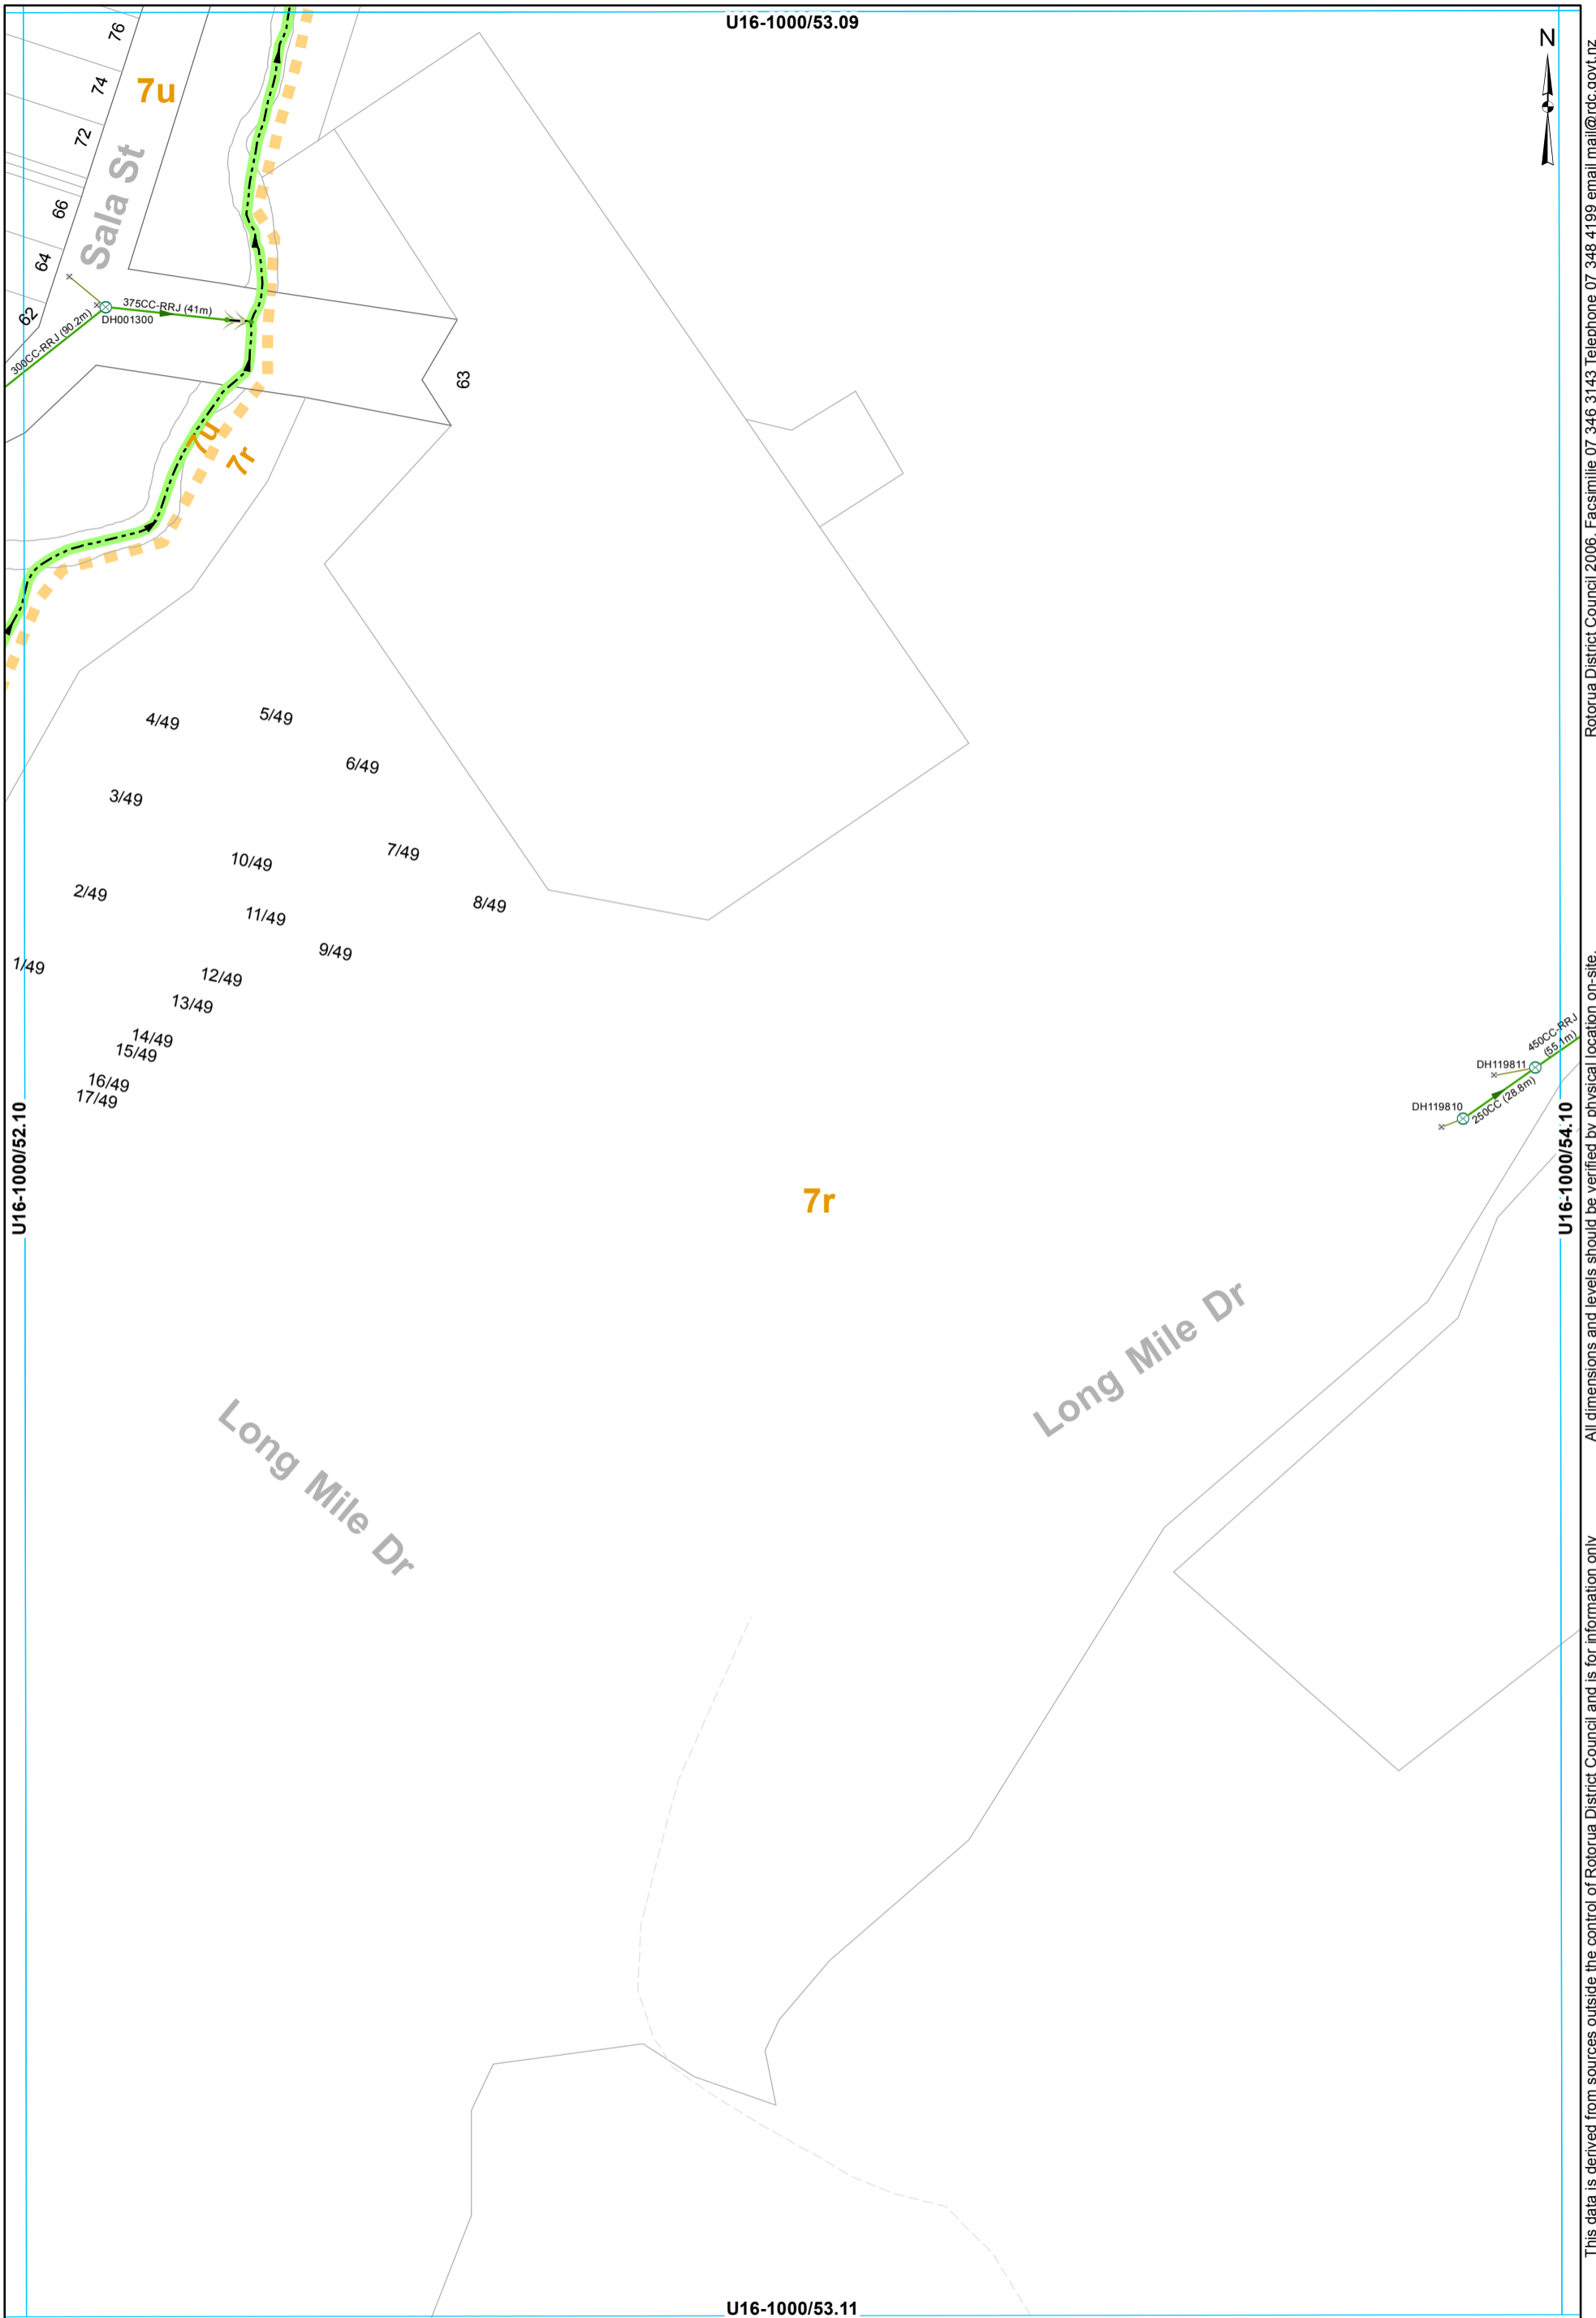

- ⊗ SWManhole
- × SWInlet
- Node
- Overland Flow
- Stream
- Gravity Main
- SWLead
- Catchment Boundary

**STORMWATER SERVICES**  
**1:2000 @ A3 - (U16-1000/53.10)**

Rotorua District Council 2006. Facsimile 07 346 3143 Telephone 07 348 4199 email mail@rdc.govt.nz  
 This data is derived from sources outside the control of Rotorua District Council and is for information only. All dimensions and levels should be verified by physical location on-site.

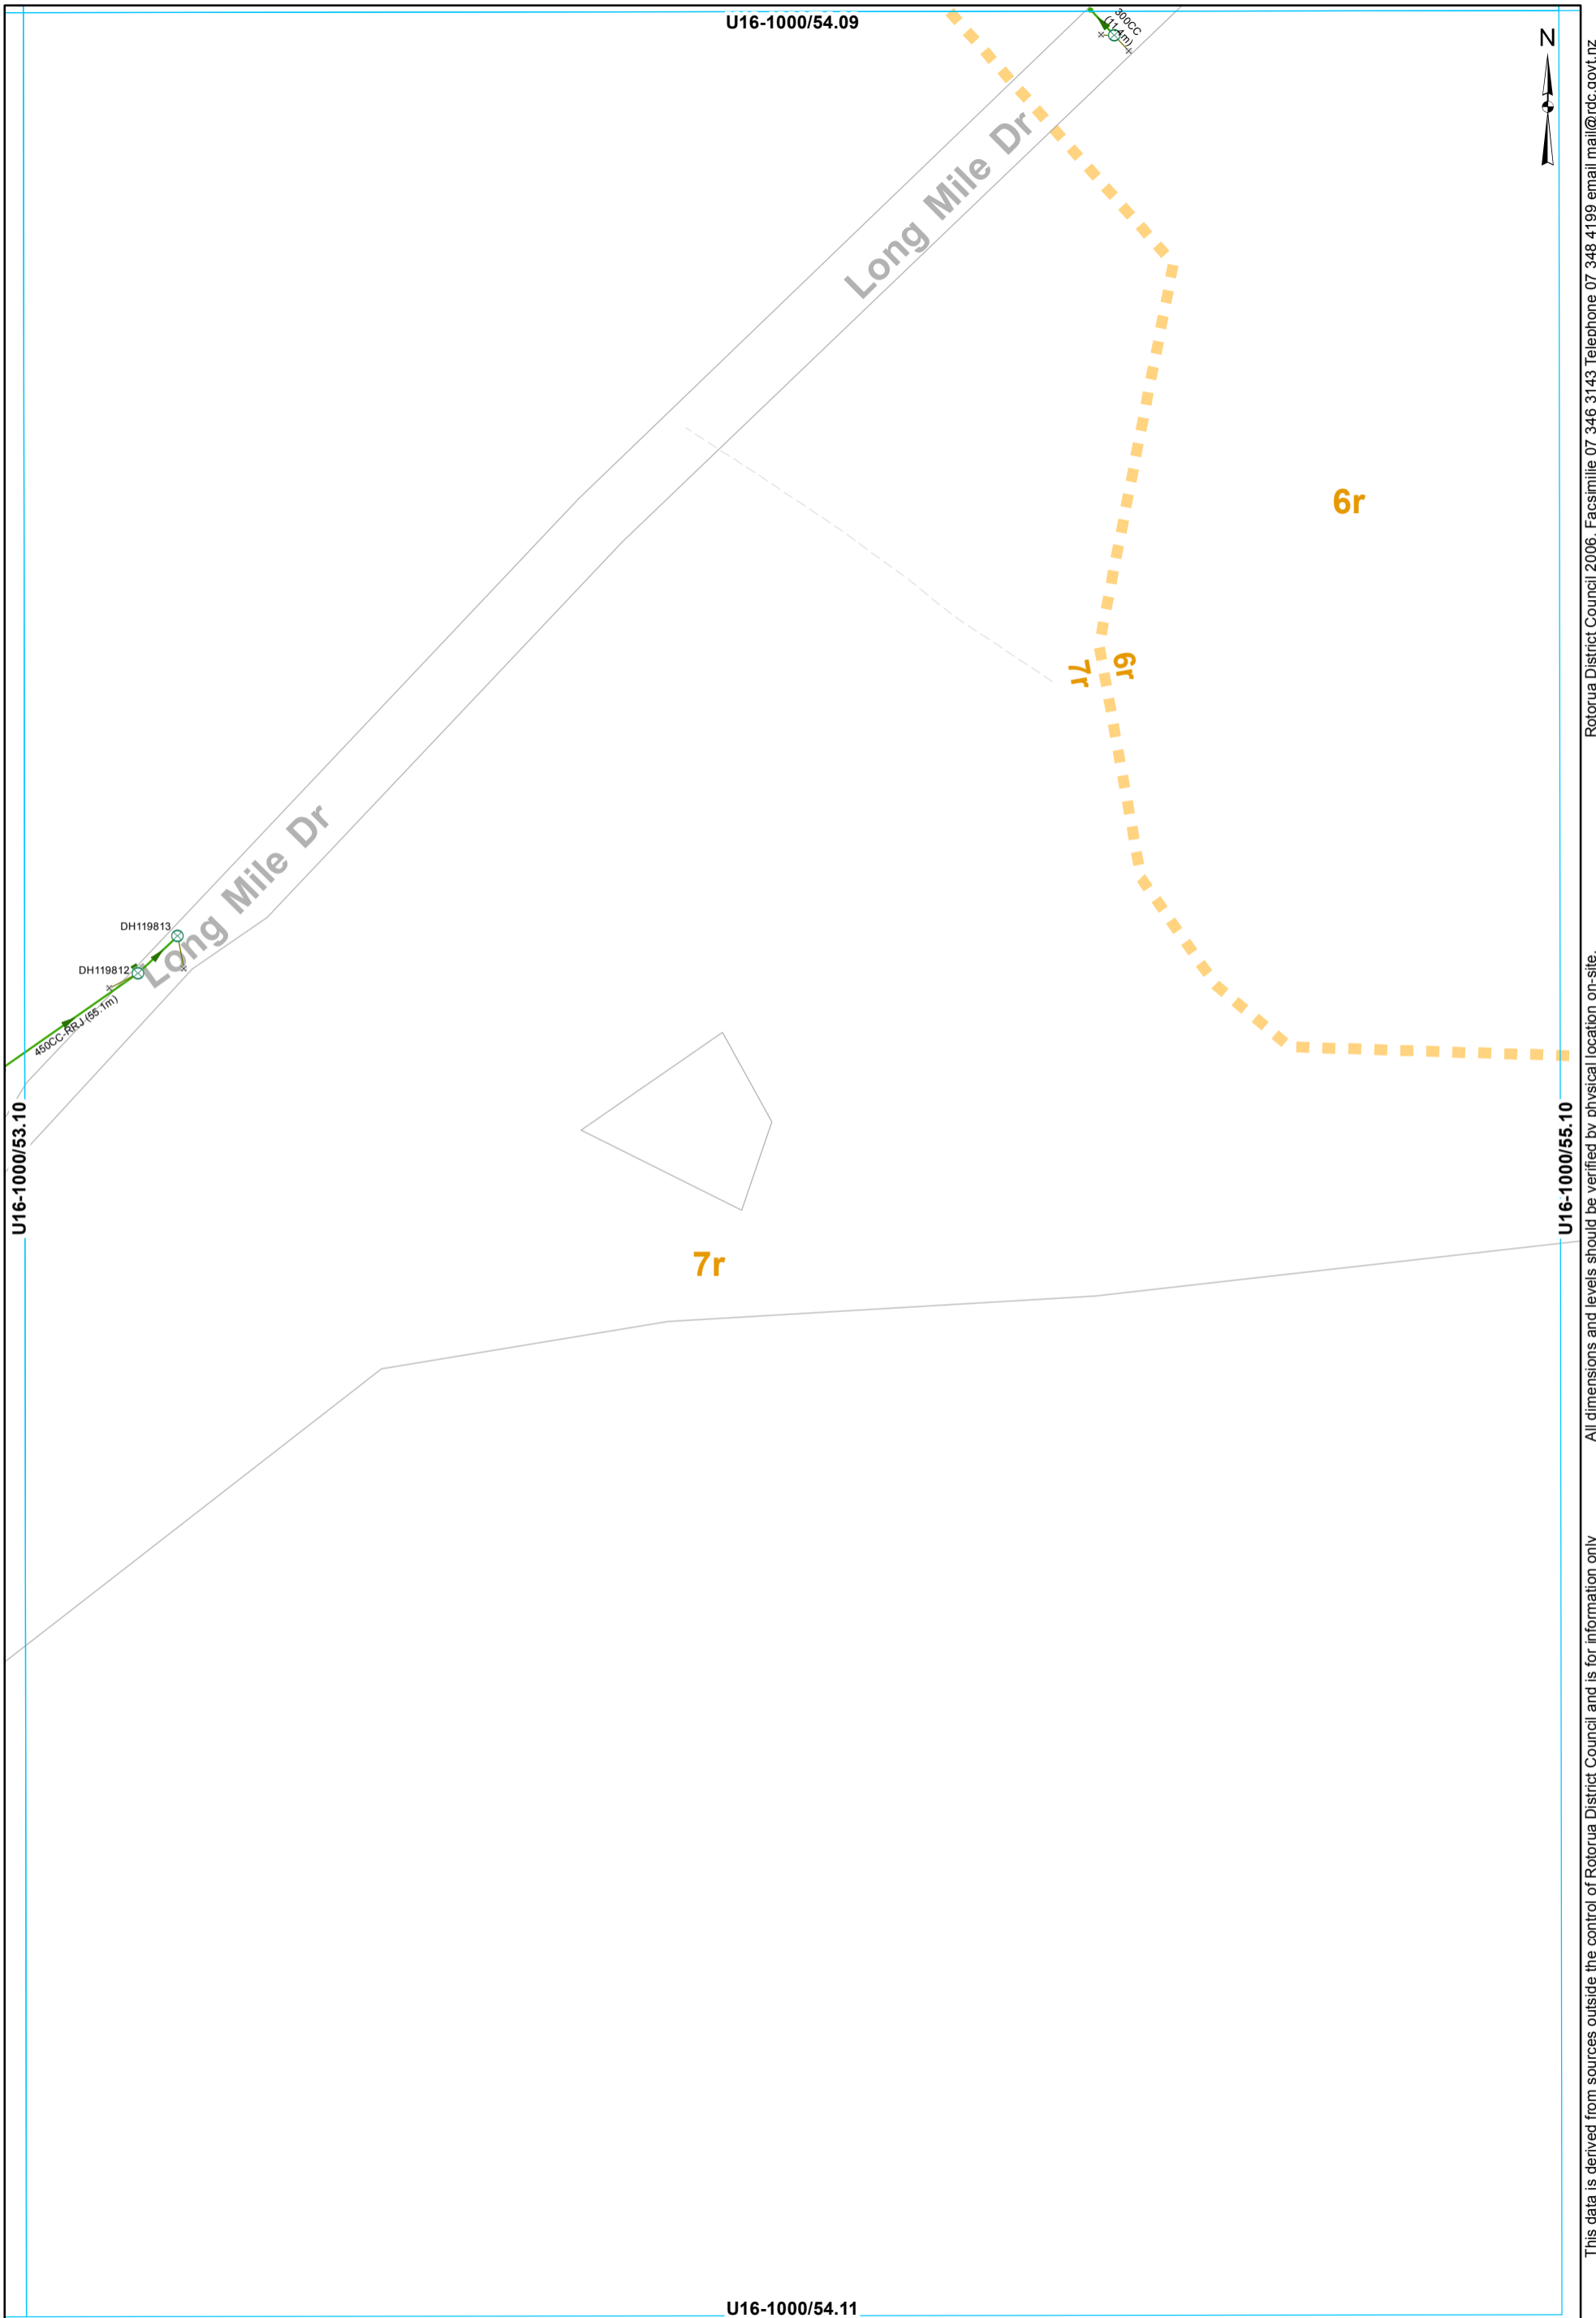


- ⊗ SWManhole    — Gravity Main
- × SWInlet      — SWLead
- Node          ■ Catchment Boundary

**STORMWATER SERVICES**  
**1:2000 @ A3 - (U16-1000/54.10)**

This data is derived from sources outside the control of Rotorua District Council and is for information only

Rotorua District Council 2006. Facsimile 07 346 3143 Telephone 07 348 4199 email mail@rdc.govt.nz

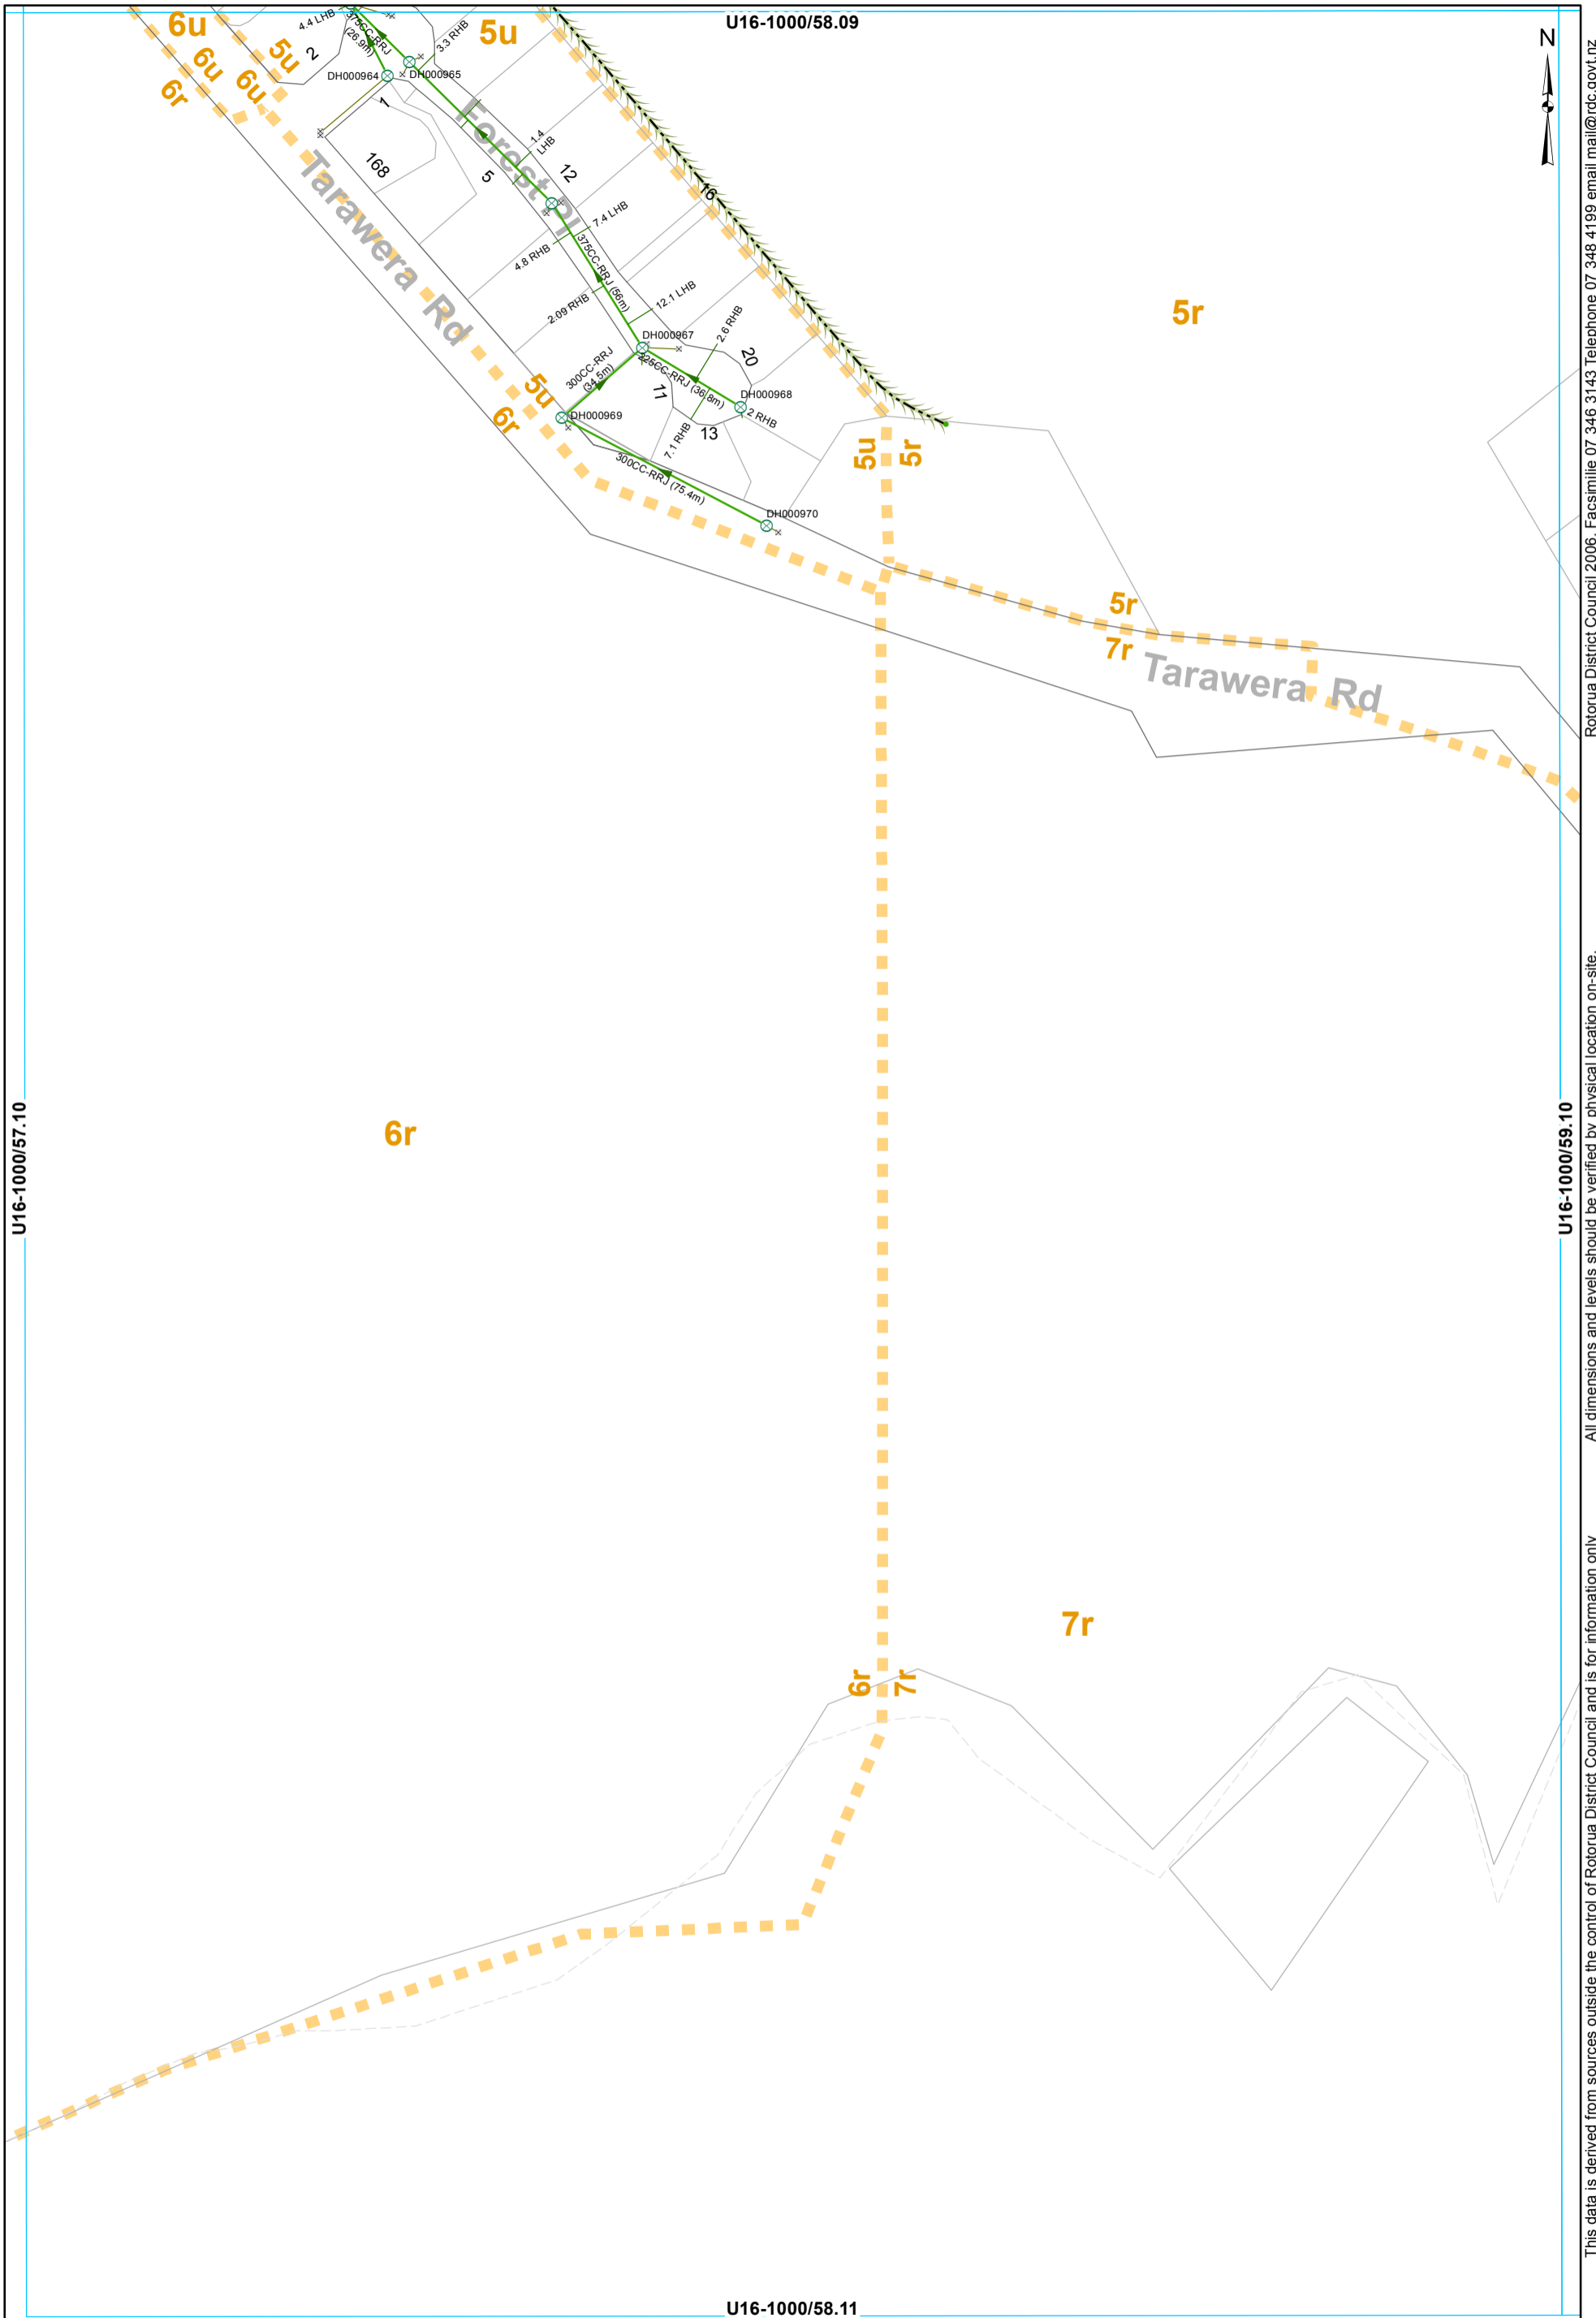

Rotorua District Council 2006. Facsimile 07 346 3143 Telephone 07 348 4199 email mail@rdc.govt.nz


All dimensions and levels should be verified by physical location on-site.

This data is derived from sources outside the control of Rotorua District Council and is for information only

- ⊗ SWManhole
- × SWInlet
- Node
- Overland Flow
- Gravity Main
- SWServiceline
- SWLead
- Catchment Boundary

**STORMWATER SERVICES**  
1:2000 @ A3 - (U16-1000/58.10)



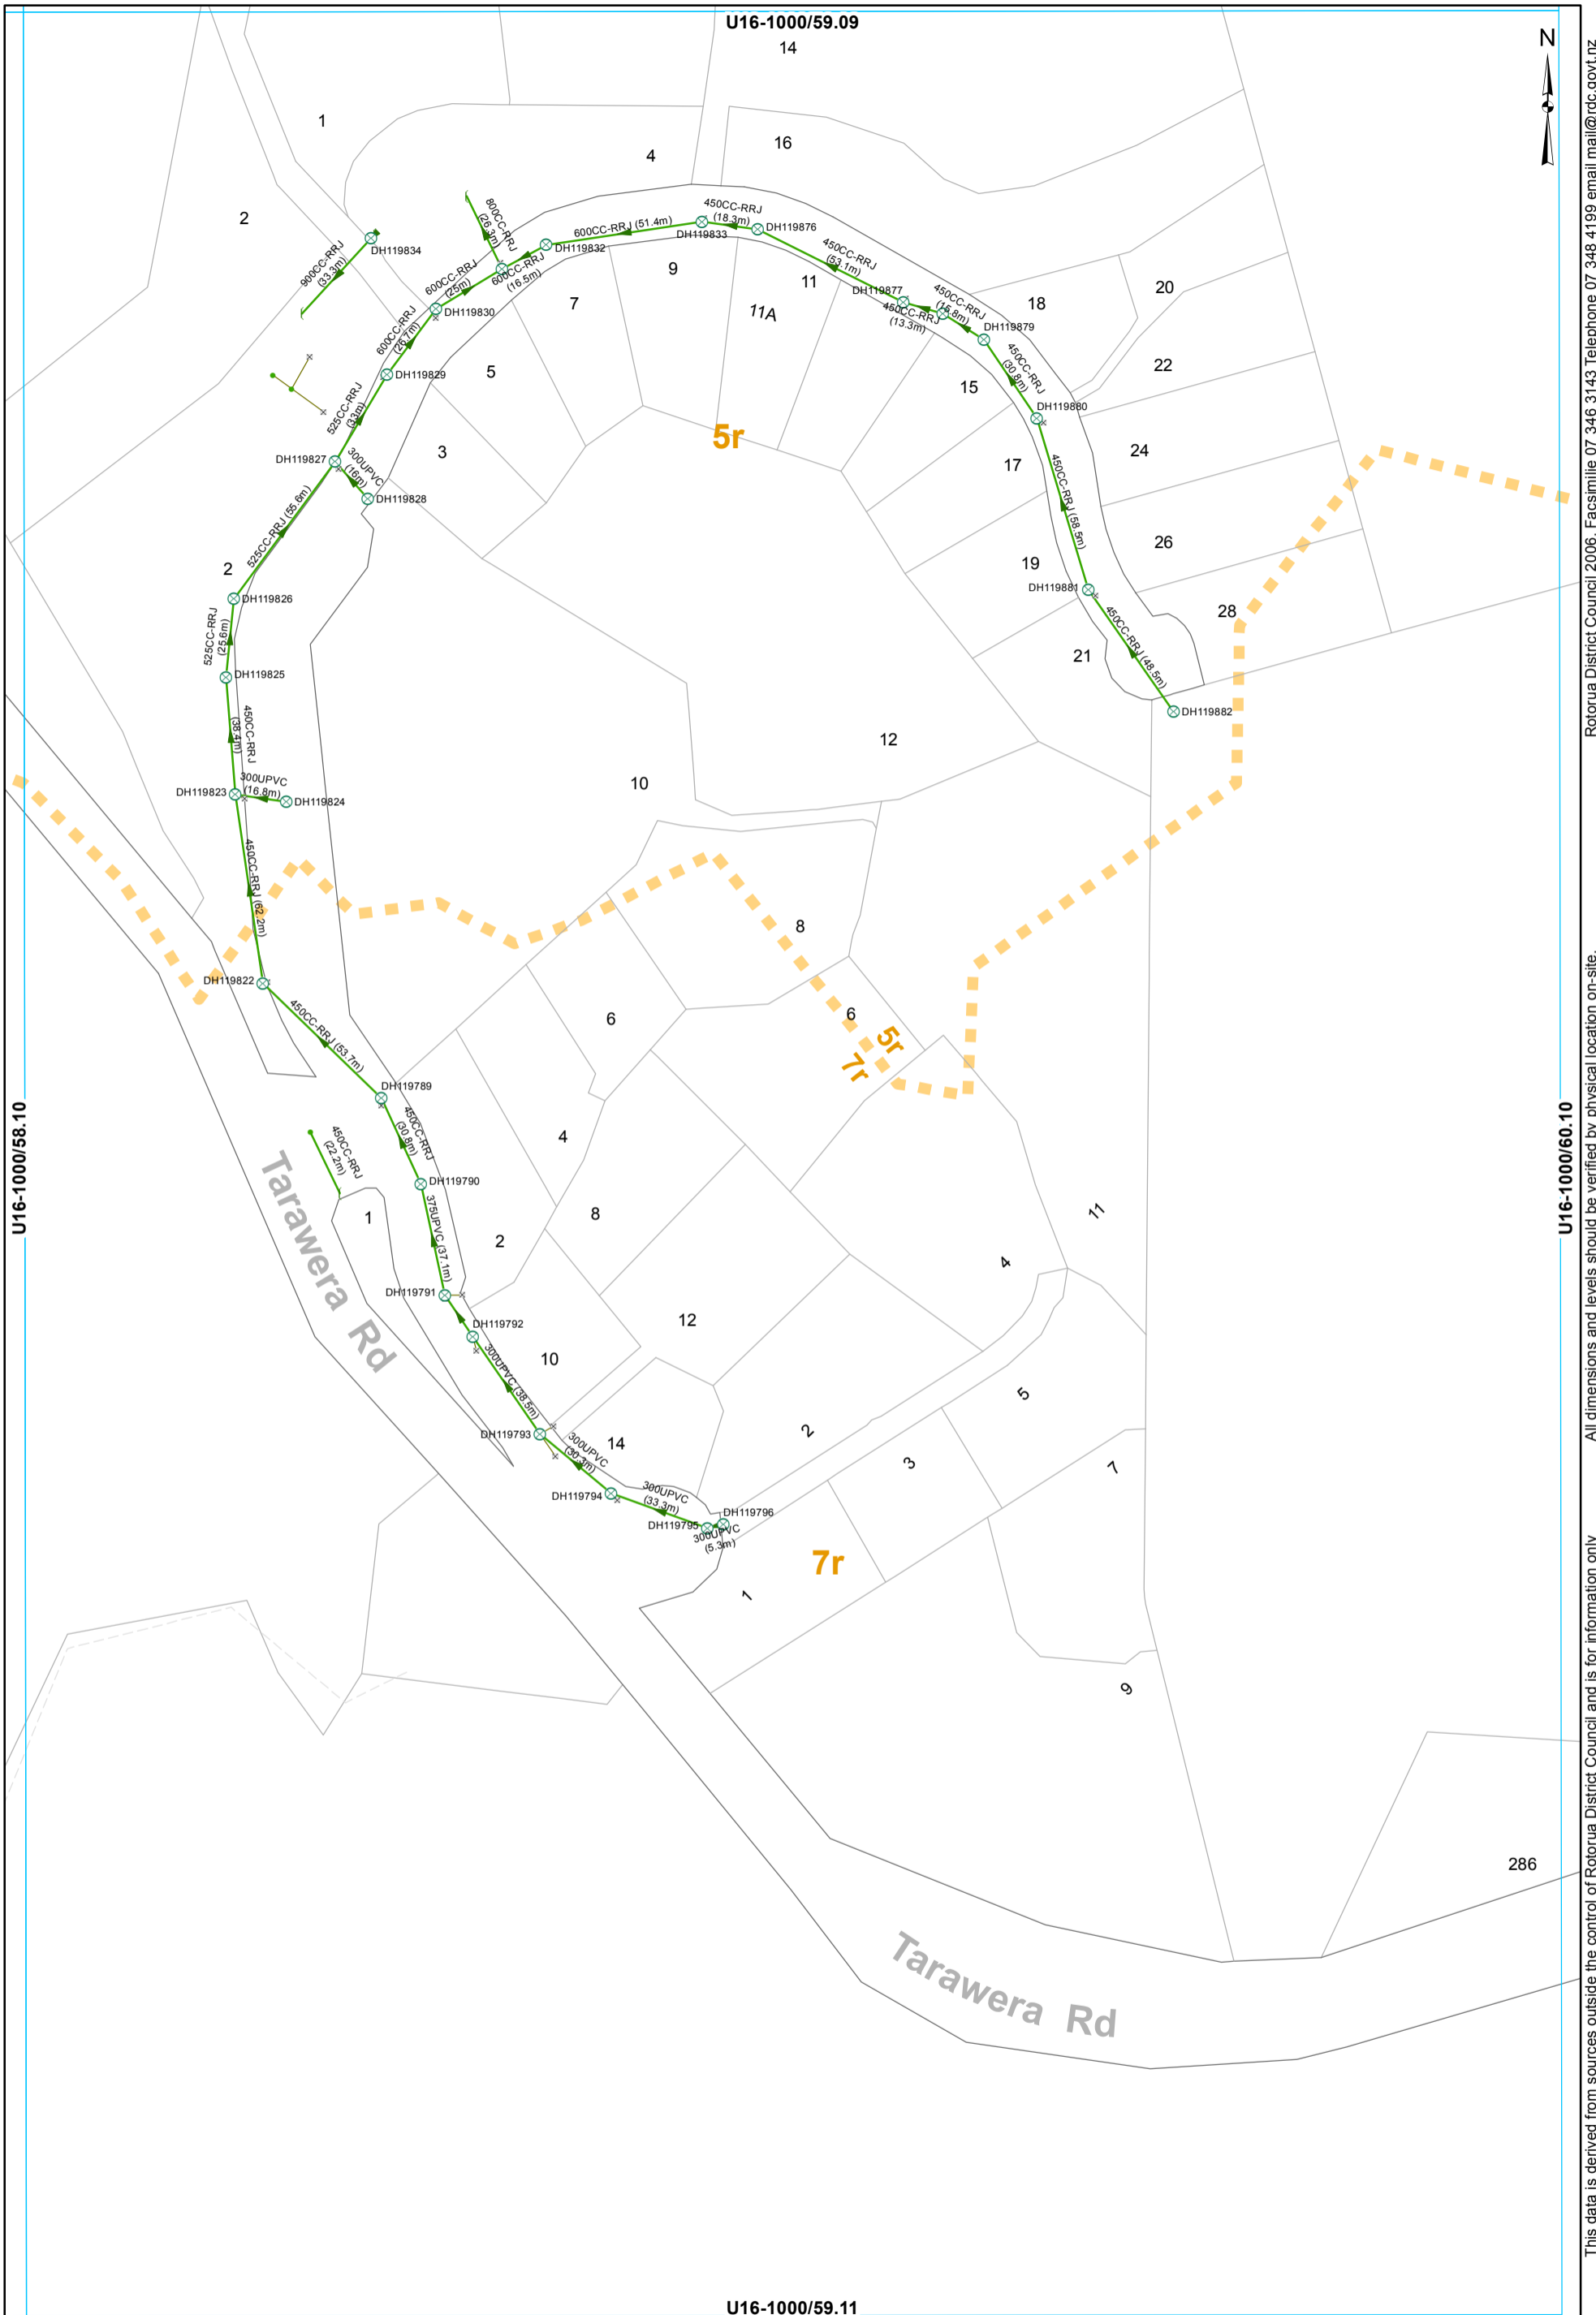


Rotorua District Council 2006. Facsimile 07 346 3143 Telephone 07 348 4199 email mail@rdc.govt.nz

All dimensions and levels should be verified by physical location on-site.

This data is derived from sources outside the control of Rotorua District Council and is for information only

- ⊗ SWManhole
- × SWInlet
- Node
- Headwall Structure
- Culvert
- Gravity Main
- SWLead
- Catchment Boundary

**STORMWATER SERVICES**  
1:2000 @ A3 - (U16-1000/59.10)

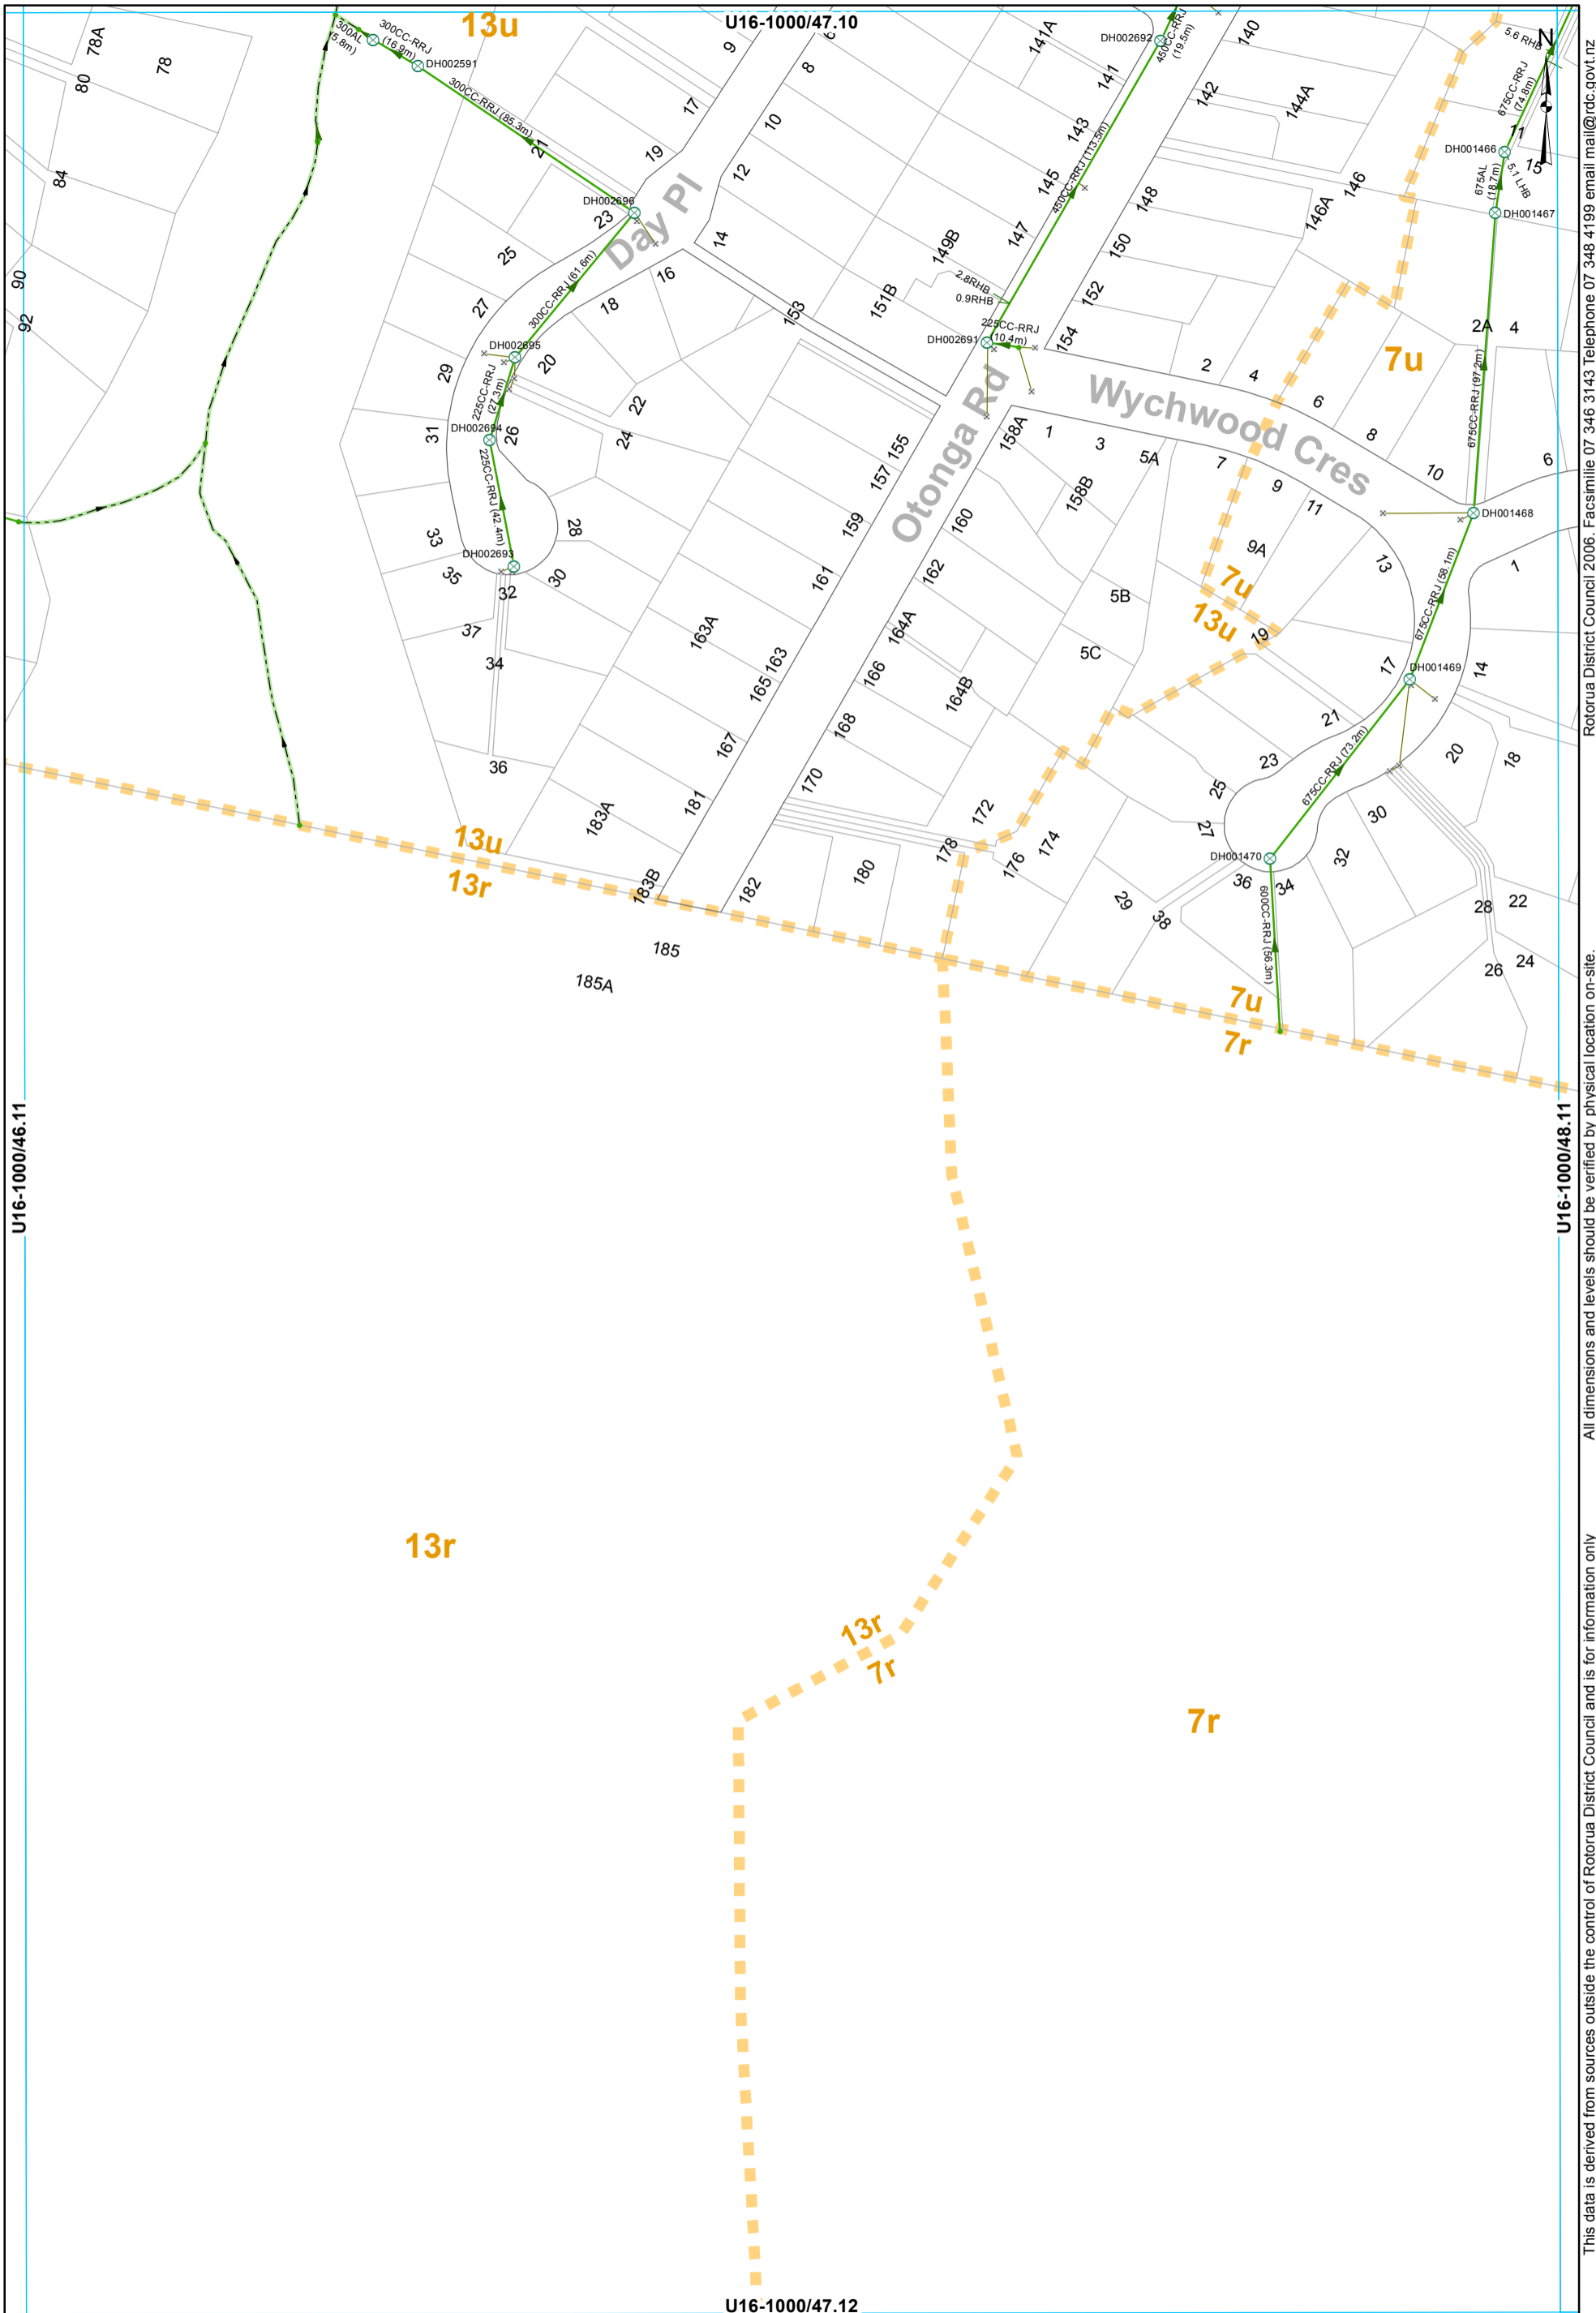

U16-1000/46.11


U16-1000/48.11

U16-1000/47.12

- ⊗ SWManhole
- × SWInlet
- Node
- Headwall Structure
- Open Drain
- Gravity Main
- SWServiceline
- SWServiceline
- SWLead
- Catchment Boundary

**STORMWATER SERVICES**  
1:2000 @ A3 - (U16-1000/47.11)

All dimensions and levels should be verified by physical location on-site. Rotorua District Council 2006. Facsimile 07 346 3143 Telephone 07 348 4199 email mail@rdc.govt.nz

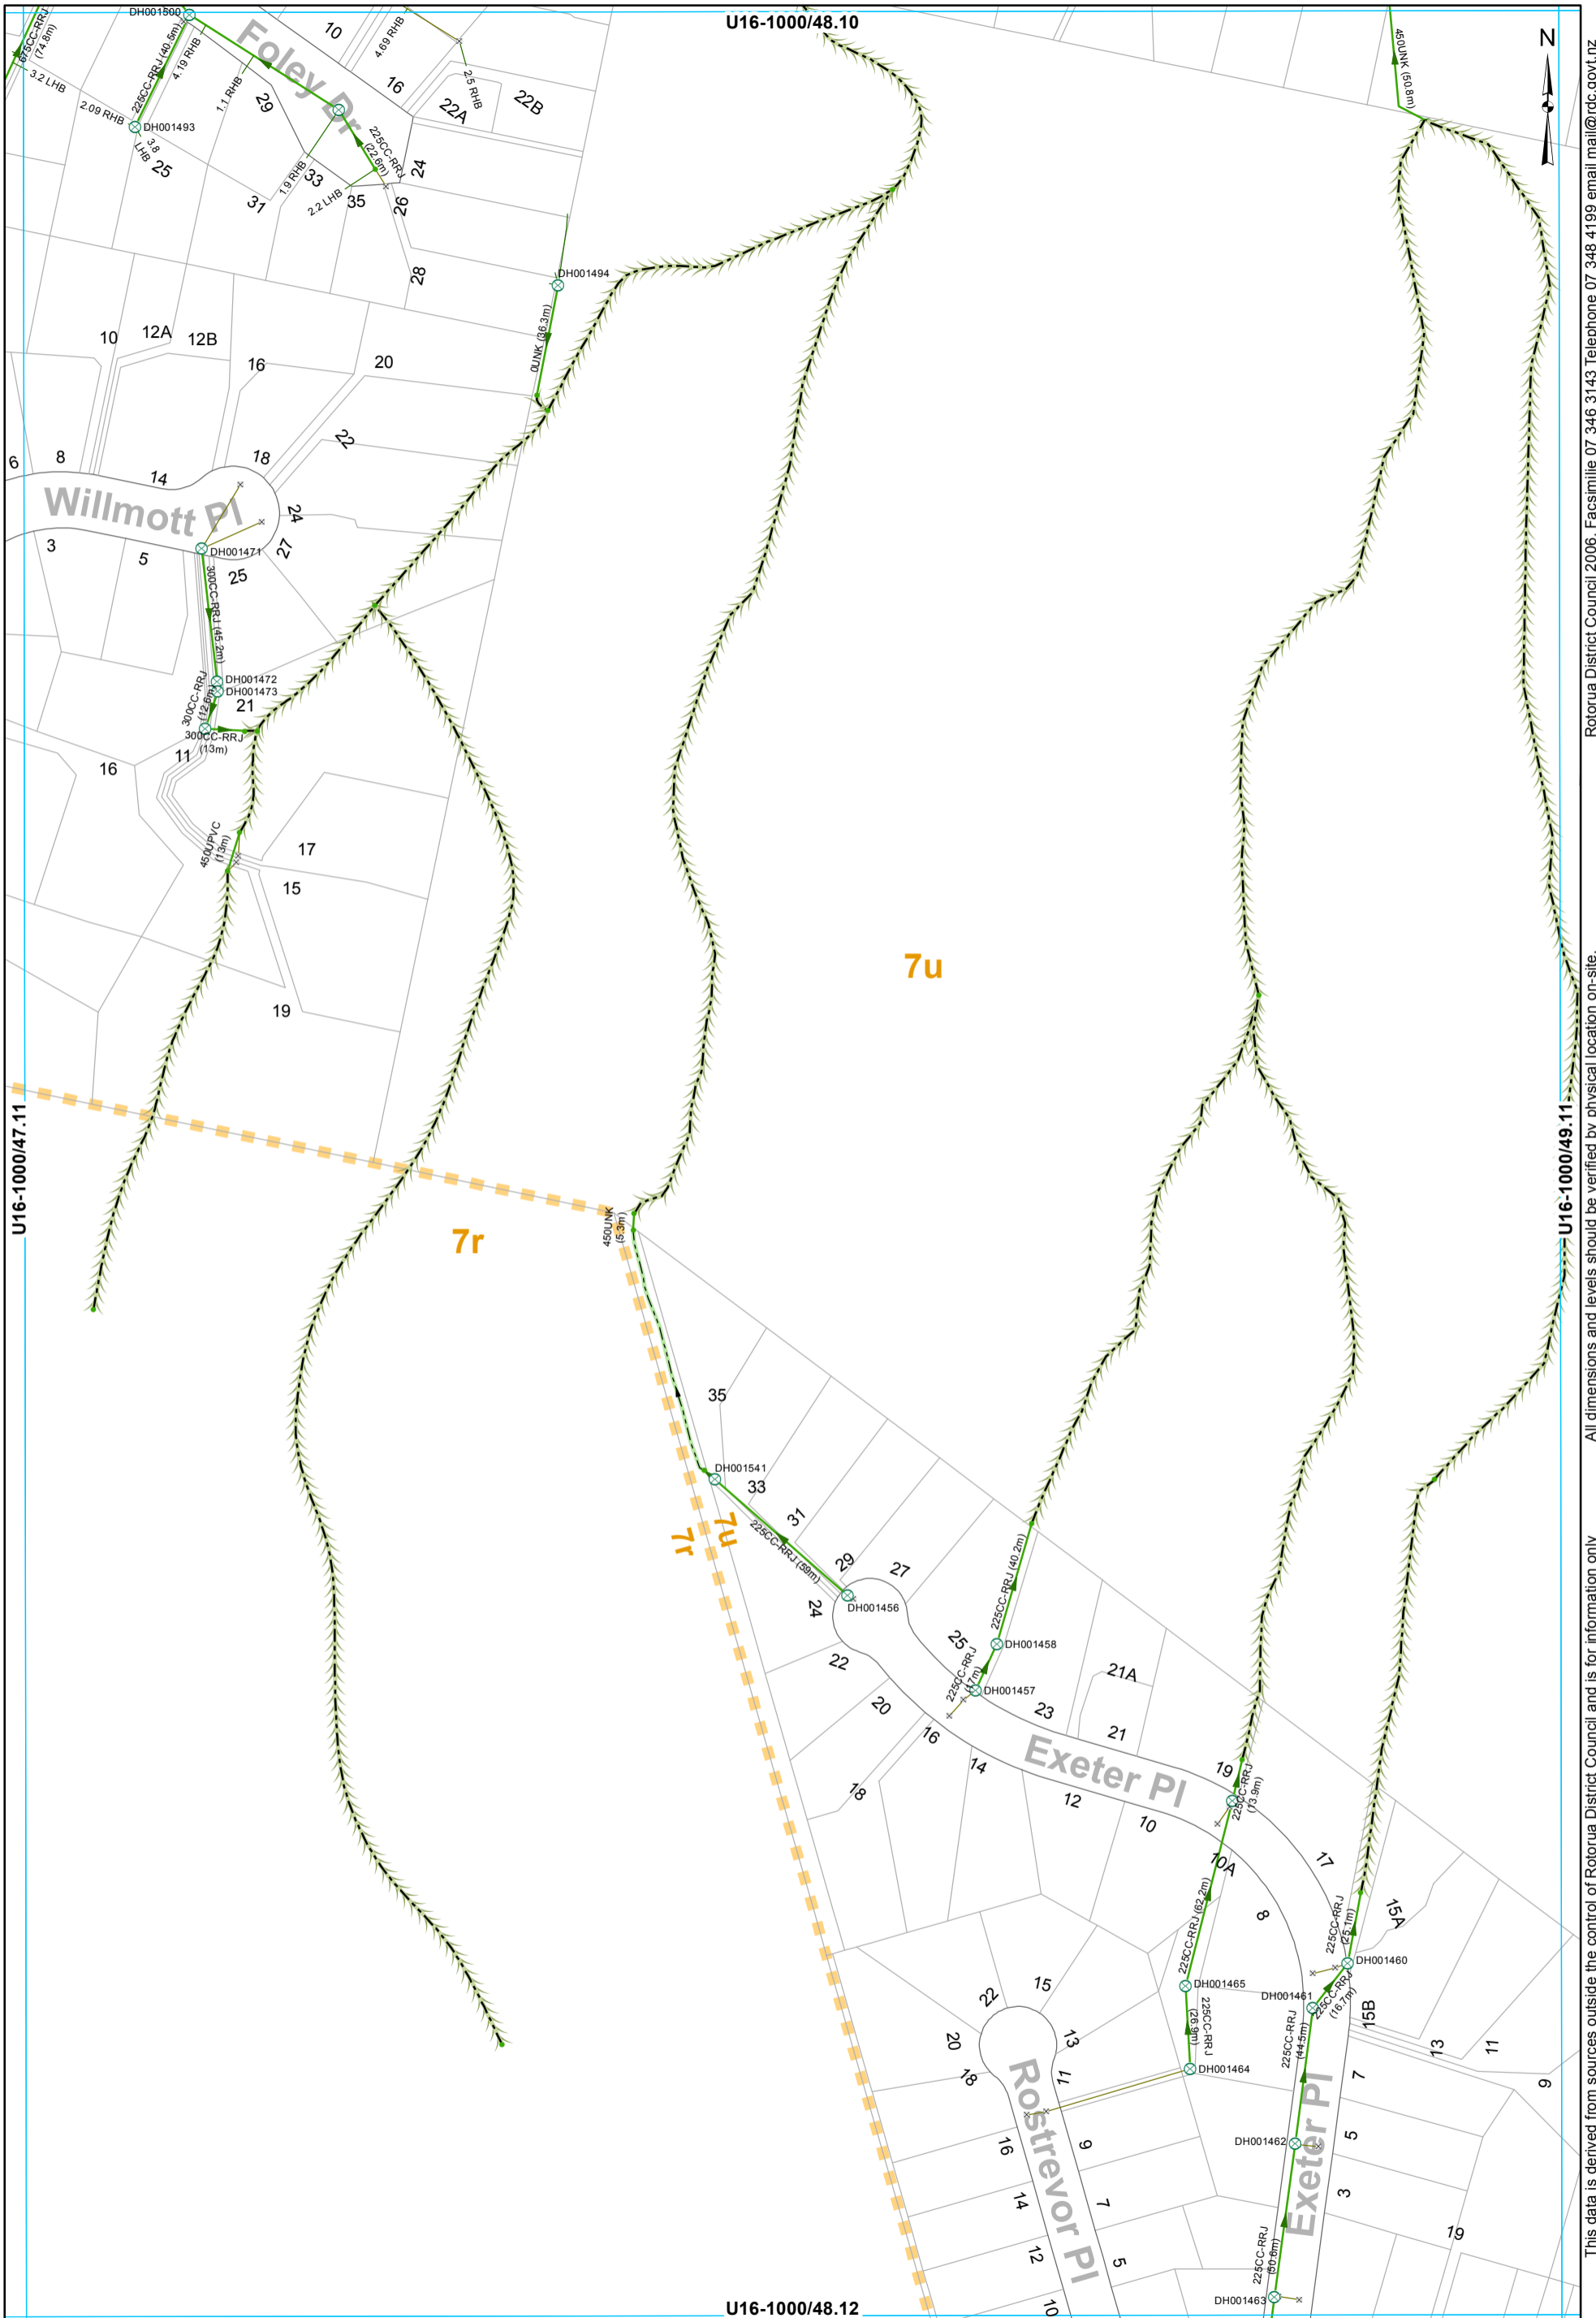


- ⊗ SWManhole
- × SWInlet
- Node
- Headwall Structure
- Open Drain
- Overland Flow
- Culvert
- Gravity Main
- SWServiceline
- SWServiceline
- SWLead
- Catchment Boundary

**STORMWATER SERVICES**  
**1:2000 @ A3 - (U16-1000/48.11)**

This data is derived from sources outside the control of Rotorua District Council and is for information only

Rotorua District Council 2006. Facsimile 07 346 3143 Telephone 07 348 4199 email mail@rdc.govt.nz

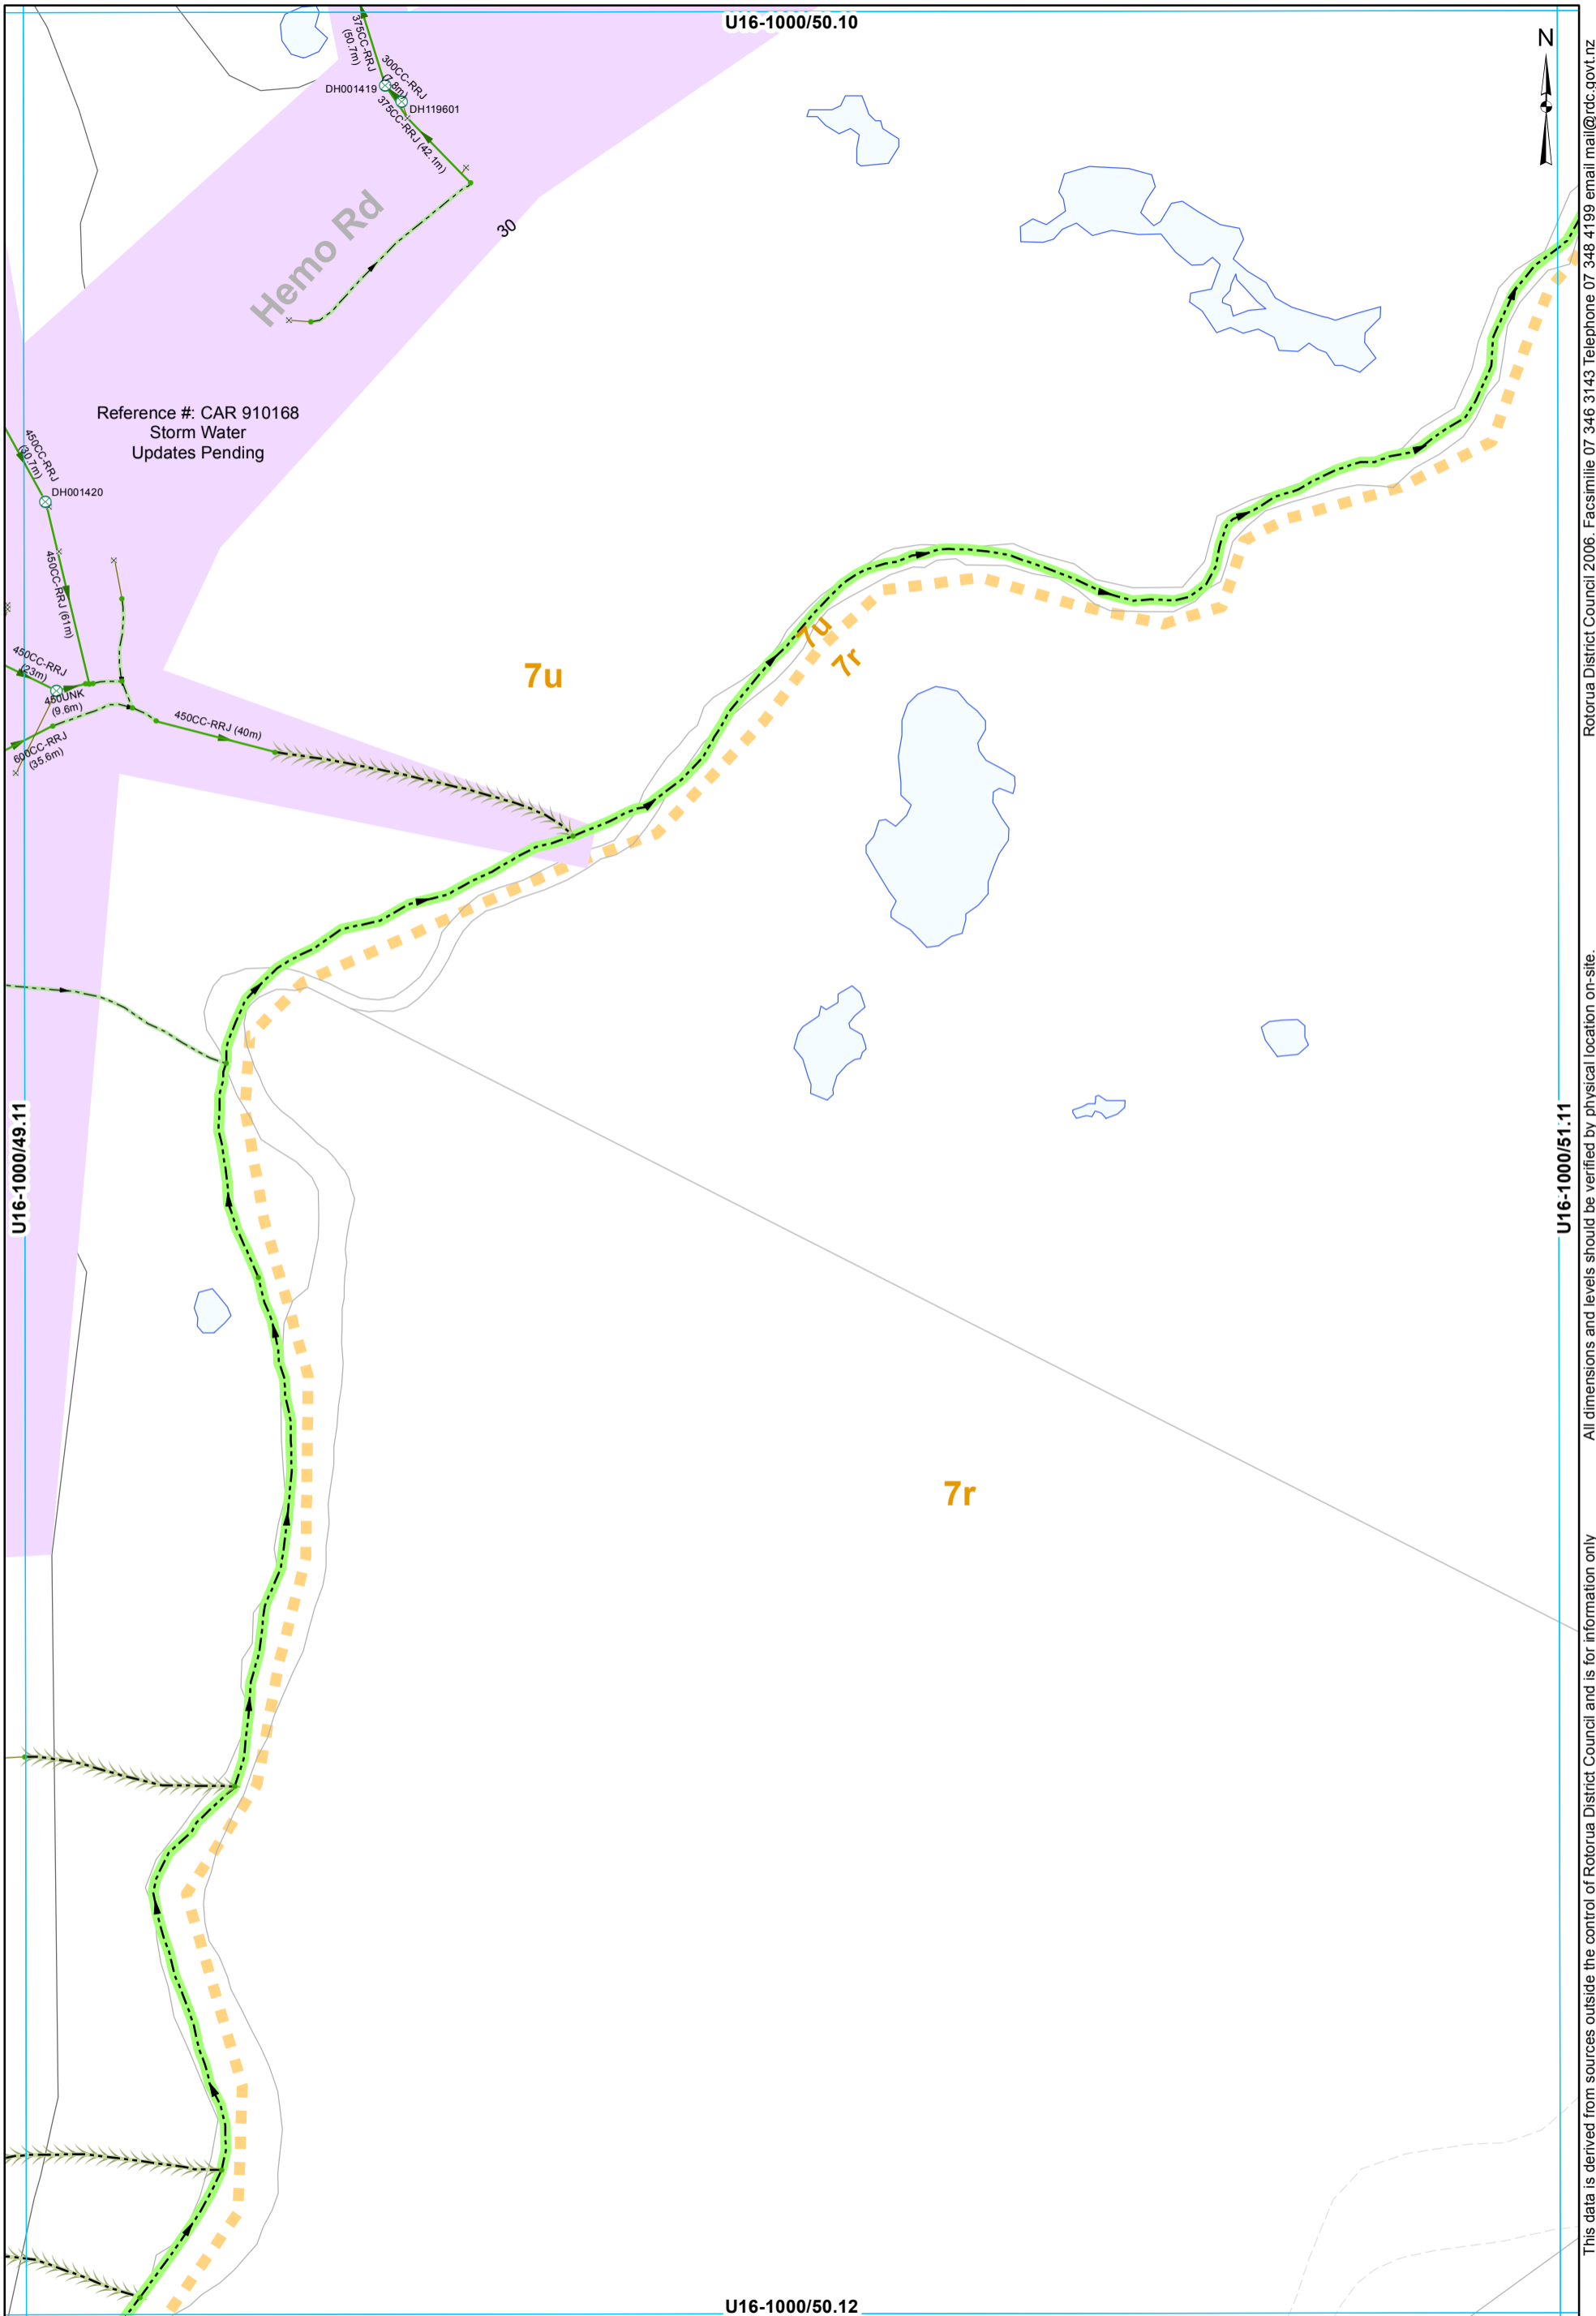


Reference #: CAR 910168  
Storm Water  
Updates Pending

- ⊗ SWManhole
- × SWInlet
- Node
- Open Drain
- Overland Flow
- Stream
- Culvert
- Gravity Main
- SWLead
- Catchment Boundary


**STORMWATER SERVICES**  
1:2000 @ A3 - (U16-1000/50.11)

This data is derived from sources outside the control of Rotorua District Council and is for information only

Rotorua District Council 2006. Facsimile 07 346 3143 Telephone 07 348 4199 email mail@rdc.govt.nz

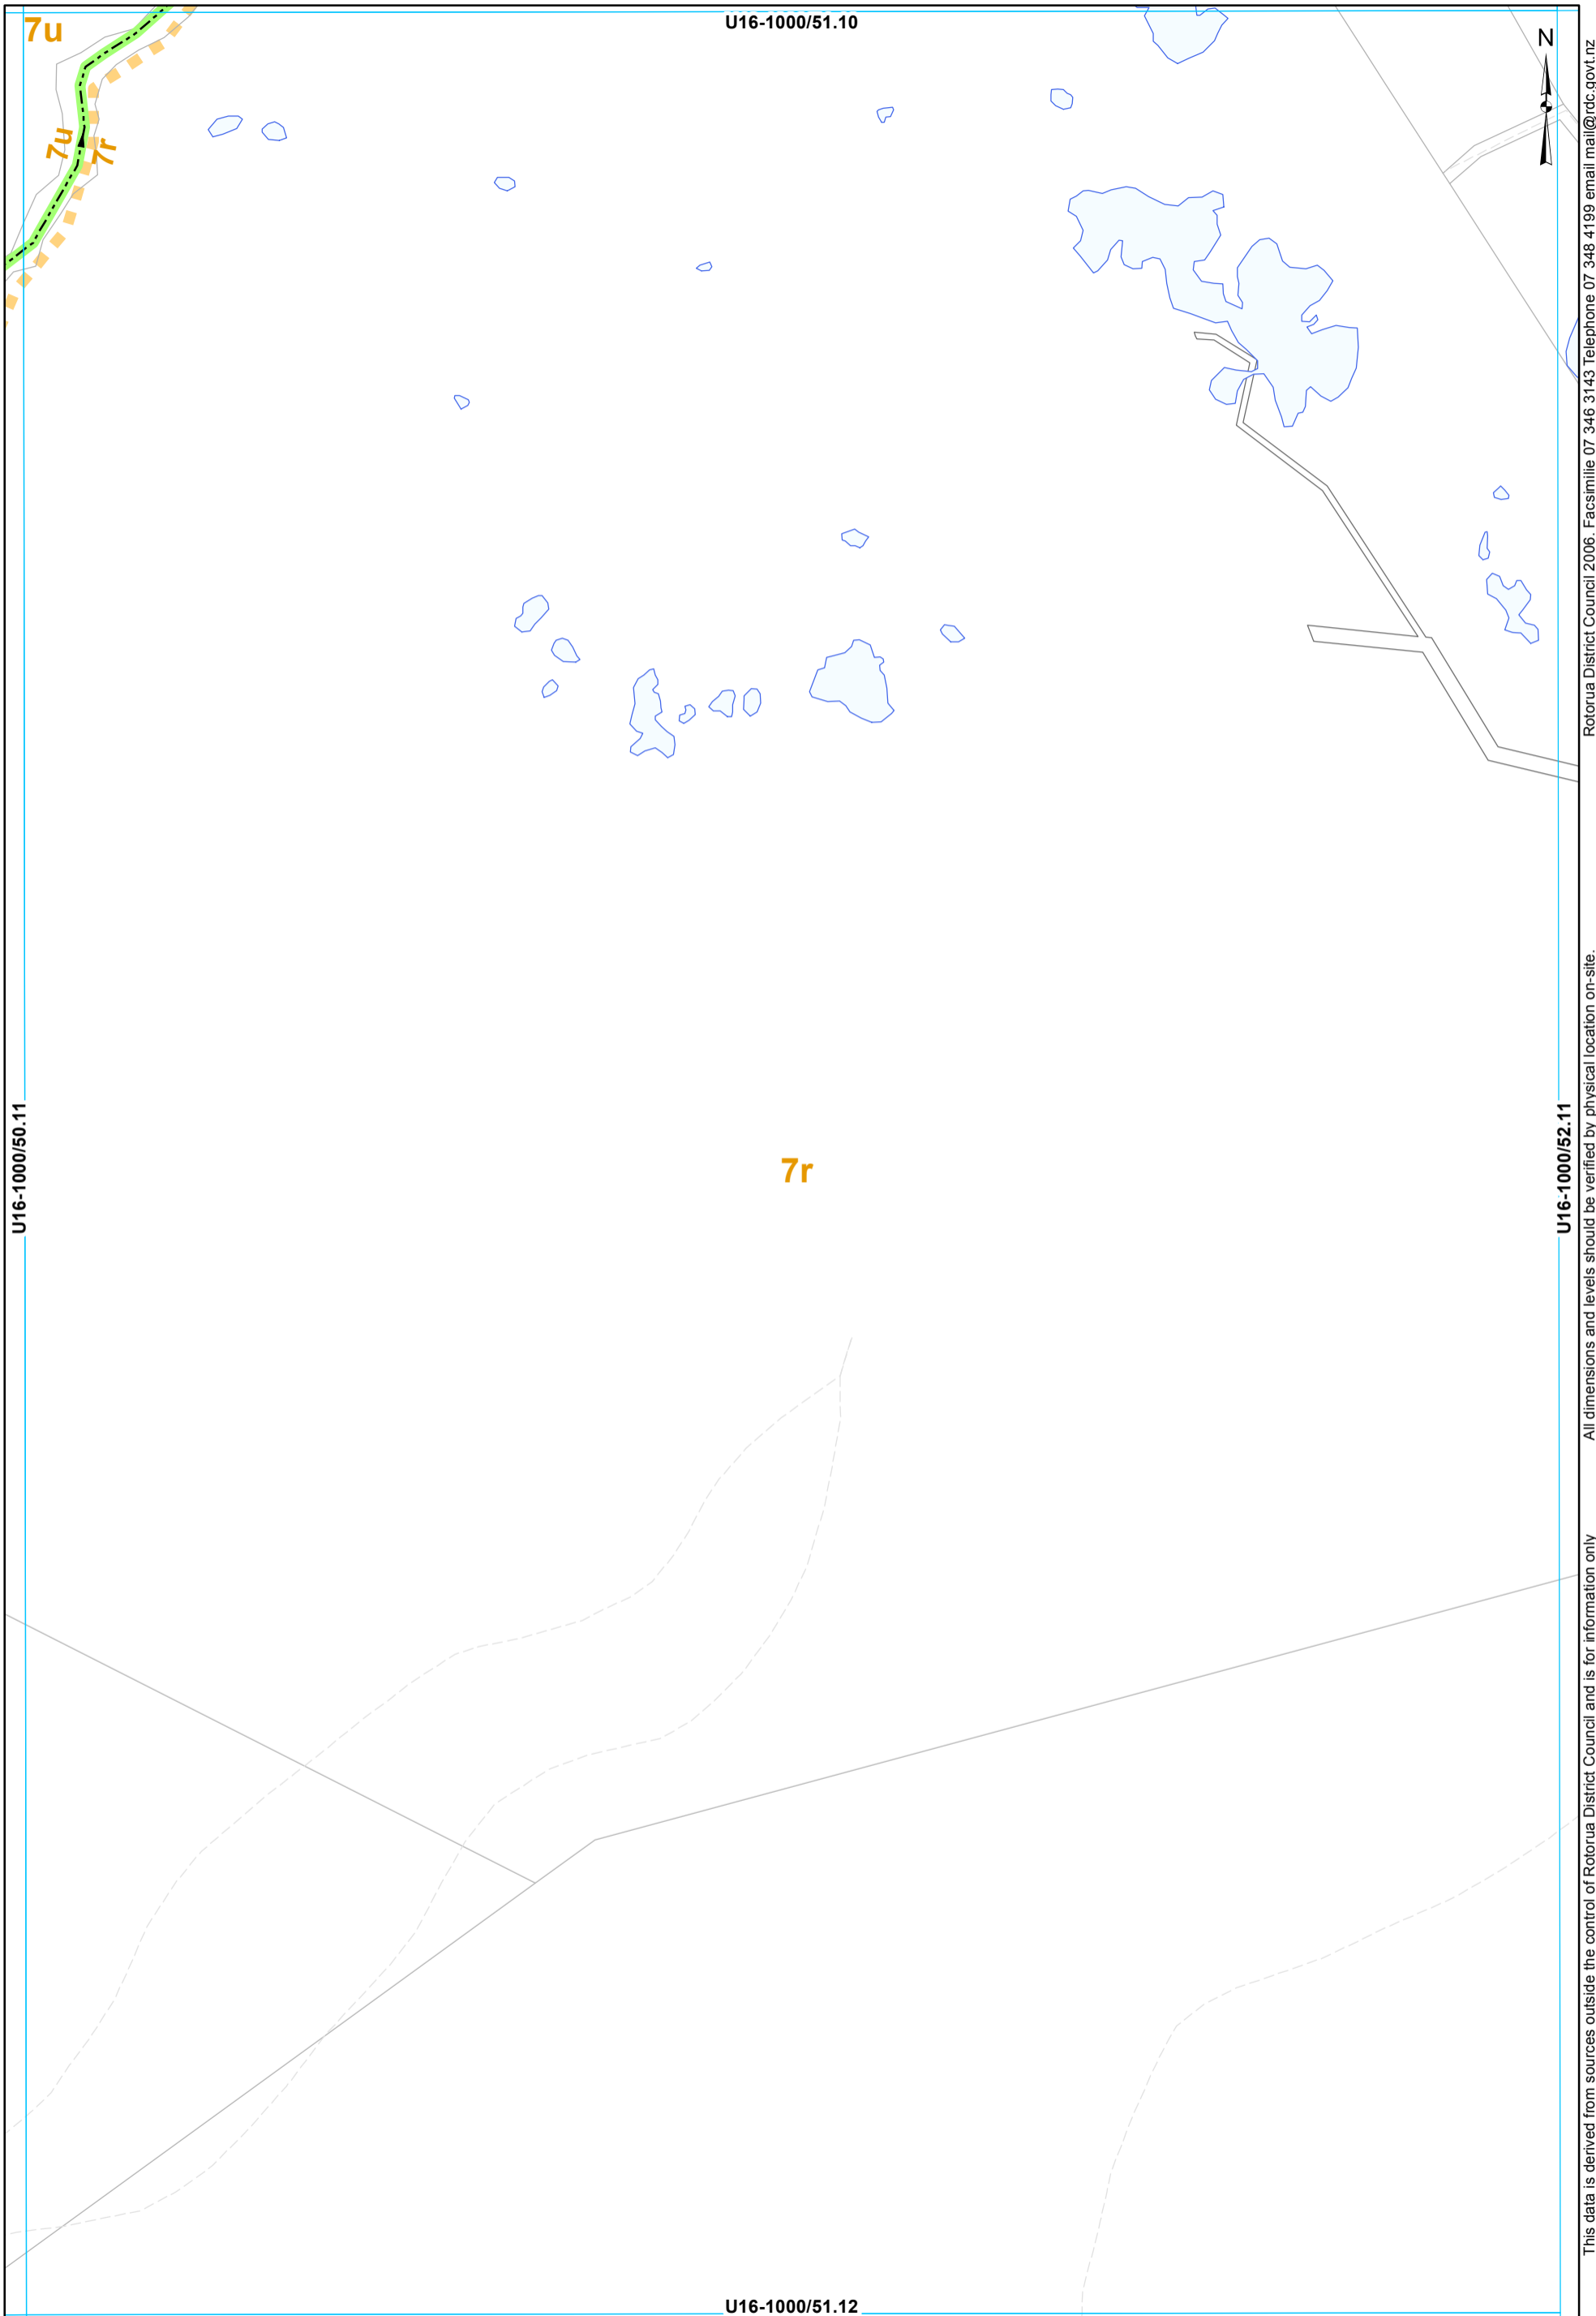

- Stream
- Catchment Boundary

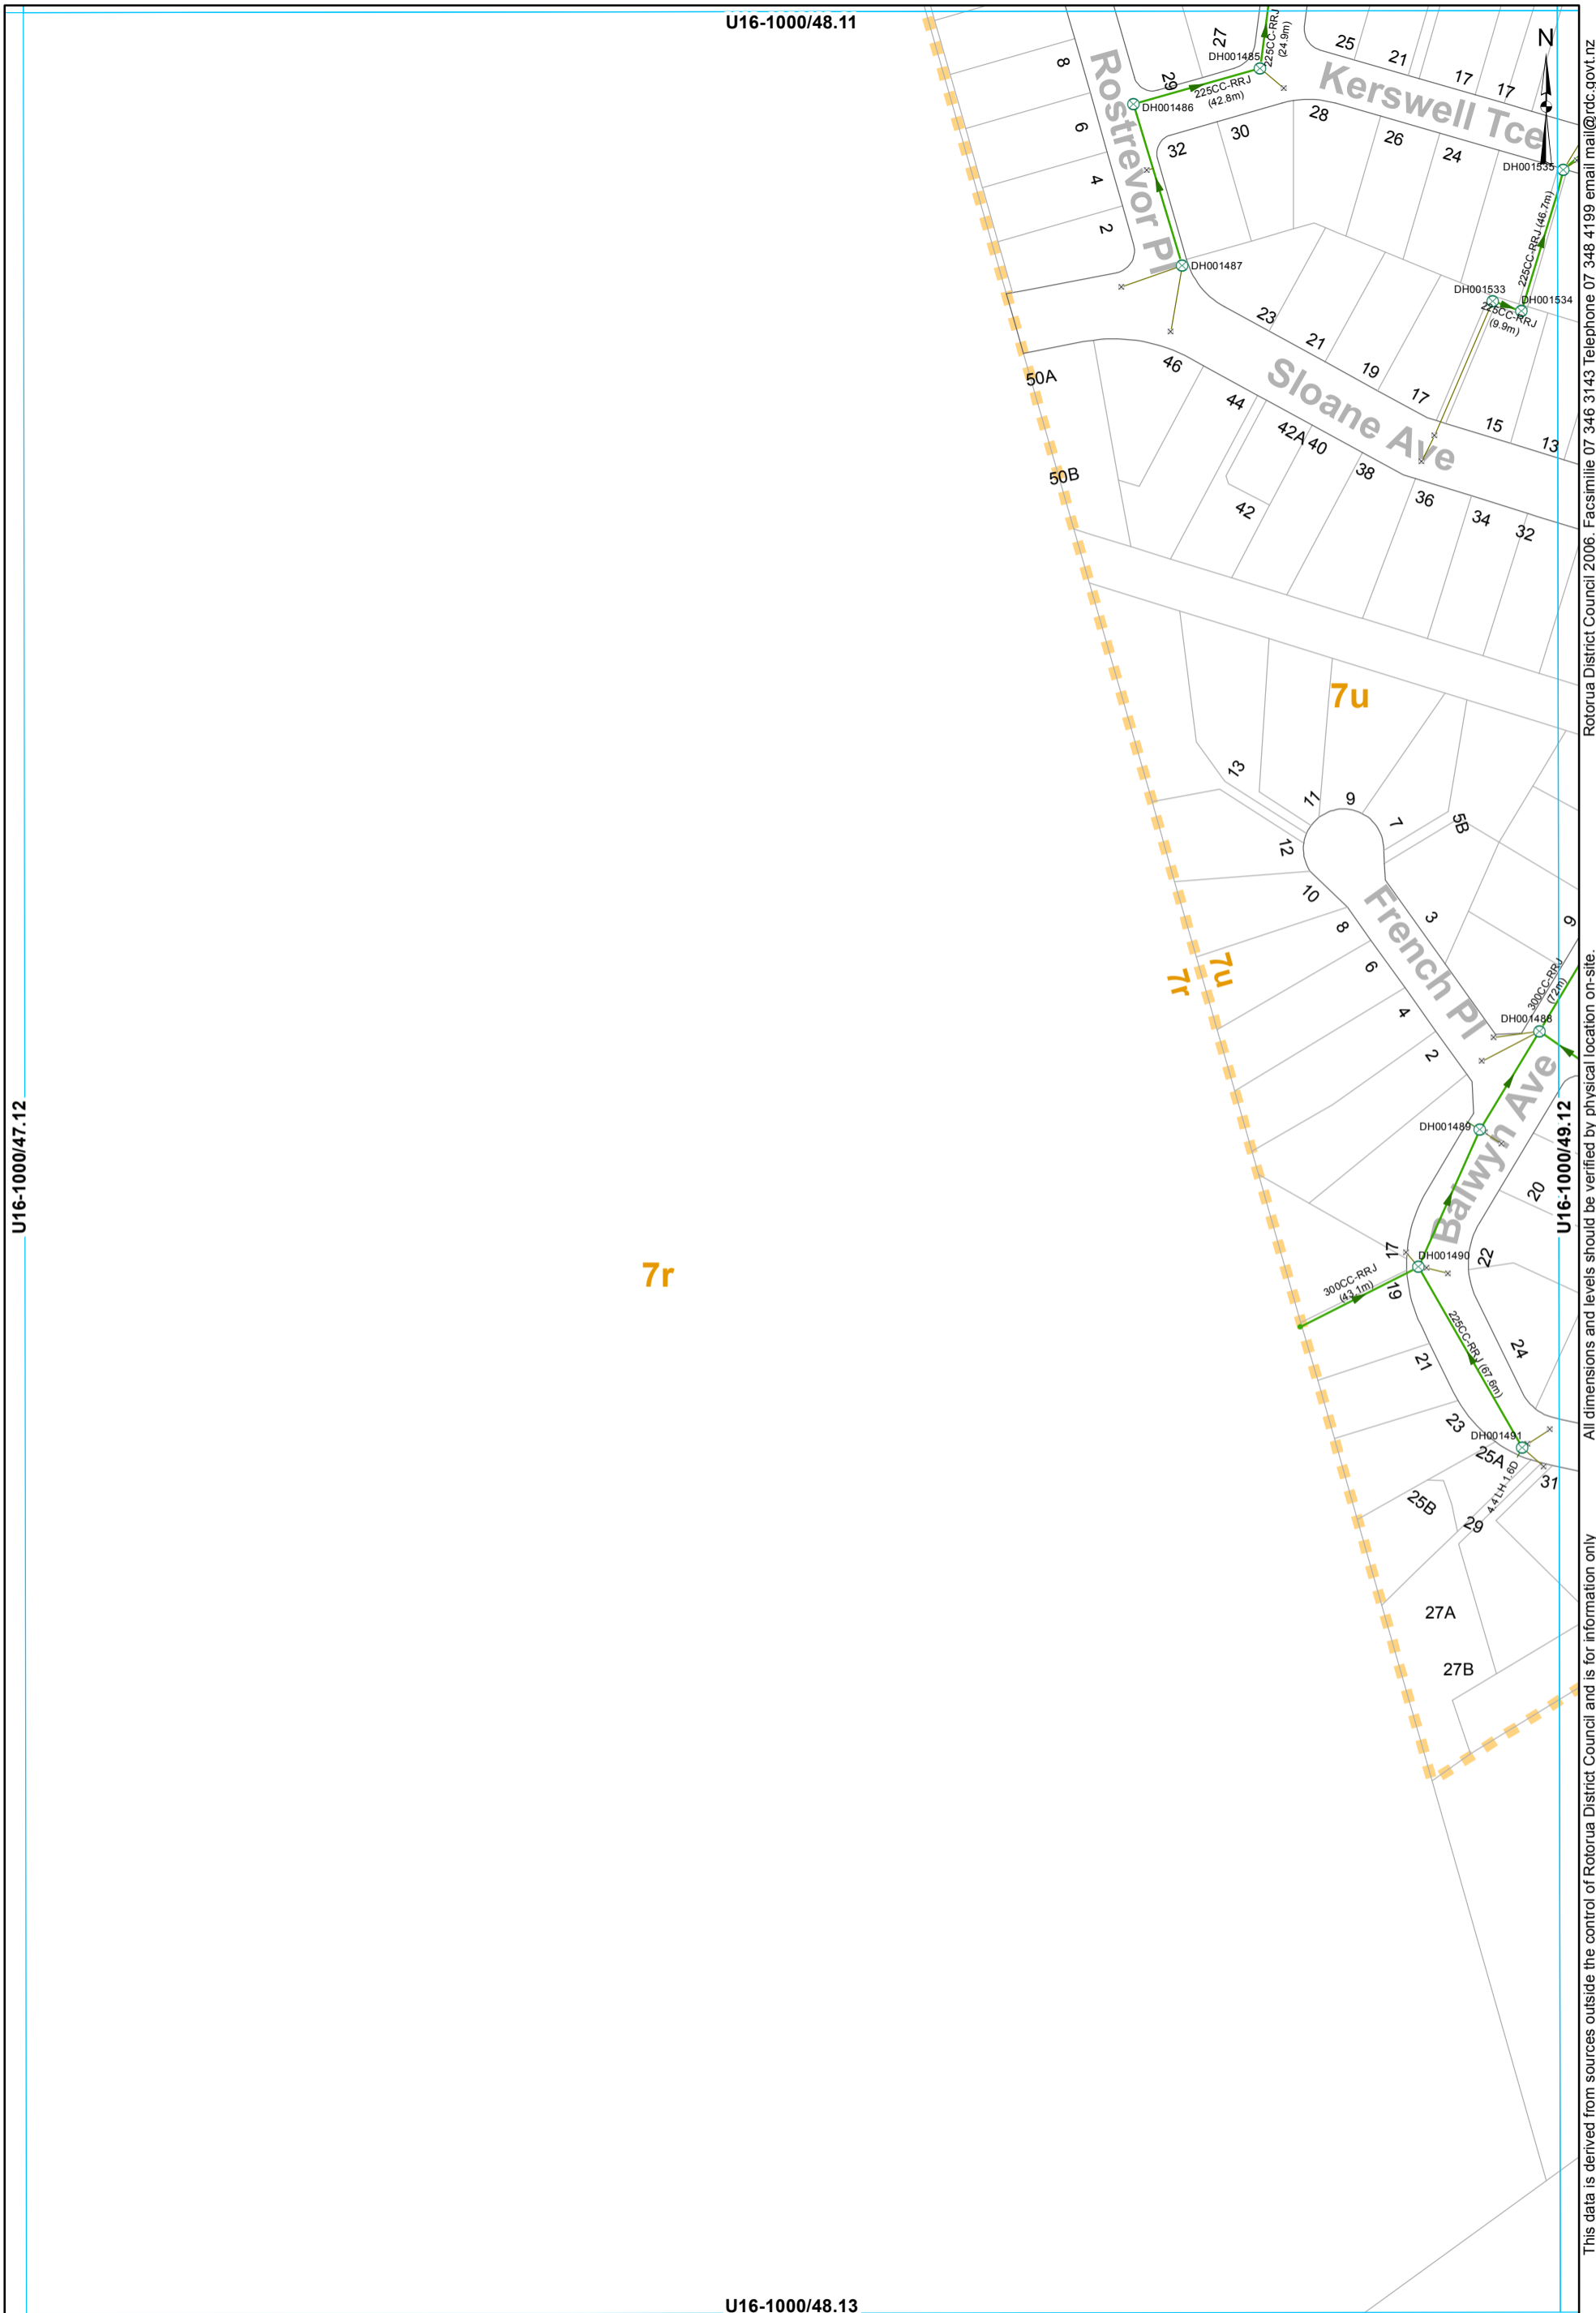

U16-1000/47.12

U16-1000/48.11

U16-1000/48.13


Rotorua District Council 2006. Facsimile 07 346 3143 Telephone 07 348 4199 email mail@rdc.govt.nz

All dimensions and levels should be verified by physical location on-site.

This data is derived from sources outside the control of Rotorua District Council and is for information only

- ⊗ SWManhole    — Gravity Main    SWServiceline
- × SWInlet        — SWServiceline
- Node            — SWLead
- Catchment Boundary

**STORMWATER SERVICES**  
1:2000 @ A3 - (U16-1000/48.12)

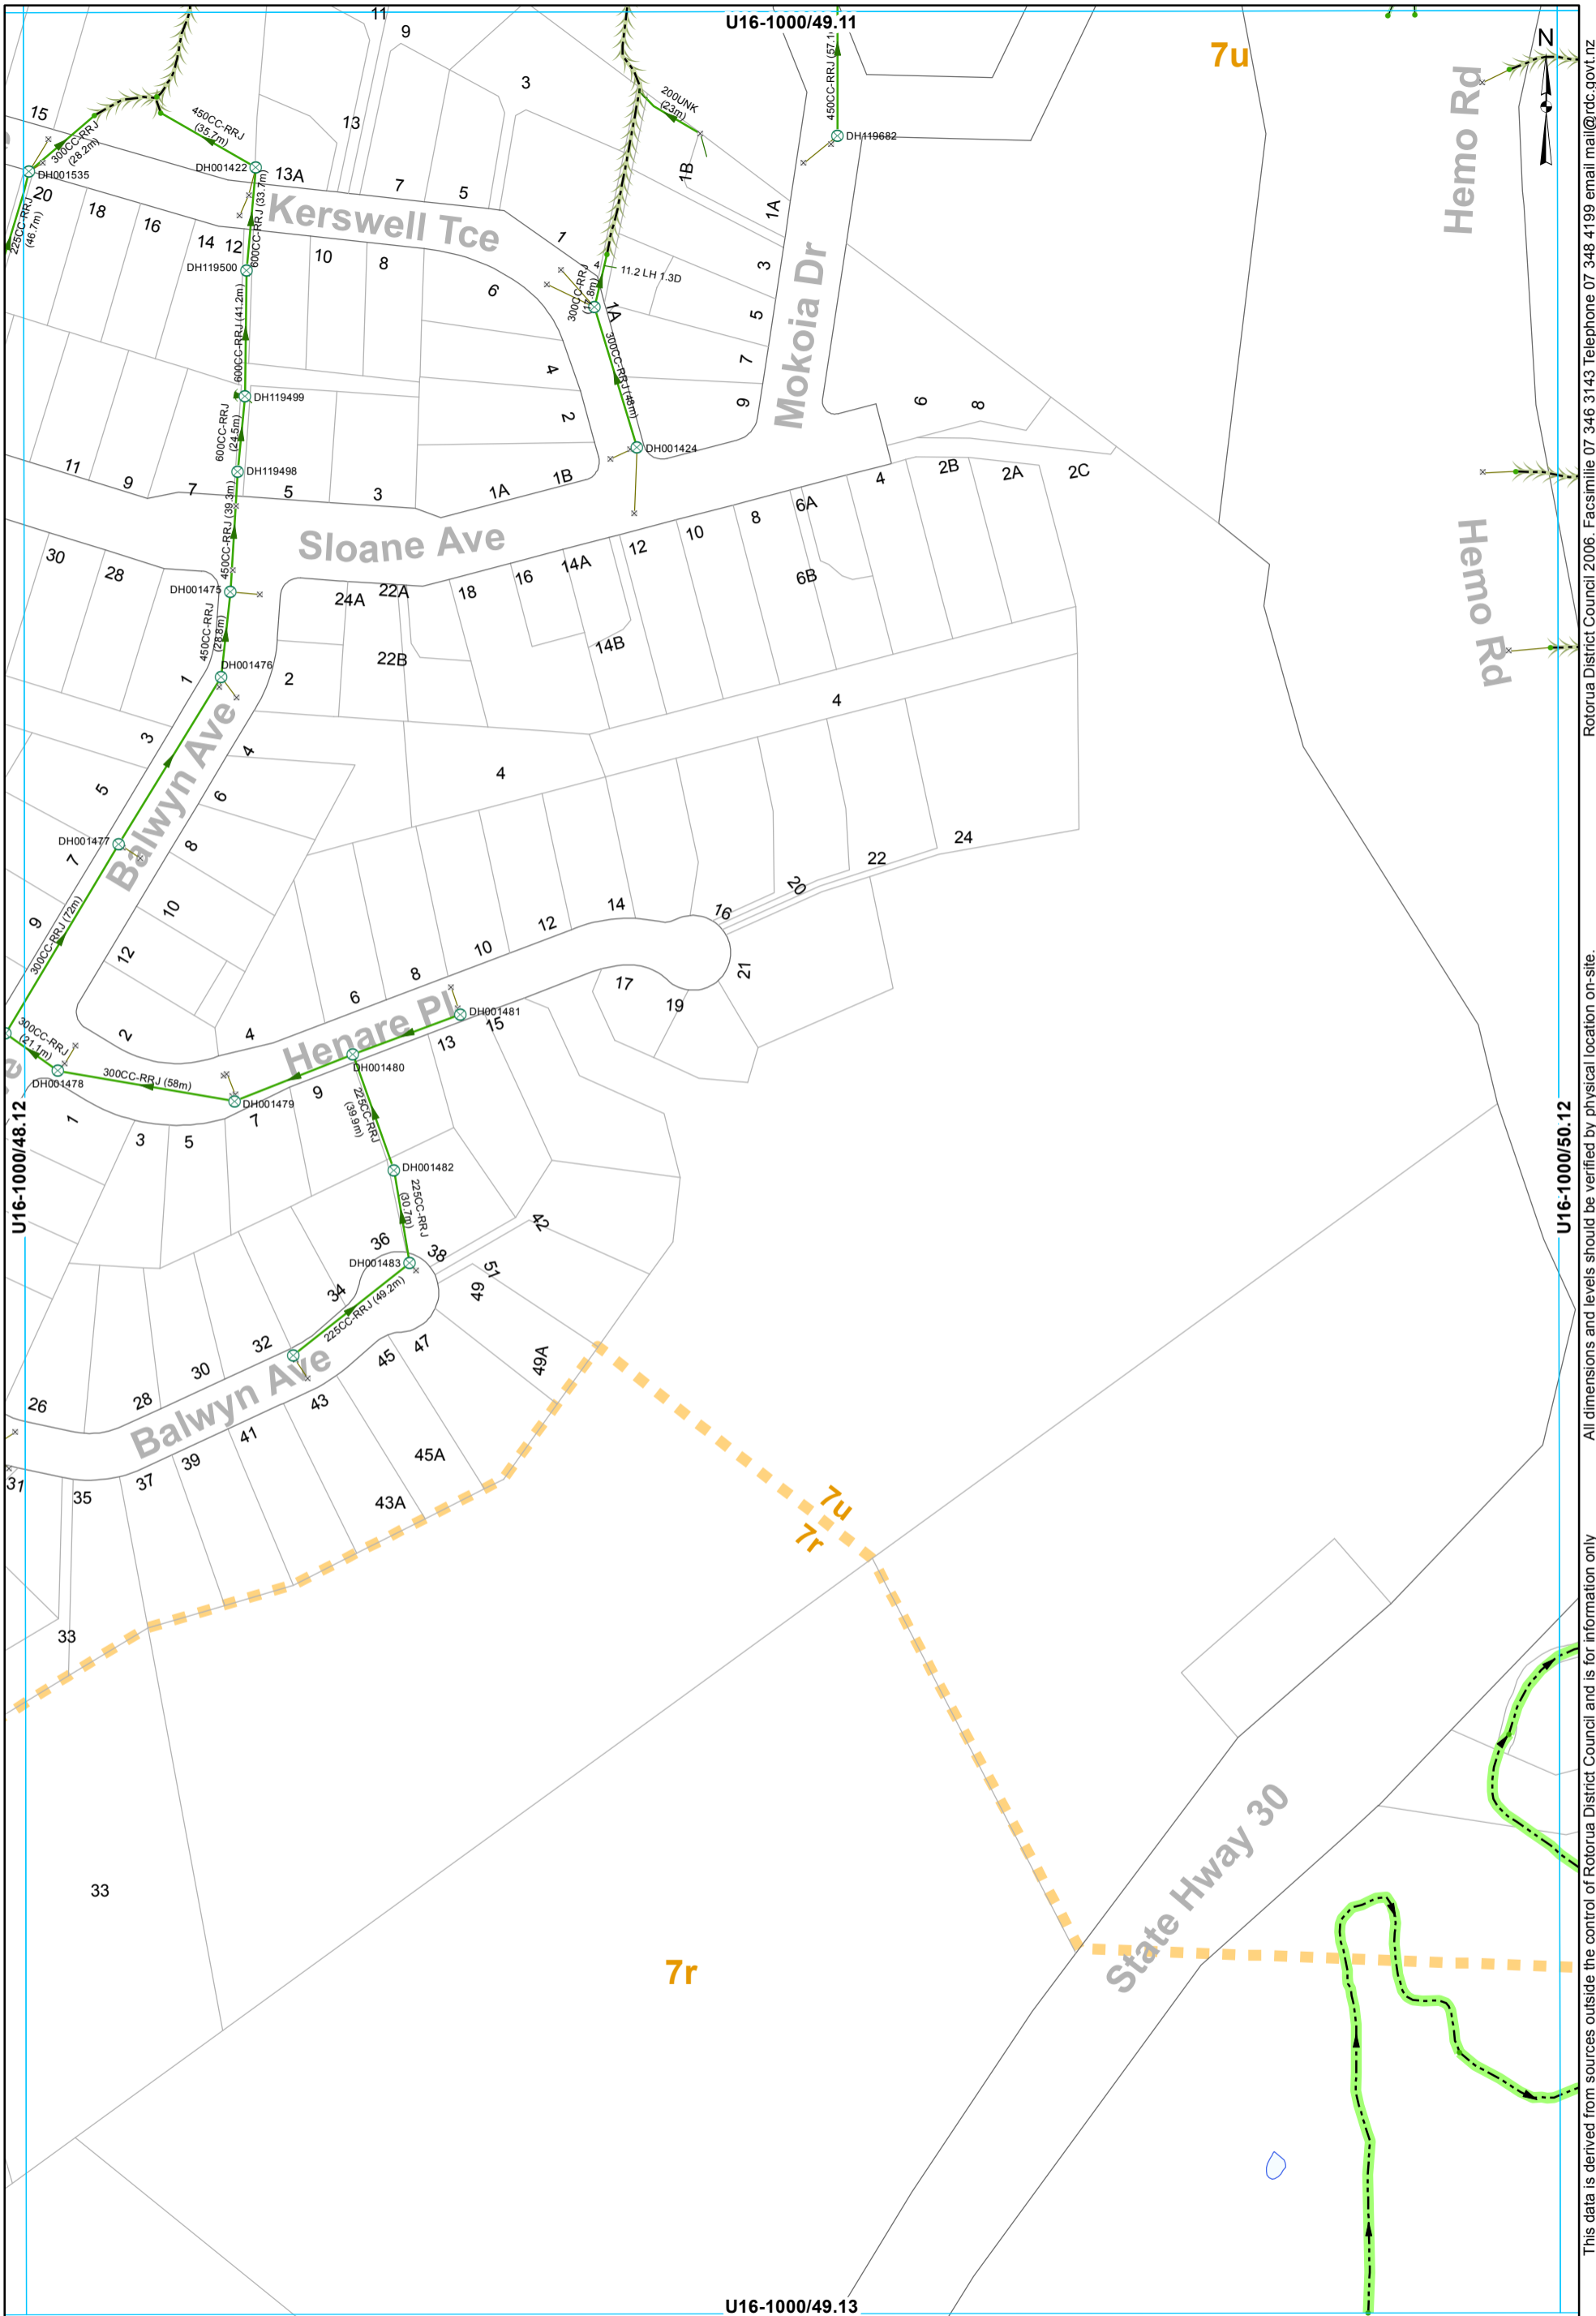

- ⊗ SWManhole
- × SWInlet
- Node
- Headwall Structure
- Open Drain
- Overland Flow
- Stream
- Gravity Main
- SWServiceline
- SWServiceline
- SWLead
- ▬ Catchment Boundary

**STORMWATER SERVICES**  
**1:2000 @ A3 - (U16-1000/49.12)**

This data is derived from sources outside the control of Rotorua District Council and is for information only

All dimensions and levels should be verified by physical location on-site.

Rotorua District Council 2006. Facsimile 07 346 3143 Telephone 07 348 4199 email mail@rdc.govt.nz




- ⊗ SWManhole
- × SWInlet
- Node
- Open Drain
- Overland Flow
- Stream
- Culvert
- Gravity Main
- SWLead
- Catchment Boundary

**STORMWATER SERVICES**  
 1:2000 @ A3 - (U16-1000/50.12)

All dimensions and levels should be verified by physical location on-site. Rotorua District Council 2006. Facsimile 07 346 3143 Telephone 07 348 4199 email mail@rdc.govt.nz




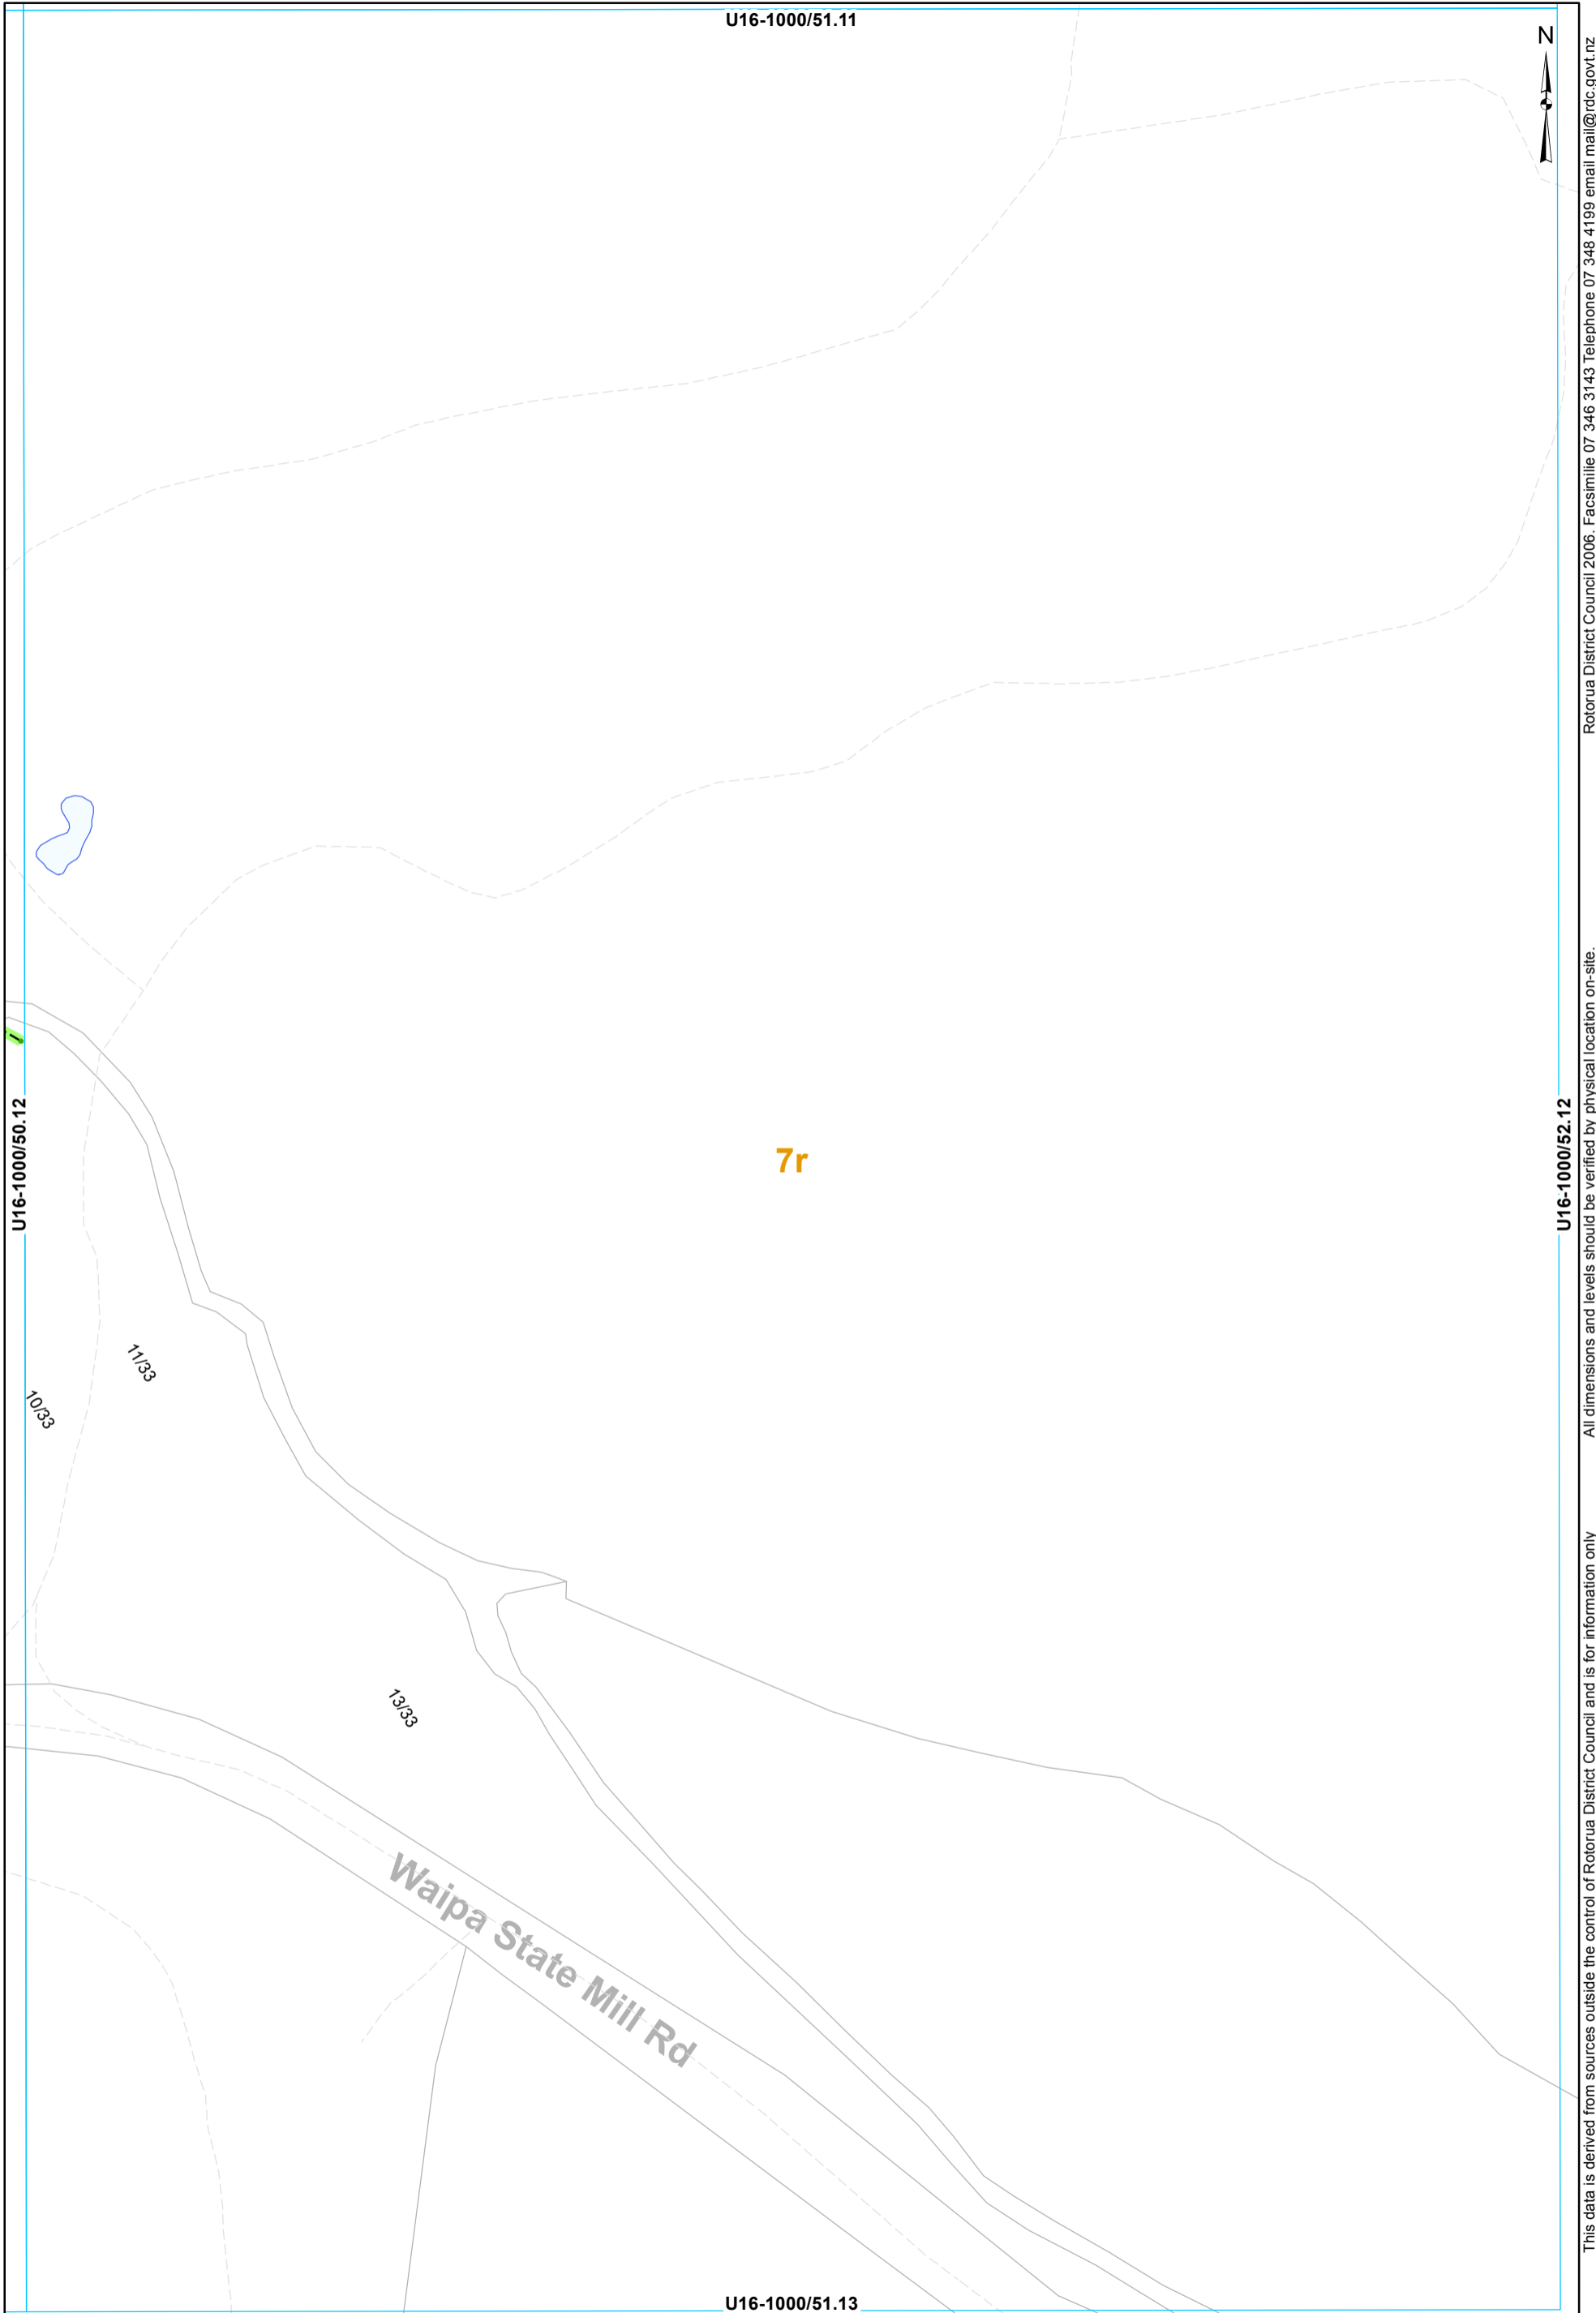

- Node
- Stream

**STORMWATER SERVICES**  
 1:2000 @ A3 - (U16-1000/51.12)

U16-1000/52.12  
 All dimensions and levels should be verified by physical location on-site.  
 Rotorua District Council 2006. Facsimile 07 346 3143 Telephone 07 348 4199 email mail@rdc.govt.nz

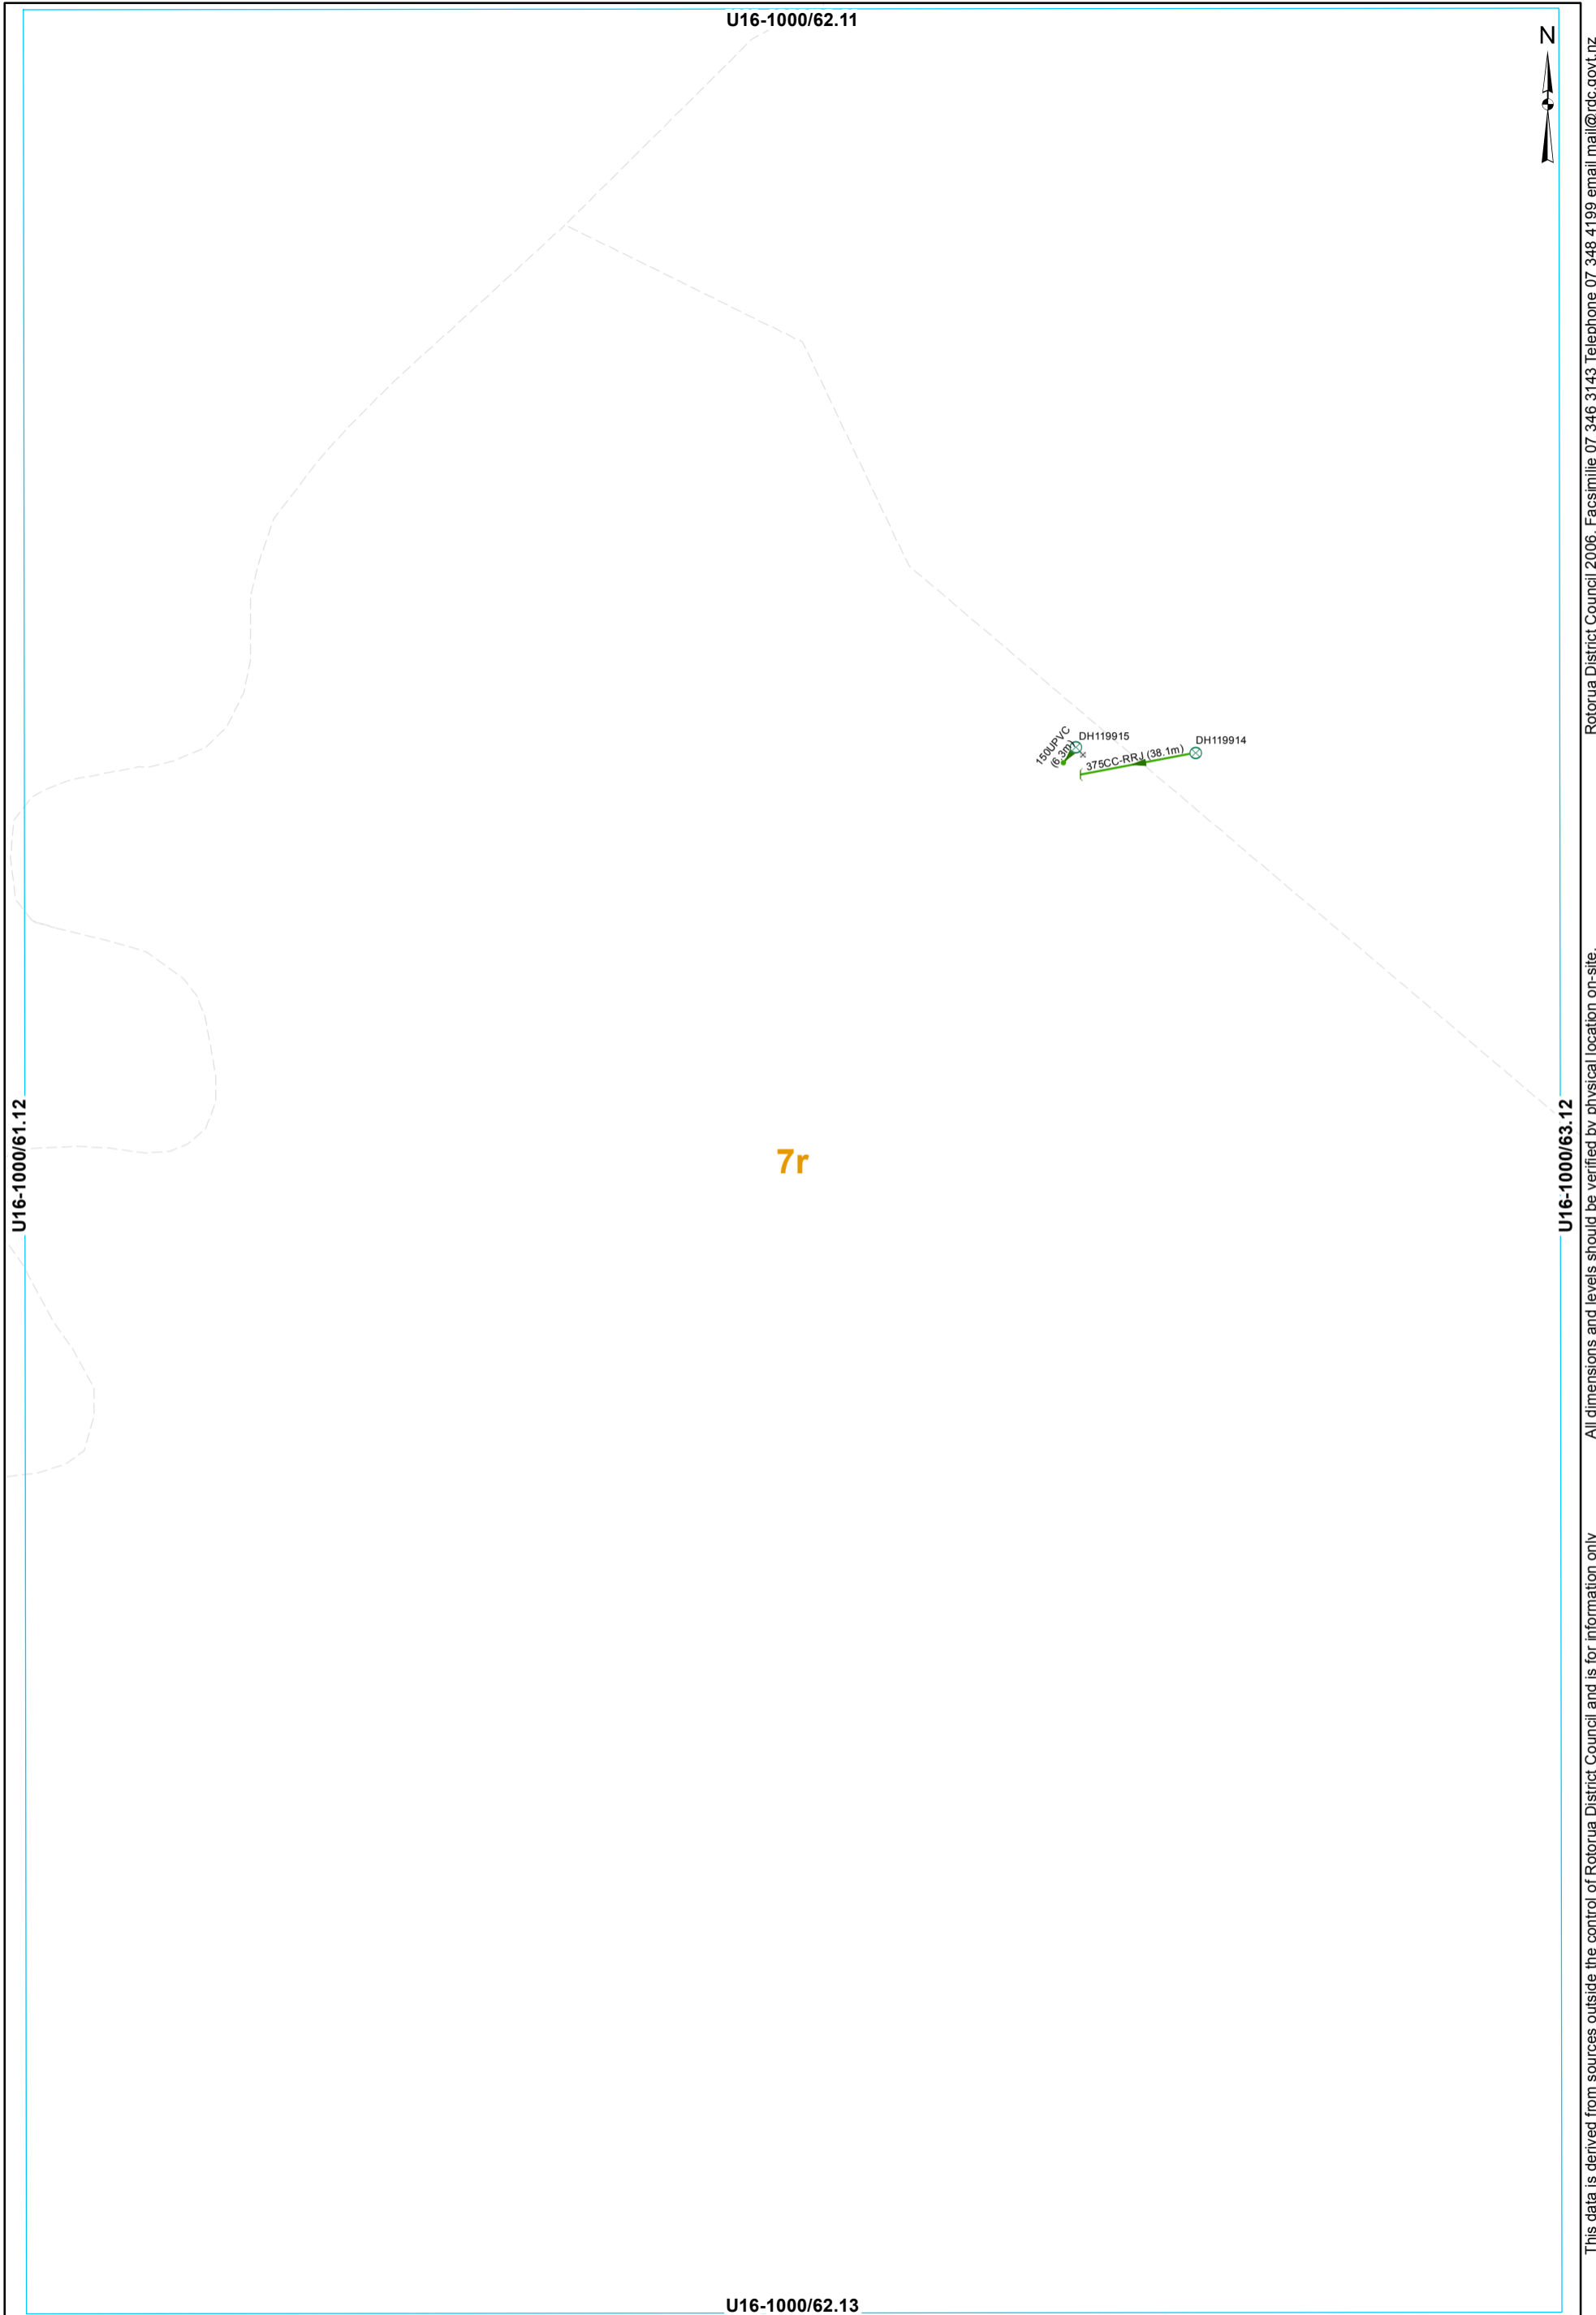


7r

- ⊗ SWManhole
- × SWInlet
- Node
- Headwall Structure
- Gravity Main
- SWLead

STORMWATER SERVICES  
1:2000 @ A3 - (U16-1000/62.12)

This data is derived from sources outside the control of Rotorua District Council and is for information only

Rotorua District Council 2006. Facsimile 07 346 3143 Telephone 07 348 4199 email mail@rdc.govt.nz

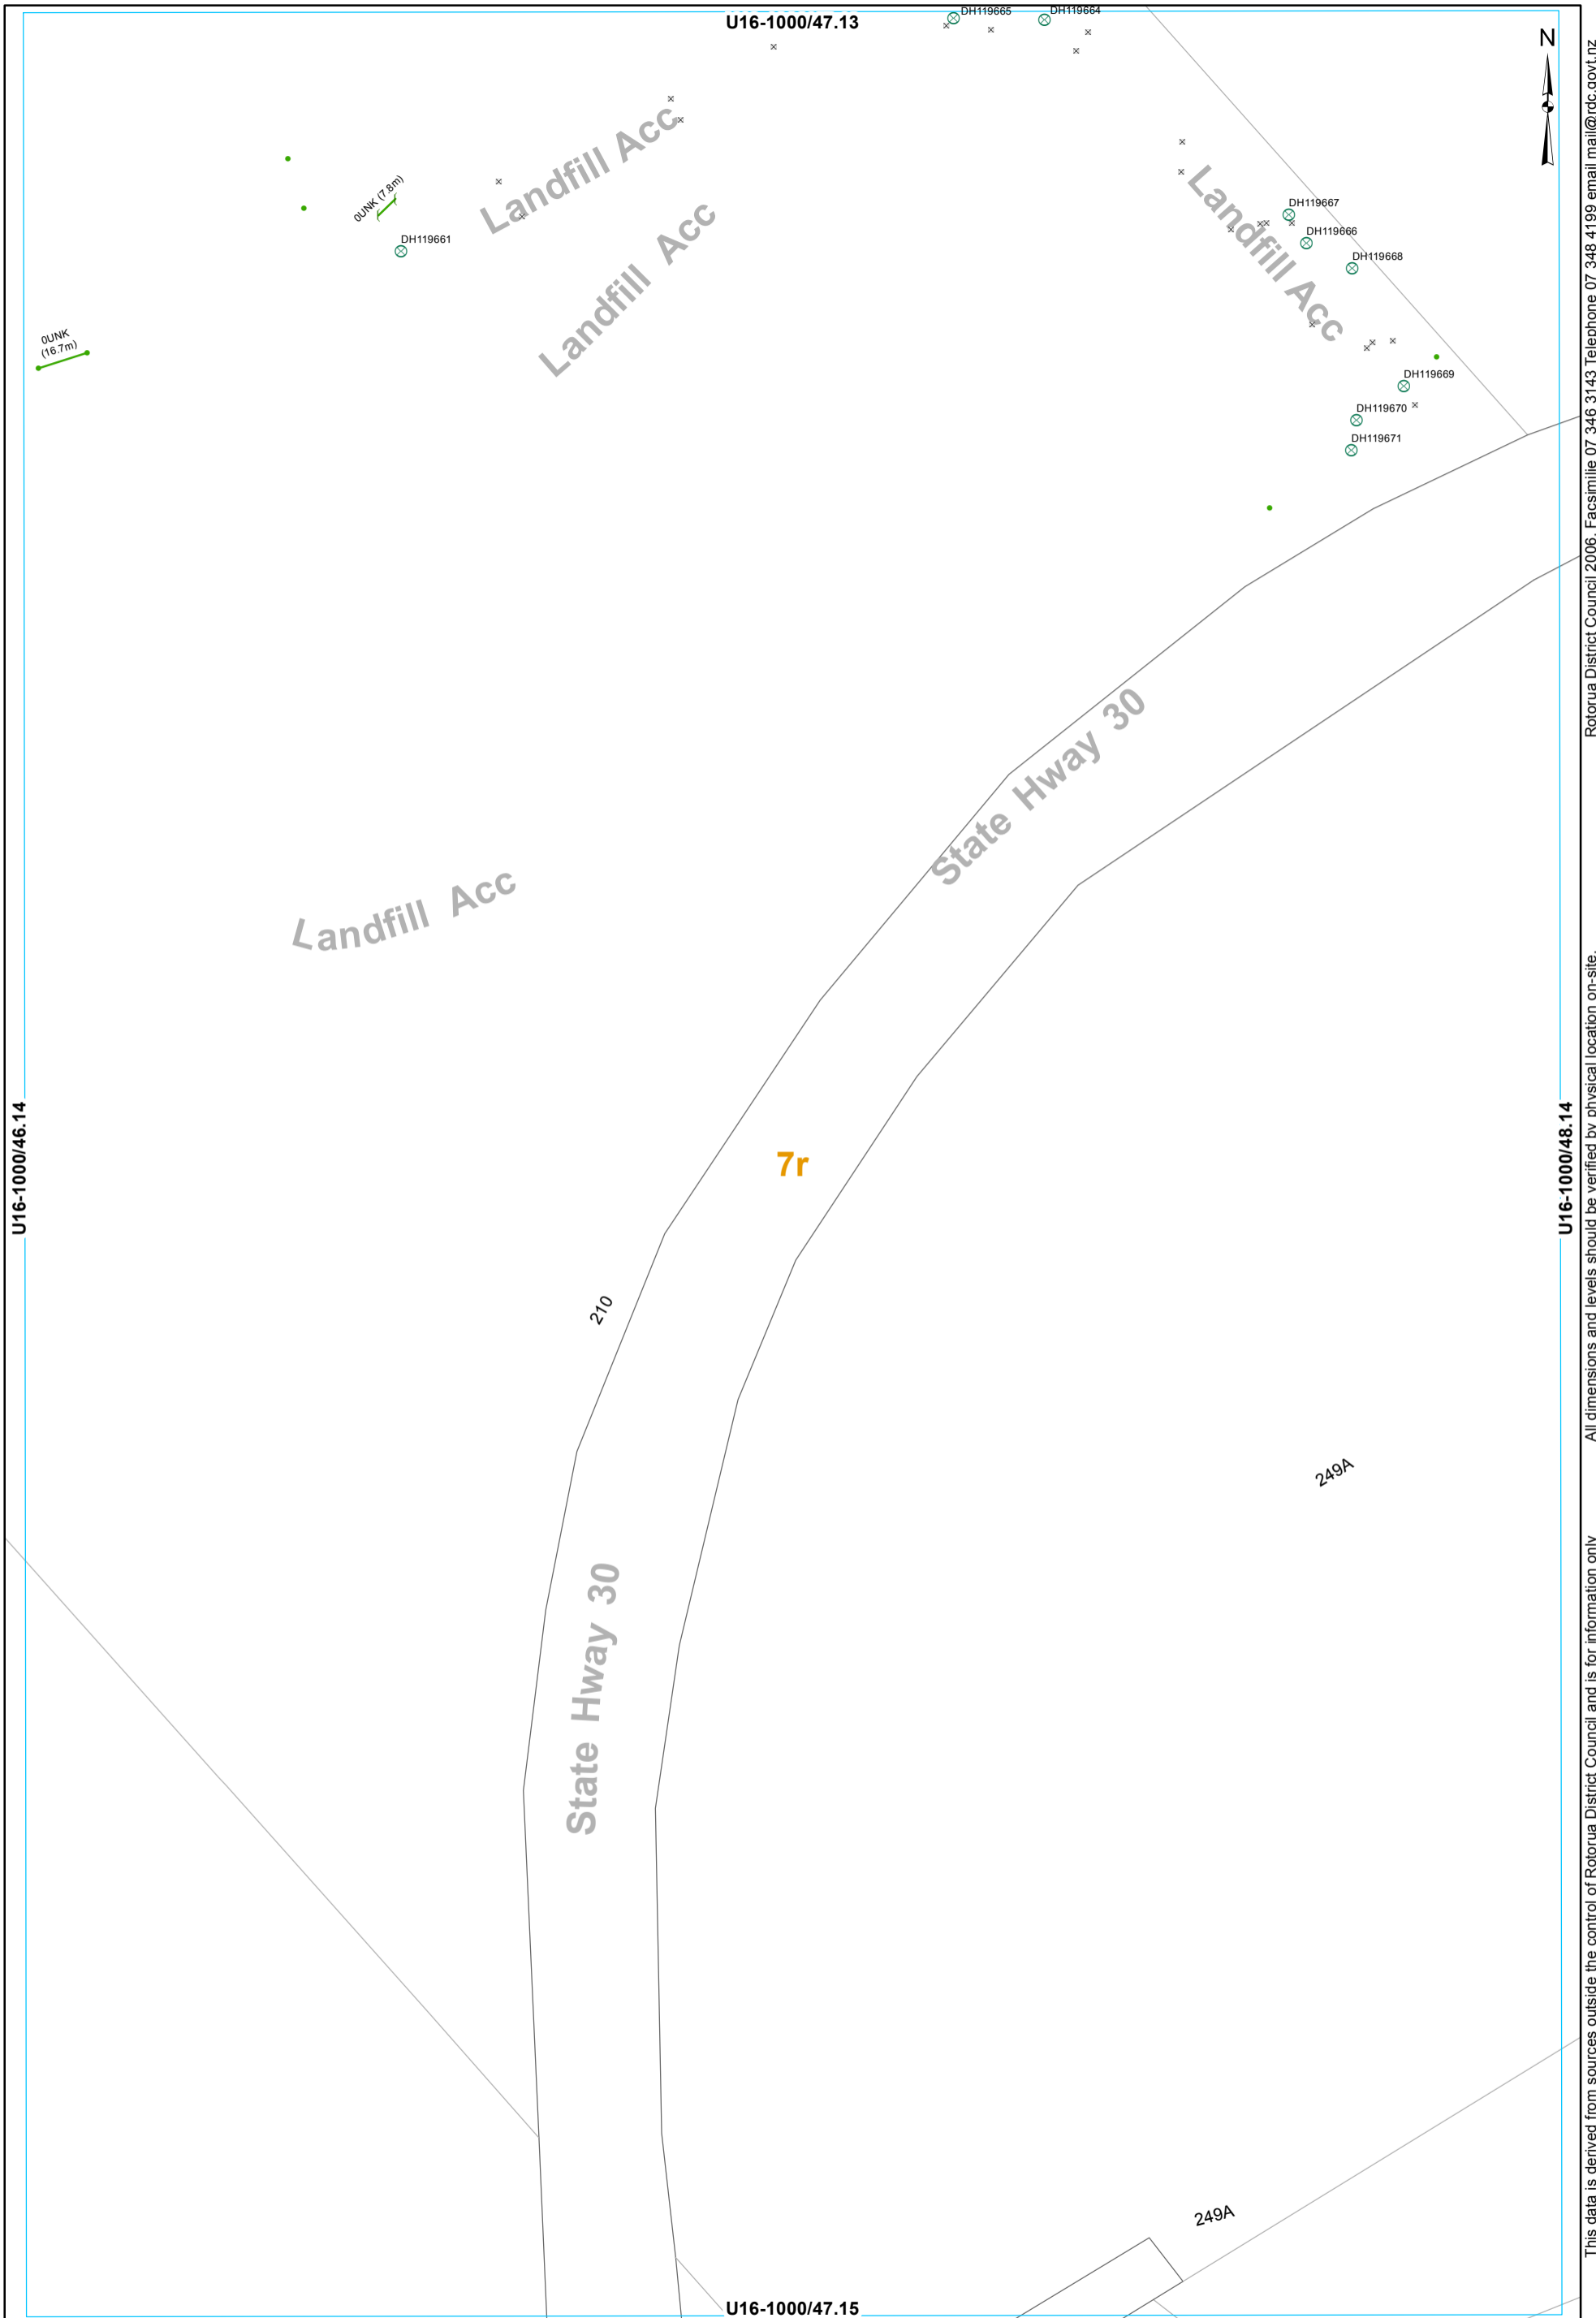

- ⊗ SWManhole
- × SWInlet
- Node
- Headwall Structure
- Culvert

**STORMWATER SERVICES**  
**1:2000 @ A3 - (U16-1000/47.14)**

This data is derived from sources outside the control of Rotorua District Council and is for information only

Rotorua District Council 2006. Facsimile 07 346 3143 Telephone 07 348 4199 email mail@rdc.govt.nz