


Storm Water Asbuil Sheet Index
SWcatchment 9u

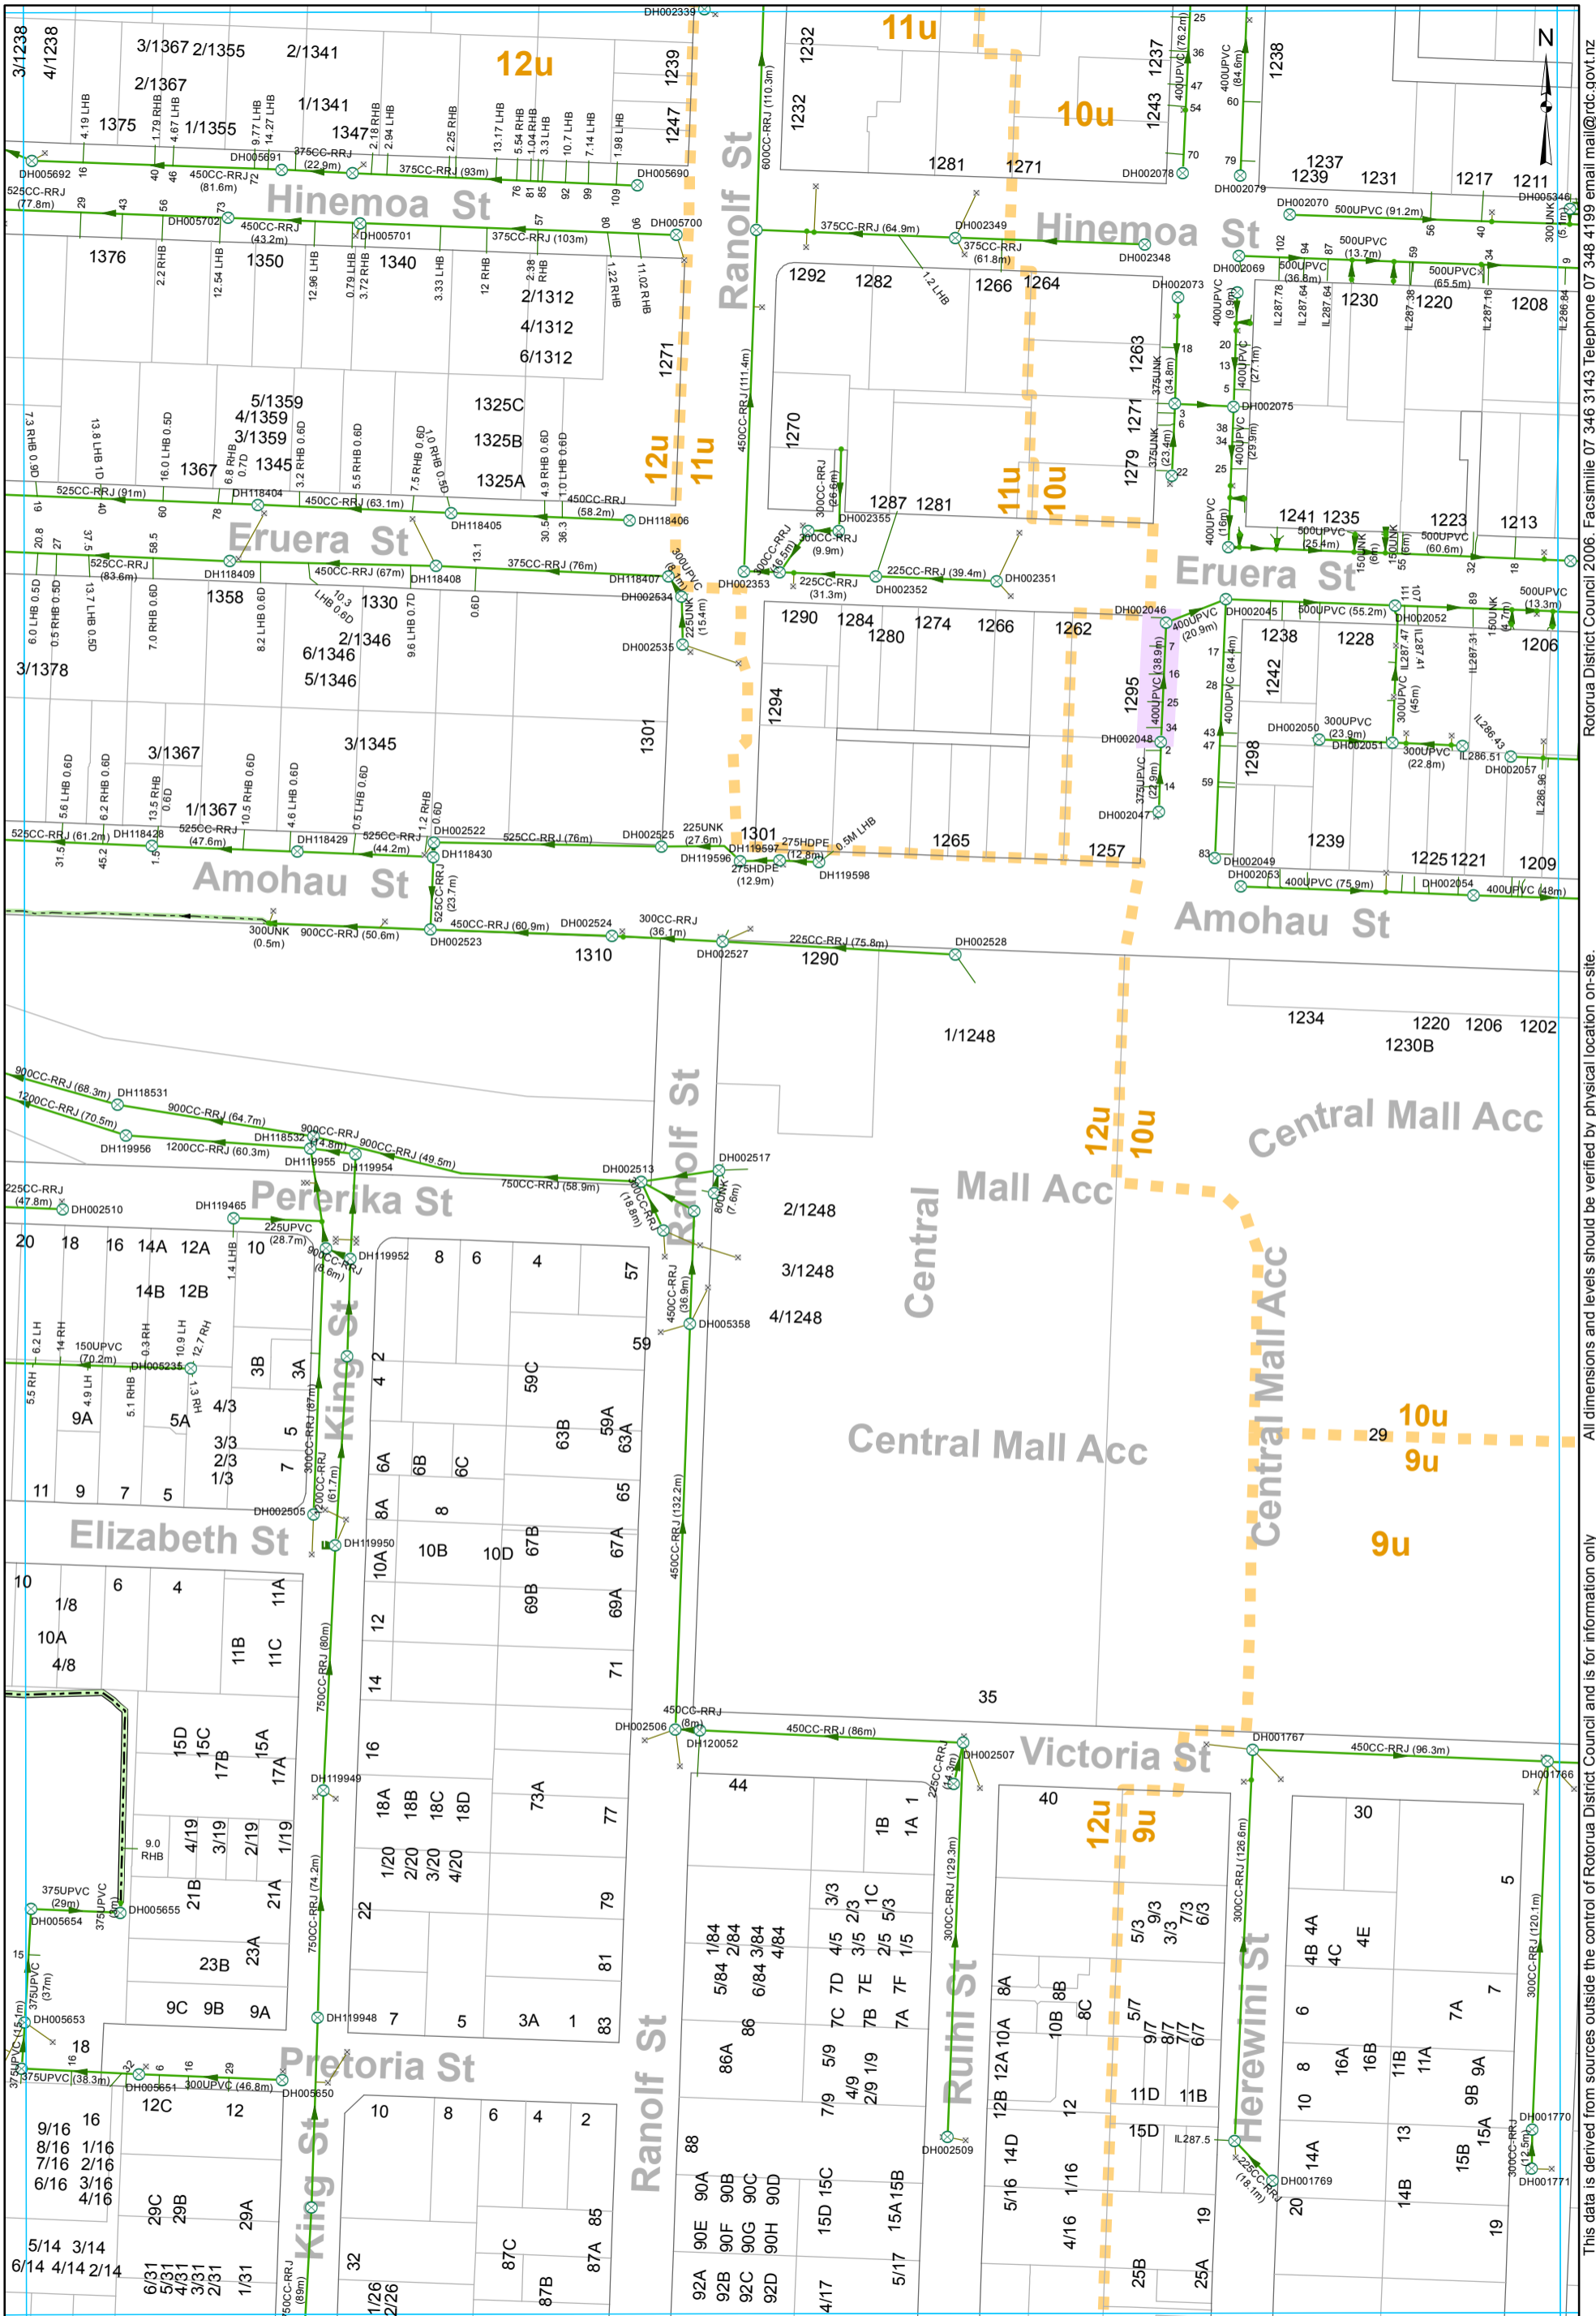


- ⊗ SWManhole
- × SWInlet
- Node
- ⌈ Capped End
- ▬ Lined Channel
- ▬ Open Drain
- Gravity Main
- SWServiceline
- SWServiceline
- SWLead
- ▬ Catchment Boundary

STORMWATER SERVICES
1:2000 @ A3 - (U16-1000/50.07)

This data is derived from sources outside the control of Rotorua District Council and is for information only.

All dimensions and levels should be verified by physical location on-site.

Rotorua District Council 2006. Facsimile 07 346 3143 Telephone 07 348 4199 email mail@rdc.govt.nz

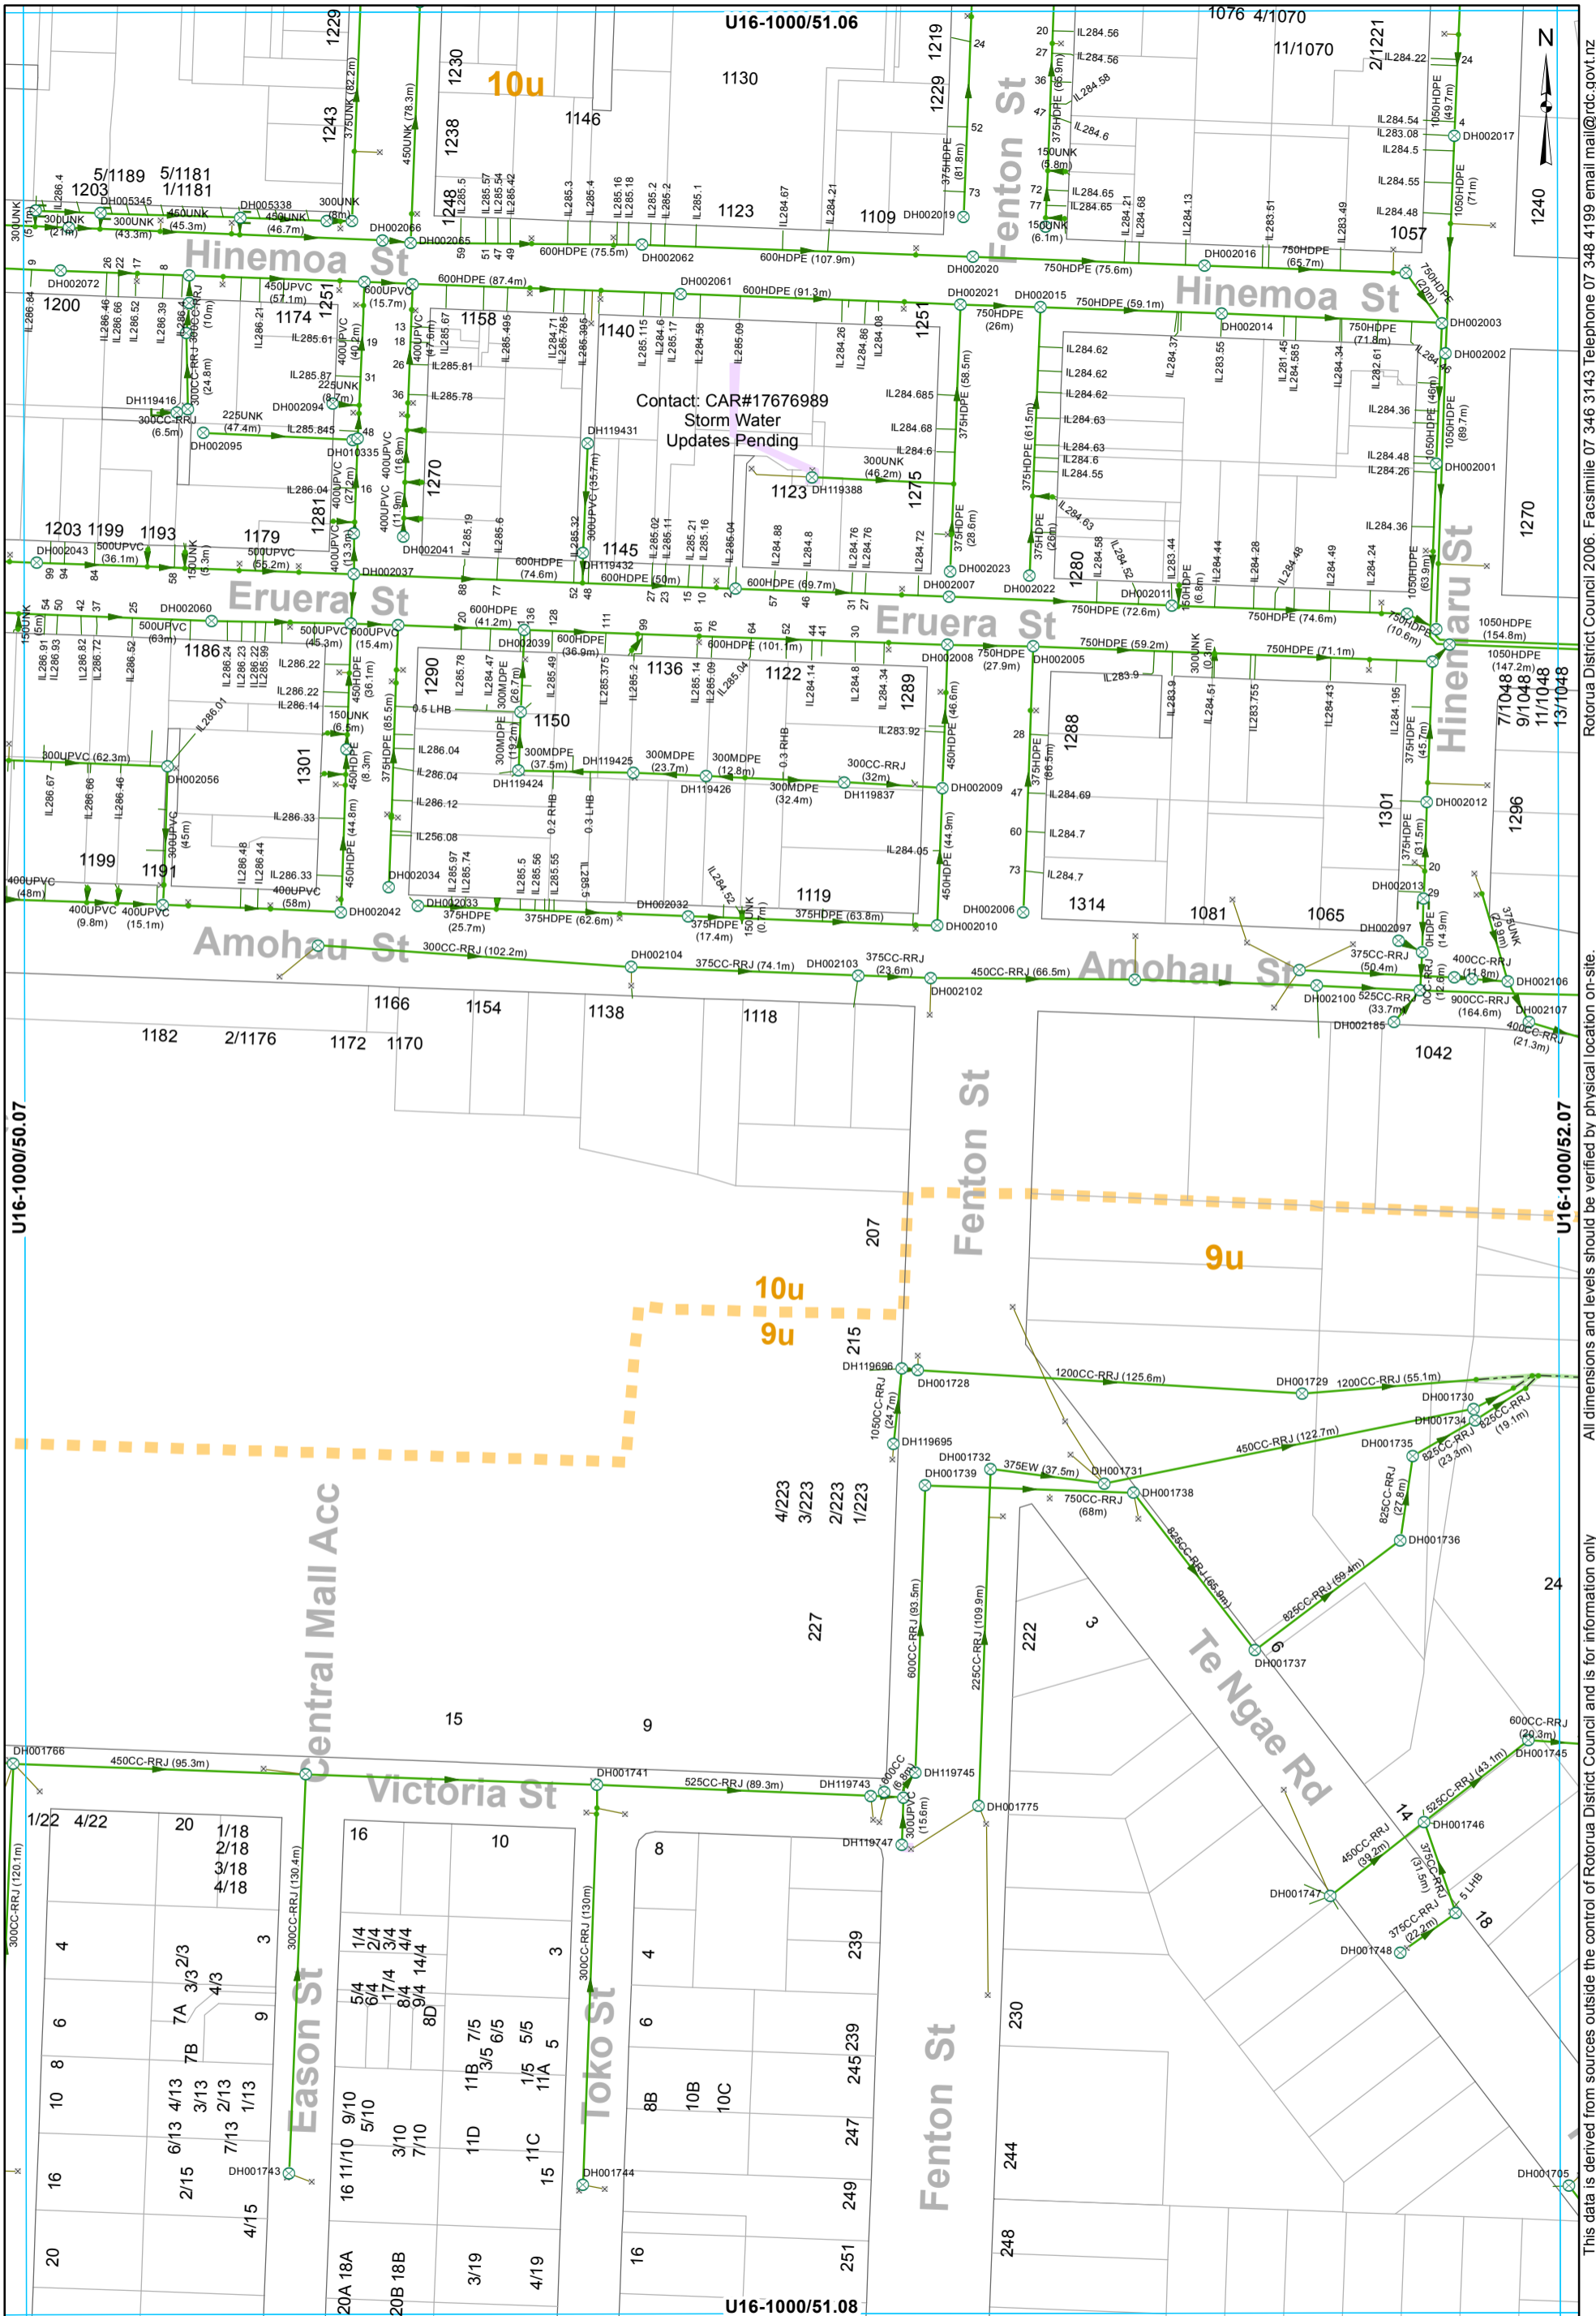


All dimensions and levels should be verified by physical location on-site.

Rotorua District Council 2006. Facsimile 07 346 3143 Telephone 07 348 4199 email mail@rdc.govt.nz

- ⊗ SWManhole
- × SWInlet
- Node
- ┌ Capped End
- Open Drain
- Gravity Main
- SWServiceline
- SWServiceline
- SWLead
- Catchment Boundary

STORMWATER SERVICES
1:2000 @ A3 - (U16-1000/51.07)

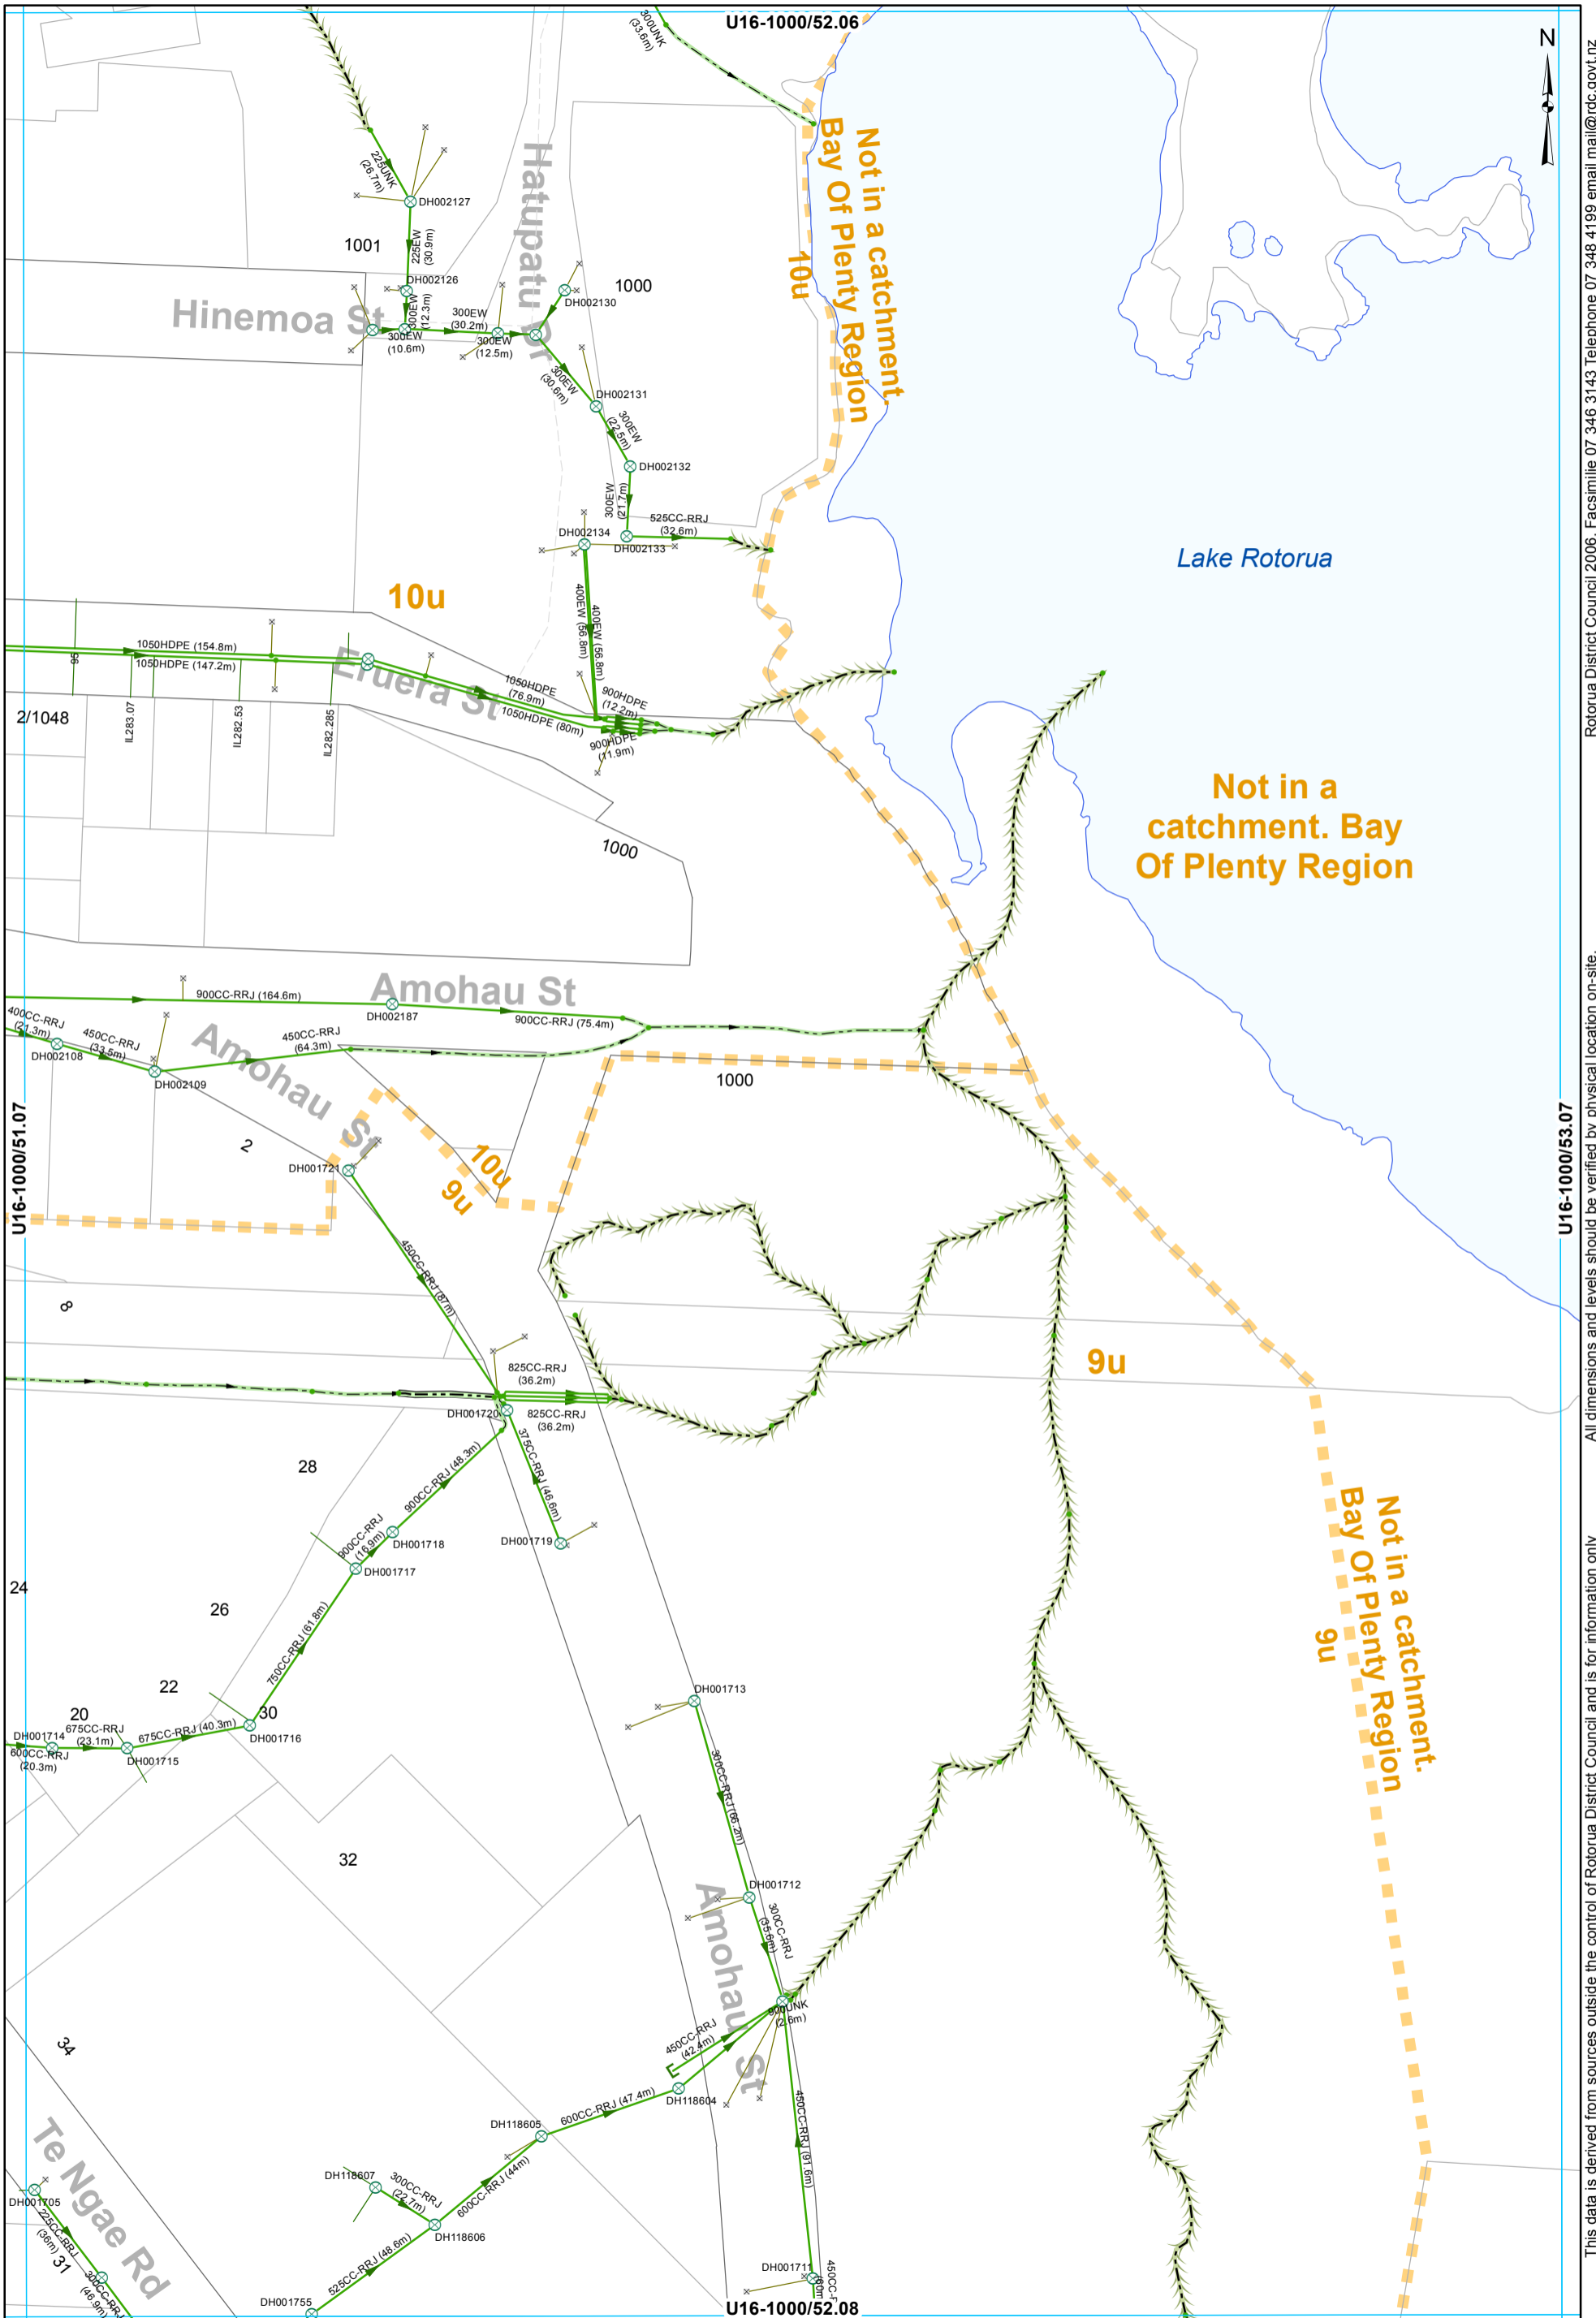

- ⊗ SWManhole
- ⊗ SWInlet
- Node
- ⌈ Capped End
- Lined Channel
- Open Drain
- Overland Flow
- Culvert
- Gravity Main
- SWServiceline
- SWServiceline
- SWLead
- Catchment Boundary

STORMWATER SERVICES
1:2000 @ A3 - (U16-1000/52.07)



- ⊗ SWManhole
- ⊗ SWInlet
- Node
- Gravity Main
- - - Subsoil Drain
- SWServiceline
- SWServiceline
- SWLead
- Catchment Boundary

STORMWATER SERVICES
1:2000 @ A3 - (U16-1000/50.08)

All dimensions and levels should be verified by physical location on-site. This data is derived from sources outside the control of Rotorua District Council and is for information only.

Rotorua District Council 2006. Facsimile 07 346 3143 Telephone 07 348 4199 email mail@rdc.govt.nz




- ⊗ SWManhole — Gravity Main SWServiceline
- × SWInlet — SWServiceline
- Node — SWLead
- ◻ Capped End — Catchment Boundary

STORMWATER SERVICES
1:2000 @ A3 - (U16-1000/51.08)

This data is derived from sources outside the control of Rotorua District Council and is for information only

U16-1000/52.08

Rotorua District Council 2006. Facsimile 07 346 3143 Telephone 07 348 4199 email mail@rdc.govt.nz

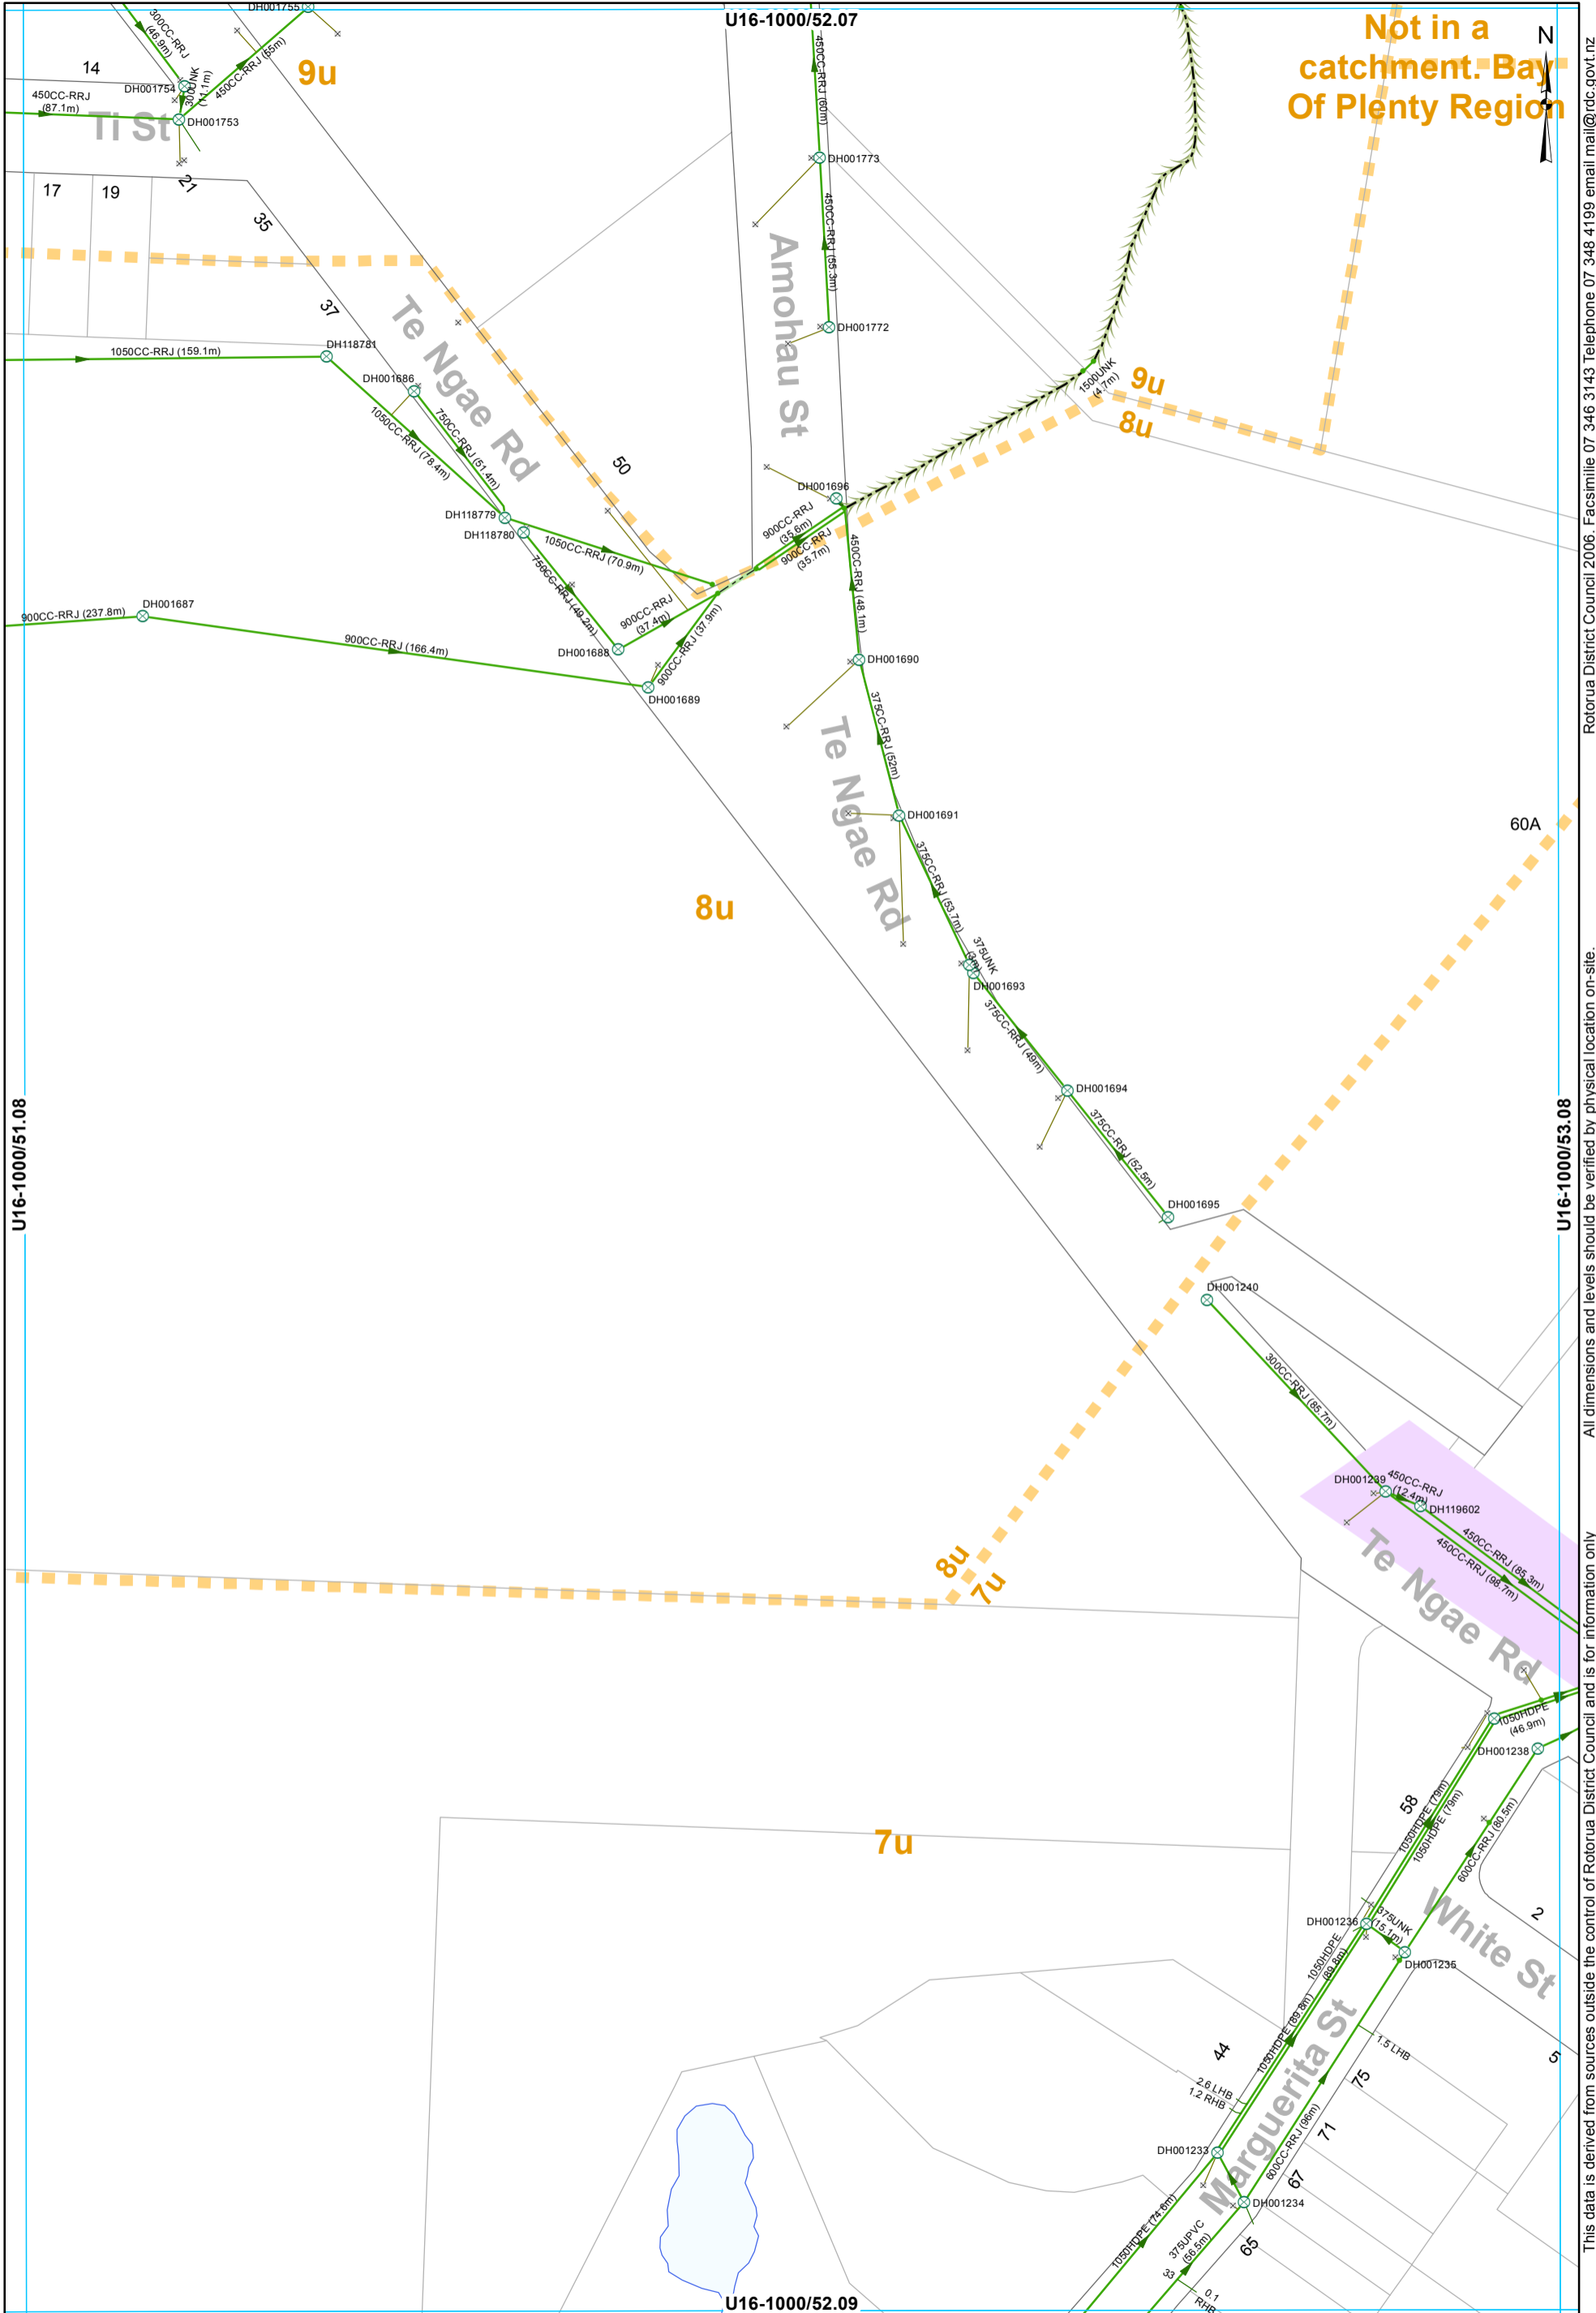

Not in a catchment. Bay Of Plenty Region

Rotorua District Council 2006. Facsimile 07 346 3143 Telephone 07 348 4199 email mail@rdc.govt.nz

All dimensions and levels should be verified by physical location on-site.

This data is derived from sources outside the control of Rotorua District Council and is for information only

- ⊗ SWManhole
- × SWInlet
- Node
- Open Drain
- Overland Flow
- Culvert
- Gravity Main
- SWServiceline
- SWServiceline
- SWLead
- Catchment Boundary

STORMWATER SERVICES
1:2000 @ A3 - (U16-1000/52.08)