


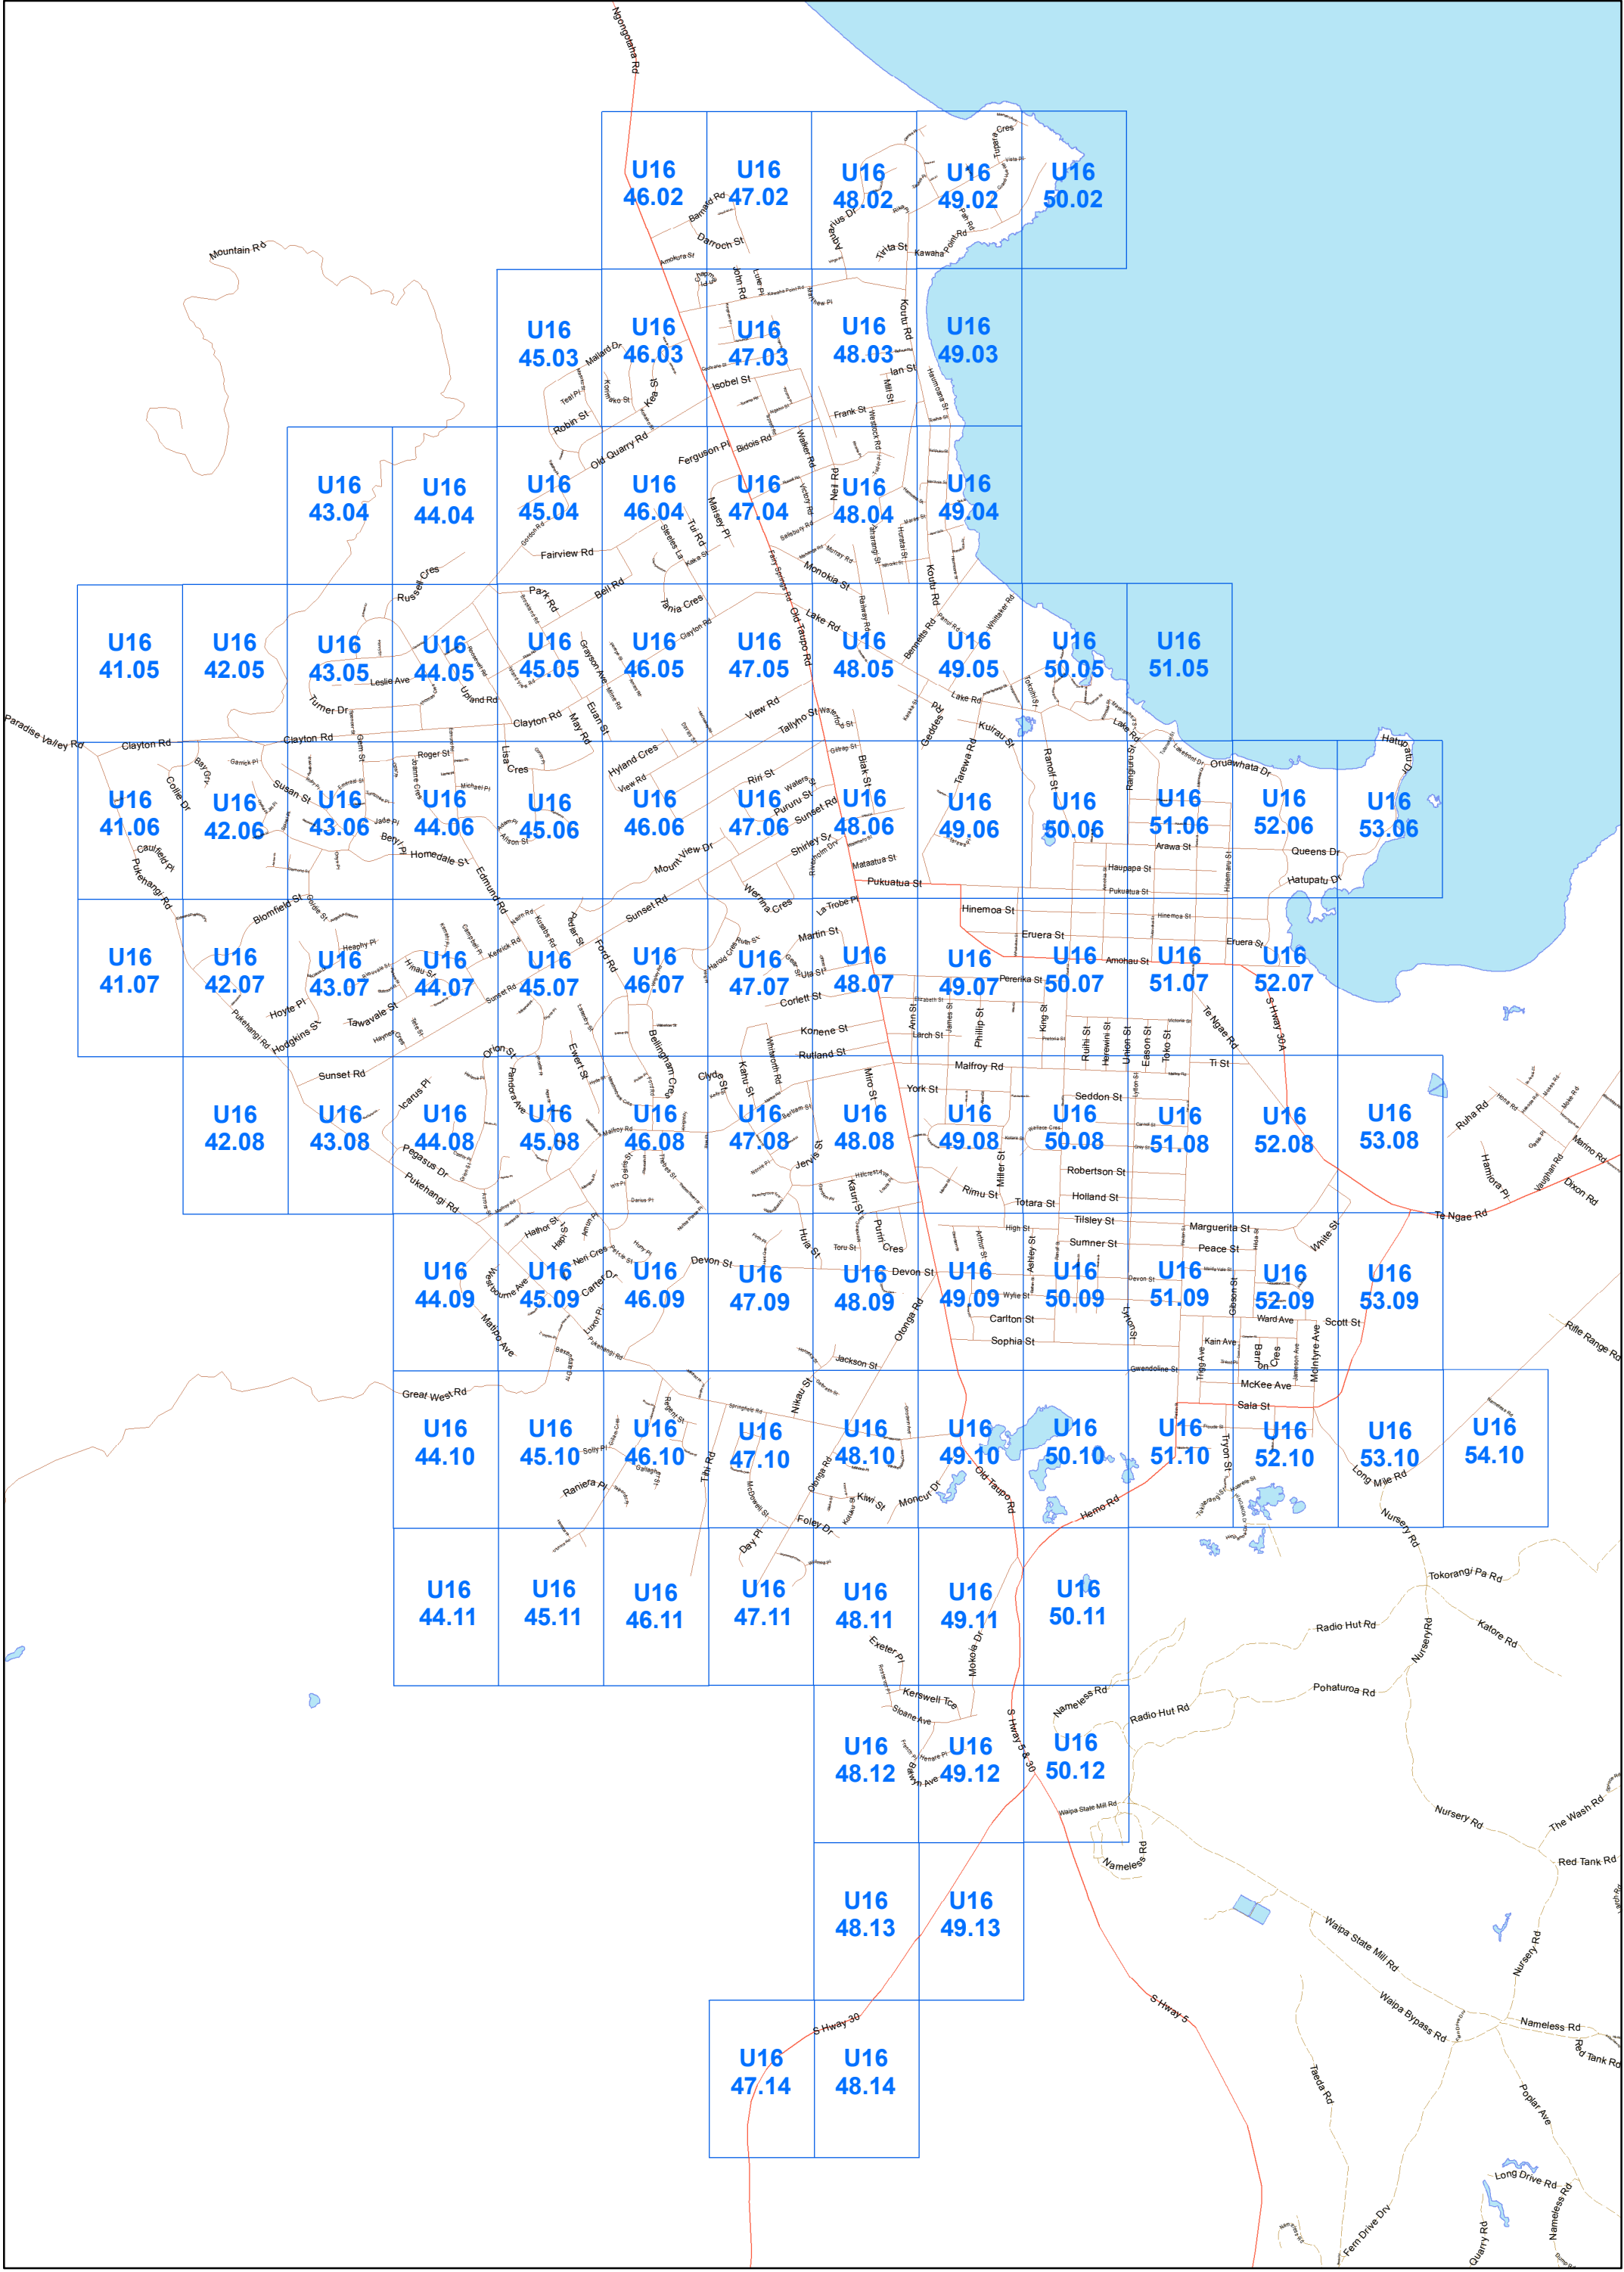

Water Supply Asbuilt Sheet Index
CENTRAL

Compiled on 2023-05-02 from as-builts of various dates. For up to date as-builts please visit http://geo.rdc.govt.nz/images/plotfiles/3waters_mobile_asbuilts/




WATER SUPPLY SERVICES
1:2000 @ A3 - (U16-1000/46.02)

U16-1000/47.01



Rotorua District Council 2006. Facsimile 07 346 3143 Telephone 07 348 4199 email mail@rdc.govt.nz

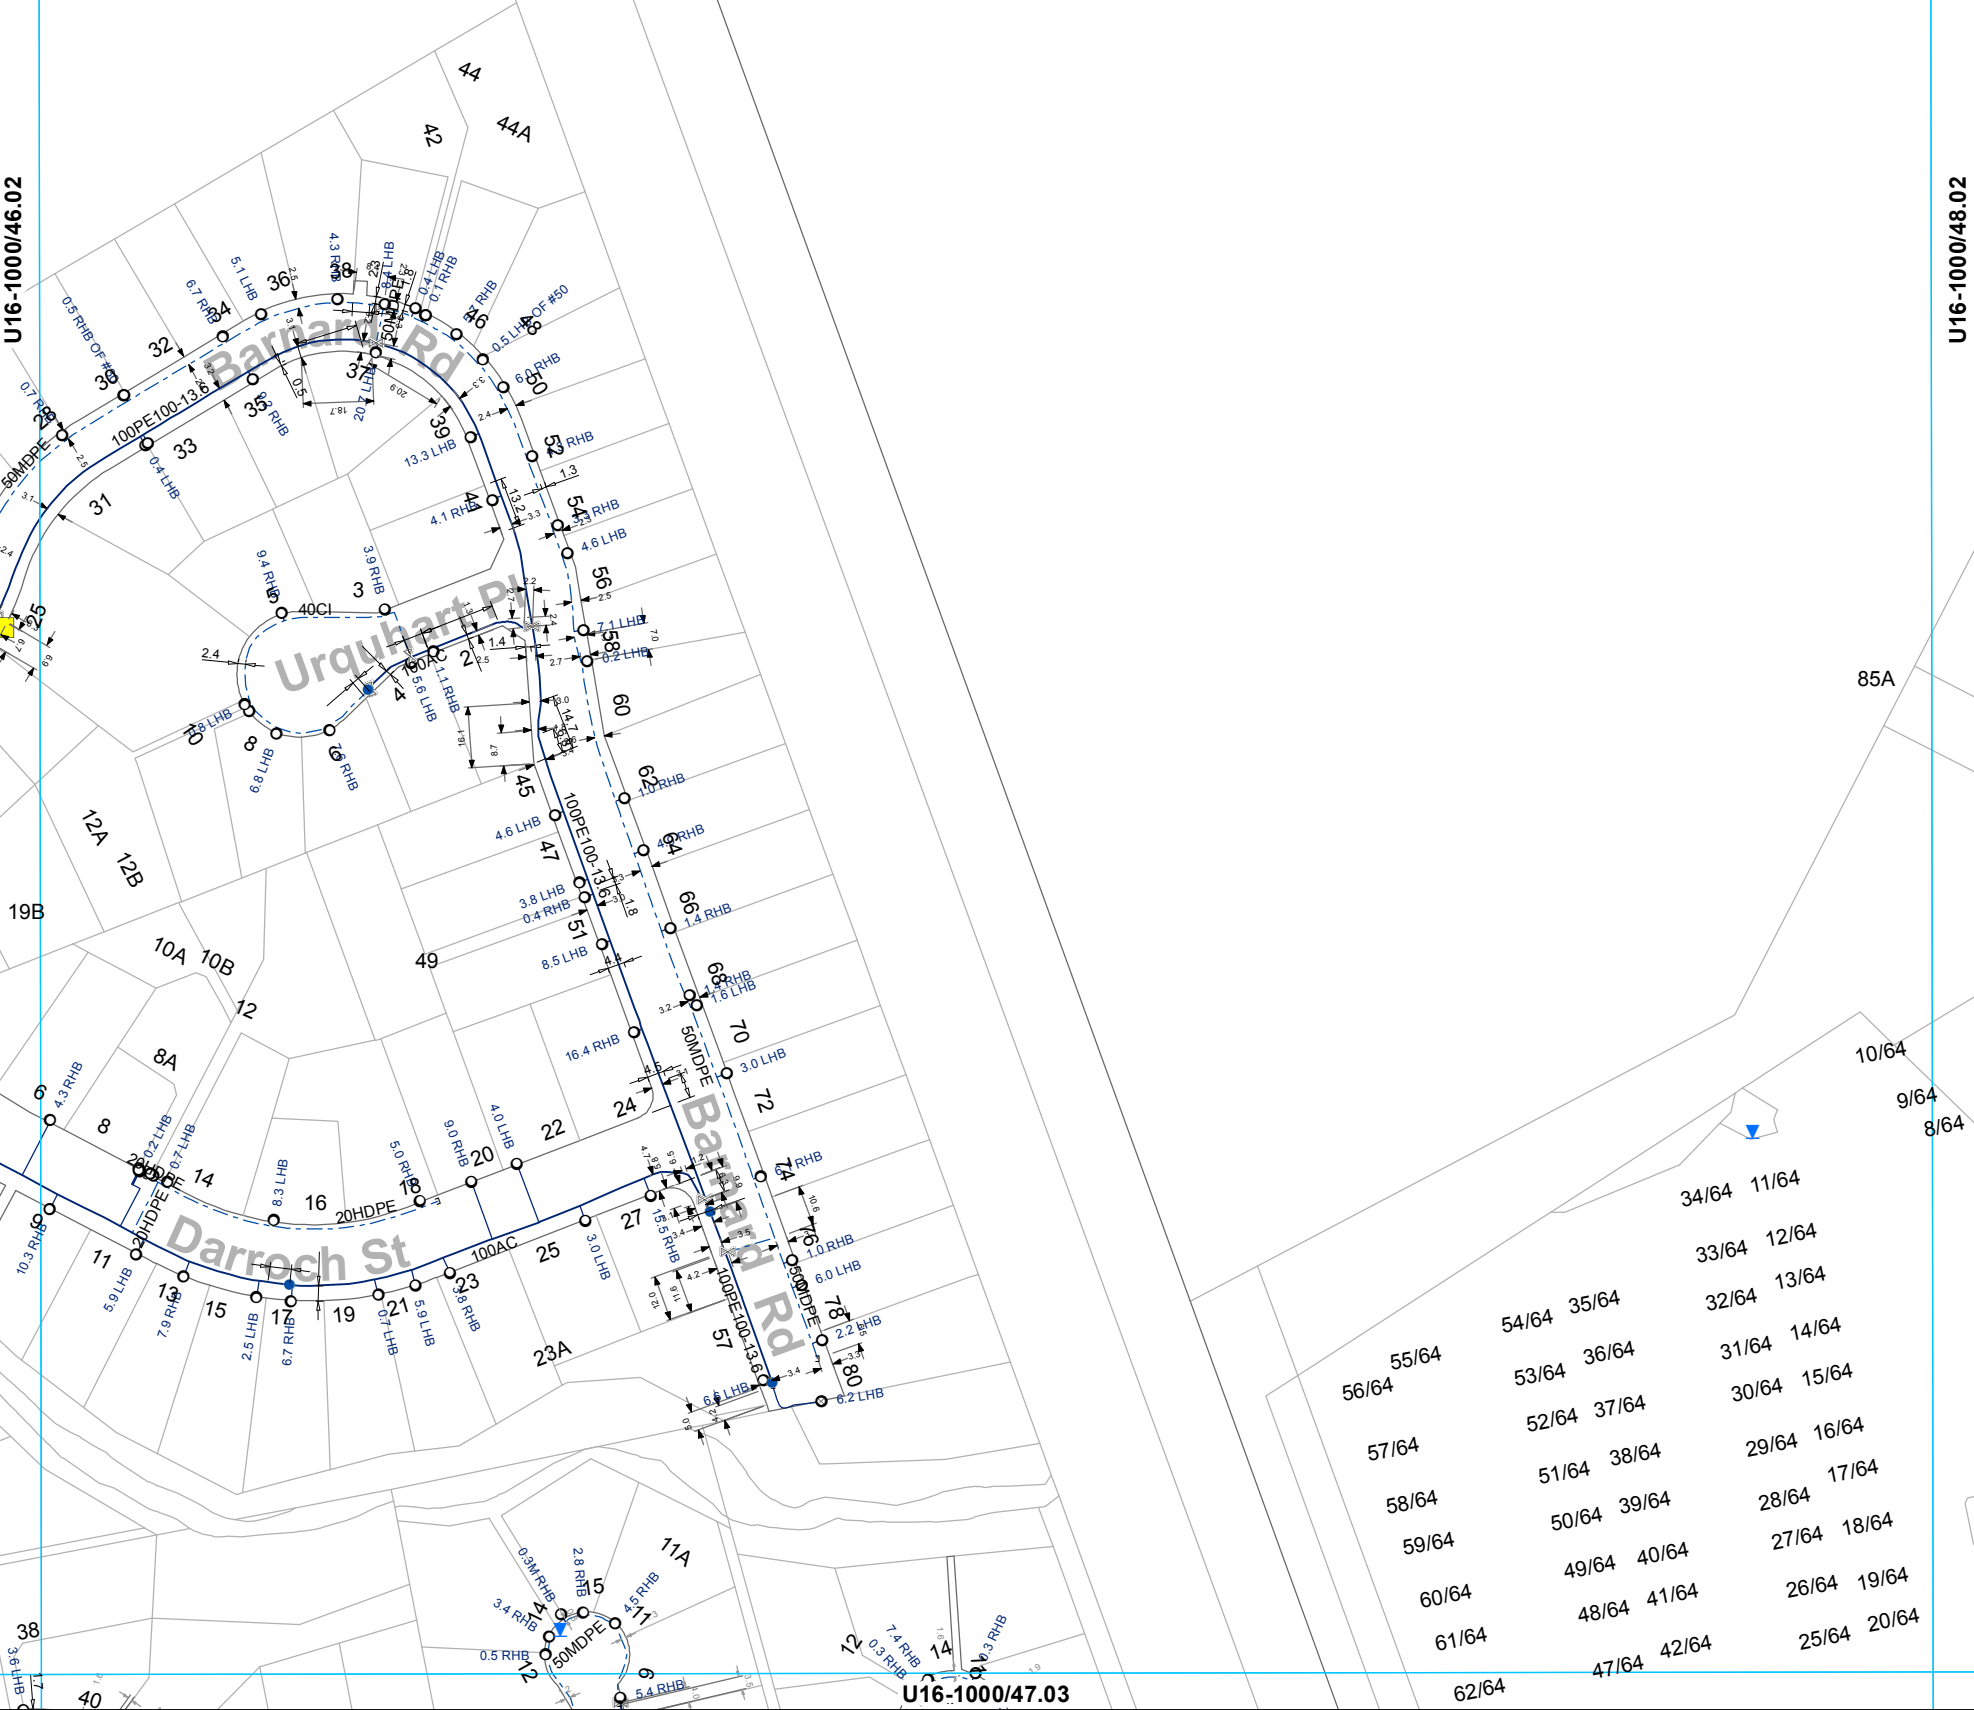

All dimensions and levels should be verified by physical location on-site.

This data is derived from sources outside the control of Rotorua District Council and is for information only

- ⌘

Valve

●

Hydrant

○

Meter Consumer

■

Miscellaneous

—

WSServiceLine

○

Toby

—


Capped End


—

Main

Rider main

WATER SUPPLY SERVICES
1:2000 @ A3 - (U16-1000/47.02)

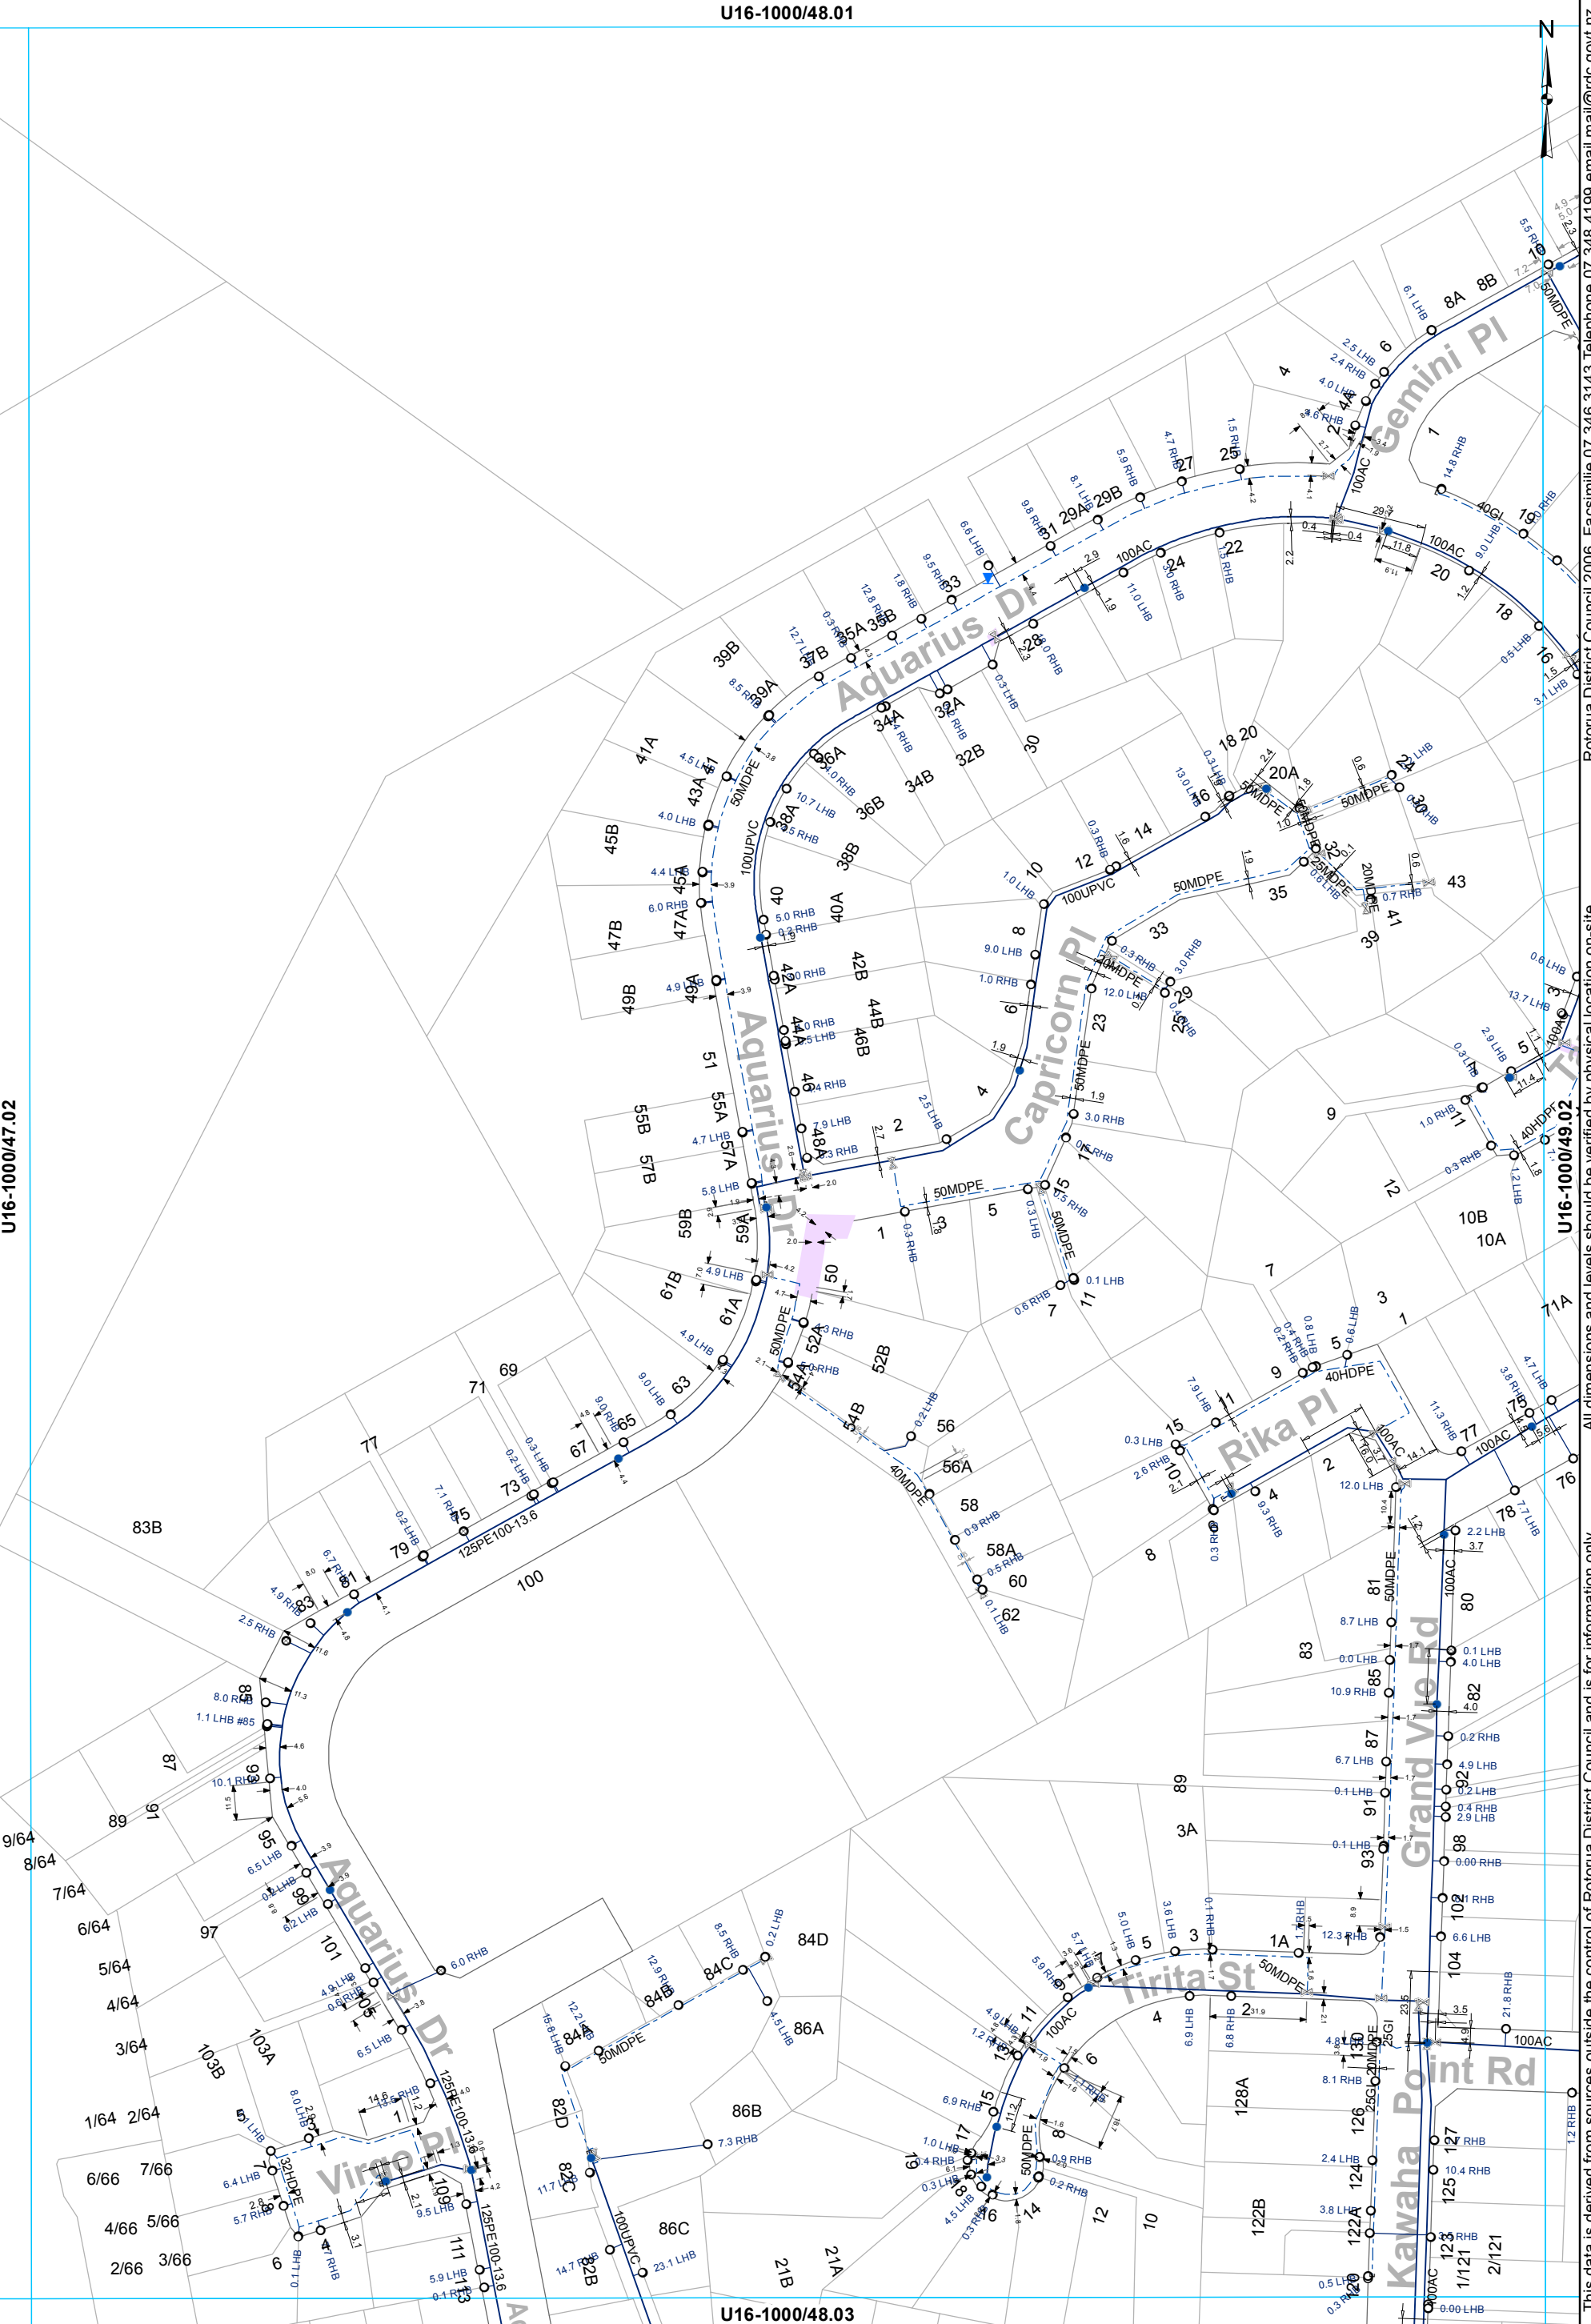

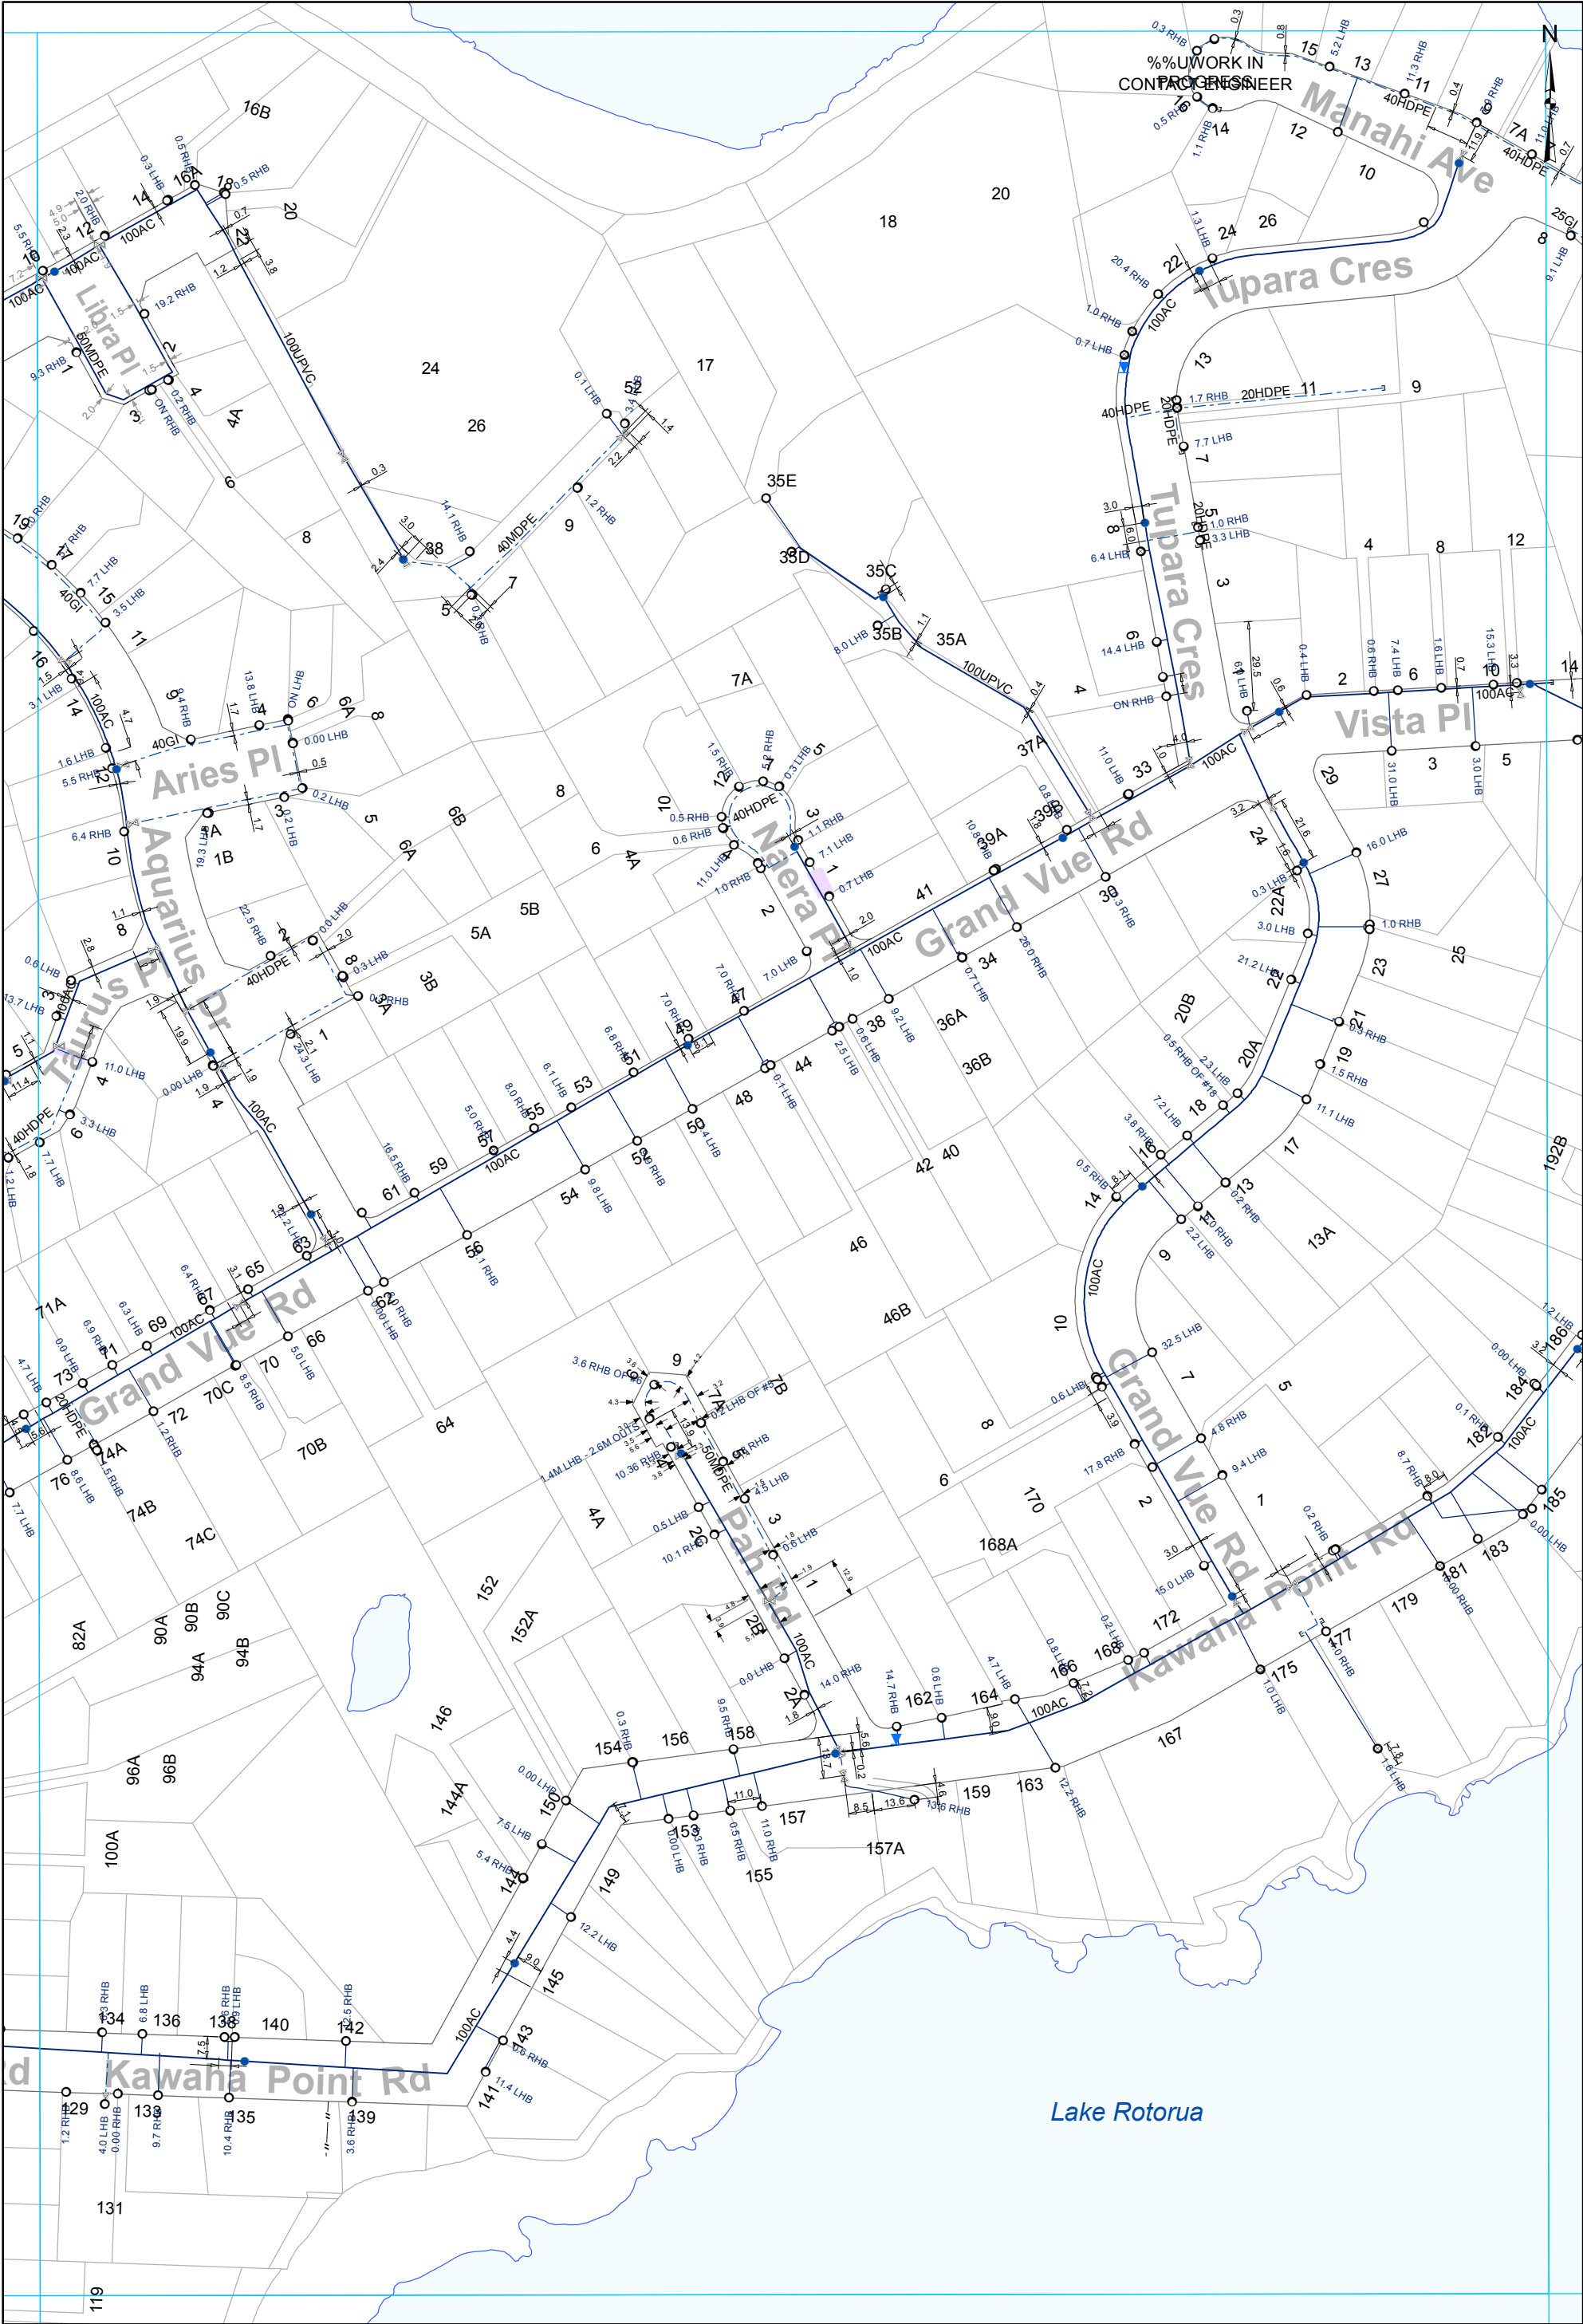

- Valve
- Hydrant
- Meter Consumer
- WSServiceLine
- Toby
- Capped End
- Main
- Rider main

WATER SUPPLY SERVICES
1:2000 @ A3 - (U16-1000/49.02)

This data is derived from sources outside the control of Rotorua District Council and is for information only

Rotorua District Council 2006. Facsimile 07 346 3143 Telephone 07 348 4199 email mail@rdc.govt.nz



This data is derived from sources outside the control of Rotorua District Council and is for information only

Rotorua District Council 2006. Facsimile 07 346 3143 Telephone 07 348 4199 email mail@rdc.govt.nz


WATER SUPPLY SERVICES
1:2000 @ A3 - (U16-1000/50.02)



WATER SUPPLY SERVICES
1:2000 @ A3 - (U16-1000/45.03)




WATER SUPPLY SERVICES
1:2000 @ A3 - (U16-1000/46.03)

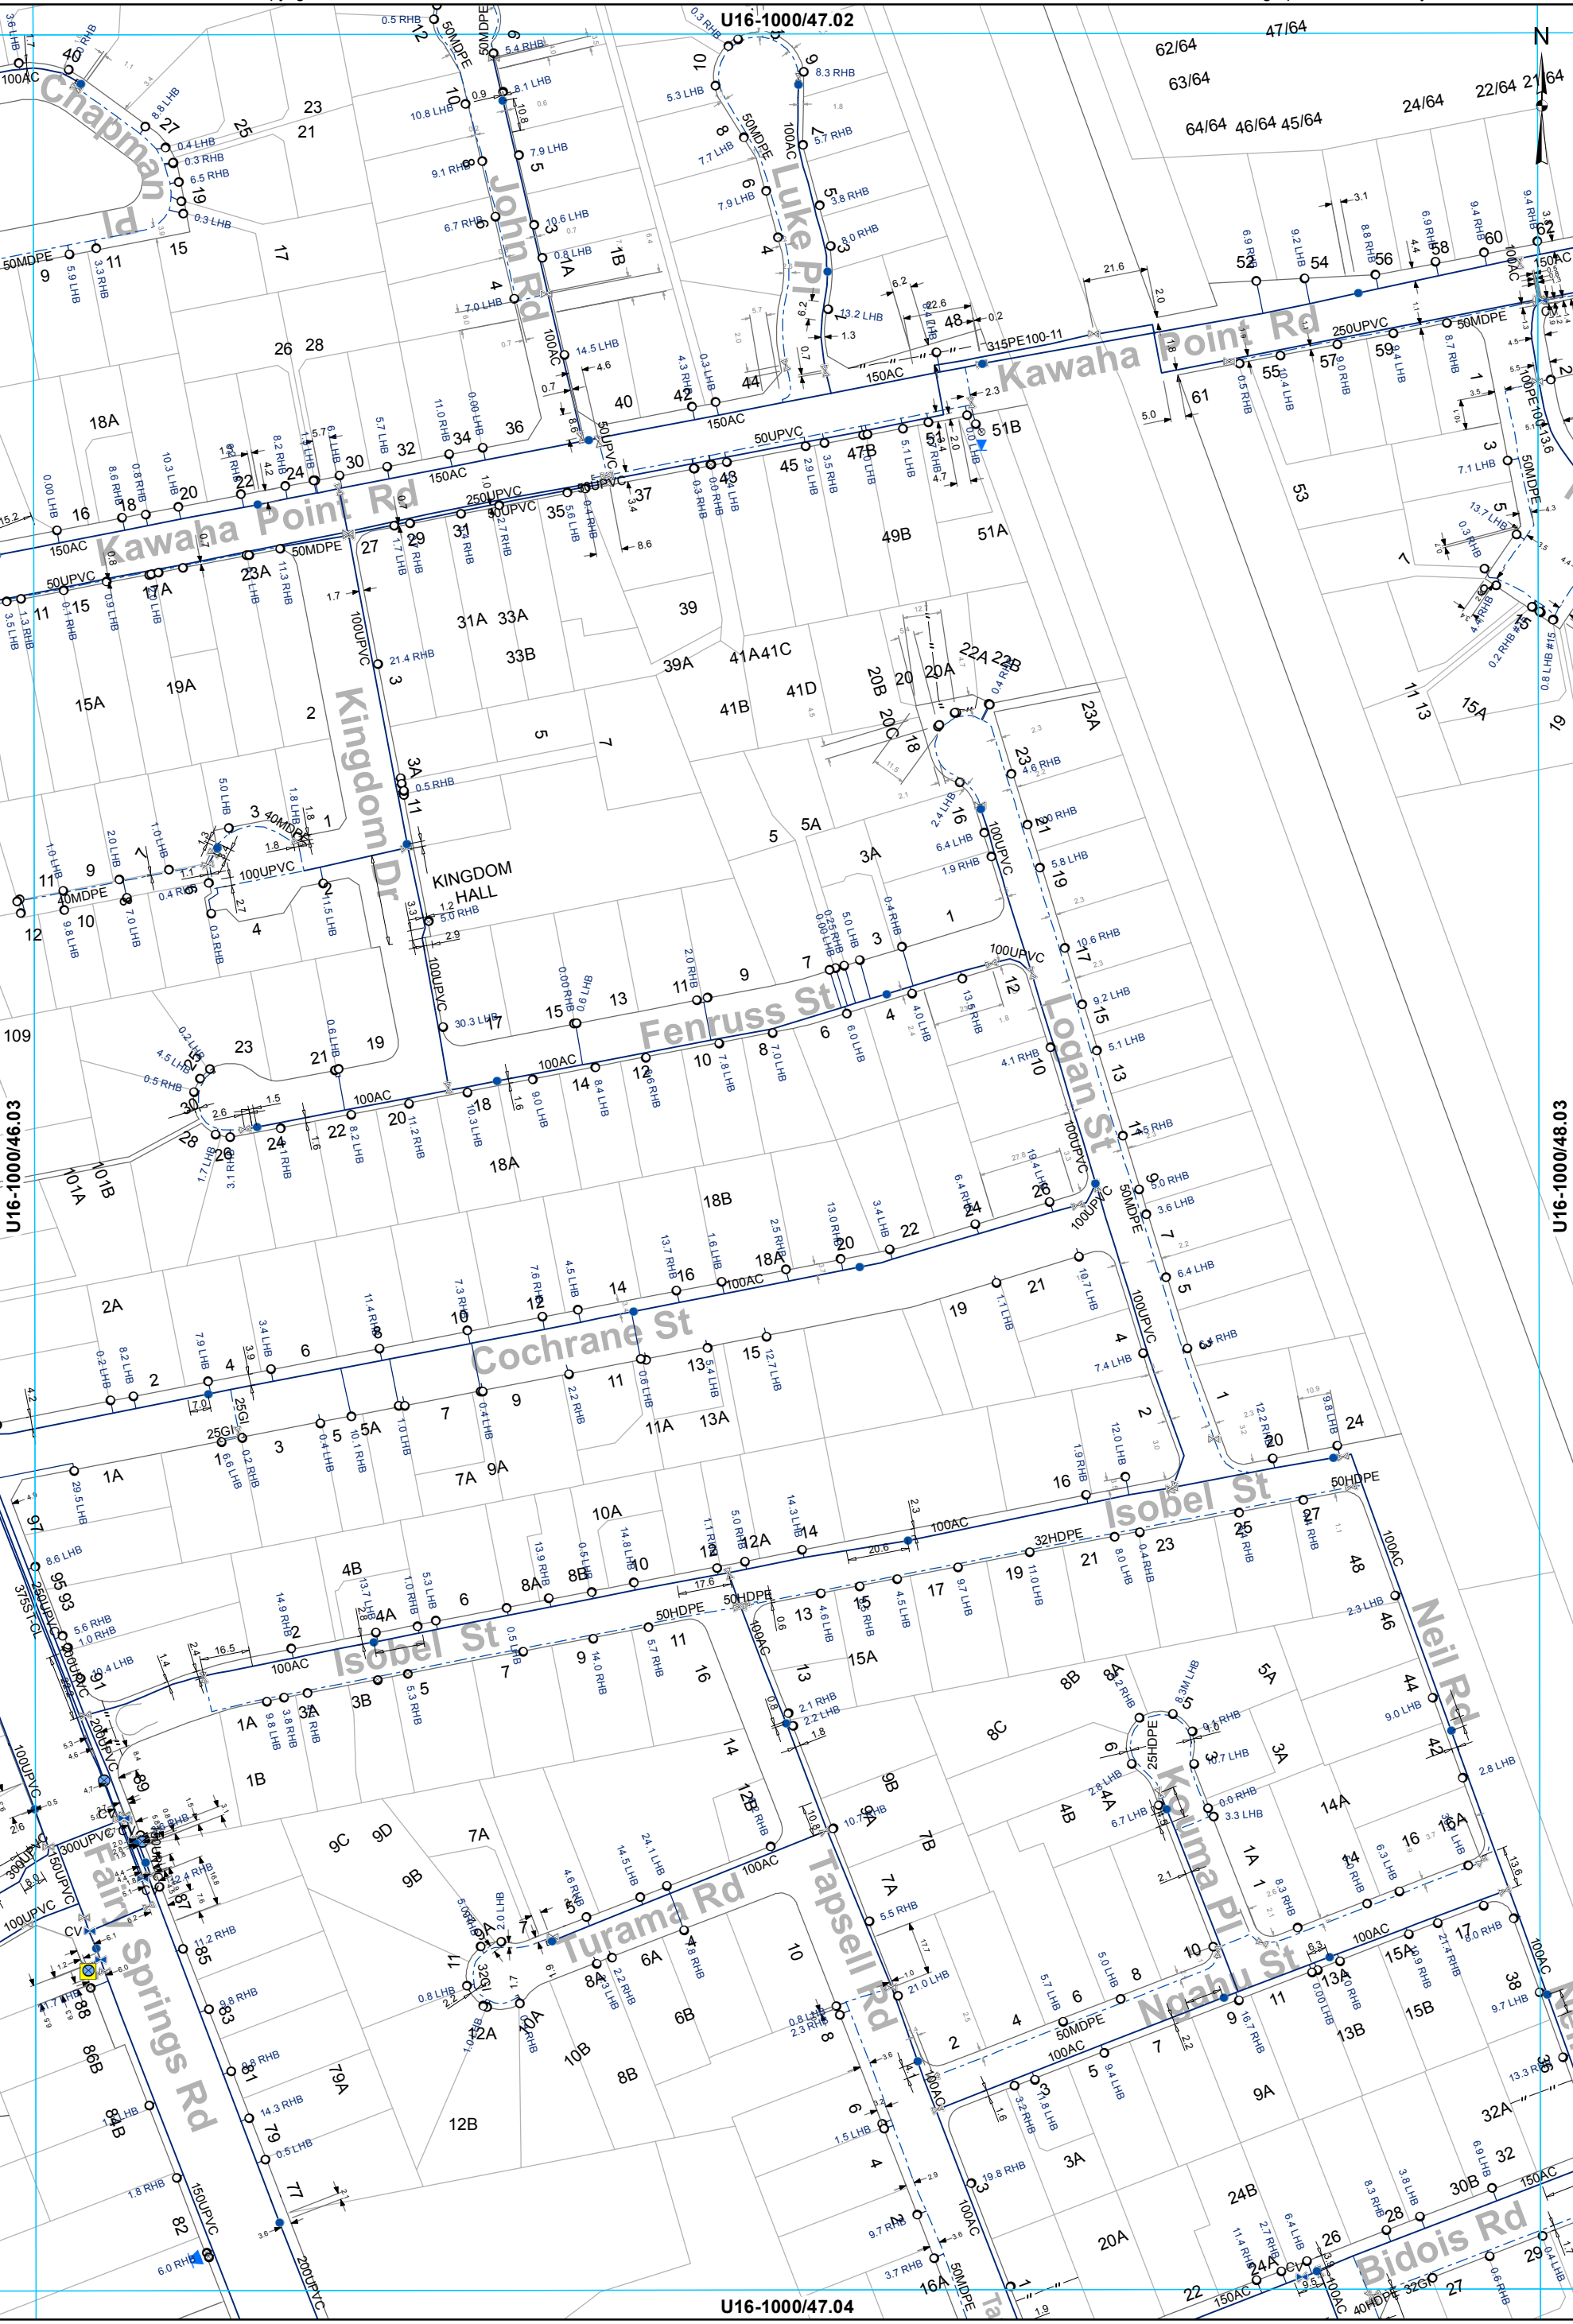

- | | | | | |
|--------------|---------|----------------|---------------|---------------|
| Valve | Hydrant | Meter Bulk | Miscellaneous | WSServiceLine |
| Toby | | Meter Consumer | | Main |
| Closed Valve | | Capped End | | Rider main |

WATER SUPPLY SERVICES
1:2000 @ A3 - (U16-1000/47.03)

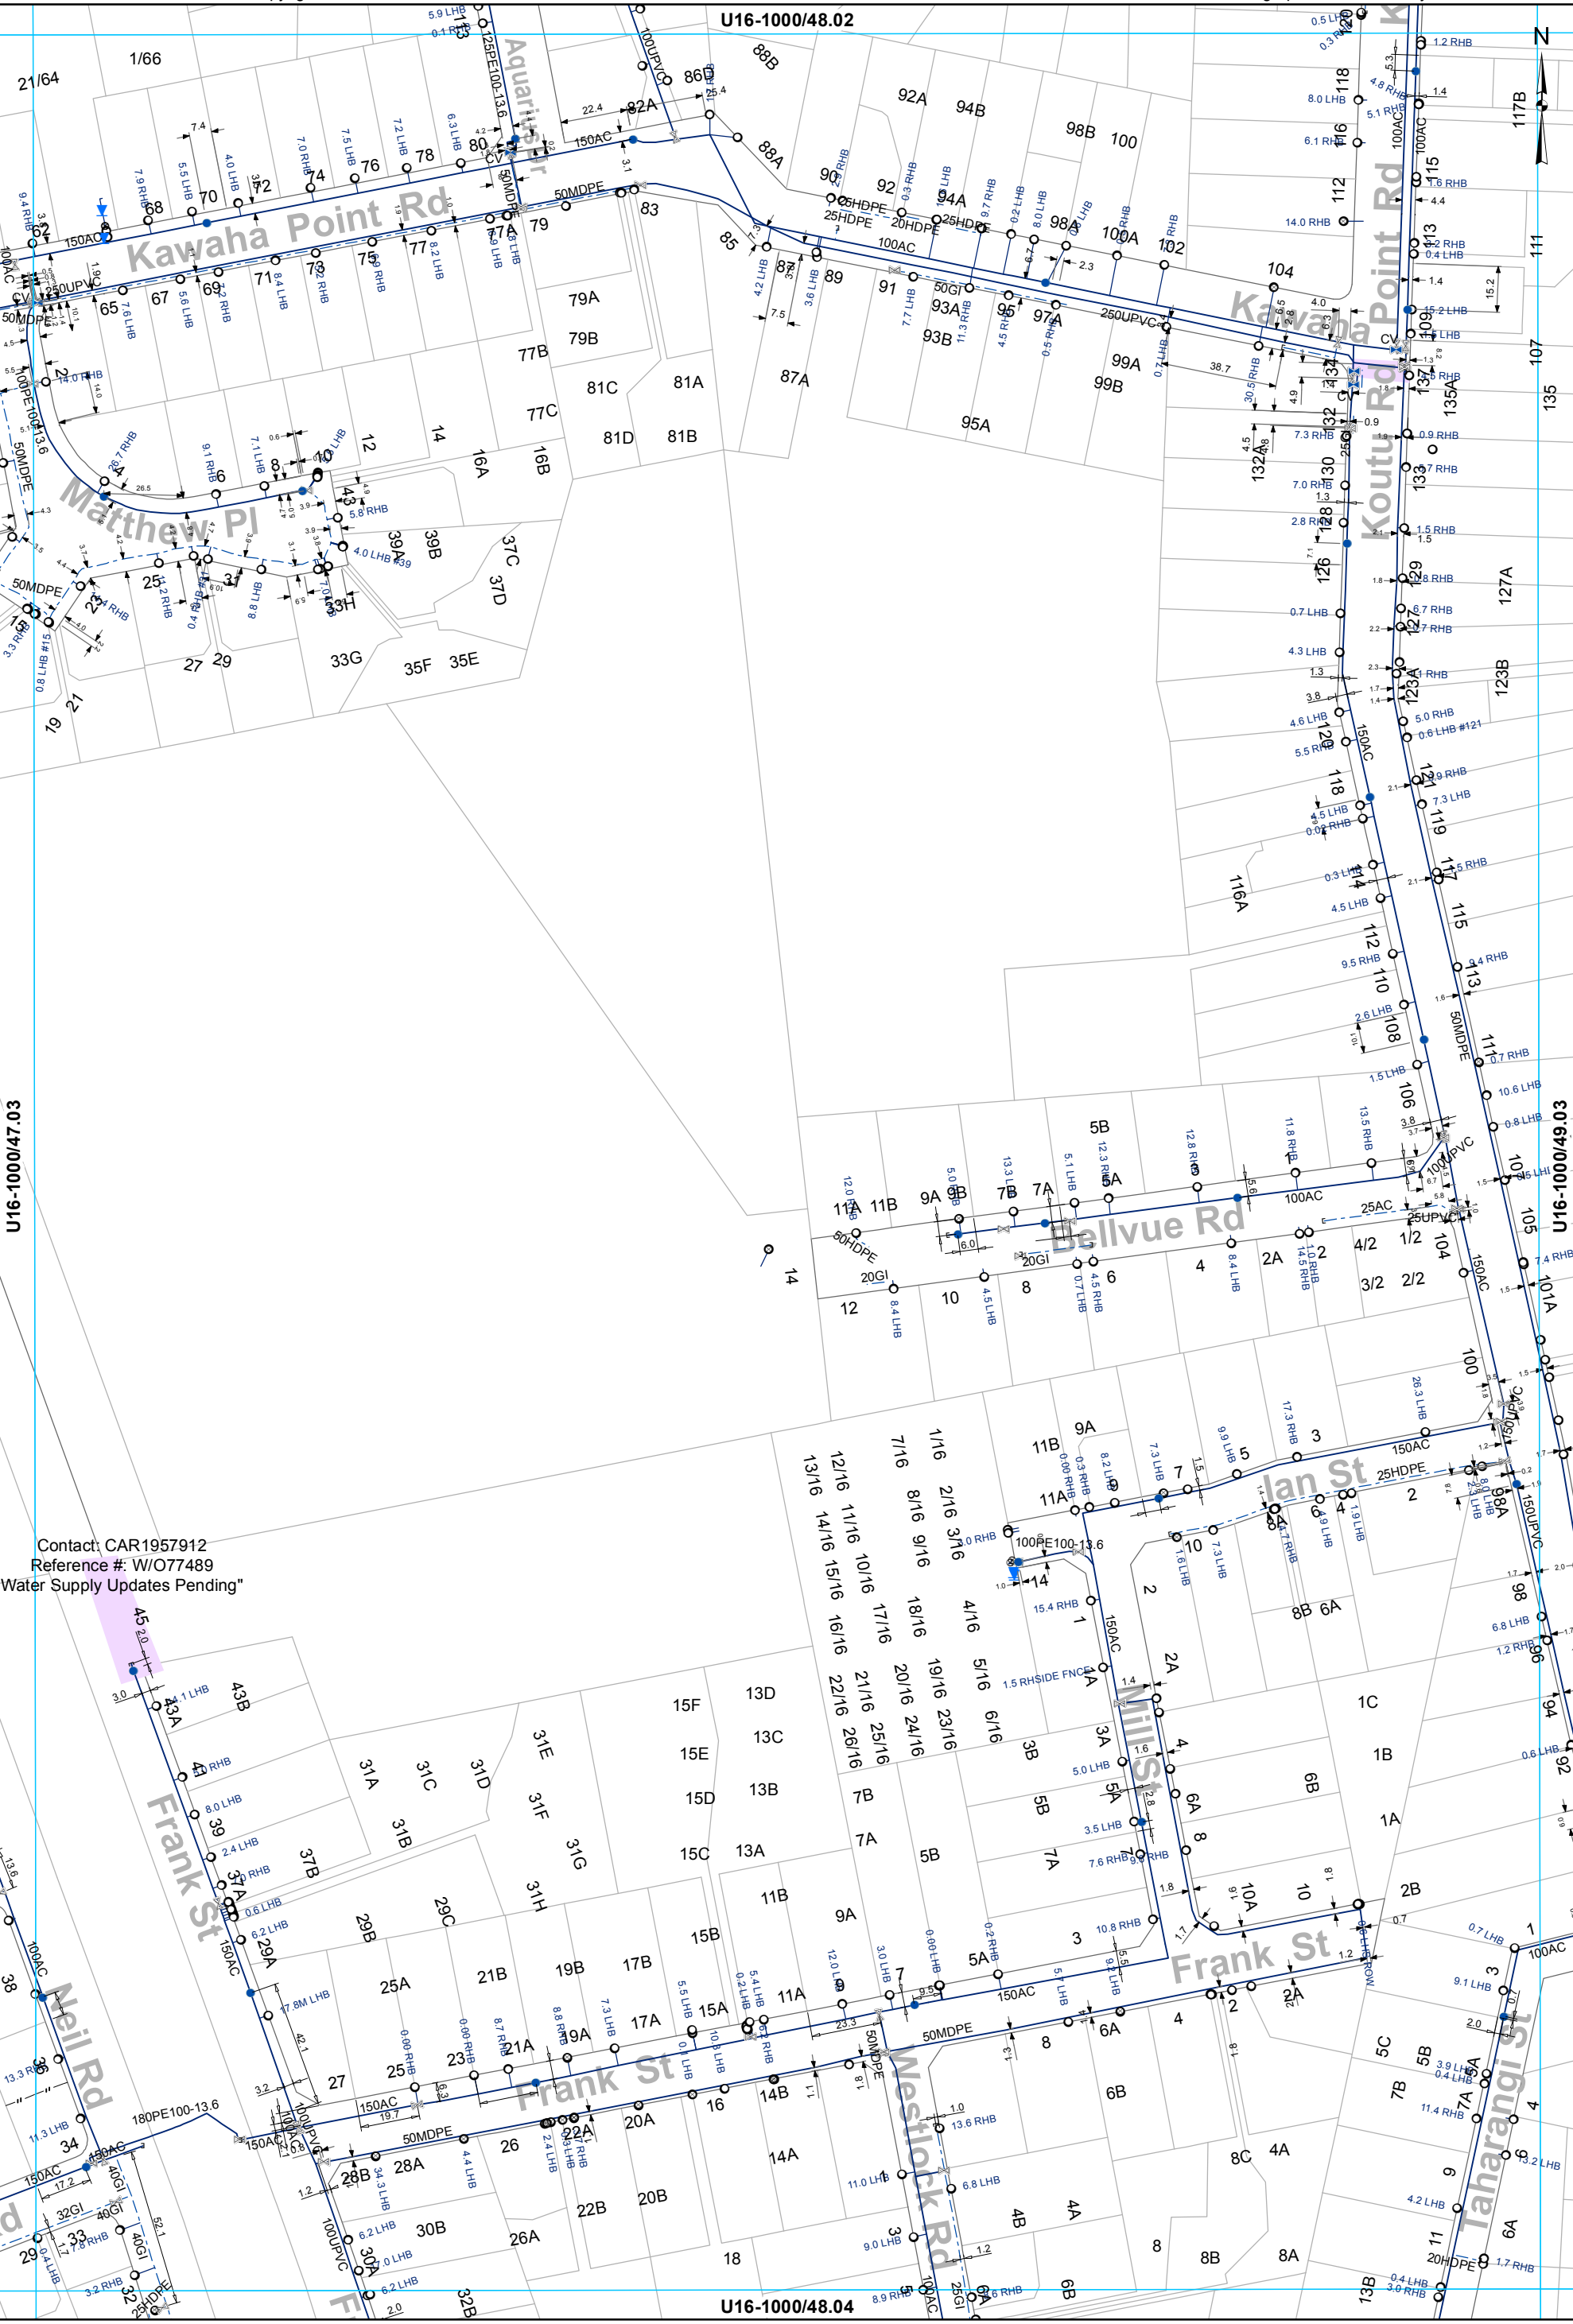

Contact: CAR1957912
Reference #: W/O77489
Water Supply Updates Pending"

- Valve
- Hydrant
- Meter Consumer
- WSServiceLine
- Toby
- Capped End
- Main
- Closed Valve
- Rider main

WATER SUPPLY SERVICES
1:2000 @ A3 - (U16-1000/48.03)

This data is derived from sources outside the control of Rotorua District Council and is for information only

All dimensions and levels should be verified by physical location on-site.

Rotorua District Council 2006. Facsimile 07 346 3143 Telephone 07 348 4199 email mail@rdc.govt.nz



- X

Valve

•

Hydrant

—

WSServiceLine

○

Toby


—

Main

- - -

Rider main

WATER SUPPLY SERVICES
1:2000 @ A3 - (U16-1000/49.03)

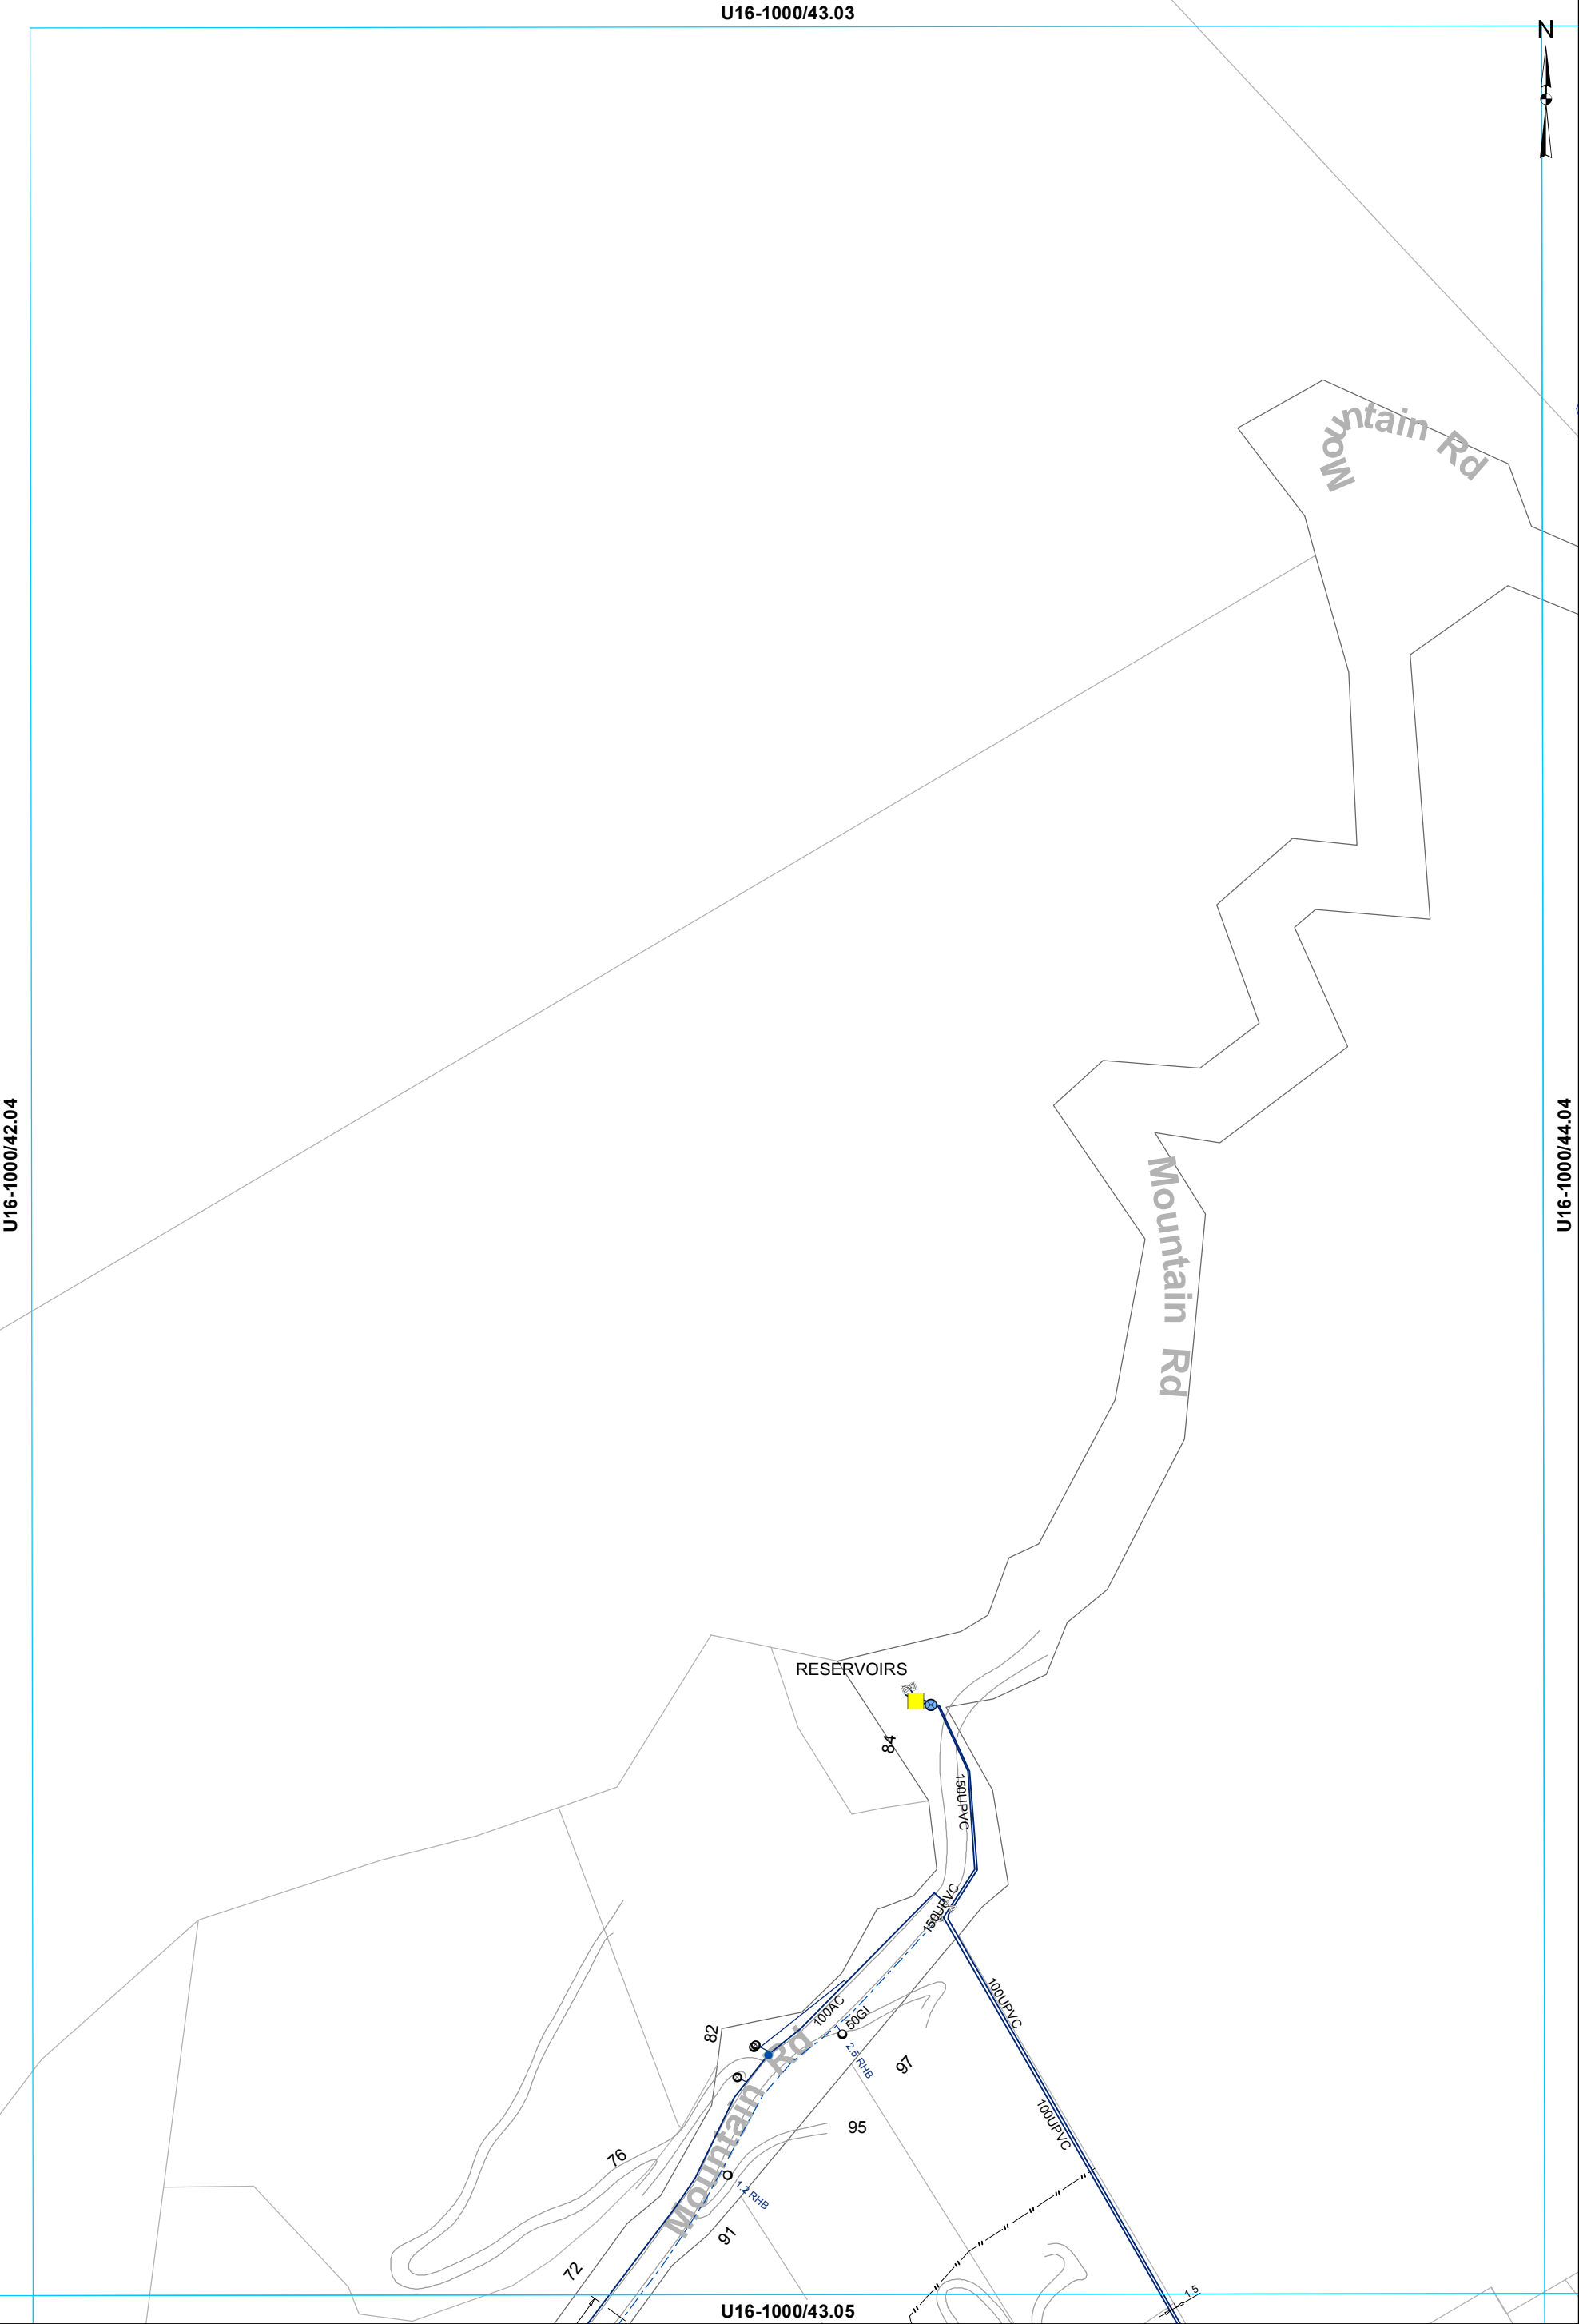

- ⌵

Valve

●

Hydrant

⊗

Meter Bulk

■

Miscellaneous

—

WSServiceLine
- Toby

⊙

Meter Consumer


—


Main

- - -

Rider main

WATER SUPPLY SERVICES
1:2000 @ A3 - (U16-1000/43.04)

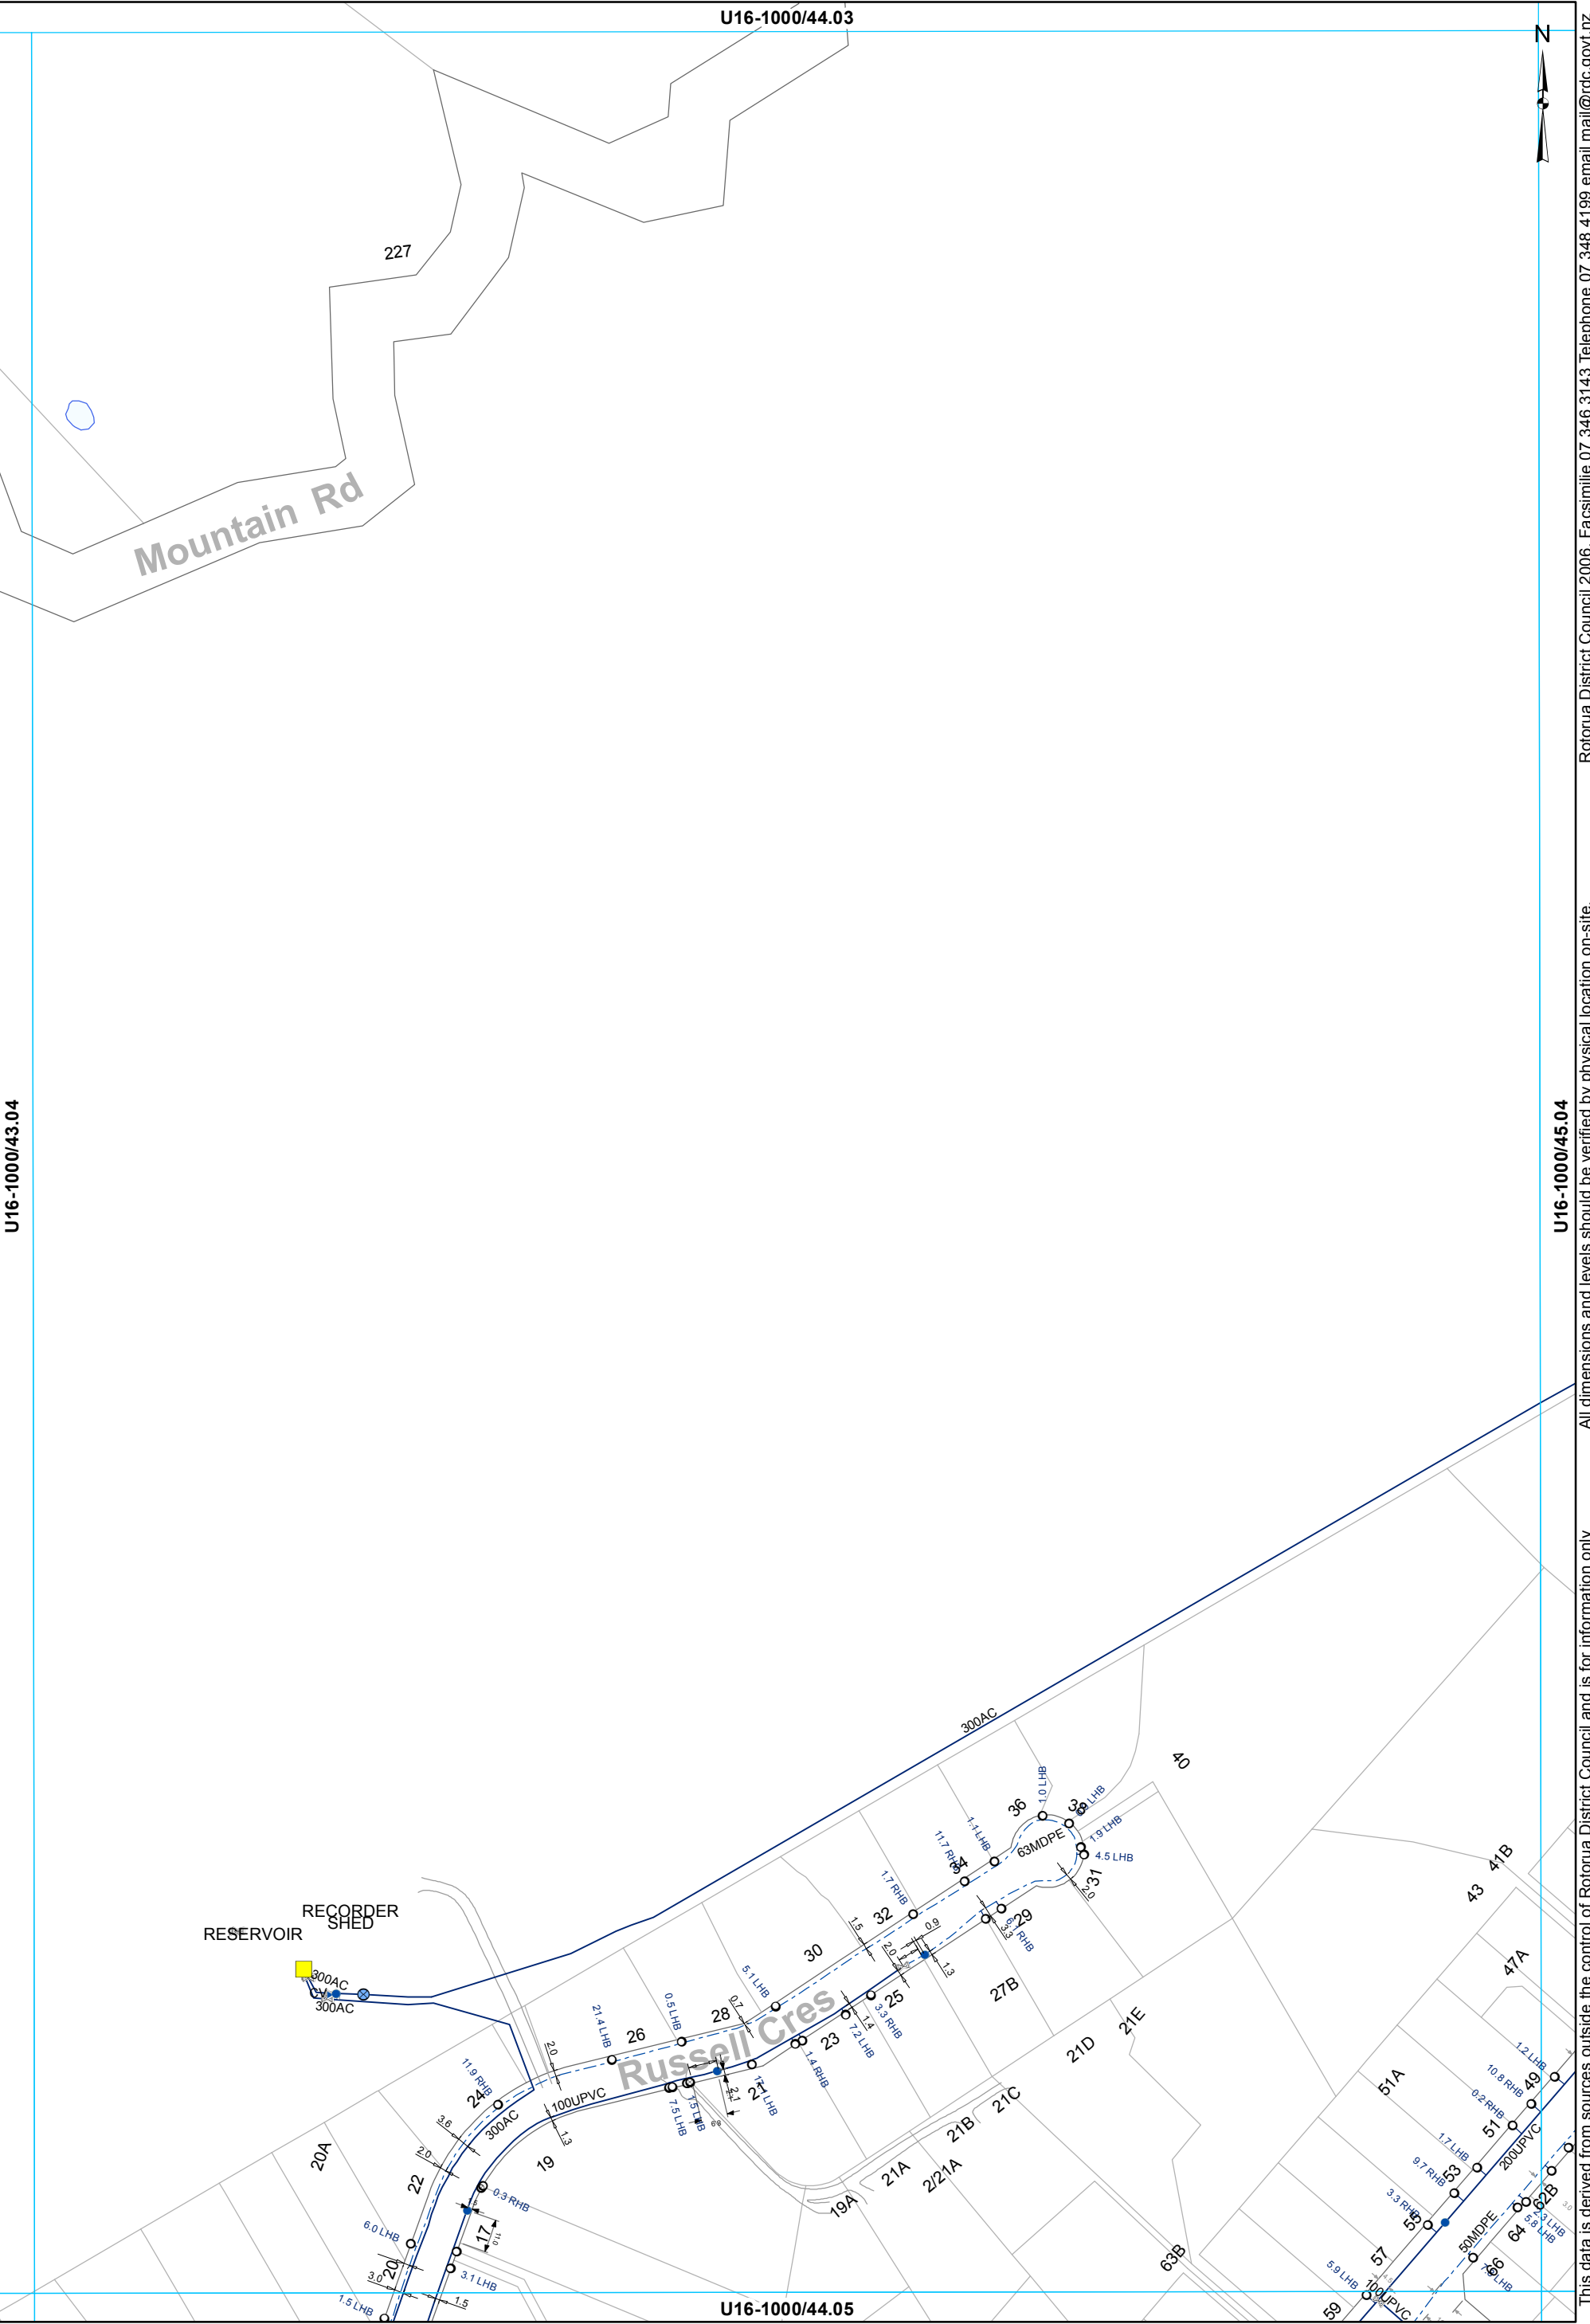

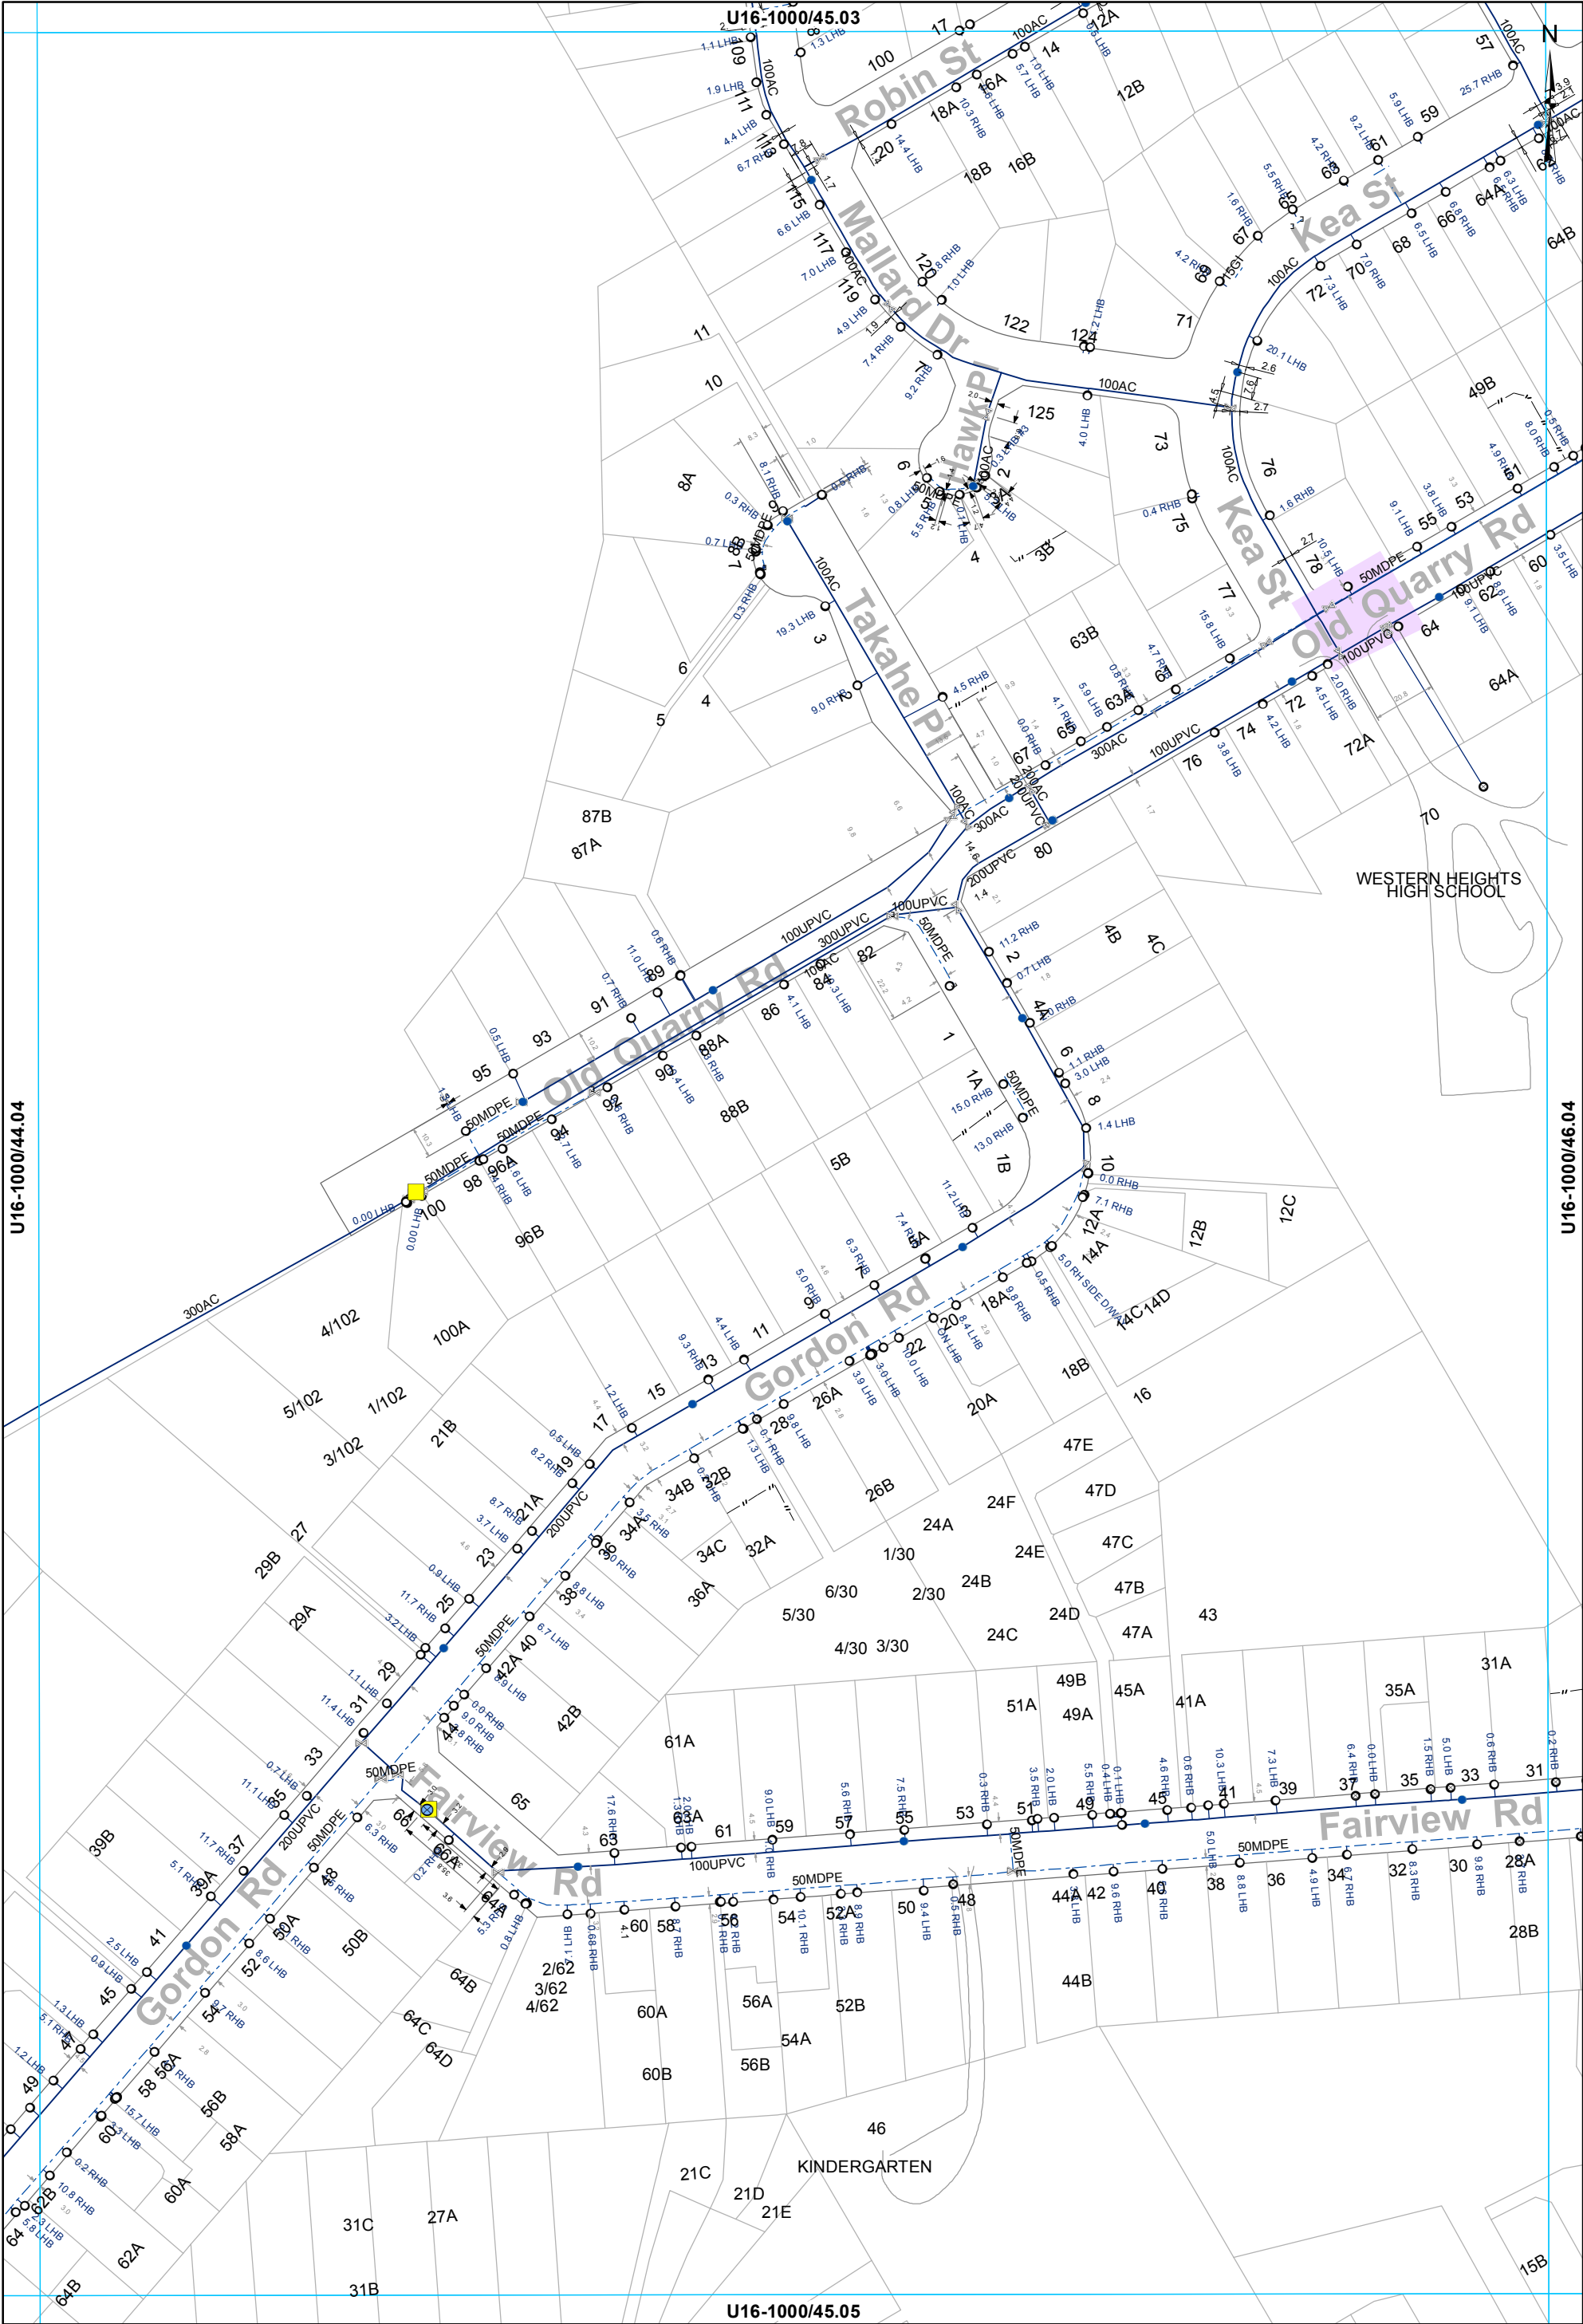

- ⌘

 Valve

●

 Hydrant

⊙

 Meter Bulk

■

 Miscellaneous

—

 WSServiceLine
- Toby

⊙

 Meter Consumer

—

 Main

 Rider main
- ⌘


 Capped End

WATER SUPPLY SERVICES
1:2000 @ A3 - (U16-1000/45.04)

This data is derived from sources outside the control of Rotorua District Council and is for information only

All dimensions and levels should be verified by physical location on-site.

Rotorua District Council 2006. Facsimile 07 346 3143 Telephone 07 348 4199 email mail@rdc.govt.nz

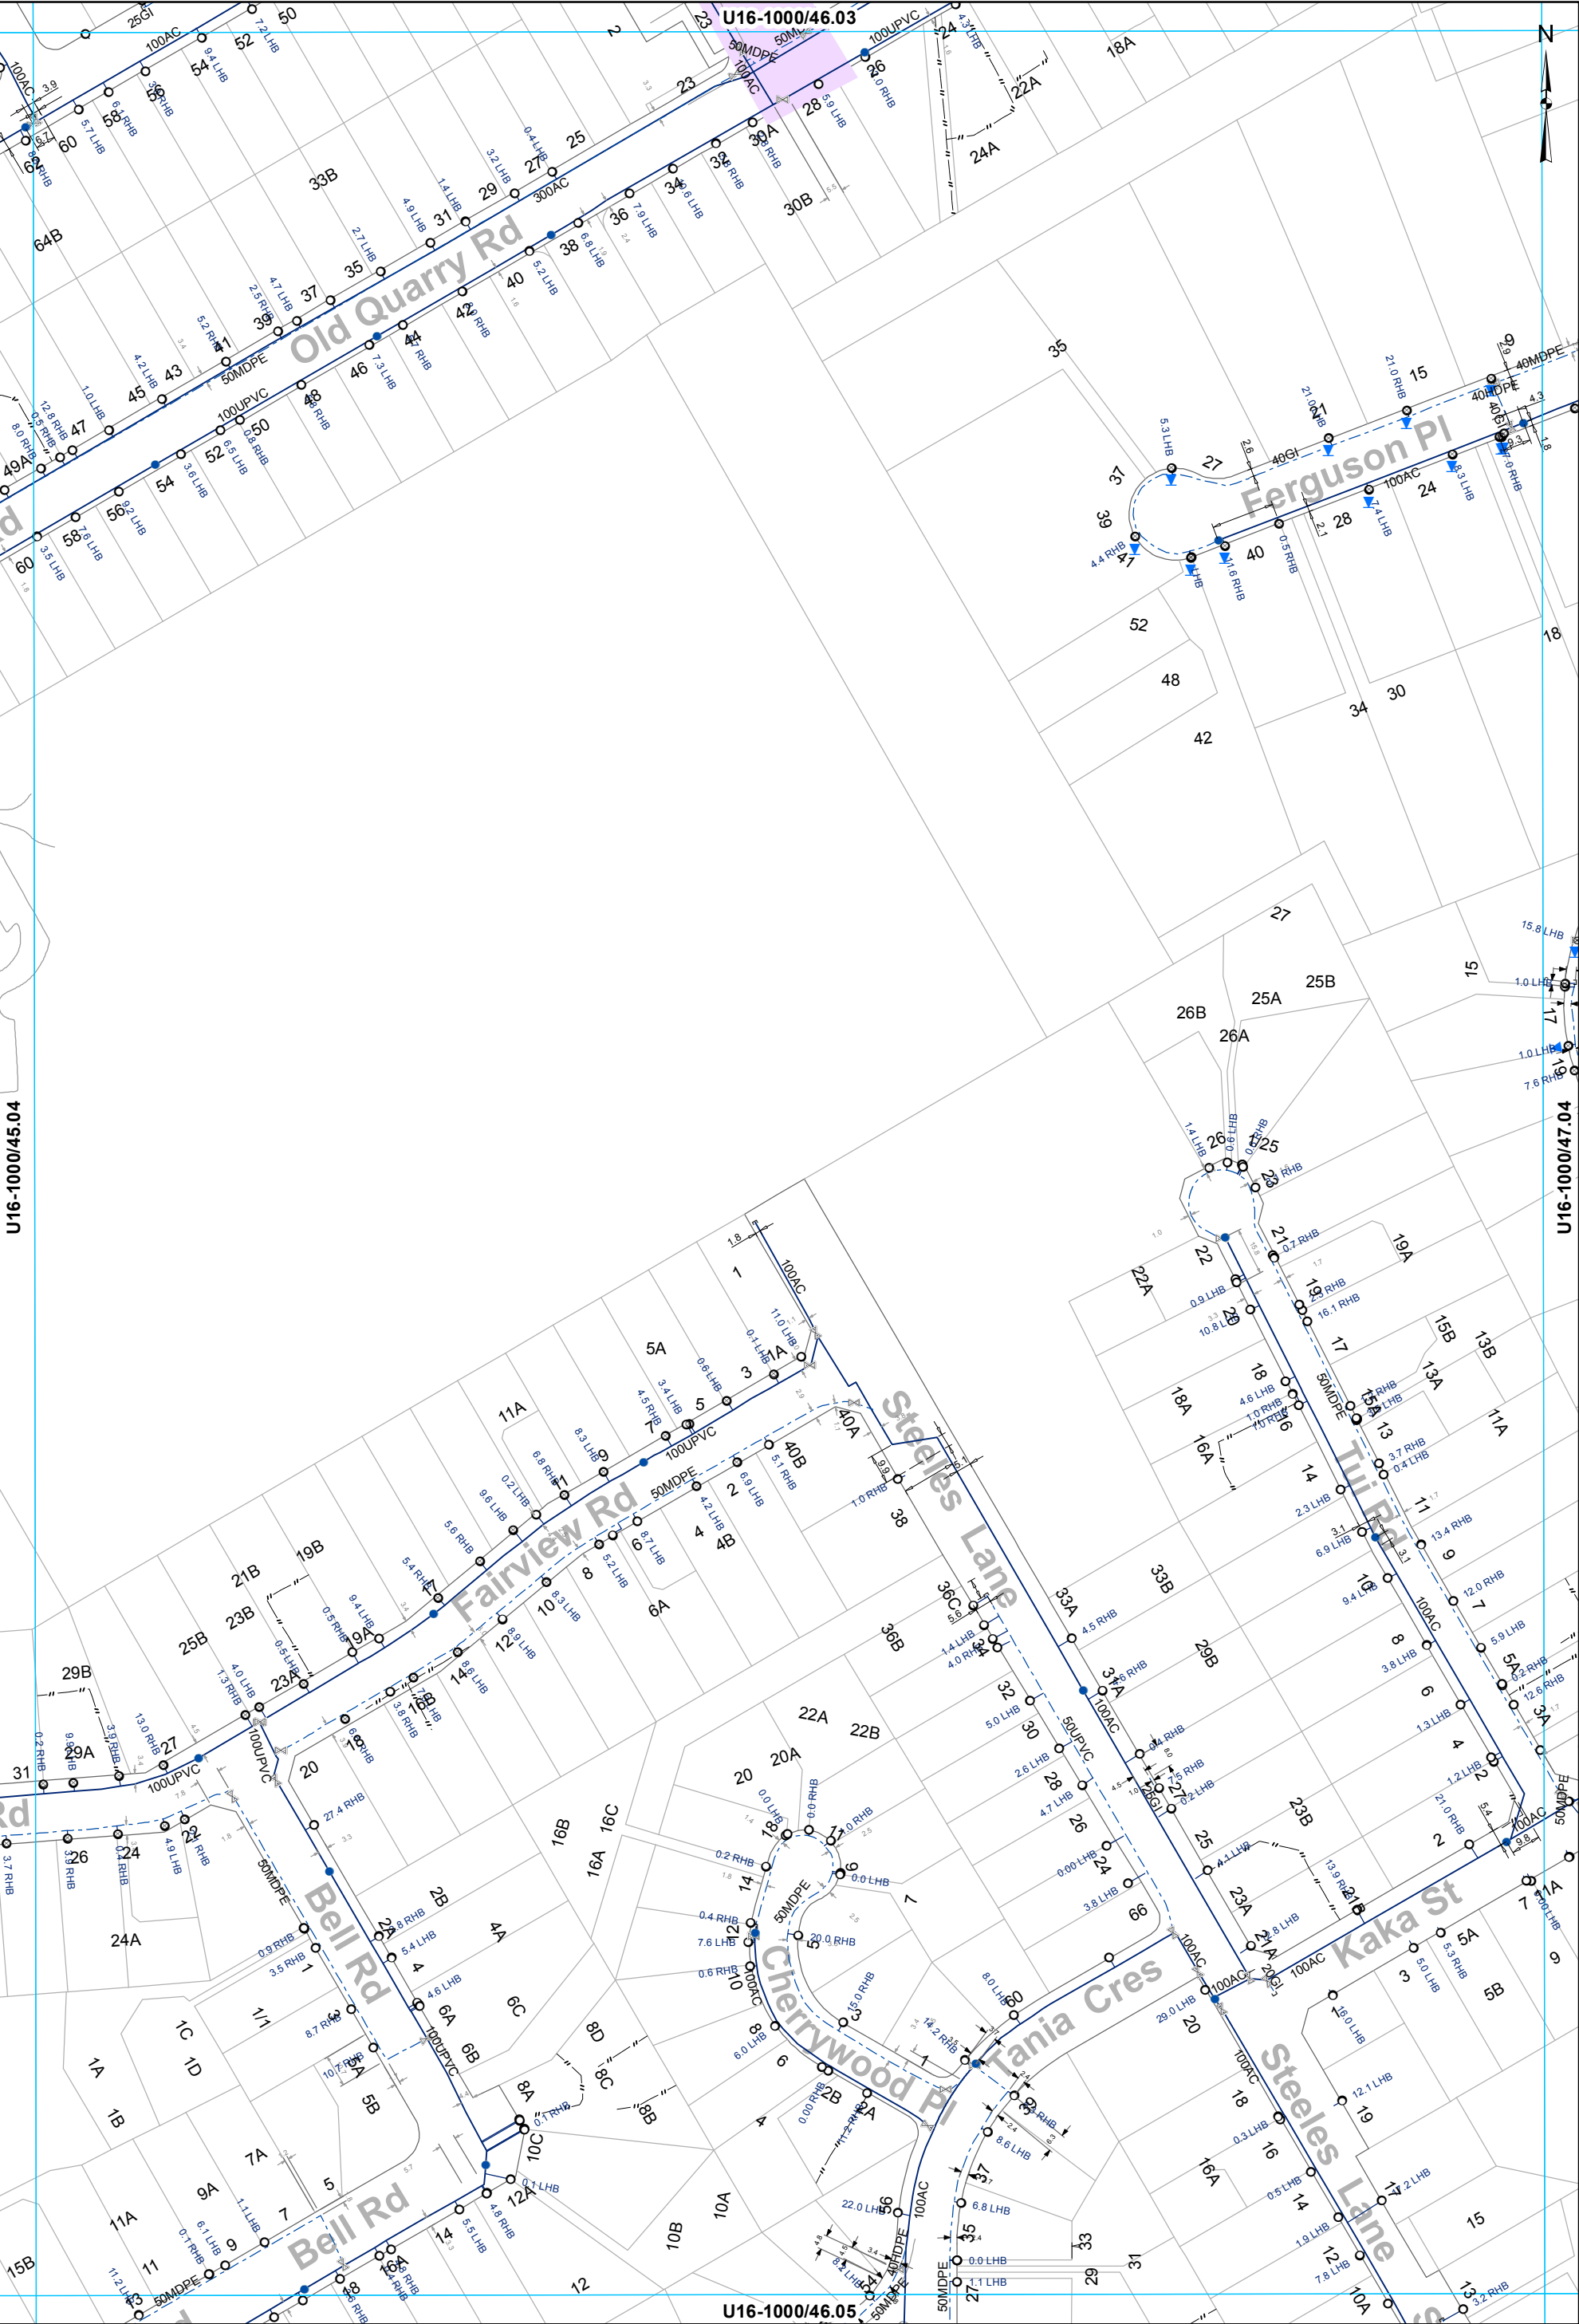


- | | | | |
|-------|---------|----------------|---------------|
| Valve | Hydrant | Meter Consumer | WSServiceLine |
| Toby | | Capped End | Main |
| | | | Rider main |

WATER SUPPLY SERVICES
1:2000 @ A3 - (U16-1000/46.04)

This data is derived from sources outside the control of Rotorua District Council and is for information only

All dimensions and levels should be verified by physical location on-site.

Rotorua District Council 2006. Facsimile 07 346 3143 Telephone 07 348 4199 email mail@rdc.govt.nz

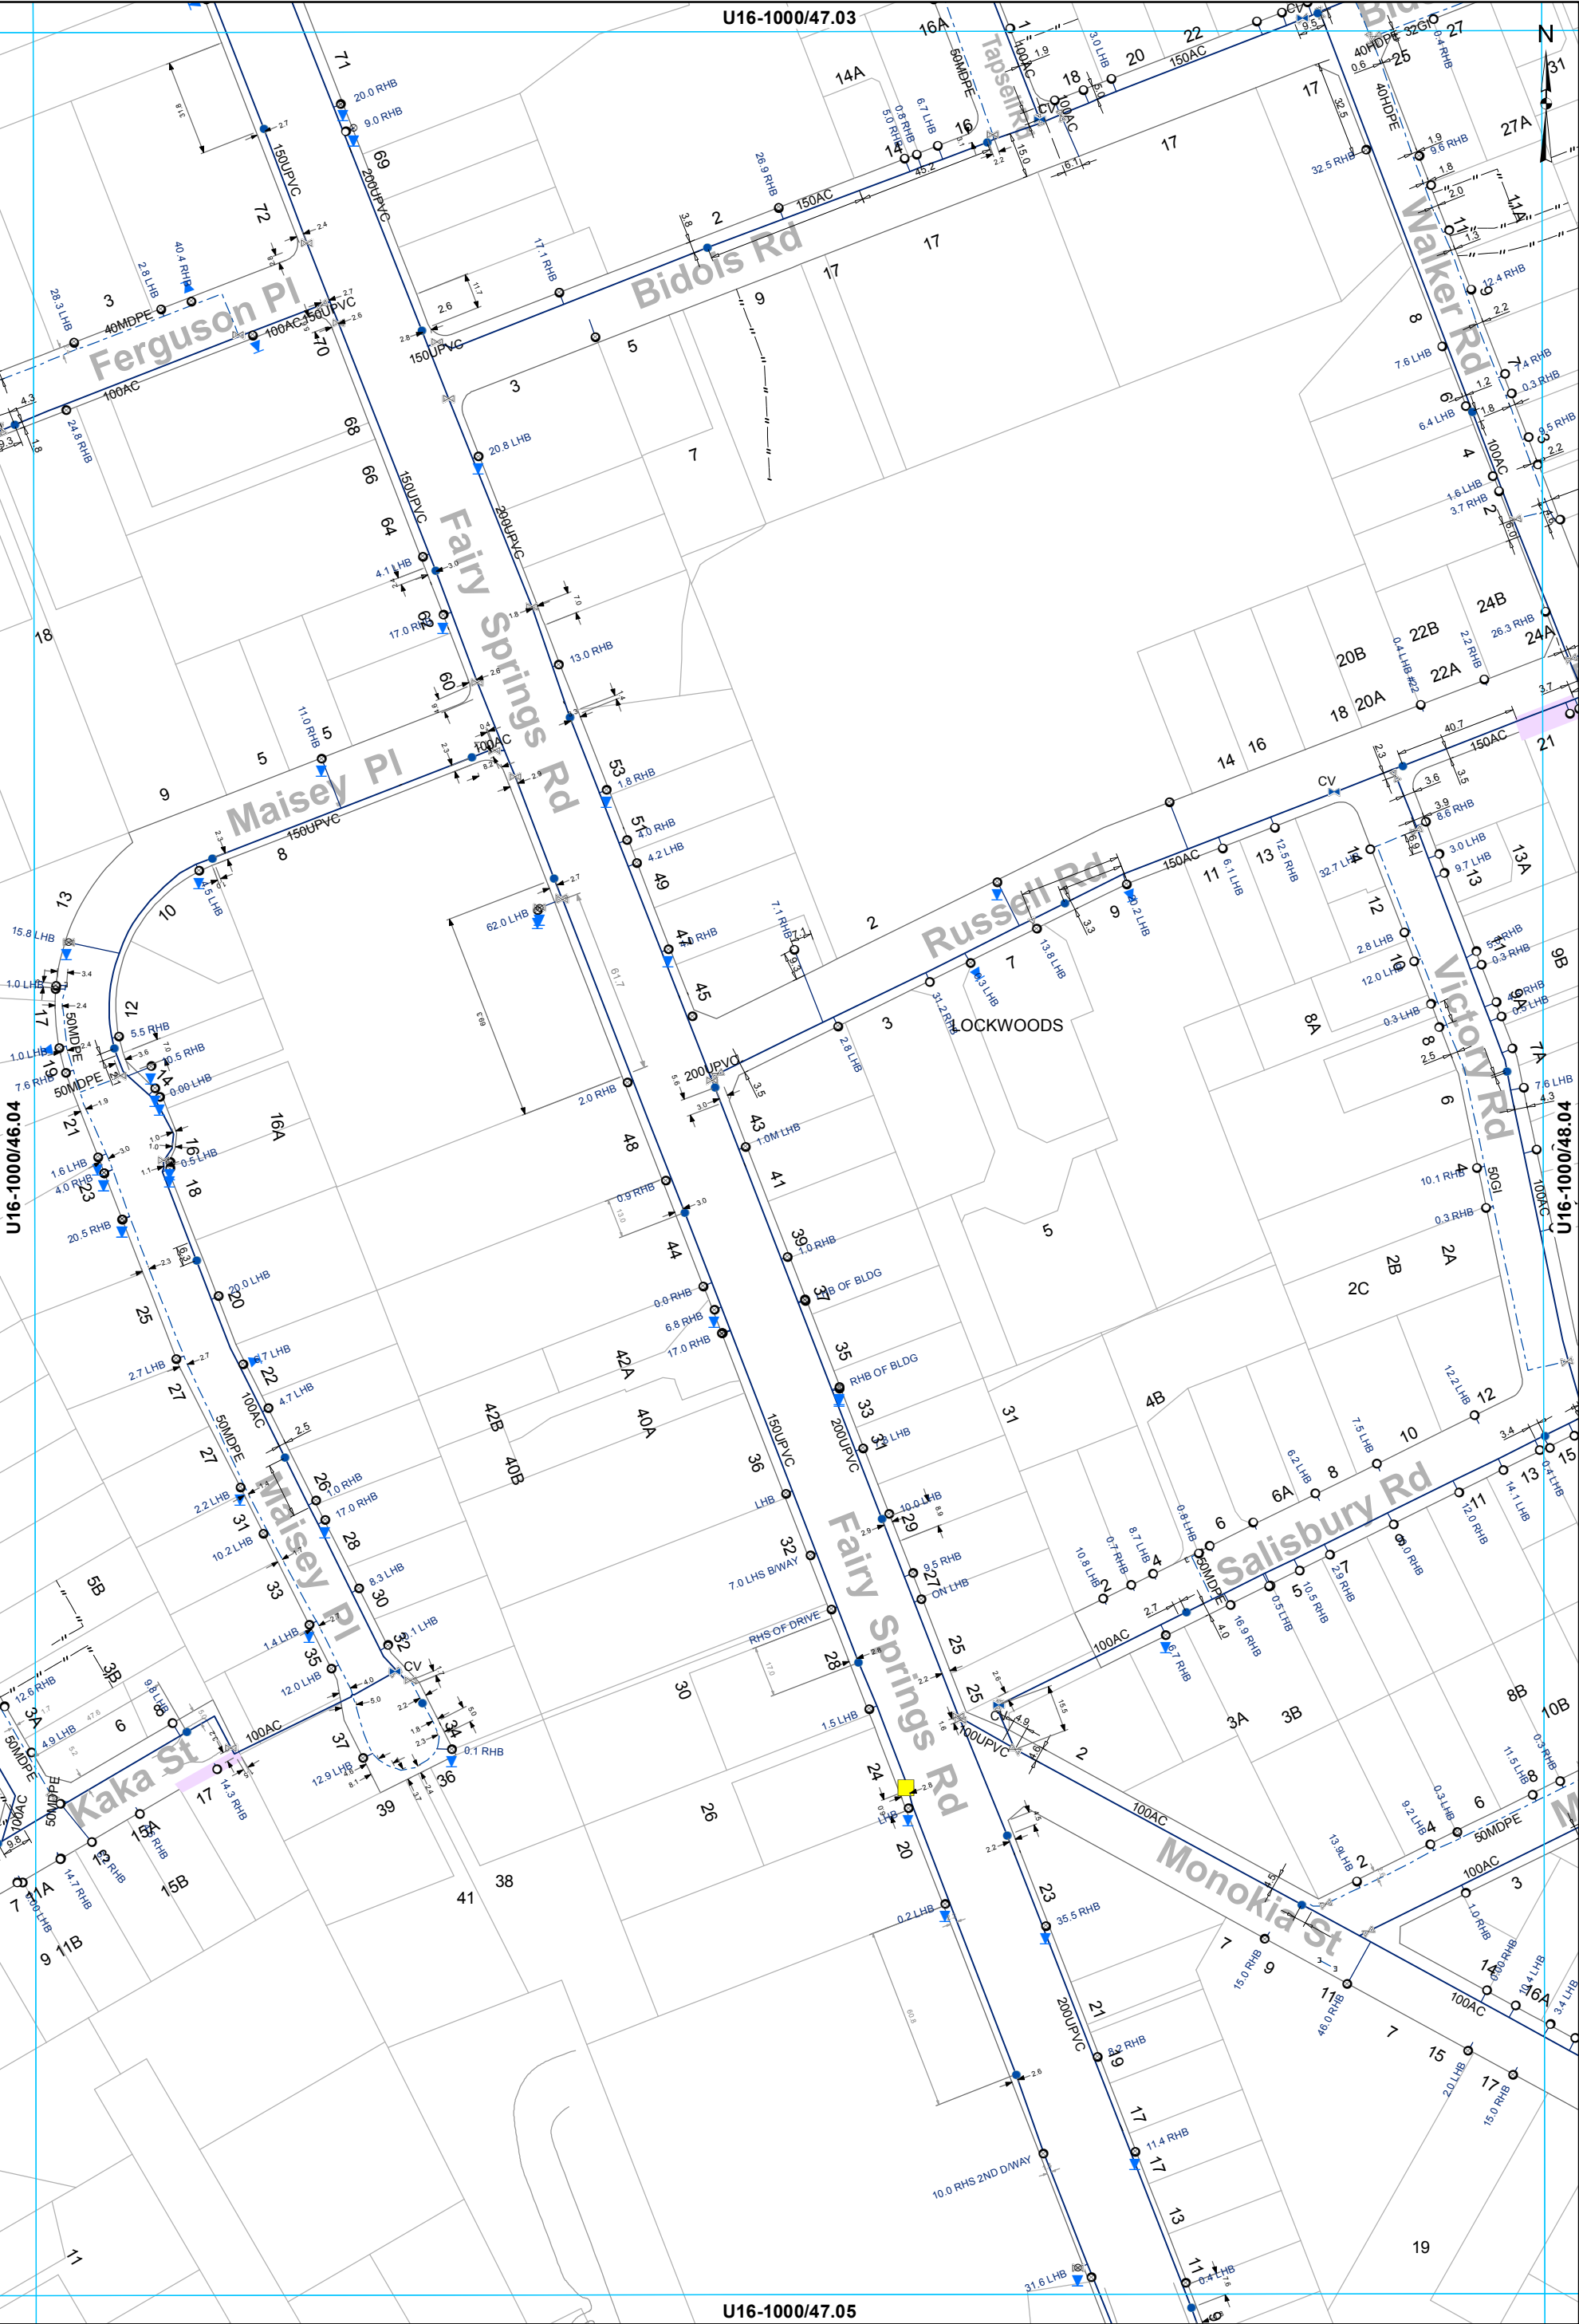


- Valve
- Hydrant
- Meter Consumer
- Miscellaneous
- WSServiceLine
- Toby
- Capped End
- Main
- Rider main
- Closed Valve

WATER SUPPLY SERVICES
1:2000 @ A3 - (U16-1000/47.04)

This data is derived from sources outside the control of Rotorua District Council and is for information only.

Rotorua District Council 2006. Facsimile 07 346 3143 Telephone 07 348 4199 email mail@rdc.govt.nz

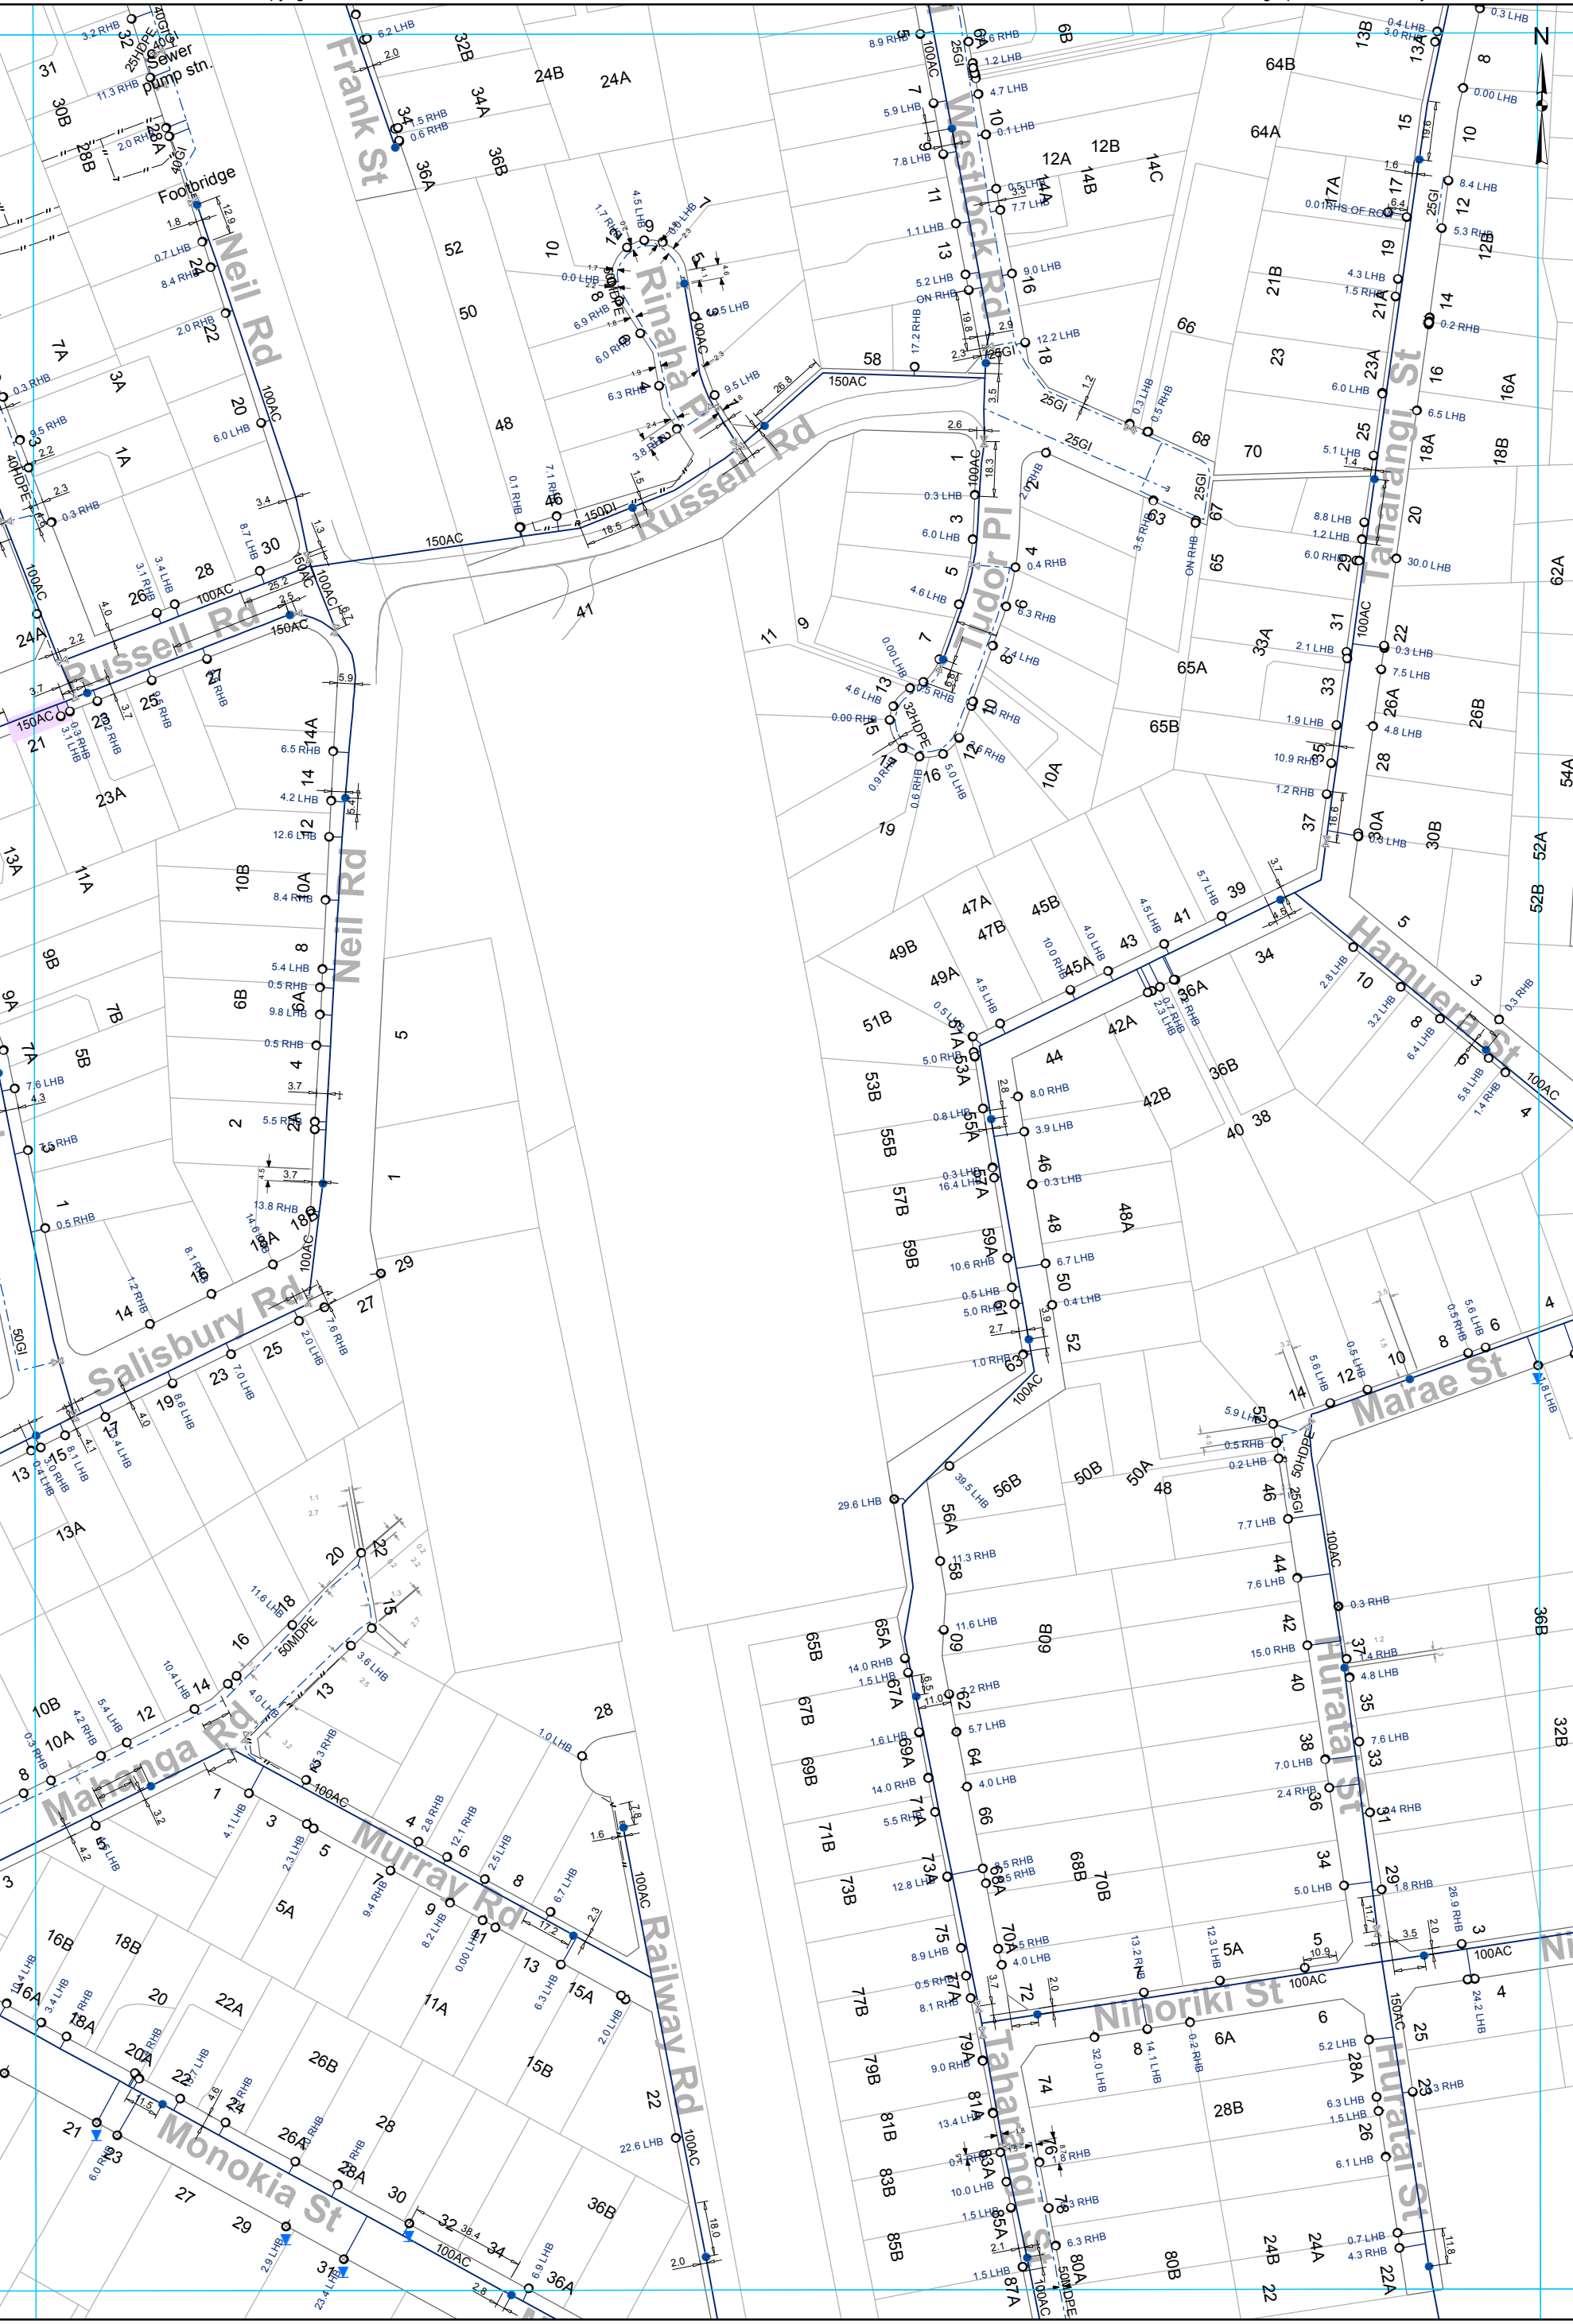


- | | | | |
|---------|-----------|------------------|------------------|
| ⌵ Valve | ● Hydrant | ⊙ Meter Consumer | — WSServiceLine |
| ○ Toby | | ⌵ Capped End | — Main |
| | | | - - - Rider main |

WATER SUPPLY SERVICES
1:2000 @ A3 - (U16-1000/48.04)

This data is derived from sources outside the control of Rotorua District Council and is for information only

All dimensions and levels should be verified by physical location on-site.

 Rotorua District Council 2006. Facsimile 07 346 3143 Telephone 07 348 4199 email mail@rdc.govt.nz



All dimensions and levels should be verified by physical location on-site.

This data is derived from sources outside the control of Rotorua District Council and is for information only

Rotorua District Council 2006. Facsimilie 07 346 3143 Telephone 07 348 4199 email mail@rdc.govt.nz

 Valve
 Hydrant
 Meter Consumer
 WSServiceLine
 Toby
 Capped End
 Main
 Rider main

WATER SUPPLY SERVICES
1:2000 @ A3 - (U16-1000/49.04)




○ Toby ● Hydrant ◉ Meter Consumer — WSServiceLine
— Main

WATER SUPPLY SERVICES
1:2000 @ A3 - (U16-1000/41.05)

This data is derived from sources outside the control of Rotorua District Council and is for information only. All dimensions and levels should be verified by physical location on-site. Rotorua District Council 2006. Facsimile 07 346 3143 Telephone 07 348 4199 email mail@rdc.govt.nz



WATER SUPPLY SERVICES
1:2000 @ A3 - (U16-1000/42.05)

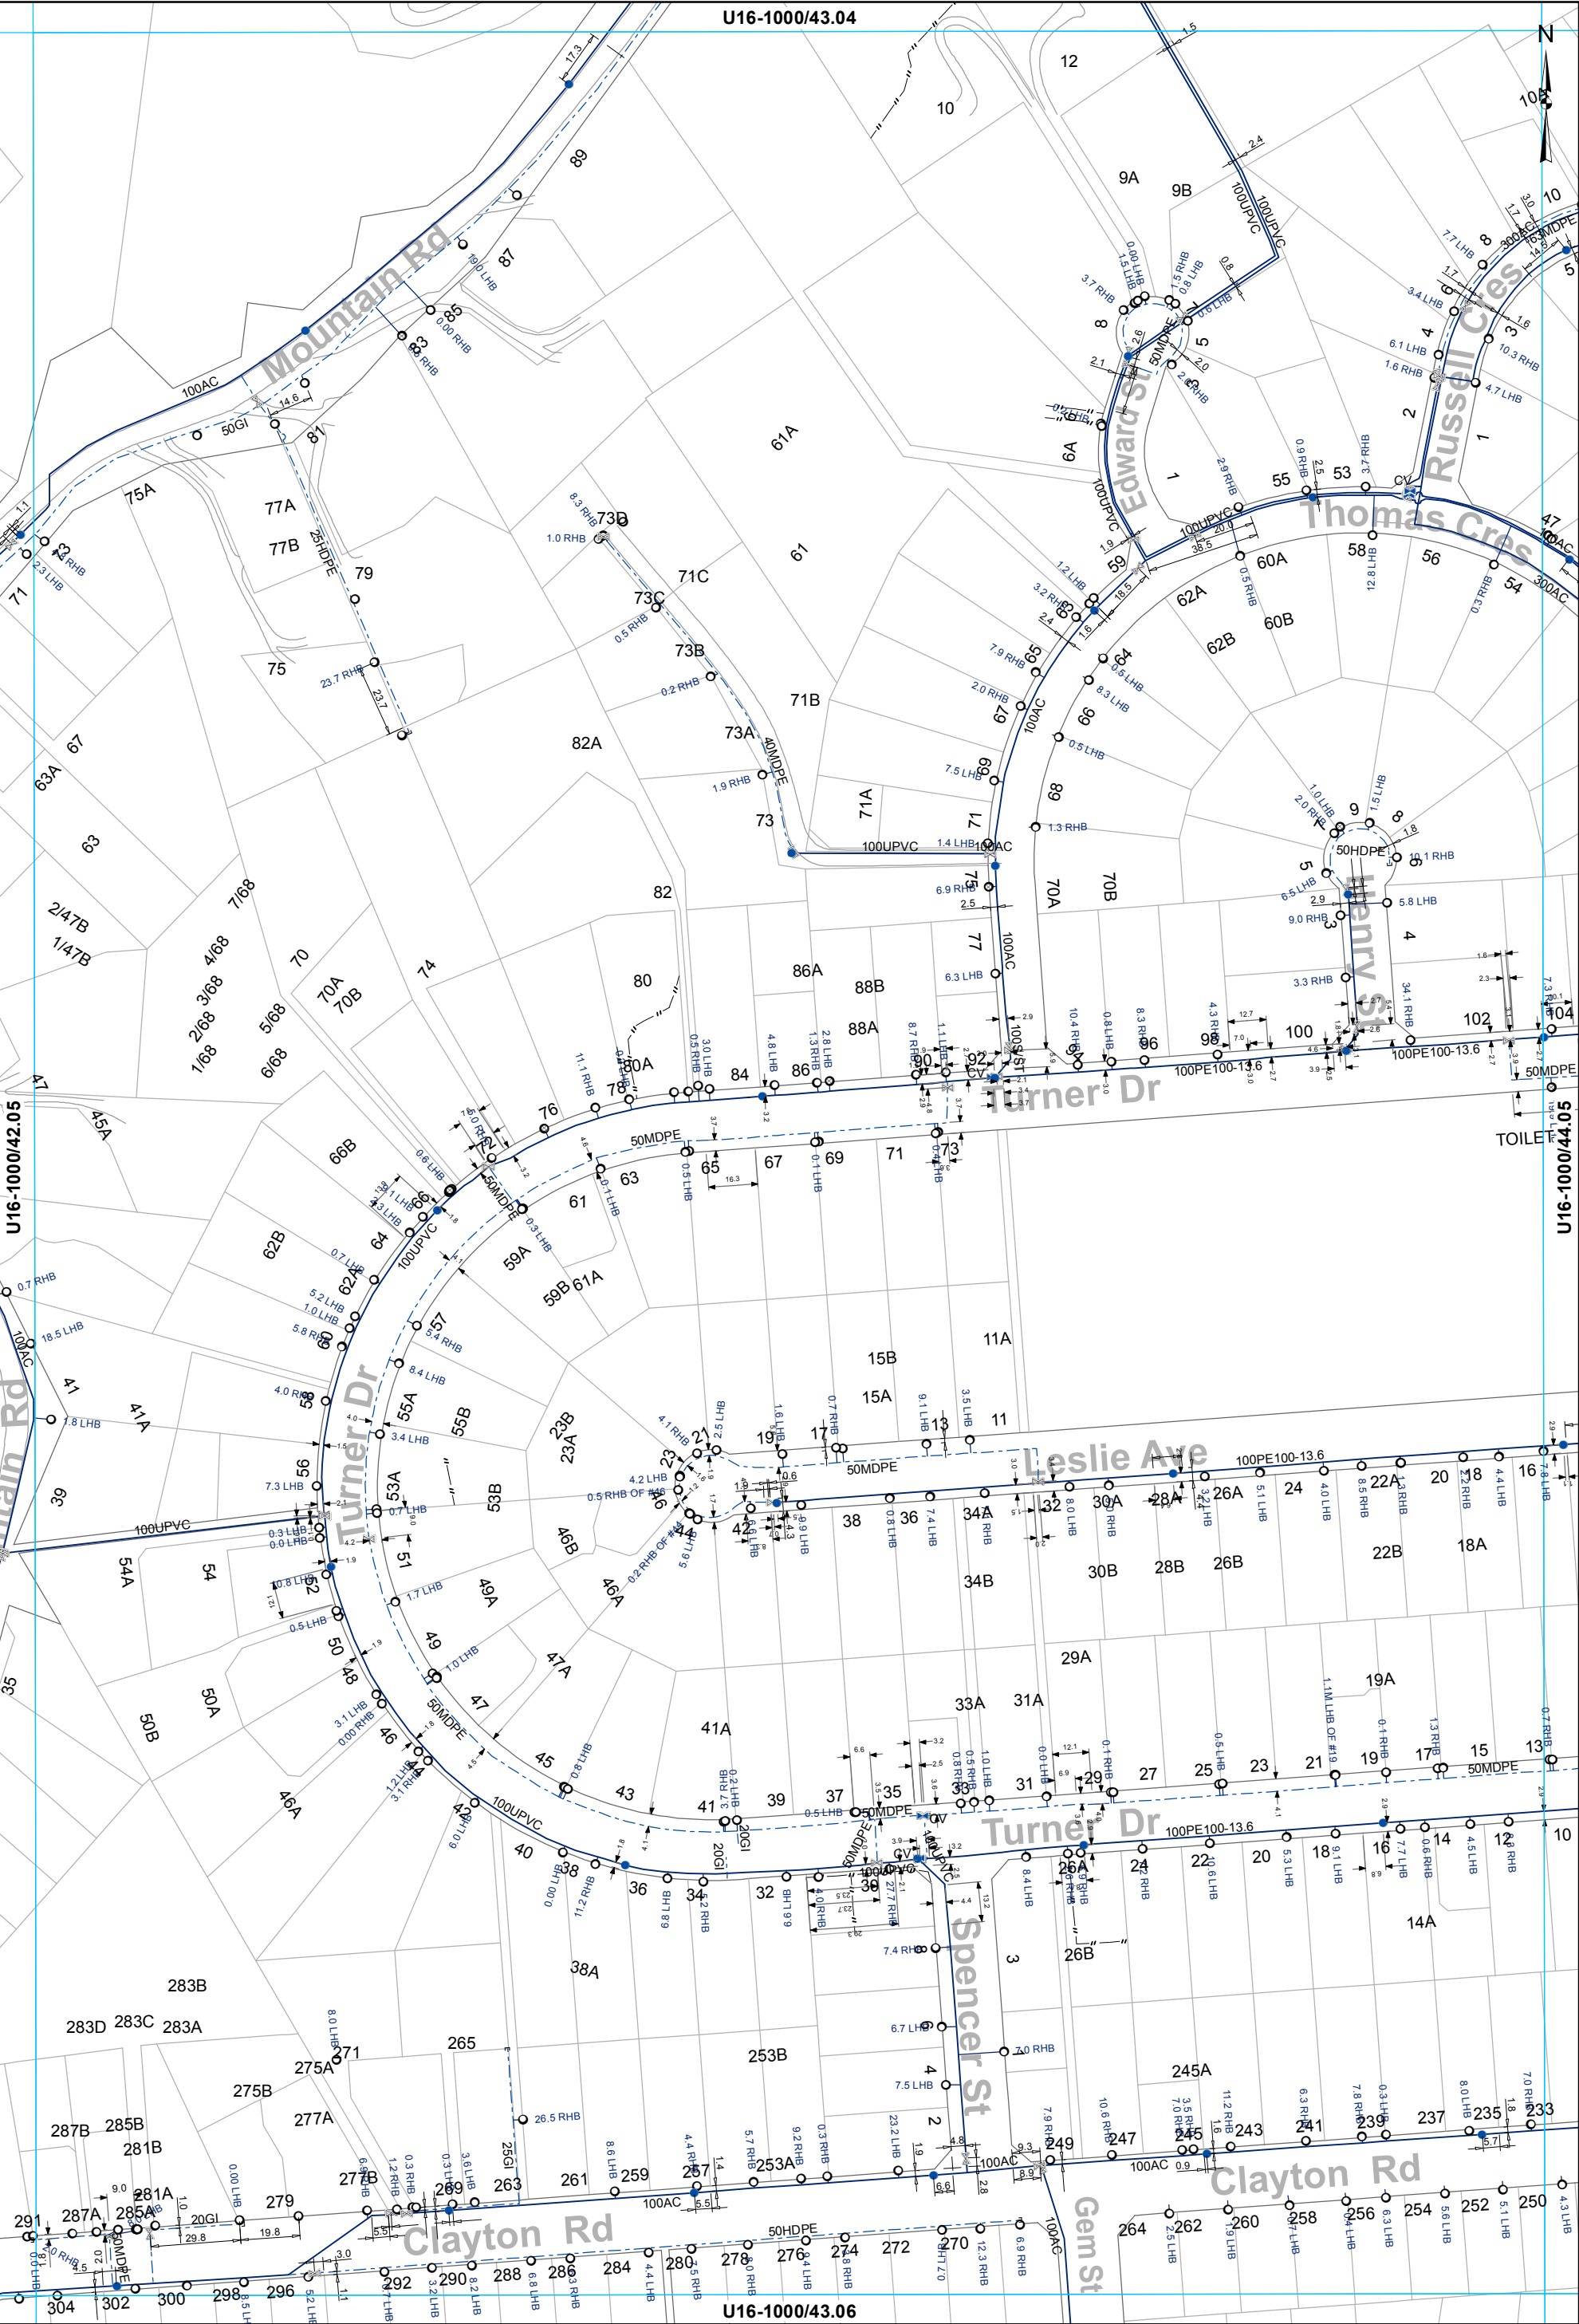

- | | | | |
|----------------|-----------|------------------|------------------|
| ⌘ Valve | ● Hydrant | ⊙ Meter Consumer | — WSServiceLine |
| ○ Toby | | ⊙ Capped End | — Main |
| ⌘ Closed Valve | | | - - - Rider main |

WATER SUPPLY SERVICES
1:2000 @ A3 - (U16-1000/43.05)

This data is derived from sources outside the control of Rotorua District Council and is for information only

Rotorua District Council 2006. Facsimile 07 346 3143 Telephone 07 348 4199 email mail@rdc.govt.nz

 


- Valve
- Hydrant
- Meter Bulk
- Miscellaneous
- WSServiceLine
- Toby
- Meter Consumer
- Main
- Rider main
- Closed Valve
- Capped End


WATER SUPPLY SERVICES
1:2000 @ A3 - (U16-1000/44.05)



WATER SUPPLY SERVICES
1:2000 @ A3 - (U16-1000/45.05)



WATER SUPPLY SERVICES
1:2000 @ A3 - (U16-1000/46.05)

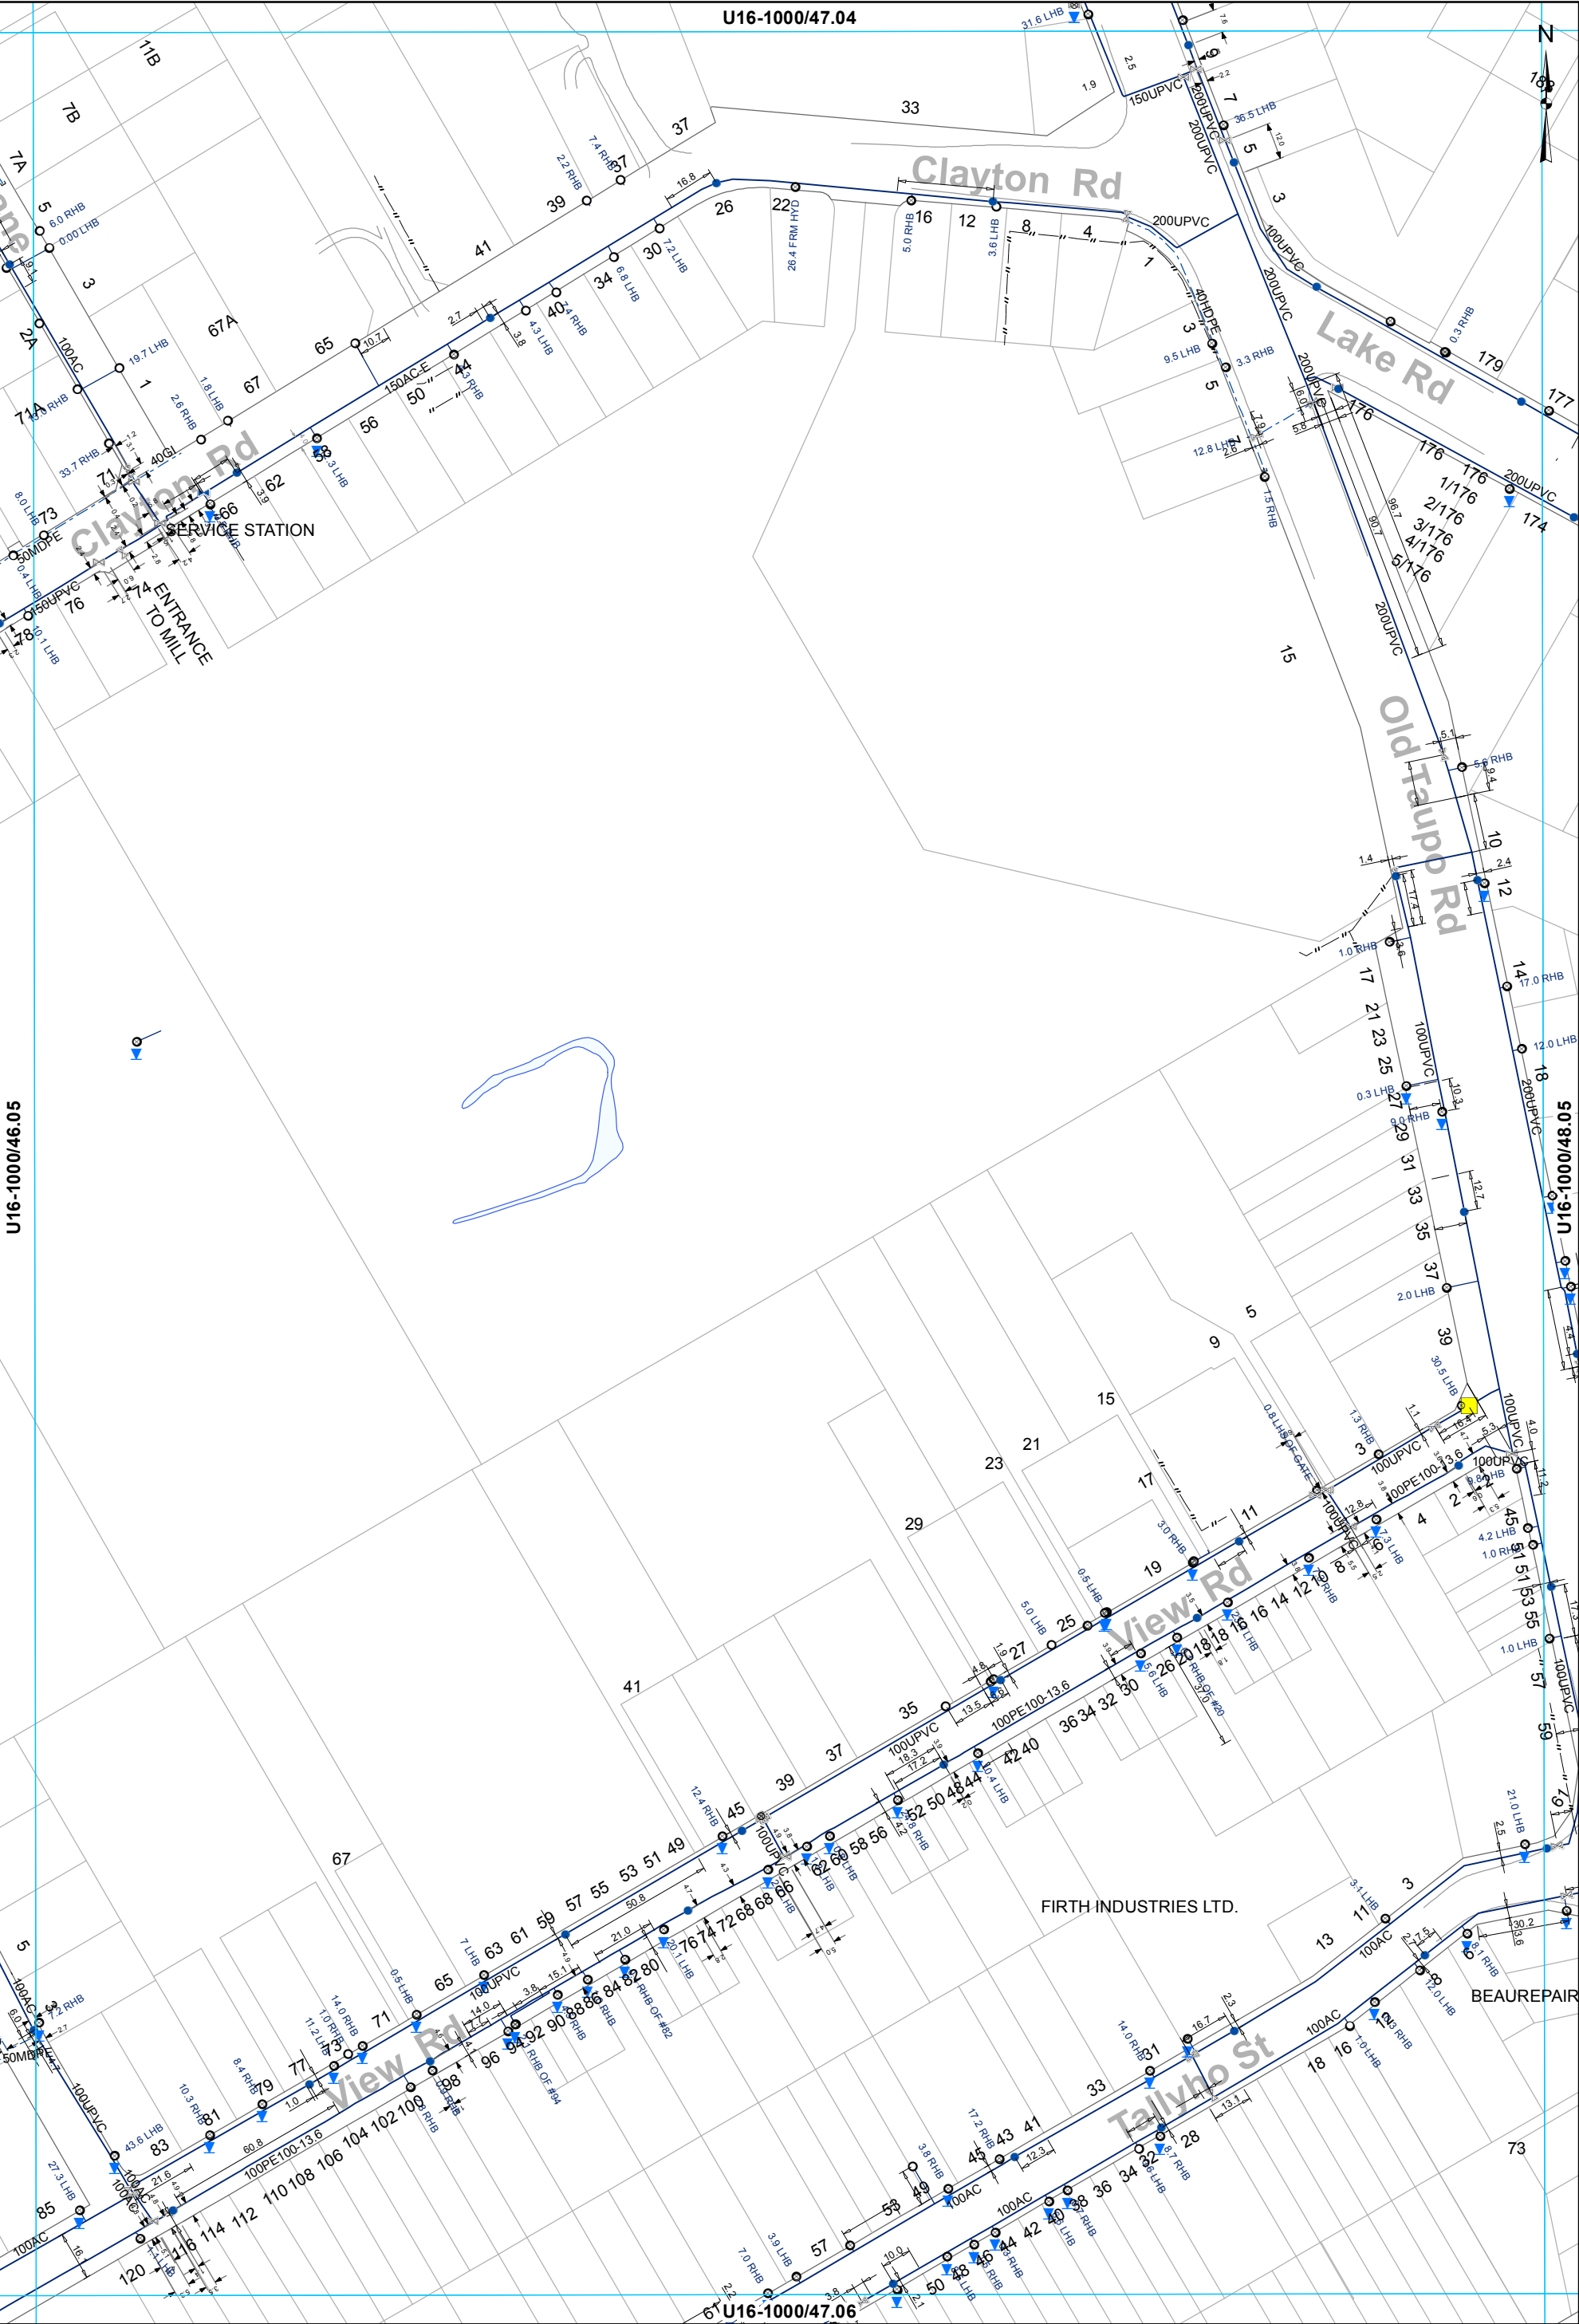


- | | | | | |
|----------------|-----------|------------------|-----------------|-----------------|
| X Valve | • Hydrant | ⊙ Meter Consumer | ■ Miscellaneous | — WSServiceLine |
| ○ Toby | | ⊖ Capped End | | — Main |
| ⌵ Closed Valve | | | | --- Rider main |

WATER SUPPLY SERVICES
1:2000 @ A3 - (U16-1000/47.05)

This data is derived from sources outside the control of Rotorua District Council and is for information only

All dimensions and levels should be verified by physical location on-site.

Rotorua District Council 2006. Facsimile 07 346 3143 Telephone 07 348 4199 email mail@rdc.govt.nz

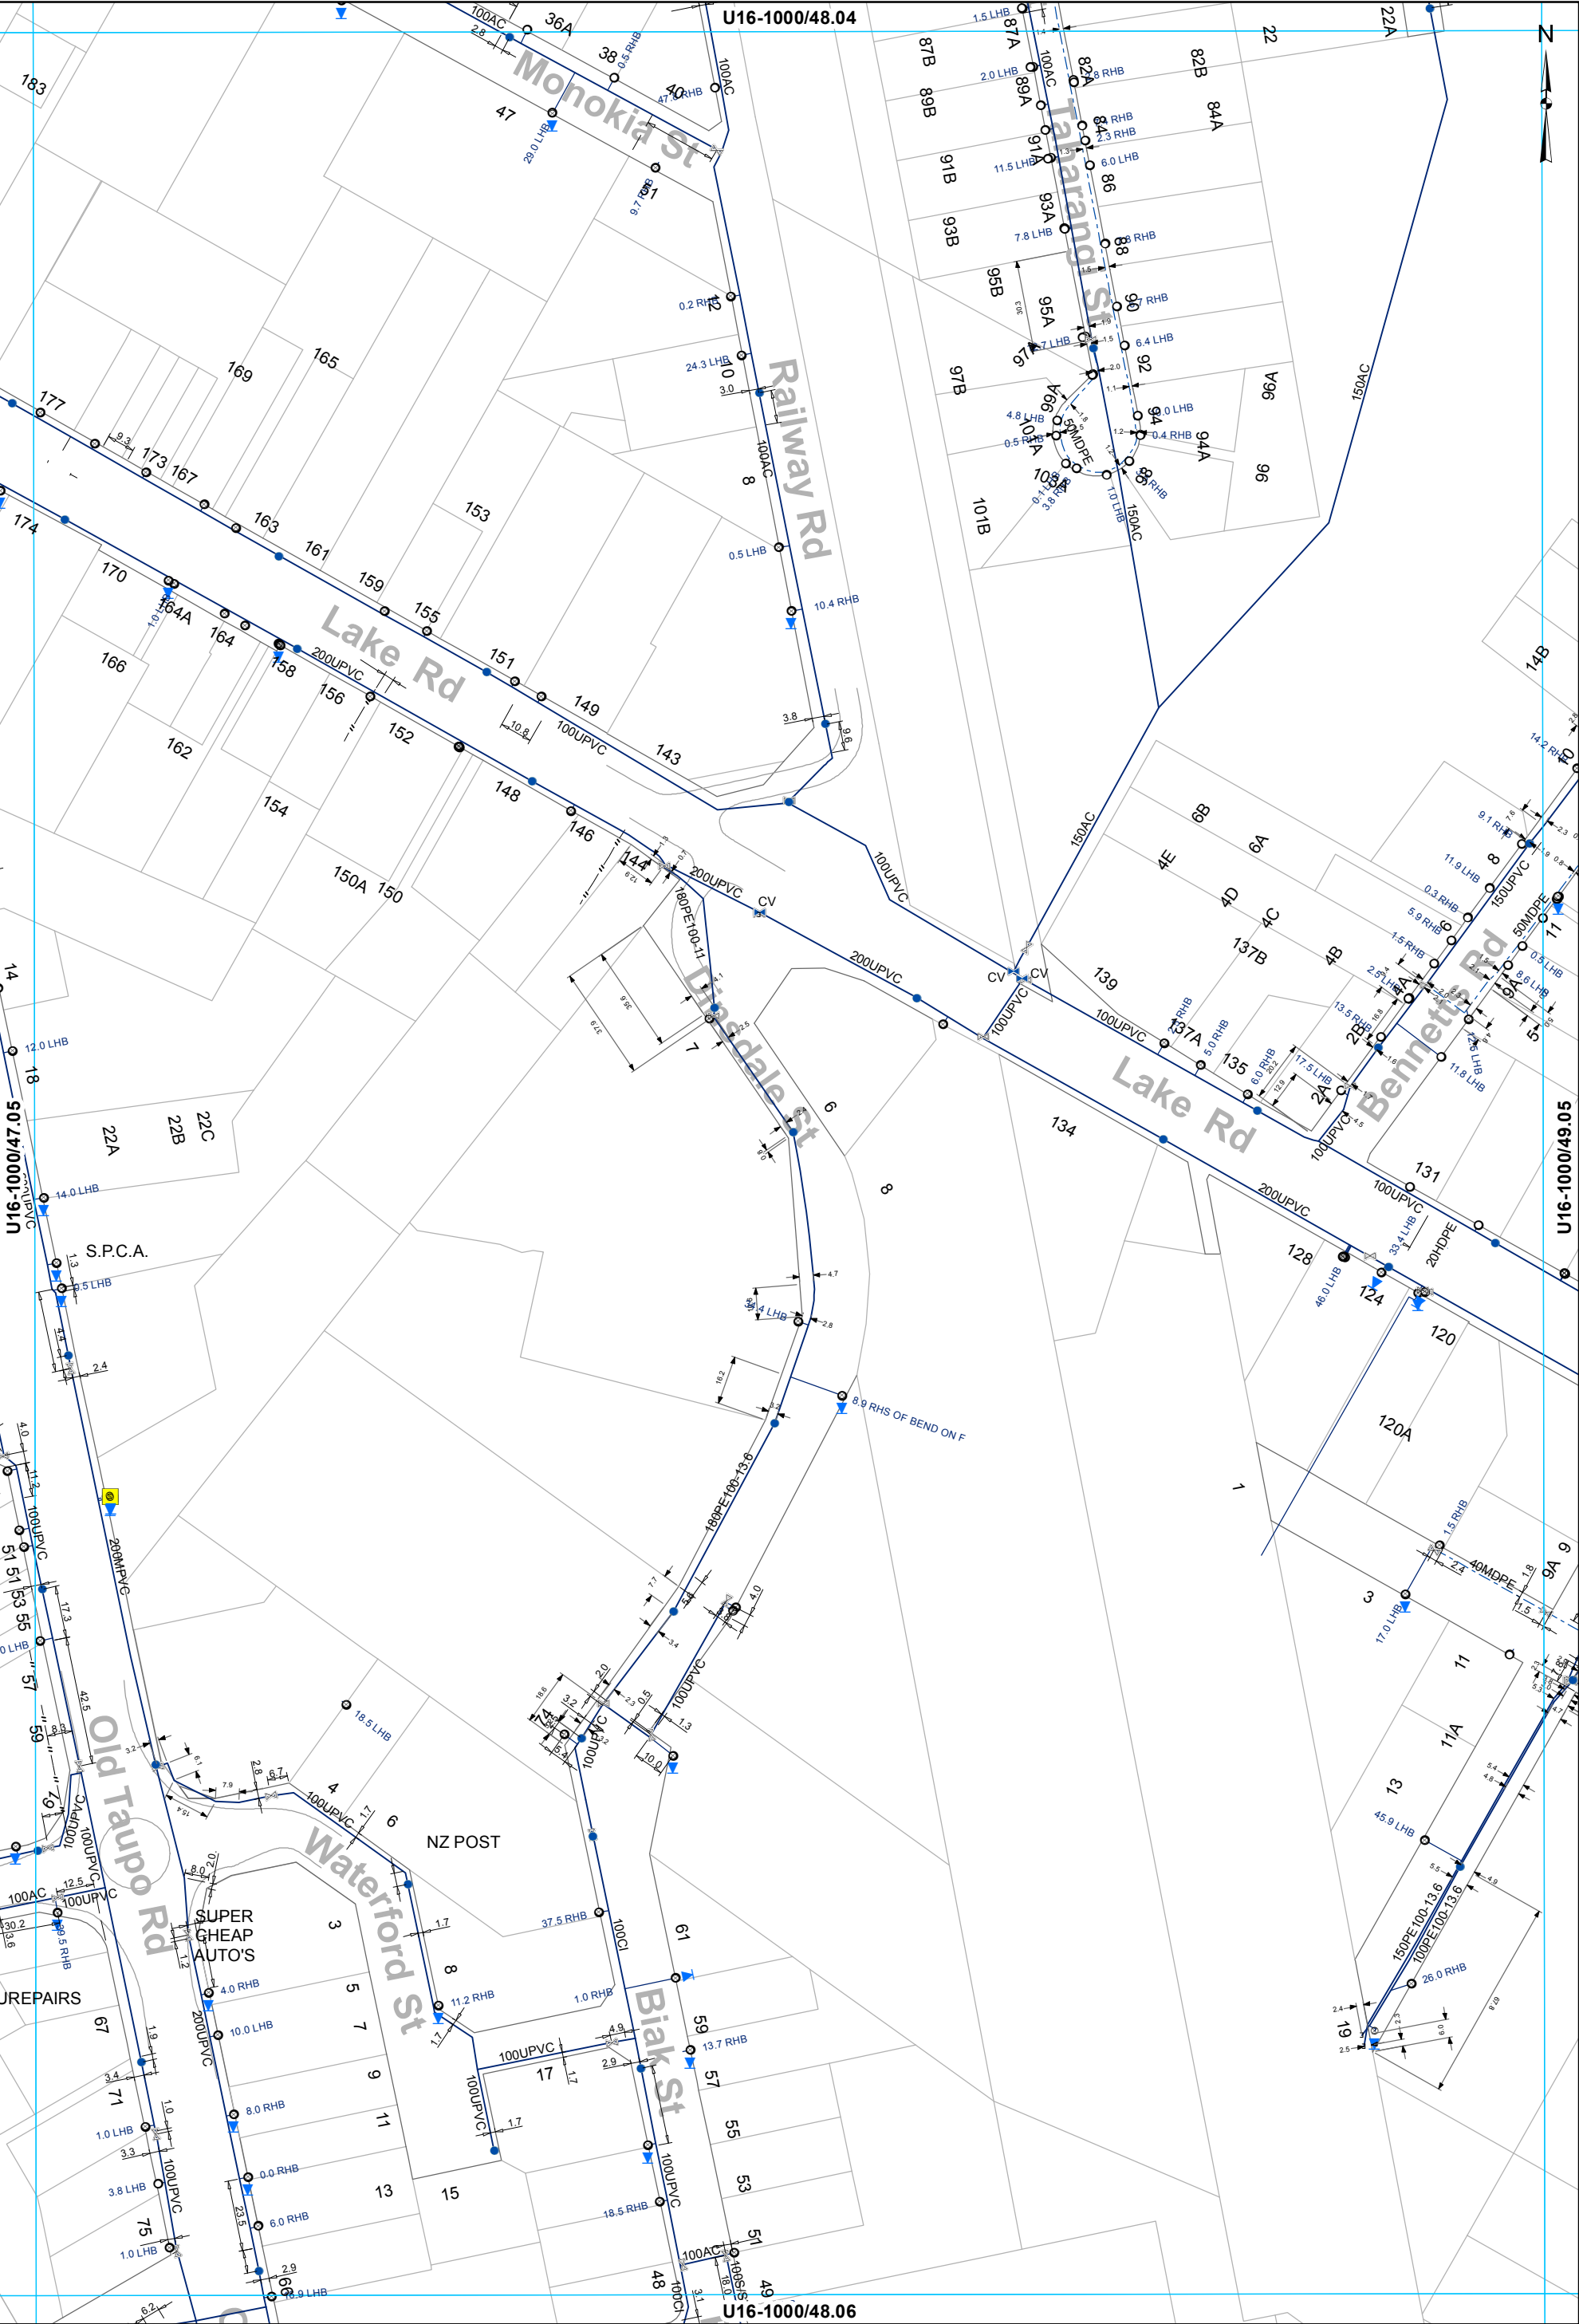


- | | | | | |
|--------------|------------|----------------|---------------|---------------|
| Valve | Hydrant | Meter Consumer | Miscellaneous | WSServiceLine |
| Toby | Capped End | | | Main |
| Closed Valve | | | | Rider main |

WATER SUPPLY SERVICES
1:2000 @ A3 - (U16-1000/48.05)

This data is derived from sources outside the control of Rotorua District Council and is for information only

All dimensions and levels should be verified by physical location on-site.

Rotorua District Council 2006. Facsimile 07 346 3143 Telephone 07 348 4199 email mail@rdc.govt.nz

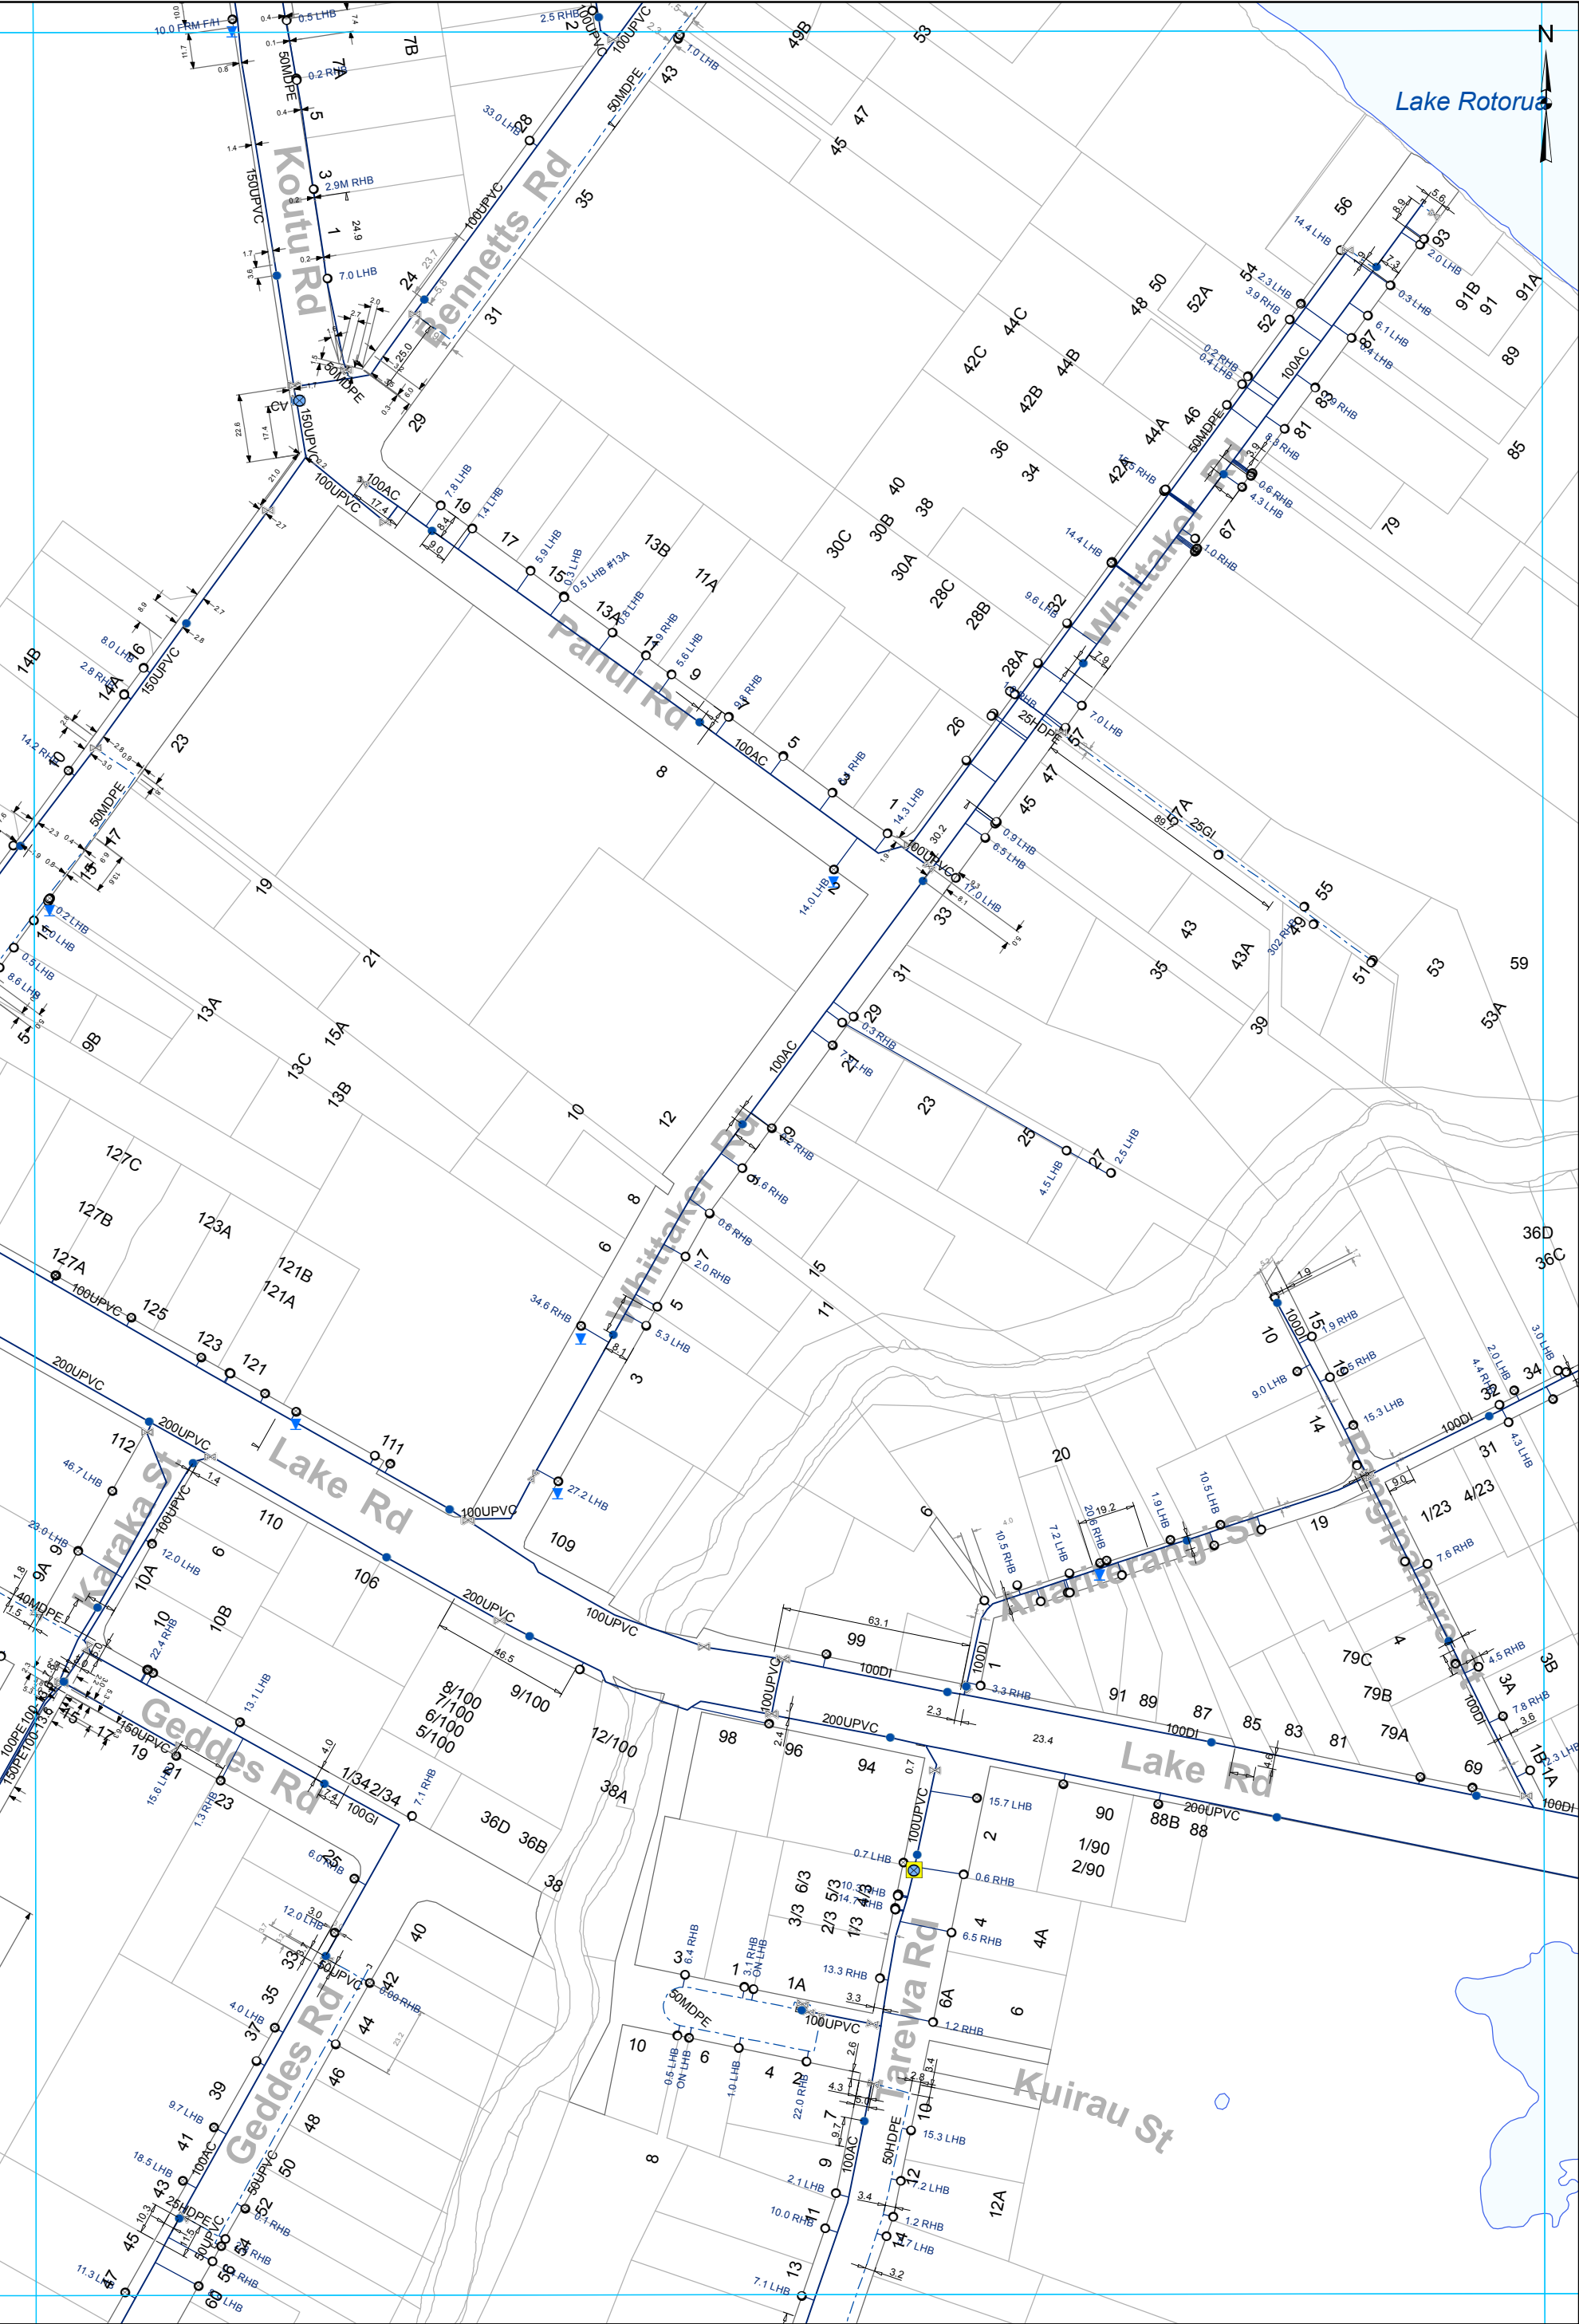

- | | | | | |
|----------------|-----------|------------------|-----------------|-----------------|
| ⌵ Valve | ● Hydrant | ⊙ Meter Bulk | ■ Miscellaneous | — WSServiceLine |
| ○ Toby | | ⊙ Meter Consumer | | — Main |
| ⌵ Closed Valve | | ⌵ Capped End | | --- Rider main |

WATER SUPPLY SERVICES
1:2000 @ A3 - (U16-1000/49.05)

U16-1000/50.04



Lake Rotorua

U16-1000/49.05

U16-1000/51.05

U16-1000/50.06

- | | | | | |
|-------|---------|----------------|---------------|---------------|
| Valve | Hydrant | Meter Consumer | Miscellaneous | WSServiceLine |
| Toby | | Capped End | | Main |
| | | | | Rider main |

WATER SUPPLY SERVICES
1:2000 @ A3 - (U16-1000/50.05)

All dimensions and levels should be verified by physical location on-site.


This data is derived from sources outside the control of Rotorua District Council and is for information only

Rotorua District Council 2006. Facsimile 07 346 3143 Telephone 07 348 4199 email mail@rdc.govt.nz






WATER SUPPLY SERVICES
1:2000 @ A3 - (U16-1000/41.06)

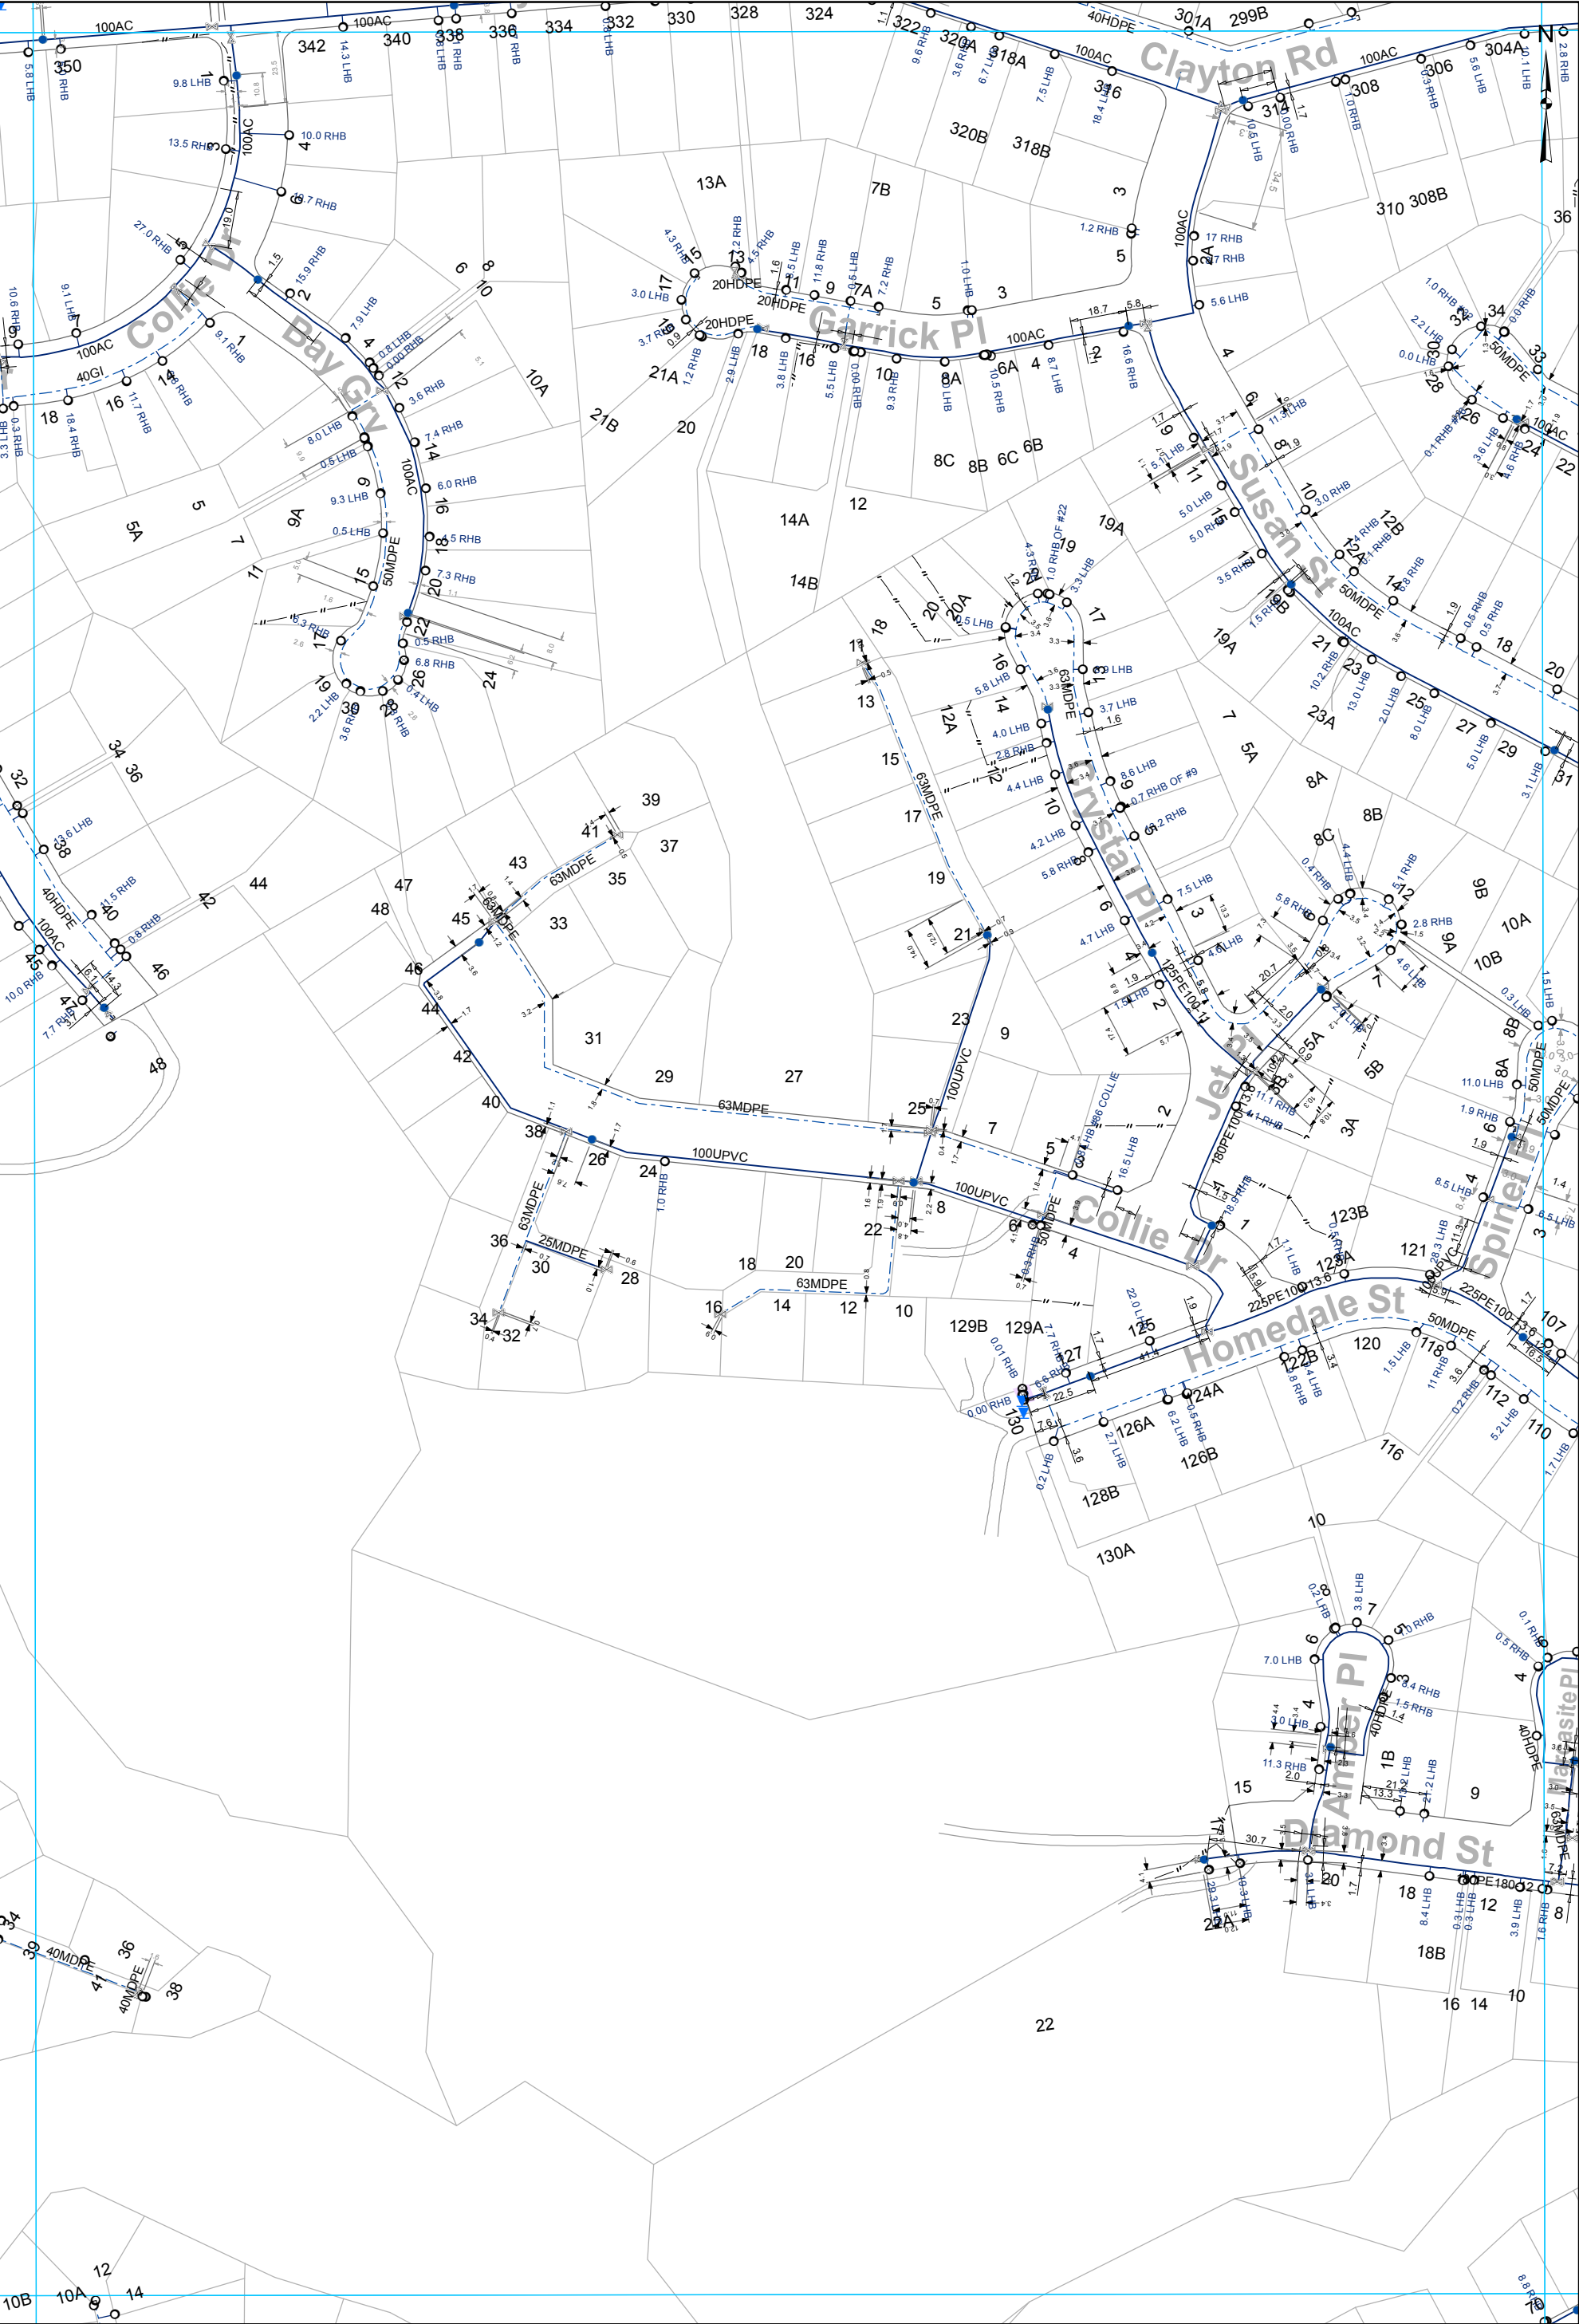

This data is derived from sources outside the control of Rotorua District Council and is for information only. All dimensions and levels should be verified by physical location on-site. Rotorua District Council 2006. Facsimile 07 346 3143 Telephone 07 348 4199 email mail@rdc.govt.nz

- Valve
- Hydrant
- Meter Consumer
- Capped End
- Toby
- WSServiceLine
- Main
- Rider main

WATER SUPPLY SERVICES
1:2000 @ A3 - (U16-1000/42.06)

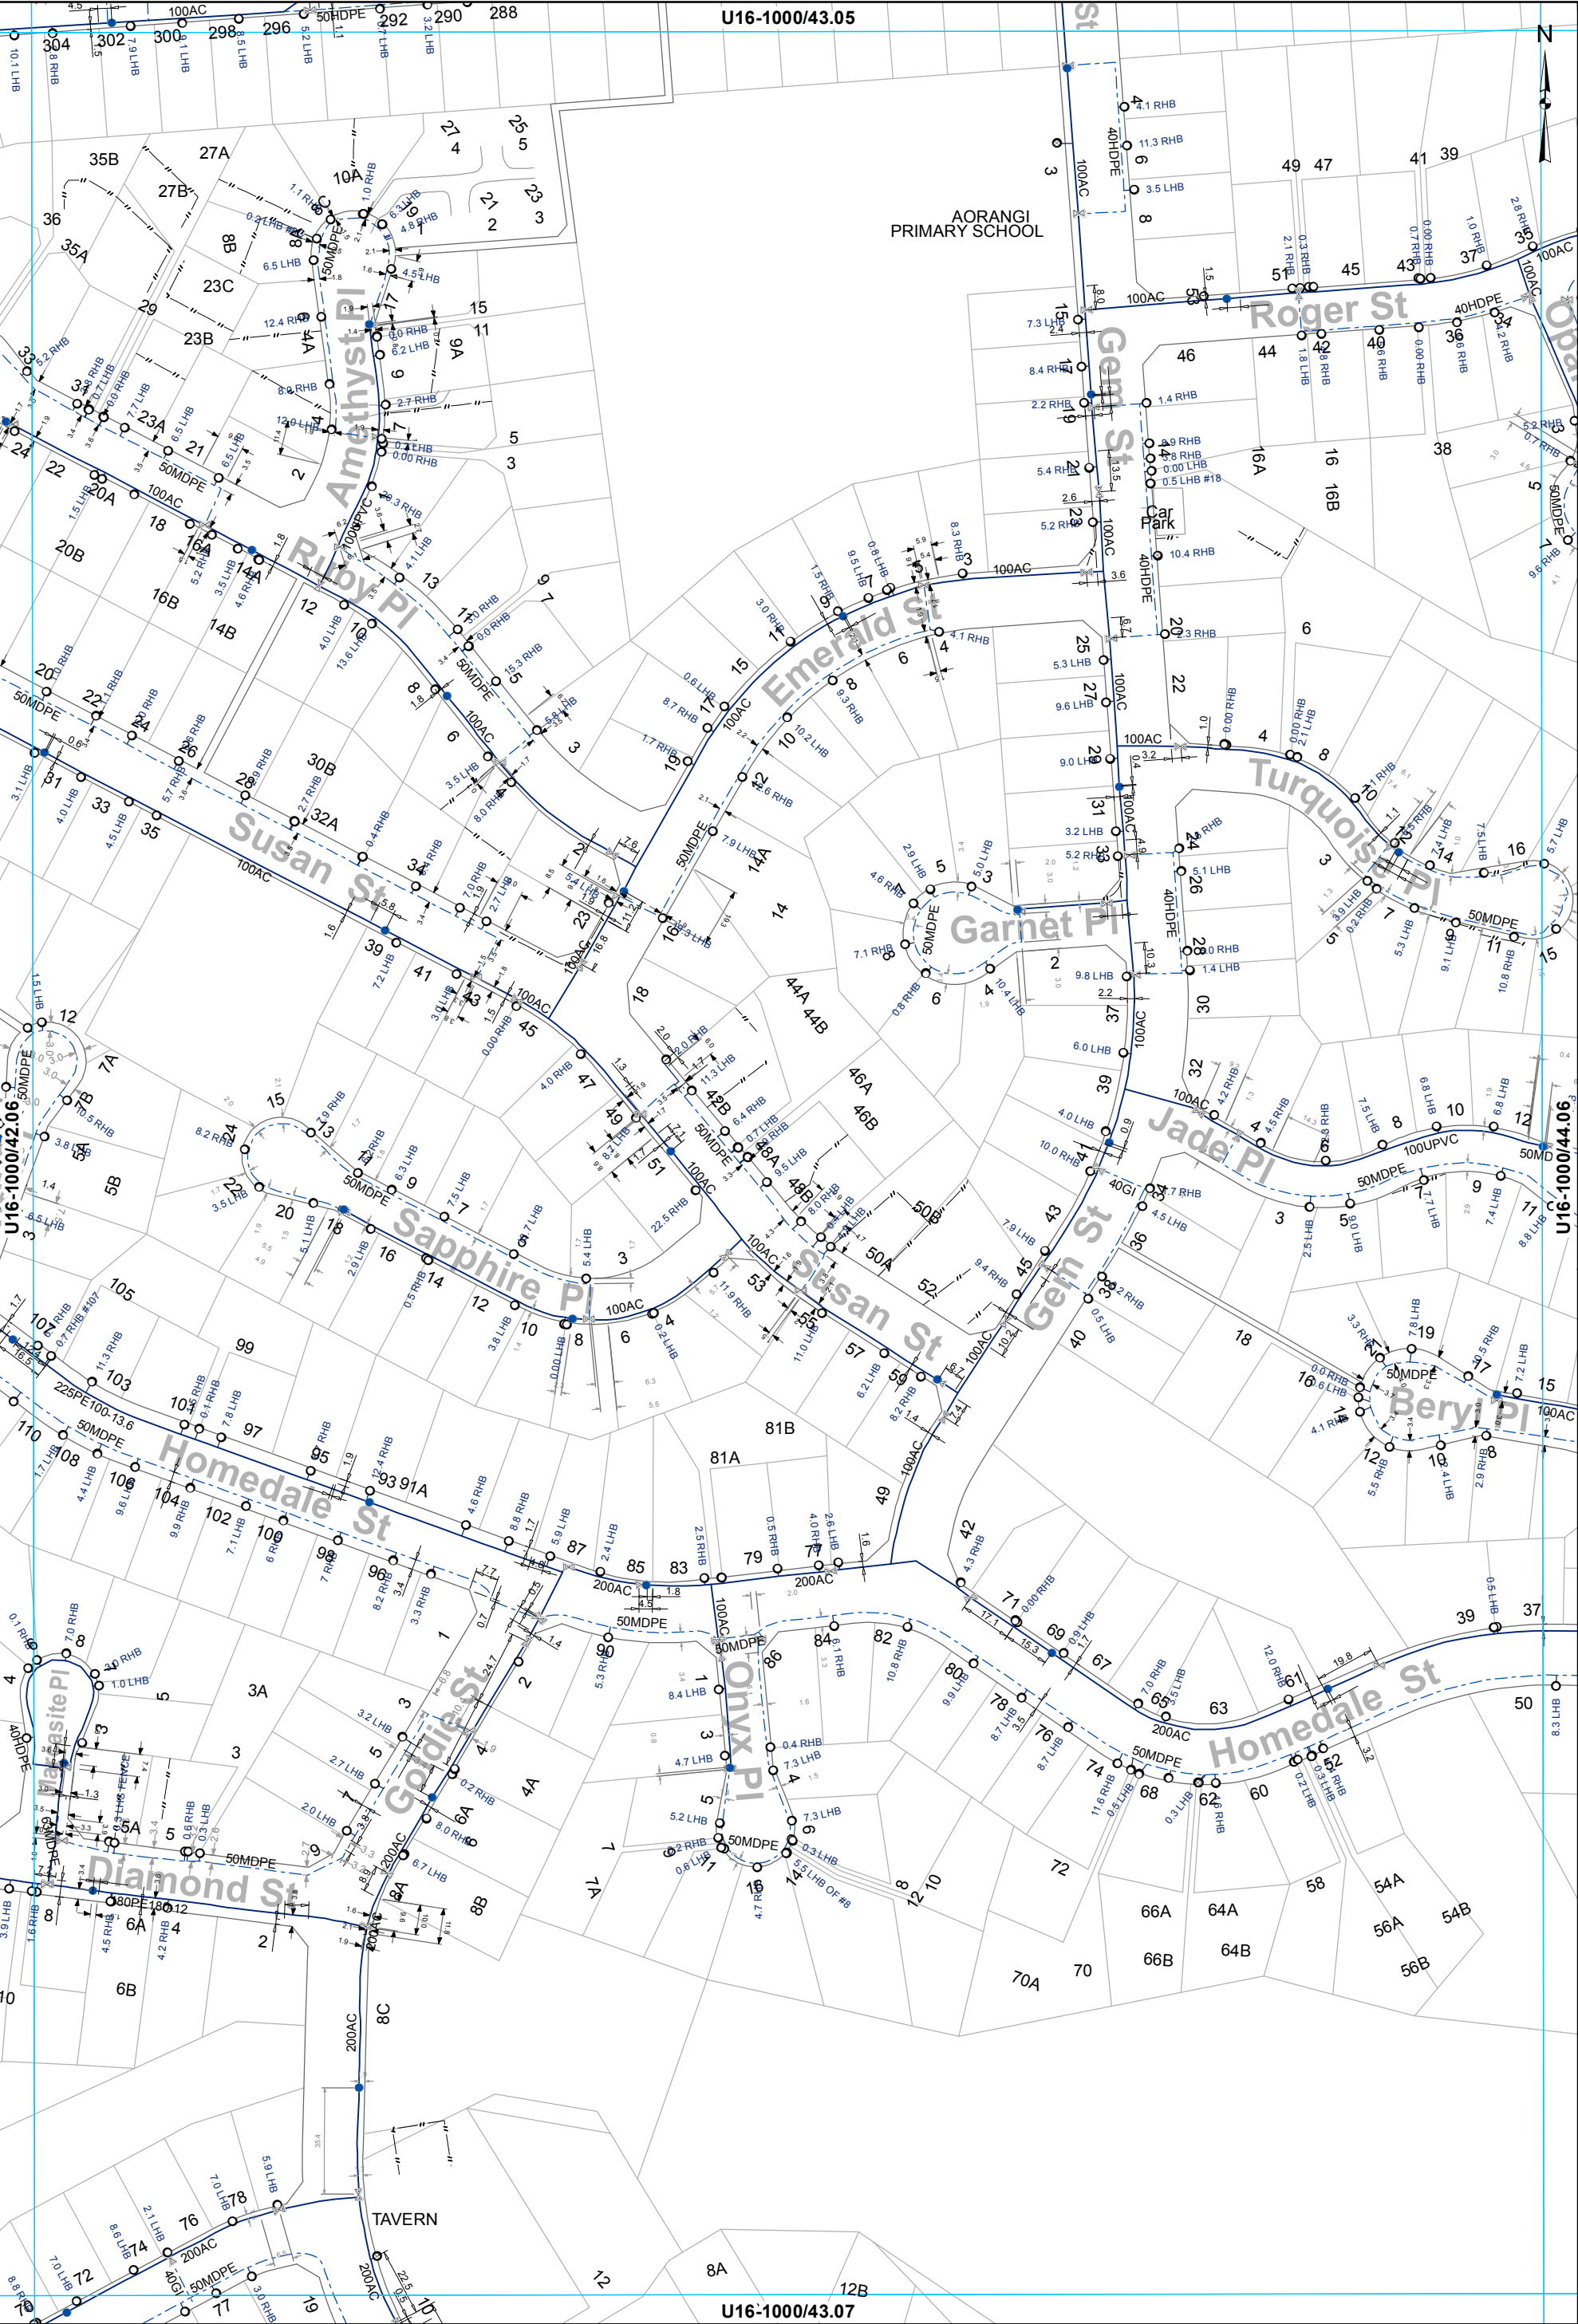


- Valve
- Hydrant
- Meter Consumer
- WSServiceLine
- Toby
- Capped End
- Main
- Rider main

WATER SUPPLY SERVICES
1:2000 @ A3 - (U16-1000/43.06)

This data is derived from sources outside the control of Rotorua District Council and is for information only

 Rotorua District Council 2006. Facsimile 07 346 3143 Telephone 07 348 4199 email mail@rdc.govt.nz




All dimensions and levels should be verified by physical location on-site.

This data is derived from sources outside the control of Rotorua District Council and is for information only


- WATER SUPPLY SERVICES**
1:2000 @ A3 - (U16-1000/44.06)

SERVICE STATION

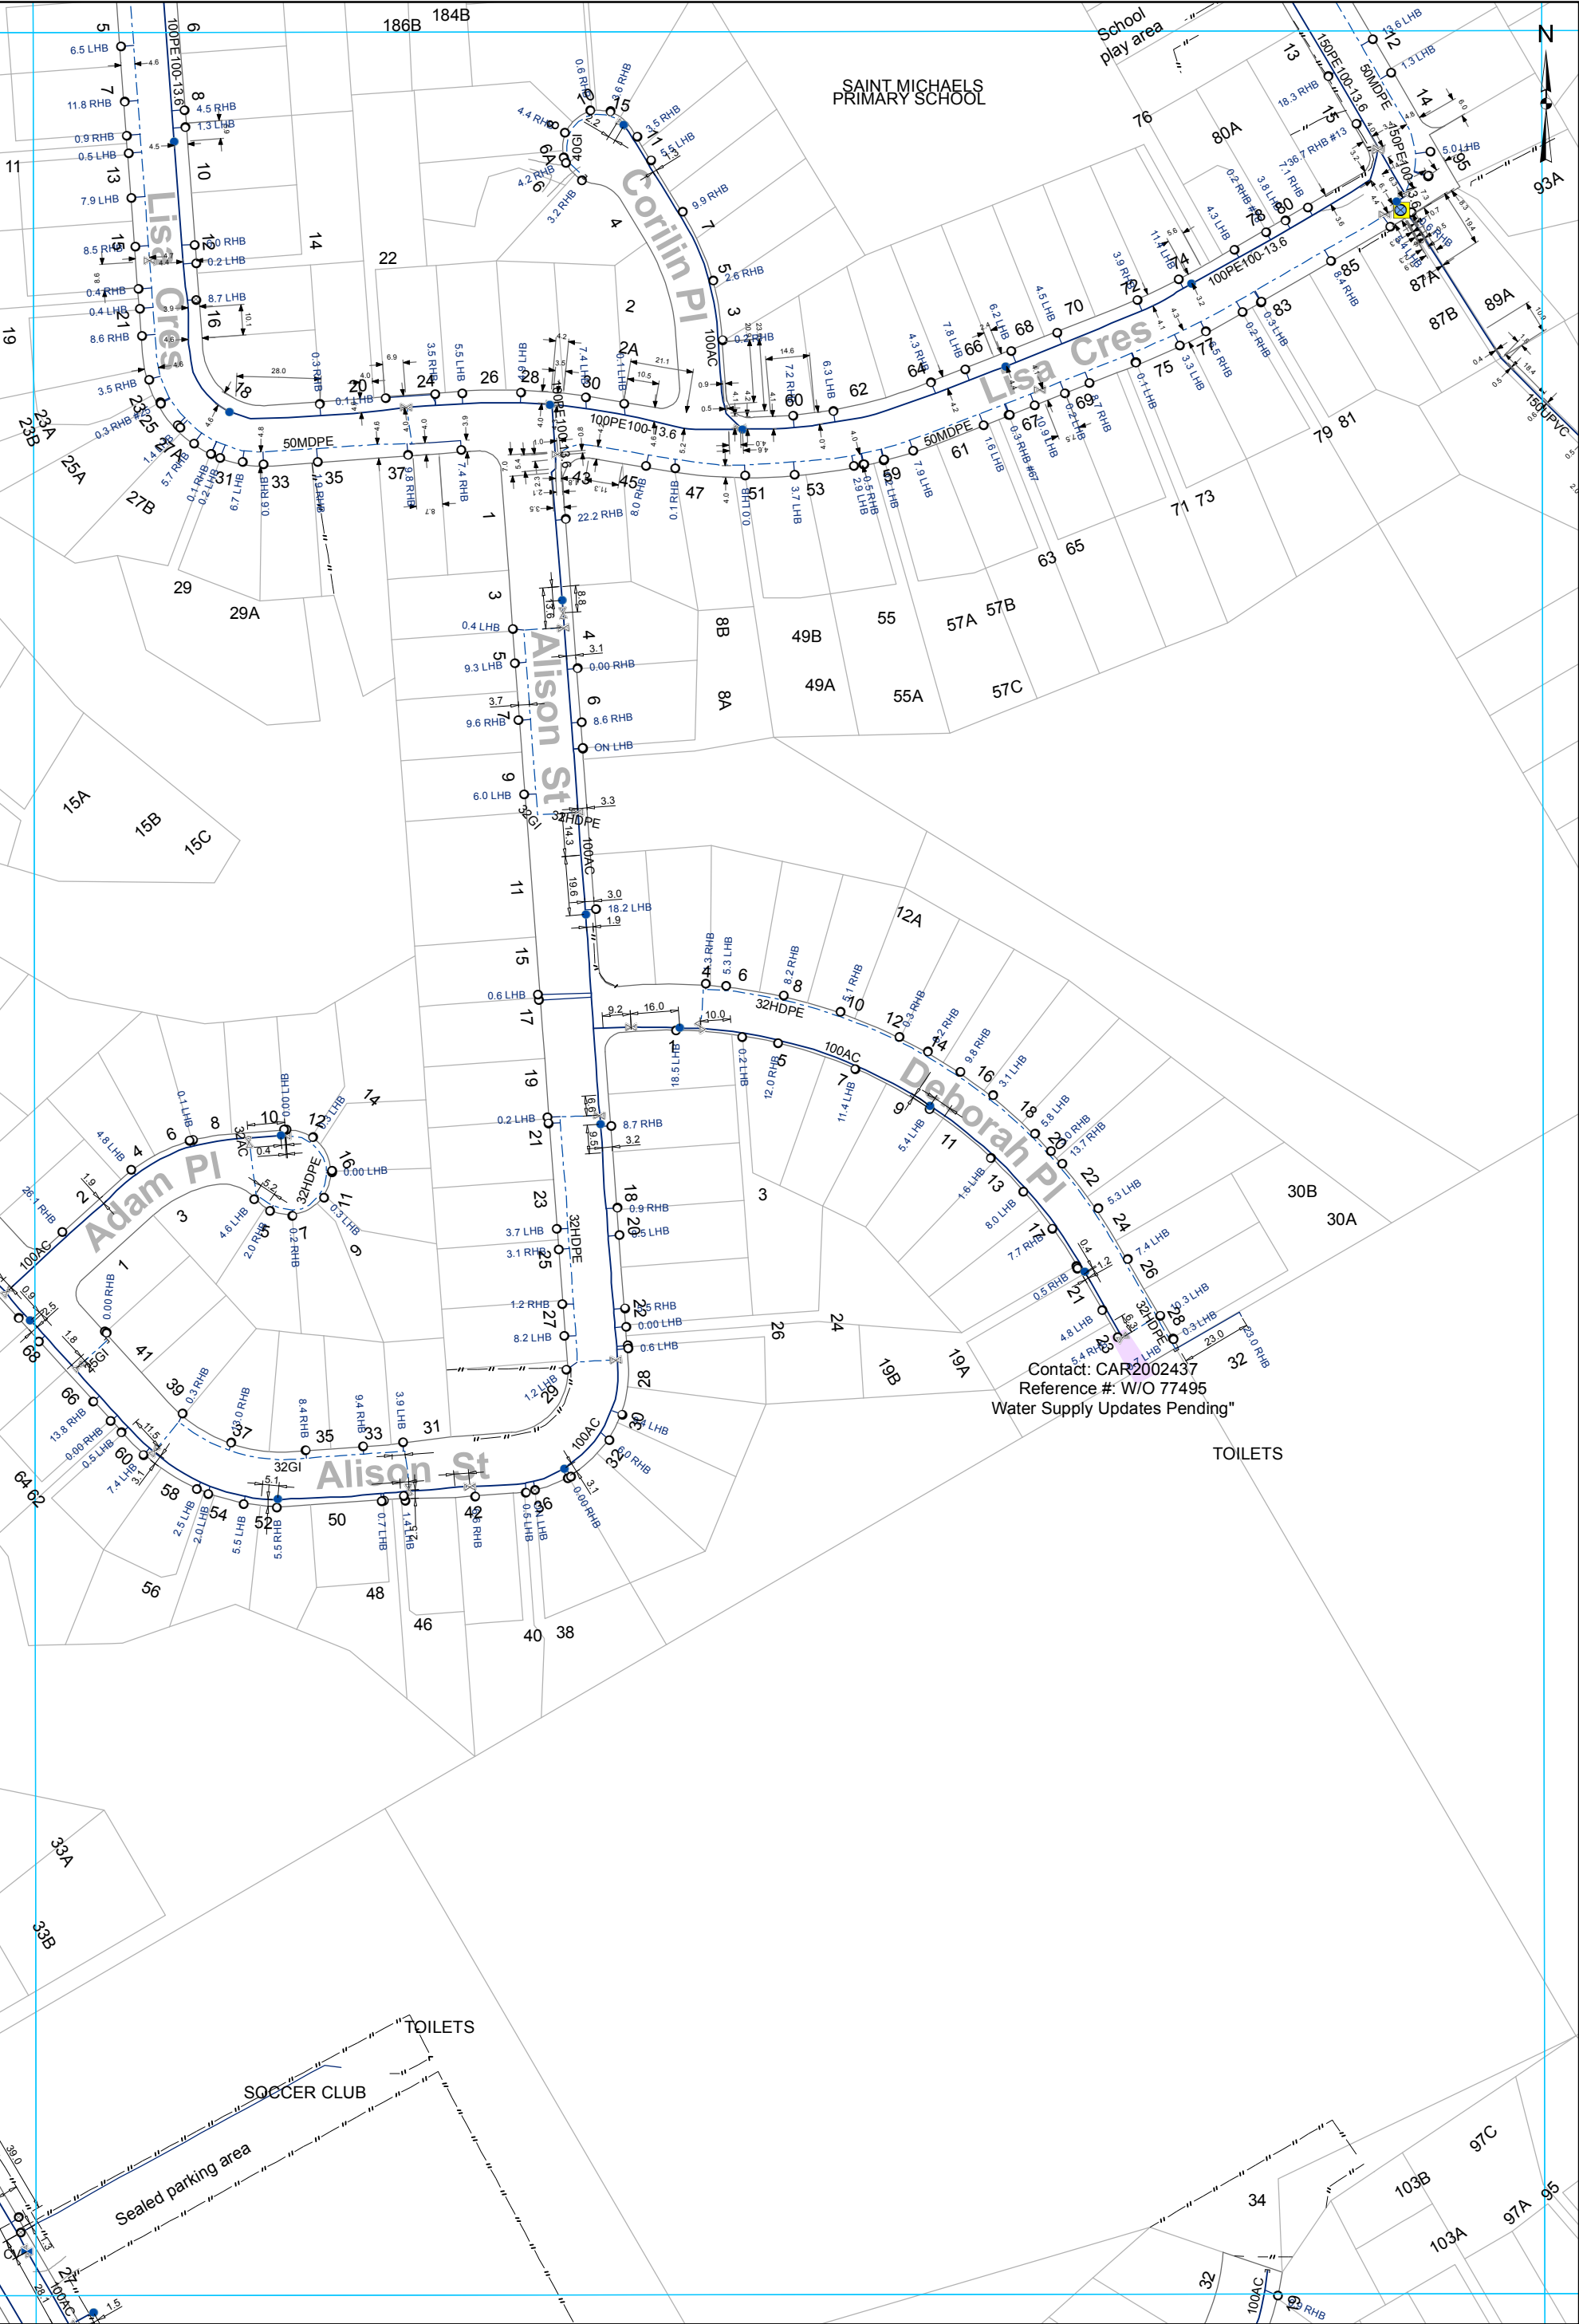

- Valve
Toby
Closed Valve
Hydrant
Meter Bulk
Meter Consumer
Capped End
Miscellaneous
WSServiceLine
Main
Rider main

WATER SUPPLY SERVICES
1:2000 @ A3 - (U16-1000/45.06)

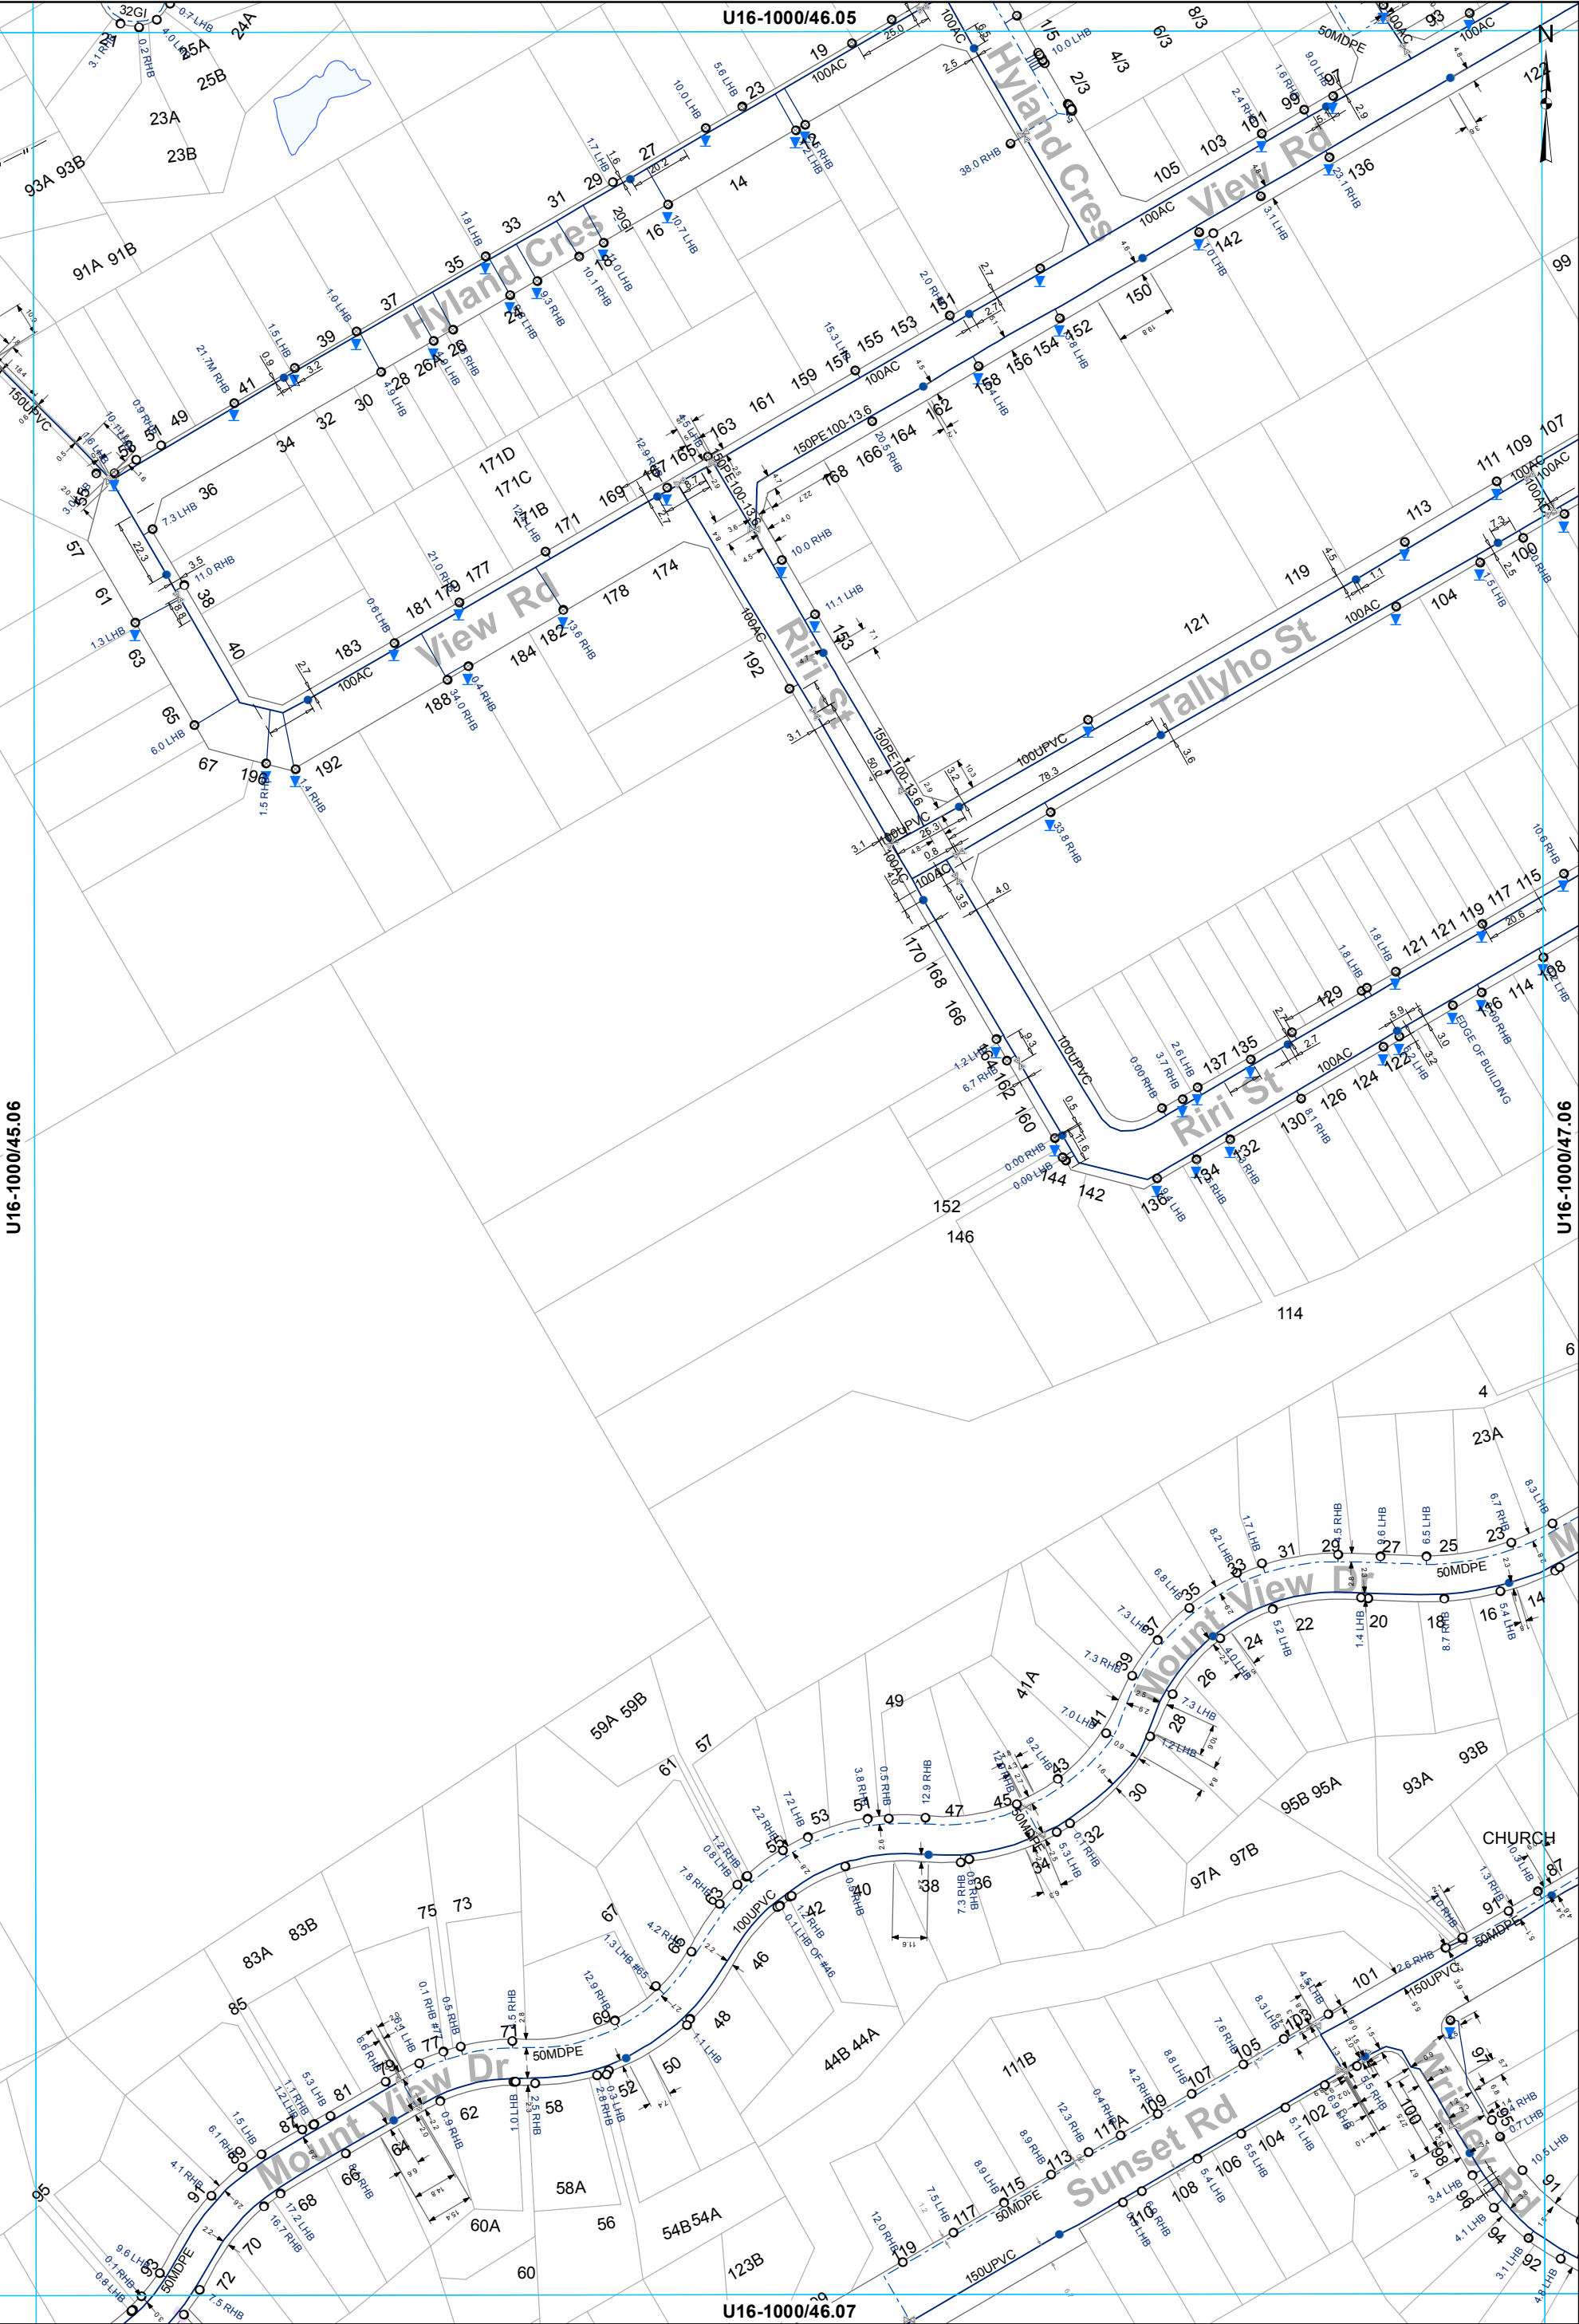


- | | | | |
|-------|---------|----------------|---------------|
| Valve | Hydrant | Meter Consumer | WSServiceLine |
| Toby | | Capped End | Main |
| | | | Rider main |

WATER SUPPLY SERVICES
1:2000 @ A3 - (U16-1000/46.06)

This data is derived from sources outside the control of Rotorua District Council and is for information only

All dimensions and levels should be verified by physical location on-site.

Rotorua District Council 2006. Facsimile 07 346 3143 Telephone 07 348 4199 email mail@rdc.govt.nz

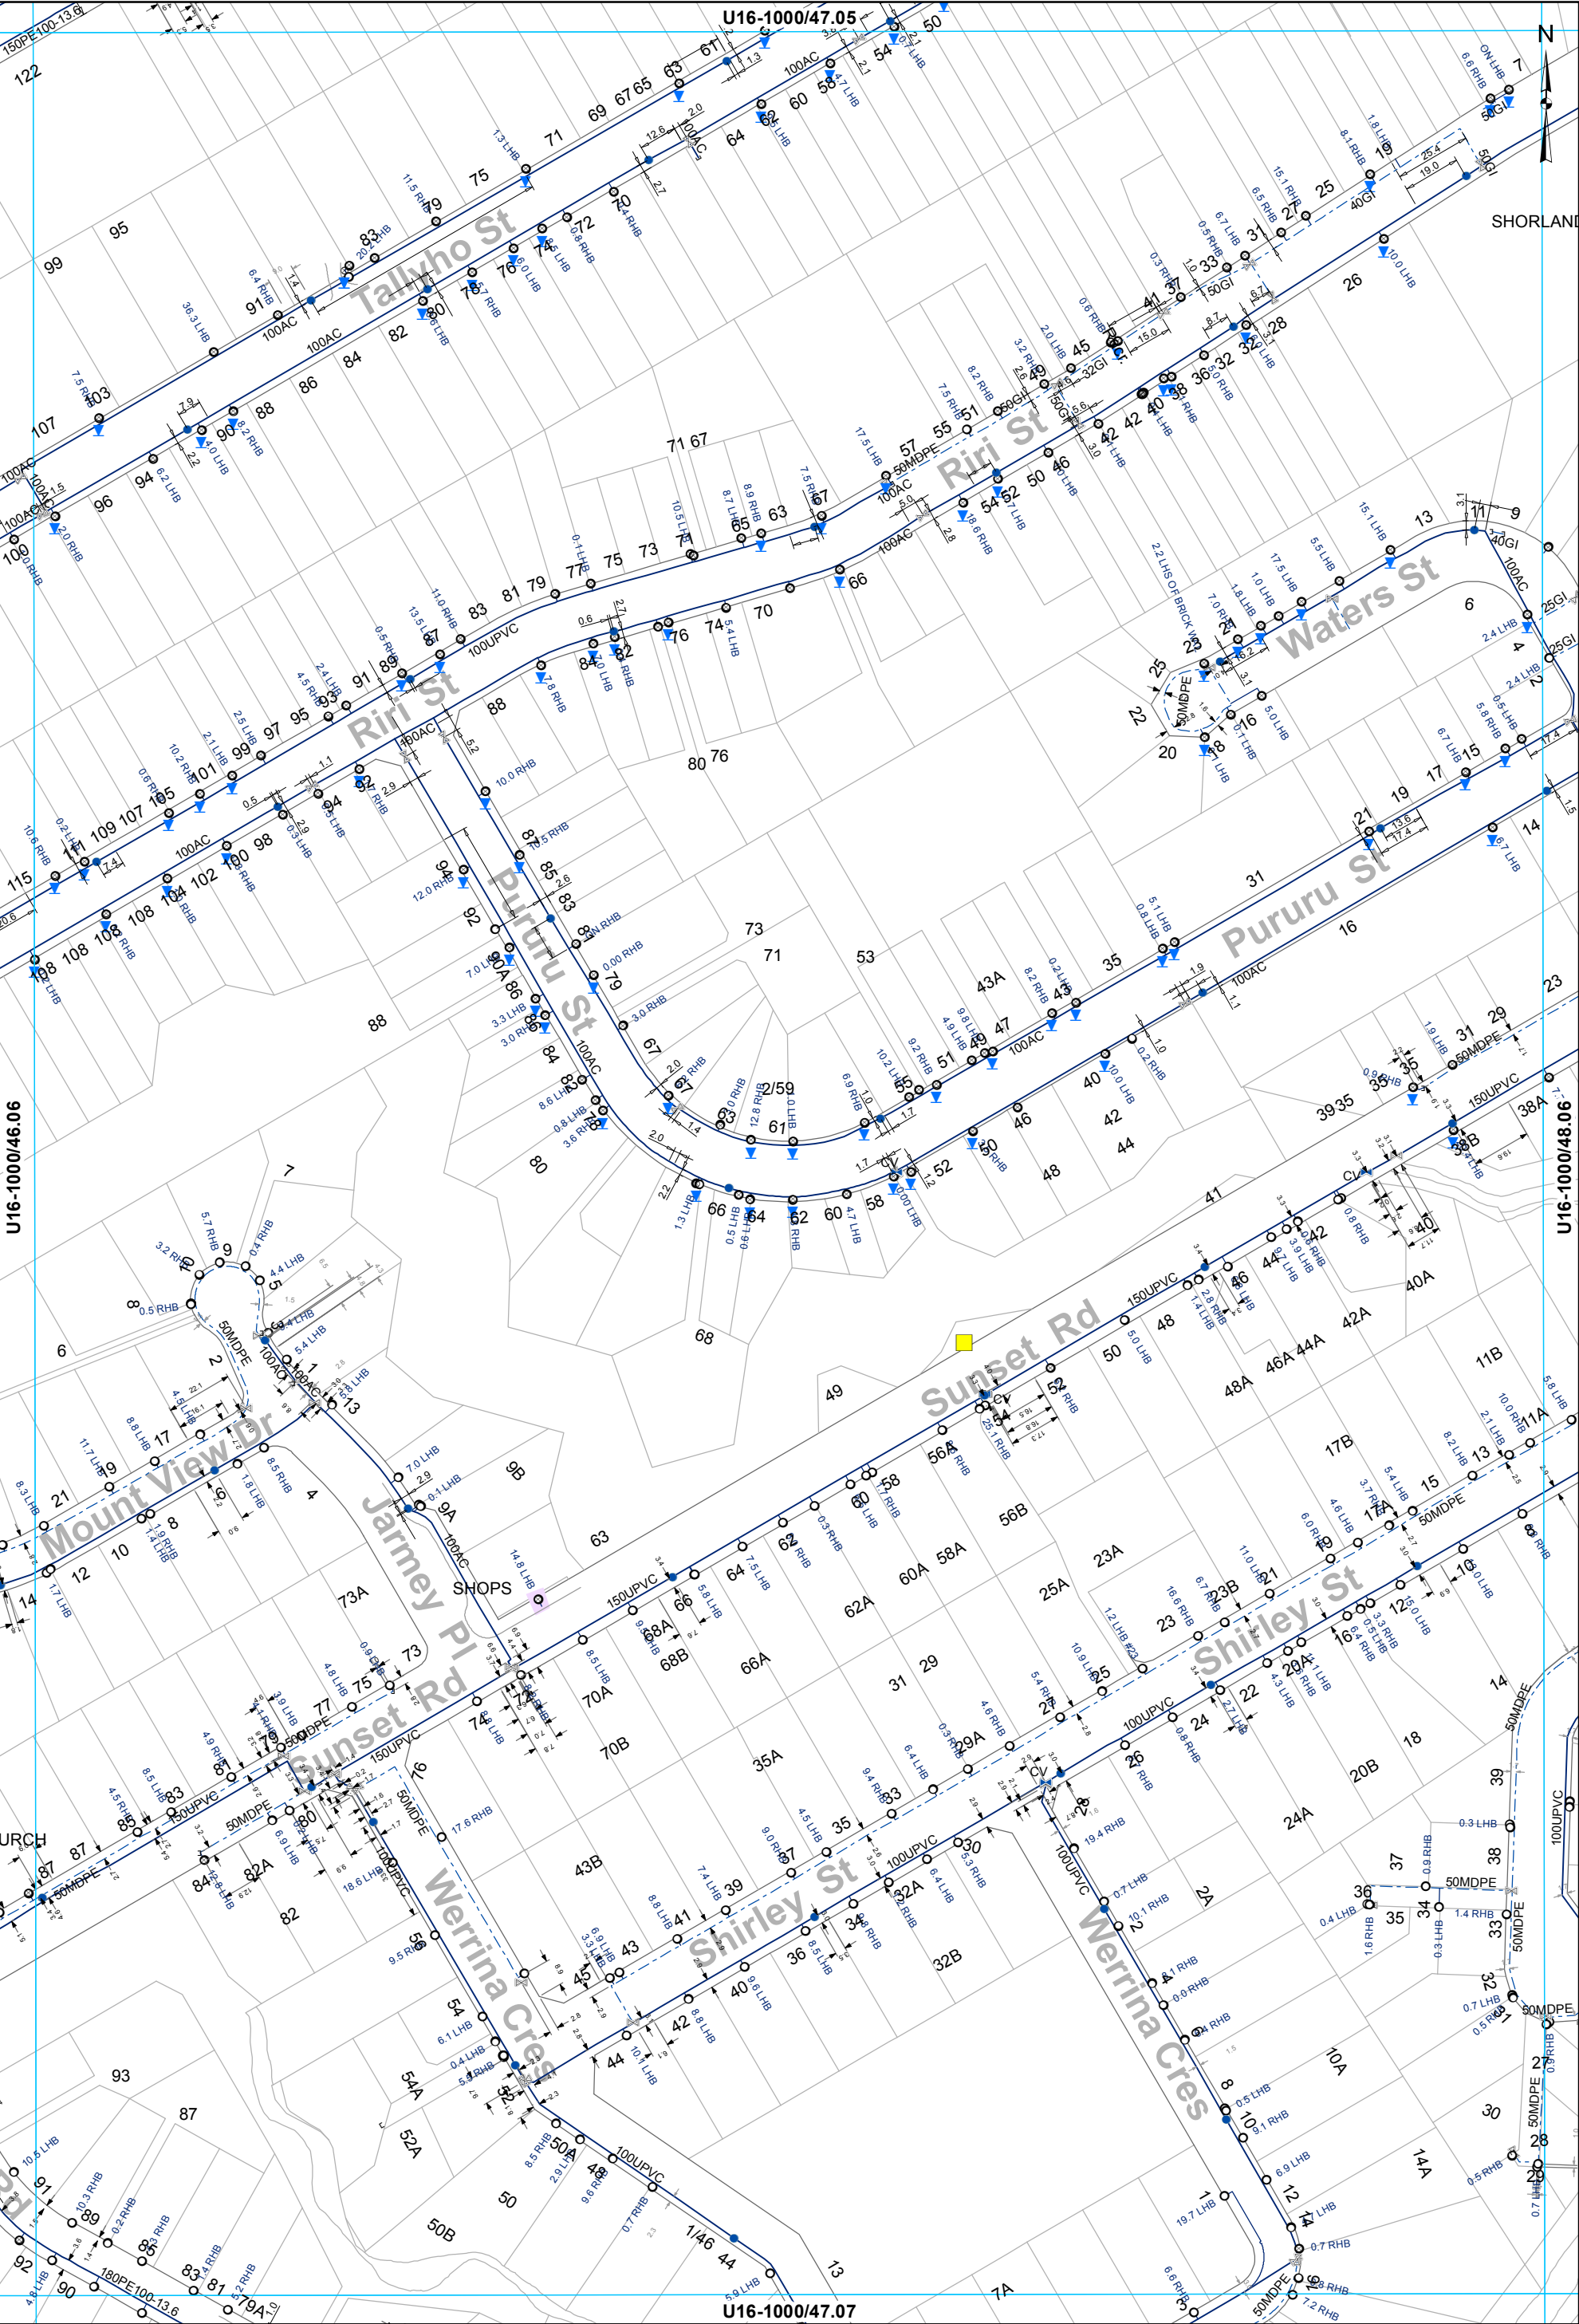

- Valve
- Hydrant
- Meter Consumer
- Miscellaneous
- WSServiceLine
- Toby
- Capped End
- Main
- Rider main
- Closed Valve

WATER SUPPLY SERVICES
1:2000 @ A3 - (U16-1000/47.06)

This data is derived from sources outside the control of Rotorua District Council and is for information only.

Rotorua District Council 2006. Facsimile 07 346 3143 Telephone 07 348 4199 email mail@rdc.govt.nz




- | | | | | |
|--------------|---------|----------------|---------------|---------------|
| Valve | Hydrant | Meter Bulk | Miscellaneous | WSServiceLine |
| Toby | | Meter Consumer | | Main |
| Closed Valve | | Capped End | | Rider main |

WATER SUPPLY SERVICES
1:2000 @ A3 - (U16-1000/48.06)

This data is derived from sources outside the control of Rotorua District Council and is for information only

All dimensions and levels should be verified by physical location on-site.

Rotorua District Council 2006. Facsimile 07 346 3143 Telephone 07 348 4199 email mail@rdc.govt.nz

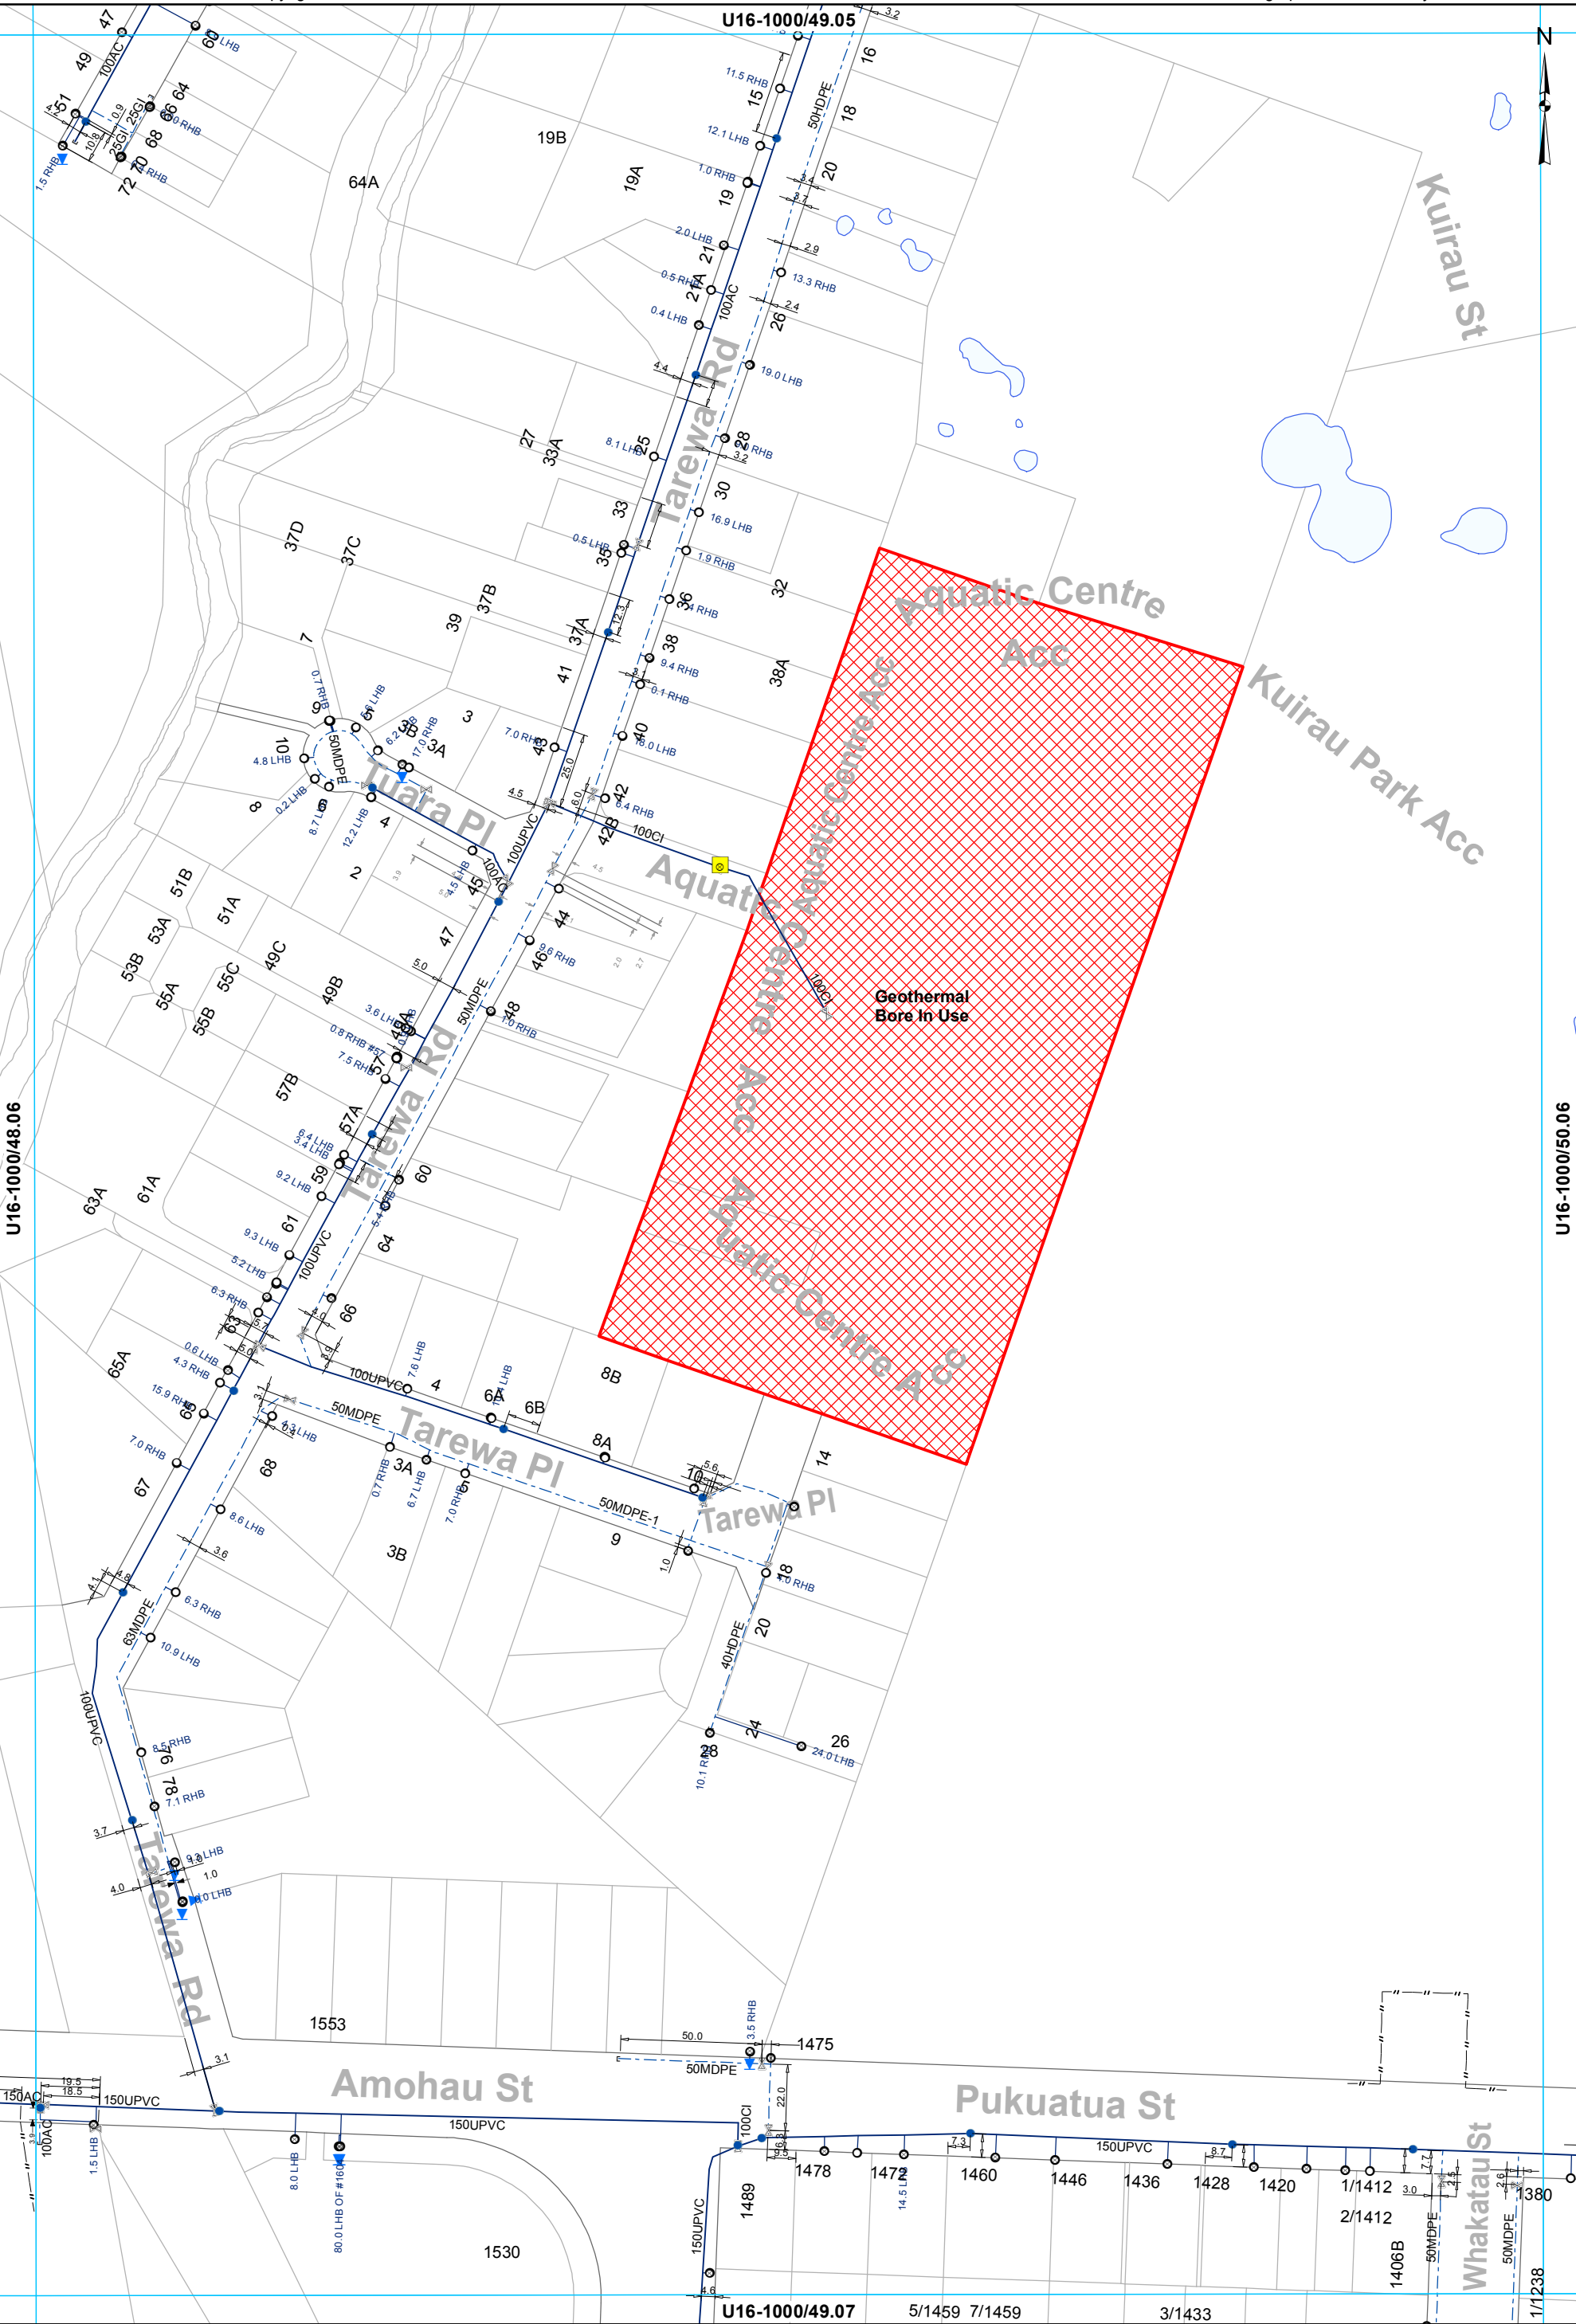

- ⌵

Valve

●

Hydrant

⊙

Meter Consumer

■

Miscellaneous

—

WSServiceLine

○

Toby

⌵

Capped End

—


Main

- - -

Rider main
- WATER SUPPLY SERVICES**
1:2000 @ A3 - (U16-1000/49.06)
- This data is derived from sources outside the control of Rotorua District Council and is for information only
- U16-1000/50.06
- All dimensions and levels should be verified by physical location on-site.
- Rotorua District Council 2006. Facsimile 07 346 3143 Telephone 07 348 4199 email mail@rdc.govt.nz



WATER SUPPLY SERVICES
1:2000 @ A3 - (U16-1000/50.06)

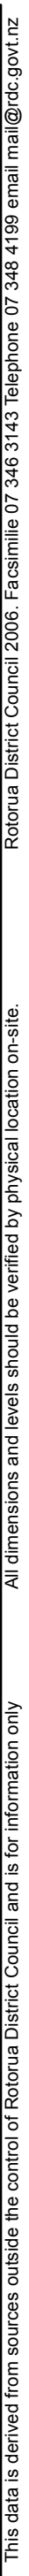

All dimensions and levels should be verified by physical location on-site.

This data is derived from sources outside the control of Rotorua District Council and is for information only


- Valve
 Hydrant
 Meter Consumer
 Miscellaneous
 WSServiceLine
 Toby
 Capped End
 Main
 Closed Valve
 Rider main

WATER SUPPLY SERVICES
1:2000 @ A3 - (U16-1000/51.06)

U16-1000/53.06

All dimensions and levels should be verified by physical location on-site.


This data is derived from sources outside the control of Rotorua District Council and is for information only

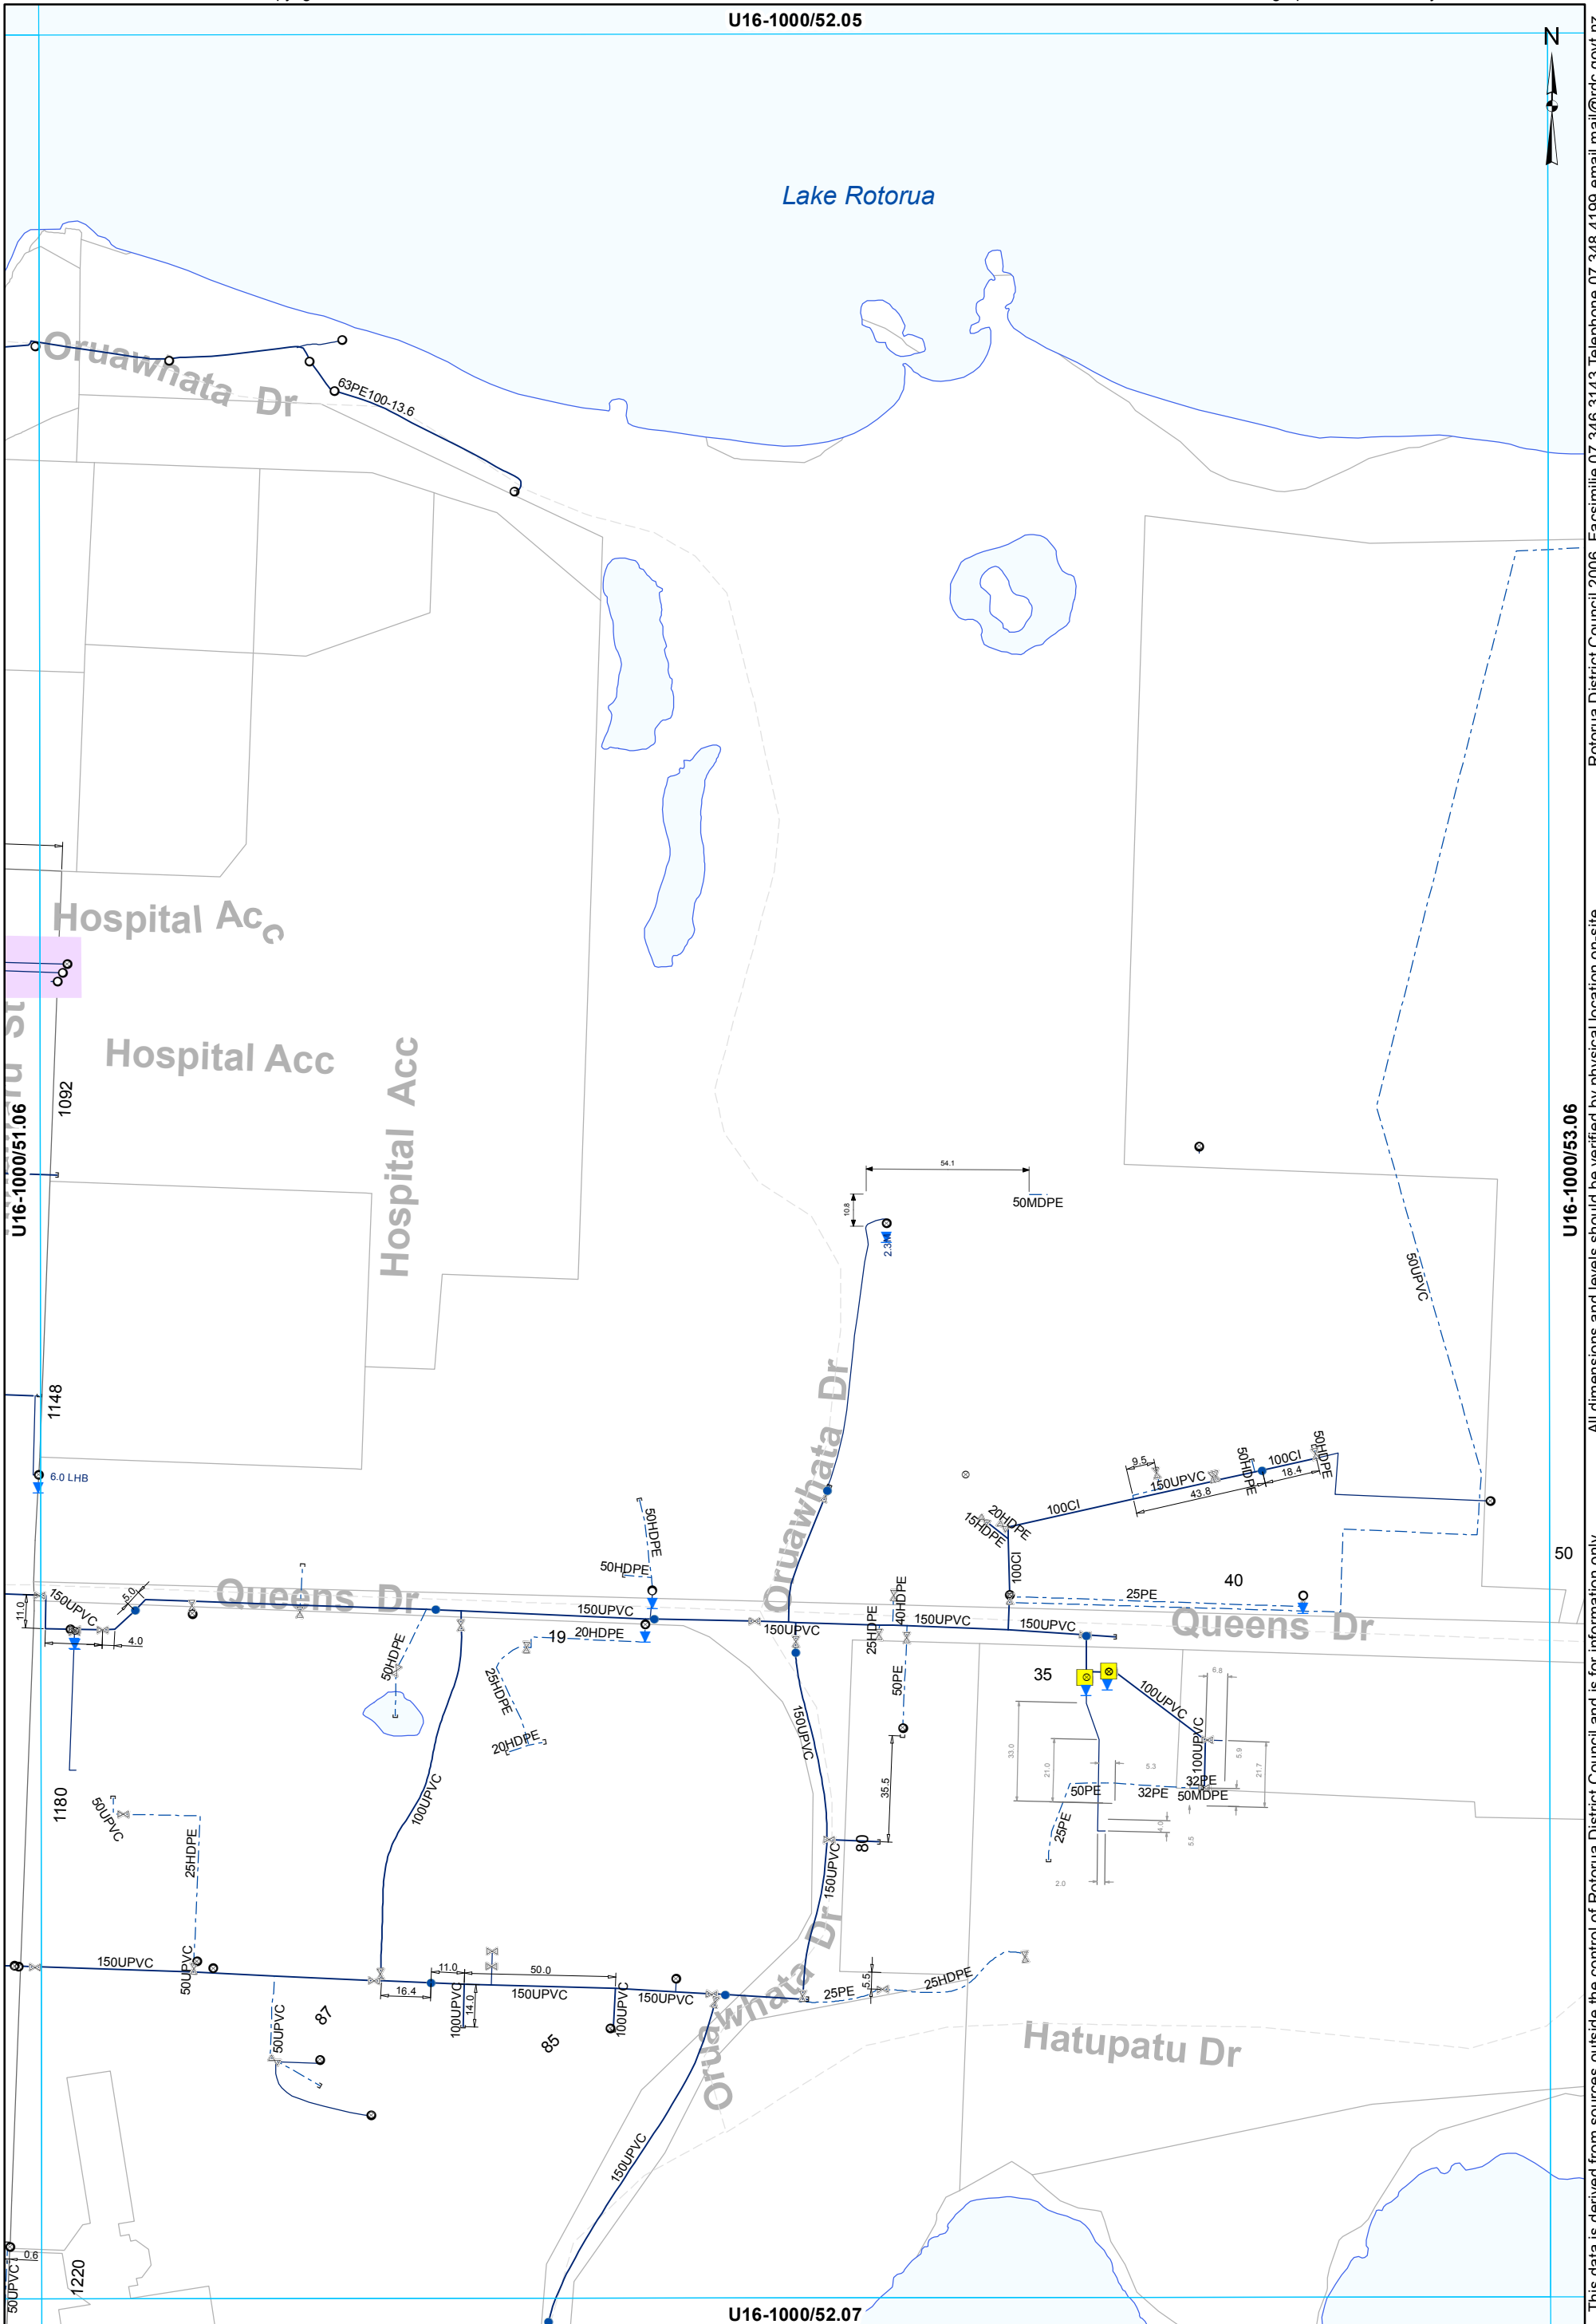


 Valve
  Hydrant
  Meter Consumer
  Miscellaneous
  WSServiceLine

 Toby
  Capped End
  Main
  Rider main

WATER SUPPLY SERVICES
1:2000 @ A3 - (U16-1000/52.06)

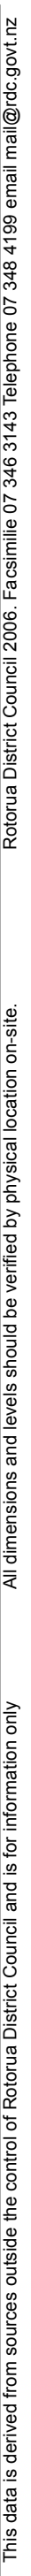

WATER SUPPLY SERVICES
1:2000 @ A3 - (U16-1000/53.06)

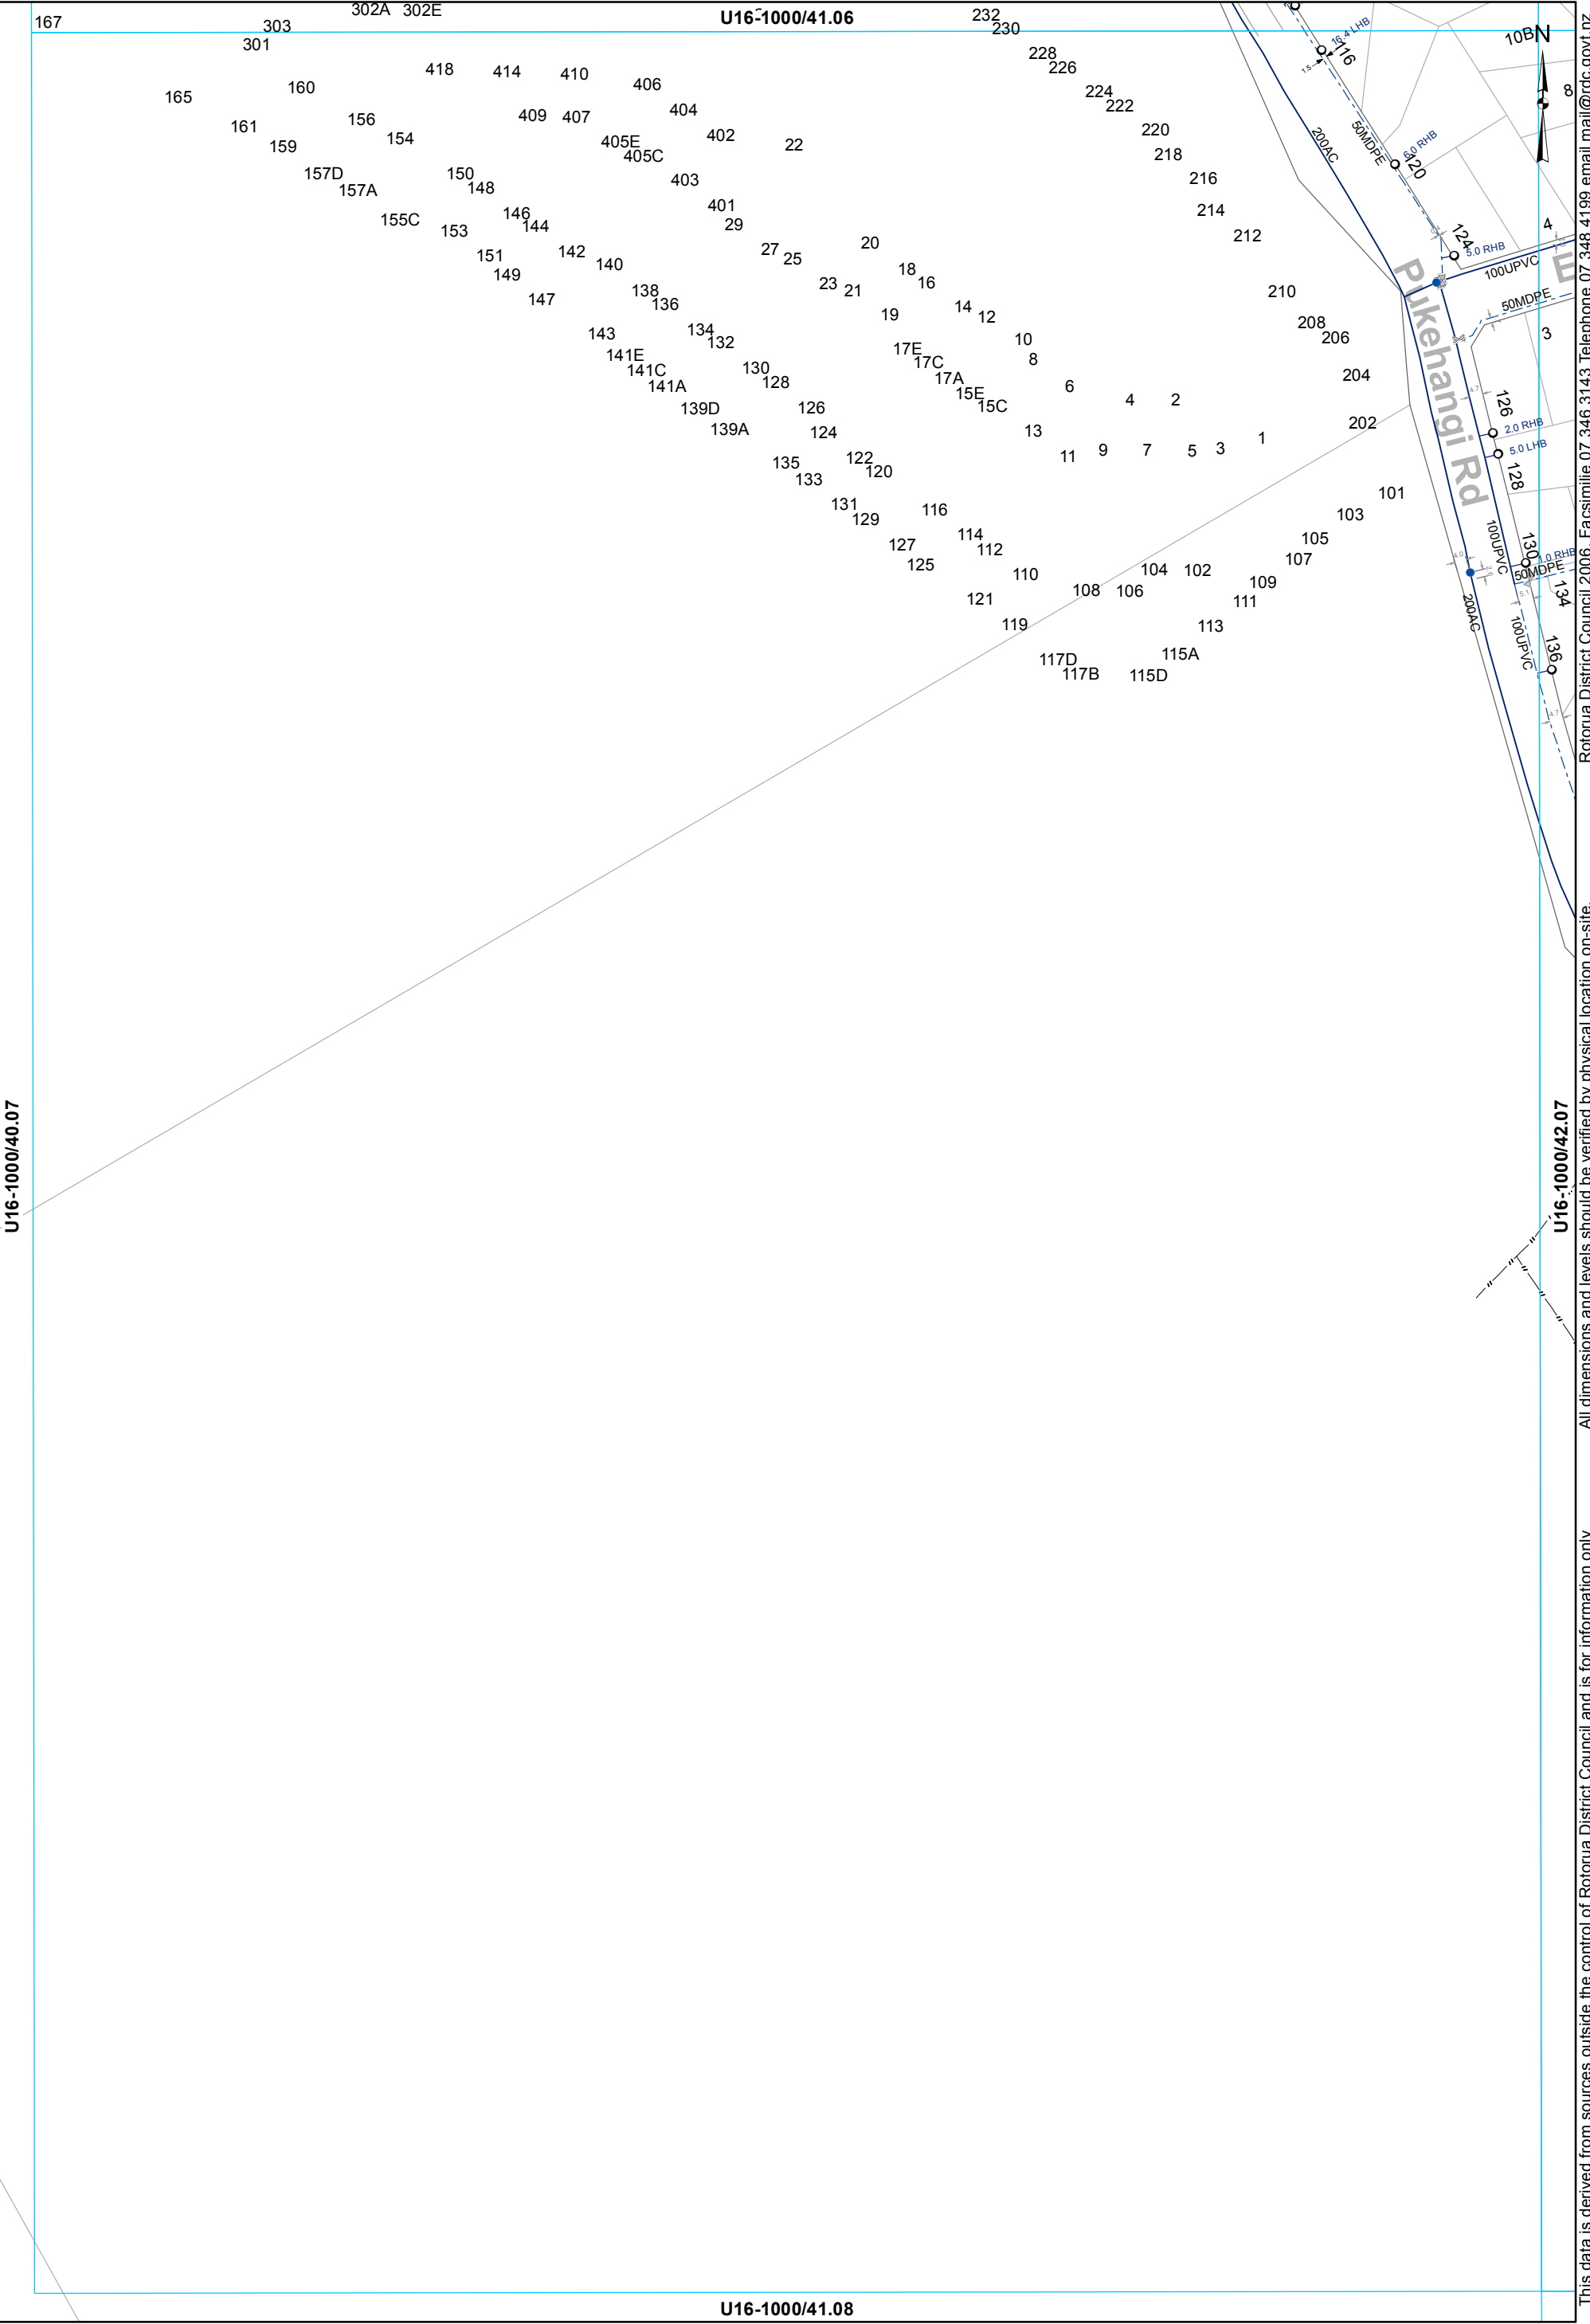

- ⊗

Valve

●

Hydrant

—

WSServiceLine
- Toby

⌒

Capped End

—


Main
- Rider main

WATER SUPPLY SERVICES
1:2000 @ A3 - (U16-1000/41.07)

This data is derived from sources outside the control of Rotorua District Council and is for information only. Rotorua District Council 2006. Facsimile 07 346 3143 Telephone 07 348 4199 email mail@rdc.govt.nz



WATER SUPPLY SERVICES
1:2000 @ A3 - (U16-1000/42.07)

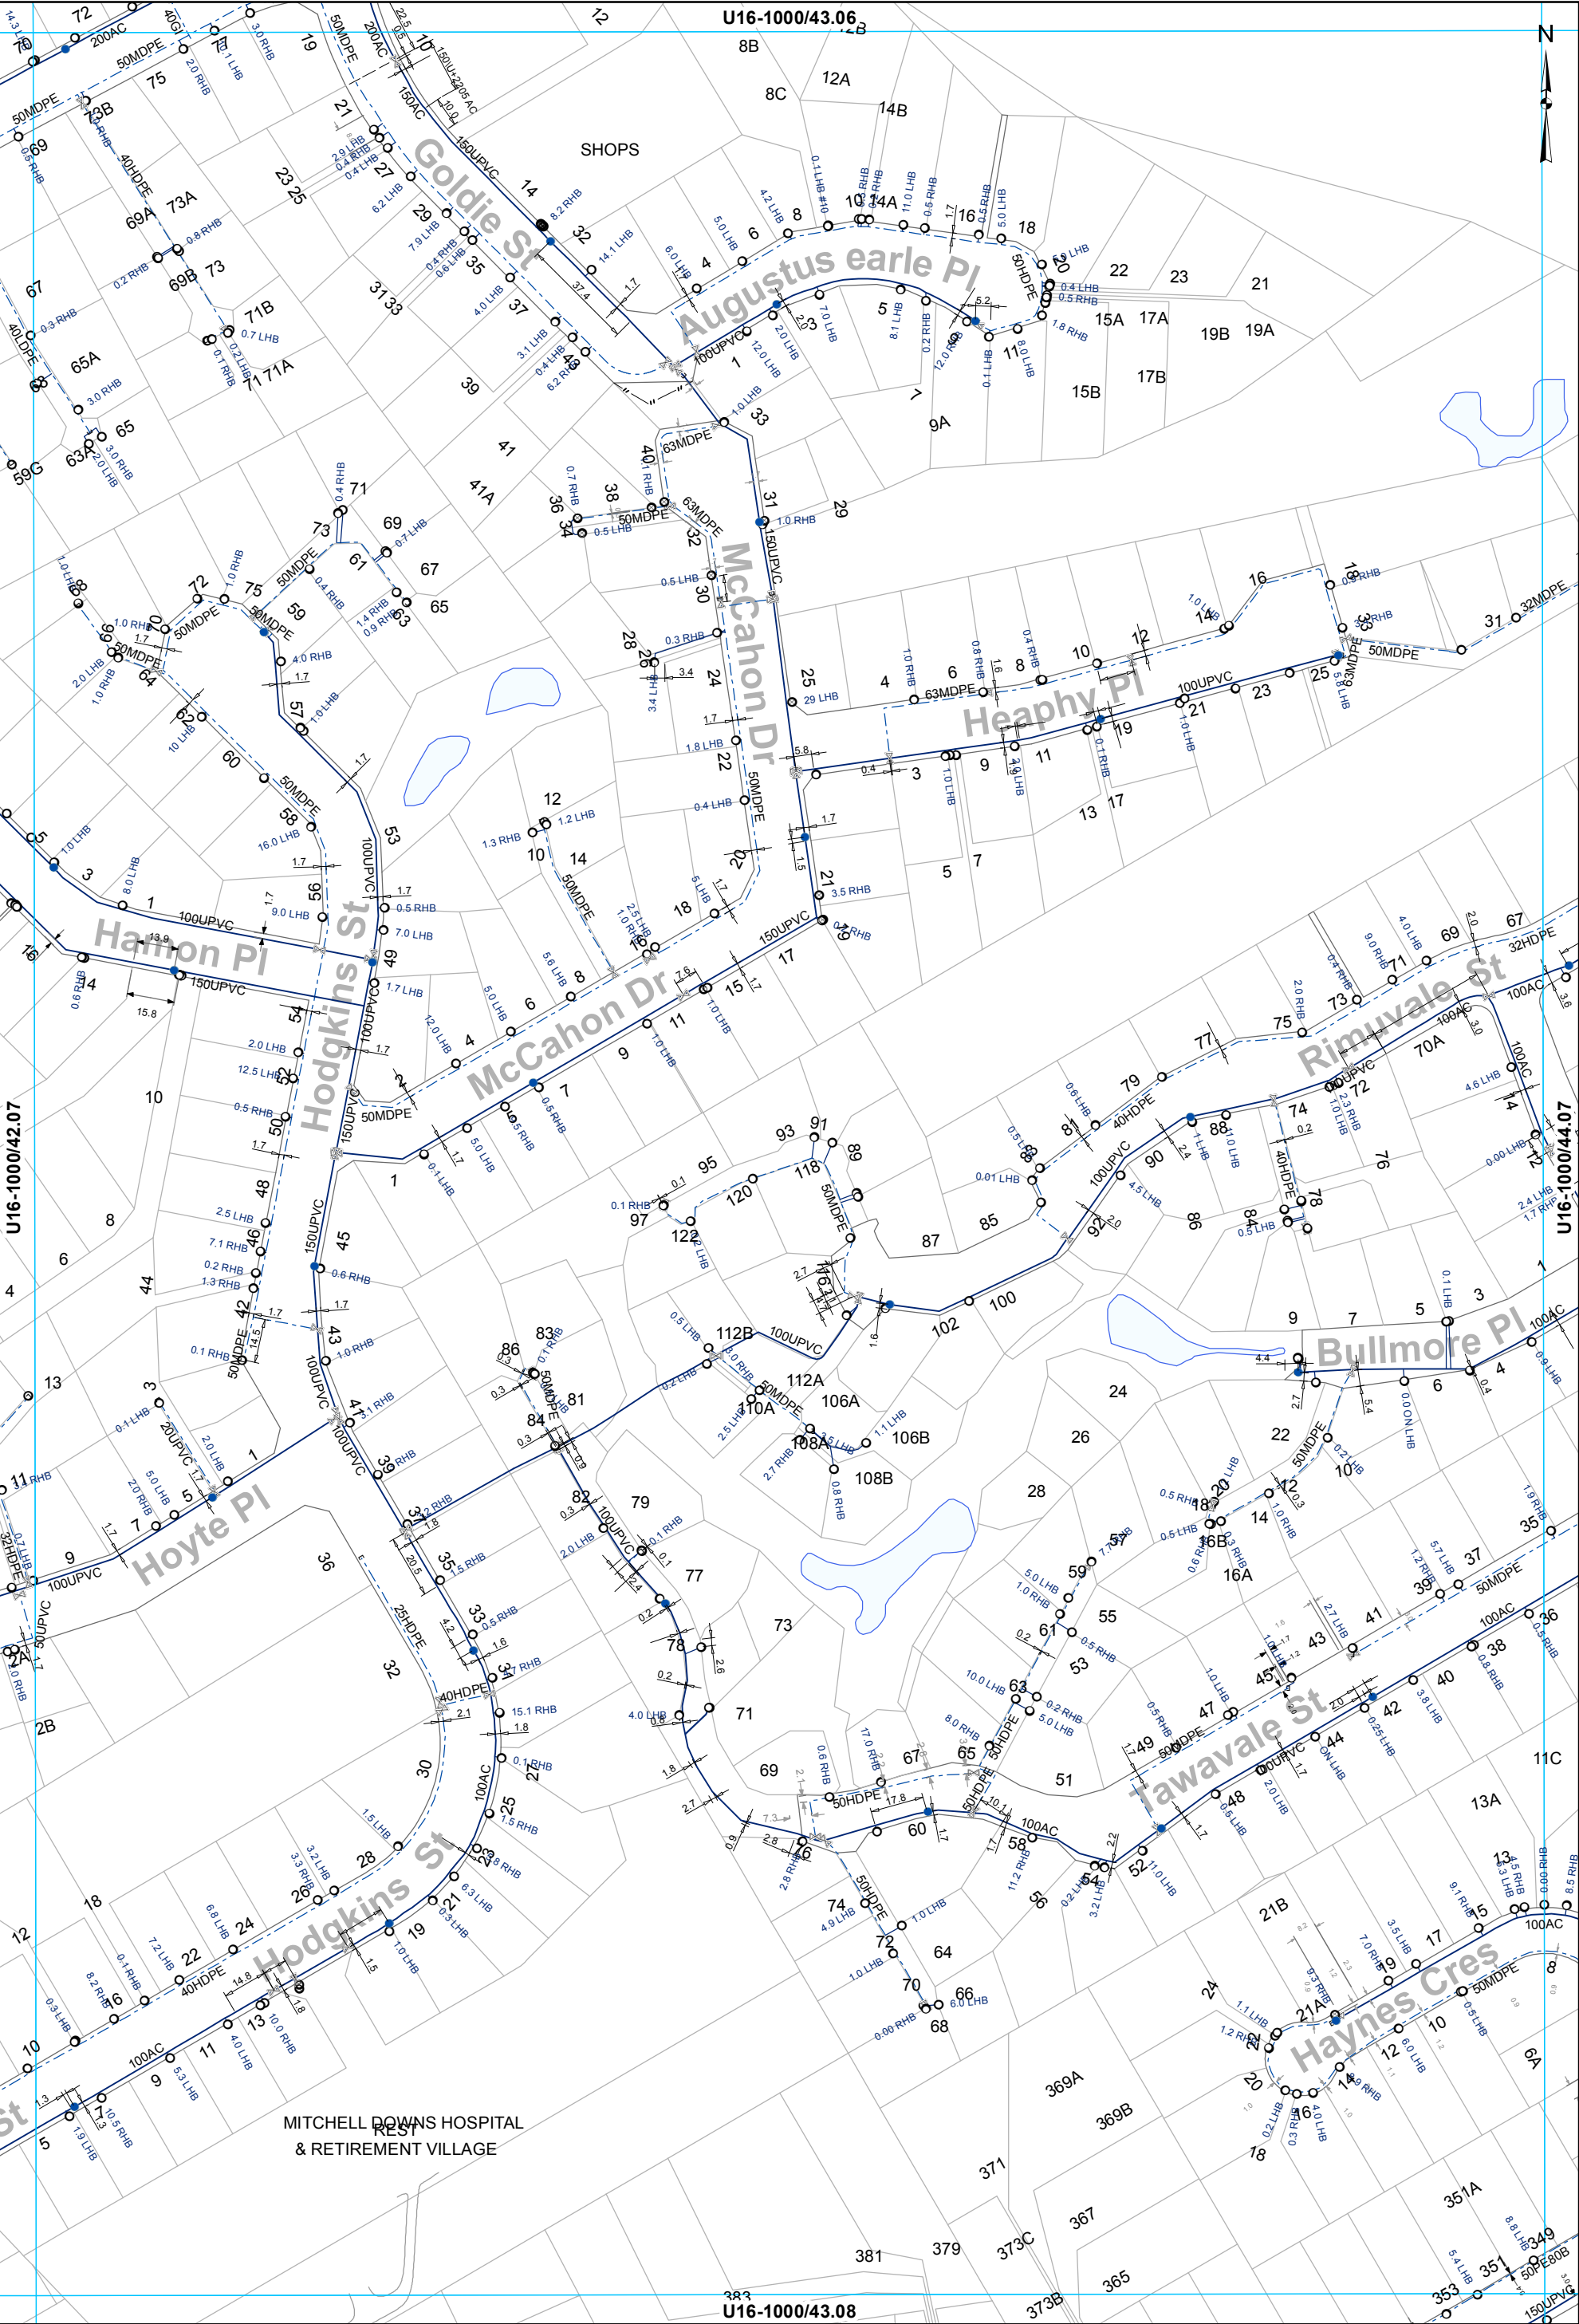

- Valve
- Hydrant
- Meter Consumer
- Toby
- Capped End
- WSServiceLine
- Main
- Rider main

WATER SUPPLY SERVICES
1:2000 @ A3 - (U16-1000/43.07)

This data is derived from sources outside the control of Rotorua District Council and is for information only

All dimensions and levels should be verified by physical location on-site.

Rotorua District Council 2006. Facsimile 07 346 3143 Telephone 07 348 4199 email mail@rdc.govt.nz

U16-1000/44.06




All dimensions and levels should be verified by physical location on-site.

This data is derived from sources outside the control of Rotorua District Council and is for information only

Rotorua District Council 2006. Facsimile 07 346 3143 Telephone 07 348 4199 email mail@rdc.govt.nz

- | | | | | |
|--------------|---------|----------------|---------------|---------------|
| Valve | Hydrant | Meter Bulk | Miscellaneous | WSServiceLine |
| Toby | | Meter Consumer | | Main |
| Closed Valve | | Capped End | | Rider main |

 WATER SUPPLY SERVICES
1:2000 @ A3 - (U16-1000/44.07)




All dimensions and levels should be verified by physical location on-site.

This data is derived from sources outside the control of Rotorua District Council and is for information only

Rotorua District Council 2006. Facsimilie 07 346 3143 Telephone 07 348 4199 email mail@rdc.govt.nz

 Valve
 Hydrant
 Meter Consumer
 WSServiceLine
 Toby
 Capped End
 Main
 Closed Valve
 Rider main

WATER SUPPLY SERVICES
1:2000 @ A3 - (U16-1000/45.07)

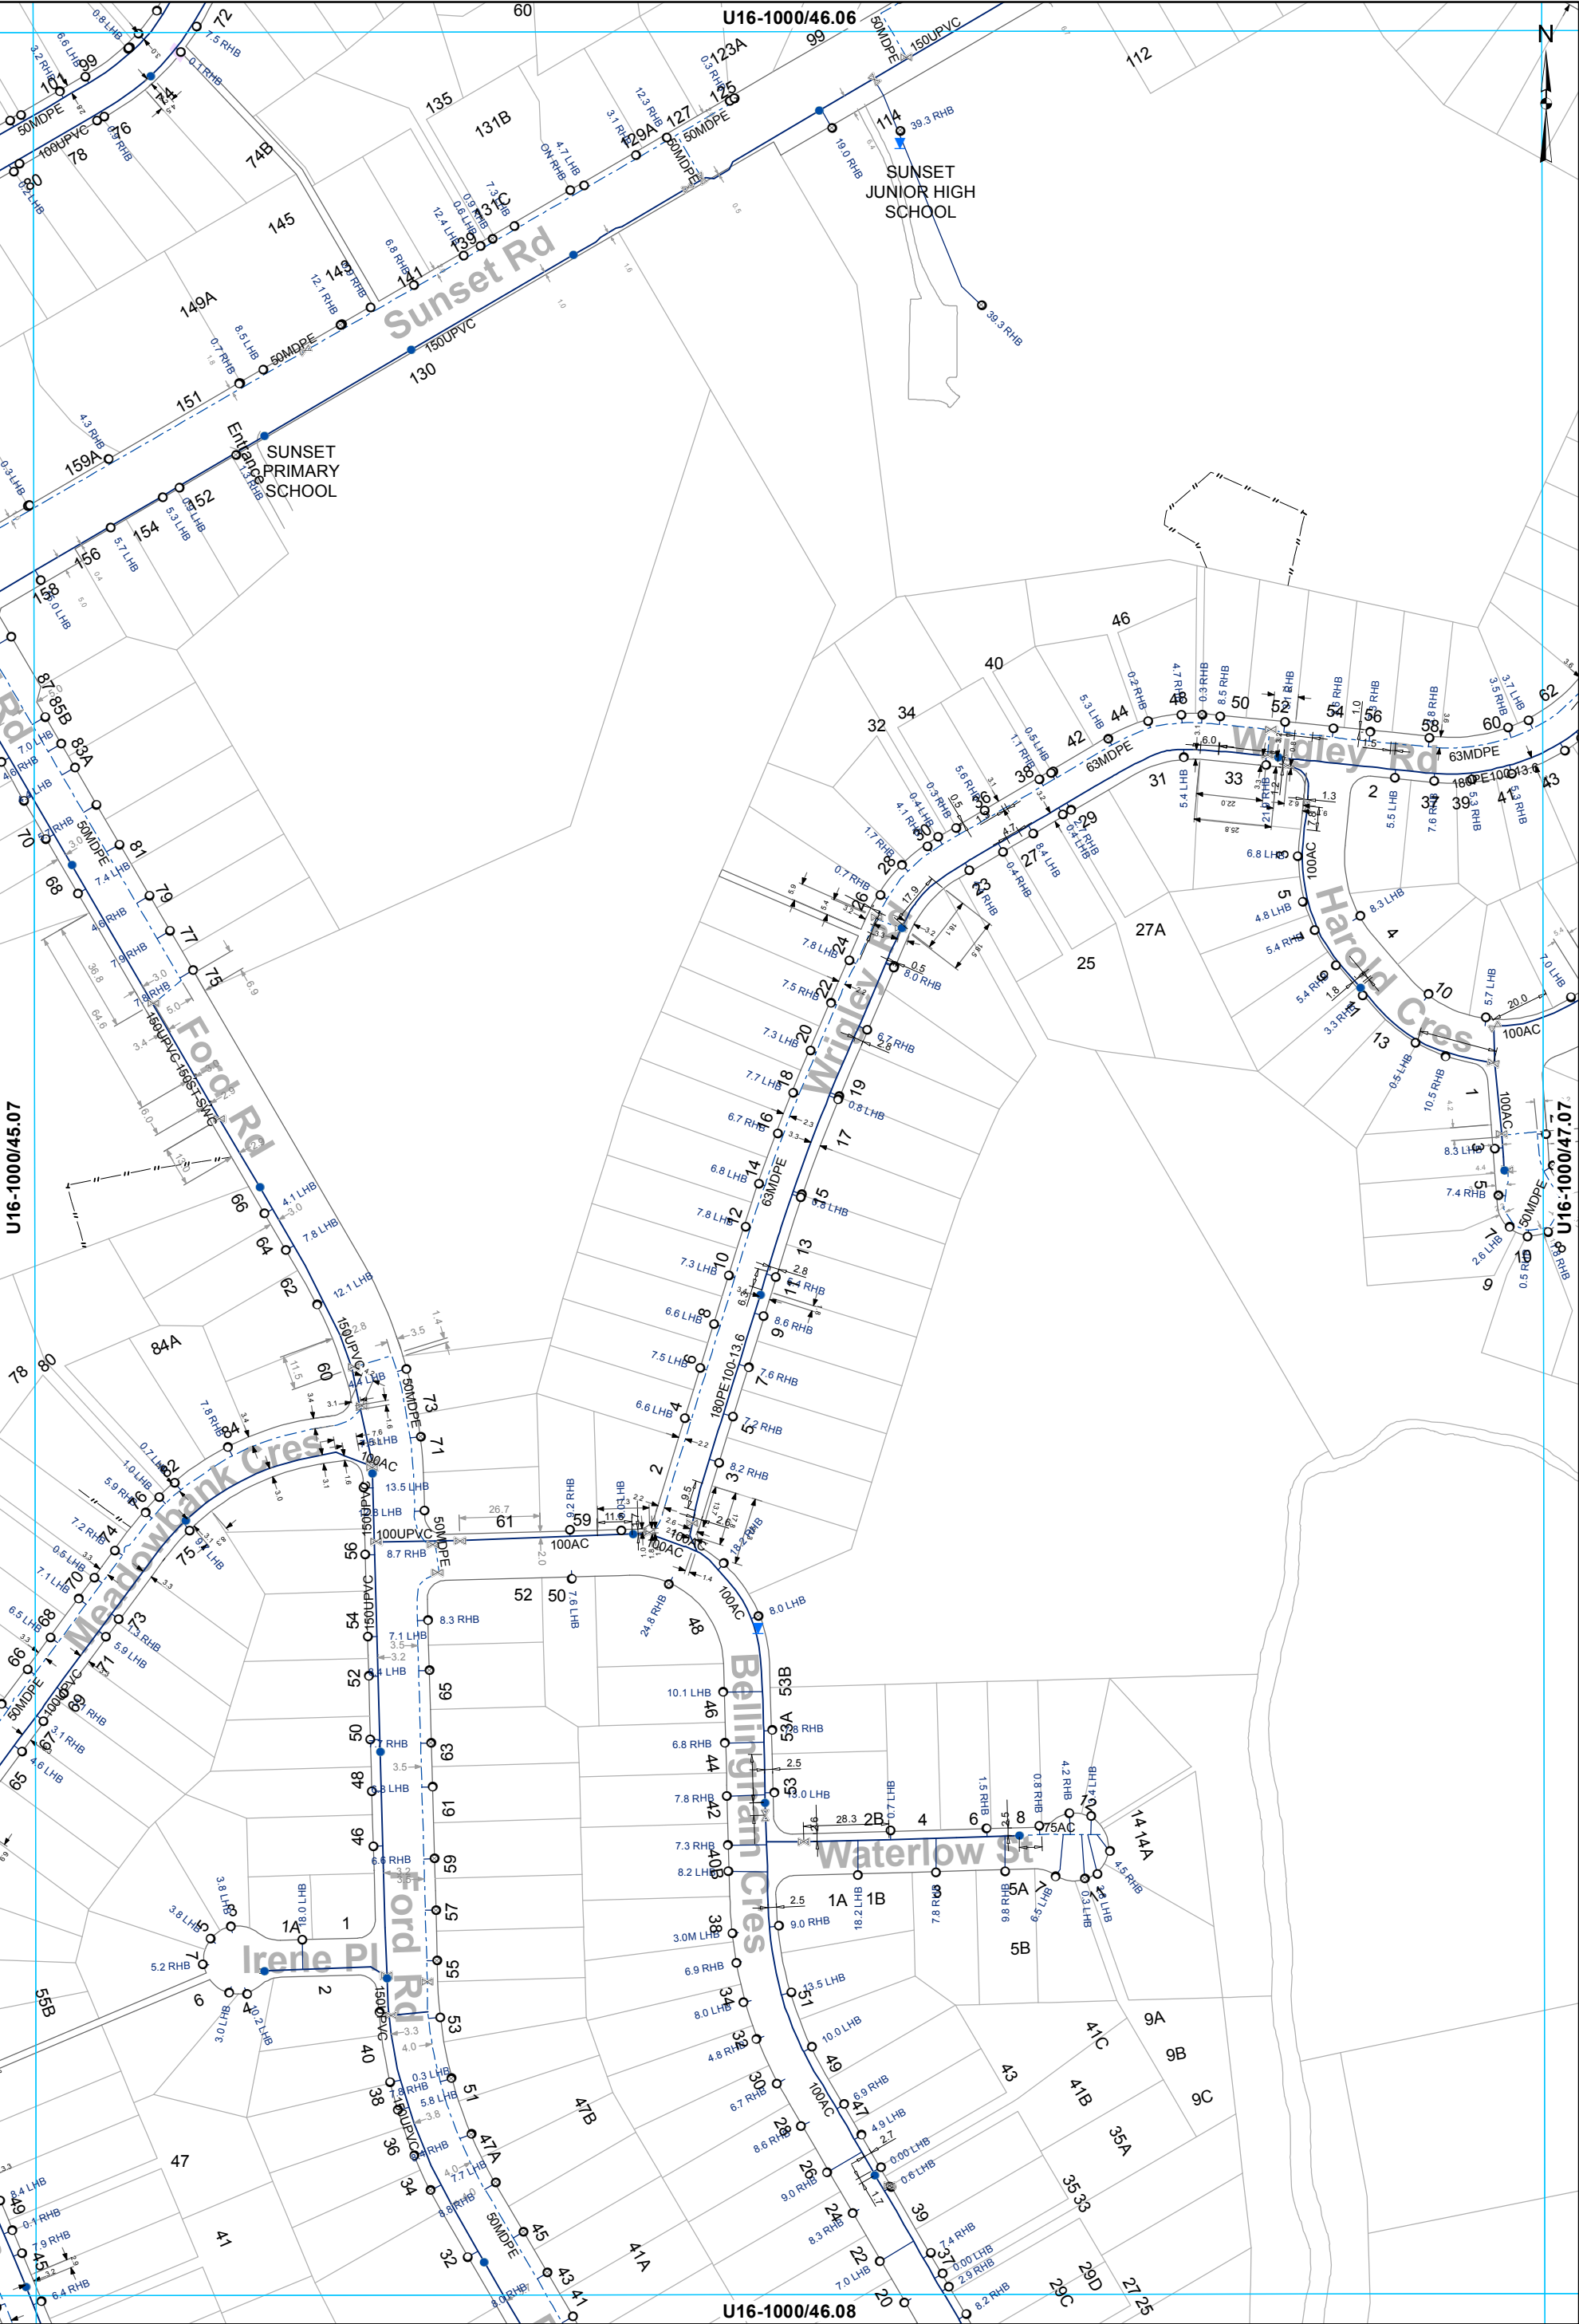

- X Valve
- Hydrant
- Meter Consumer
- Toby
- Capped End
- WSServiceLine
- Main
- - - Rider main

WATER SUPPLY SERVICES
1:2000 @ A3 - (U16-1000/46.07)



- | | | | |
|----------------|-----------|------------------|------------------|
| ⌵ Valve | ● Hydrant | ⊗ Meter Bulk | — WSServiceLine |
| ○ Toby | | ⊙ Meter Consumer | — Main |
| ⌵ Closed Valve | | ⌵ Capped End | - - - Rider main |

WATER SUPPLY SERVICES
1:2000 @ A3 - (U16-1000/47.07)

This data is derived from sources outside the control of Rotorua District Council and is for information only

Rotorua District Council 2006. Facsimile 07 346 3143 Telephone 07 348 4199 email mail@rdc.govt.nz




- Valve
- Hydrant
- Meter Consumer
- WSServiceLine
- Toby
- Capped End
- Main
- Rider main

WATER SUPPLY SERVICES
1:2000 @ A3 - (U16-1000/48.07)

This data is derived from sources outside the control of Rotorua District Council and is for information only

All dimensions and levels should be verified by physical location on-site.

Rotorua District Council 2006. Facsimile 07 346 3143 Telephone 07 348 4199 email mail@rdc.govt.nz

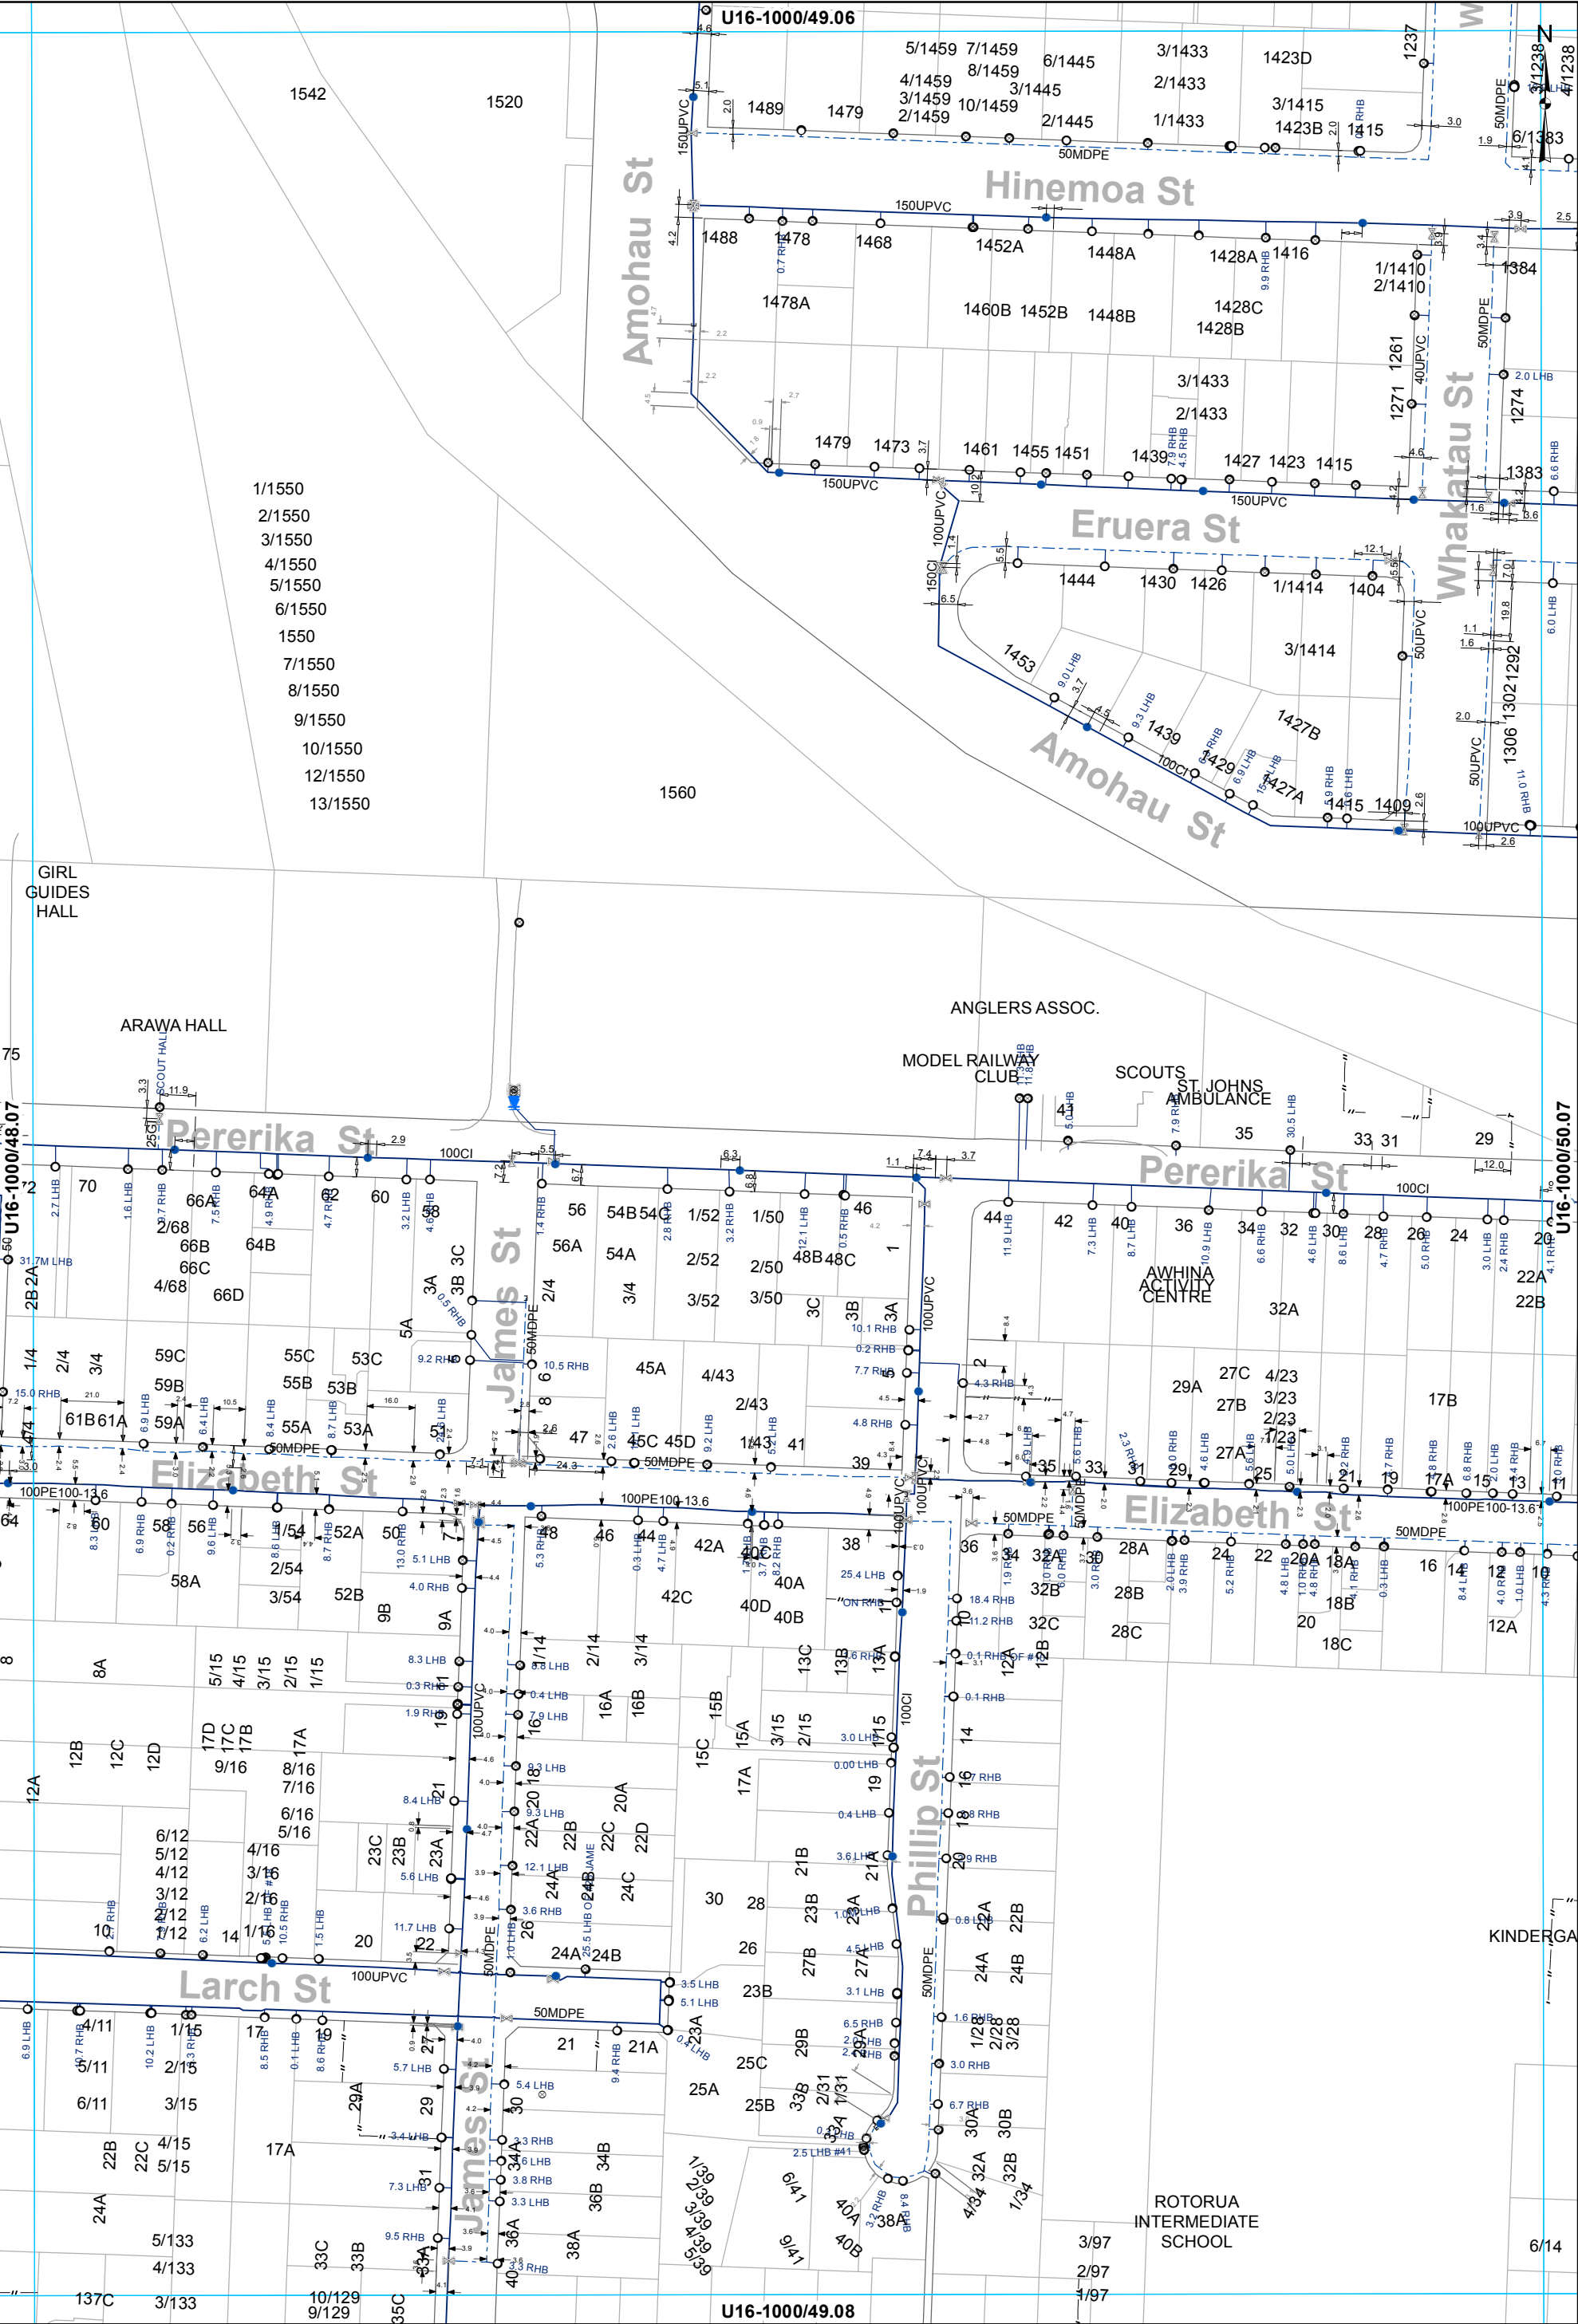


- X Valve
- Hydrant
- Meter Consumer
- Toby
- Capped End
- WSServiceLine
- Main
- - - Rider main

WATER SUPPLY SERVICES
1:2000 @ A3 - (U16-1000/49.07)

All dimensions and levels should be verified by physical location on-site.


This data is derived from sources outside the control of Rotorua District Council and is for information only

Rotorua District Council 2006. Facsimile 07 346 3143 Telephone 07 348 4199 email mail@rdc.govt.nz

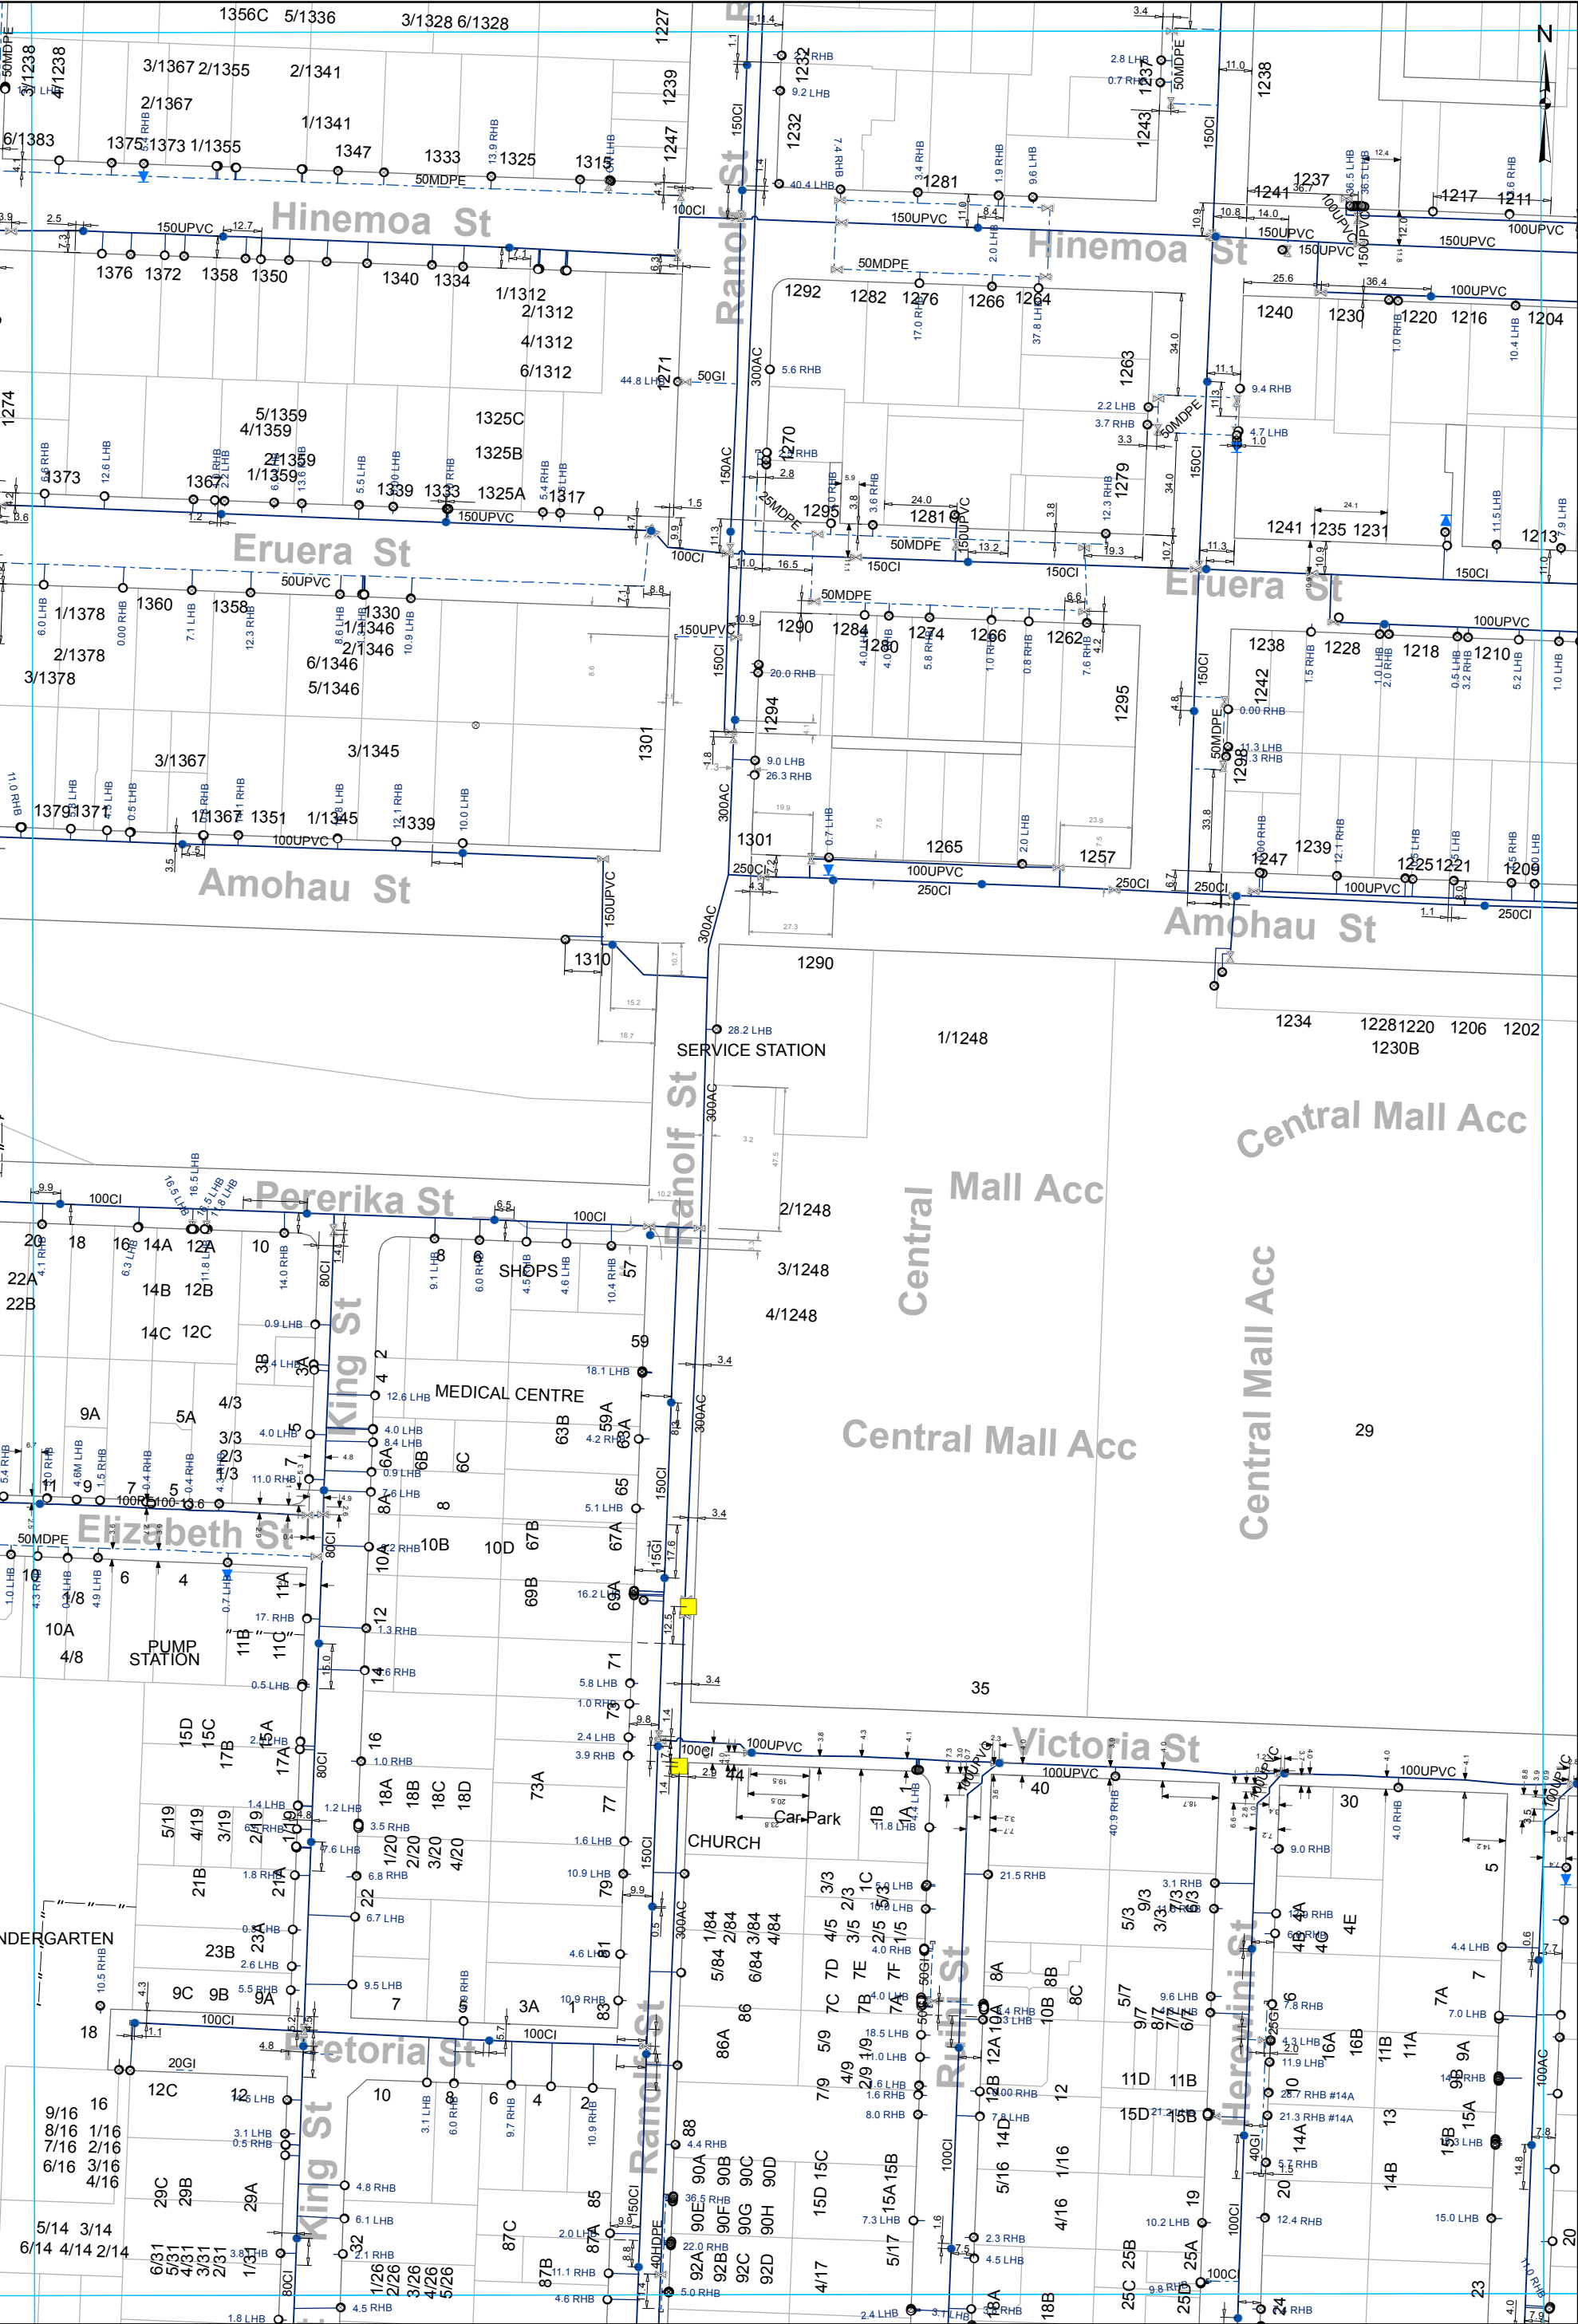

- X Valve
- Hydrant
- Meter Consumer
- Miscellaneous
- WSServiceLine
- Toby
- ⌒ Capped End
- Main
- - - Rider main

WATER SUPPLY SERVICES
1:2000 @ A3 - (U16-1000/50.07)

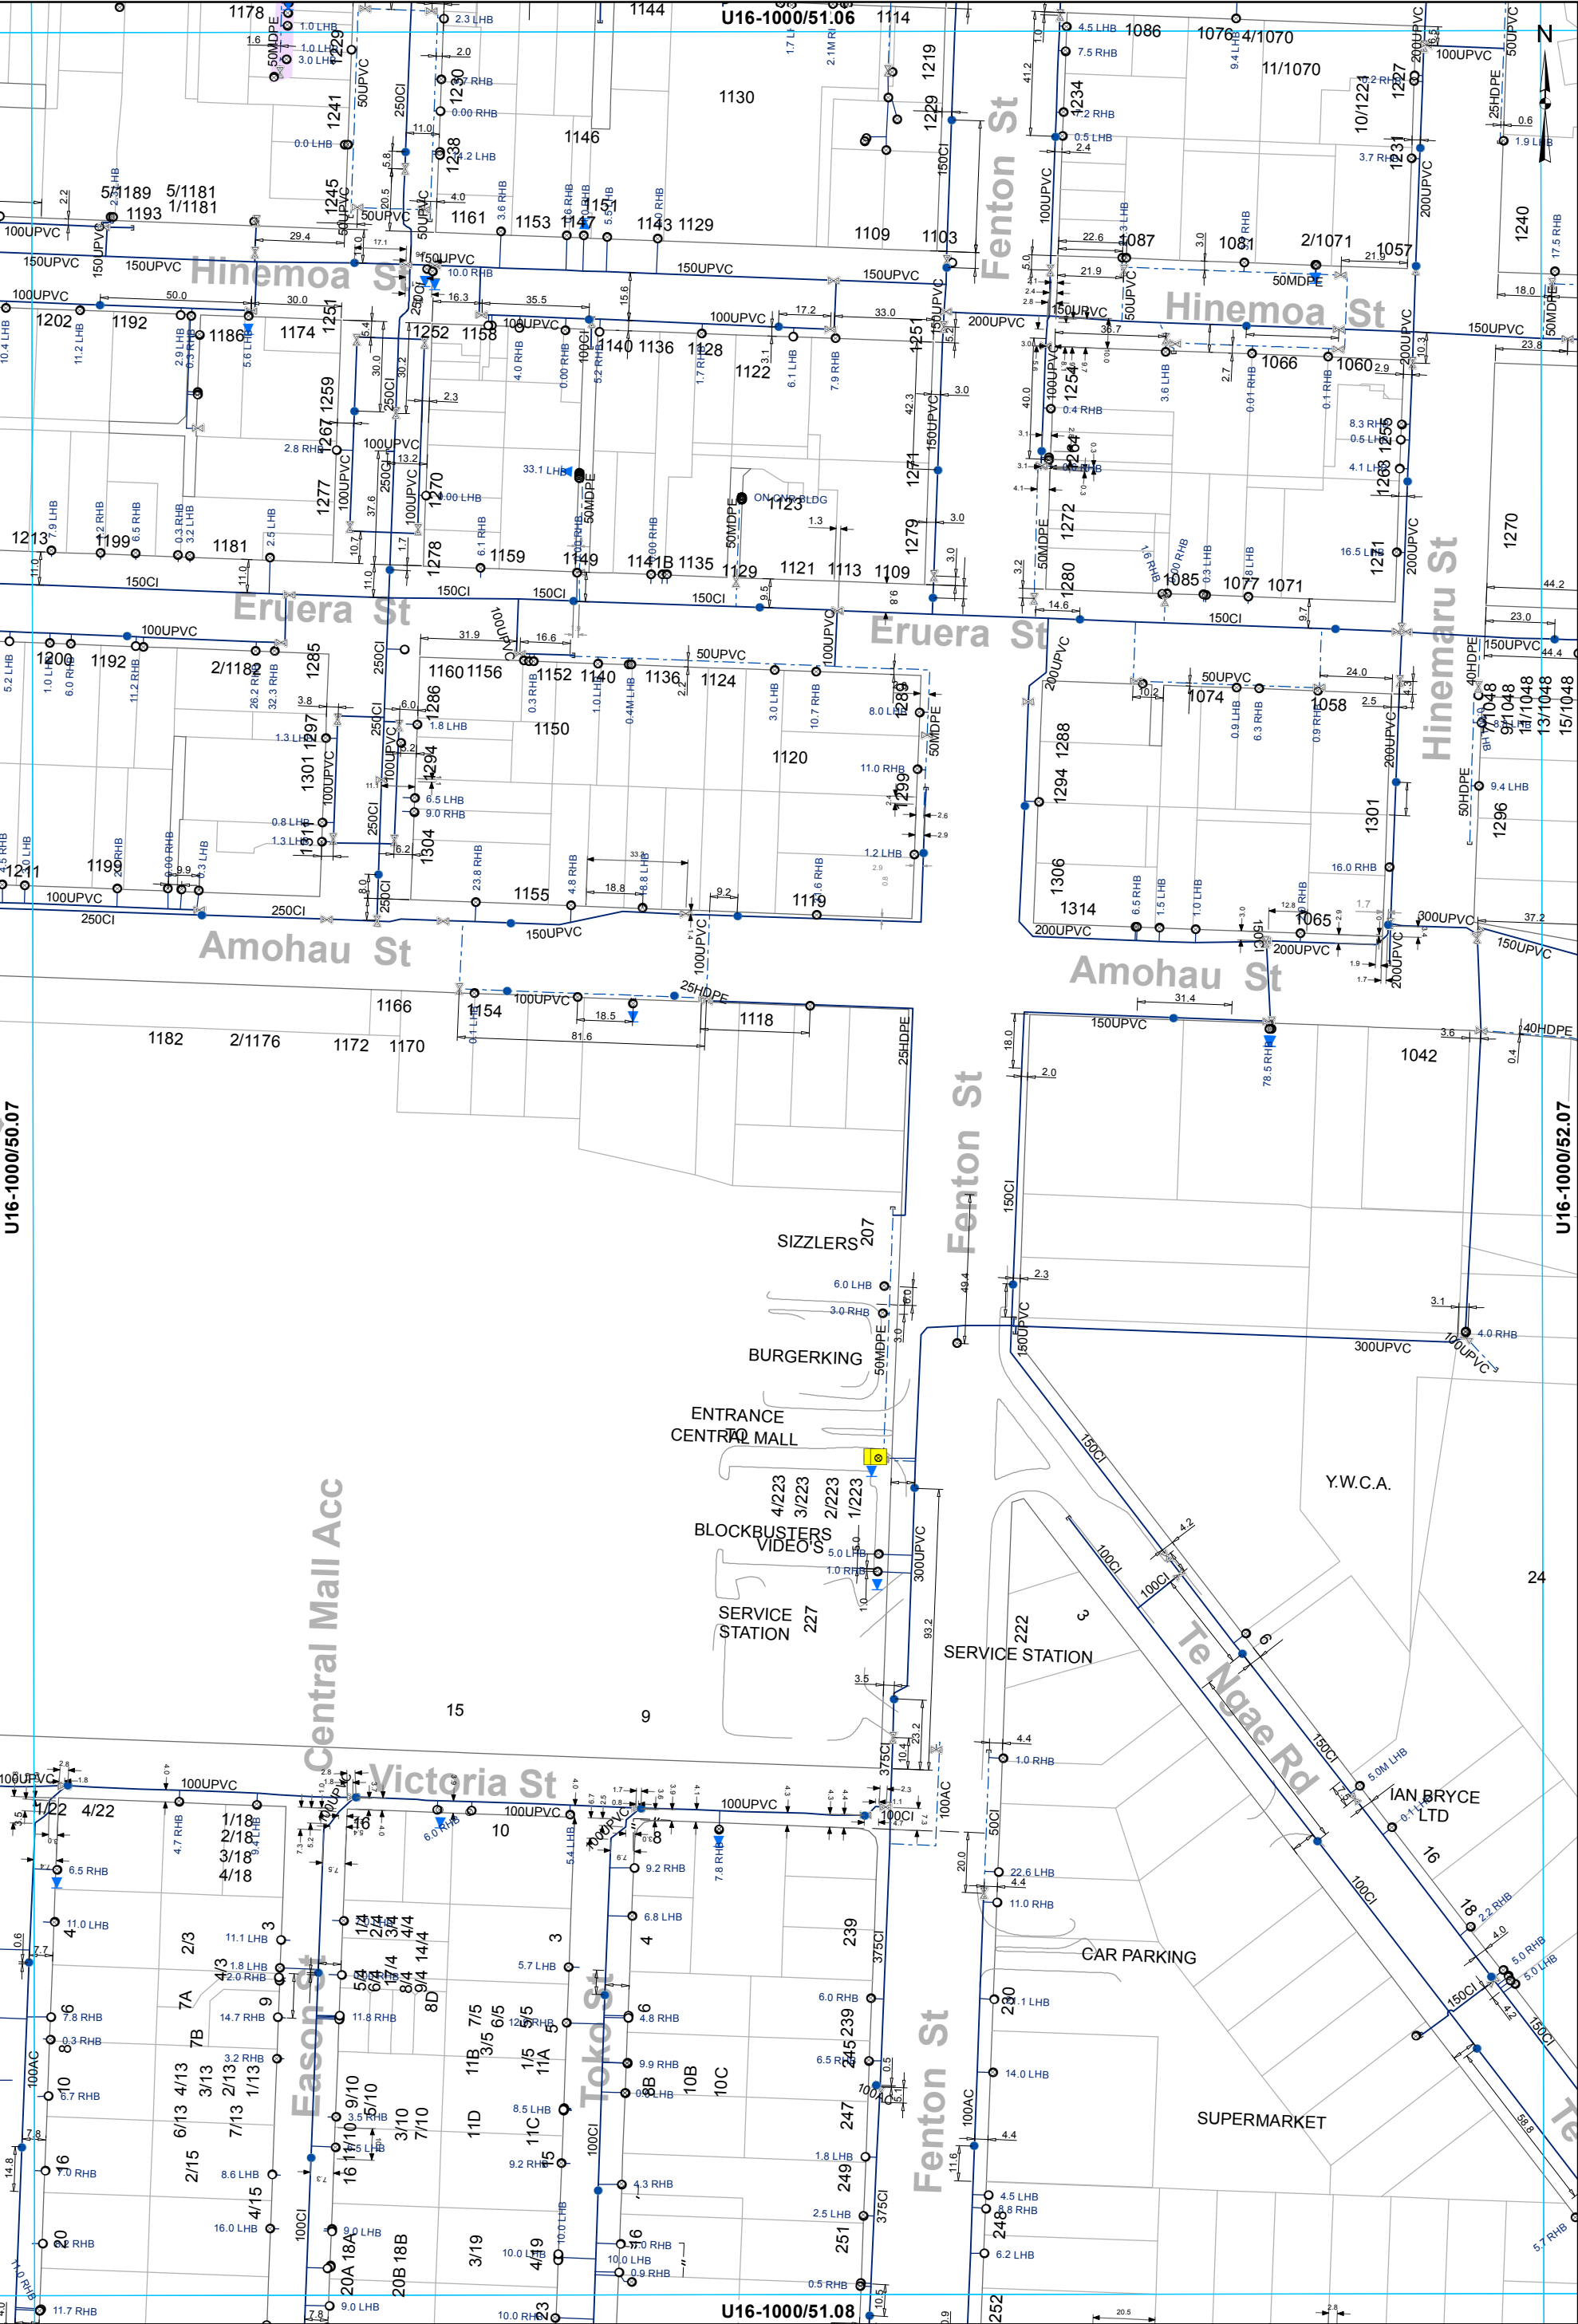


- Valve
- Hydrant
- Meter Consumer
- Miscellaneous
- WSServiceLine
- Toby
- Capped End
- Main
- Rider main

WATER SUPPLY SERVICES
1:2000 @ A3 - (U16-1000/51.07)

This data is derived from sources outside the control of Rotorua District Council and is for information only

Rotorua District Council 2006. Facsimile 07 346 3143 Telephone 07 348 4199 email mail@rdc.govt.nz

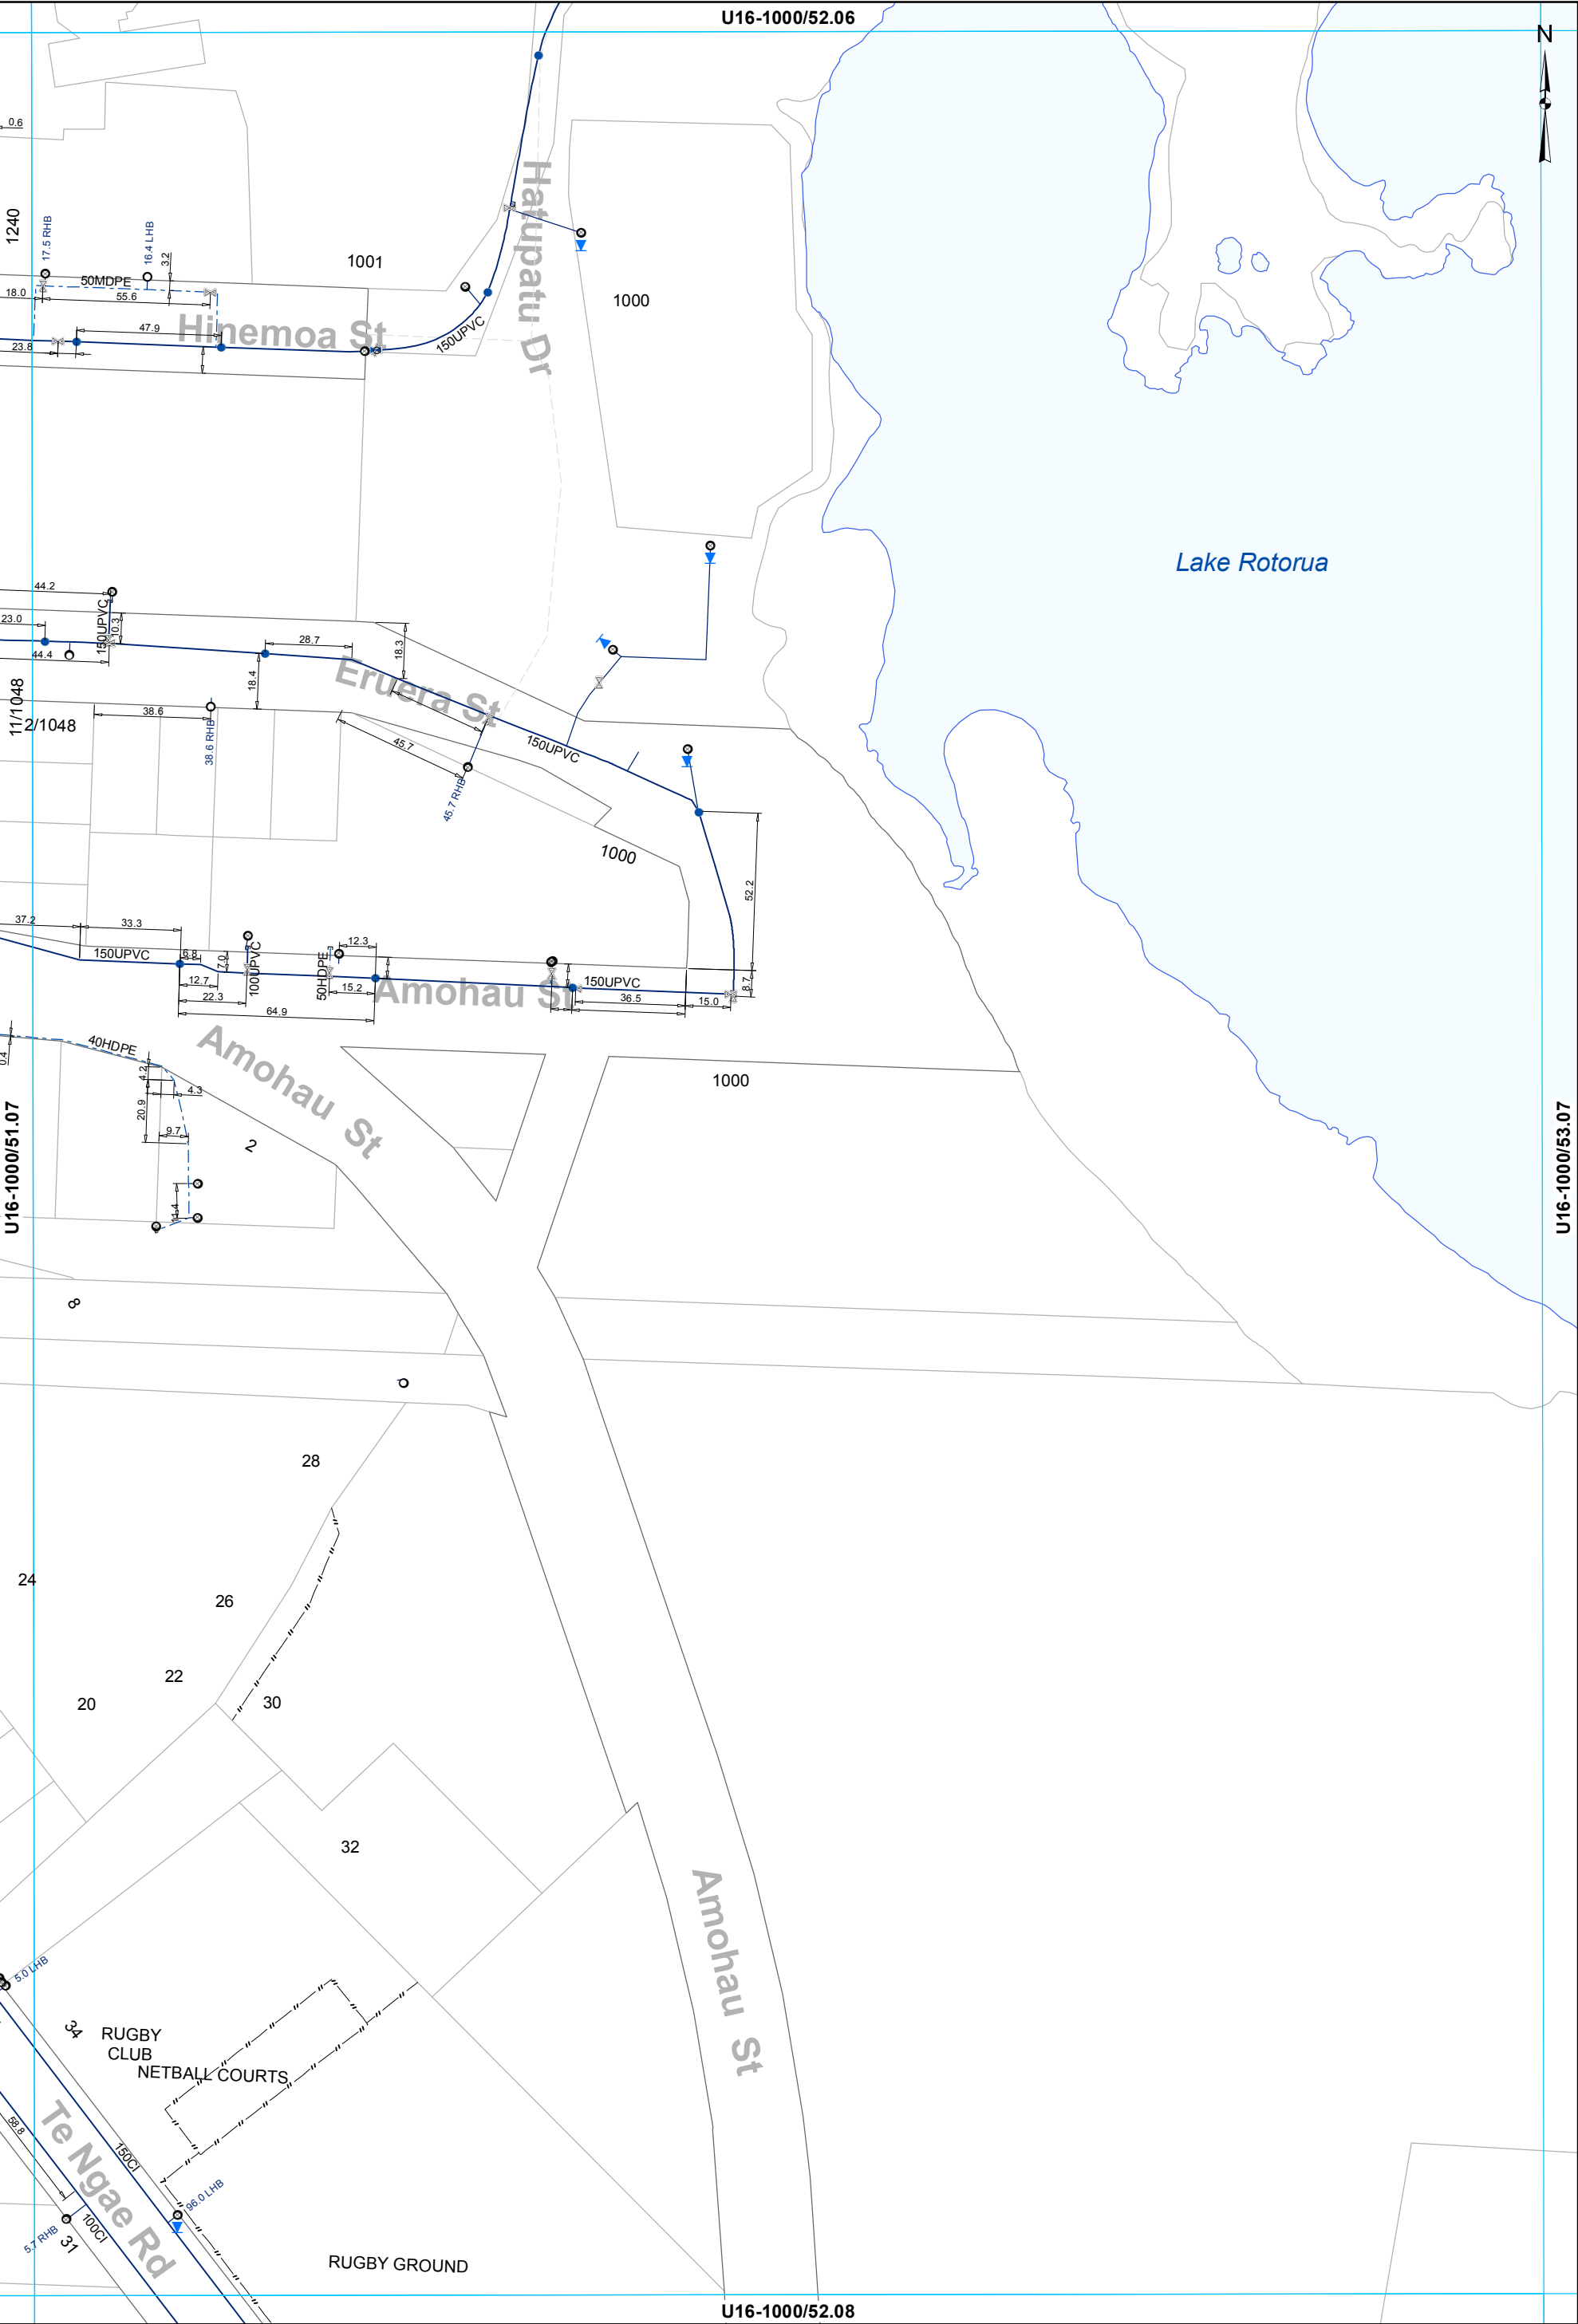

- | | | | |
|----------------|--------------|------------------|-----------------|
| ⌵ Valve | ● Hydrant | ⊙ Meter Consumer | — WSServiceLine |
| ○ Toby | ⌵ Capped End | — Main | |
| ⌵ Closed Valve | | --- Rider main | |

WATER SUPPLY SERVICES
1:2000 @ A3 - (U16-1000/52.07)

This data is derived from sources outside the control of Rotorua District Council and is for information only

U16-1000/53.07

All dimensions and levels should be verified by physical location on-site.

Rotorua District Council 2006. Facsimile 07 346 3143 Telephone 07 348 4199 email mail@rdc.govt.nz



U16-1000/41.08

U16-1000/42.07

U16-1000/42.09

U16-1000/43.08

- Toby

● Hydrant

— WSServiceLine


— Main

WATER SUPPLY SERVICES
1:2000 @ A3 - (U16-1000/42.08)

This data is derived from sources outside the control of Rotorua District Council and is for information only

All dimensions and levels should be verified by physical location on-site.

Rotorua District Council 2006. Facsimile 07 346 3143 Telephone 07 348 4199 email mail@rdc.govt.nz

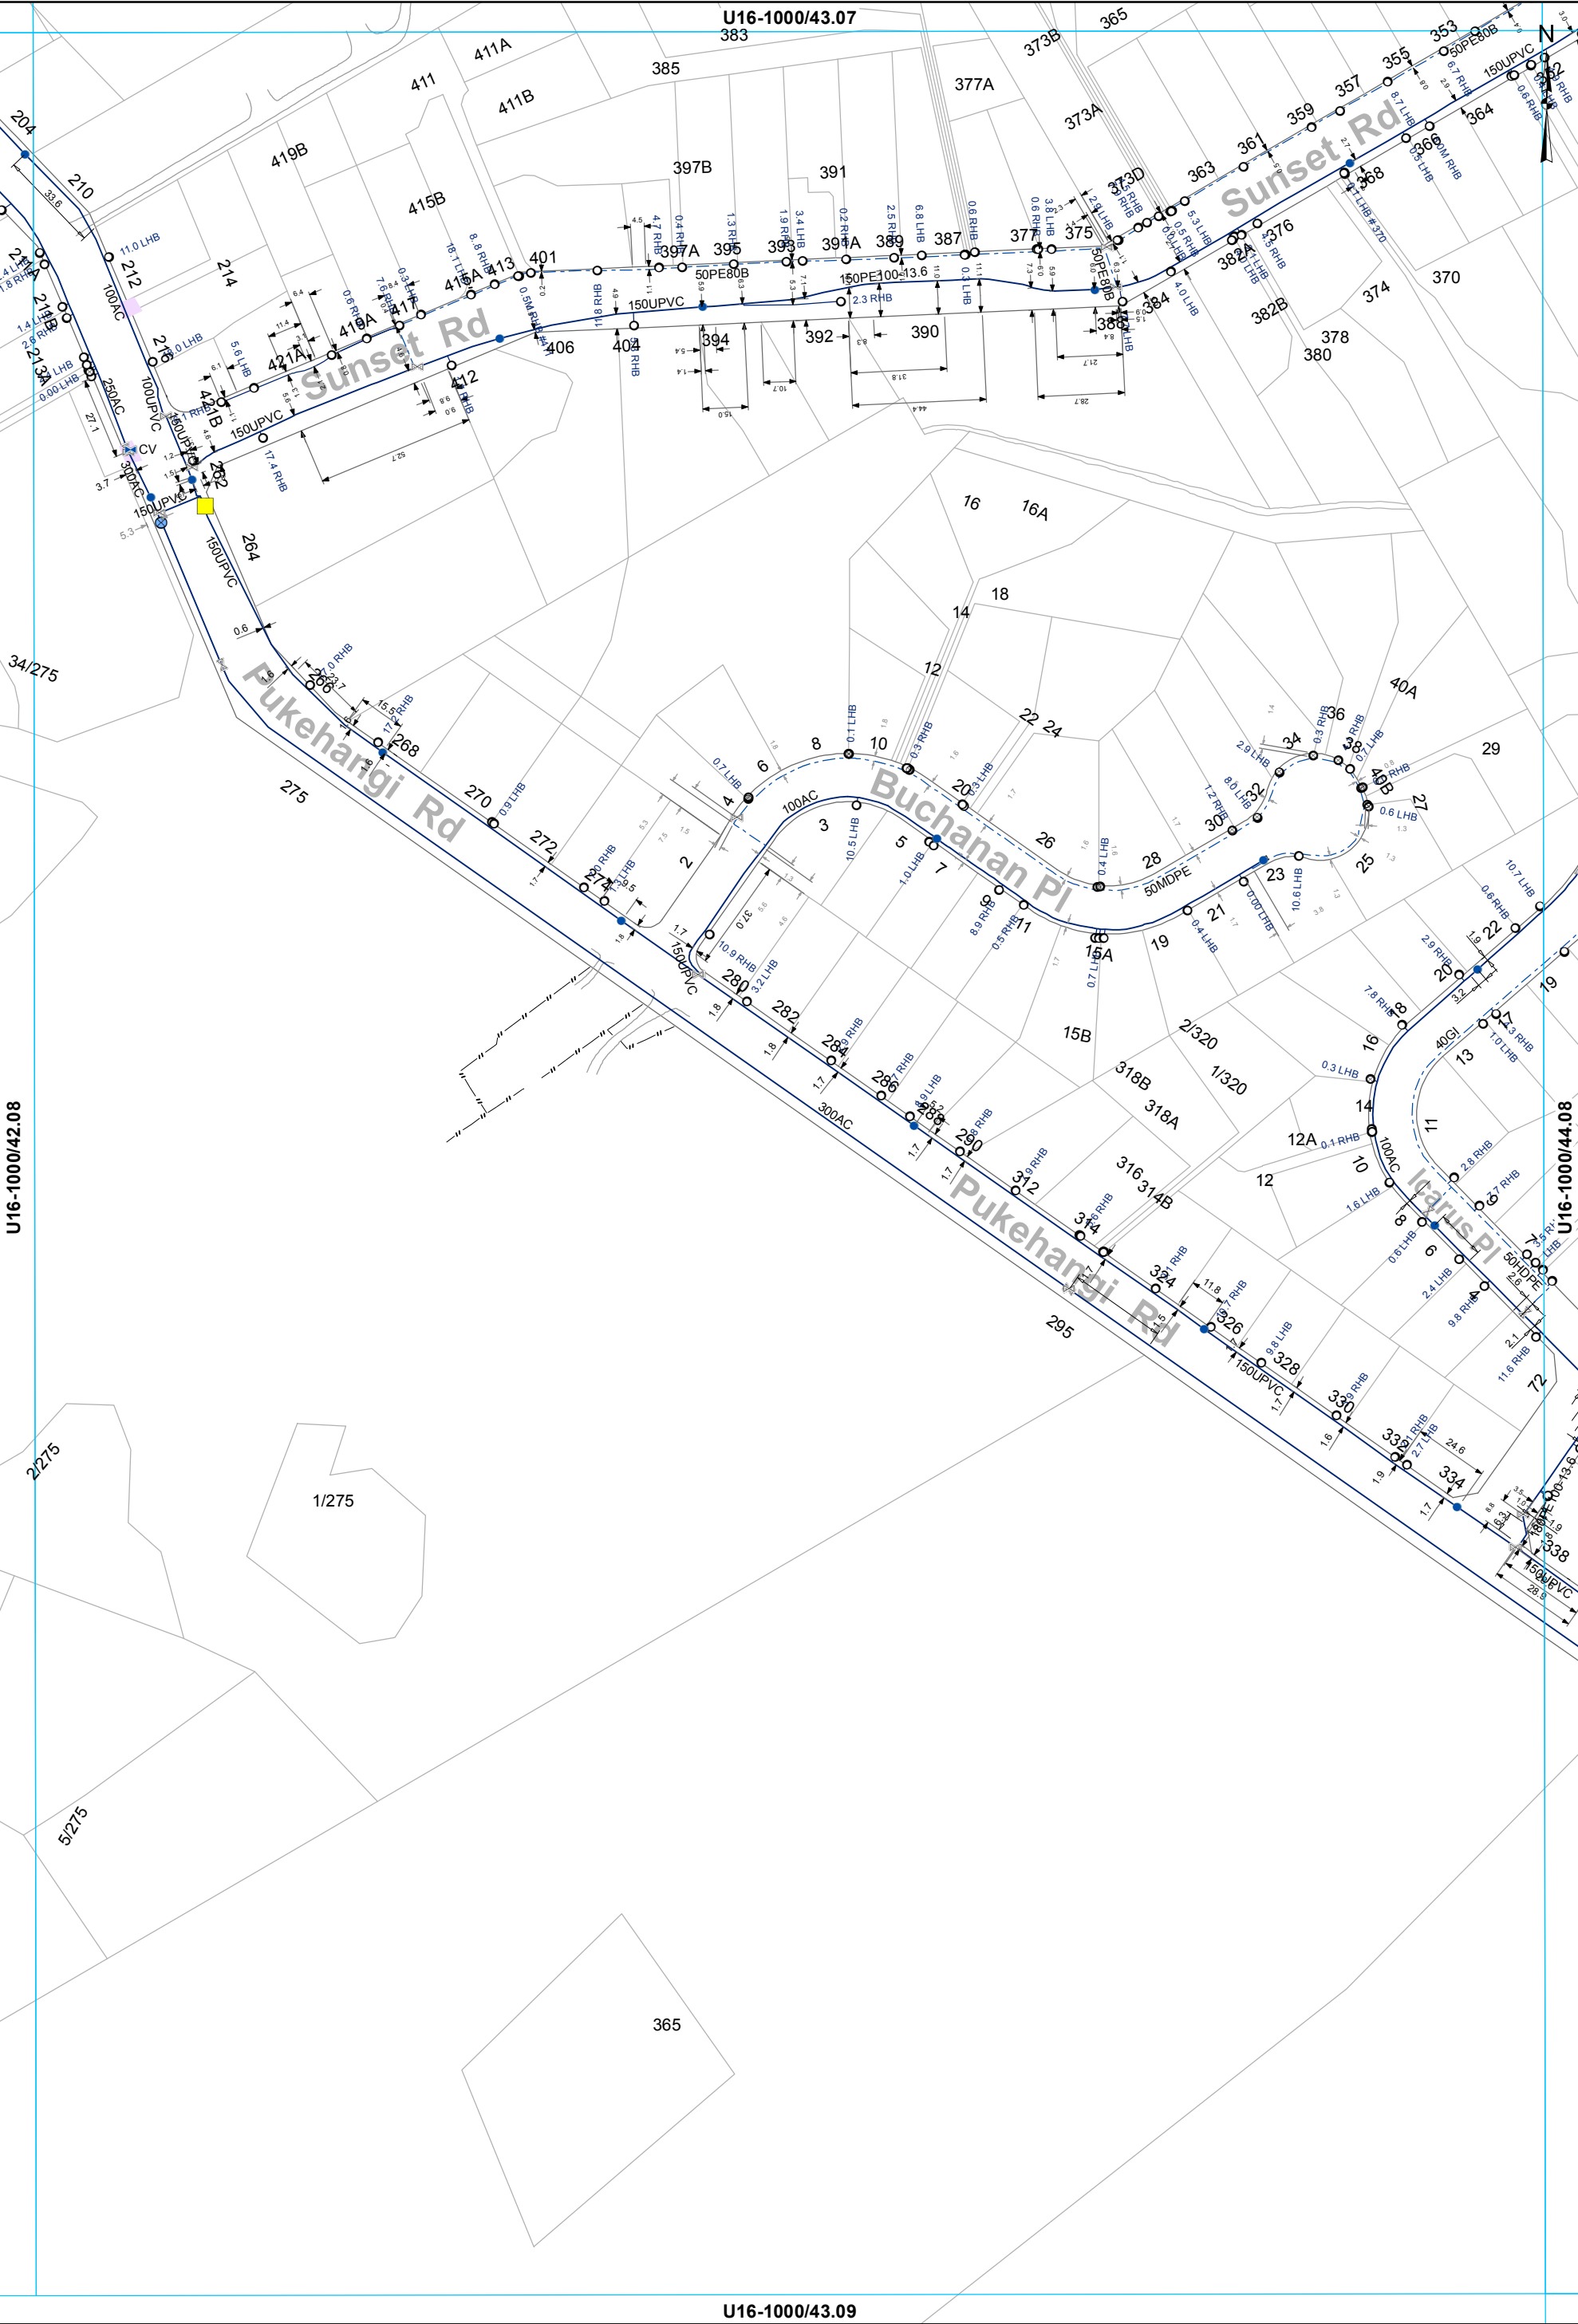


- X Valve
- Hydrant
- Meter Bulk
- Miscellaneous
- WSServiceLine
- Toby
- Meter Consumer
- Main
- Closed Valve
- Capped End
- Rider main

WATER SUPPLY SERVICES
1:2000 @ A3 - (U16-1000/43.08)

This data is derived from sources outside the control of Rotorua District Council and is for information only

 Rotorua District Council 2006. Facsimile 07 346 3143 Telephone 07 348 4199 email mail@rdc.govt.nz




All dimensions and levels should be verified by physical location on-site.

This data is derived from sources outside the control of Rotorua District Council and is for information only

- Valve
 Hydrant
 Meter Consumer
 WSServiceLine
 Toby
 Capped End
 Main
 Rider main

 
WATER SUPPLY SERVICES
1:2000 @ A3 - (U16-1000/44.08)



All dimensions and levels should be verified by physical location on-site.

This data is derived from sources outside the control of Rotorua District Council and is for information only

WATER SUPPLY SERVICES
1:2000 @ A3 - (U16-1000/45.08)

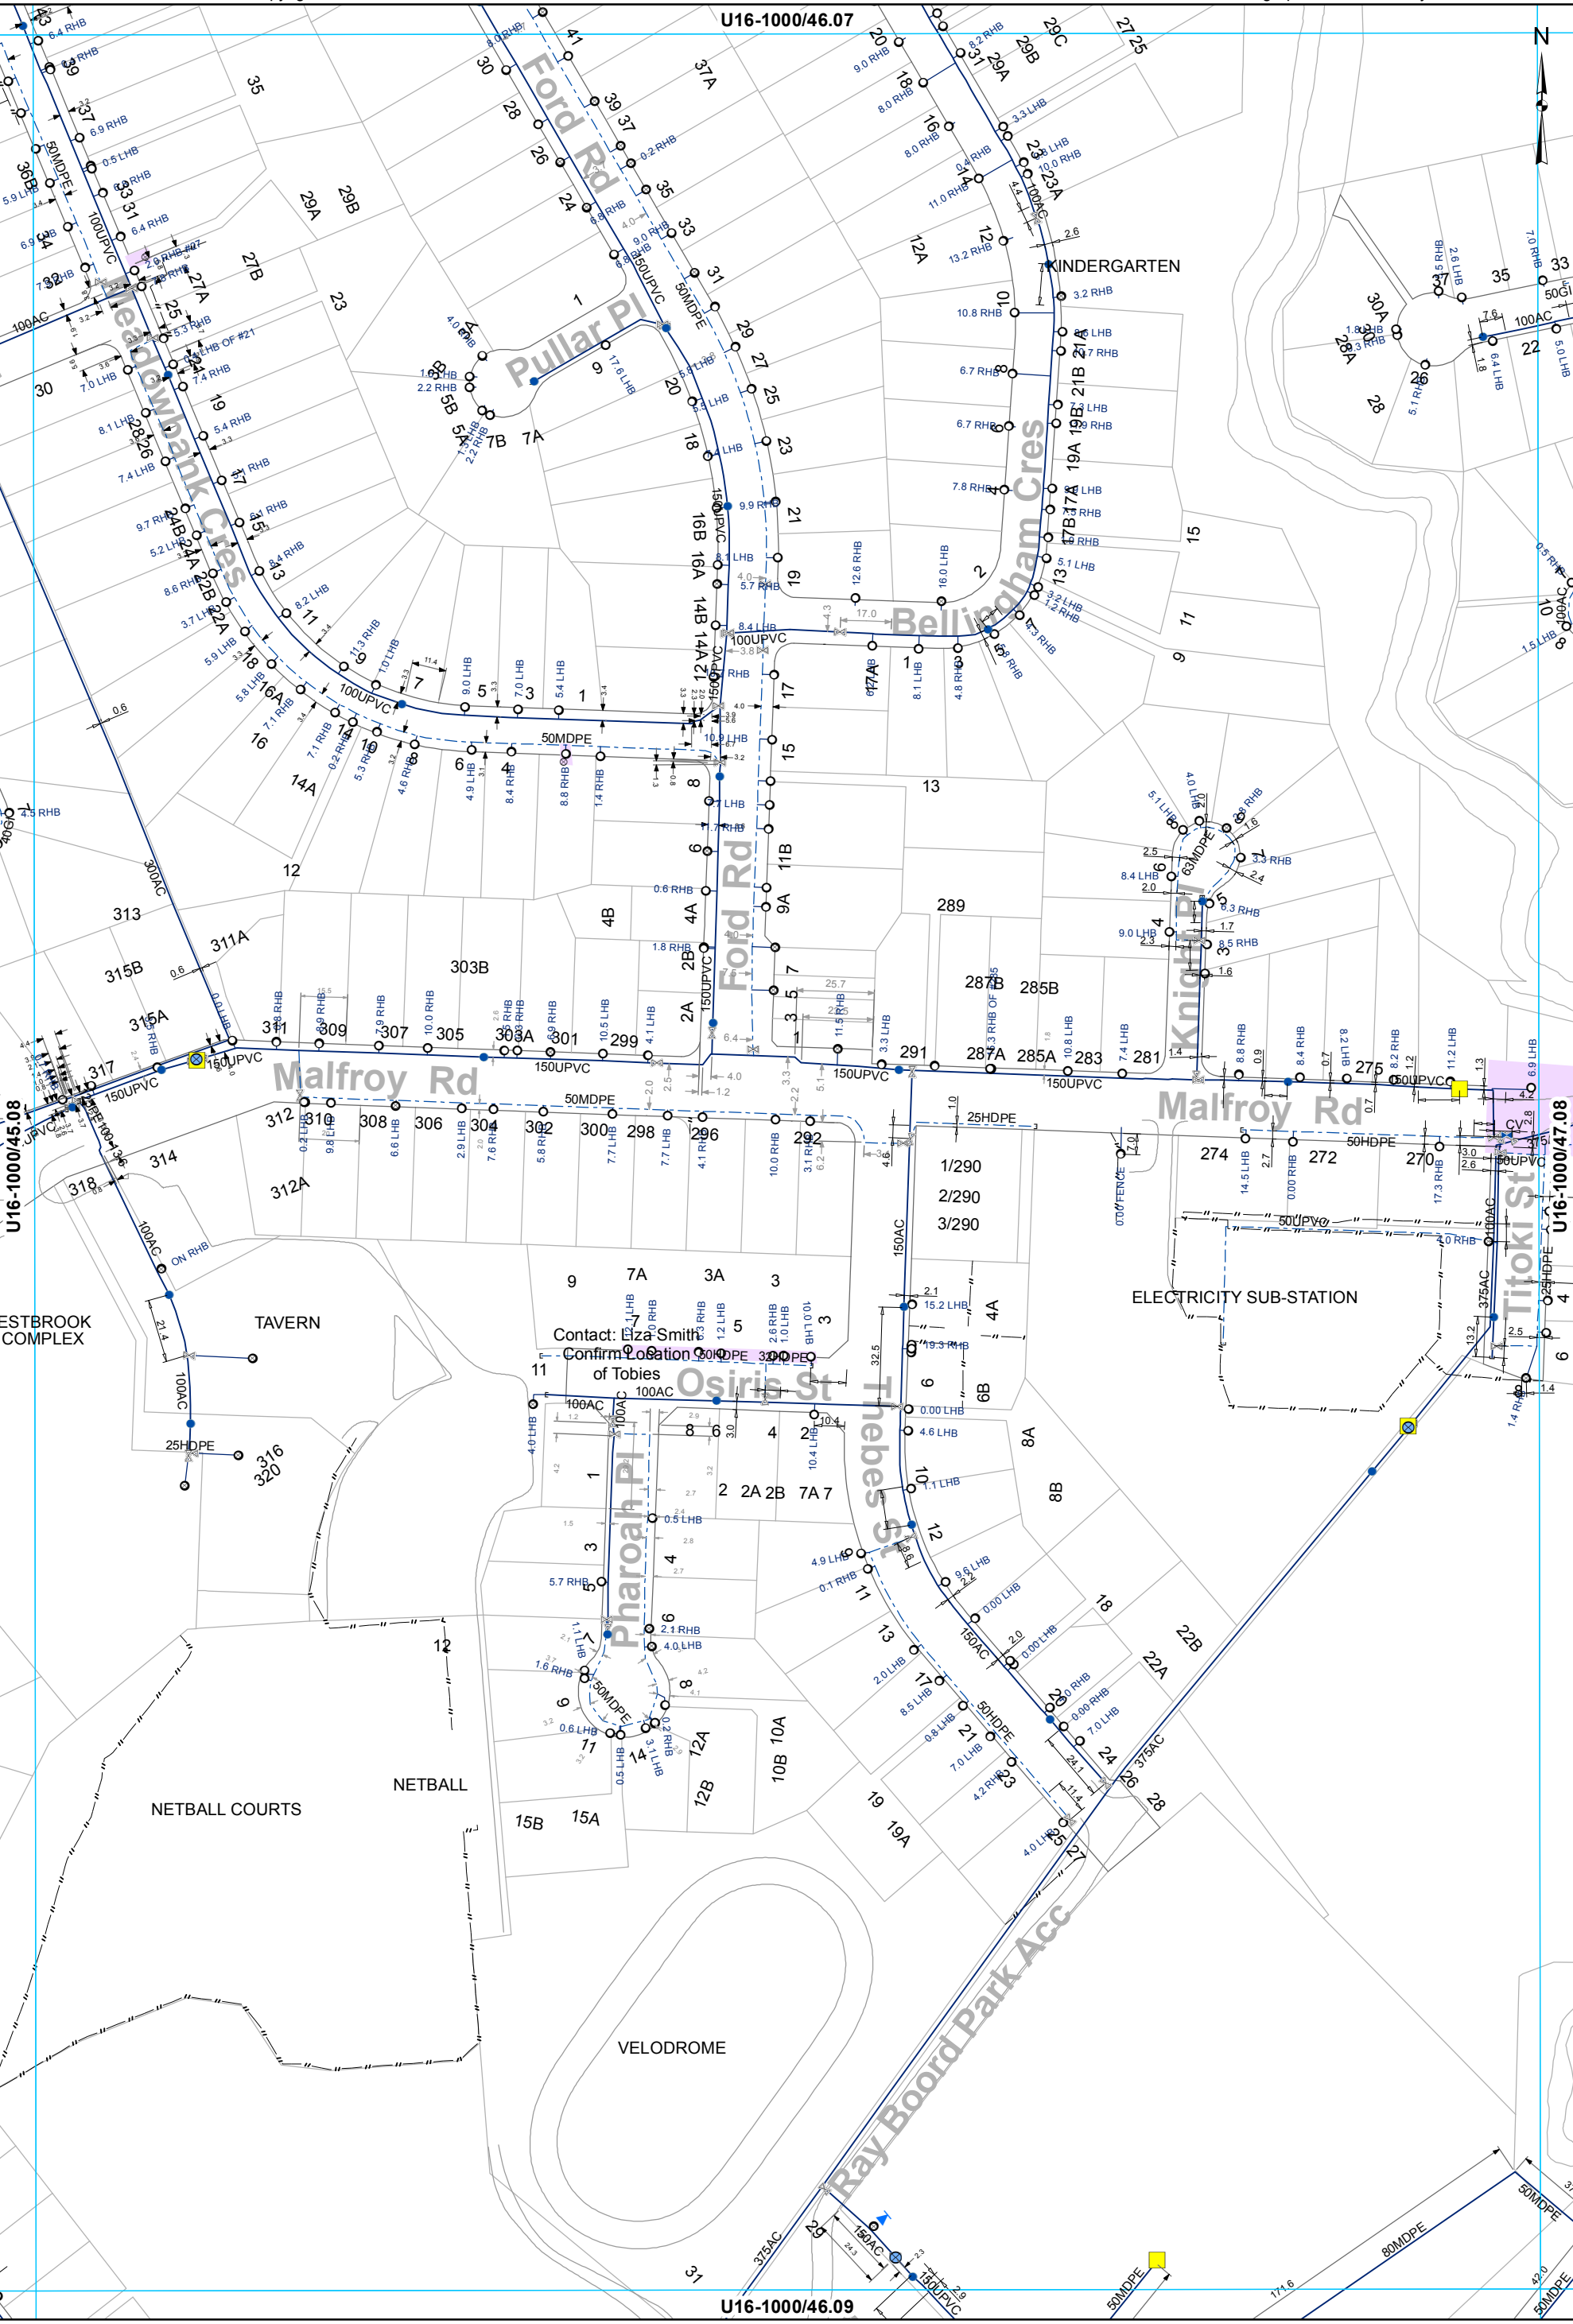


- | | | | | |
|----------------|-----------|------------------|-----------------|------------------|
| ⌘ Valve | ● Hydrant | ⊗ Meter Bulk | ■ Miscellaneous | — WSServiceLine |
| ○ Toby | | ⊙ Meter Consumer | | — Main |
| ⌘ Closed Valve | | ⌚ Capped End | | - - - Rider main |

WATER SUPPLY SERVICES
1:2000 @ A3 - (U16-1000/46.08)


All dimensions and levels should be verified by physical location on-site.

This data is derived from sources outside the control of Rotorua District Council and is for information only

 Rotorua District Council 2006. Facsimile 07 346 3143 Telephone 07 348 4199 email mail@rdc.govt.nz




WATER SUPPLY SERVICES
1:2000 @ A3 - (U16-1000/47.08)

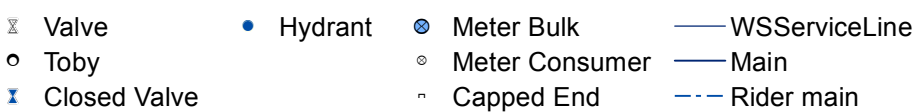

This data is derived from sources outside the control of Rotorua District Council and is for information only. All dimensions and levels should be verified by physical location on-site.

 Rotorua District Council 2006. Facsimile 07 346 3143 Telephone 07 348 4199 email mail@rdc.govt.nz




All dimensions and levels should be verified by physical location on-site.

This data is derived from sources outside the control of Rotorua District Council and is for information only


 Valve
 Hydrant
 Meter Consumer
  WSServiceLine
 Toby
 Capped End
 Main
 Closed Valve
 Rider main

WATER SUPPLY SERVICES
1:2000 @ A3 - (U16-1000/49.08)

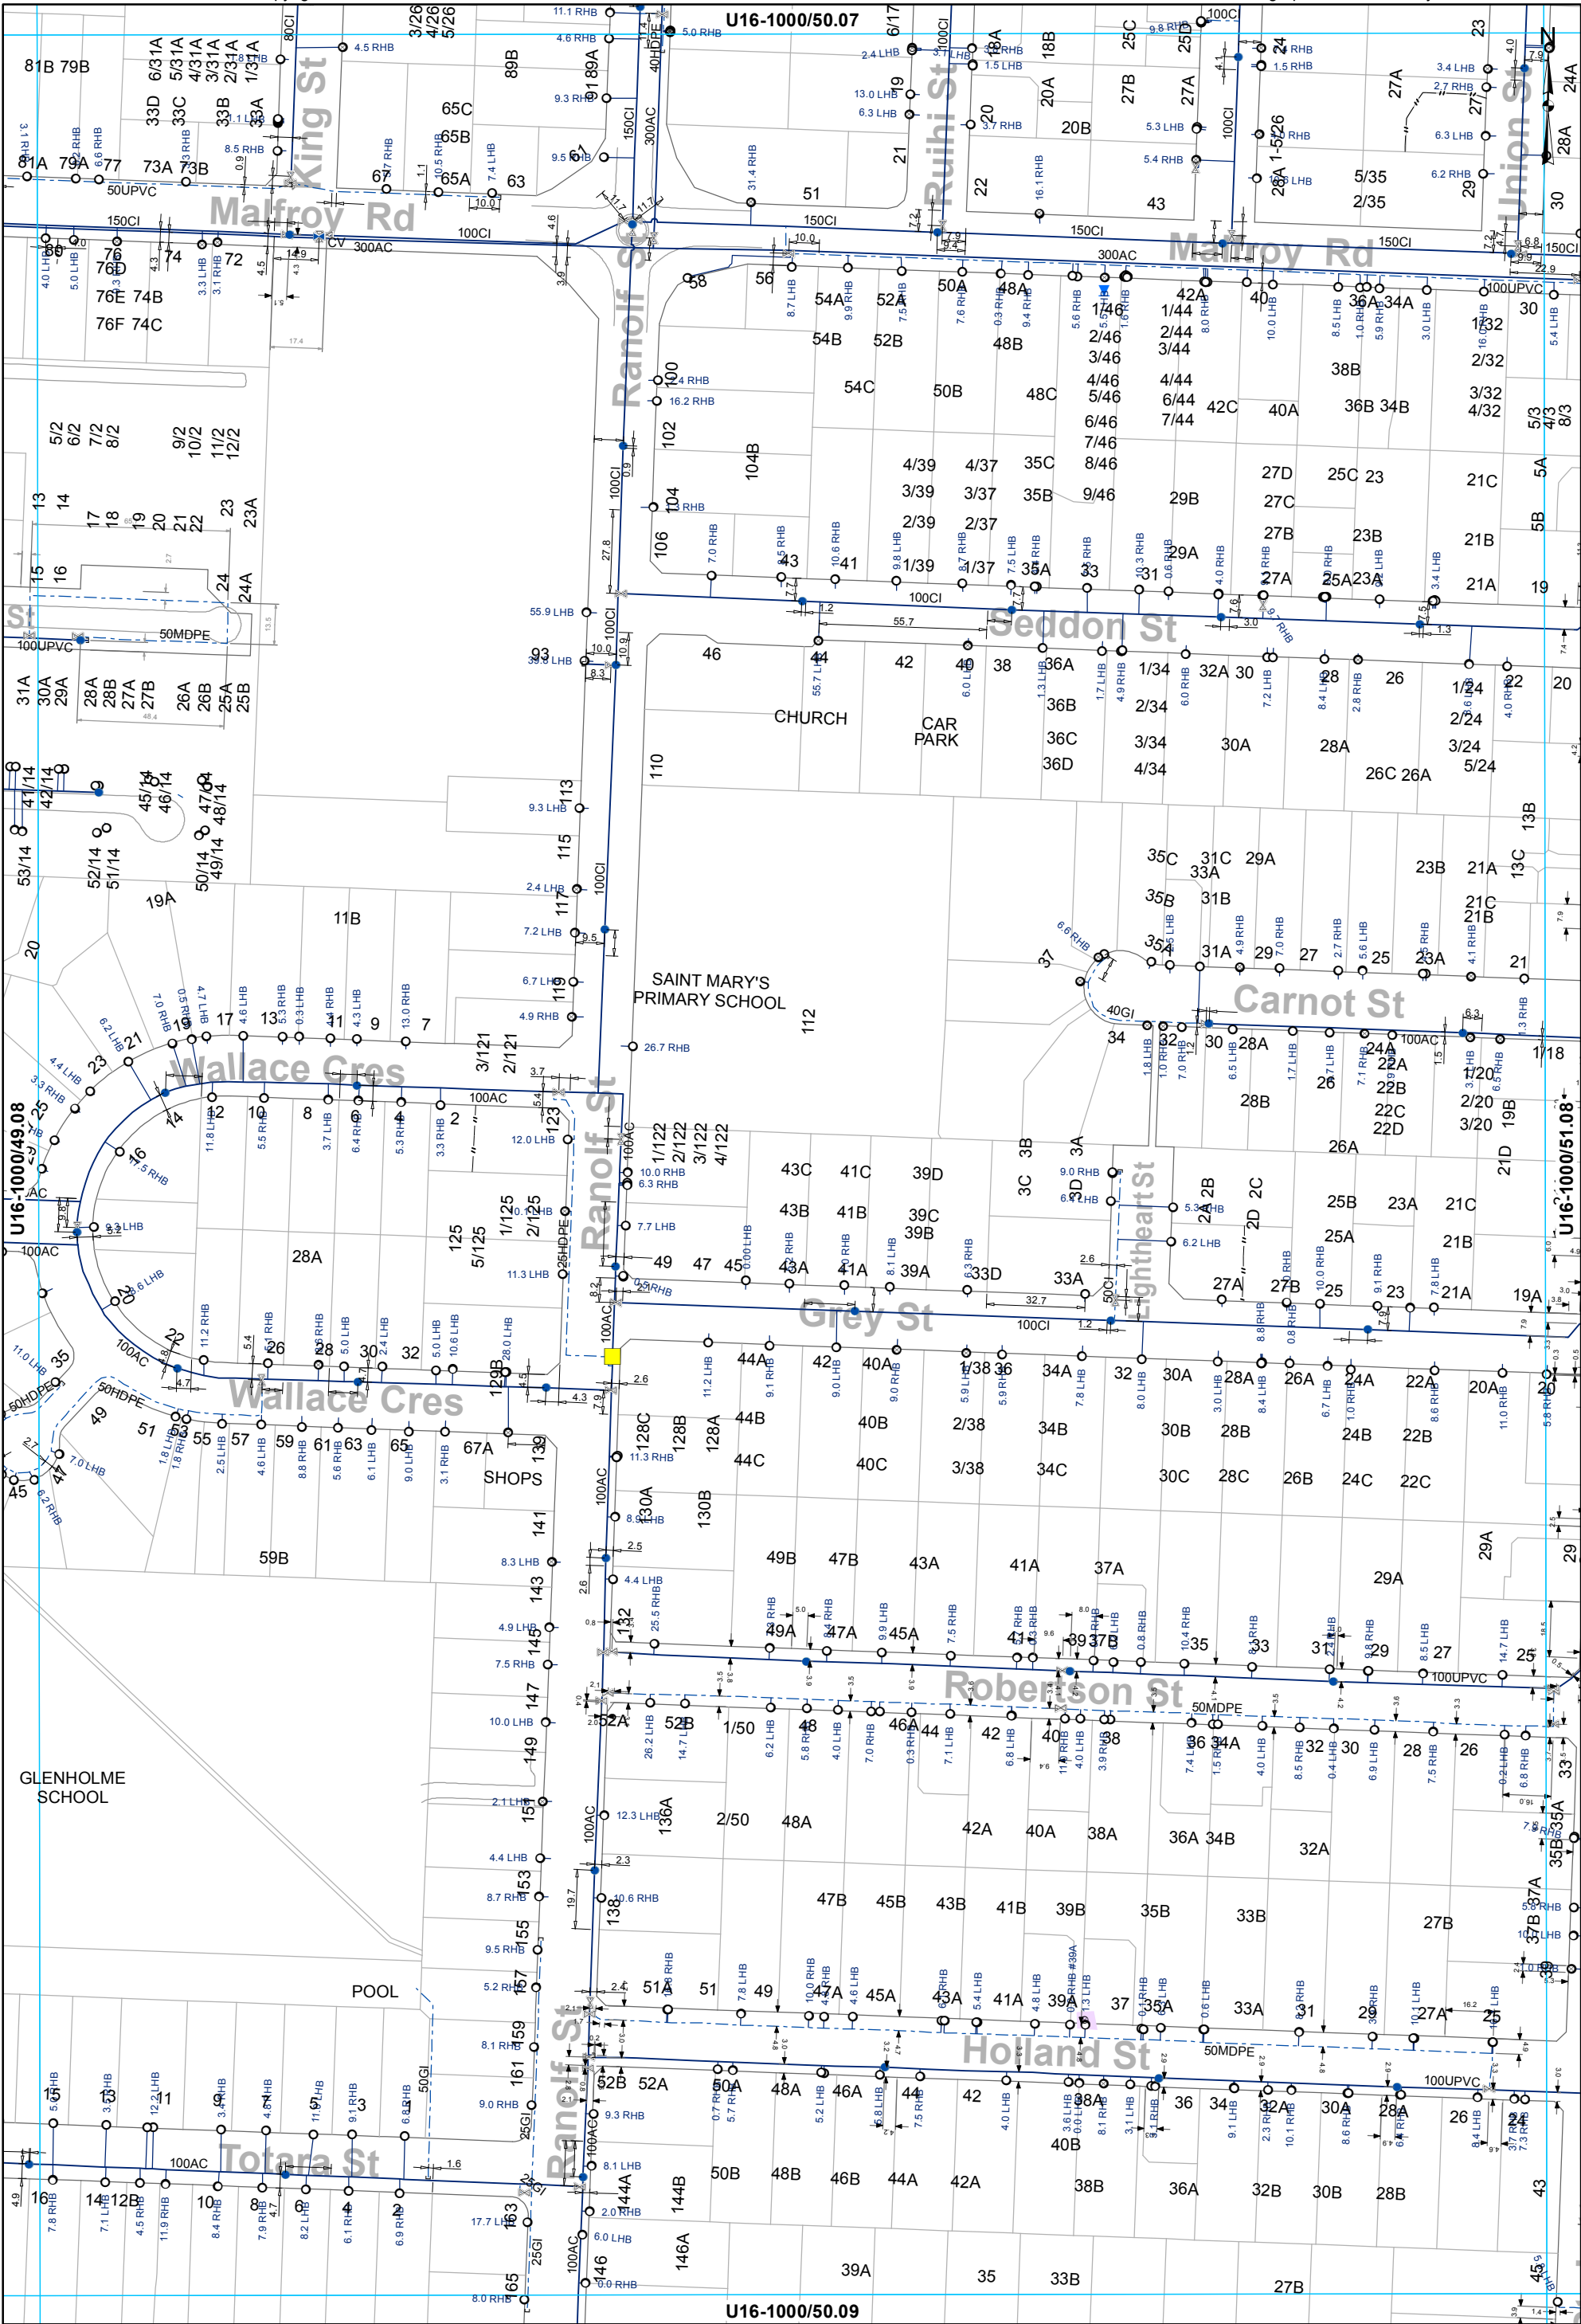

- | | | | | |
|--------------|---------|----------------|---------------|---------------|
| Valve | Hydrant | Meter Consumer | Miscellaneous | WSServiceLine |
| Toby | | Capped End | | Main |
| Closed Valve | | | | Rider main |

WATER SUPPLY SERVICES
1:2000 @ A3 - (U16-1000/50.08)

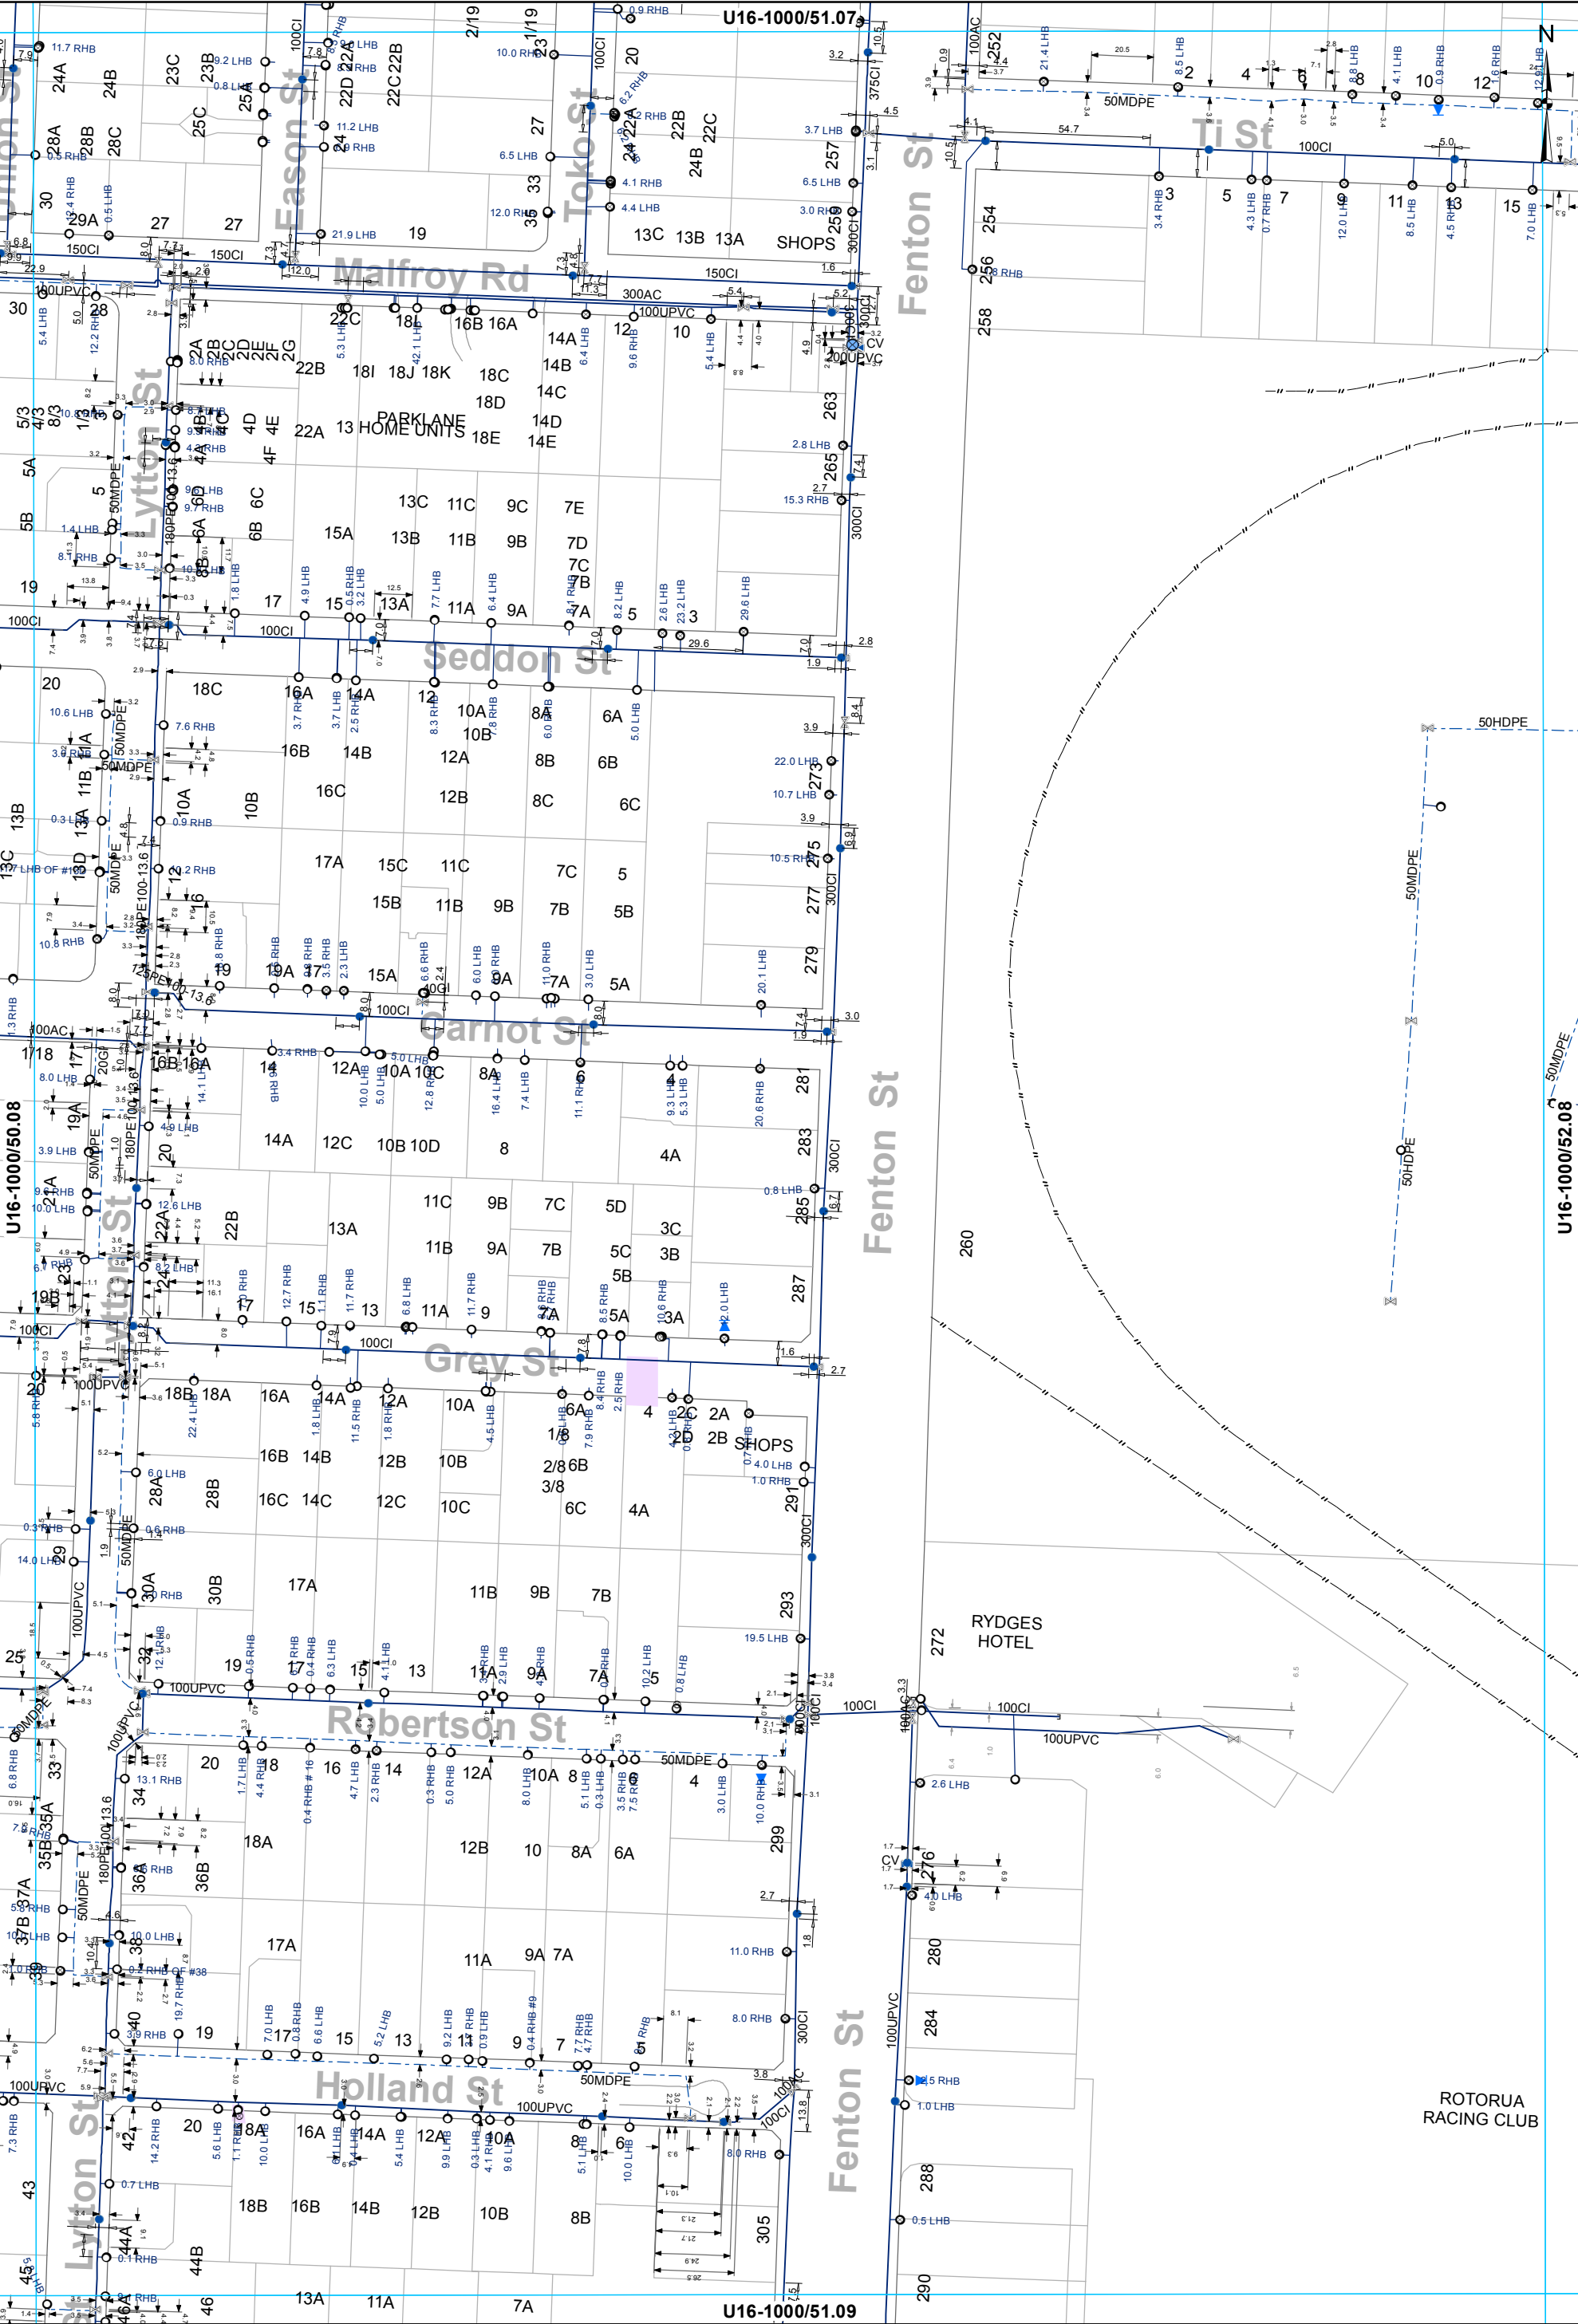


- | | | | |
|--------------|---------|----------------|---------------|
| Valve | Hydrant | Meter Bulk | WSServiceLine |
| Toby | | Meter Consumer | Main |
| Closed Valve | | Capped End | Rider main |

WATER SUPPLY SERVICES
1:2000 @ A3 - (U16-1000/51.08)

This data is derived from sources outside the control of Rotorua District Council and is for information only


All dimensions and levels should be verified by physical location on-site.

Rotorua District Council 2006. Facsimile 07 346 3143 Telephone 07 348 4199 email mail@rdc.govt.nz

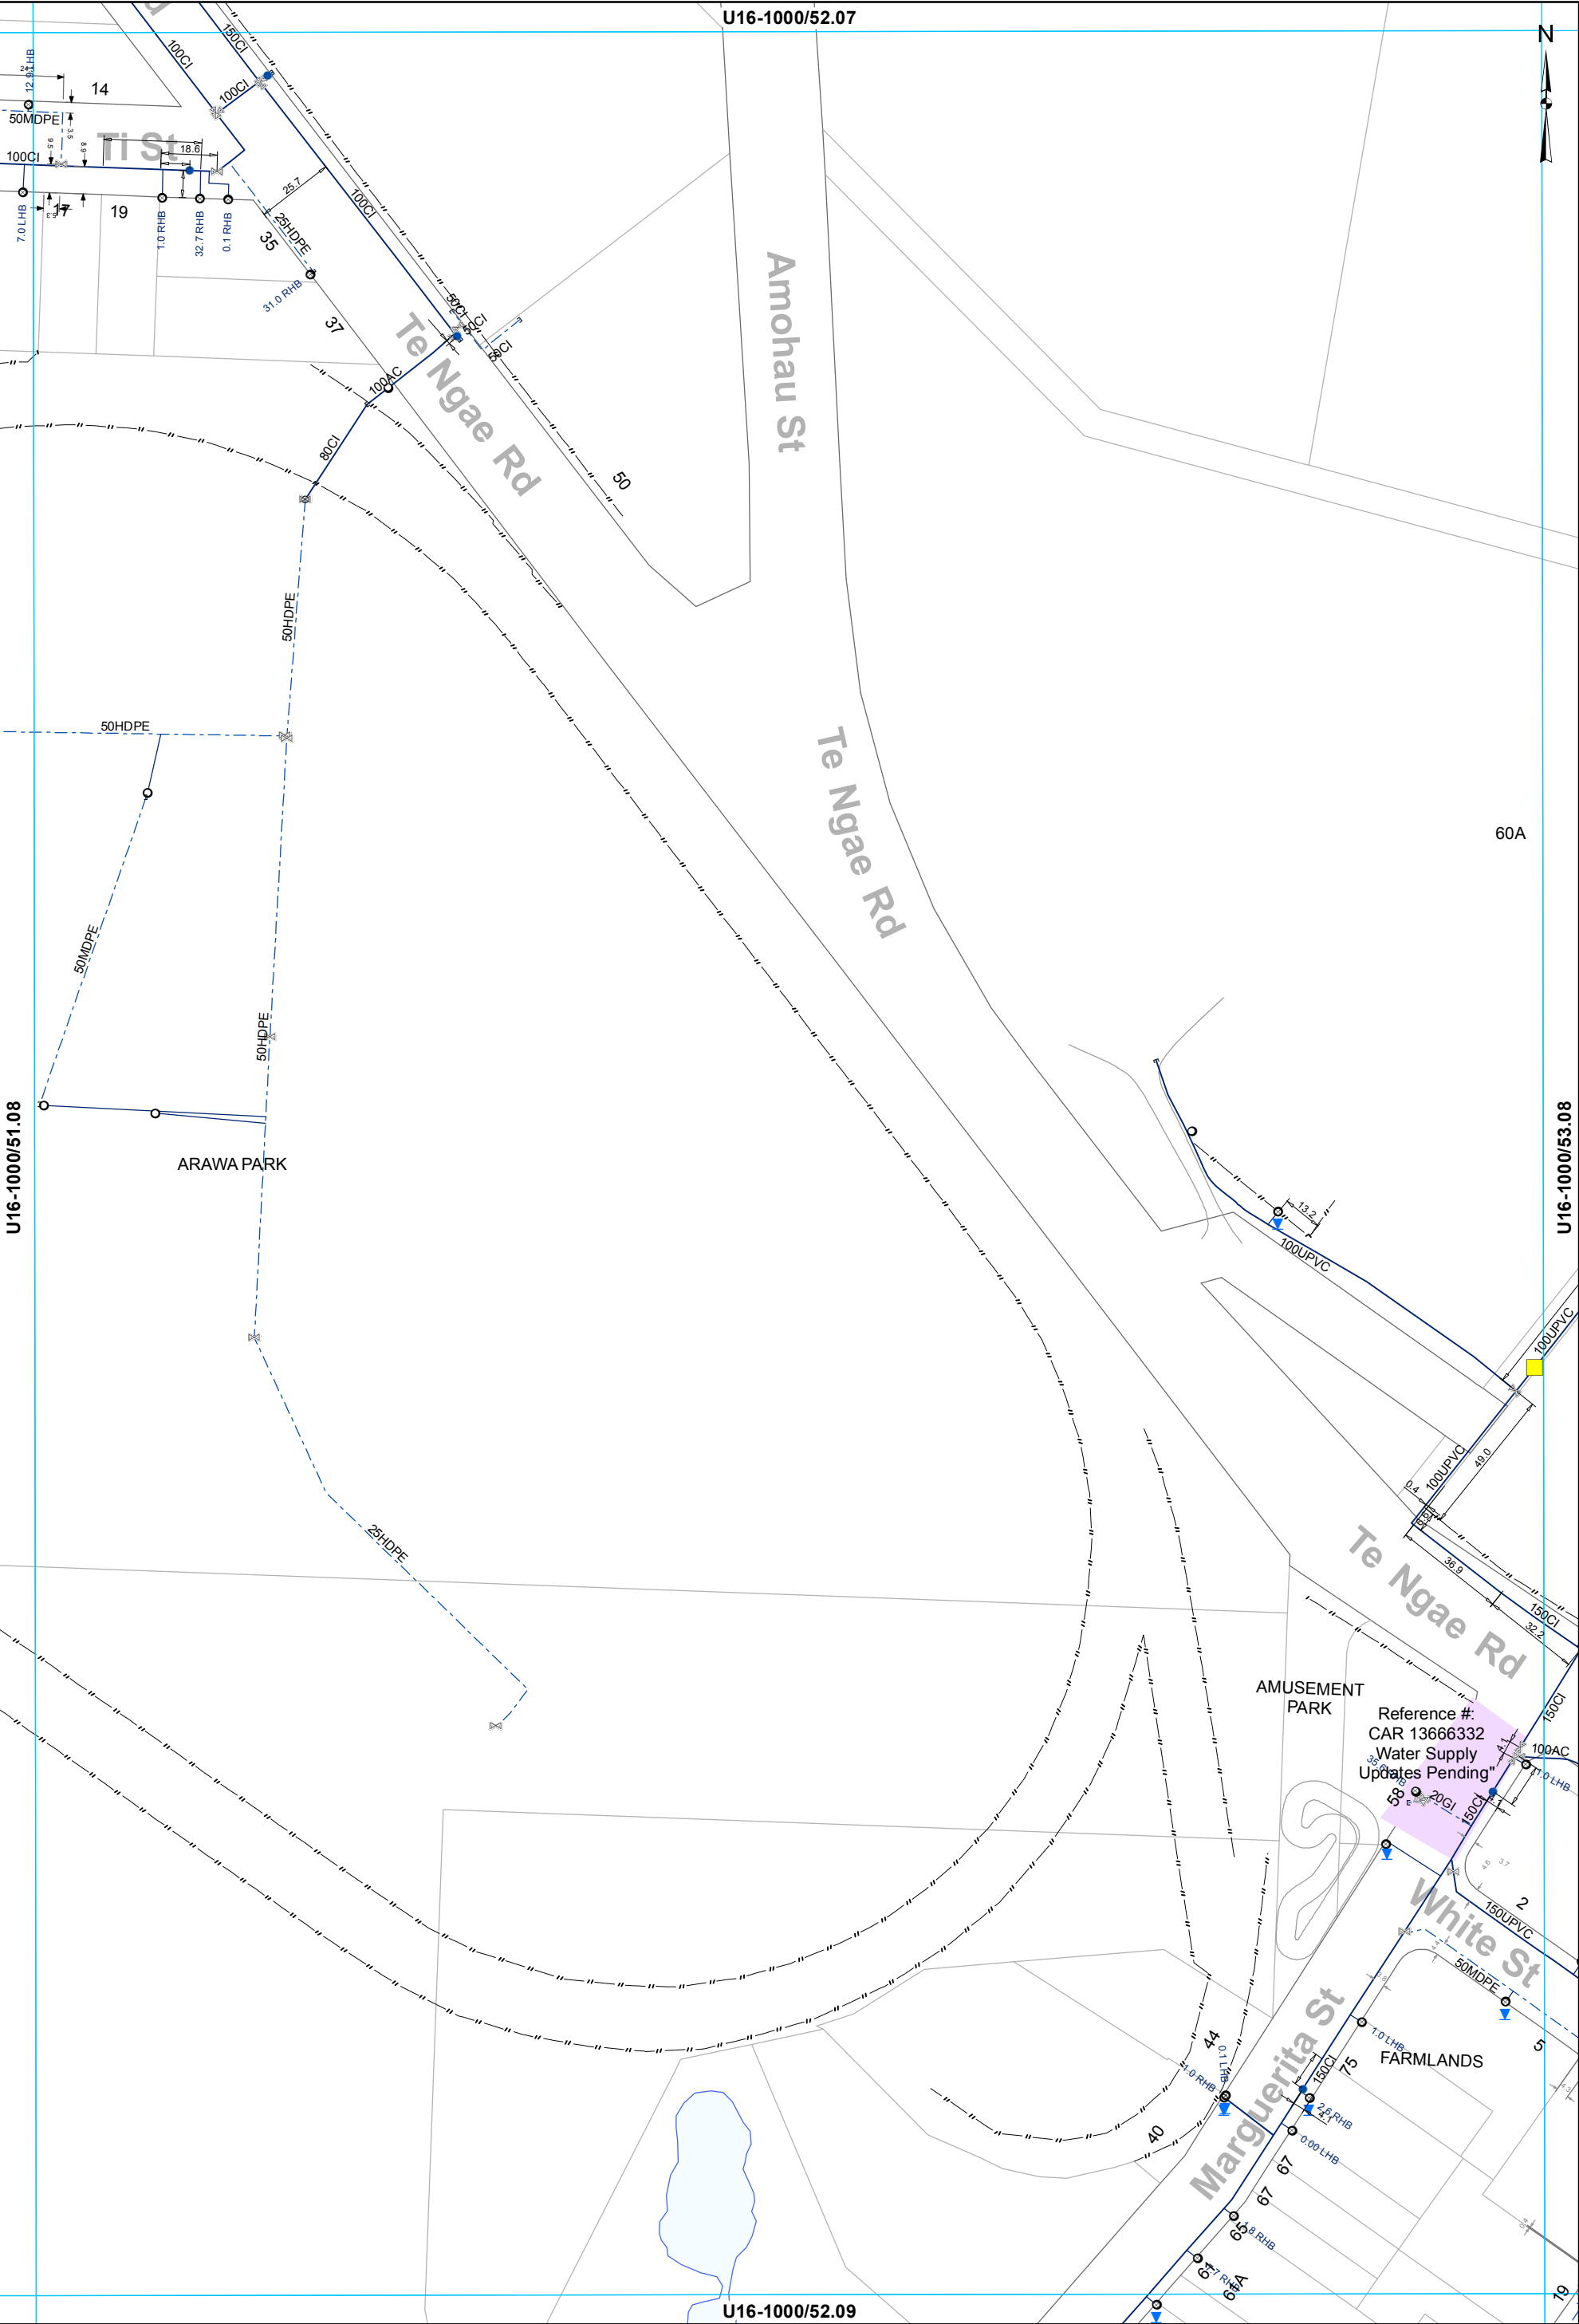



WATER SUPPLY SERVICES
1:2000 @ A3 - (U16-1000/53.08)

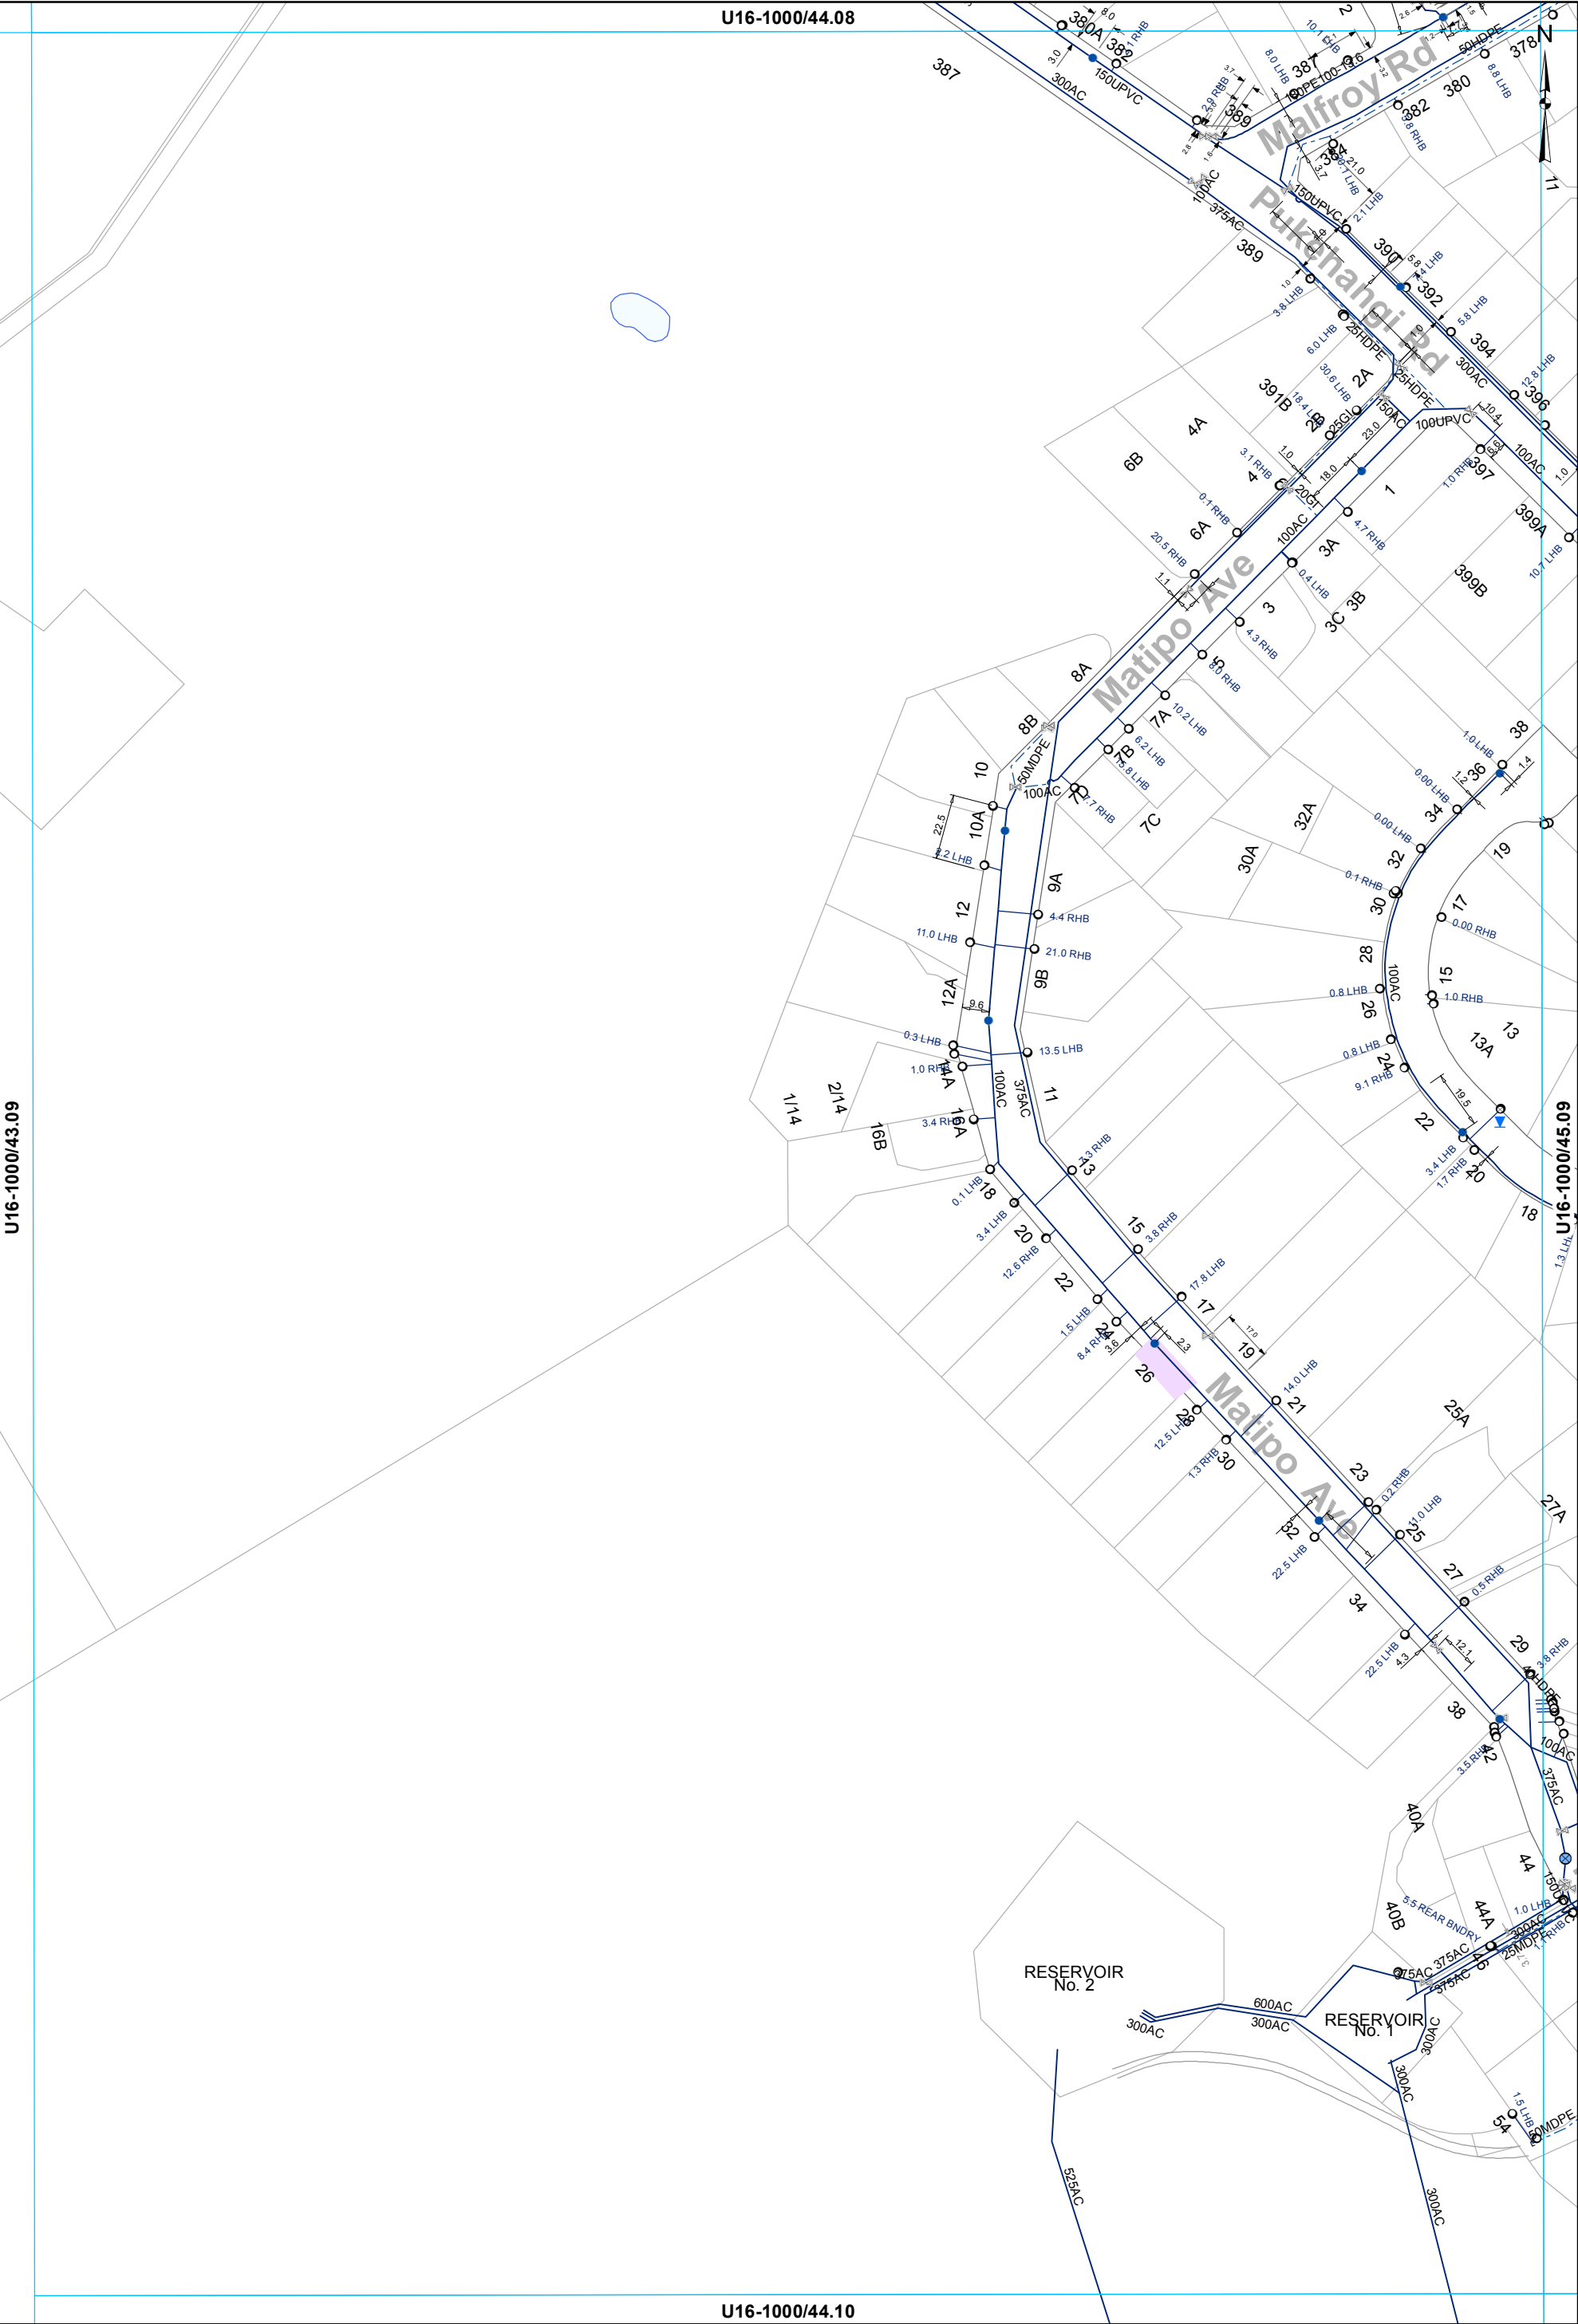

U16-1000/43.09

U16-1000/44.08

U16-1000/45.09

U16-1000/44.10

- ⌵

Valve

●

Hydrant

⊗

Meter Bulk

—

WSServiceLine
- Toby

⊙

Meter Consumer

⌵

Capped End

—


Main
- Rider main

WATER SUPPLY SERVICES
1:2000 @ A3 - (U16-1000/44.09)

This data is derived from sources outside the control of Rotorua District Council and is for information only


All dimensions and levels should be verified by physical location on-site.


Rotorua District Council 2006. Facsimile 07 346 3143 Telephone 07 348 4199 email mail@rdc.govt.nz

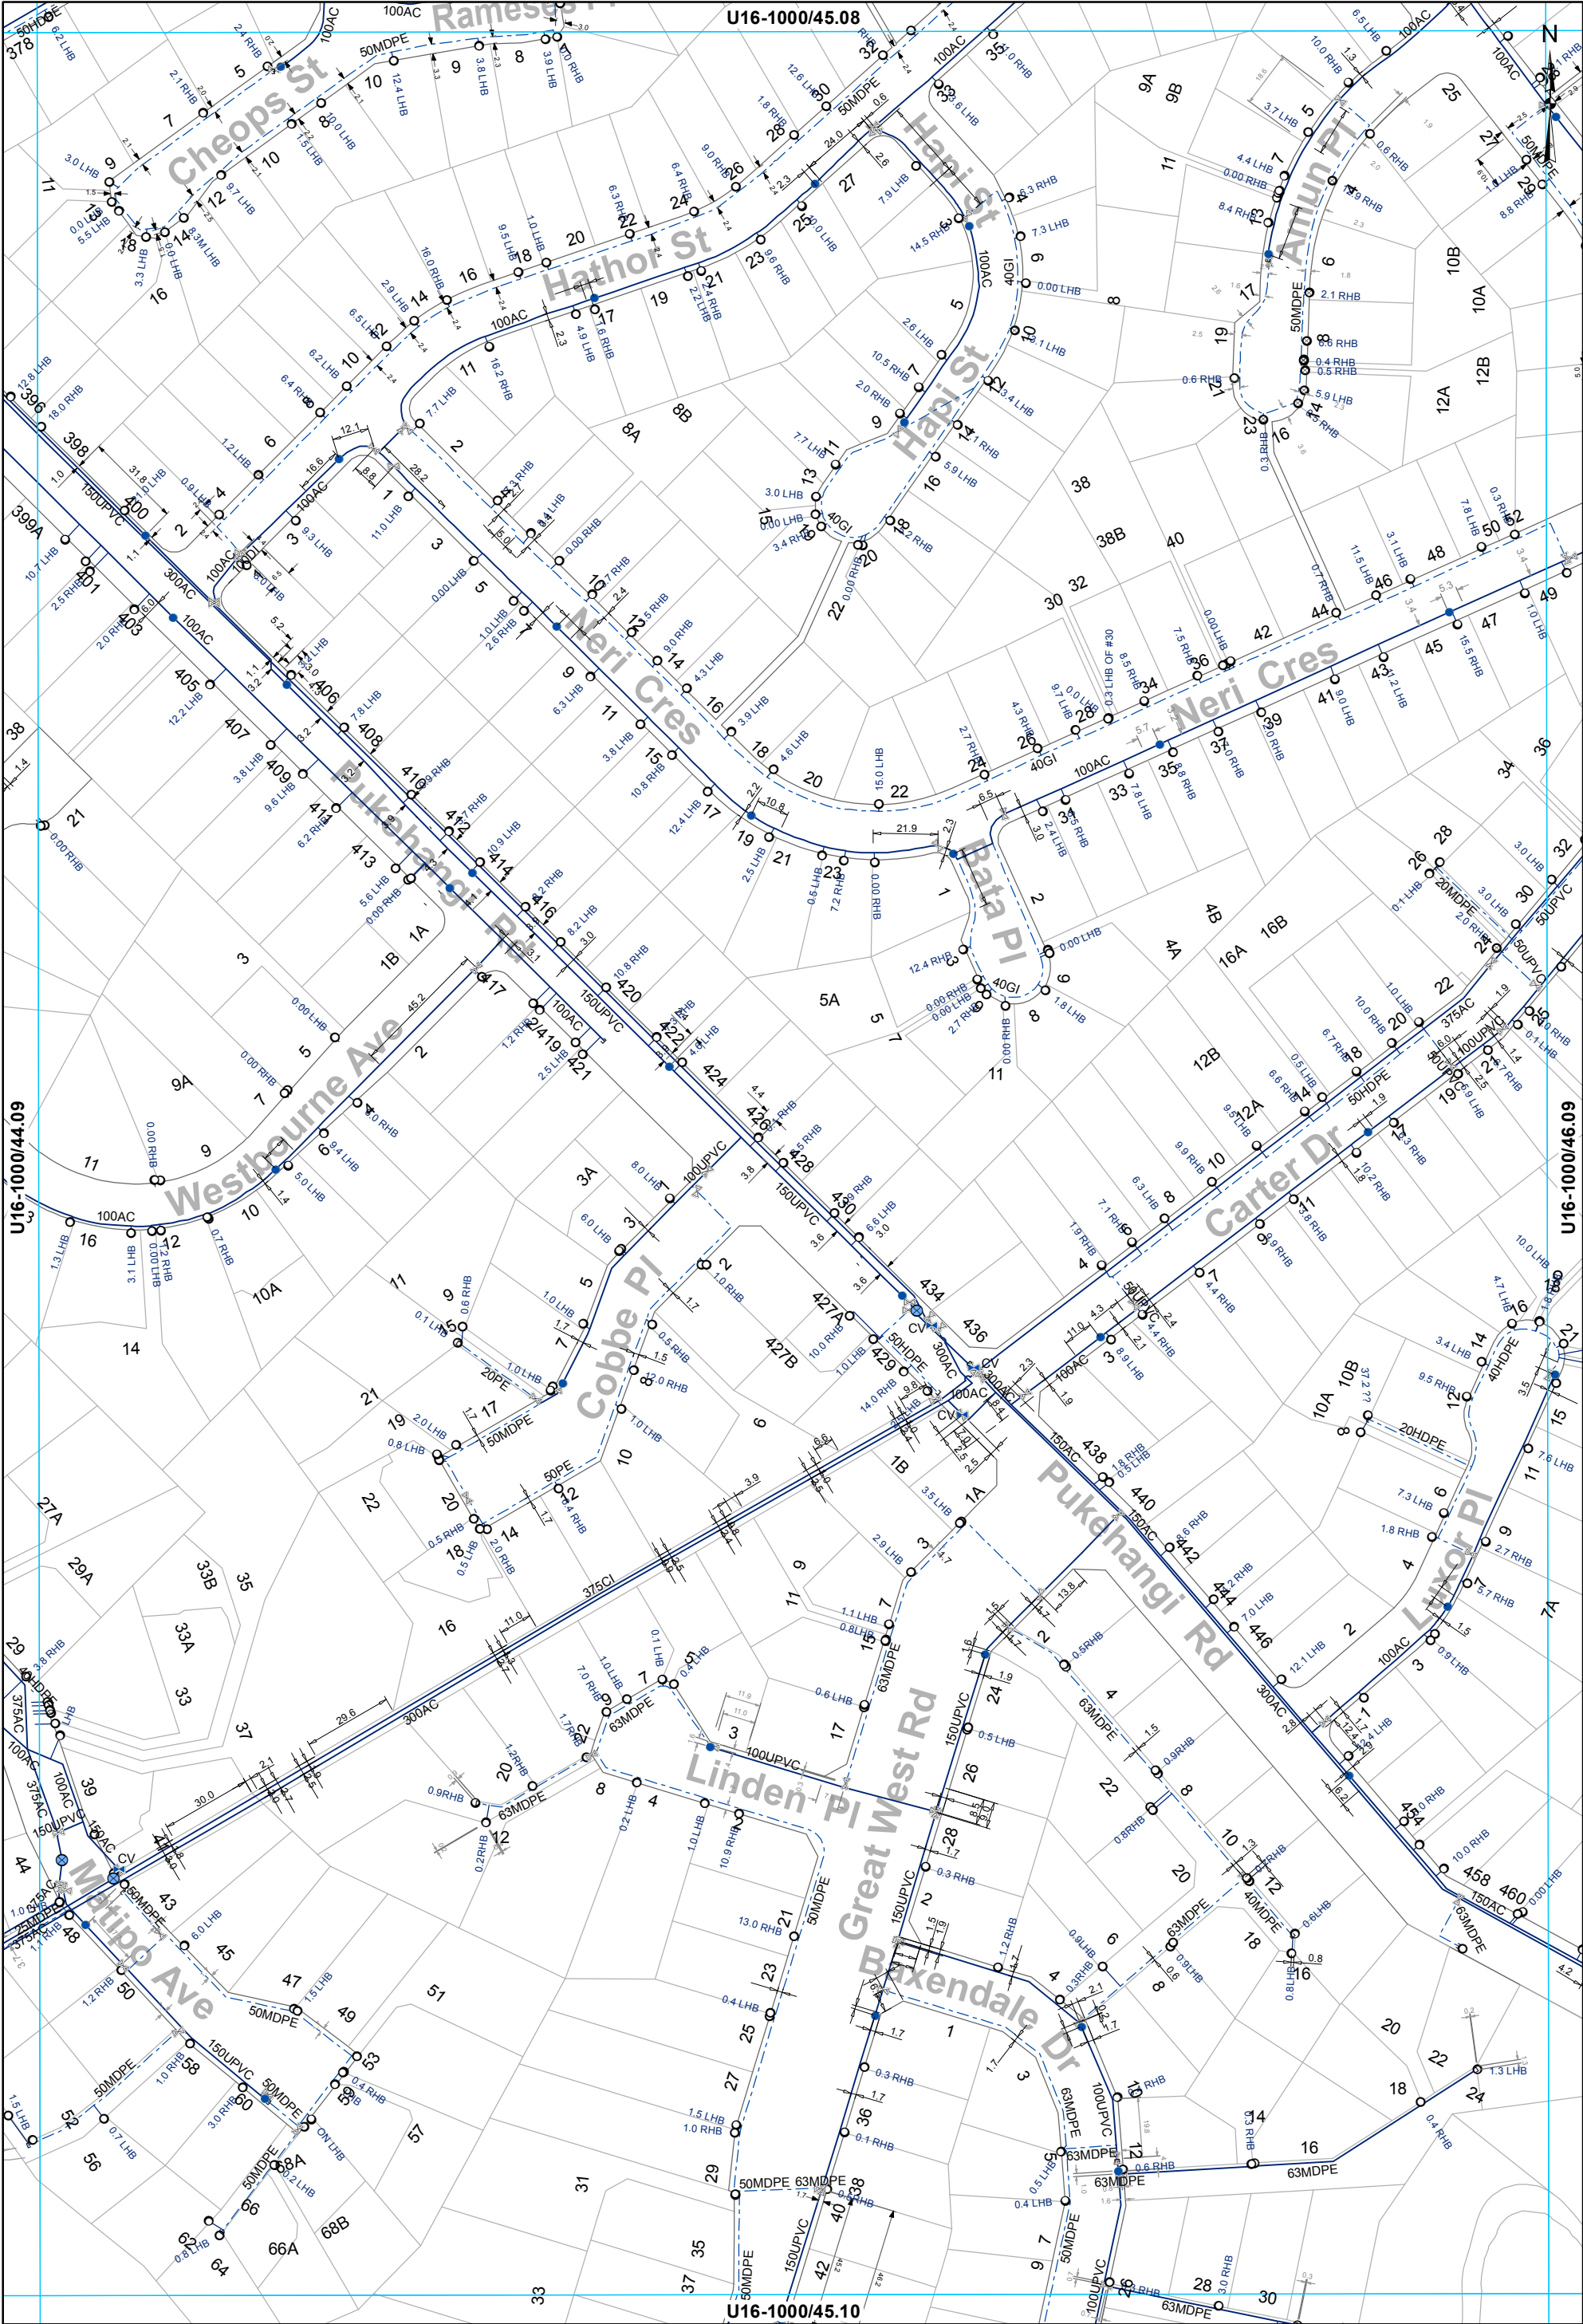

- | | | | |
|--------------|----------------|------------|---------------|
| Valve | Hydrant | Meter Bulk | WSServiceLine |
| Toby | Meter Consumer | Main | |
| Closed Valve | Capped End | Rider main | |

WATER SUPPLY SERVICES
1:2000 @ A3 - (U16-1000/45.09)

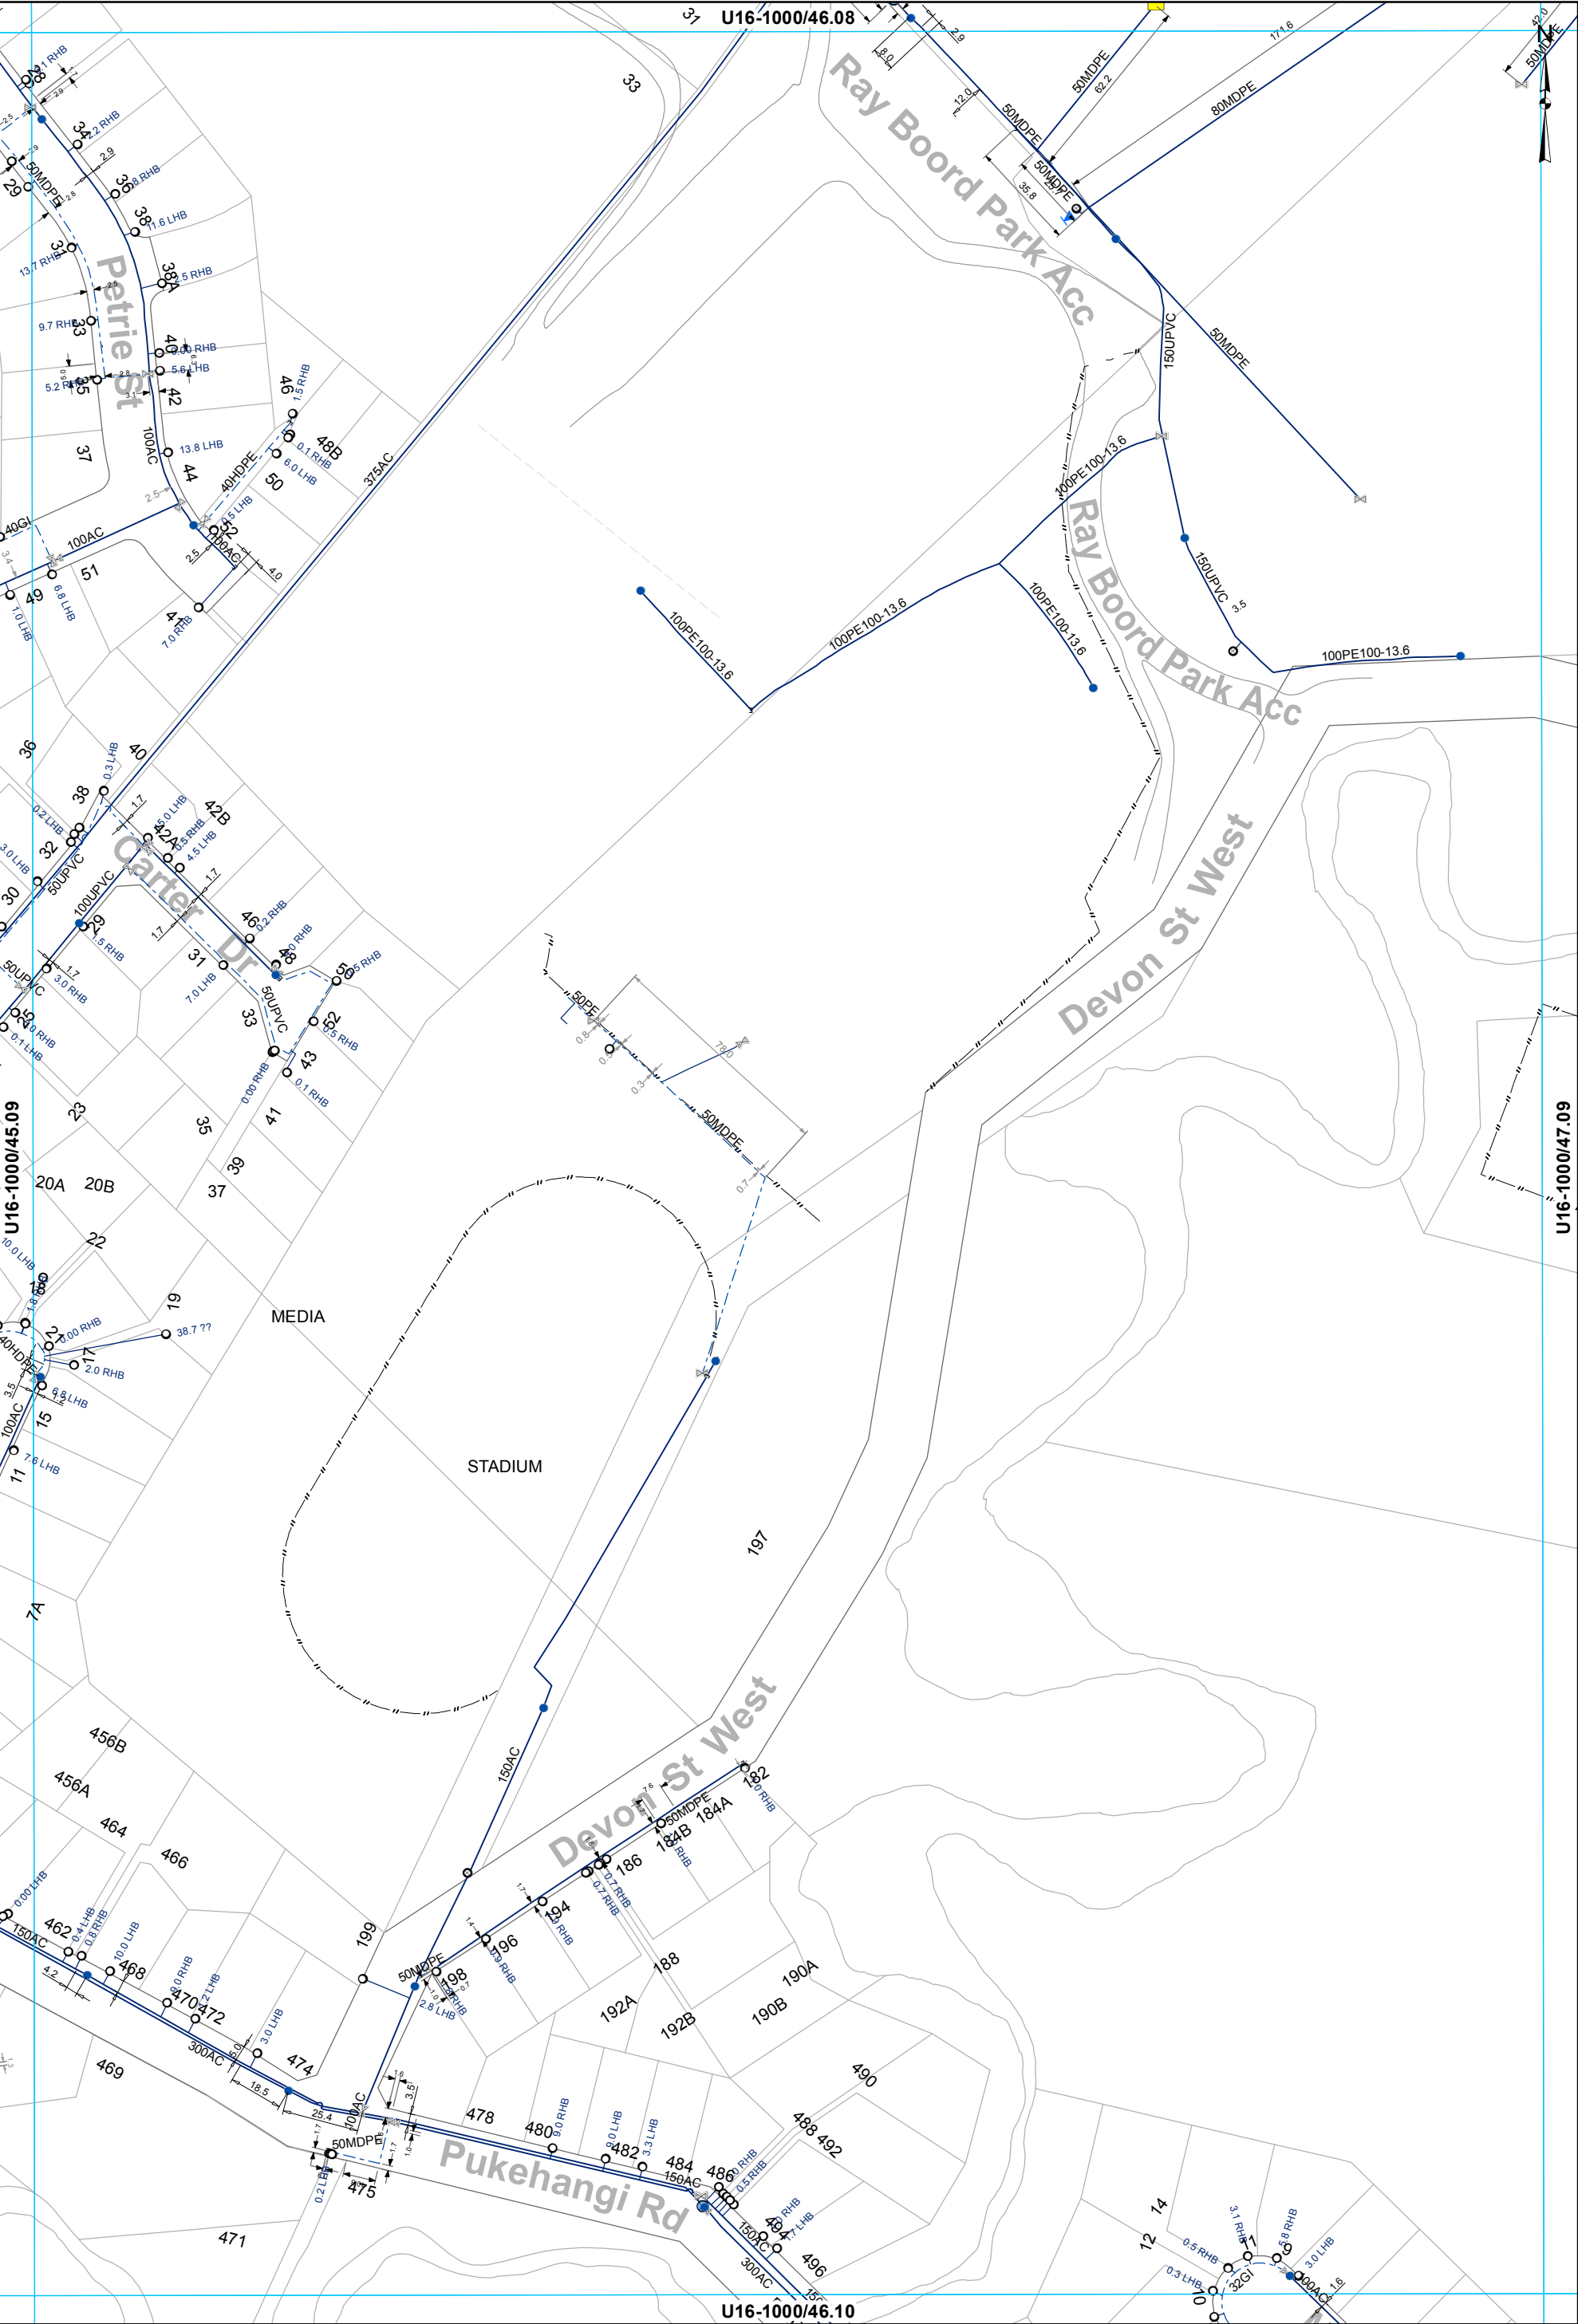

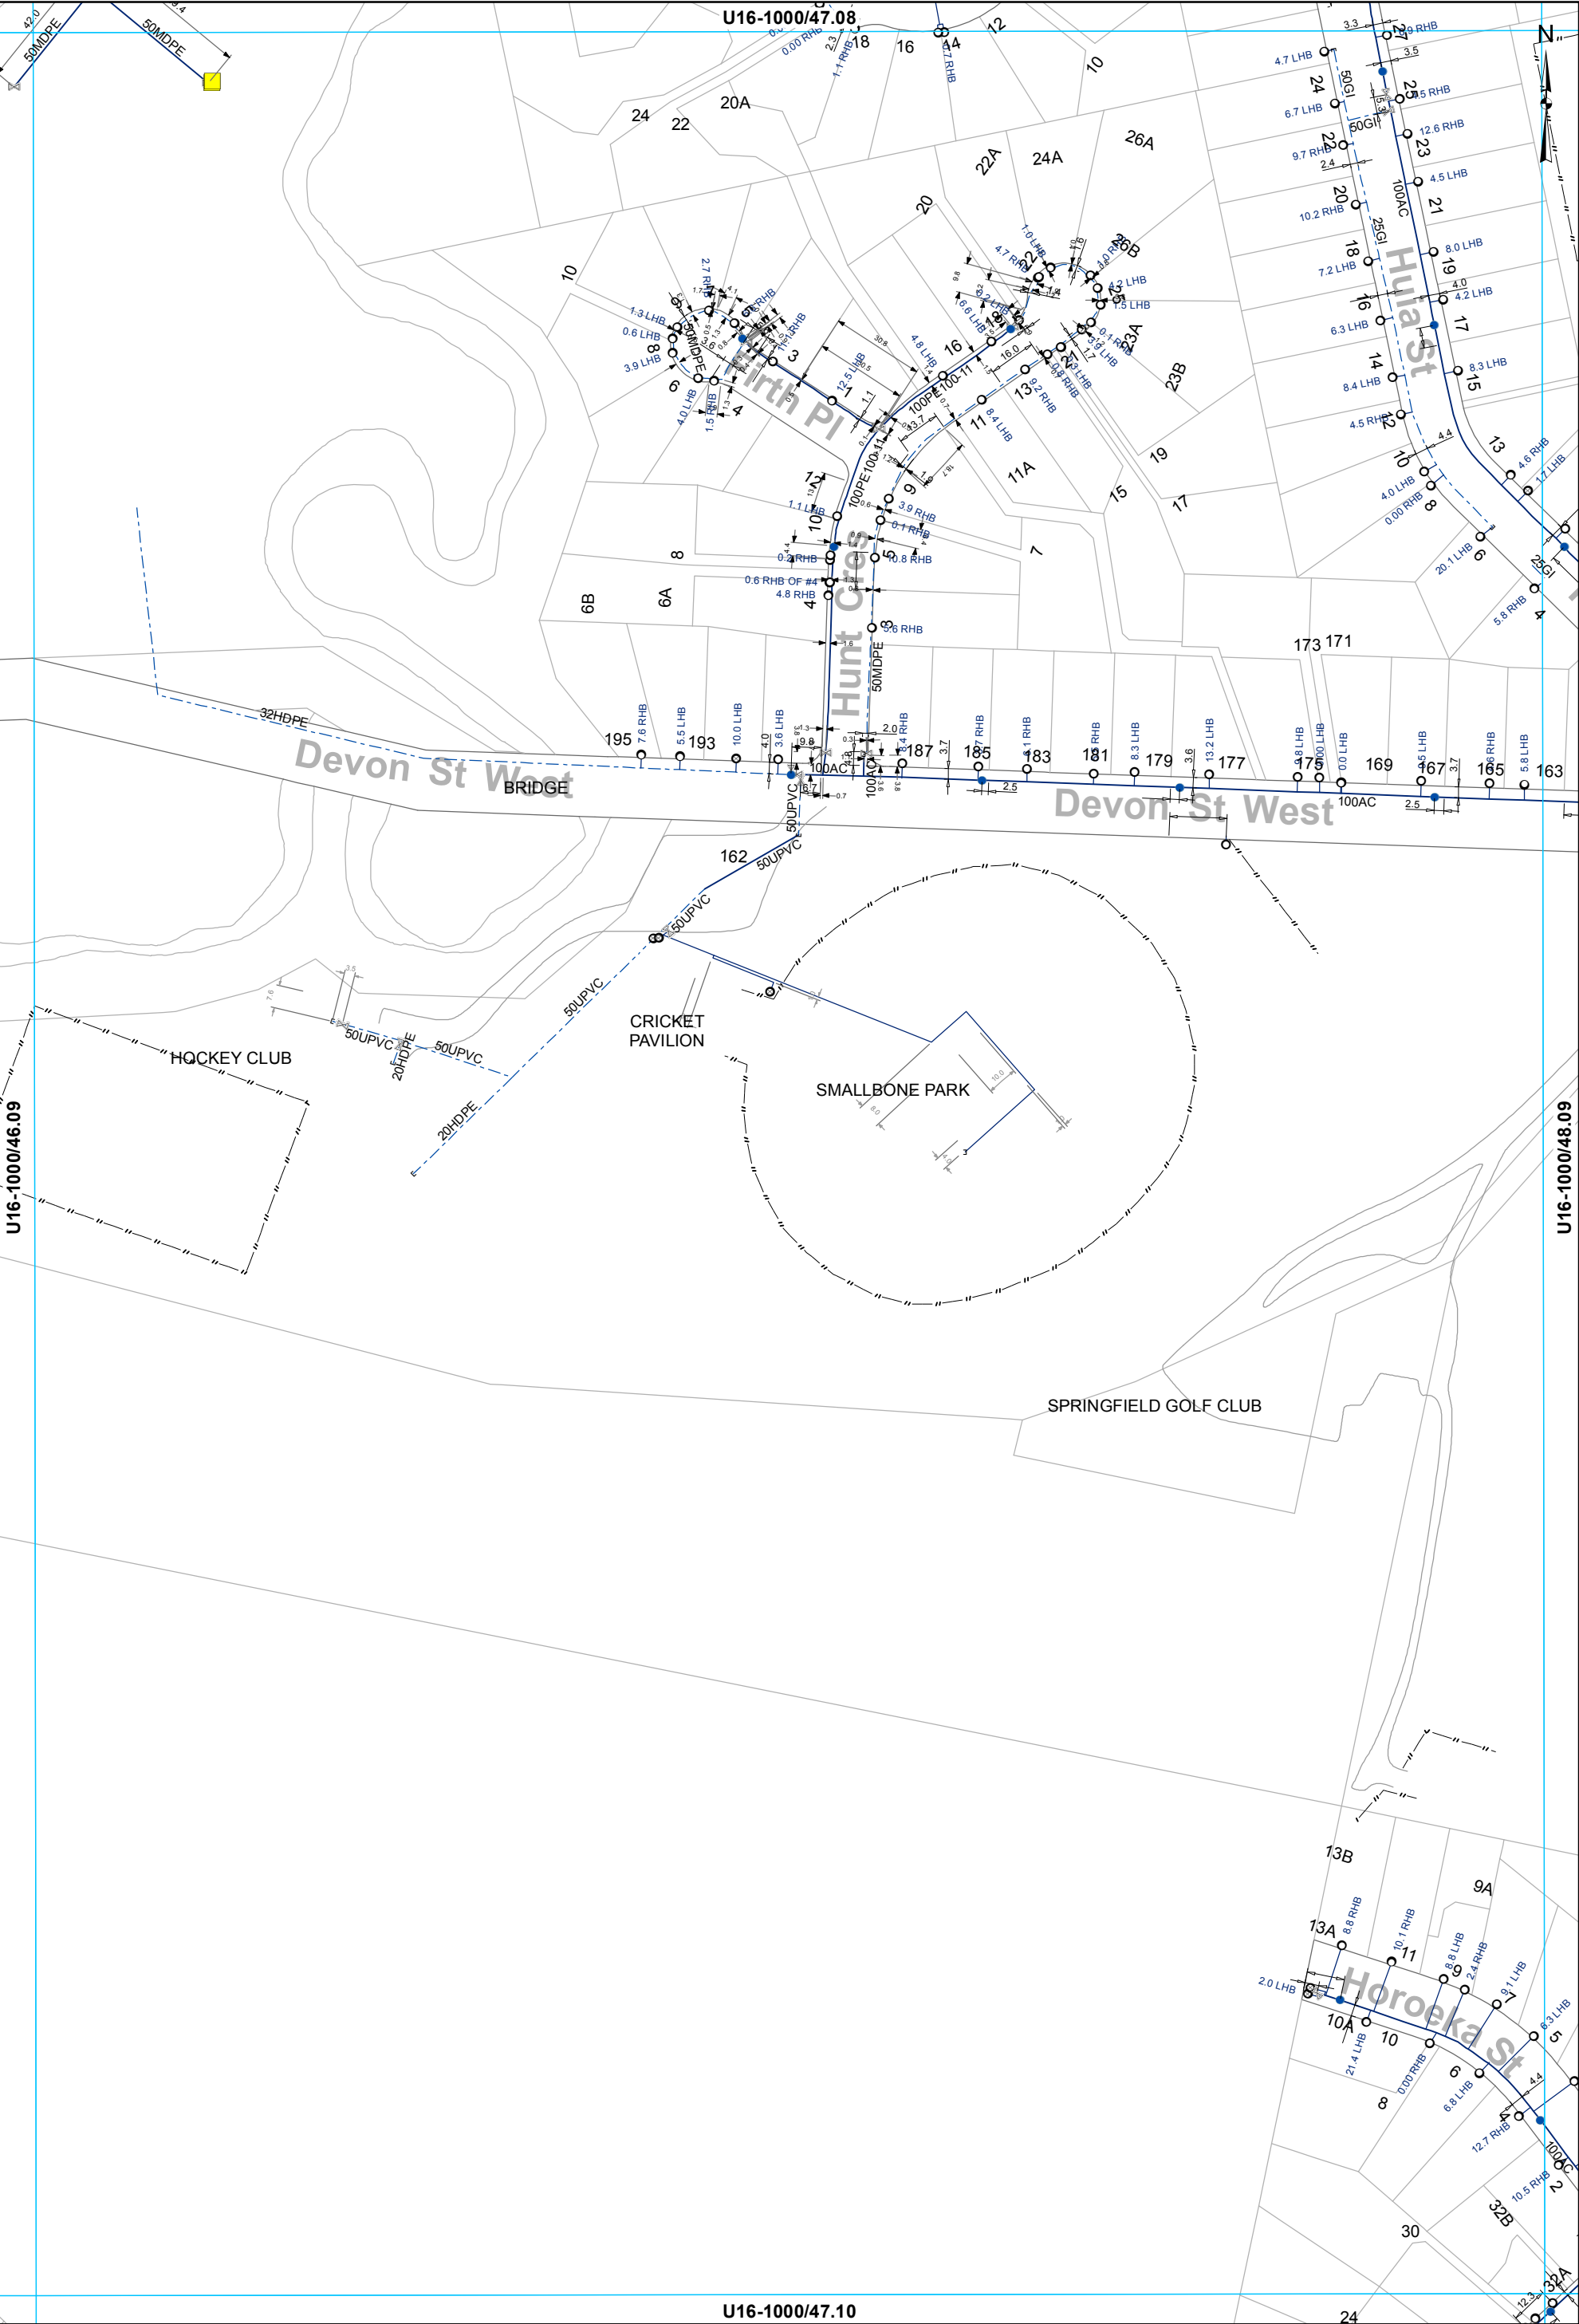


- | | | | | |
|---------|-----------|------------------|-----------------|------------------|
| ⌵ Valve | ● Hydrant | ⊙ Meter Consumer | ■ Miscellaneous | — WSServiceLine |
| ○ Toby | | ⌵ Capped End | | — Main |
| | | | | - - - Rider main |

WATER SUPPLY SERVICES
1:2000 @ A3 - (U16-1000/47.09)

This data is derived from sources outside the control of Rotorua District Council and is for information only

All dimensions and levels should be verified by physical location on-site.

Rotorua District Council 2006. Facsimile 07 348 3143 Telephone 07 348 4199 email mail@rdc.govt.nz

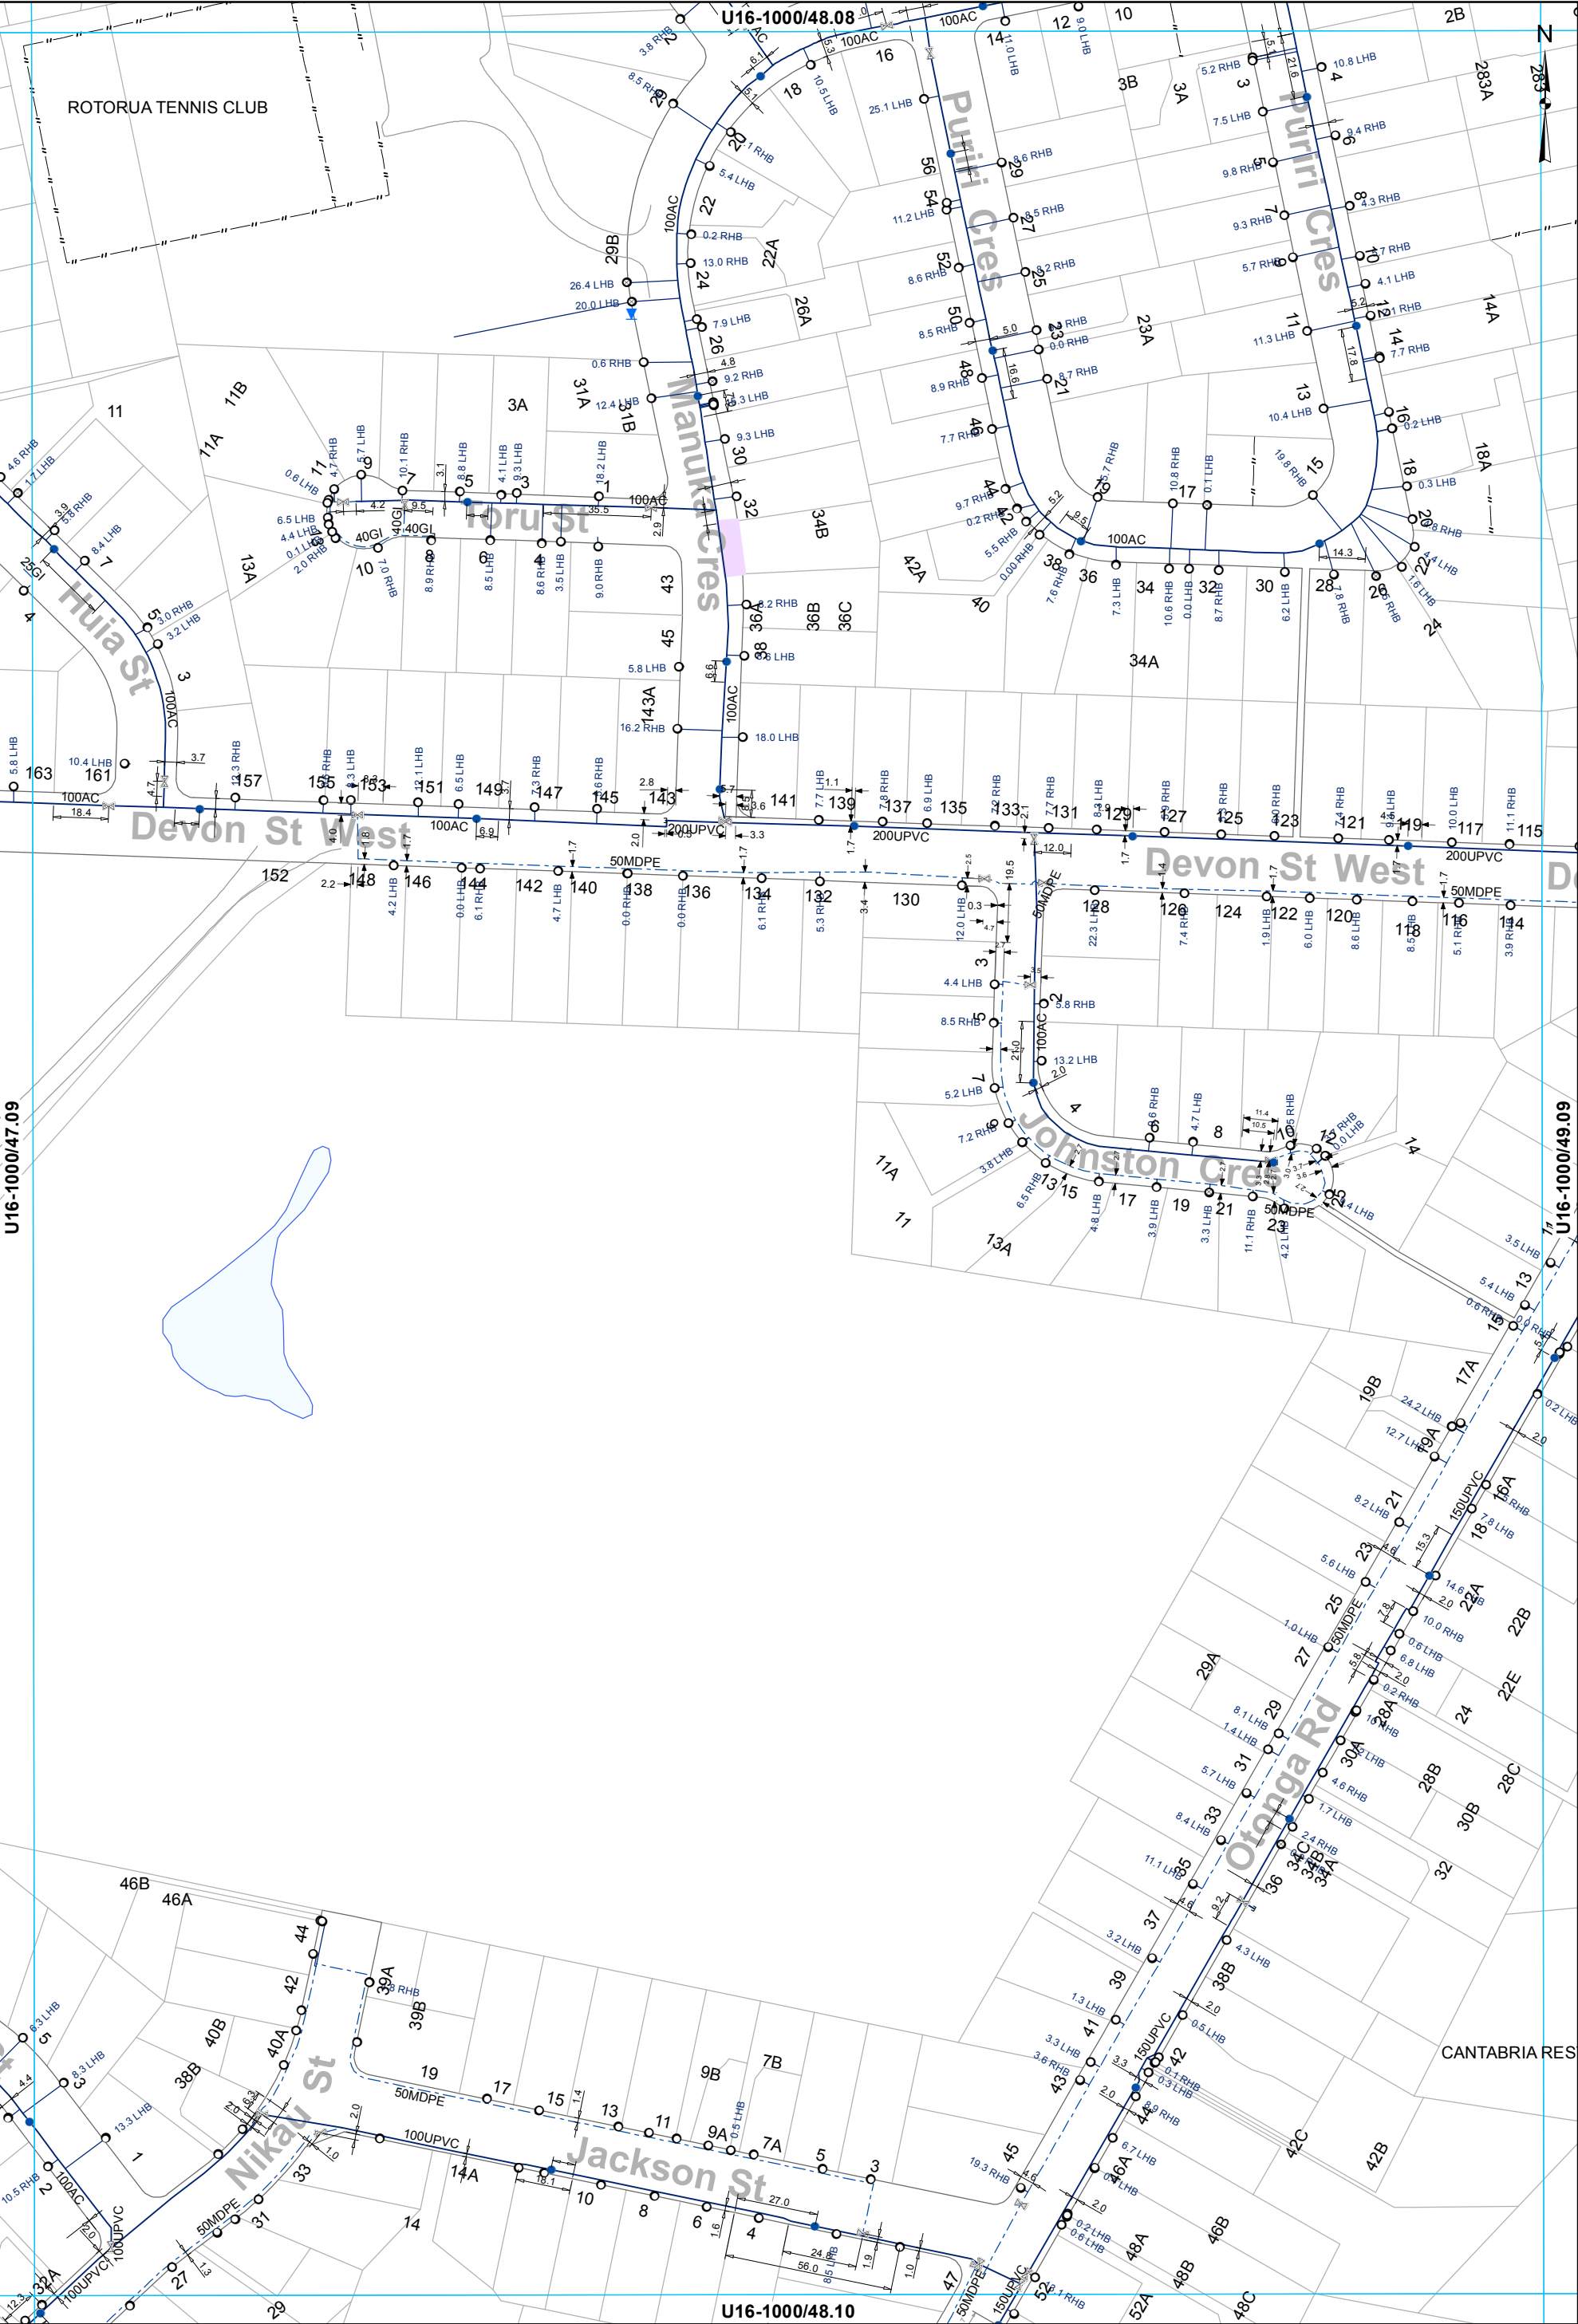

- Valve
- Hydrant
- Meter Consumer
- WSServiceLine
- Toby
- Capped End
- Main
- Rider main

WATER SUPPLY SERVICES
1:2000 @ A3 - (U16-1000/48.09)

This data is derived from sources outside the control of Rotorua District Council and is for information only

Rotorua District Council 2006. Facsimile 07 346 3143 Telephone 07 348 4199 email mail@rdc.govt.nz




Rotorua District Council 2006. Facsimile 07 346 3143 Telephone 07 348 4199 email mail@rdc.govt.nz

All dimensions and levels should be verified by physical location on-site.

This data is derived from sources outside the control of Rotorua District Council and is for information only

- | | | | |
|----------------|--------------|------------------|-----------------|
| ⌘ Valve | ● Hydrant | ⊙ Meter Consumer | — WSServiceLine |
| ○ Toby | ⊙ Capped End | — Main | |
| ⌘ Closed Valve | | — Rider main | |

WATER SUPPLY SERVICES
1:2000 @ A3 - (U16-1000/49.09)

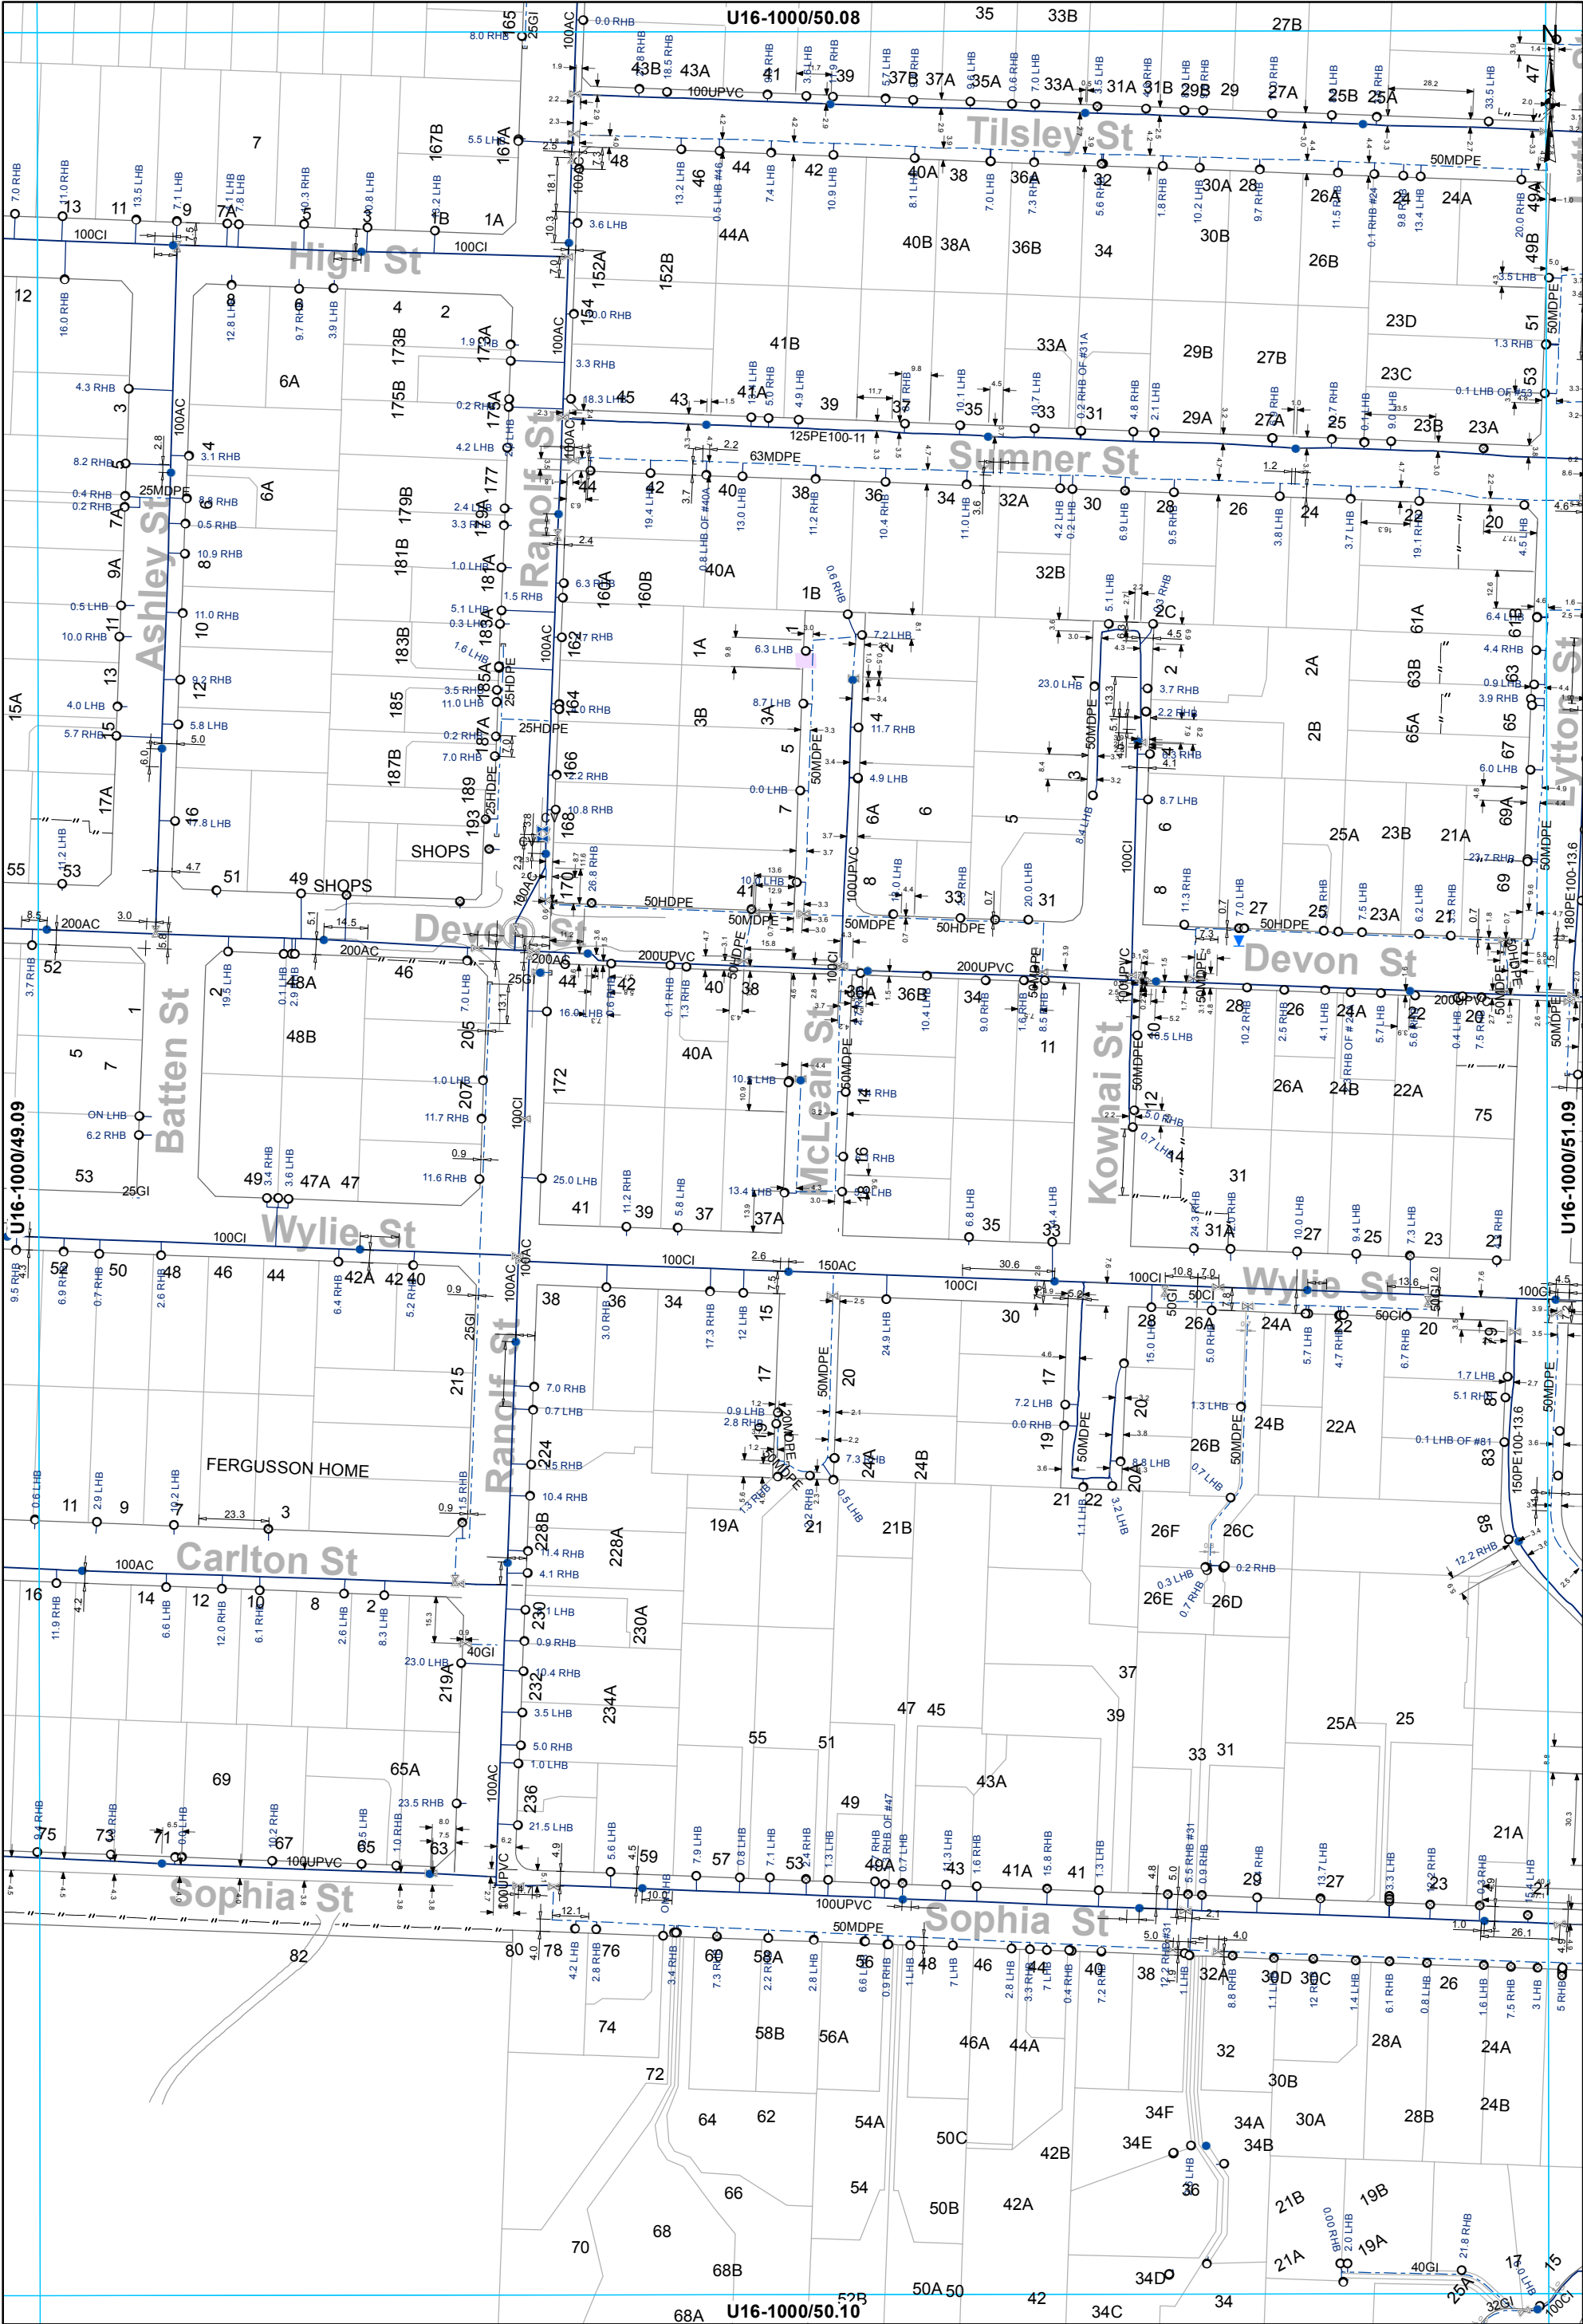

- Valve

Hydrant

Meter Consumer


WSServiceLine
- Toby

Capped End

Main

Rider main
- Closed Valve

WATER SUPPLY SERVICES
1:2000 @ A3 - (U16-1000/50.09)

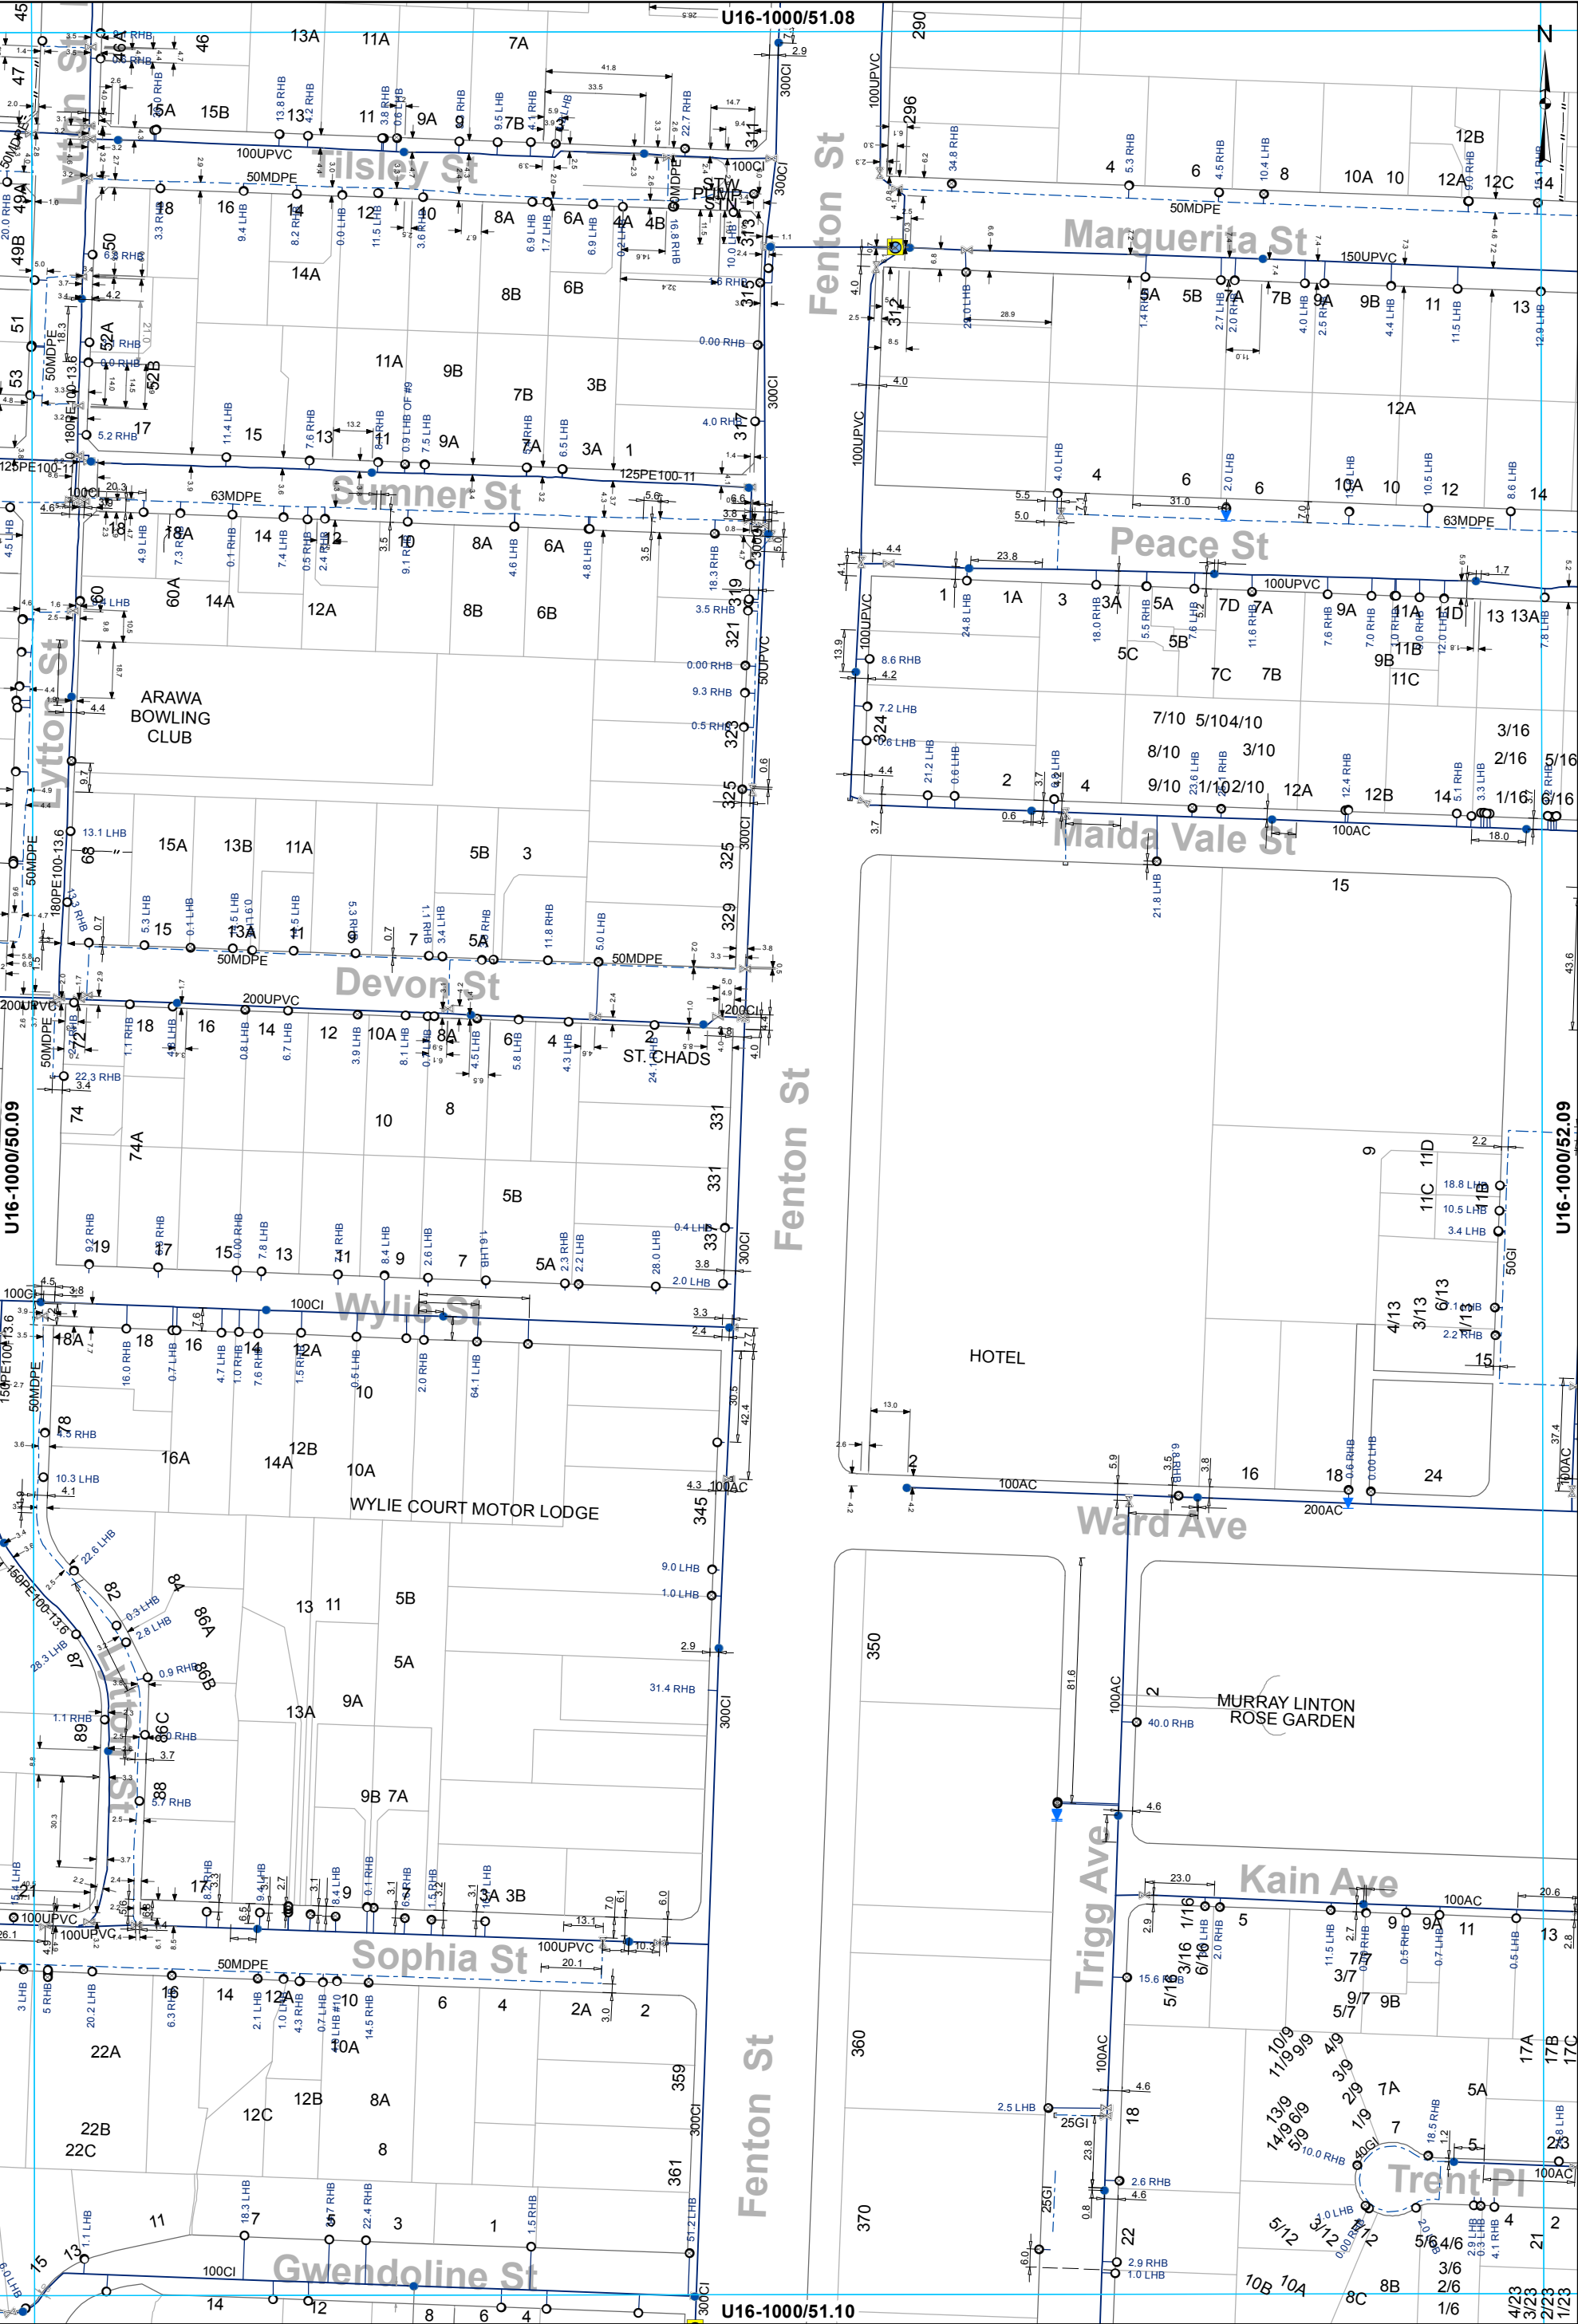

- Valve

Toby

Hydrant

Meter Bulk

Meter Consumer

Capped End

Miscellaneous

WSServiceLine

Main

Rider main
- WATER SUPPLY SERVICES**
1:2000 @ A3 - (U16-1000/51.09)
- This data is derived from sources outside the control of Rotorua District Council and is for information only
- All dimensions and levels should be verified by physical location on-site.
- Rotorua District Council 2006. Facsimile 07 346 3143 Telephone 07 348 4199 email mail@rdc.govt.nz



- X Valve

• Hydrant

⊗ Meter Consumer

— WSServiceLine
- Toby

⊢ Capped End

— Main


- - - Rider main


WATER SUPPLY SERVICES
1:2000 @ A3 - (U16-1000/52.09)

This data is derived from sources outside the control of Rotorua District Council and is for information only

All dimensions and levels should be verified by physical location on-site.

Rotorua District Council 2006. Facsimile 07 346 3143 Telephone 07 348 4199 email mail@rdc.govt.nz

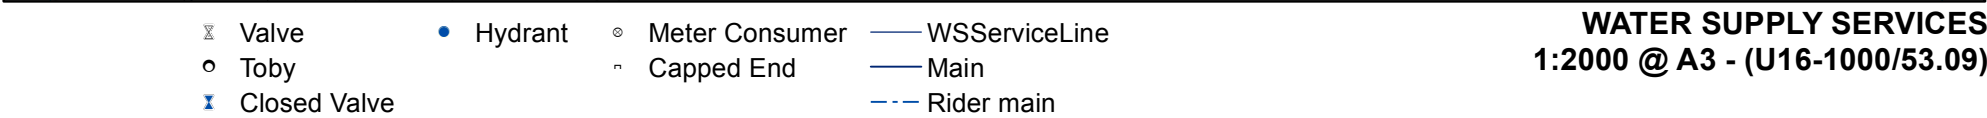

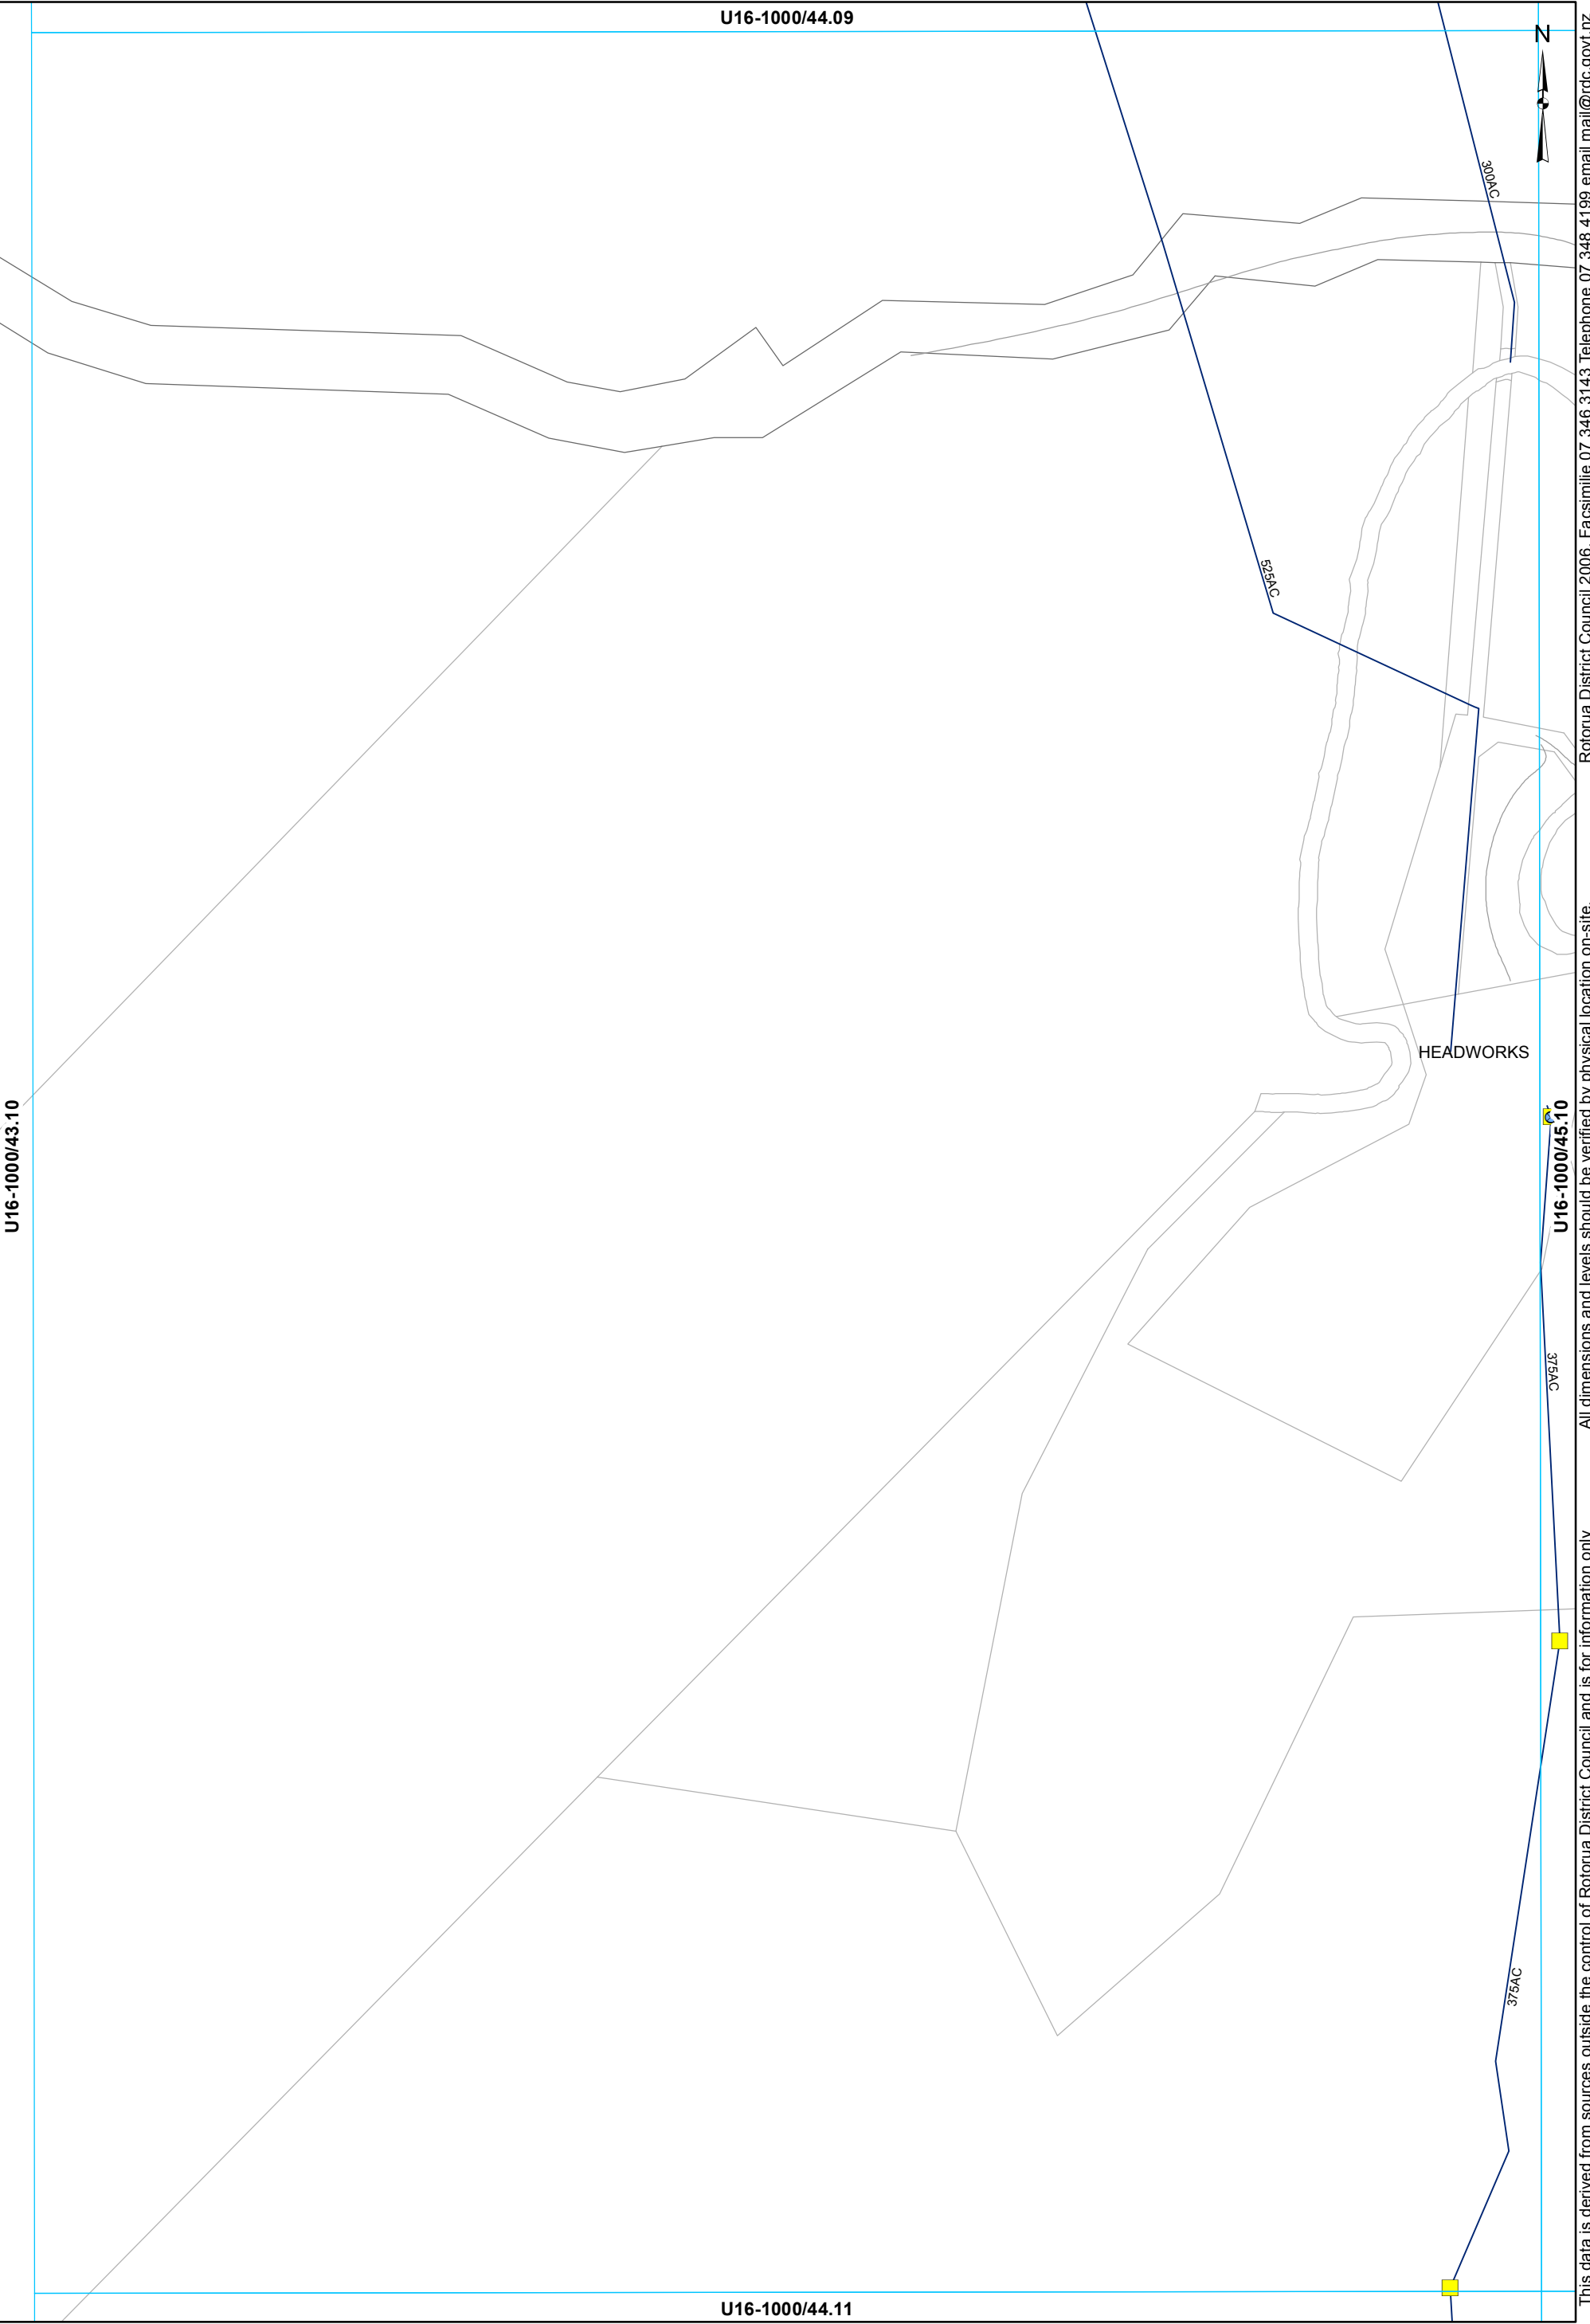


- Valve
- Meter Bulk
- Miscellaneous
- Closed Valve
- Main

WATER SUPPLY SERVICES
1:2000 @ A3 - (U16-1000/44.10)

This data is derived from sources outside the control of Rotorua District Council and is for information only. All dimensions and levels should be verified by physical location on-site. Rotorua District Council 2006. Facsimile 07 346 3143 Telephone 07 348 4199 email mail@rdc.govt.nz



WATER SUPPLY SERVICES
1:2000 @ A3 - (U16-1000/45.10)

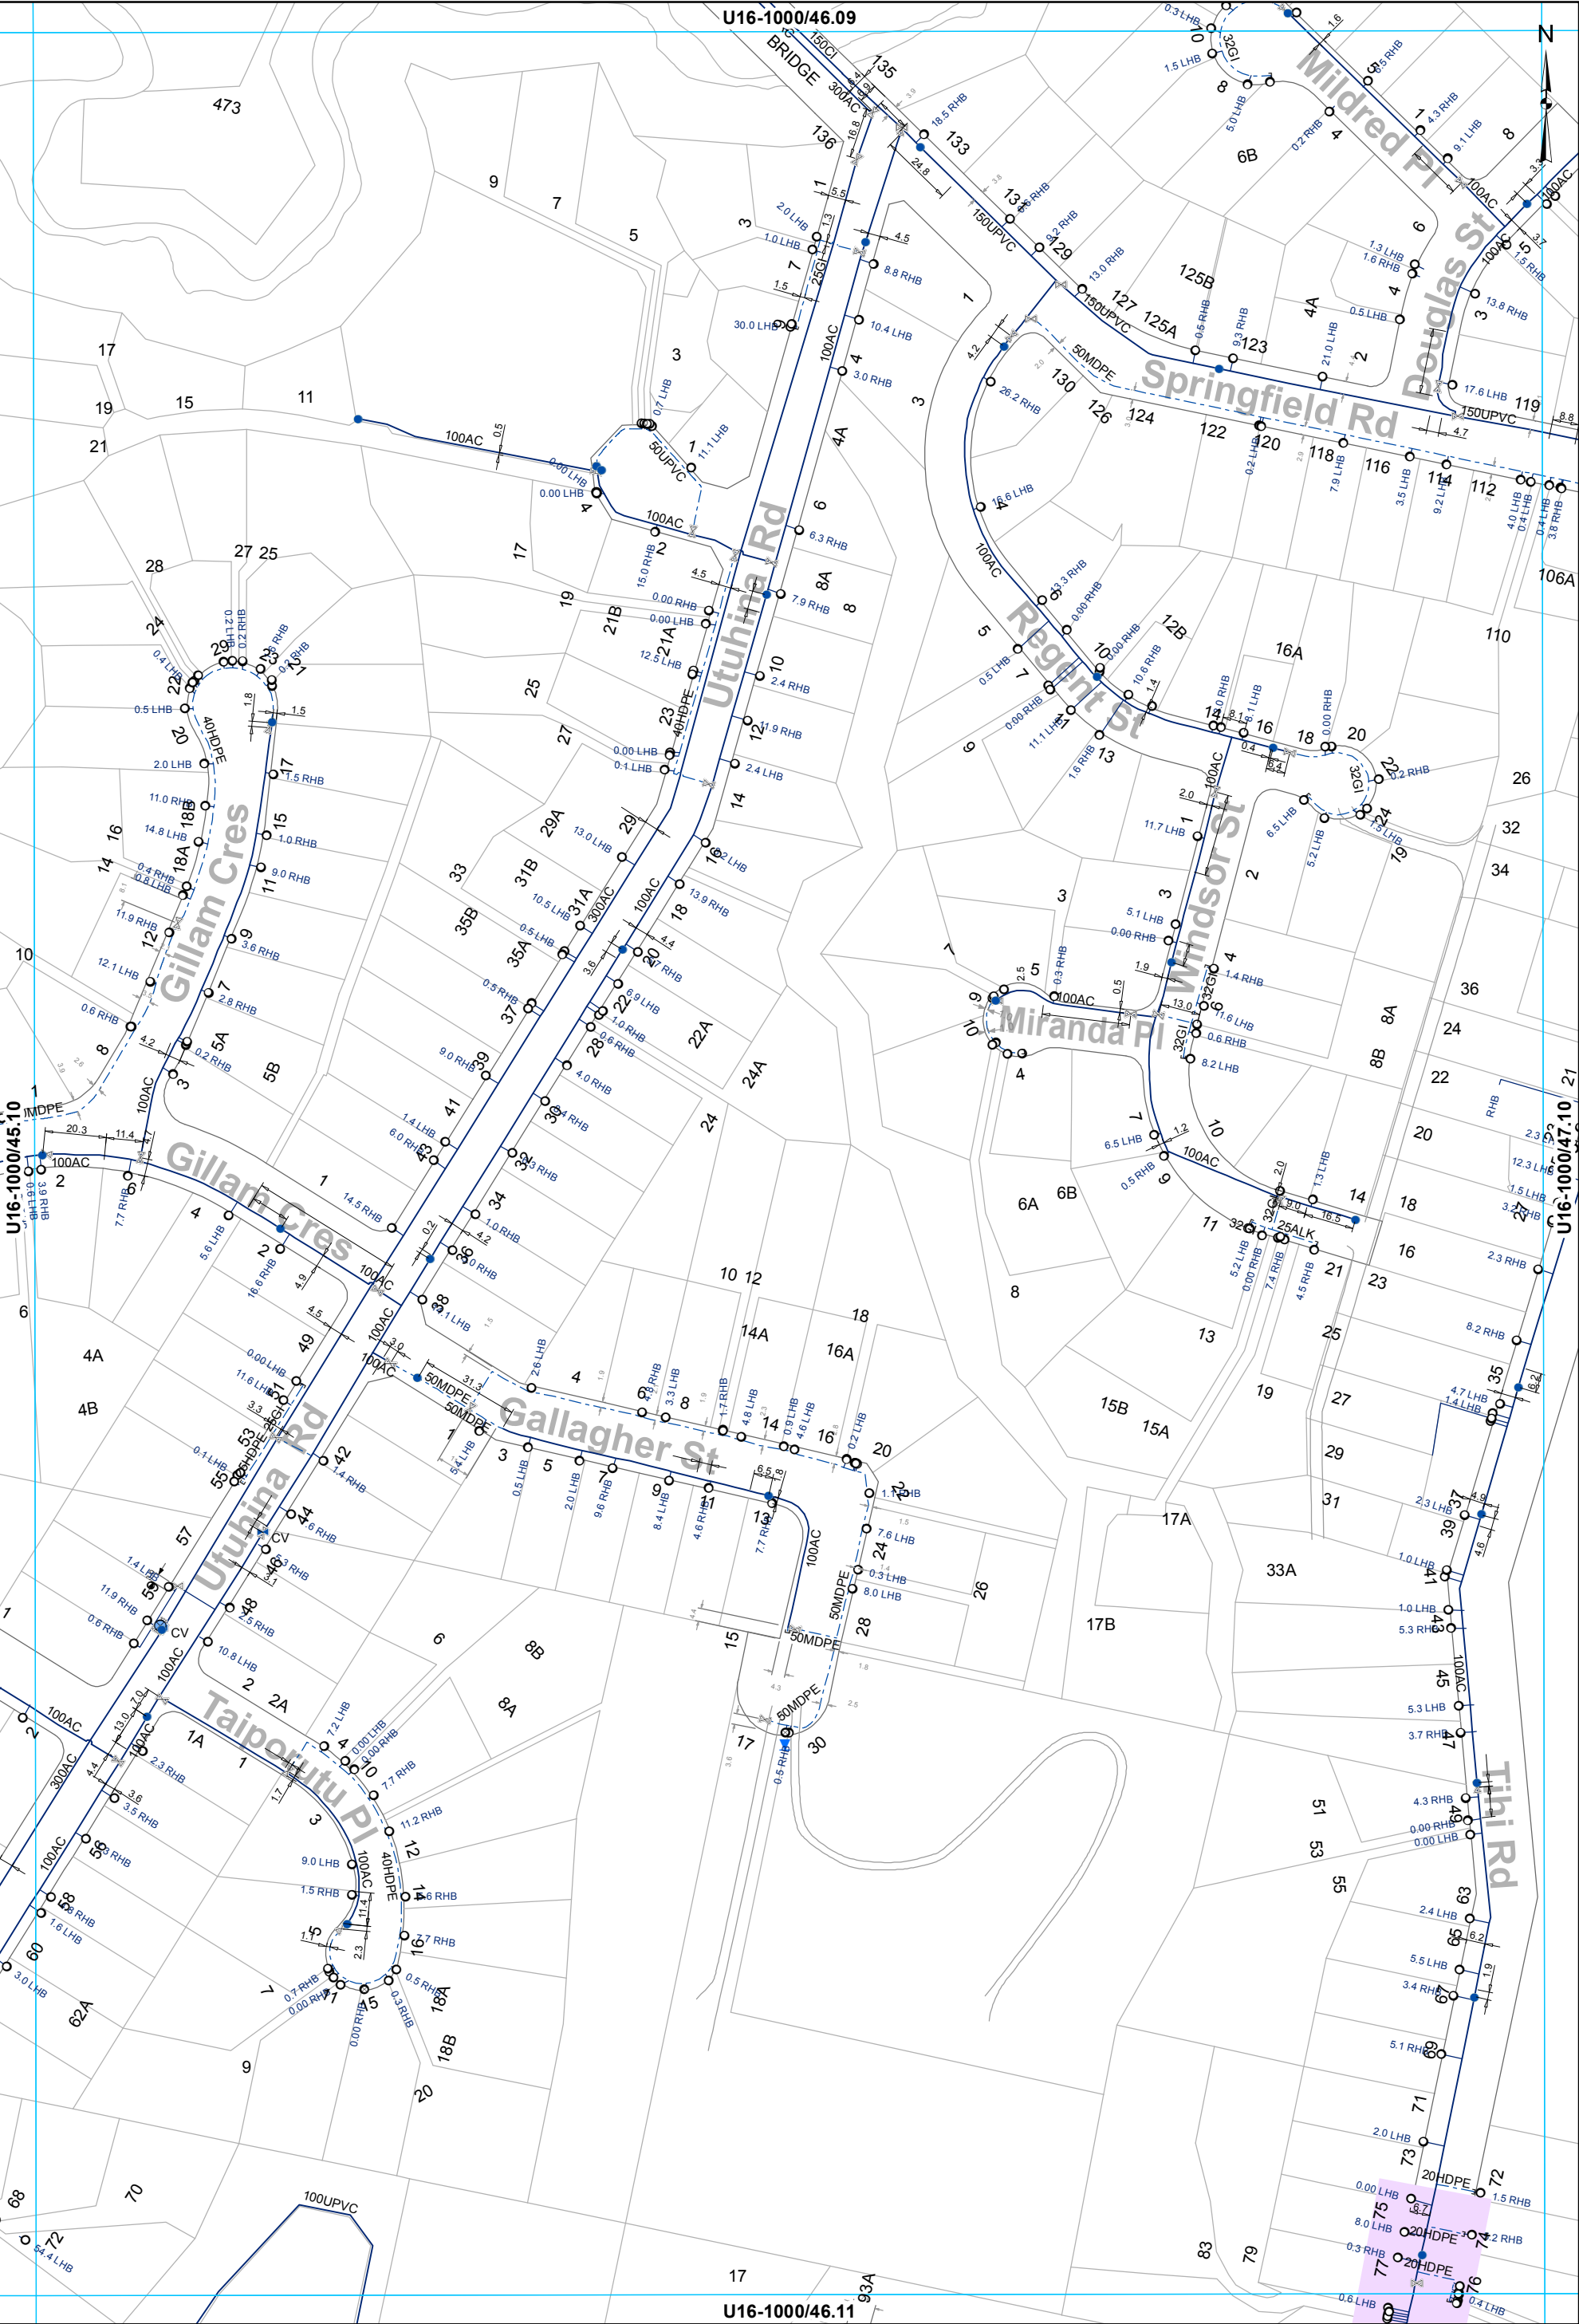


- | | | | |
|----------------|-----------|------------------|------------------|
| ⌵ Valve | ● Hydrant | ⊙ Meter Bulk | — WSServiceLine |
| ○ Toby | | ⊙ Meter Consumer | — Main |
| ⌵ Closed Valve | | ⌵ Capped End | - - - Rider main |

WATER SUPPLY SERVICES
1:2000 @ A3 - (U16-1000/46.10)

This data is derived from sources outside the control of Rotorua District Council and is for information only

All dimensions and levels should be verified by physical location on-site.

Rotorua District Council 2006. Facsimile 07 346 3143 Telephone 07 348 4199 email mail@rdc.govt.nz

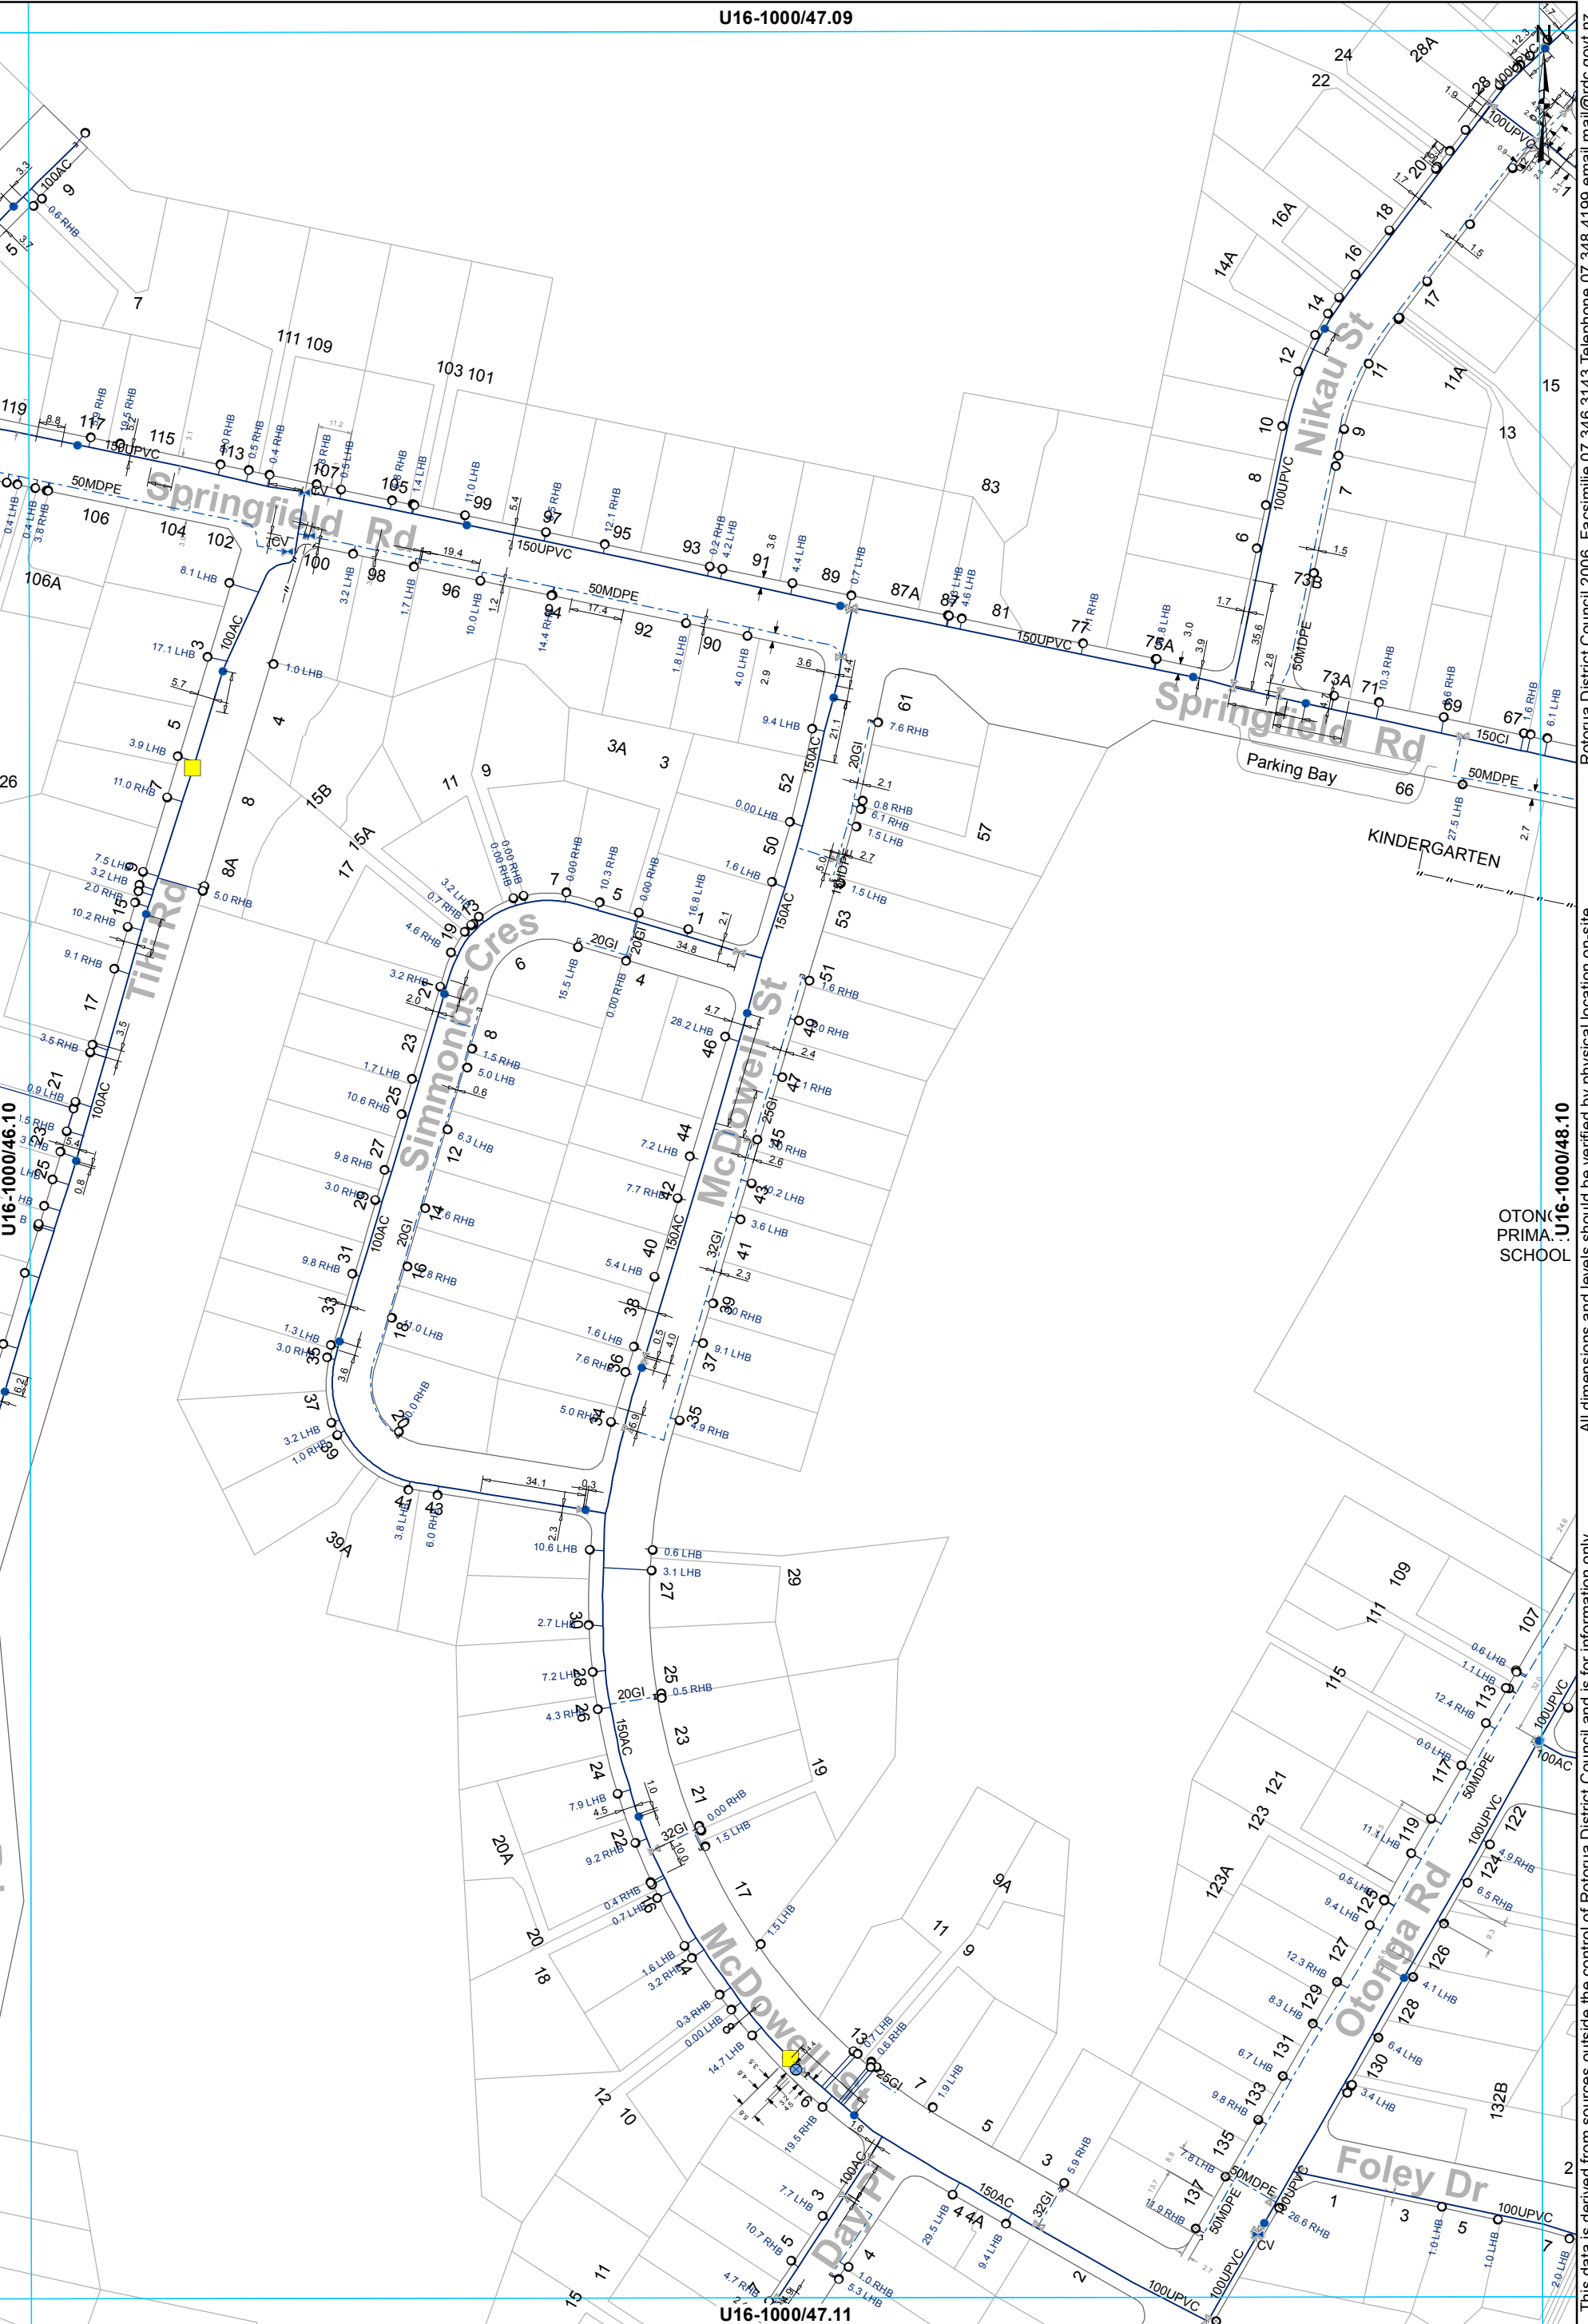

- | | | | | |
|----------------|-----------|------------------|-----------------|------------------|
| ⌘ Valve | ● Hydrant | ⊗ Meter Bulk | ■ Miscellaneous | — WSServiceLine |
| ○ Toby | | ⊙ Meter Consumer | | — Main |
| ⌘ Closed Valve | | ⌘ Capped End | | - - - Rider main |

WATER SUPPLY SERVICES
1:2000 @ A3 - (U16-1000/47.10)


This data is derived from sources outside the control of Rotorua District Council and is for information only

All dimensions and levels should be verified by physical location on-site.

Rotorua District Council 2006. Facsimile 07 346 3143 Telephone 07 348 4199 email mail@rdc.govt.nz



WATER SUPPLY SERVICES
1:2000 @ A3 - (U16-1000/48.10)

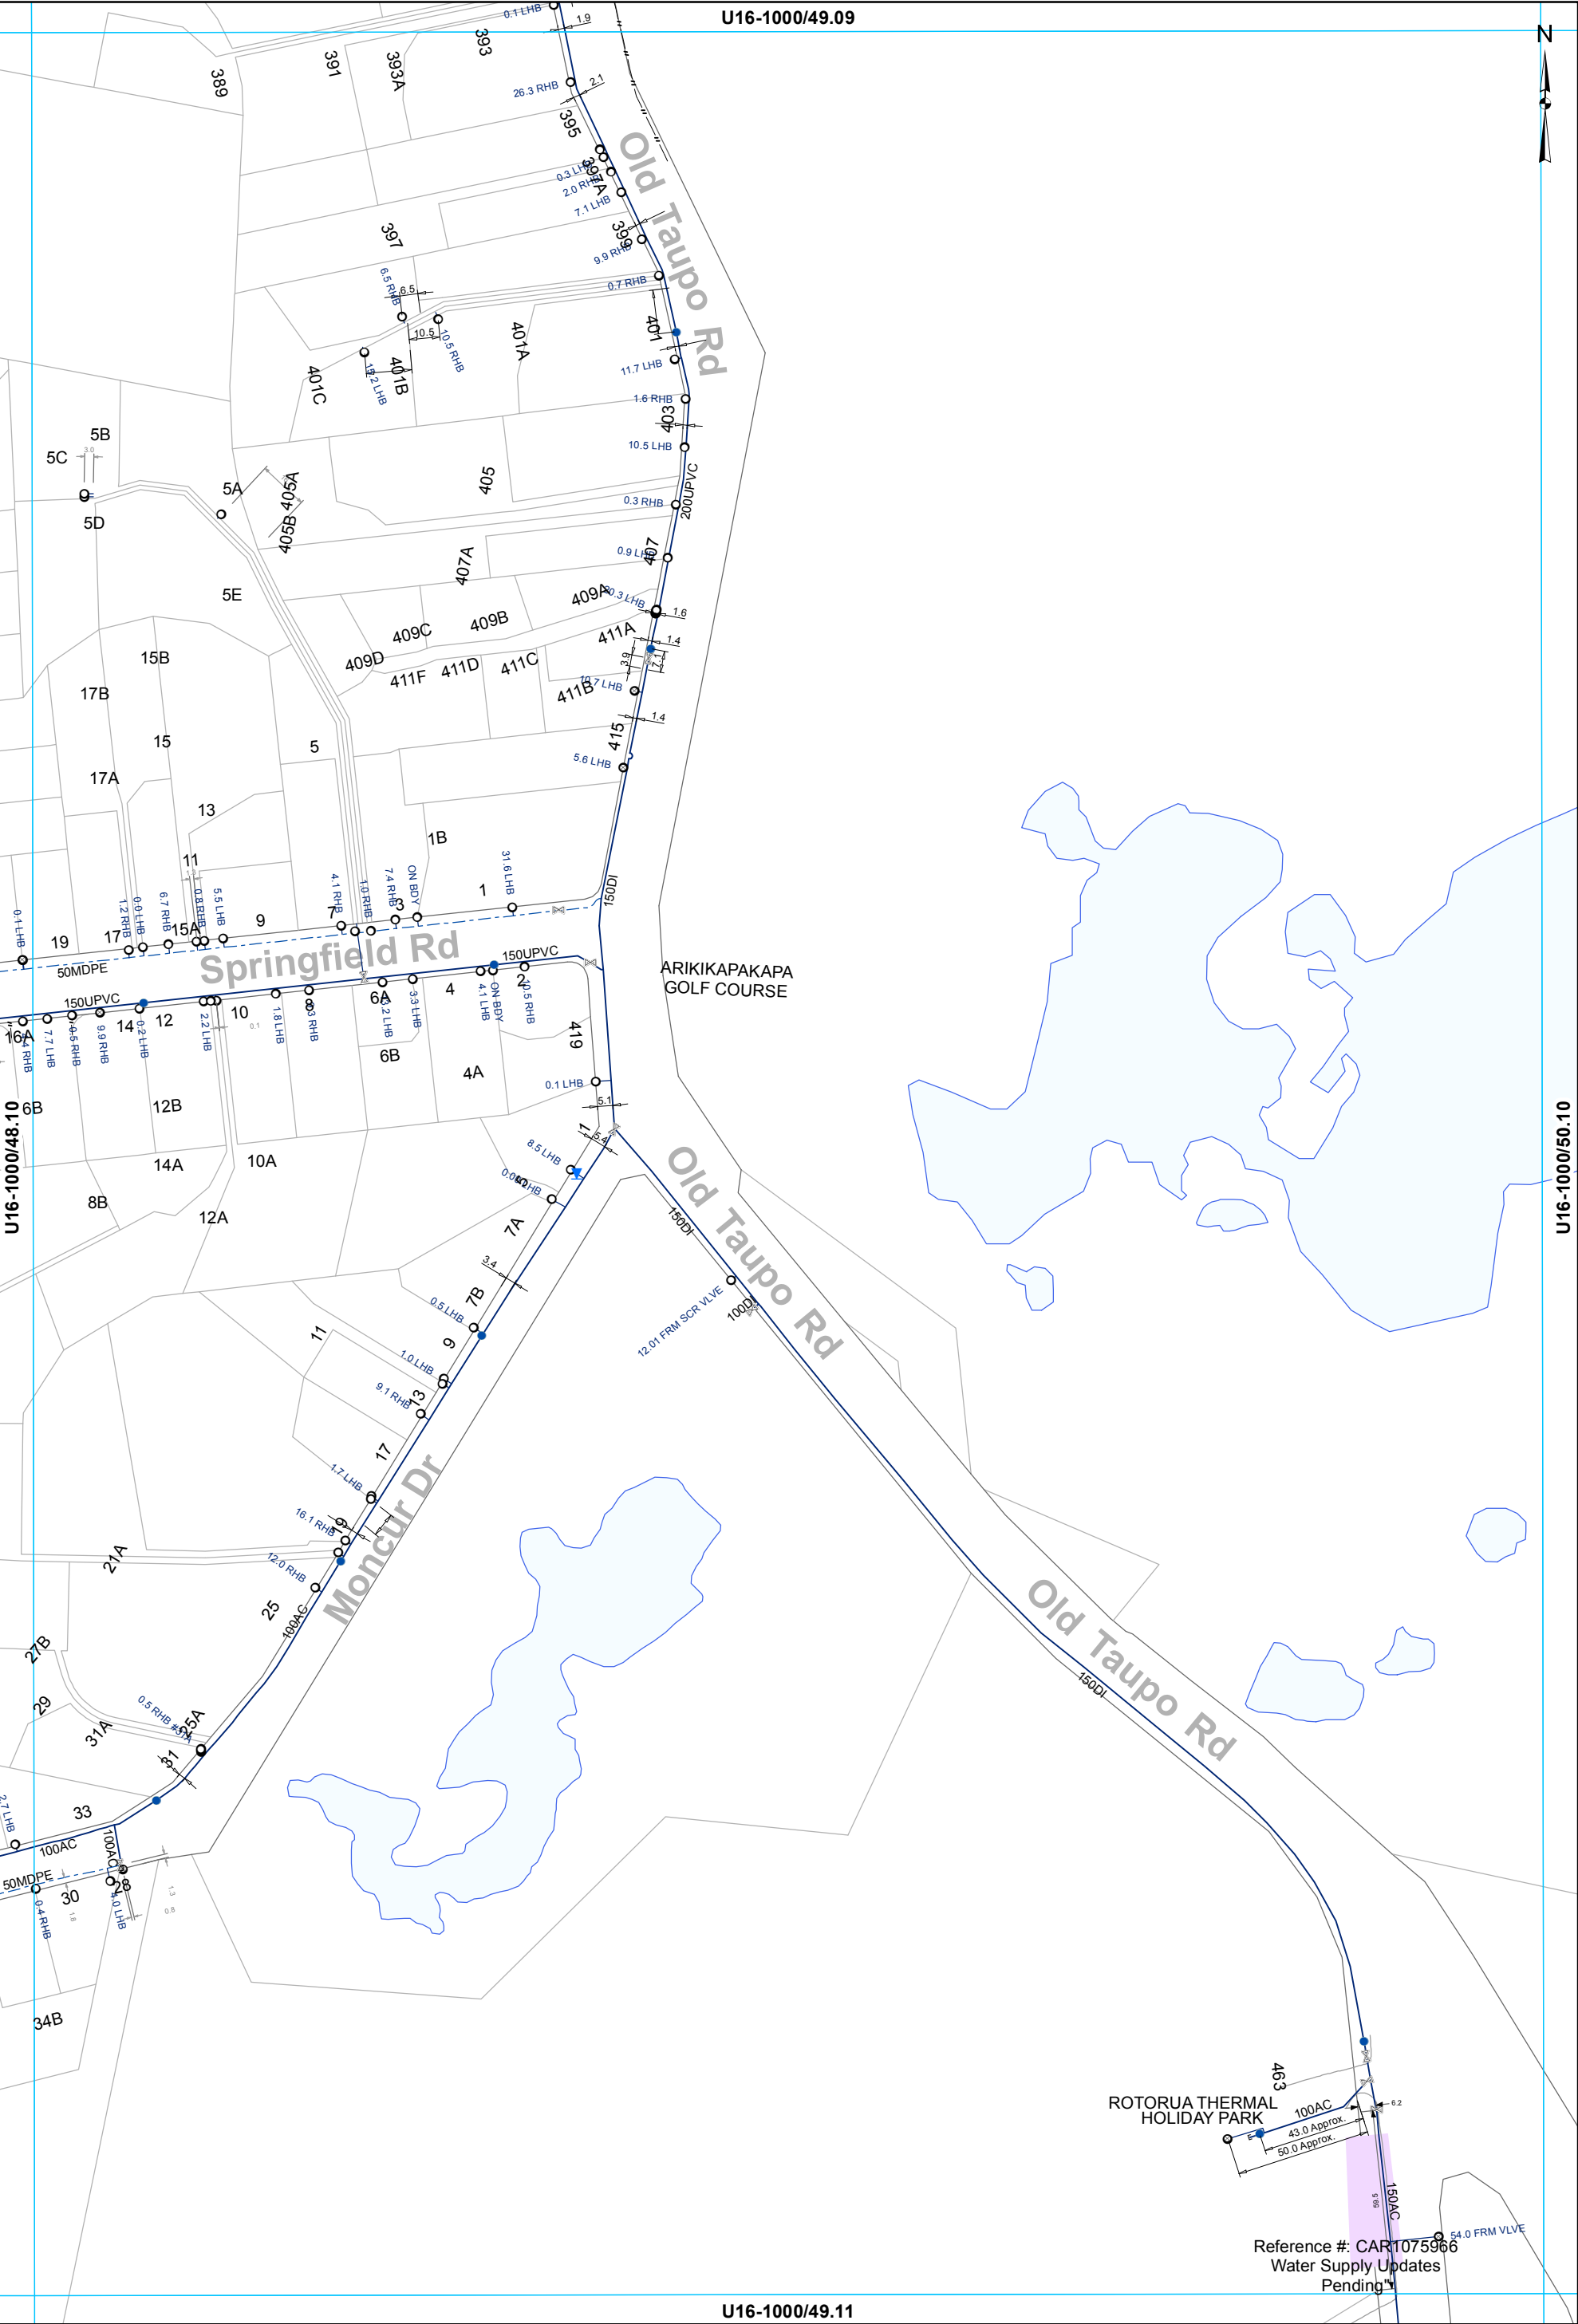


This data is derived from sources outside the control of Rotorua District Council and is for information only

All dimensions and levels should be verified by physical location on-site.

Rotorua District Council 2006. Facsimile 07 346 3143 Telephone 07 348 4199 email mail@rdc.govt.nz

- Valve
- Hydrant
- Meter Consumer
- WSServiceLine
- Toby
- Capped End
- Main
- Rider main

WATER SUPPLY SERVICES
1:2000 @ A3 - (U16-1000/49.10)

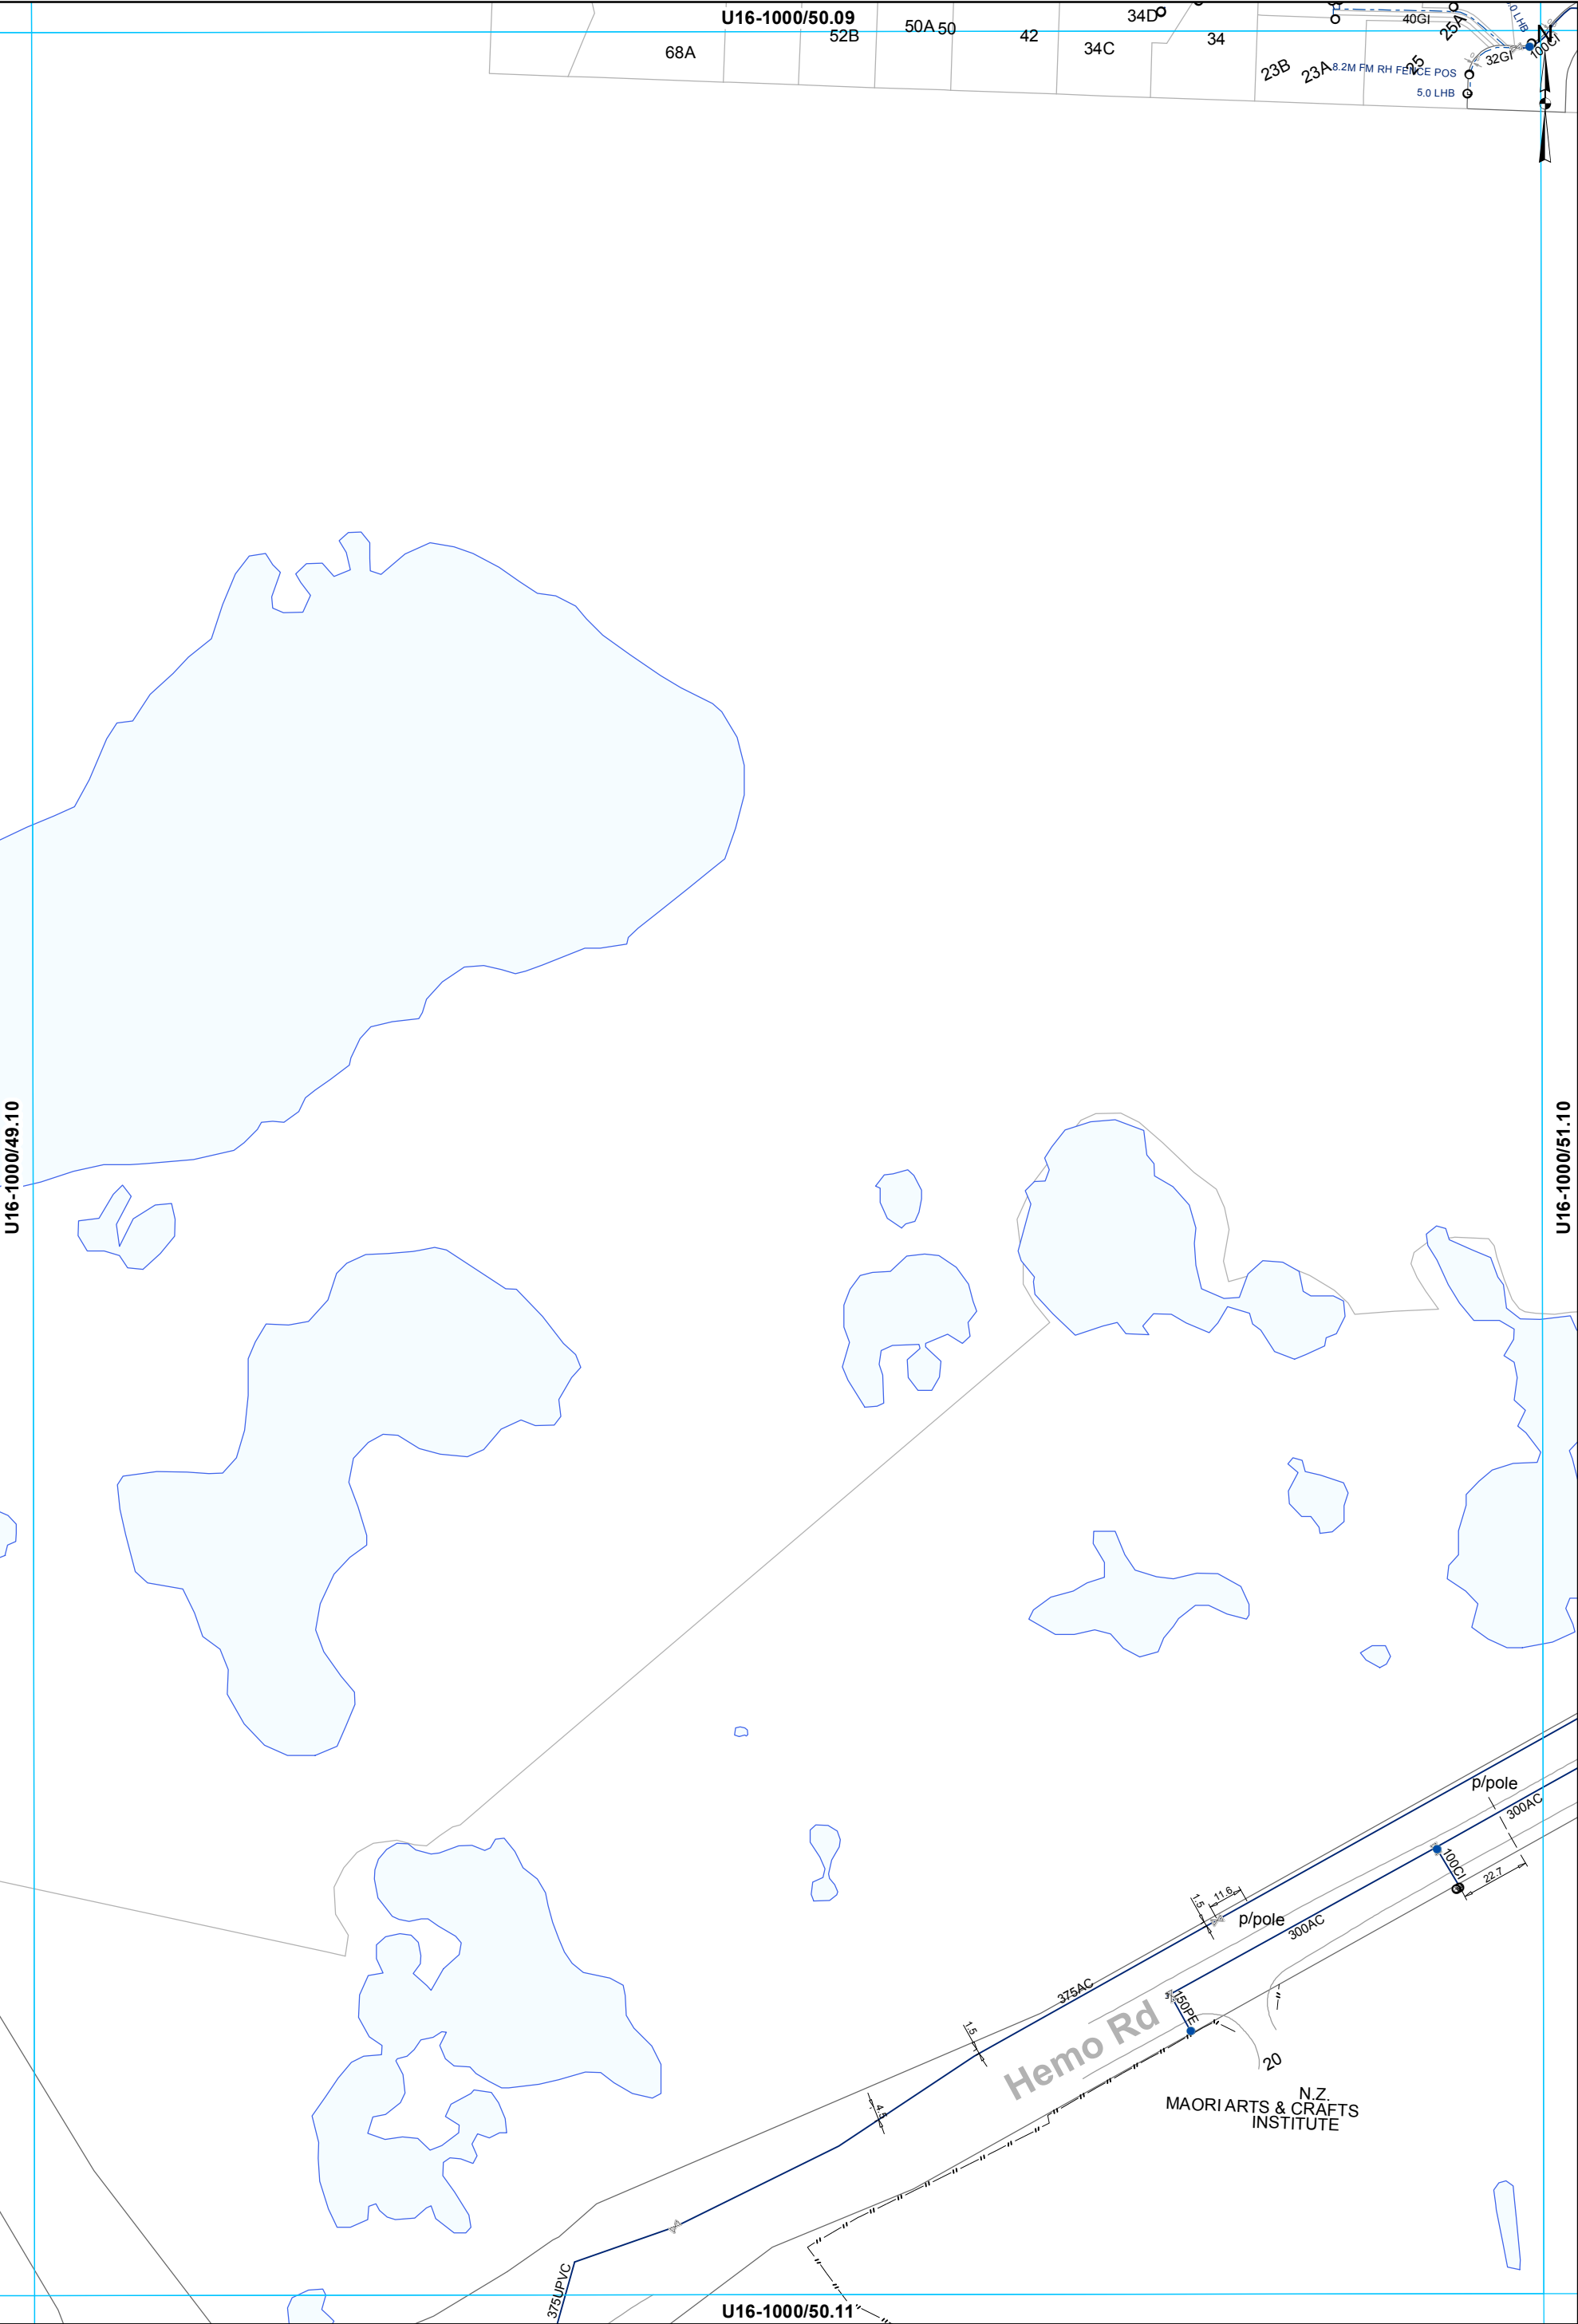

U16-1000/49.10

U16-1000/51.10

U16-1000/50.11


- | | | | |
|---------|-----------|------------------|------------------|
| ⌵ Valve | ● Hydrant | ⊙ Meter Consumer | — WSServiceLine |
| ○ Toby | | ⌒ Capped End | — Main |
| | | | - - - Rider main |

WATER SUPPLY SERVICES
1:2000 @ A3 - (U16-1000/50.10)

This data is derived from sources outside the control of Rotorua District Council and is for information only

All dimensions and levels should be verified by physical location on-site.

Rotorua District Council 2006. Facsimile 07 346 3143 Telephone 07 348 4199 email mail@rdc.govt.nz

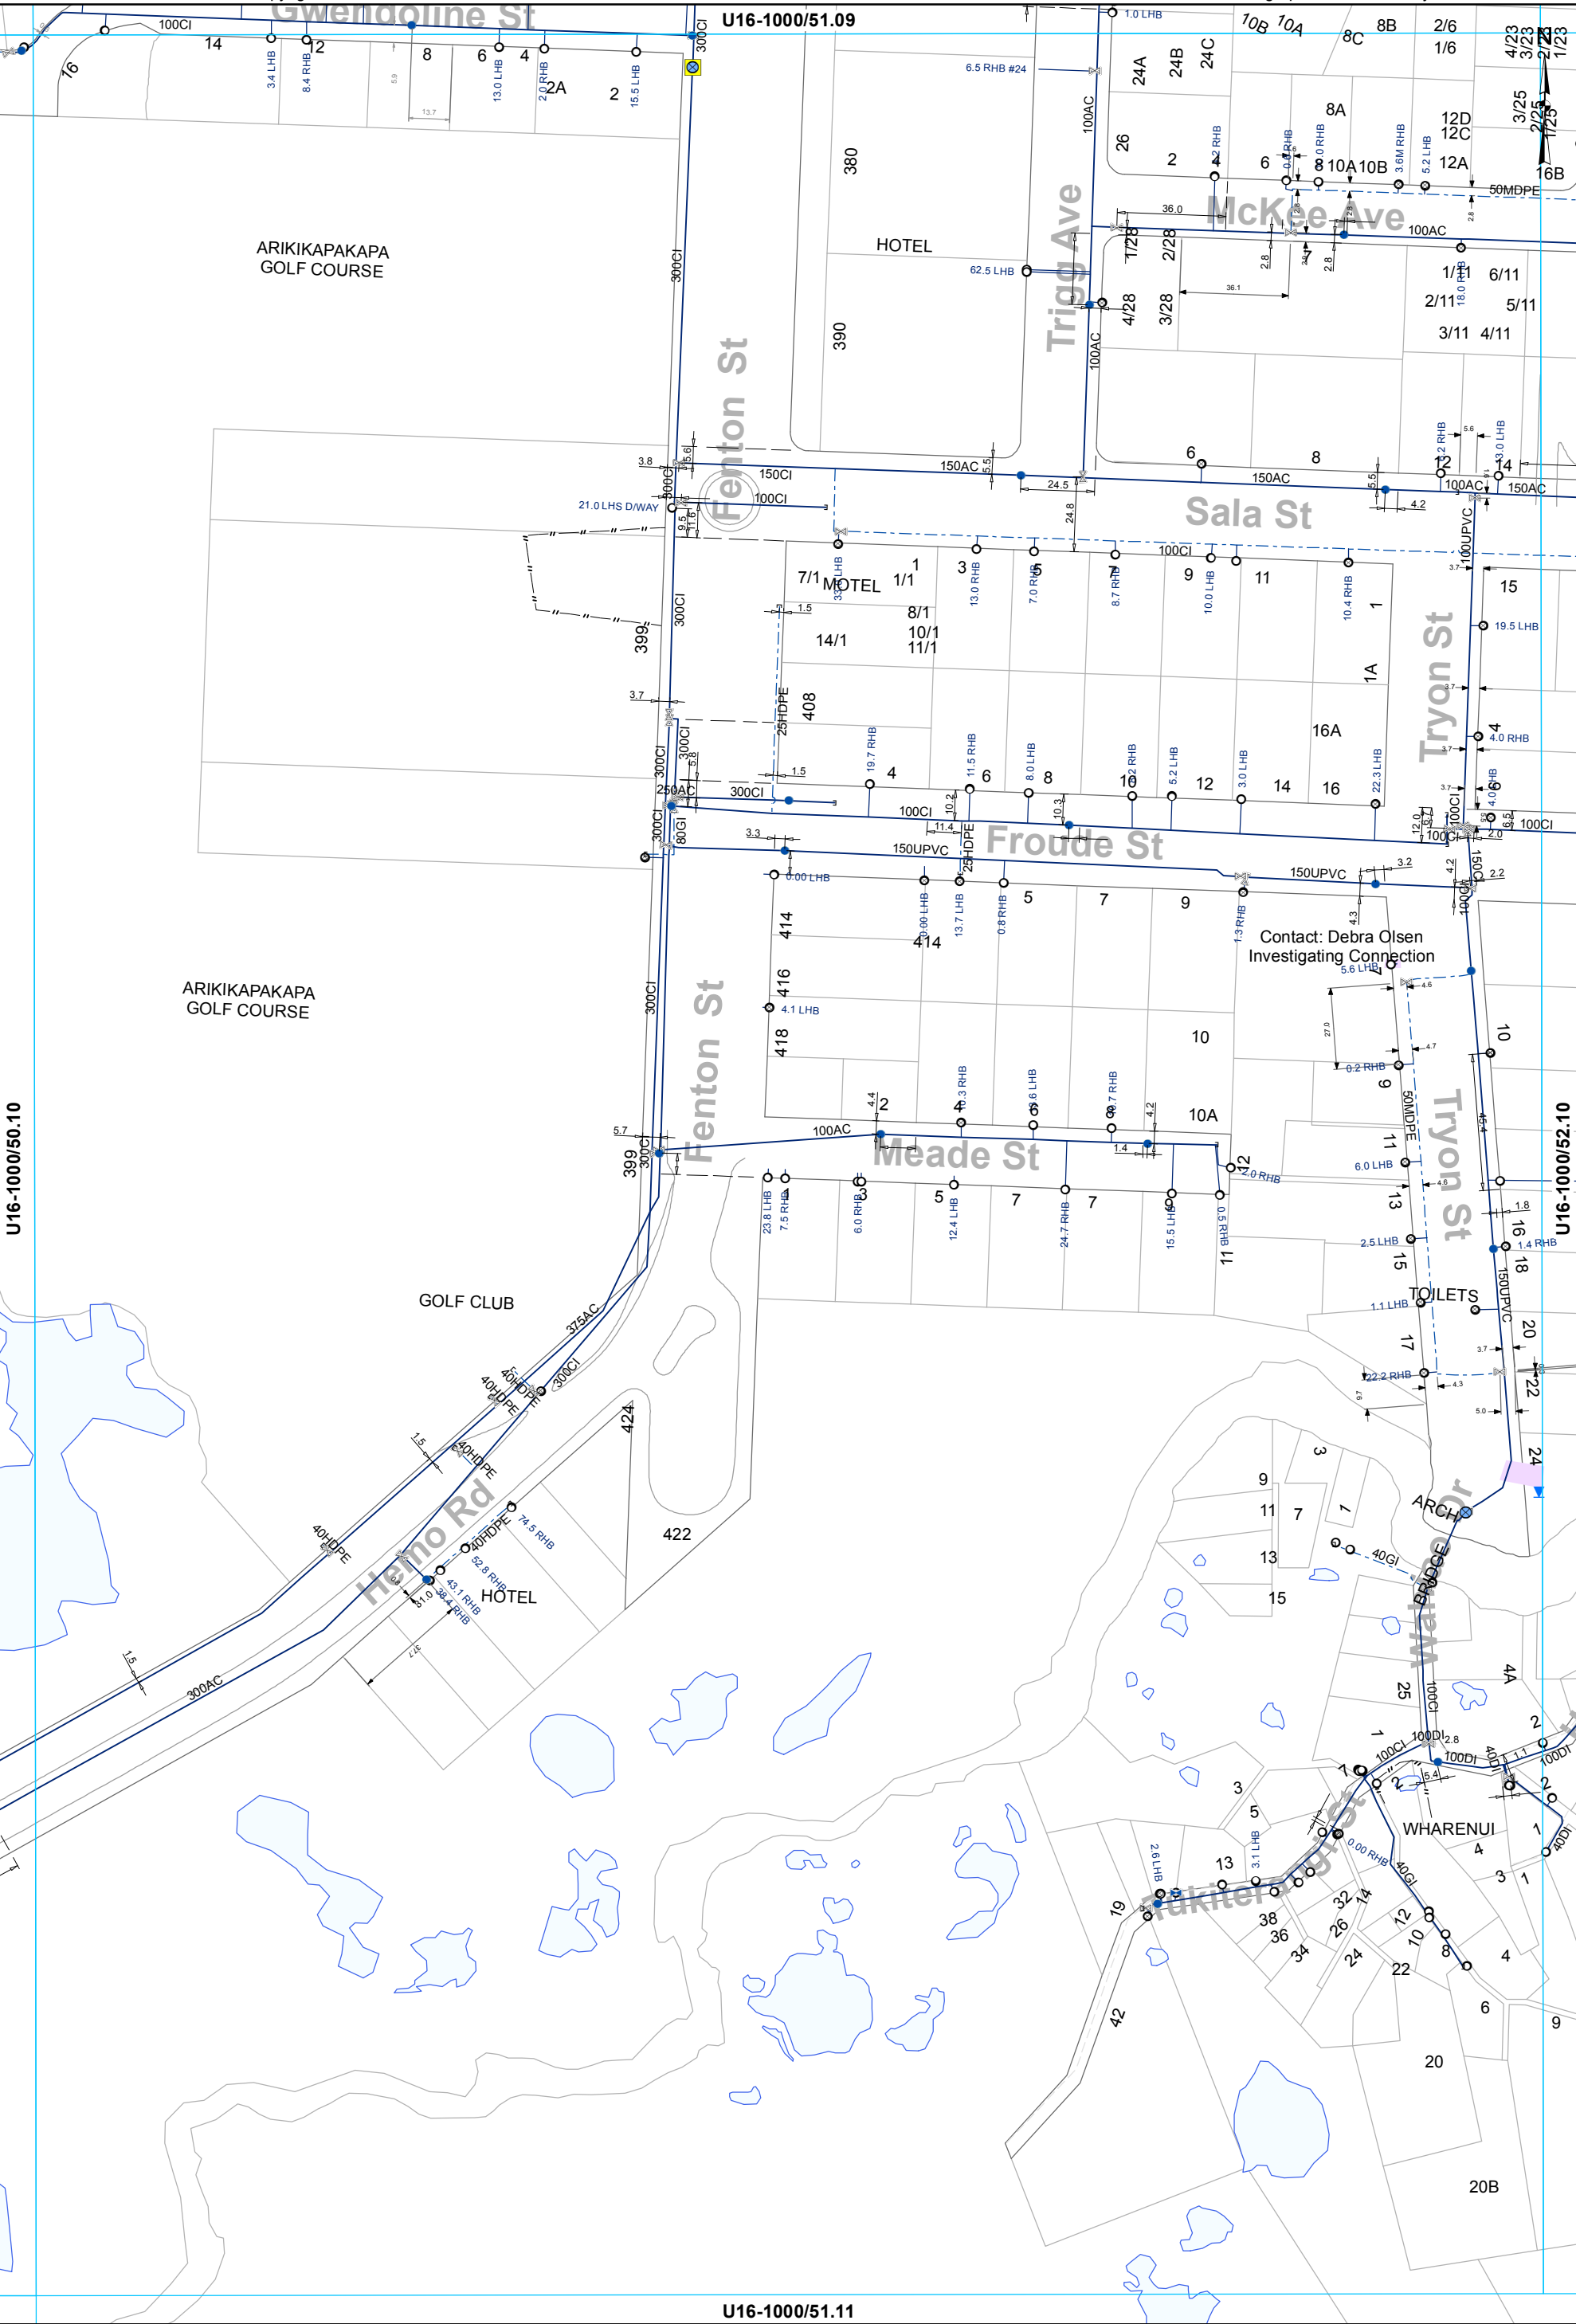


- | | | | | |
|----------------|-----------|------------------|-----------------|------------------|
| ⊗ Valve | ● Hydrant | ⊗ Meter Bulk | ■ Miscellaneous | — WSServiceLine |
| ○ Toby | | ○ Meter Consumer | | — Main |
| ⊗ Closed Valve | | ⌒ Capped End | | - - - Rider main |

WATER SUPPLY SERVICES
1:2000 @ A3 - (U16-1000/51.10)

This data is derived from sources outside the control of Rotorua District Council and is for information only


All dimensions and levels should be verified by physical location on-site.

Rotorua District Council 2006. Facsimile 07 346 3143 Telephone 07 348 4199 email mail@rdc.govt.nz

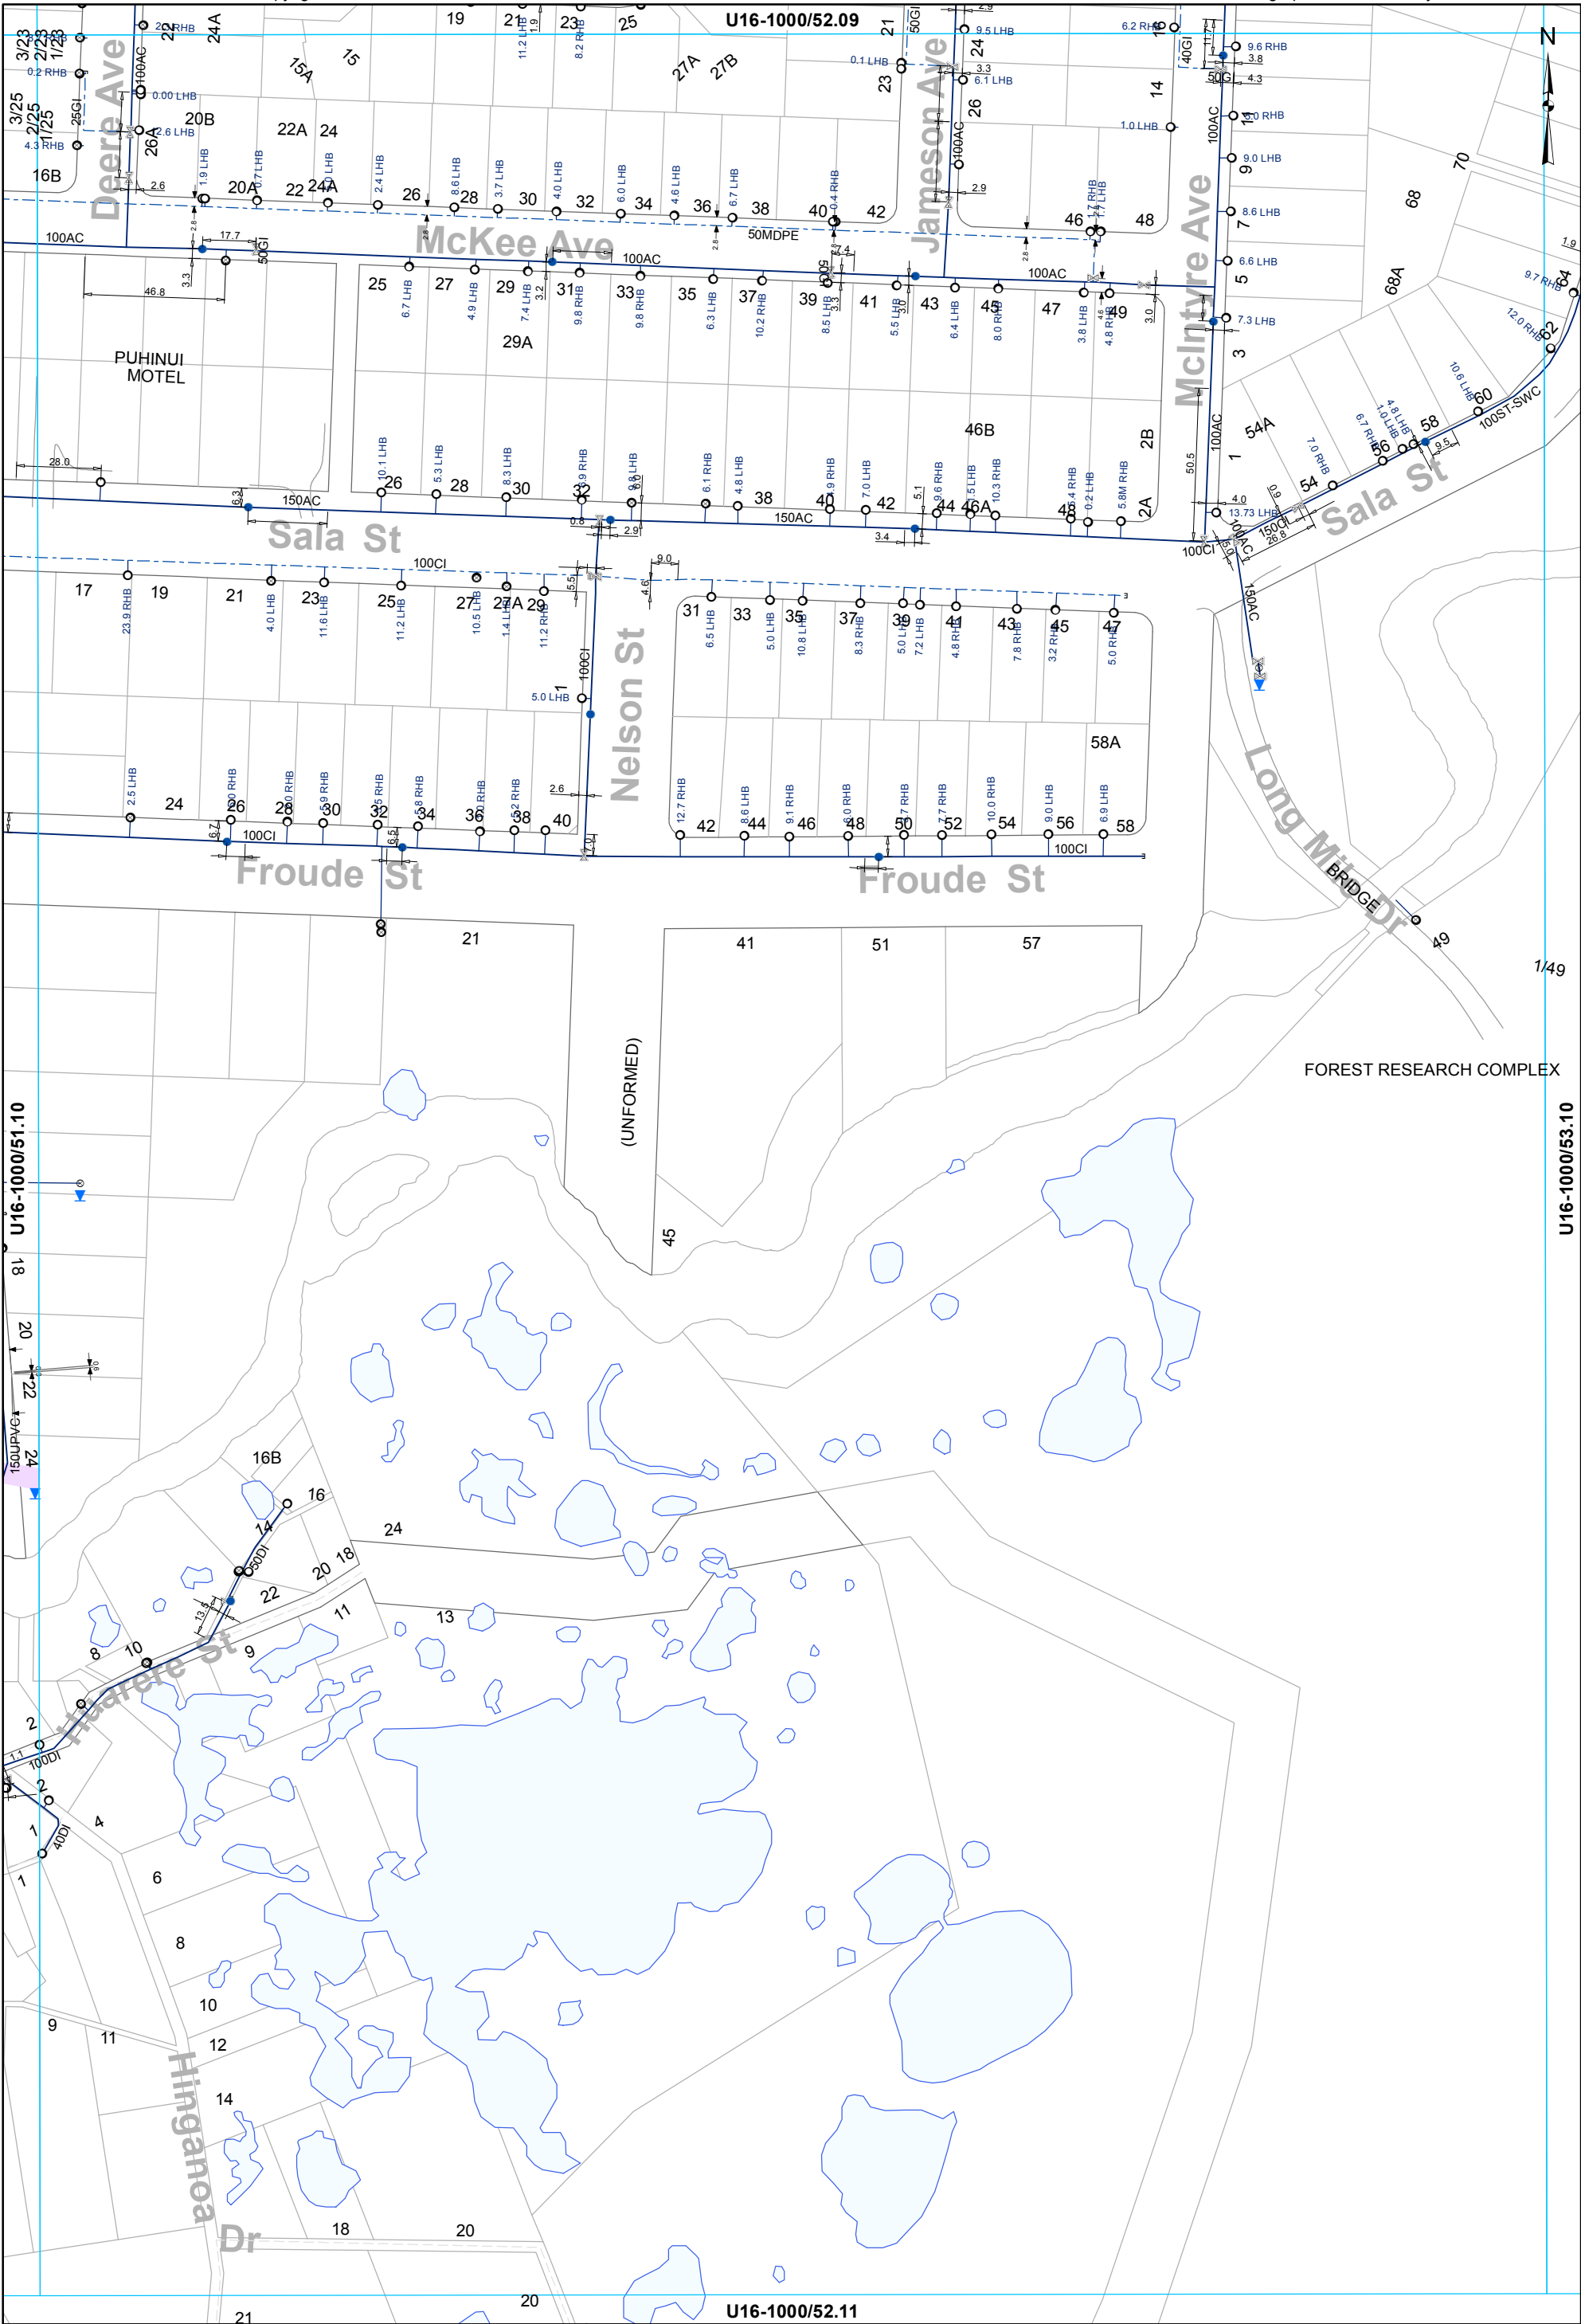


- X Valve
- Hydrant
- Meter Consumer
- WSServiceLine
- Toby
- ⌢ Capped End
- Main
- - - Rider main

WATER SUPPLY SERVICES
1:2000 @ A3 - (U16-1000/52.10)

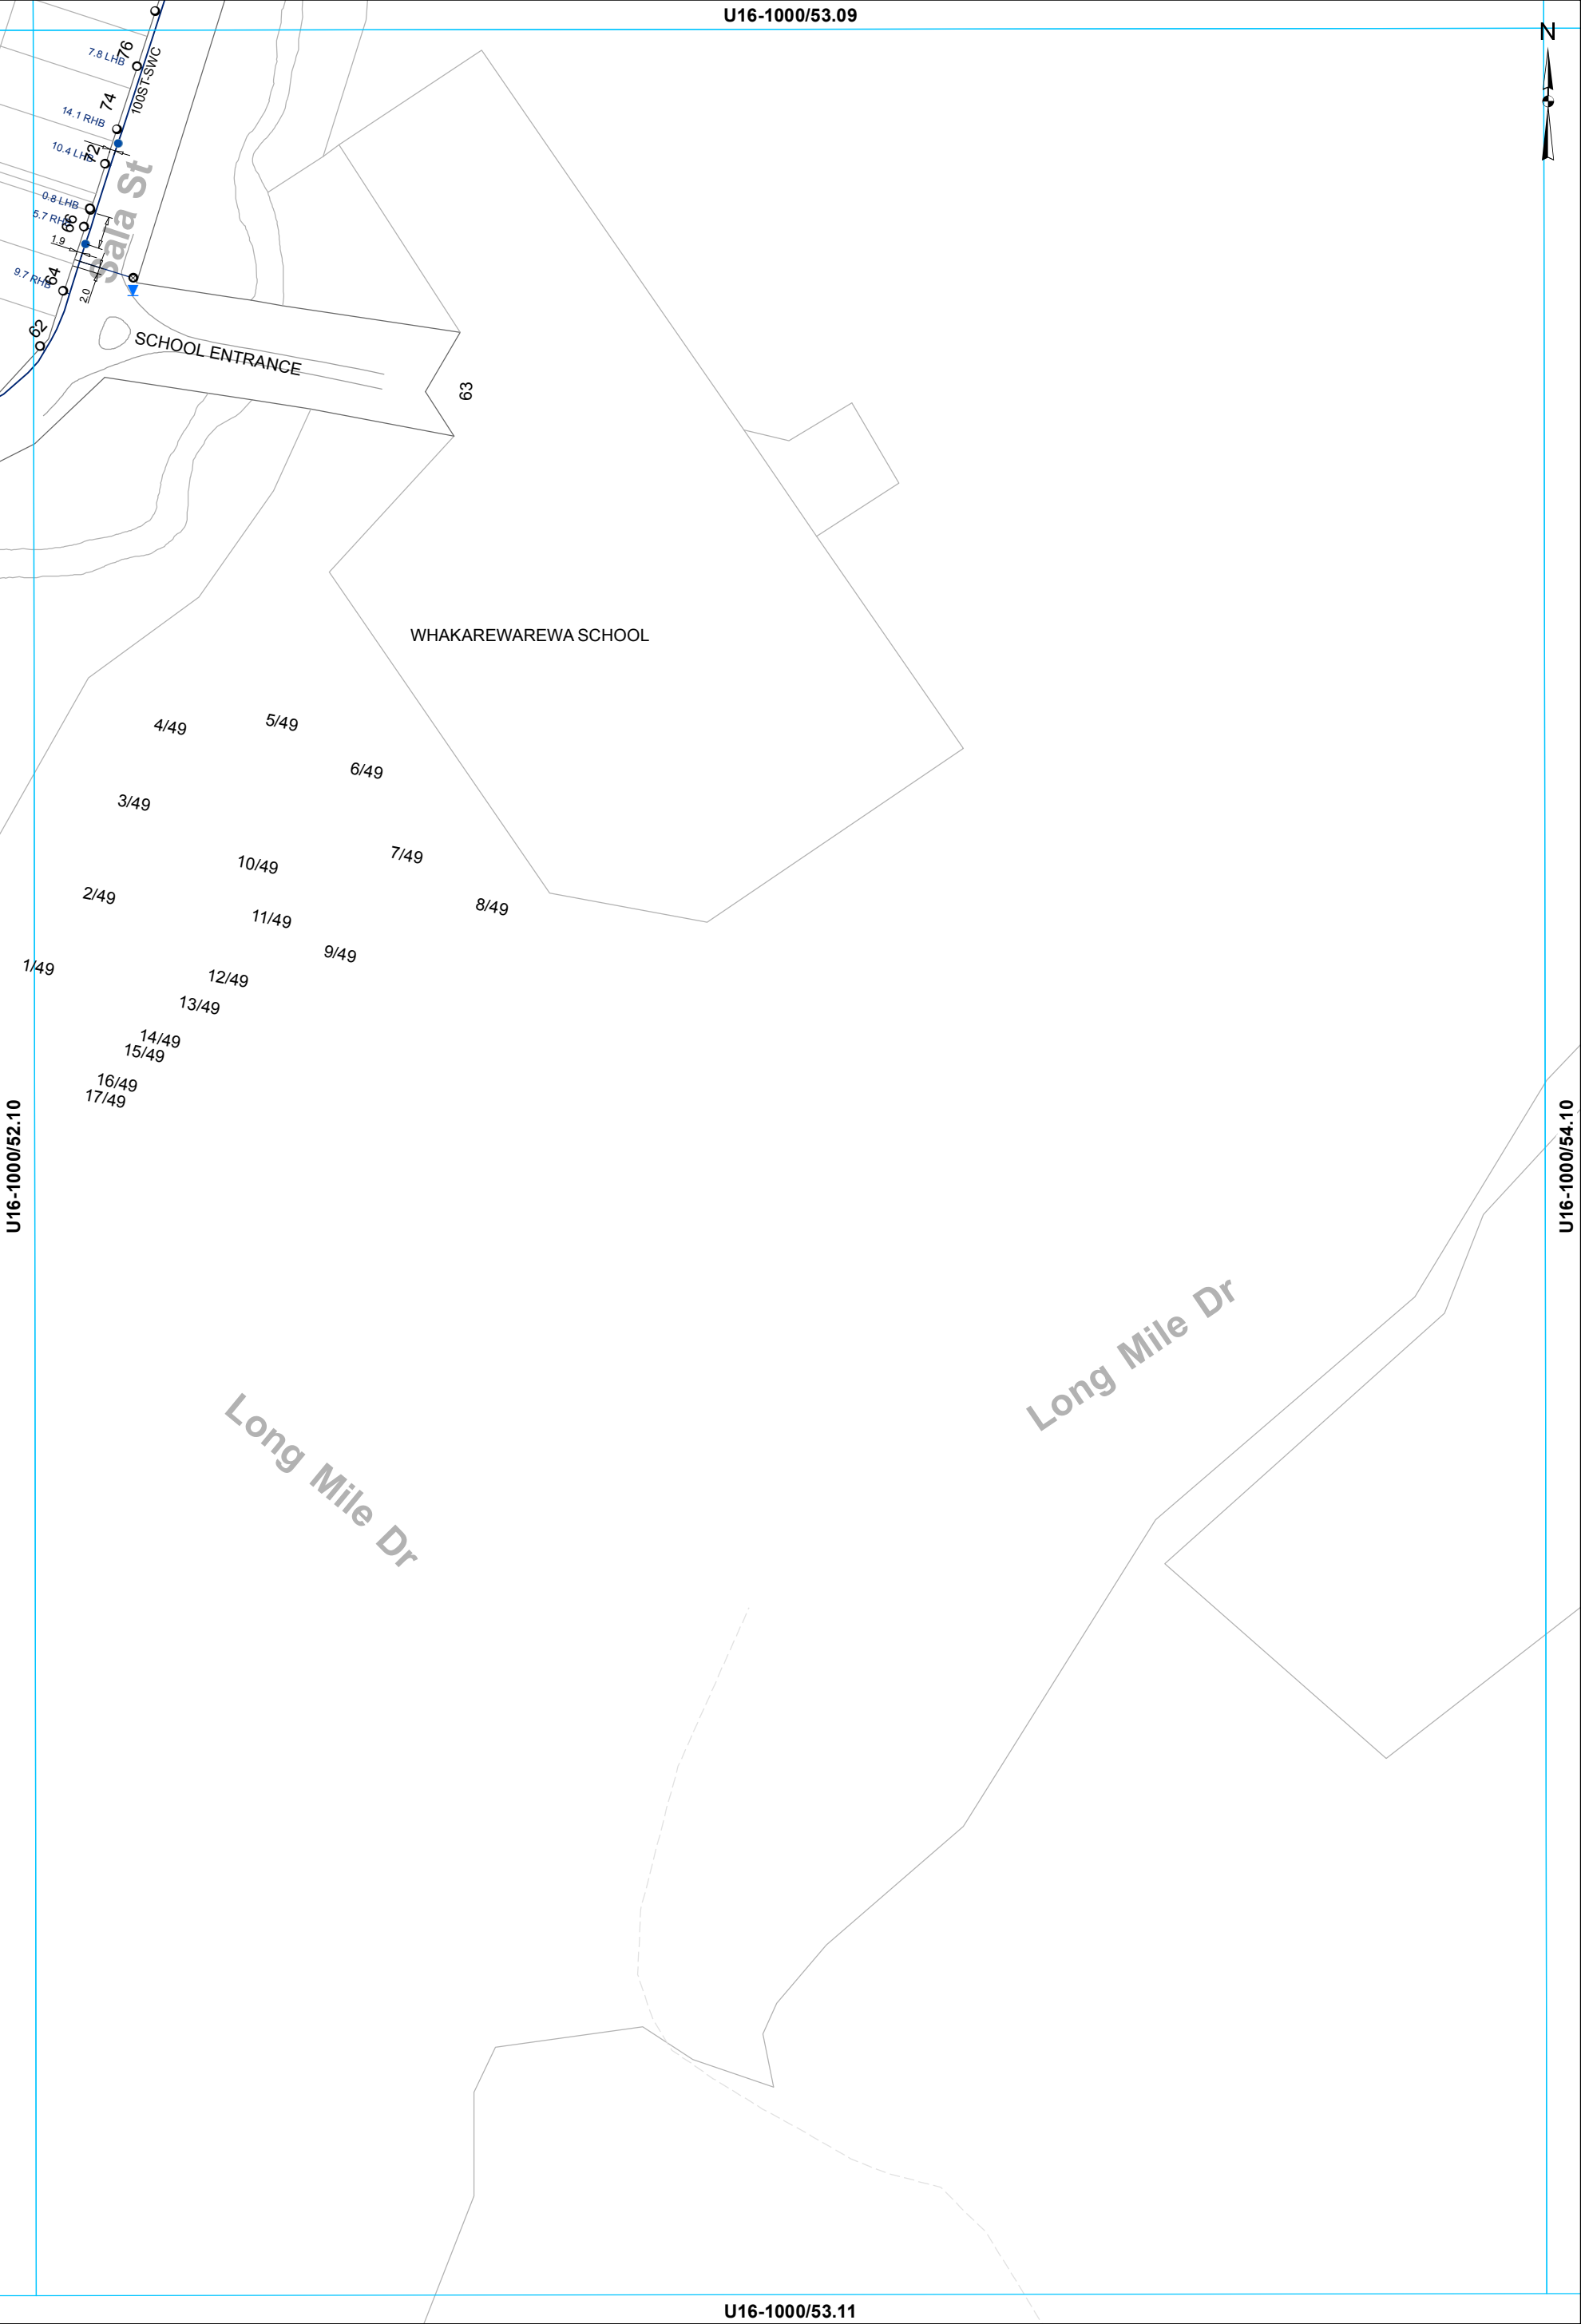


This data is derived from sources outside the control of Rotorua District Council and is for information only

Rotorua District Council 2006. Facsimile 07 346 3143 Telephone 07 348 4199 email mail@rdc.govt.nz

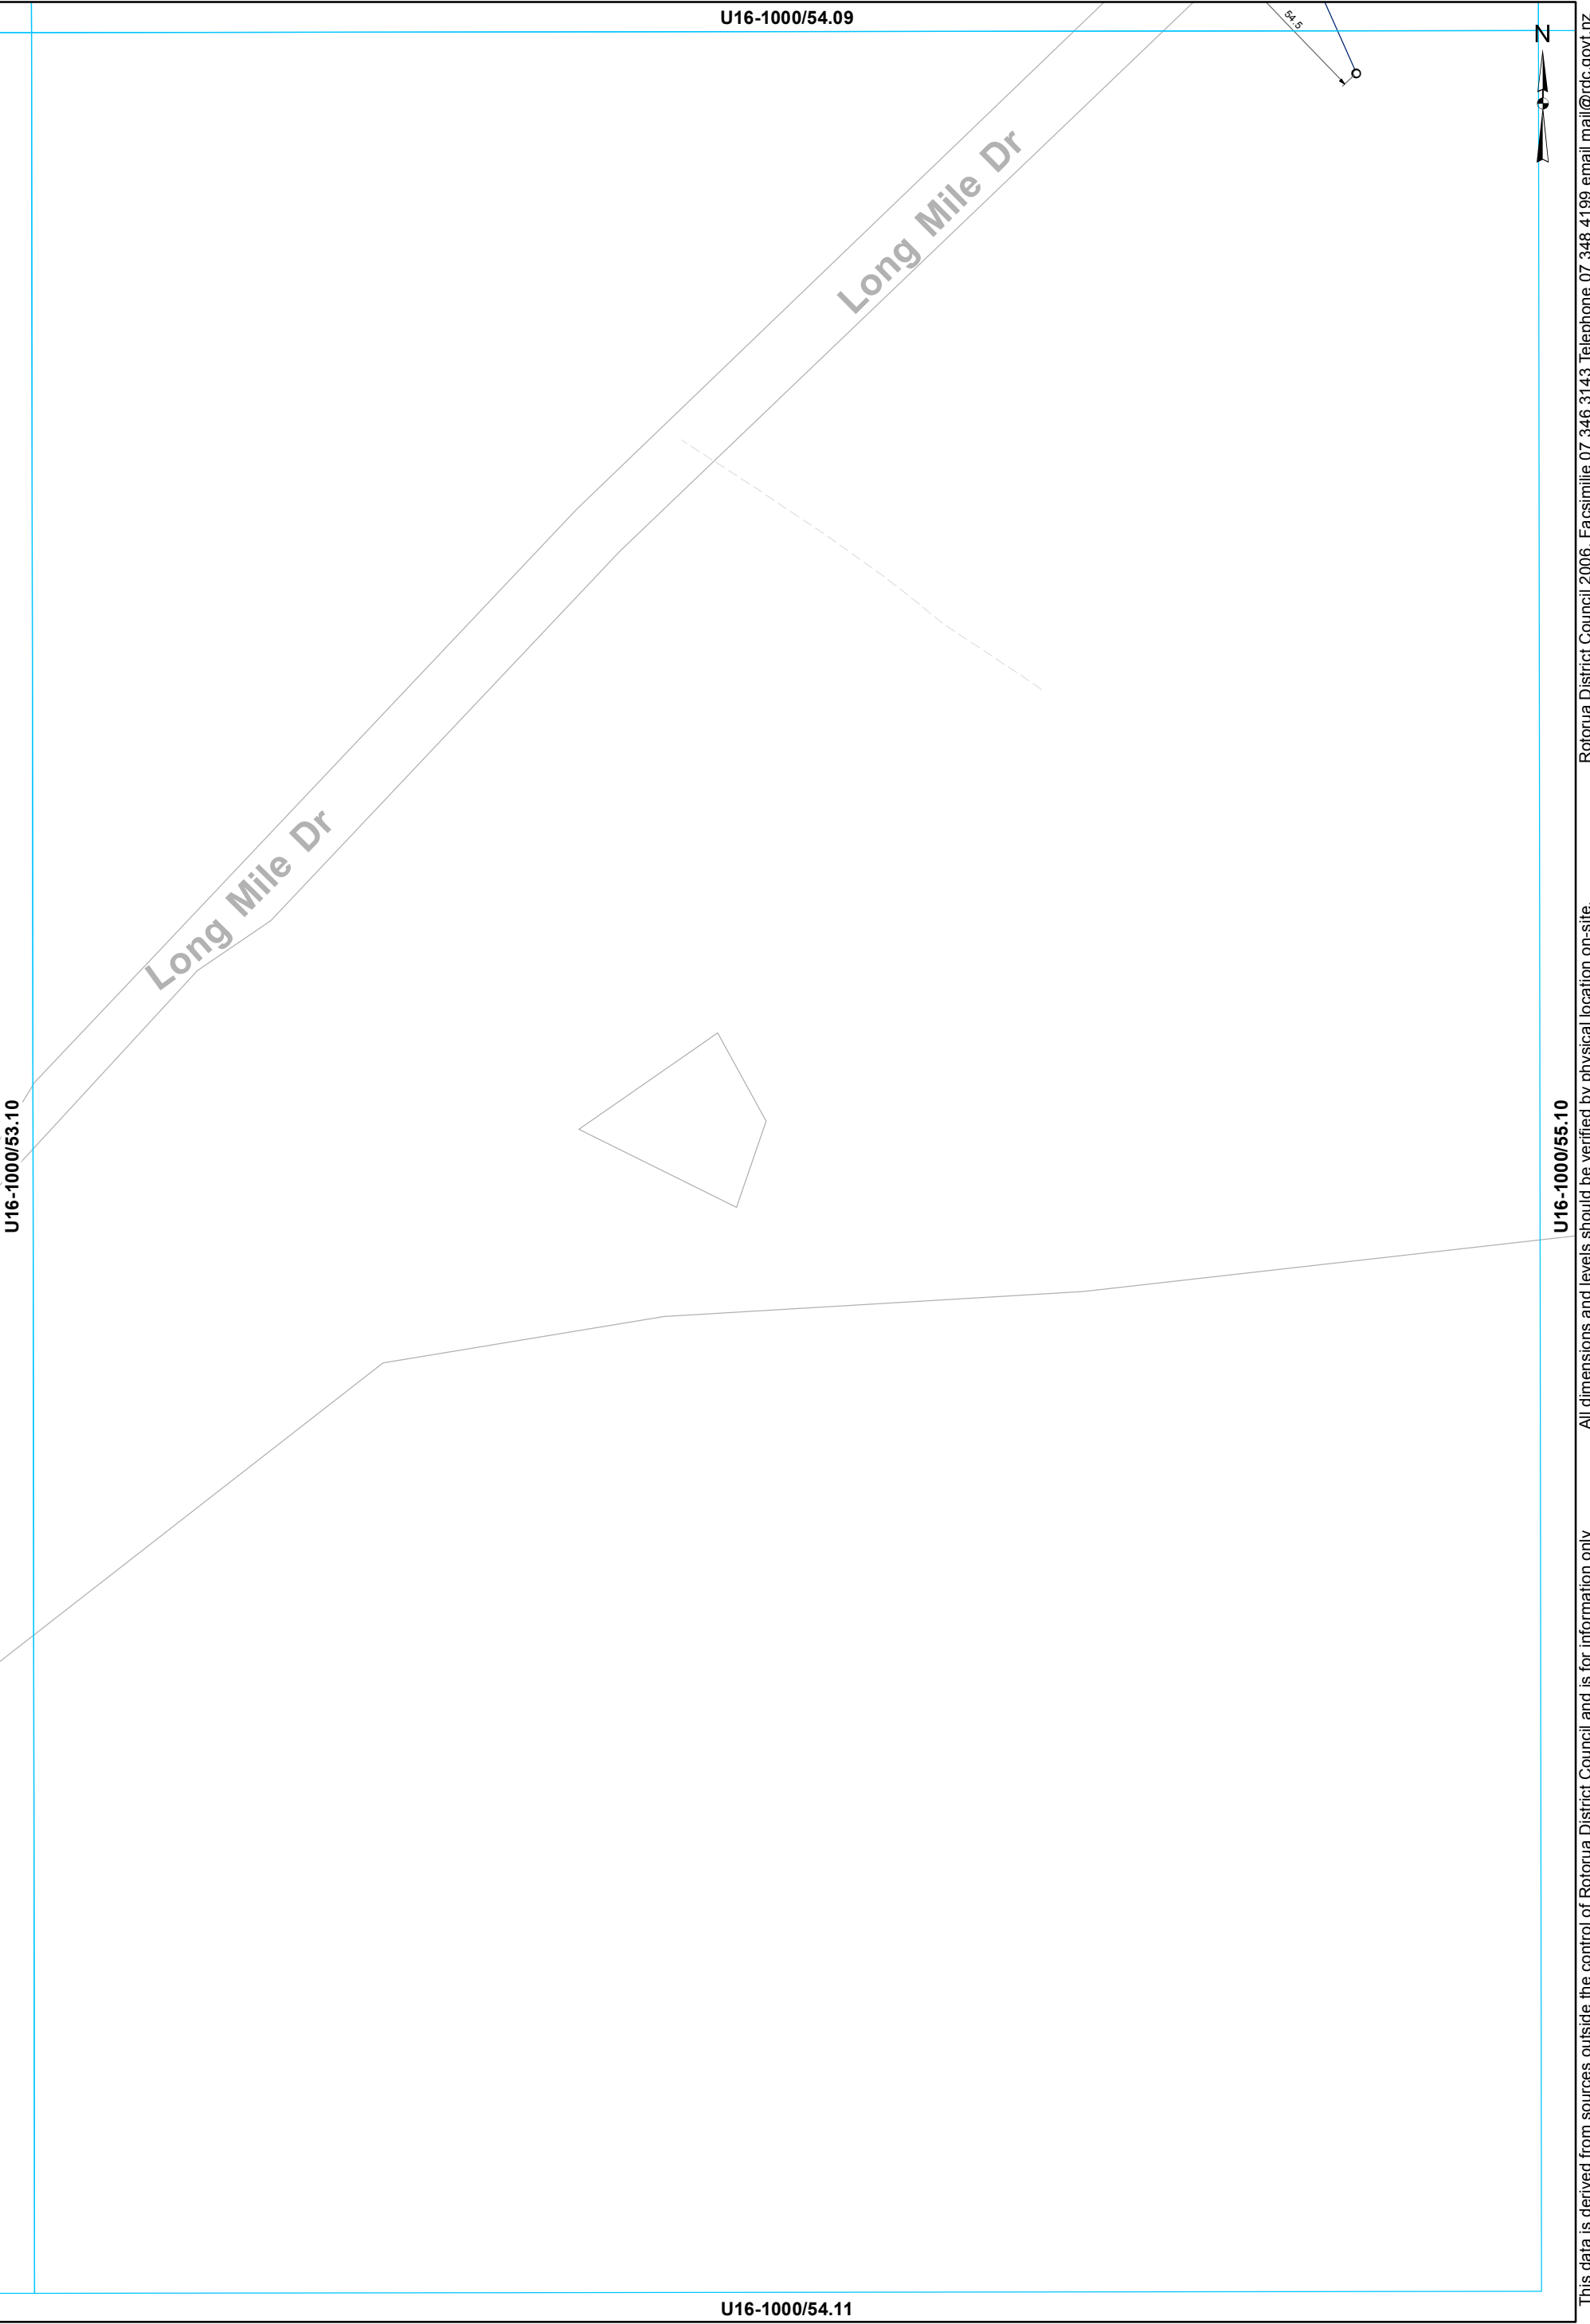


This data is derived from sources outside the control of Rotorua District Council and is for information only

Rotarua District Council 2006. Facsimile 07 346 3143 Telephone 07 348 4199 email mail@rdc.govt.nz

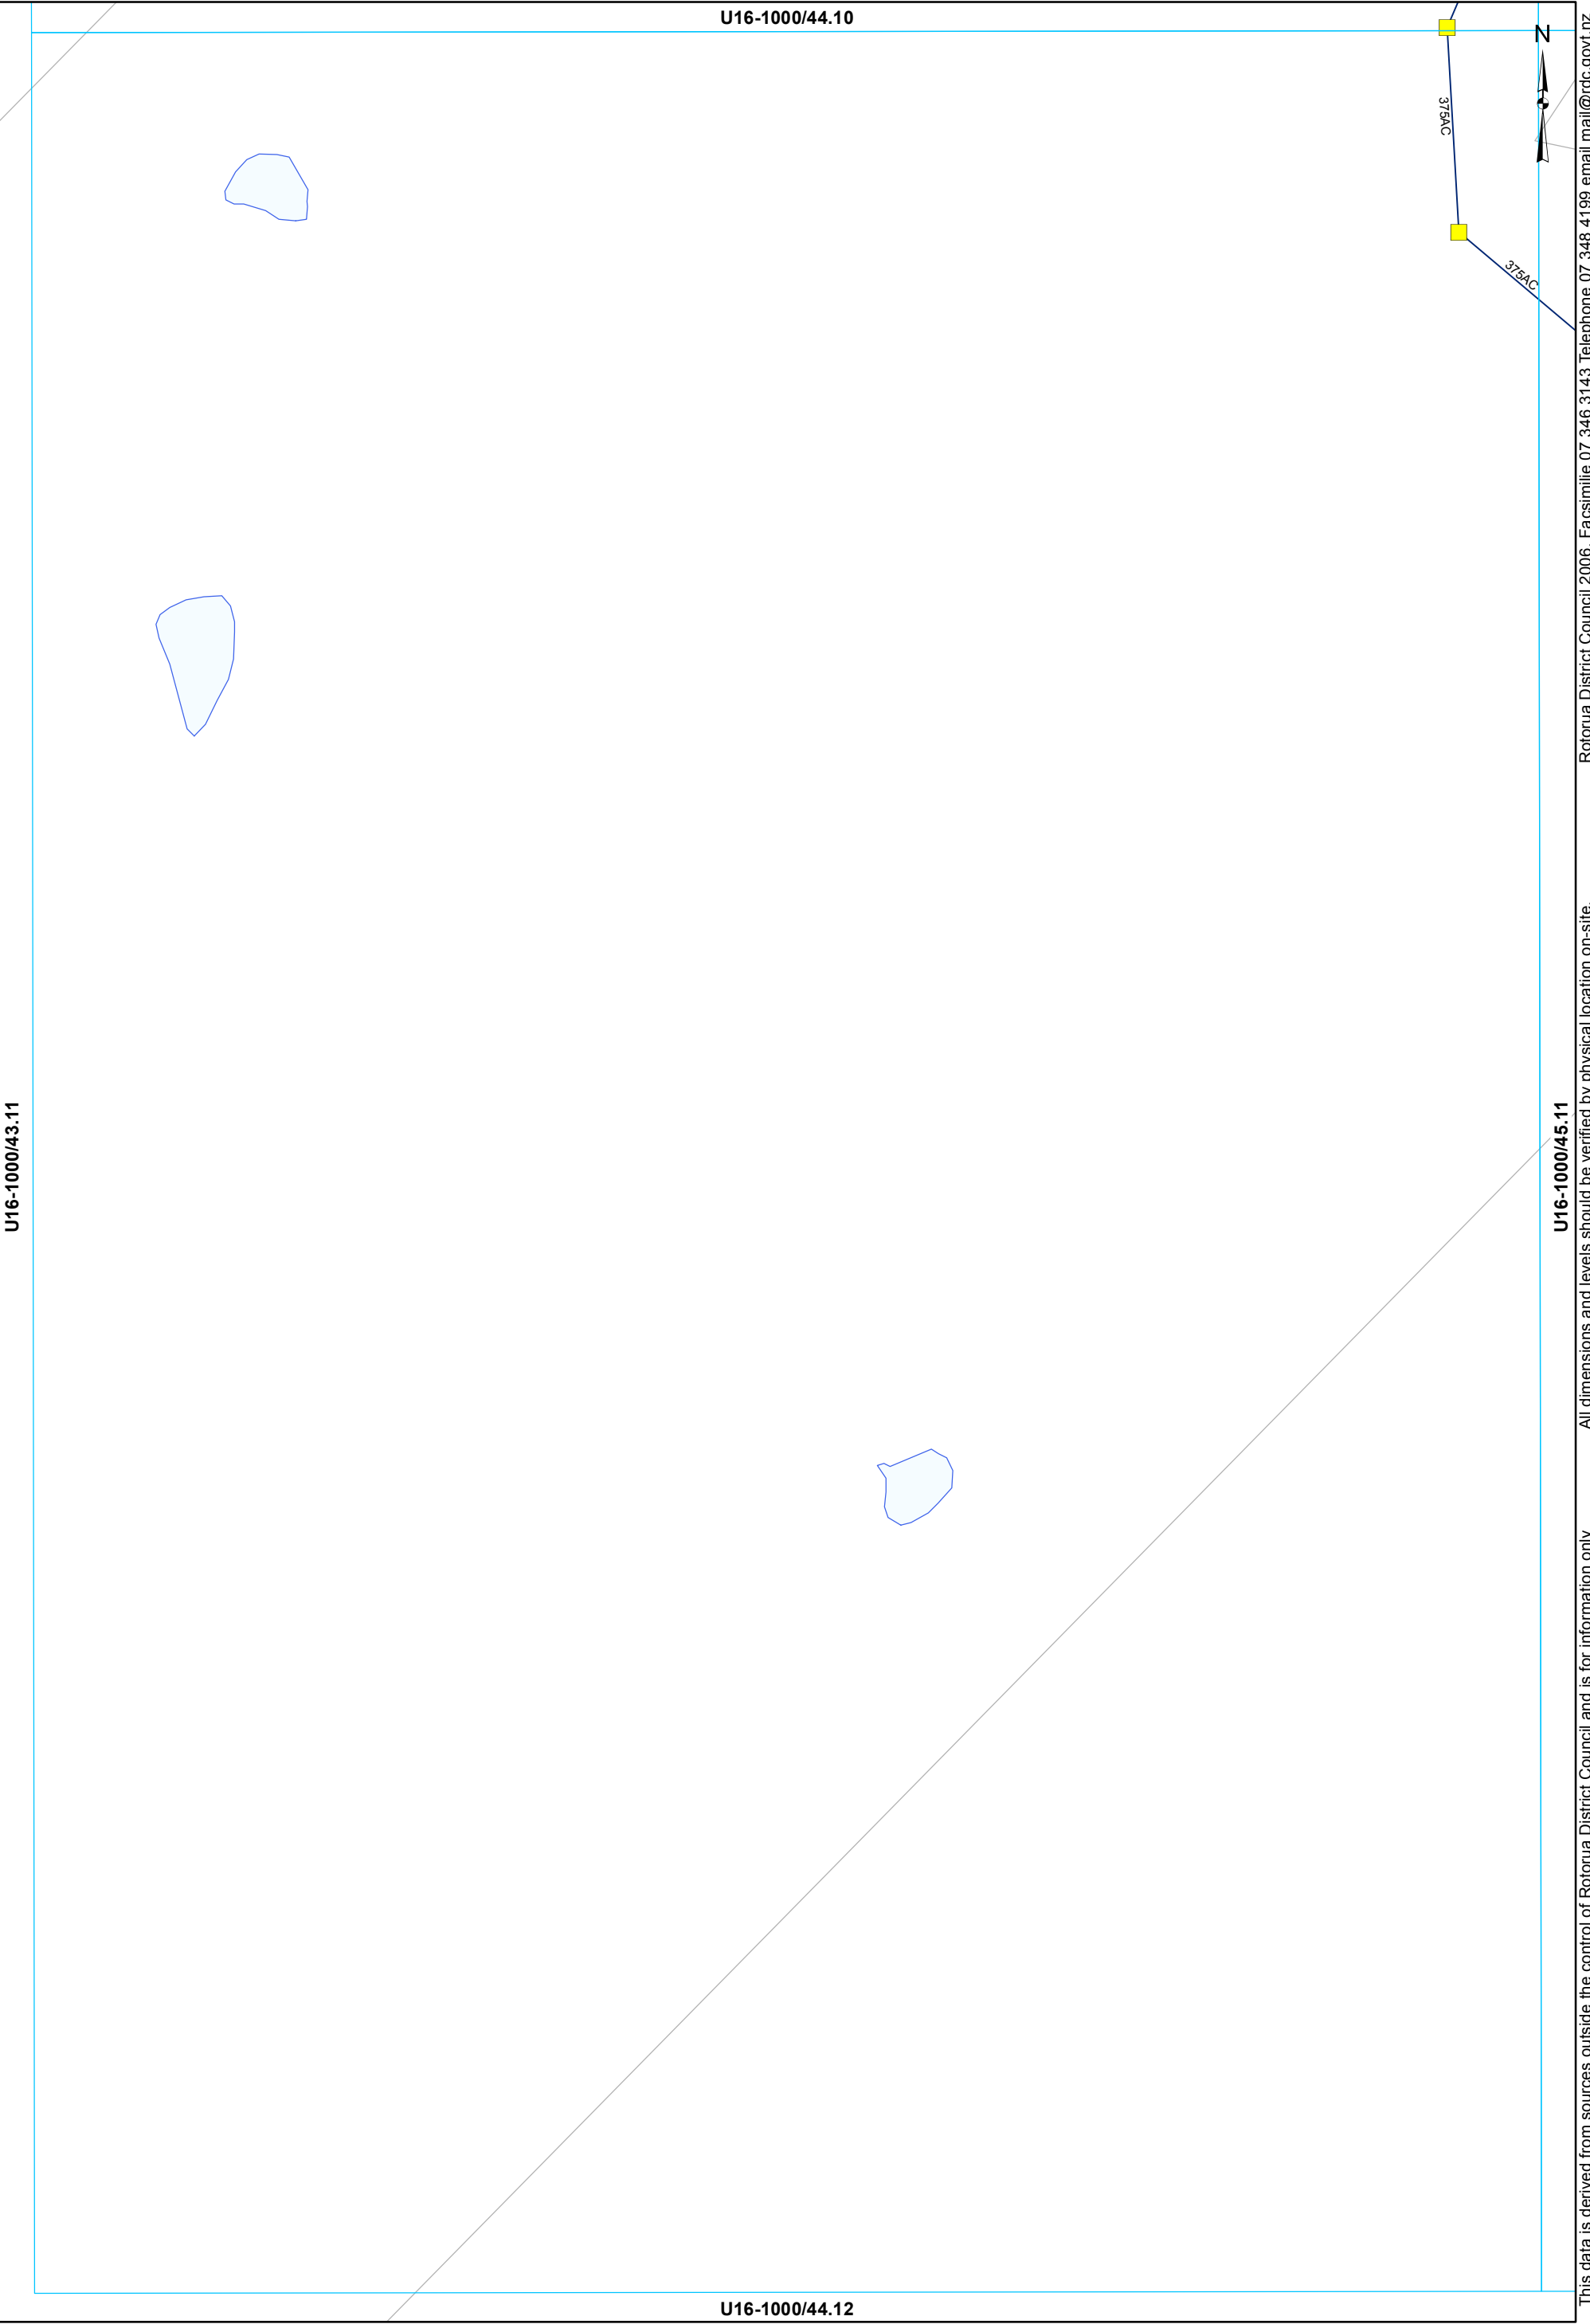

This data is derived from sources outside the control of Rotorua District Council and is for information only

Rotorua District Council 2006. Facsimile 07 346 3143 Telephone 07 348 4199 email mail@rdc.govt.nz

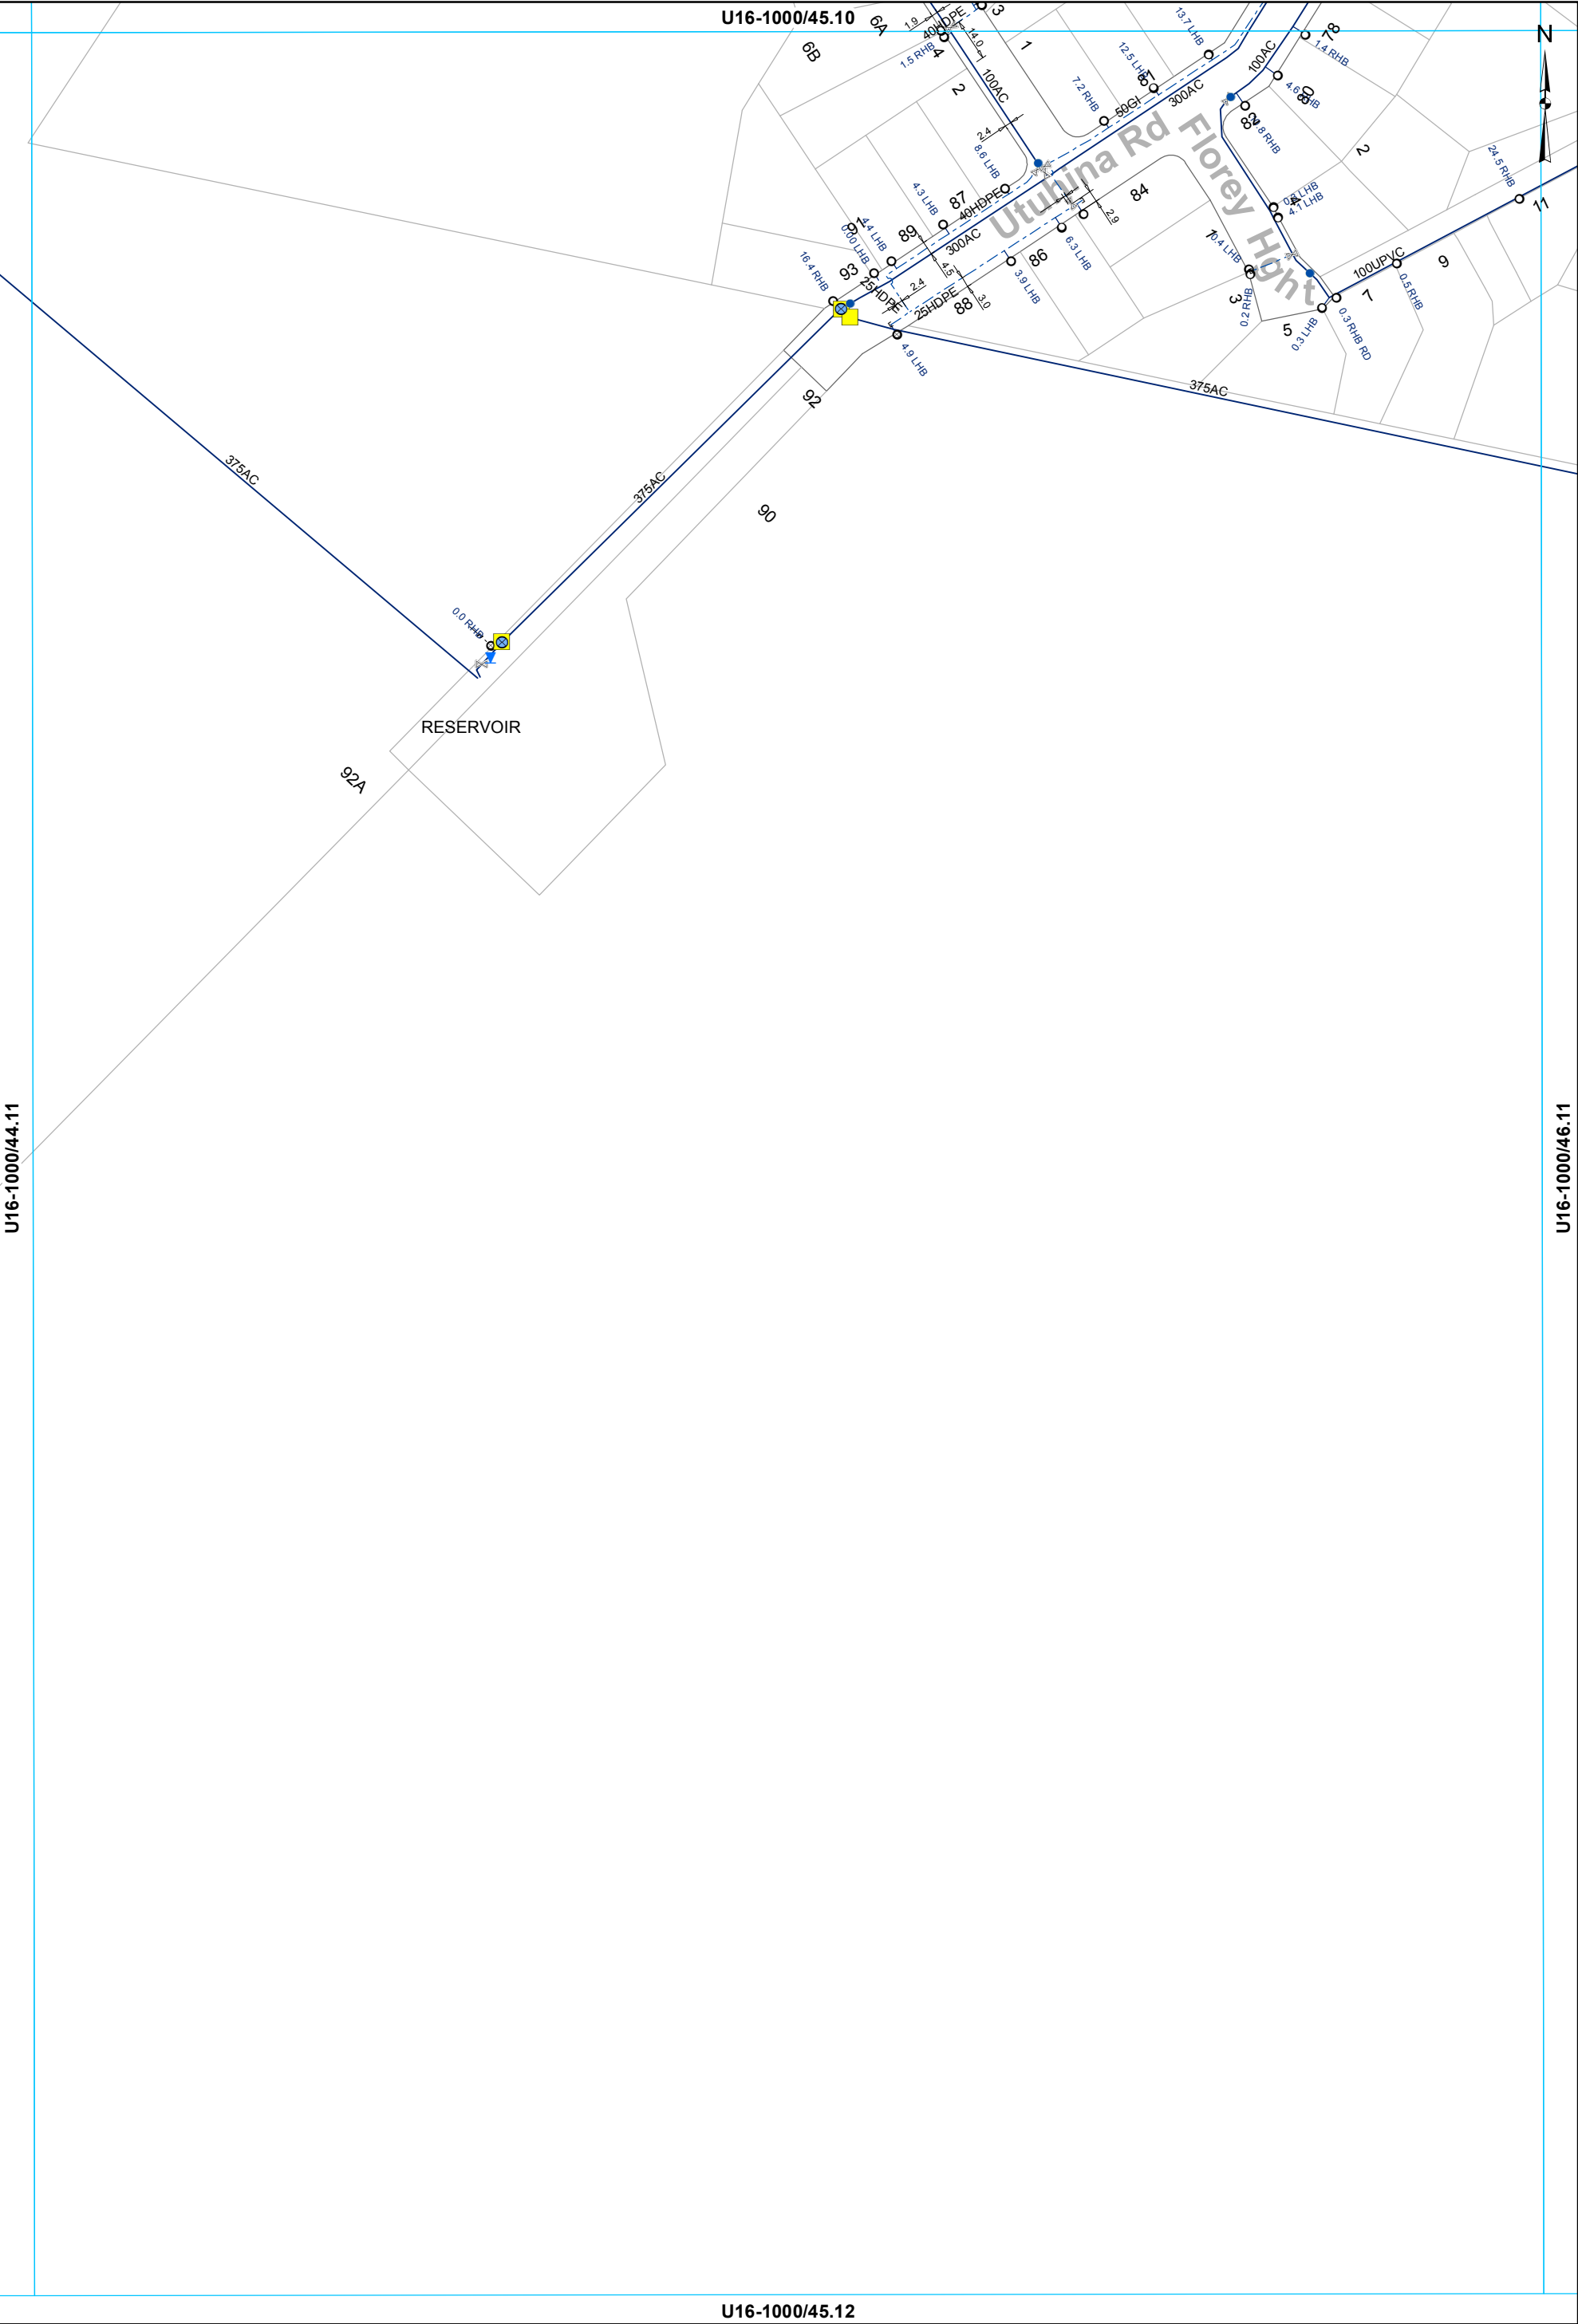

- | | | | | |
|---------|-----------|------------------|-----------------|------------------|
| ⌘ Valve | ● Hydrant | ⊗ Meter Bulk | ■ Miscellaneous | — WSServiceLine |
| ○ Toby | | ⊙ Meter Consumer | | — Main |
| | | ⌒ Capped End | | - - - Rider main |

WATER SUPPLY SERVICES
1:2000 @ A3 - (U16-1000/45.11)

This data is derived from sources outside the control of Rotorua District Council and is for information only

U16-1000/46.11

All dimensions and levels should be verified by physical location on-site.

Rotorua District Council 2006. Facsimile 07 346 3143 Telephone 07 348 4199 email mail@rdc.govt.nz



U16-1000/45.11

U16-1000/46.10

U16-1000/47.11

- X

Valve

•

Hydrant

⊗

Meter Bulk

■

Miscellaneous

—

WSServiceLine
- Toby

^

Capped End

—

Main

- - -

Rider main

WATER SUPPLY SERVICES
1:2000 @ A3 - (U16-1000/46.11)

This data is derived from sources outside the control of Rotorua District Council and is for information only


Rotorua District Council 2006. Facsimile 07 346 3143 Telephone 07 348 4199 email mail@rdc.govt.nz




All dimensions and levels should be verified by physical location on-site.

This data is derived from sources outside the control of Rotorua District Council and is for information only

WATER SUPPLY SERVICES
1:2000 @ A3 - (U16-1000/47.11)

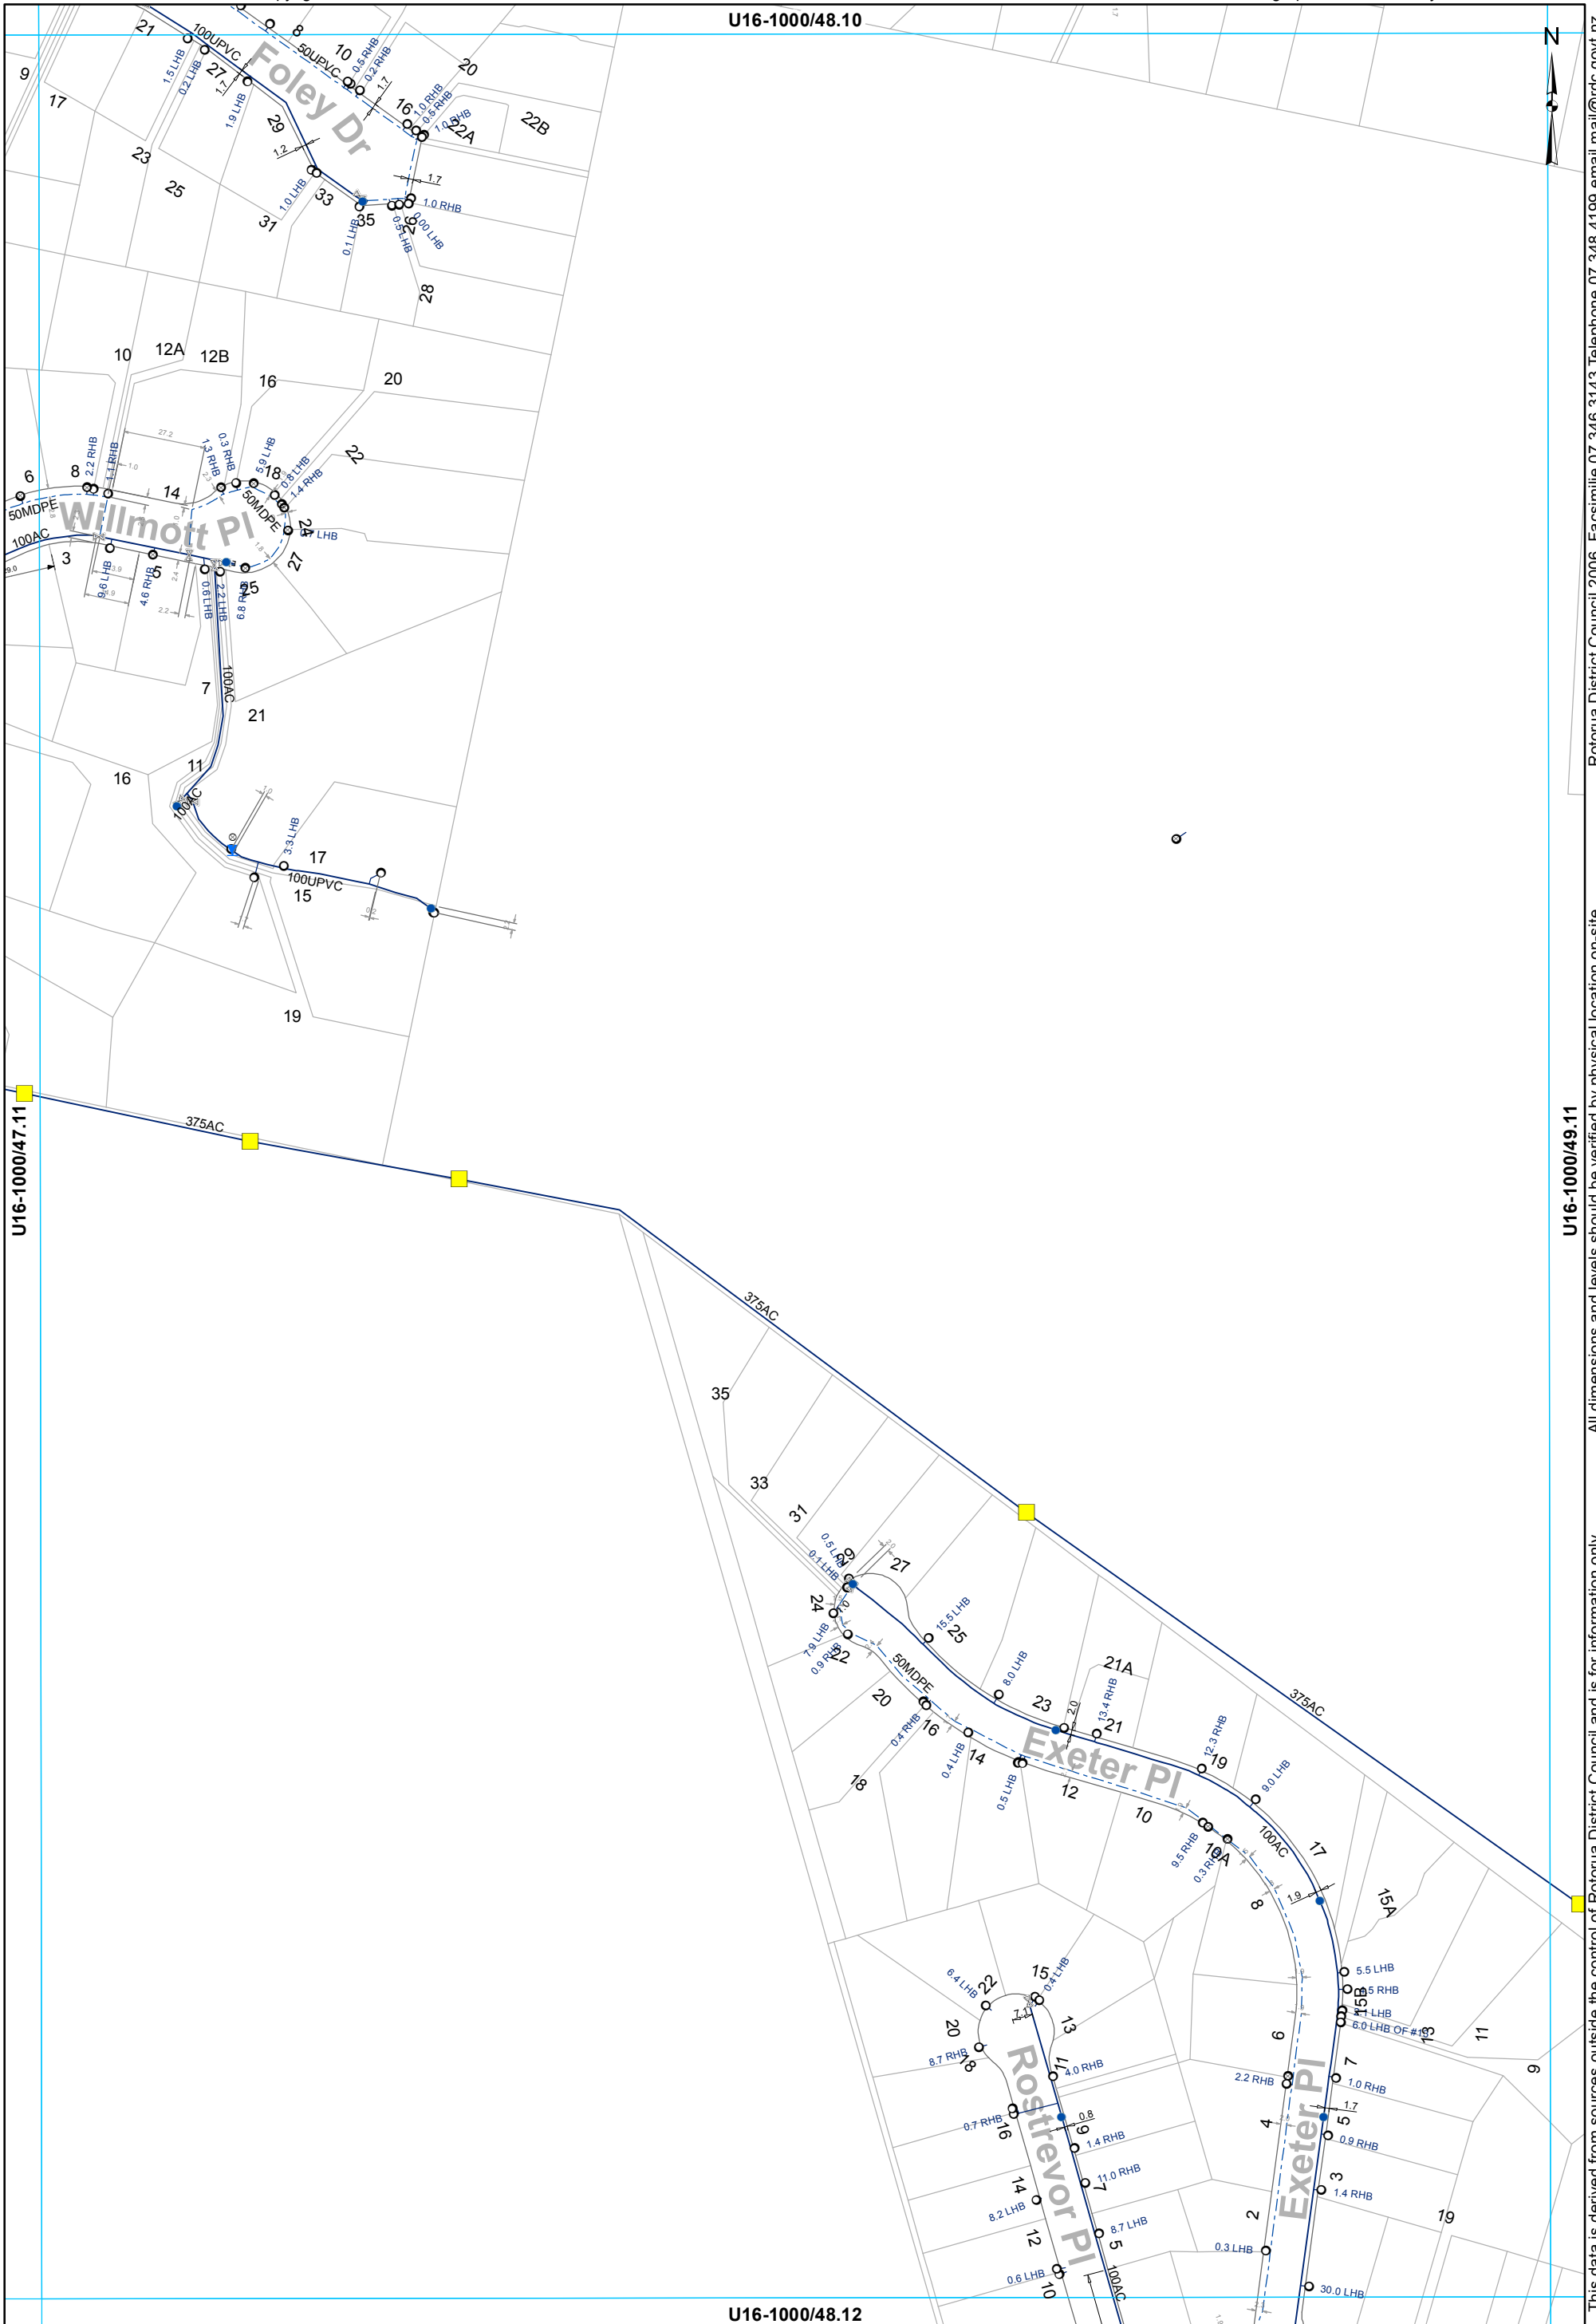

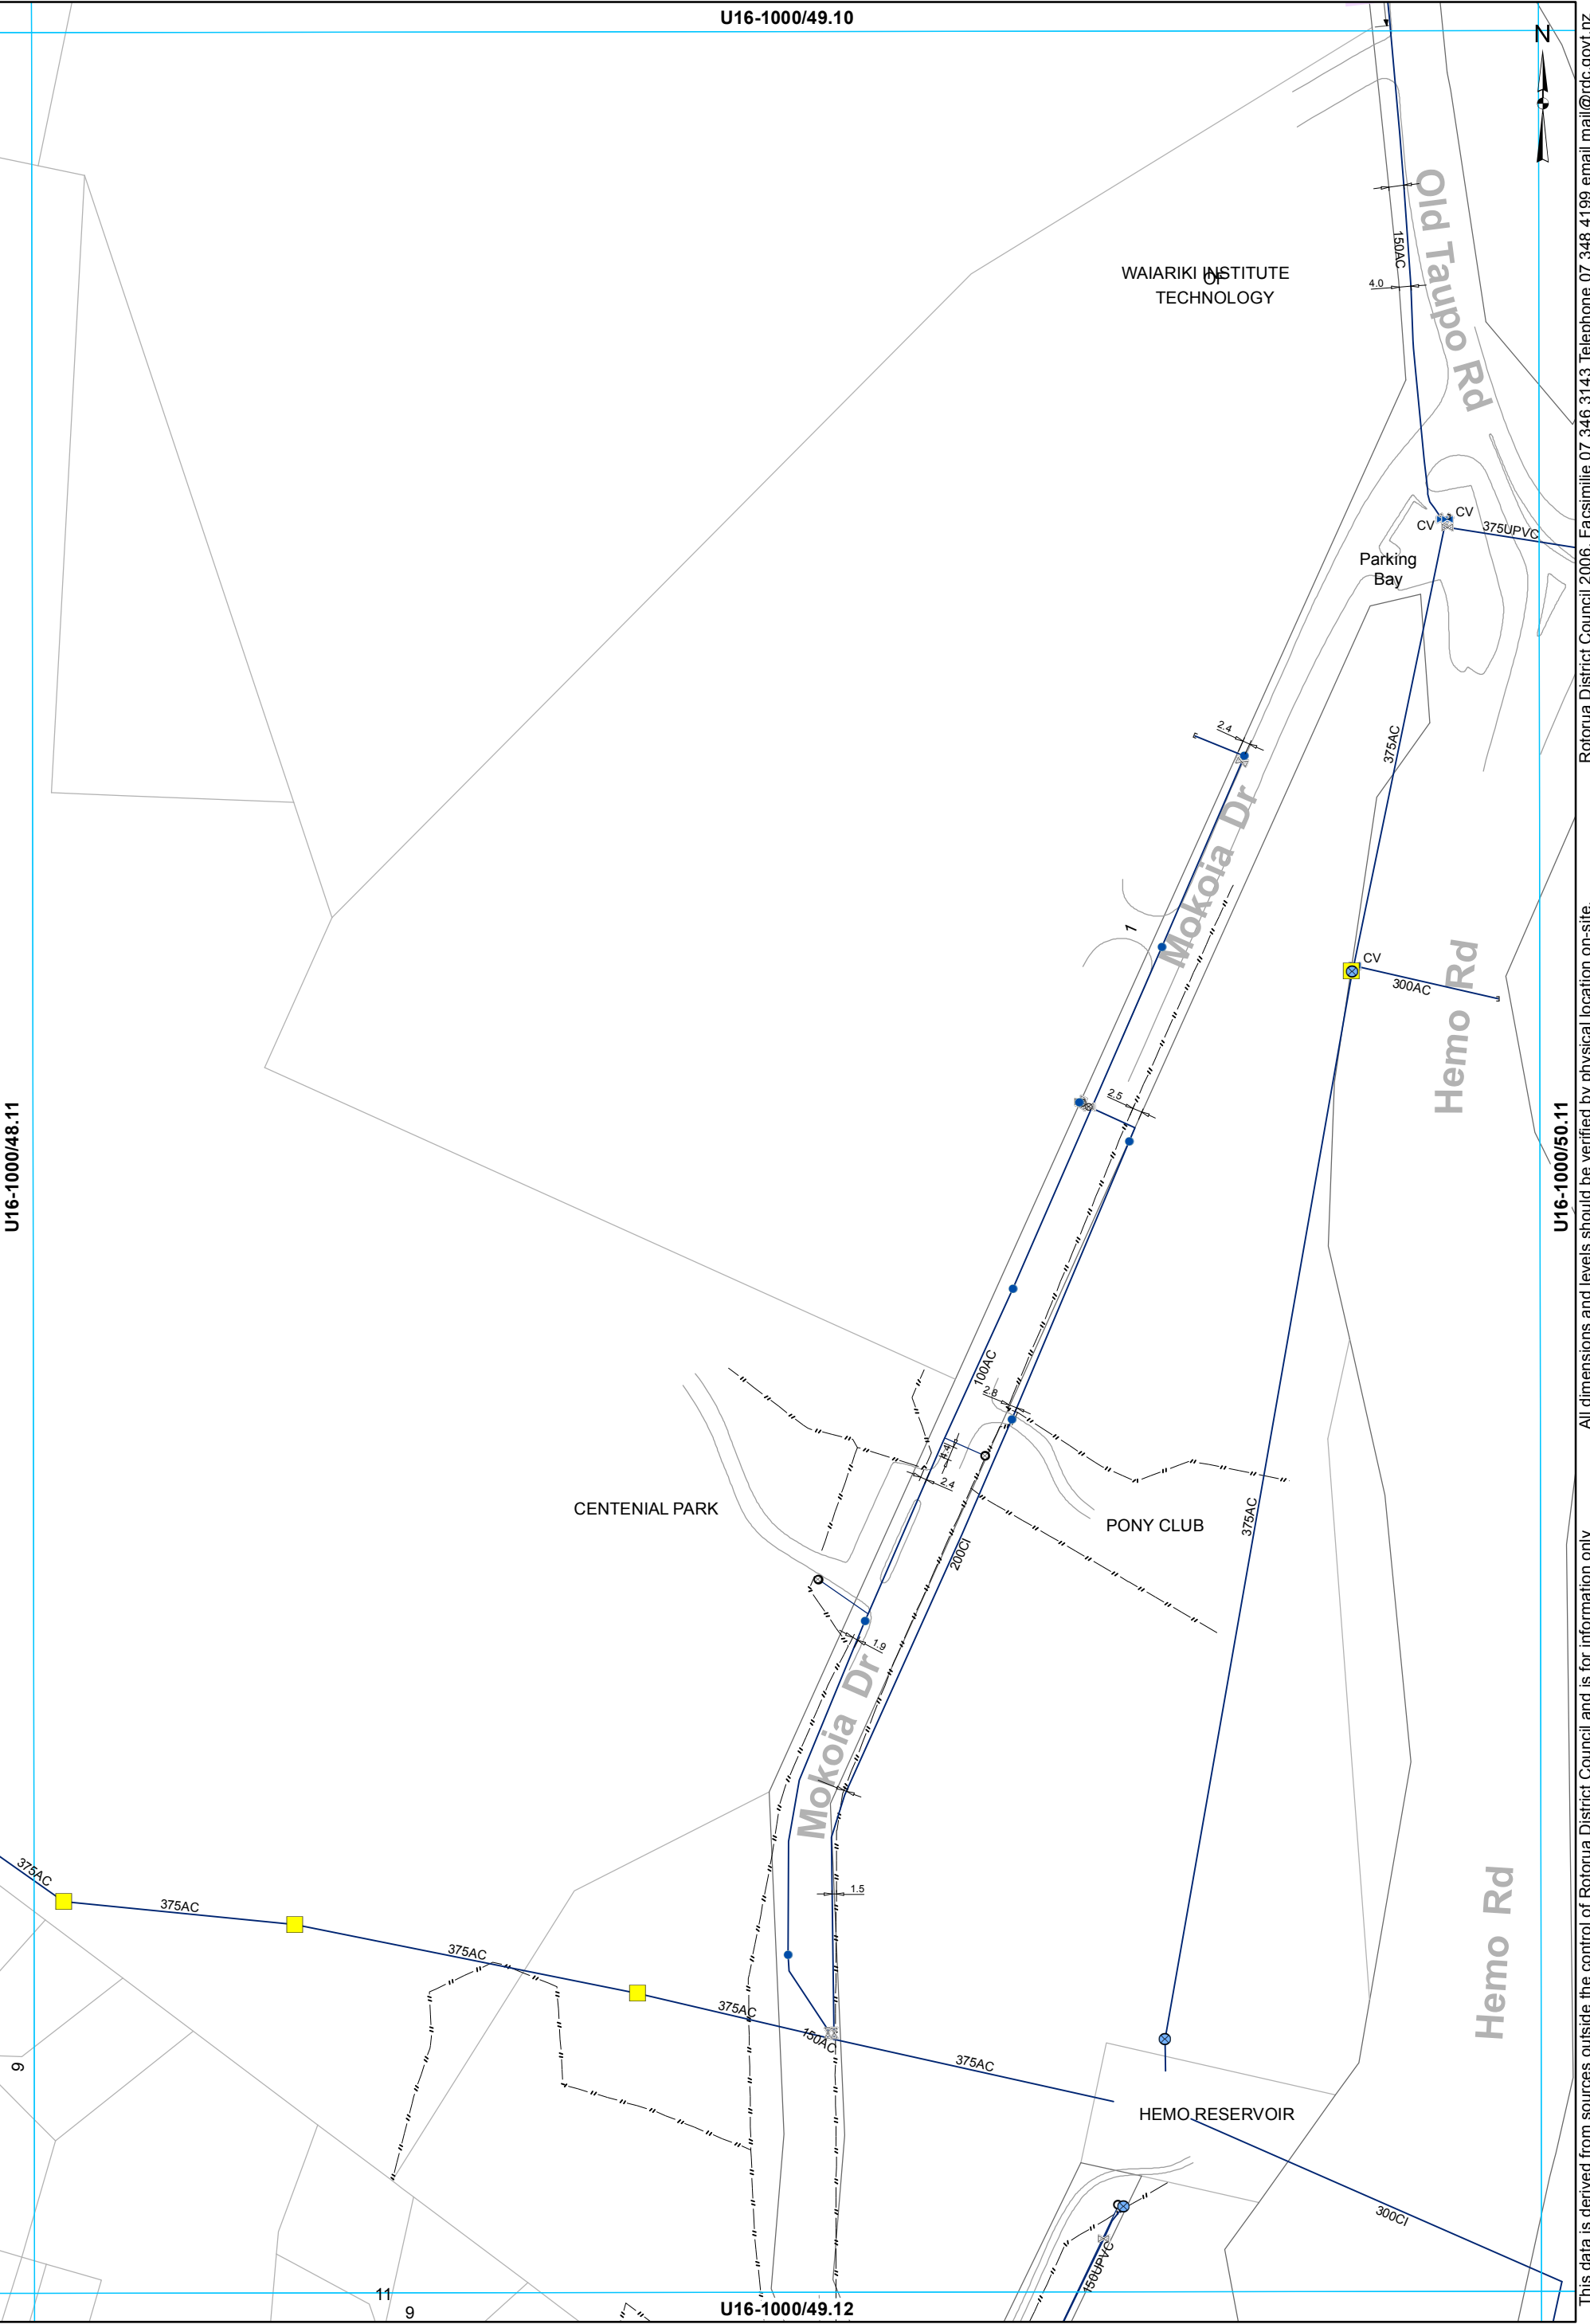

U16-1000/48.11

U16-1000/49.10


U16-1000/49.12

U16-1000/50.11

- | | | | | |
|--------------|---------|----------------|---------------|---------------|
| Valve | Hydrant | Meter Bulk | Miscellaneous | WSServiceLine |
| Toby | | Meter Consumer | | Main |
| Closed Valve | | Capped End | | |

WATER SUPPLY SERVICES
1:2000 @ A3 - (U16-1000/49.11)

This data is derived from sources outside the control of Rotorua District Council and is for information only. All dimensions and levels should be verified by physical location on-site. Rotorua District Council 2006. Facsimile 07 346 3143 Telephone 07 348 4199 email mail@rdc.govt.nz

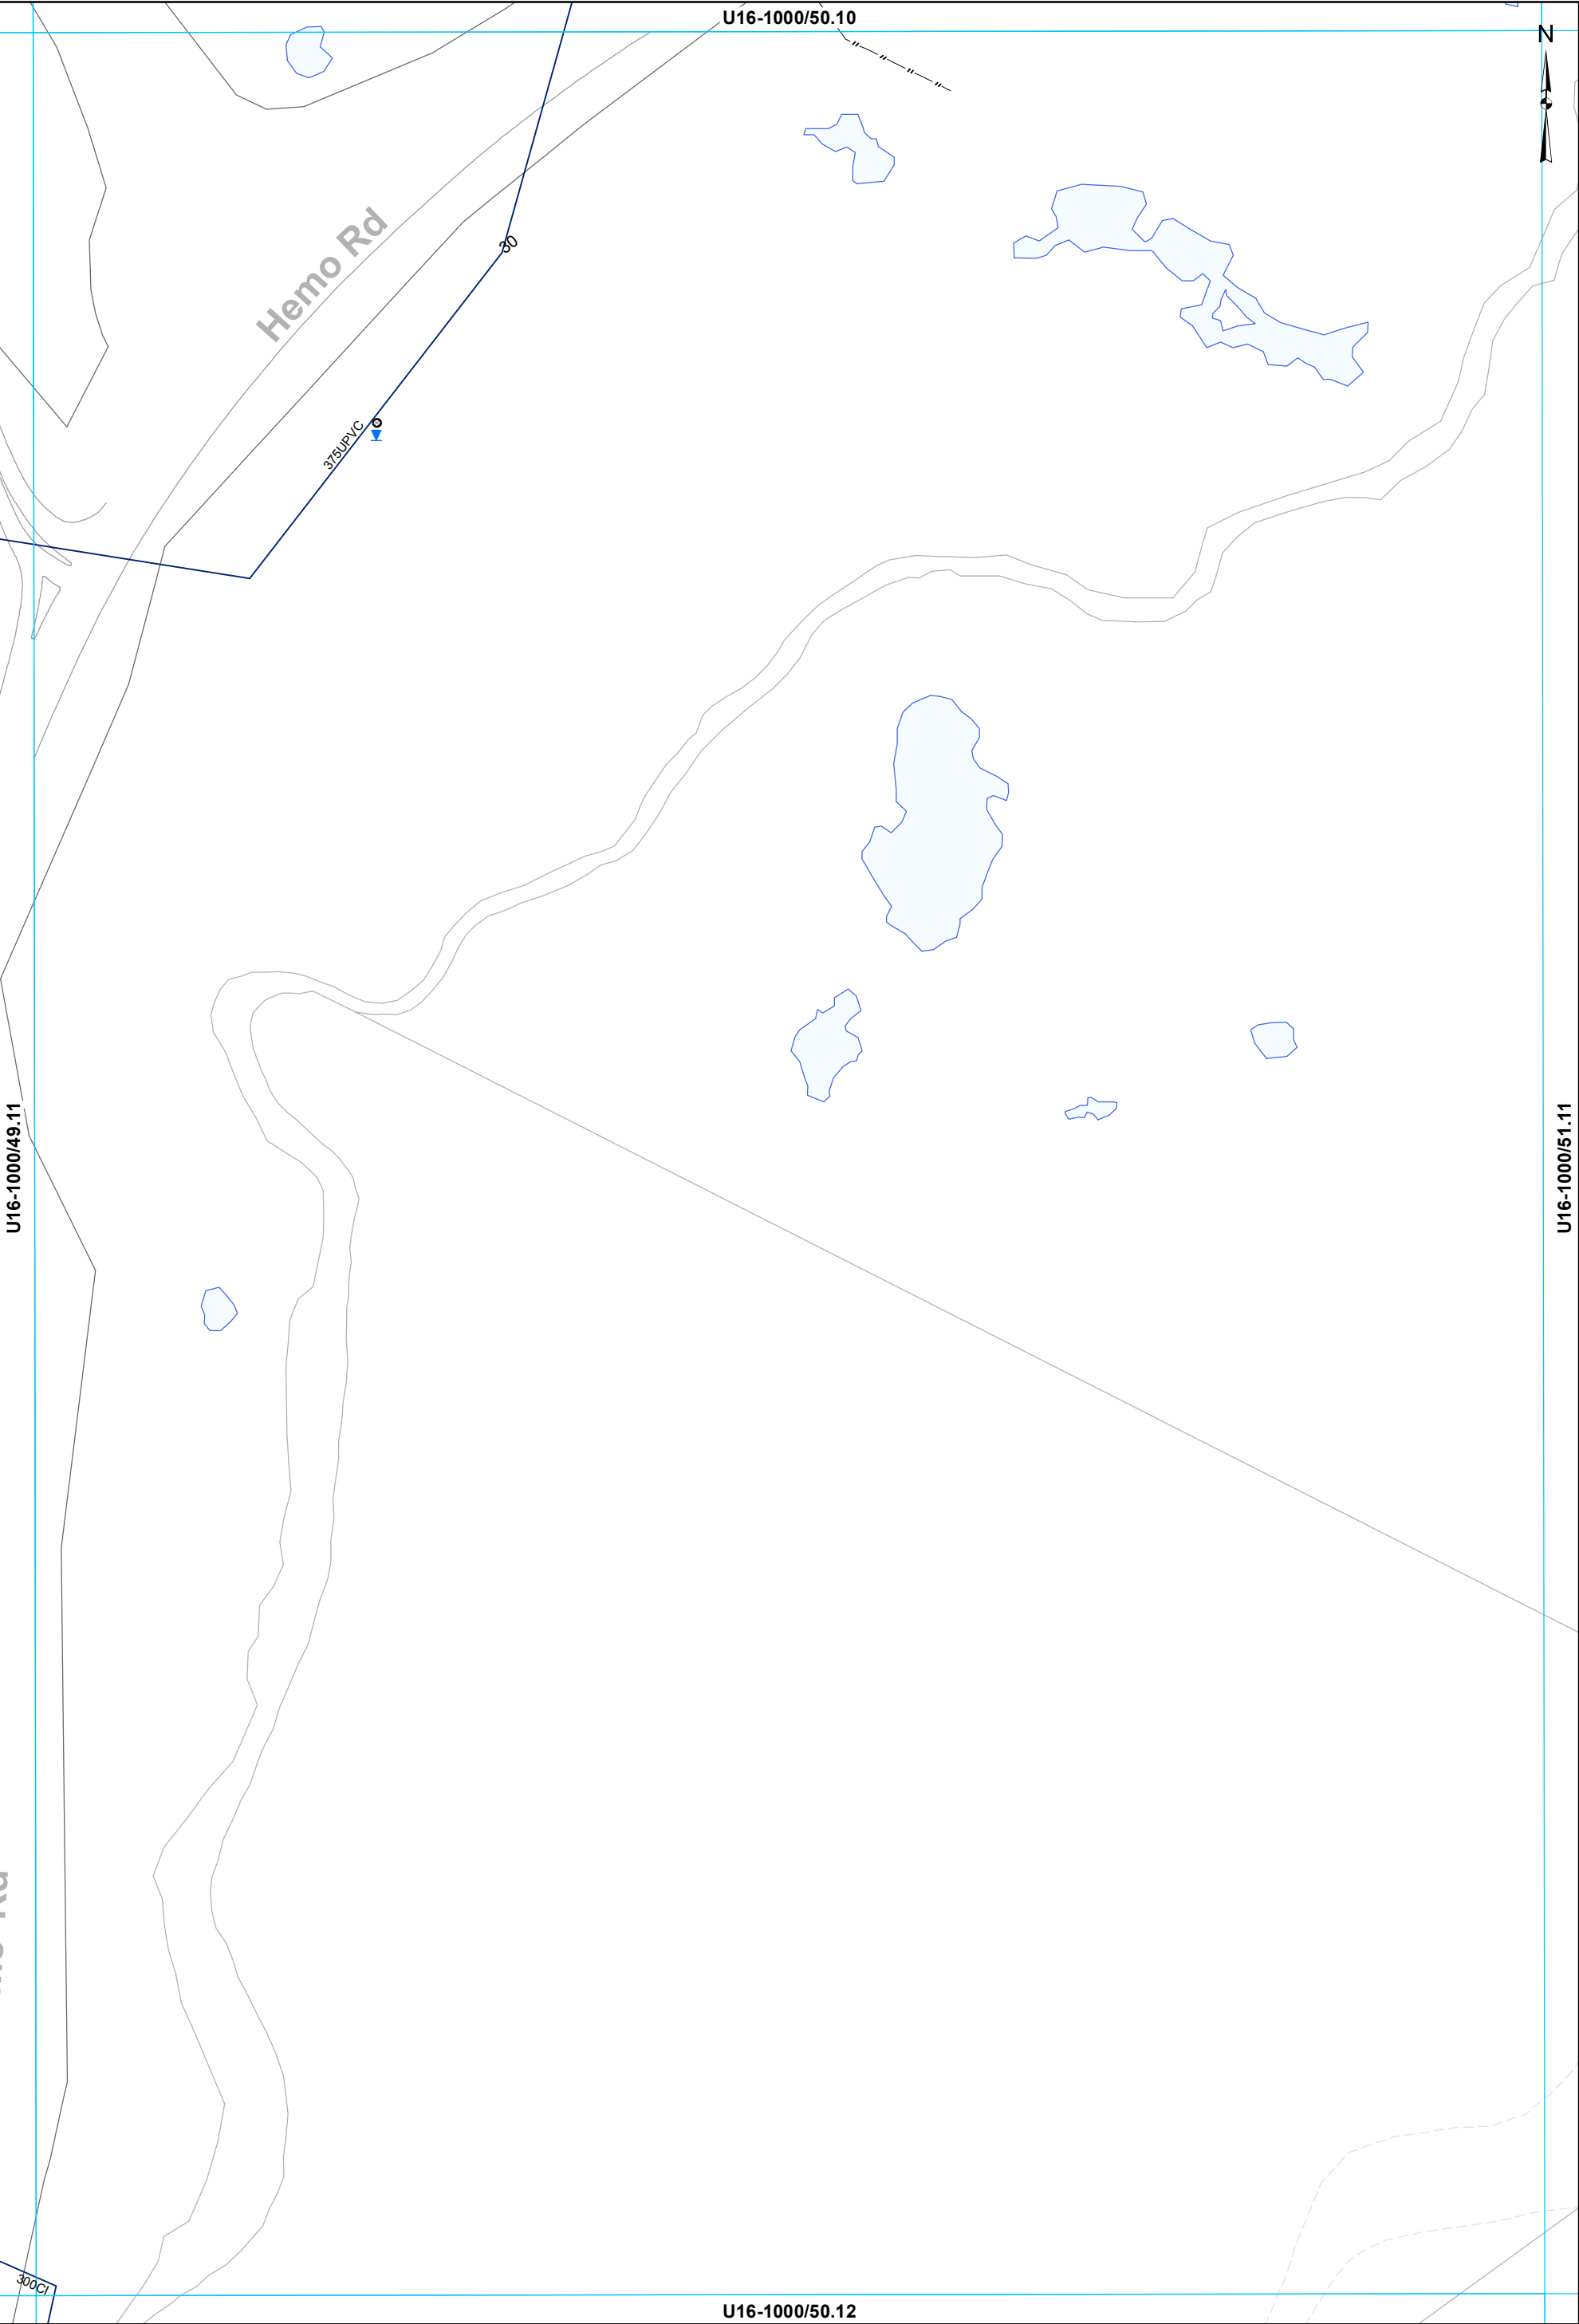

○ Toby ○ Meter Consumer — WSServiceLine
— Main

WATER SUPPLY SERVICES
1:2000 @ A3 - (U16-1000/50.11)

This data is derived from sources outside the control of Rotorua District Council and is for information only

Rotorua District Council 2006. Facsimile 07 346 3143 Telephone 07 348 4199 email mail@rdc.govt.nz

U16-1000/47.12

U16-1000/48.11

U16-1000/48.13

U16-1000/49.12/13

This data is derived from sources outside the control of Rotorua District Council and is for information only

All dimensions and levels should be verified by physical location on-site.

Rotorua District Council 2006. Facsimile 07 348 3143 Telephone 07 348 4199 email mail@rdc.govt.nz

- ⌘

Valve

○

Toby

●

Hydrant

⊗

Meter Bulk

⊙

Meter Consumer

⌒

Capped End
- WSServiceLine


—


Main

- - -

Rider main

WATER SUPPLY SERVICES
1:2000 @ A3 - (U16-1000/48.12)

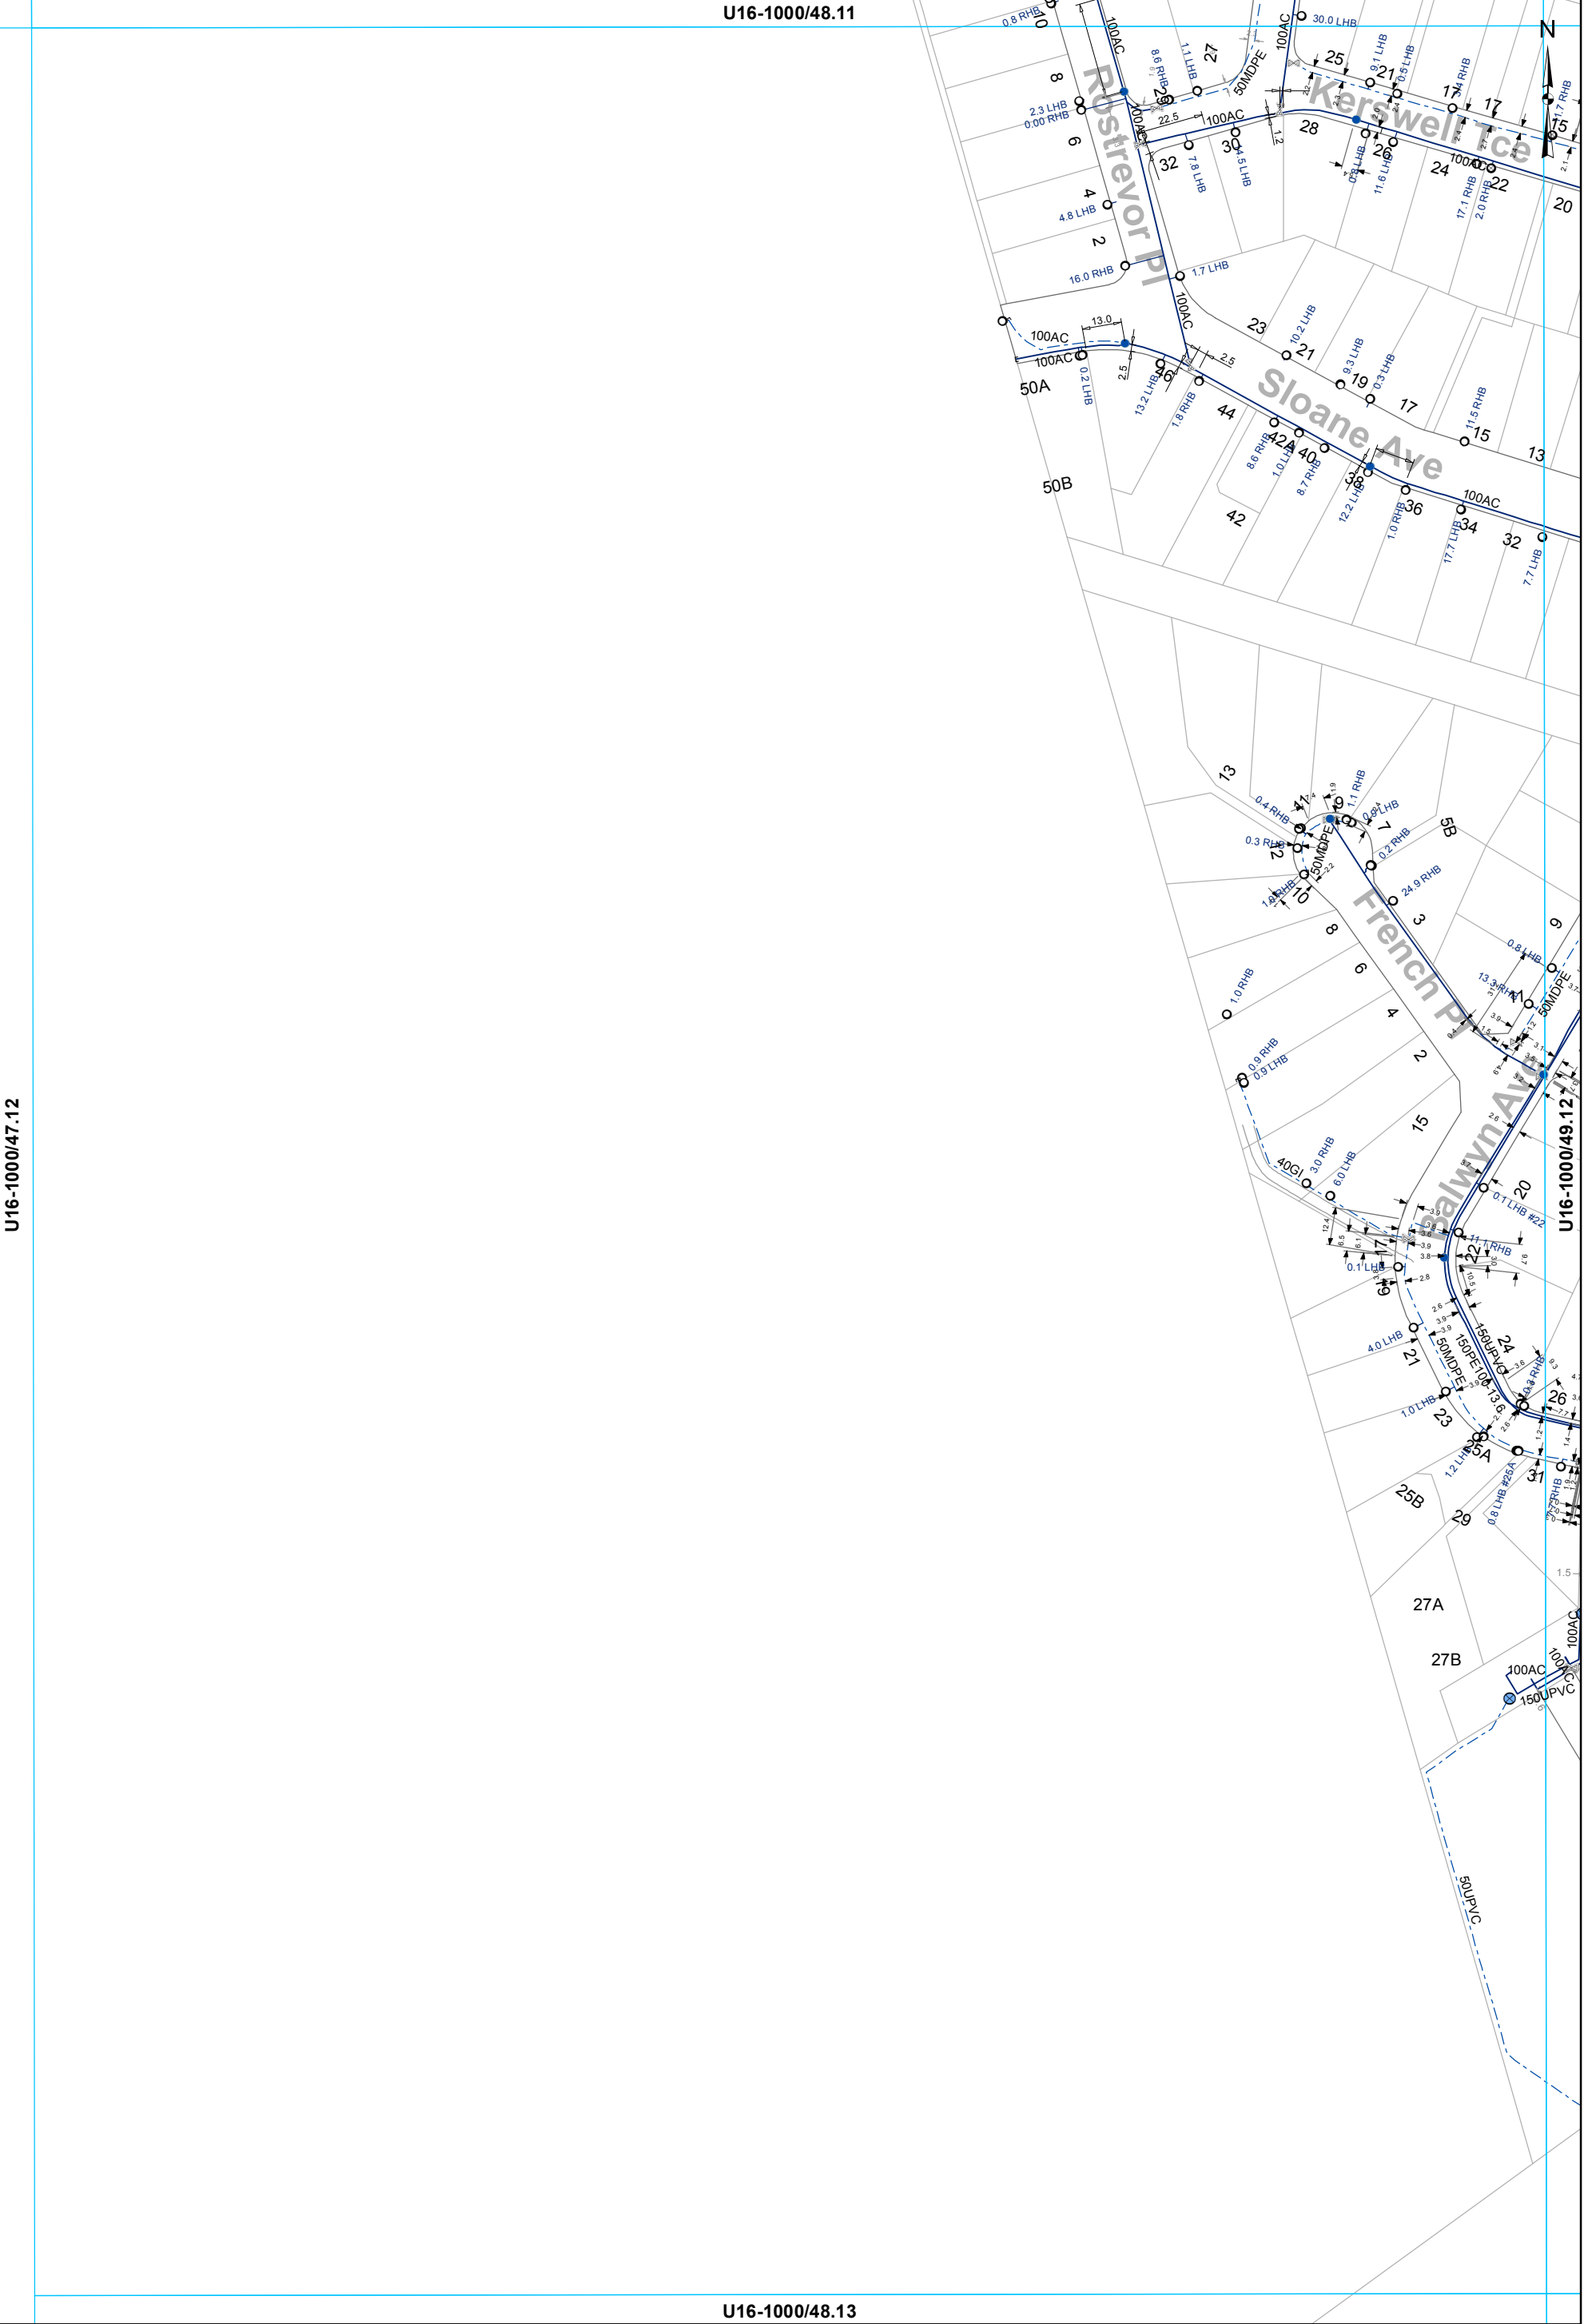

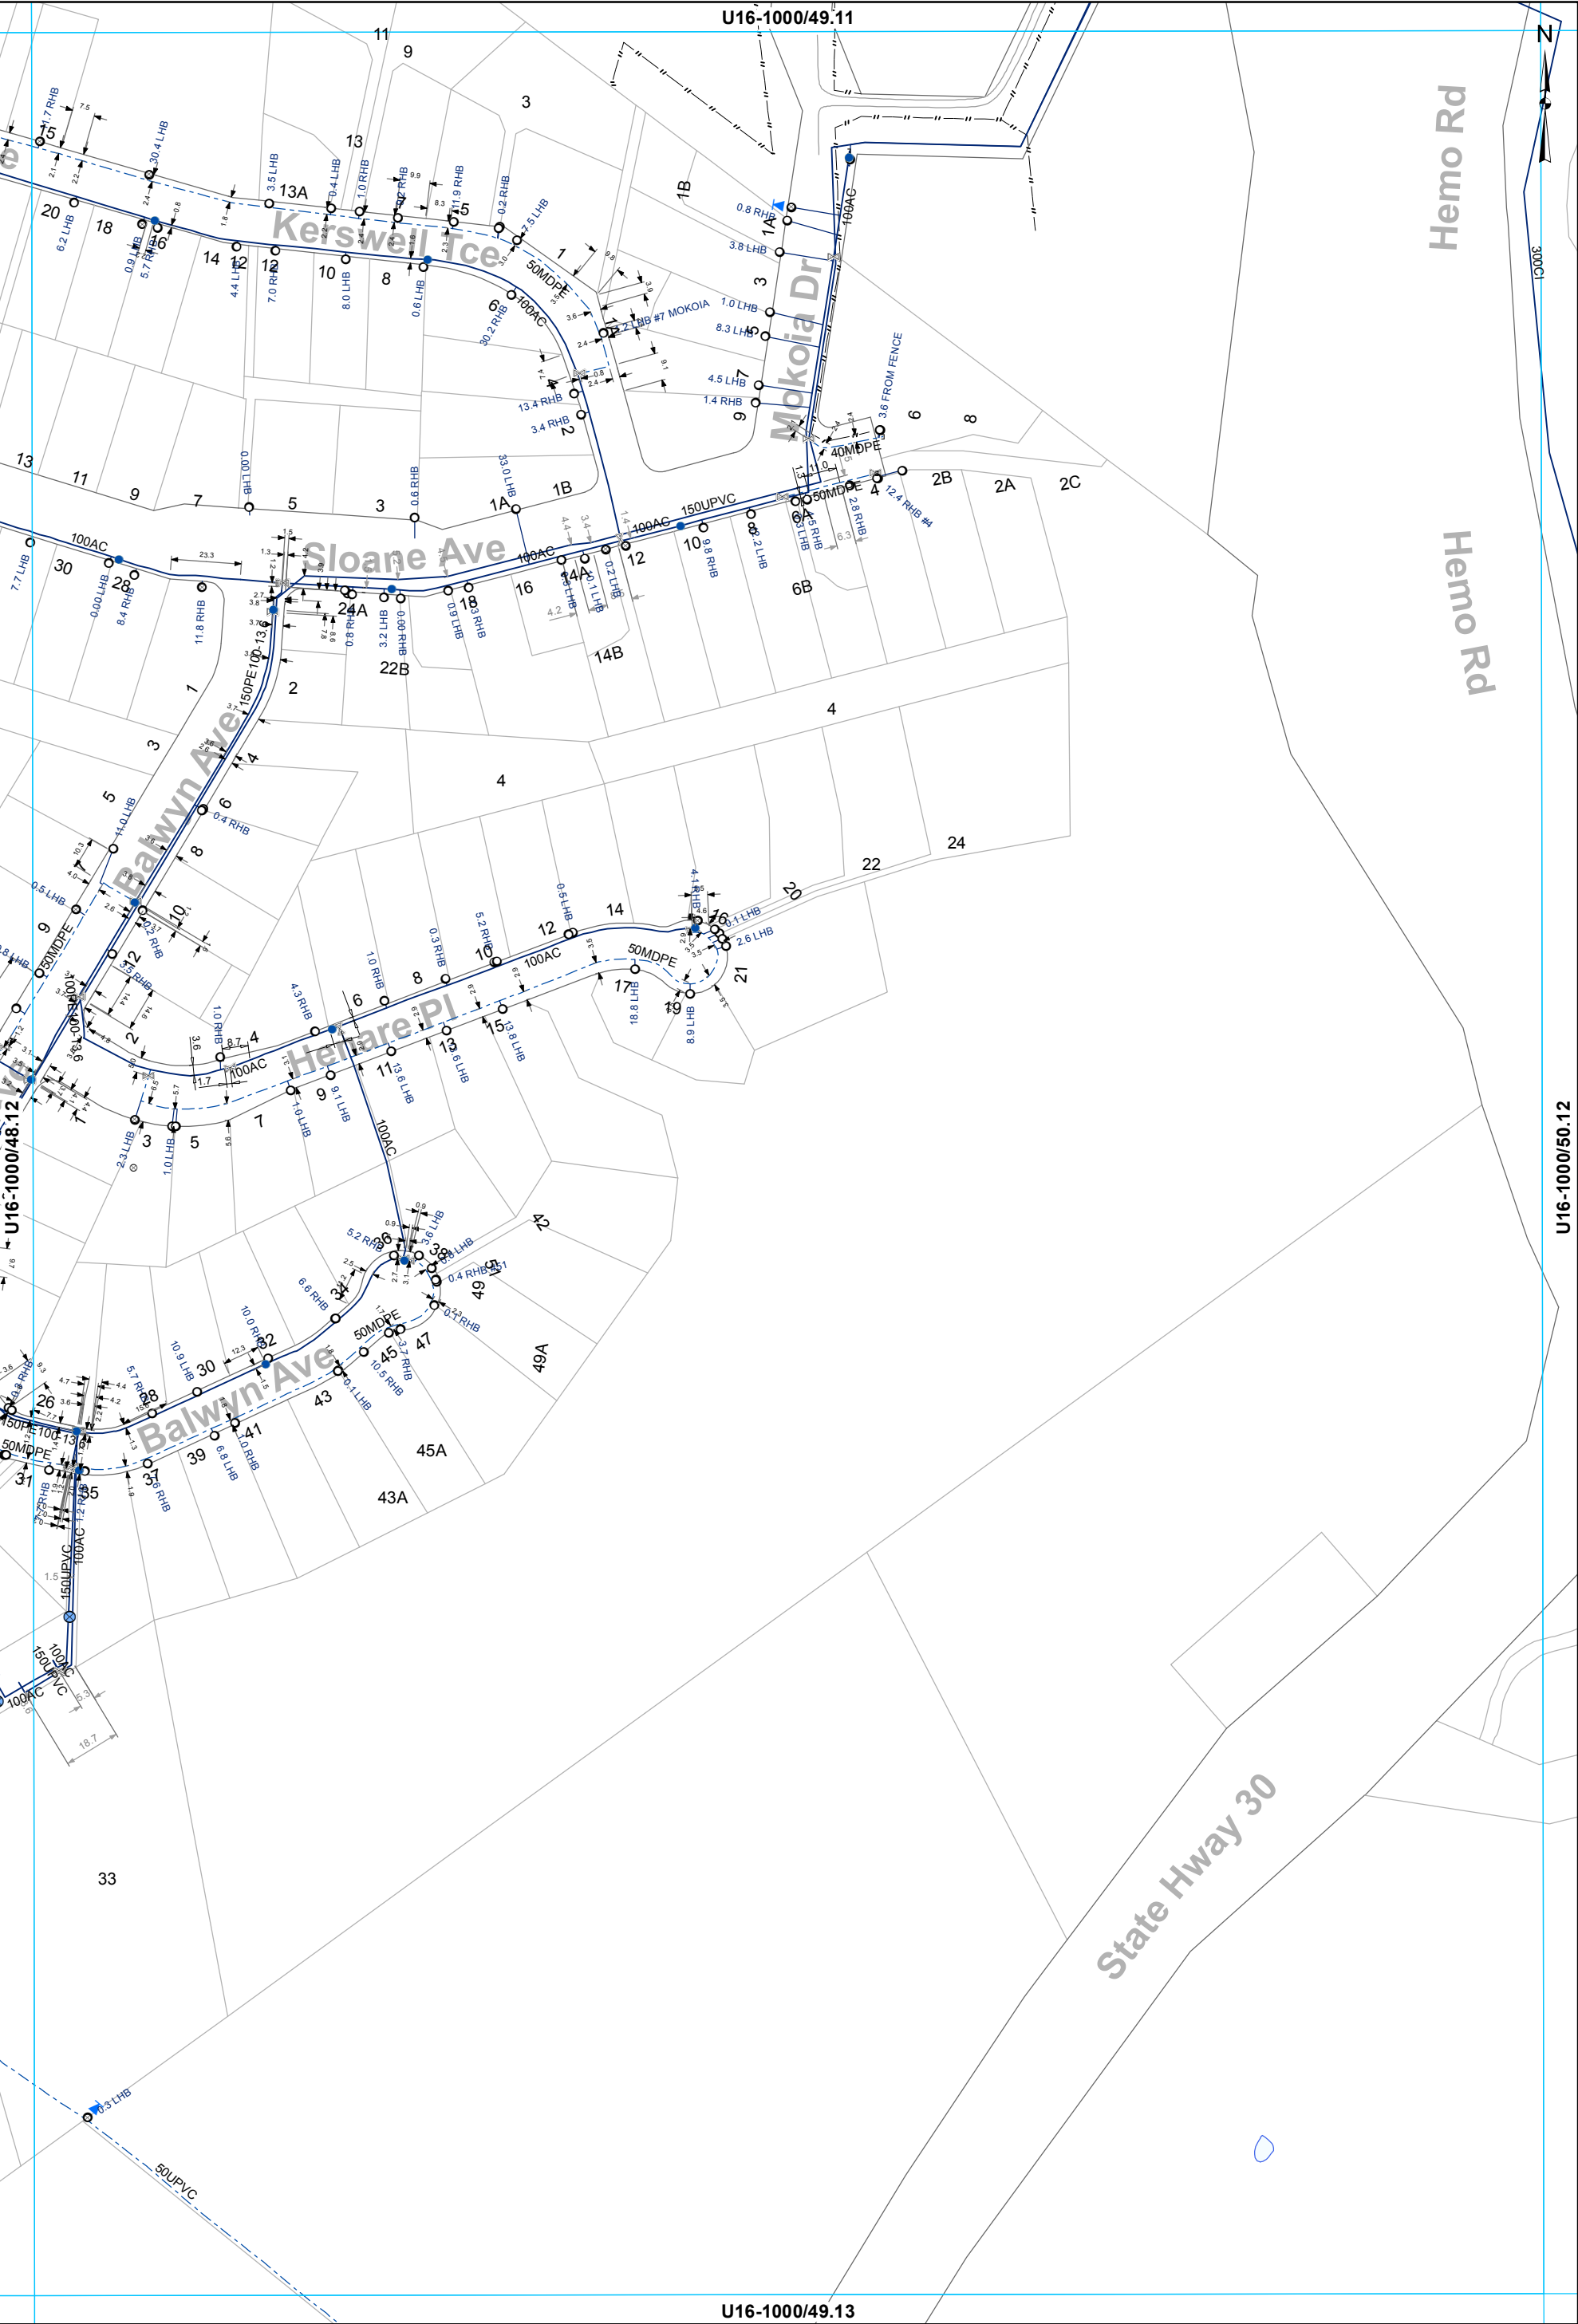



- | | | | |
|-------|---------|----------------|---------------|
| Valve | Hydrant | Meter Bulk | WSServiceLine |
| Toby | | Meter Consumer | Main |
| | | Capped End | Rider main |

WATER SUPPLY SERVICES
1:2000 @ A3 - (U16-1000/49.12)

This data is derived from sources outside the control of Rotorua District Council and is for information only

Rotorua District Council 2006. Facsimile 07 346 3143 Telephone 07 348 4199 email mail@rdc.govt.nz

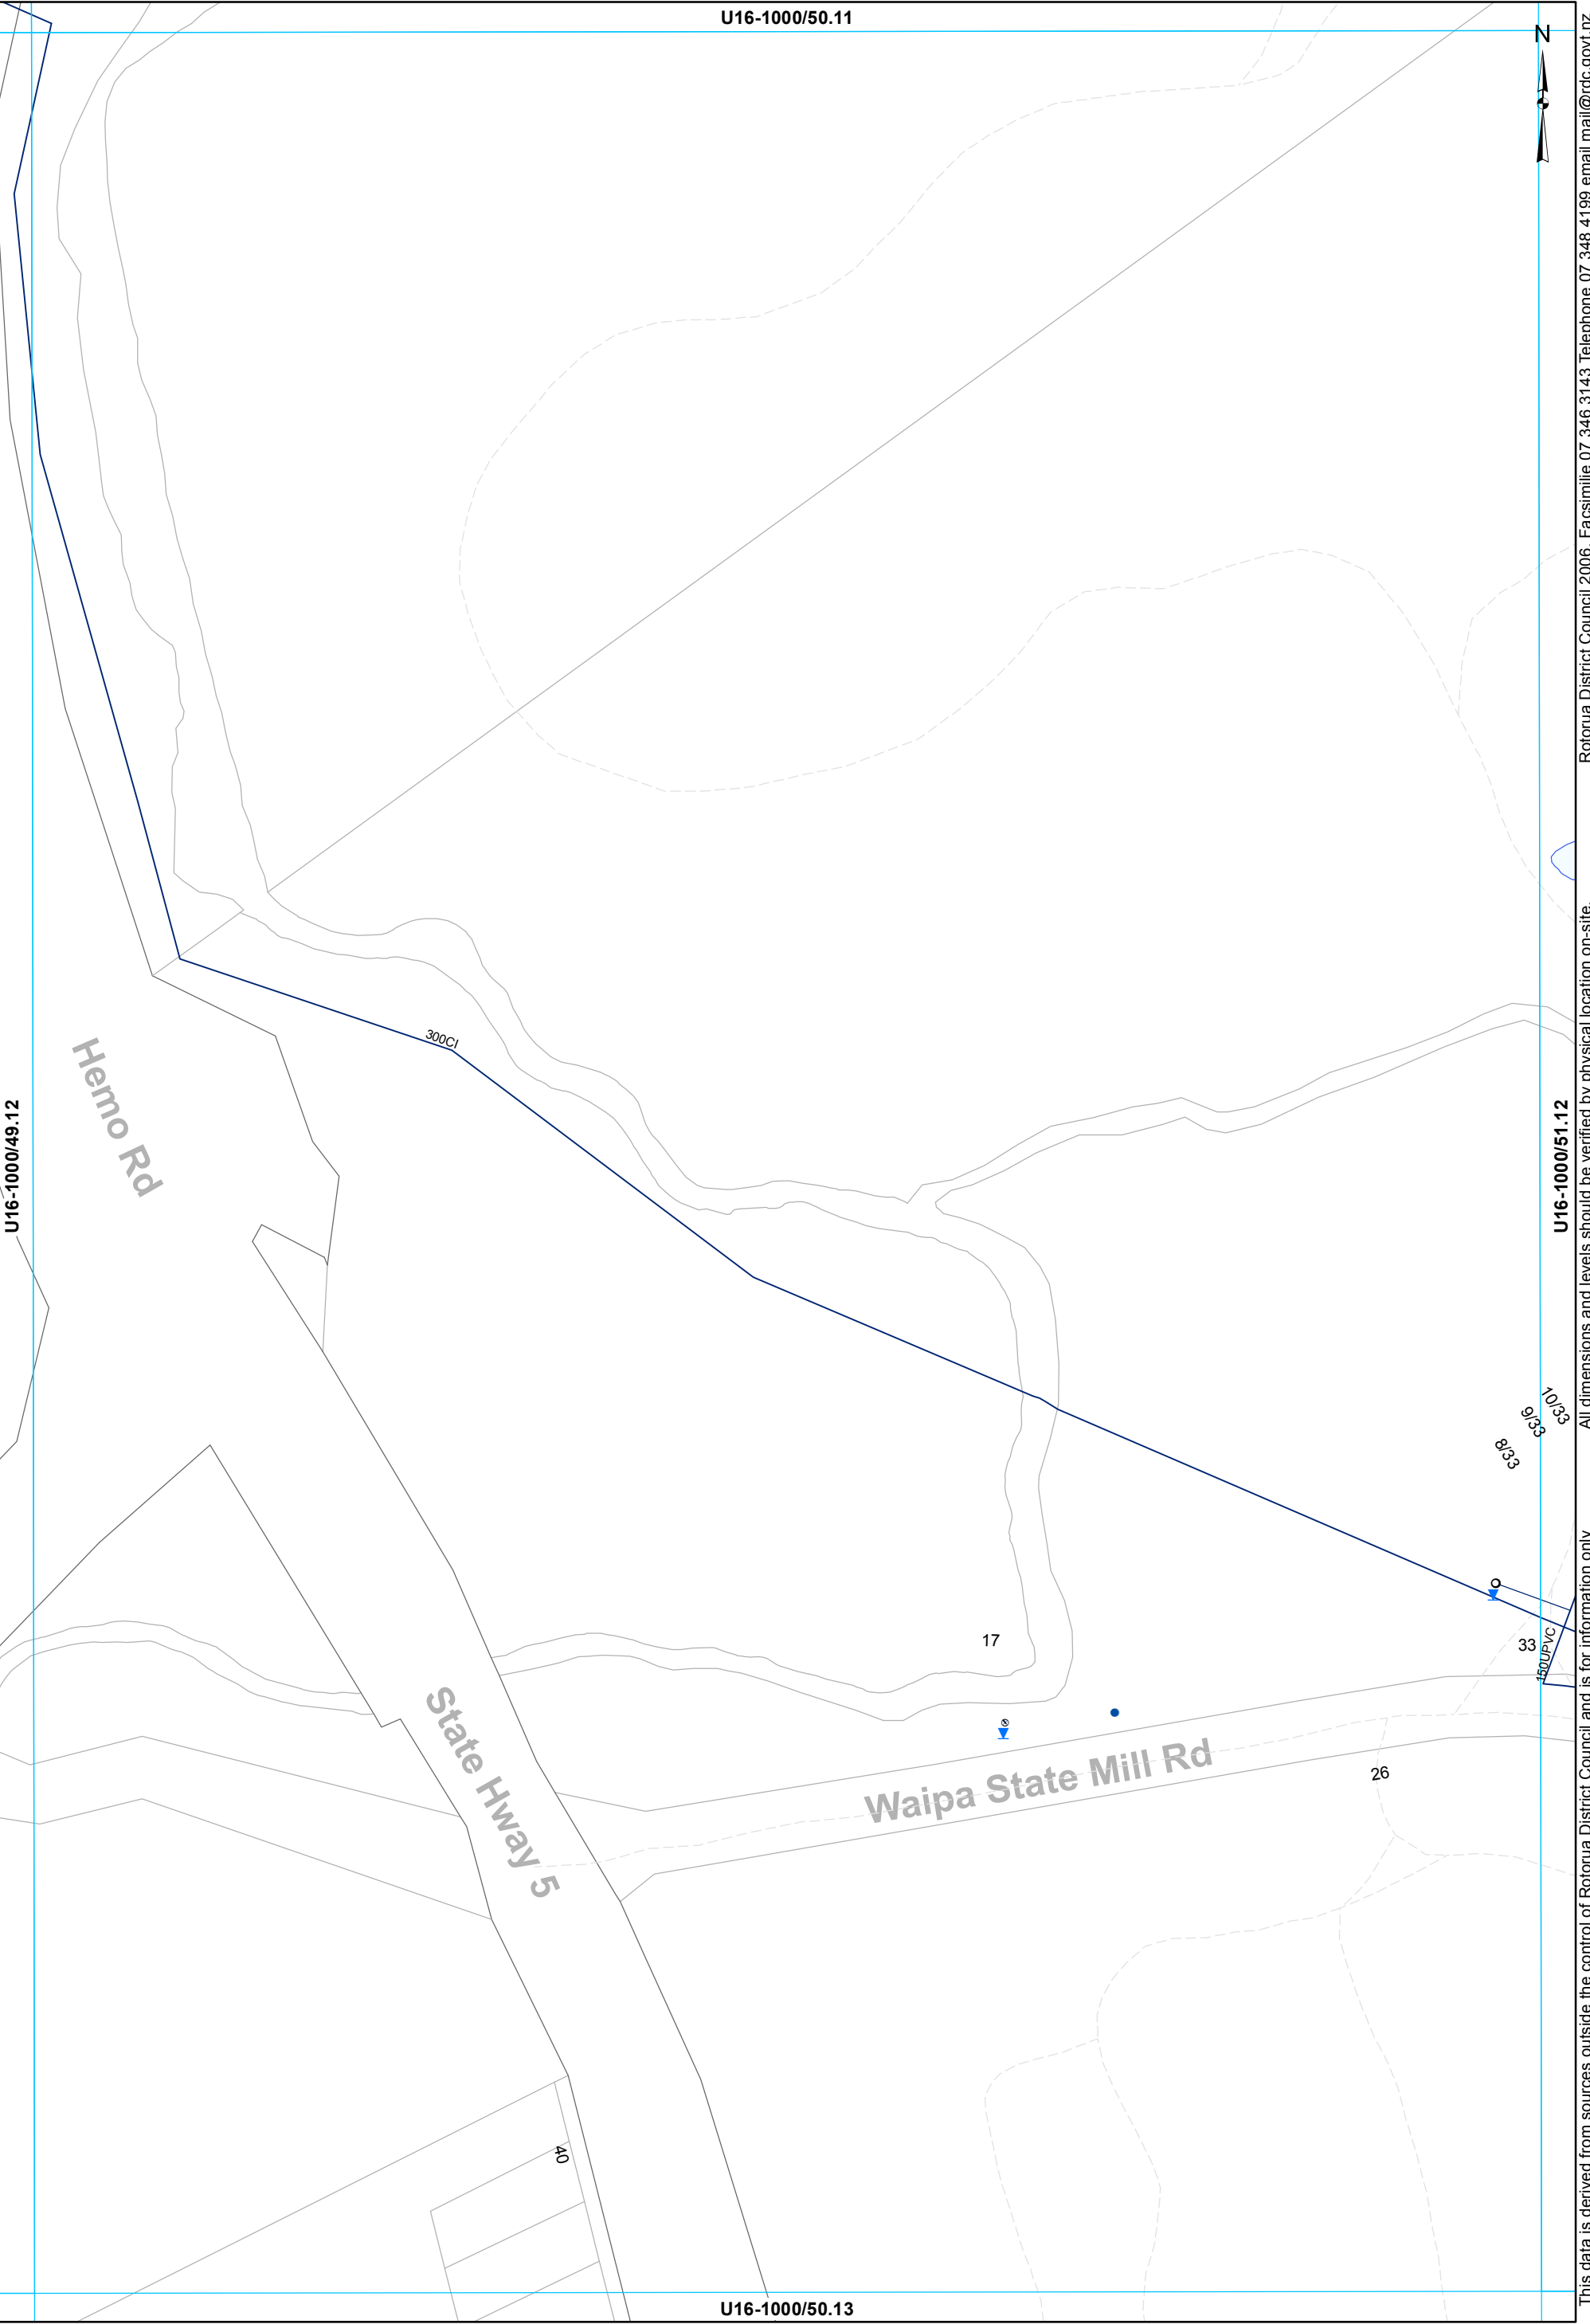

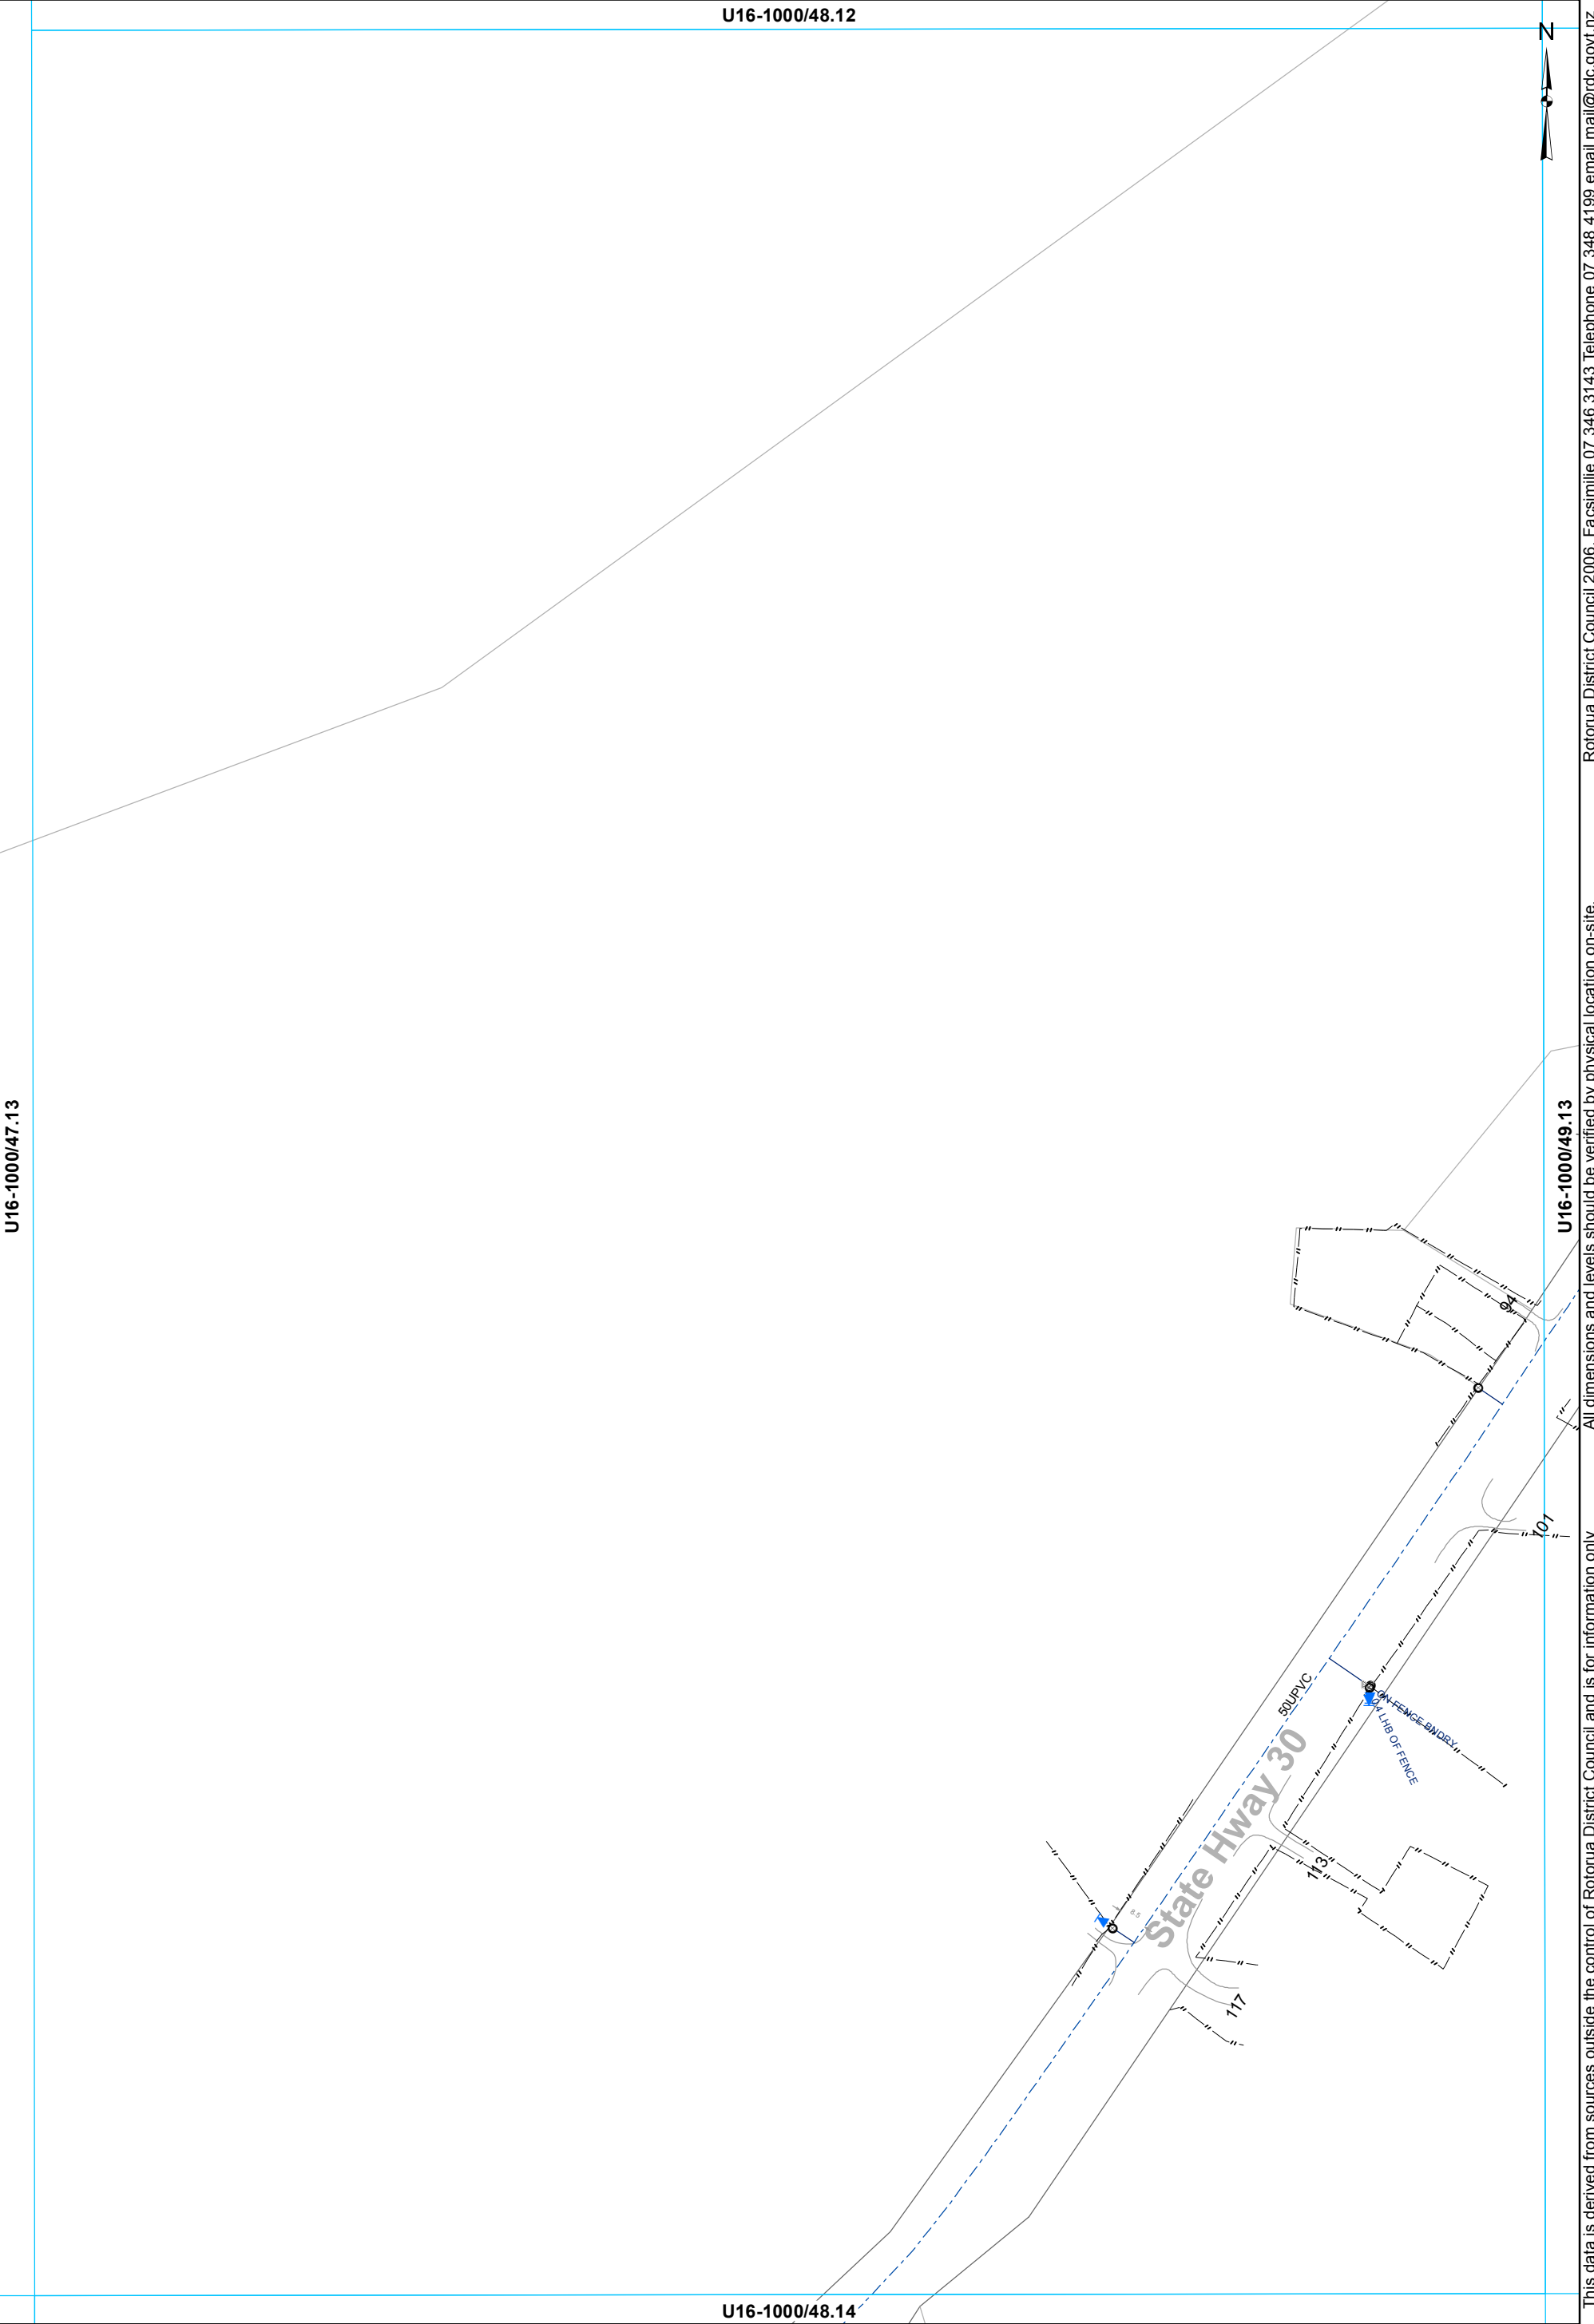

⌵

Valve

⊙

Meter Consumer

—

WSServiceLine


○

Toby

- - -

Rider main

WATER SUPPLY SERVICES
1:2000 @ A3 - (U16-1000/48.13)

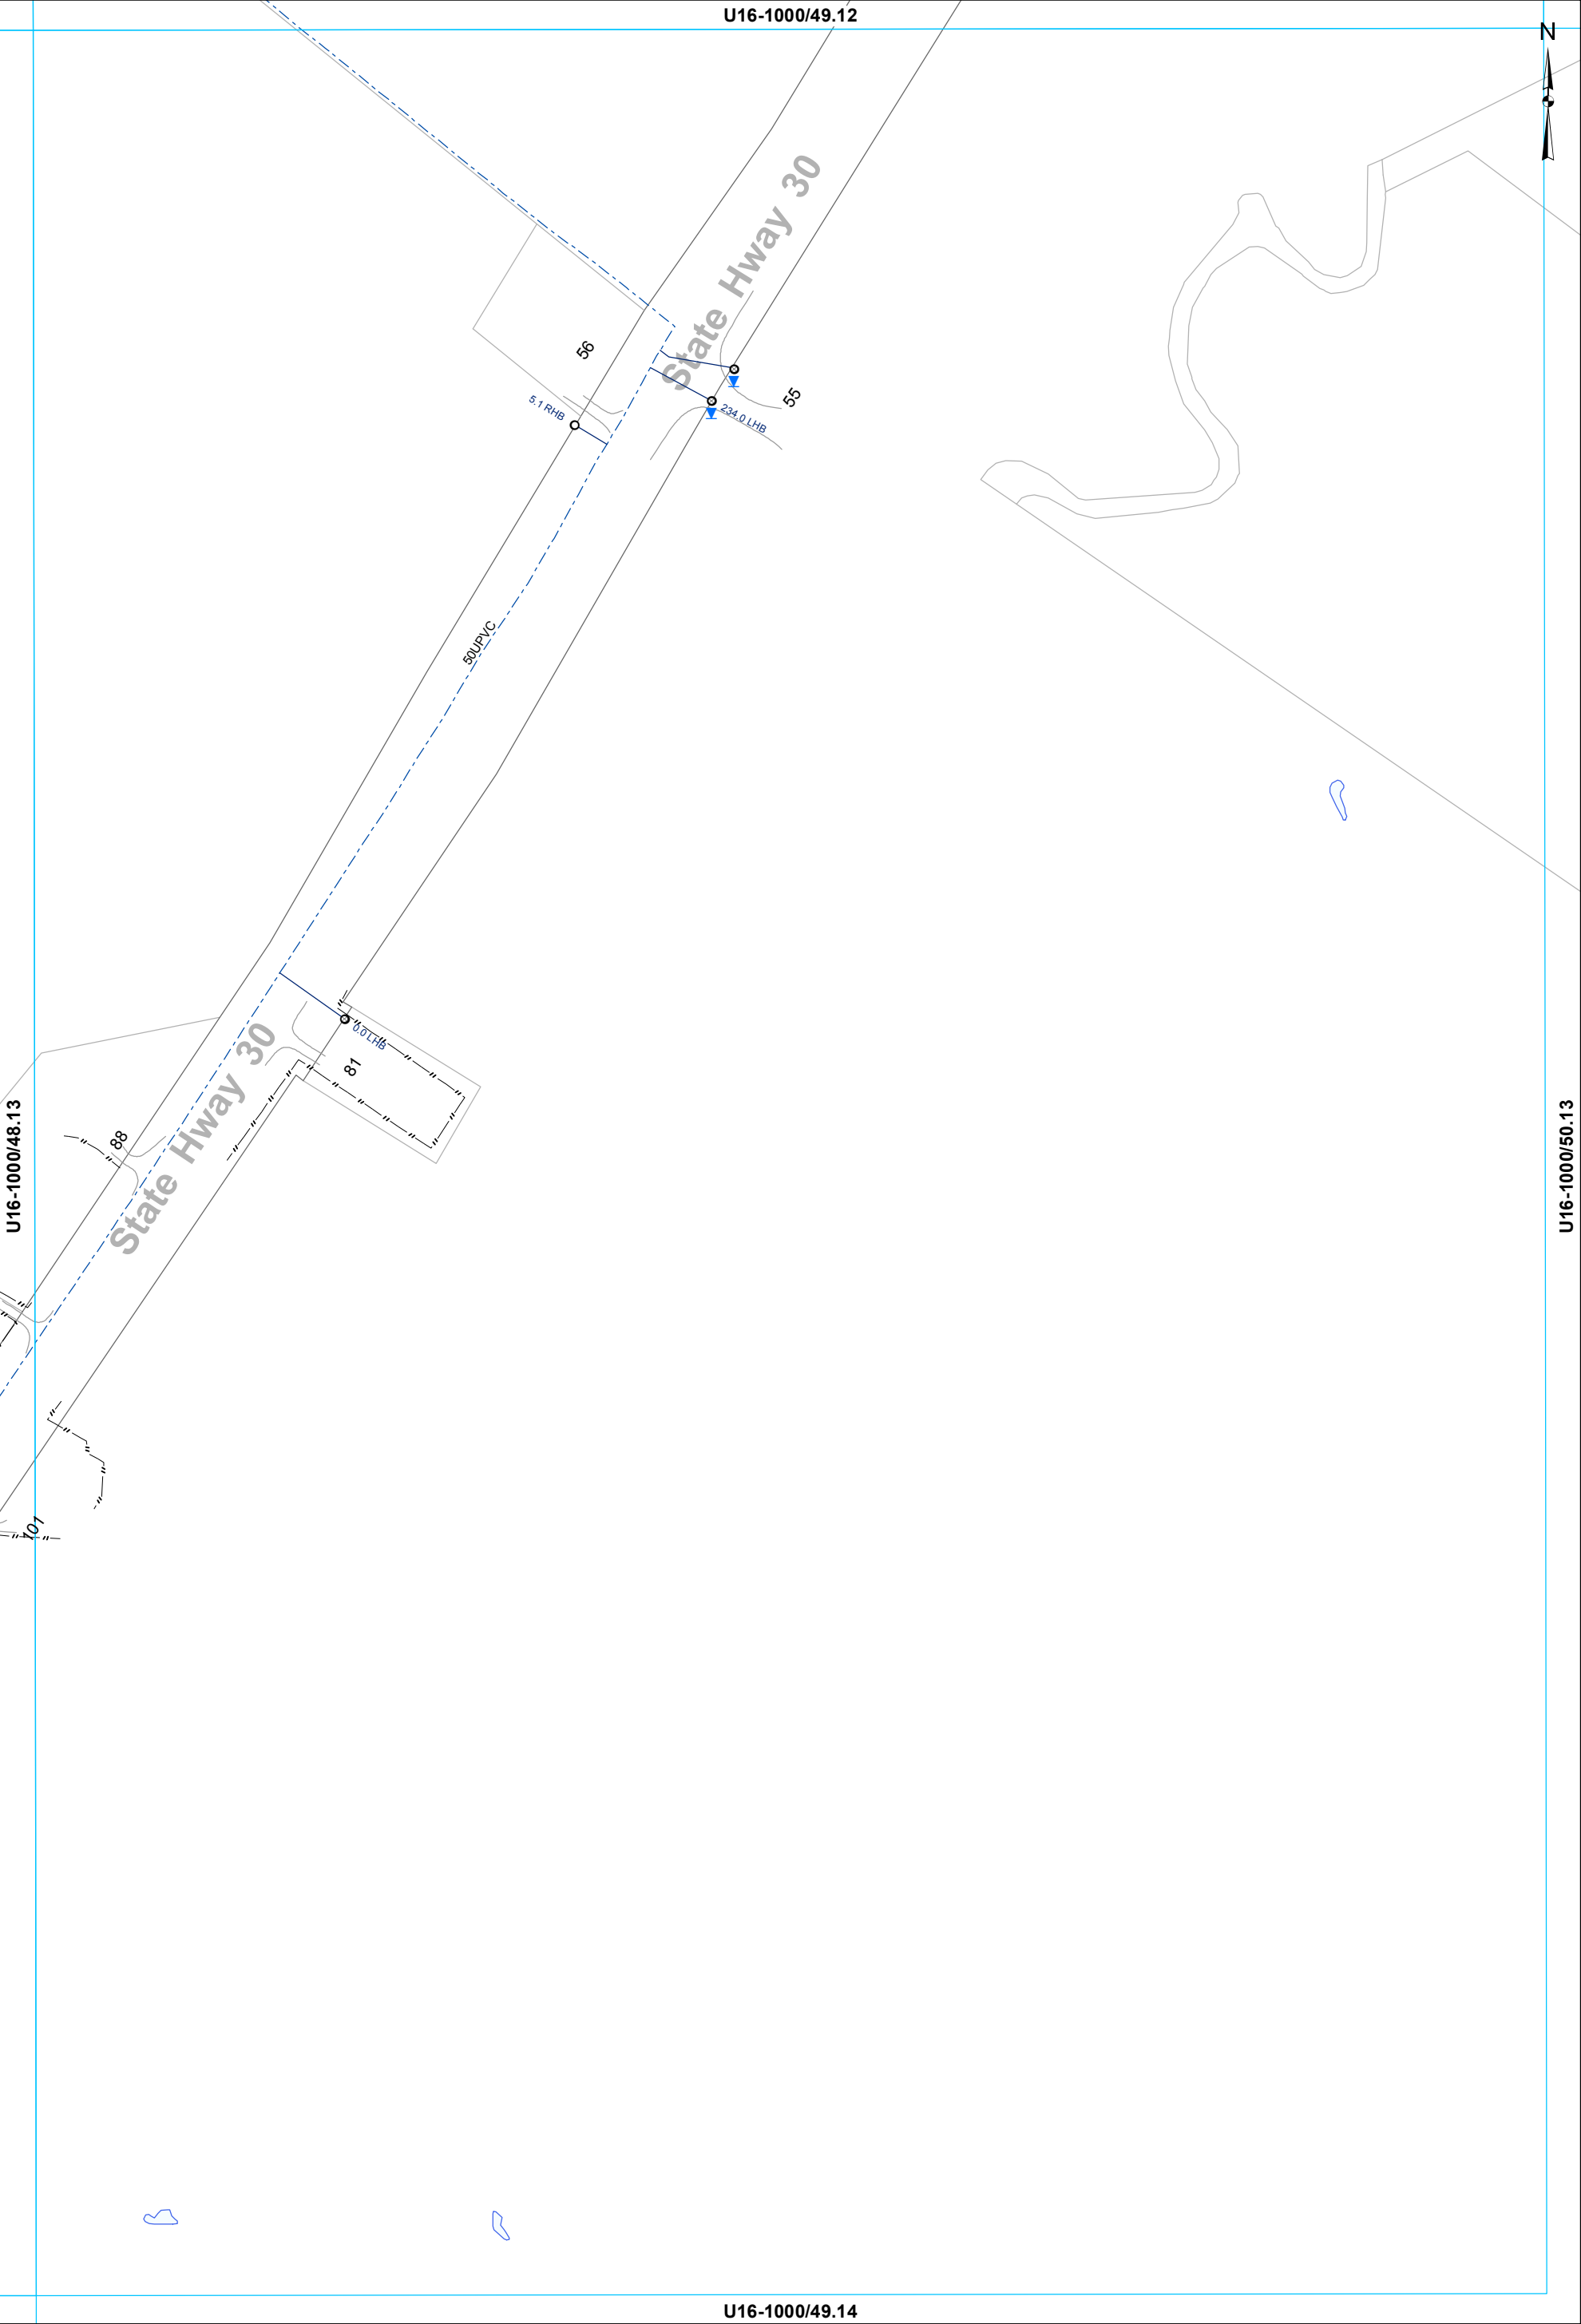


○ Toby ◉ Meter Consumer — WSServiceLine
 --- Rider main

WATER SUPPLY SERVICES
1:2000 @ A3 - (U16-1000/49.13)

This data is derived from sources outside the control of Rotorua District Council and is for information only

Rotorua District Council 2006. Facsimile 07 346 3143 Telephone 07 348 4199 email mail@rdc.govt.nz

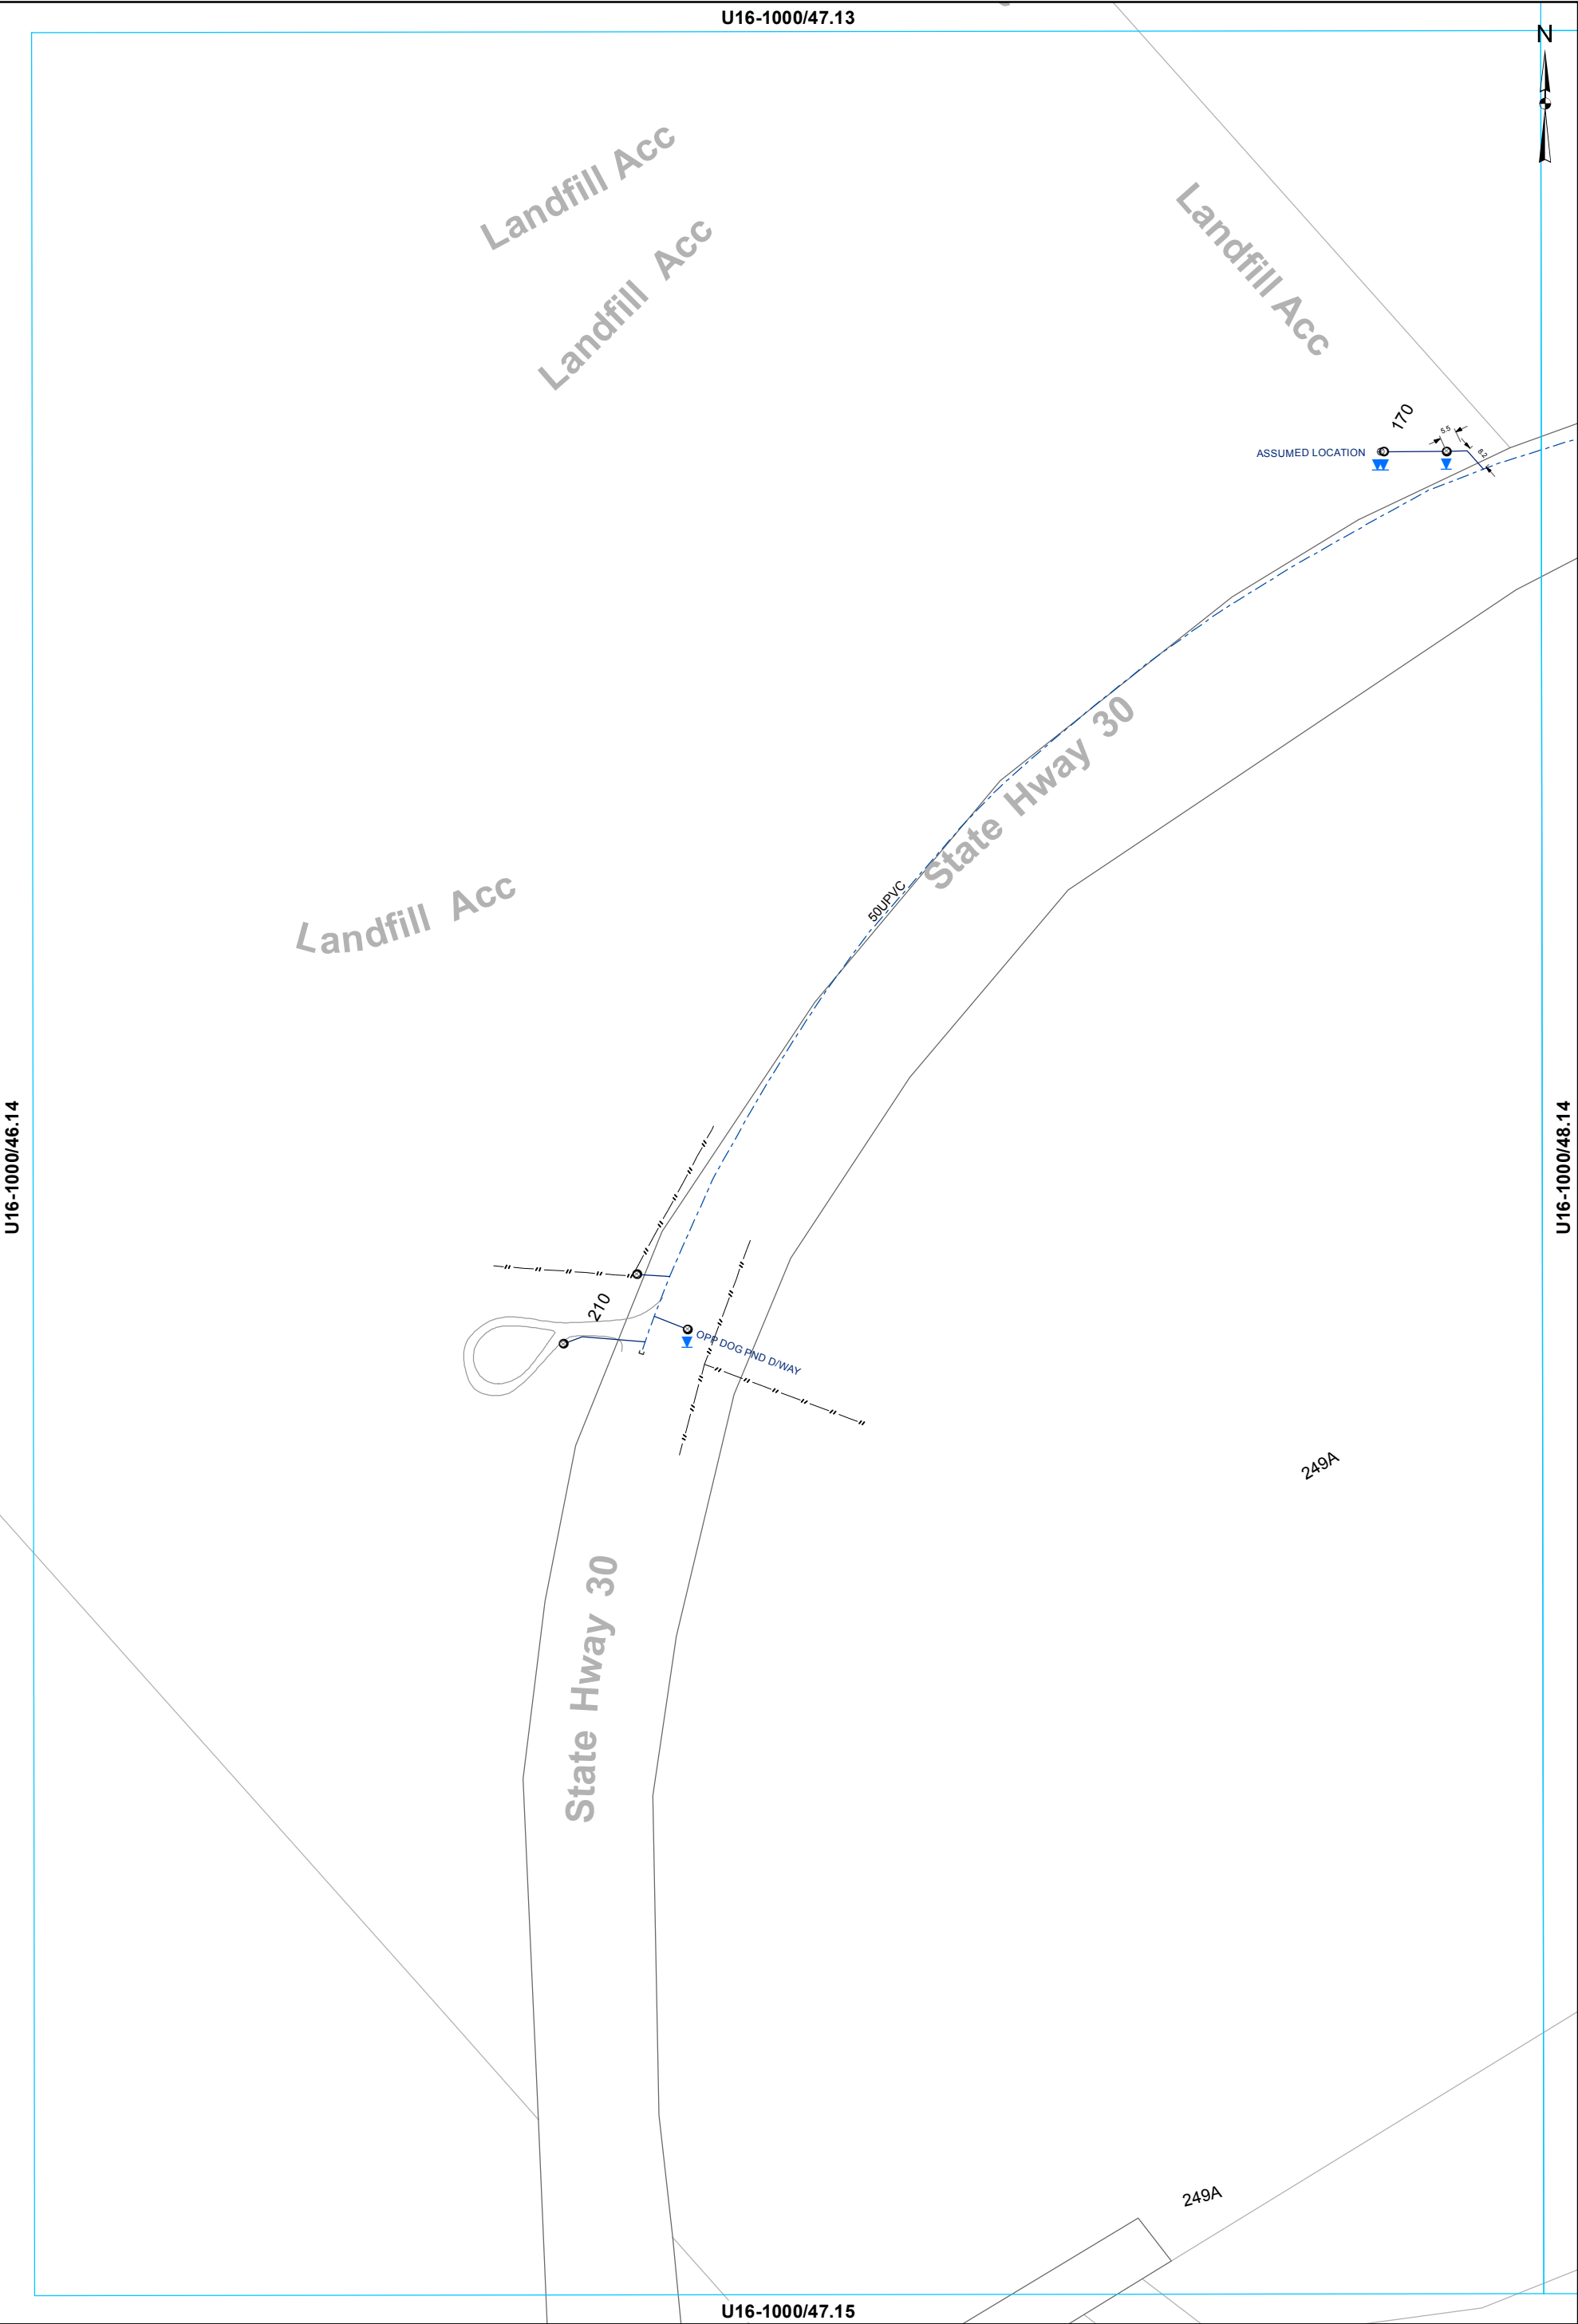

- Toby

⊙ Meter Consumer


⌒ Capped End
- WSServiceLine

- - - Rider main

WATER SUPPLY SERVICES
1:2000 @ A3 - (U16-1000/47.14)

This data is derived from sources outside the control of Rotorua District Council and is for information only

Rotorua District Council 2006. Facsimile 07 346 3143 Telephone 07 348 4199 email mail@rdc.govt.nz

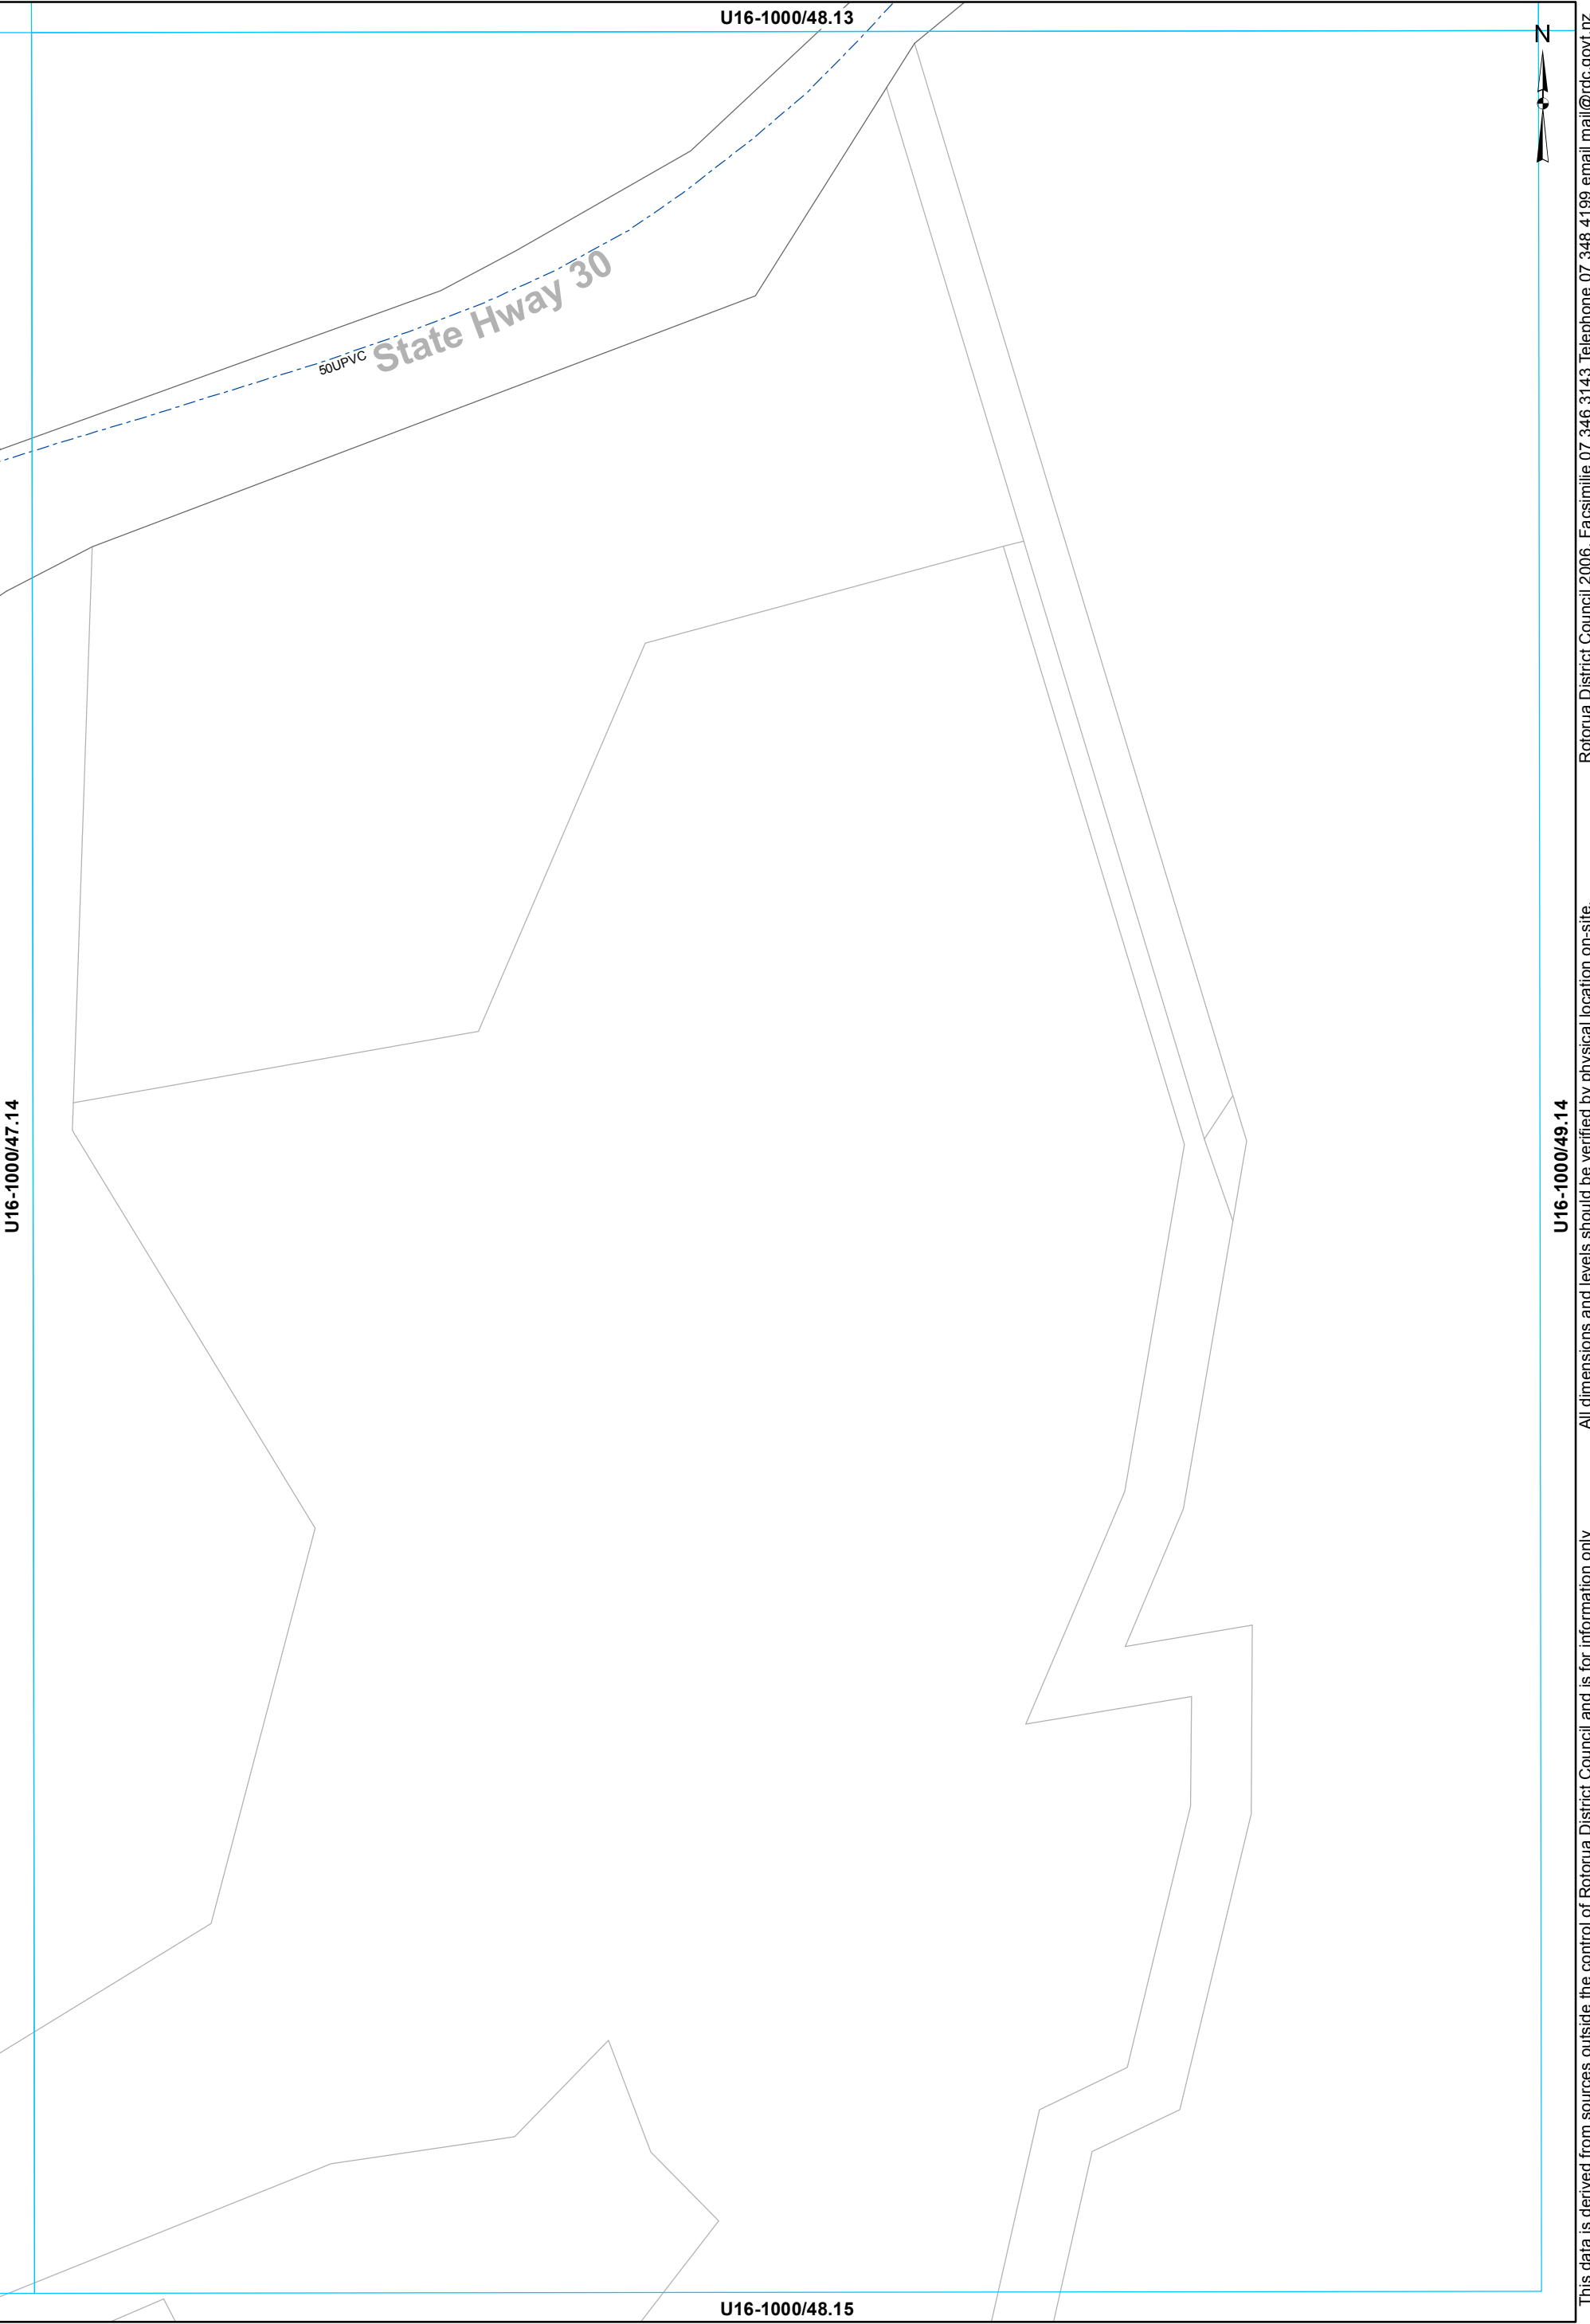

--- Rider main