

Waste Water Asbuilt Sheet Index
BRUNSWICK_ROTOKAWA

Date: 5/2/2023



U15-1000/64.35



U15-1000/63.36

Lake Rotorua

U15-1000/65.36

All dimensions and levels should be verified by physical location on-site.


This data is derived from sources outside the control of Rotorua District Council and is for information only

Rotorua District Council 2006. Facsimile 07 346 3143 Telephone 07 348 4199 email mail@rdc.govt.nz


U15-1000/64.37

- Manhole
- Main line
- Service Line

WASTEWATER SERVICES
1:2000 @ A3 - (U15-1000/64.36)

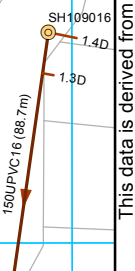

U15-1000/65.35

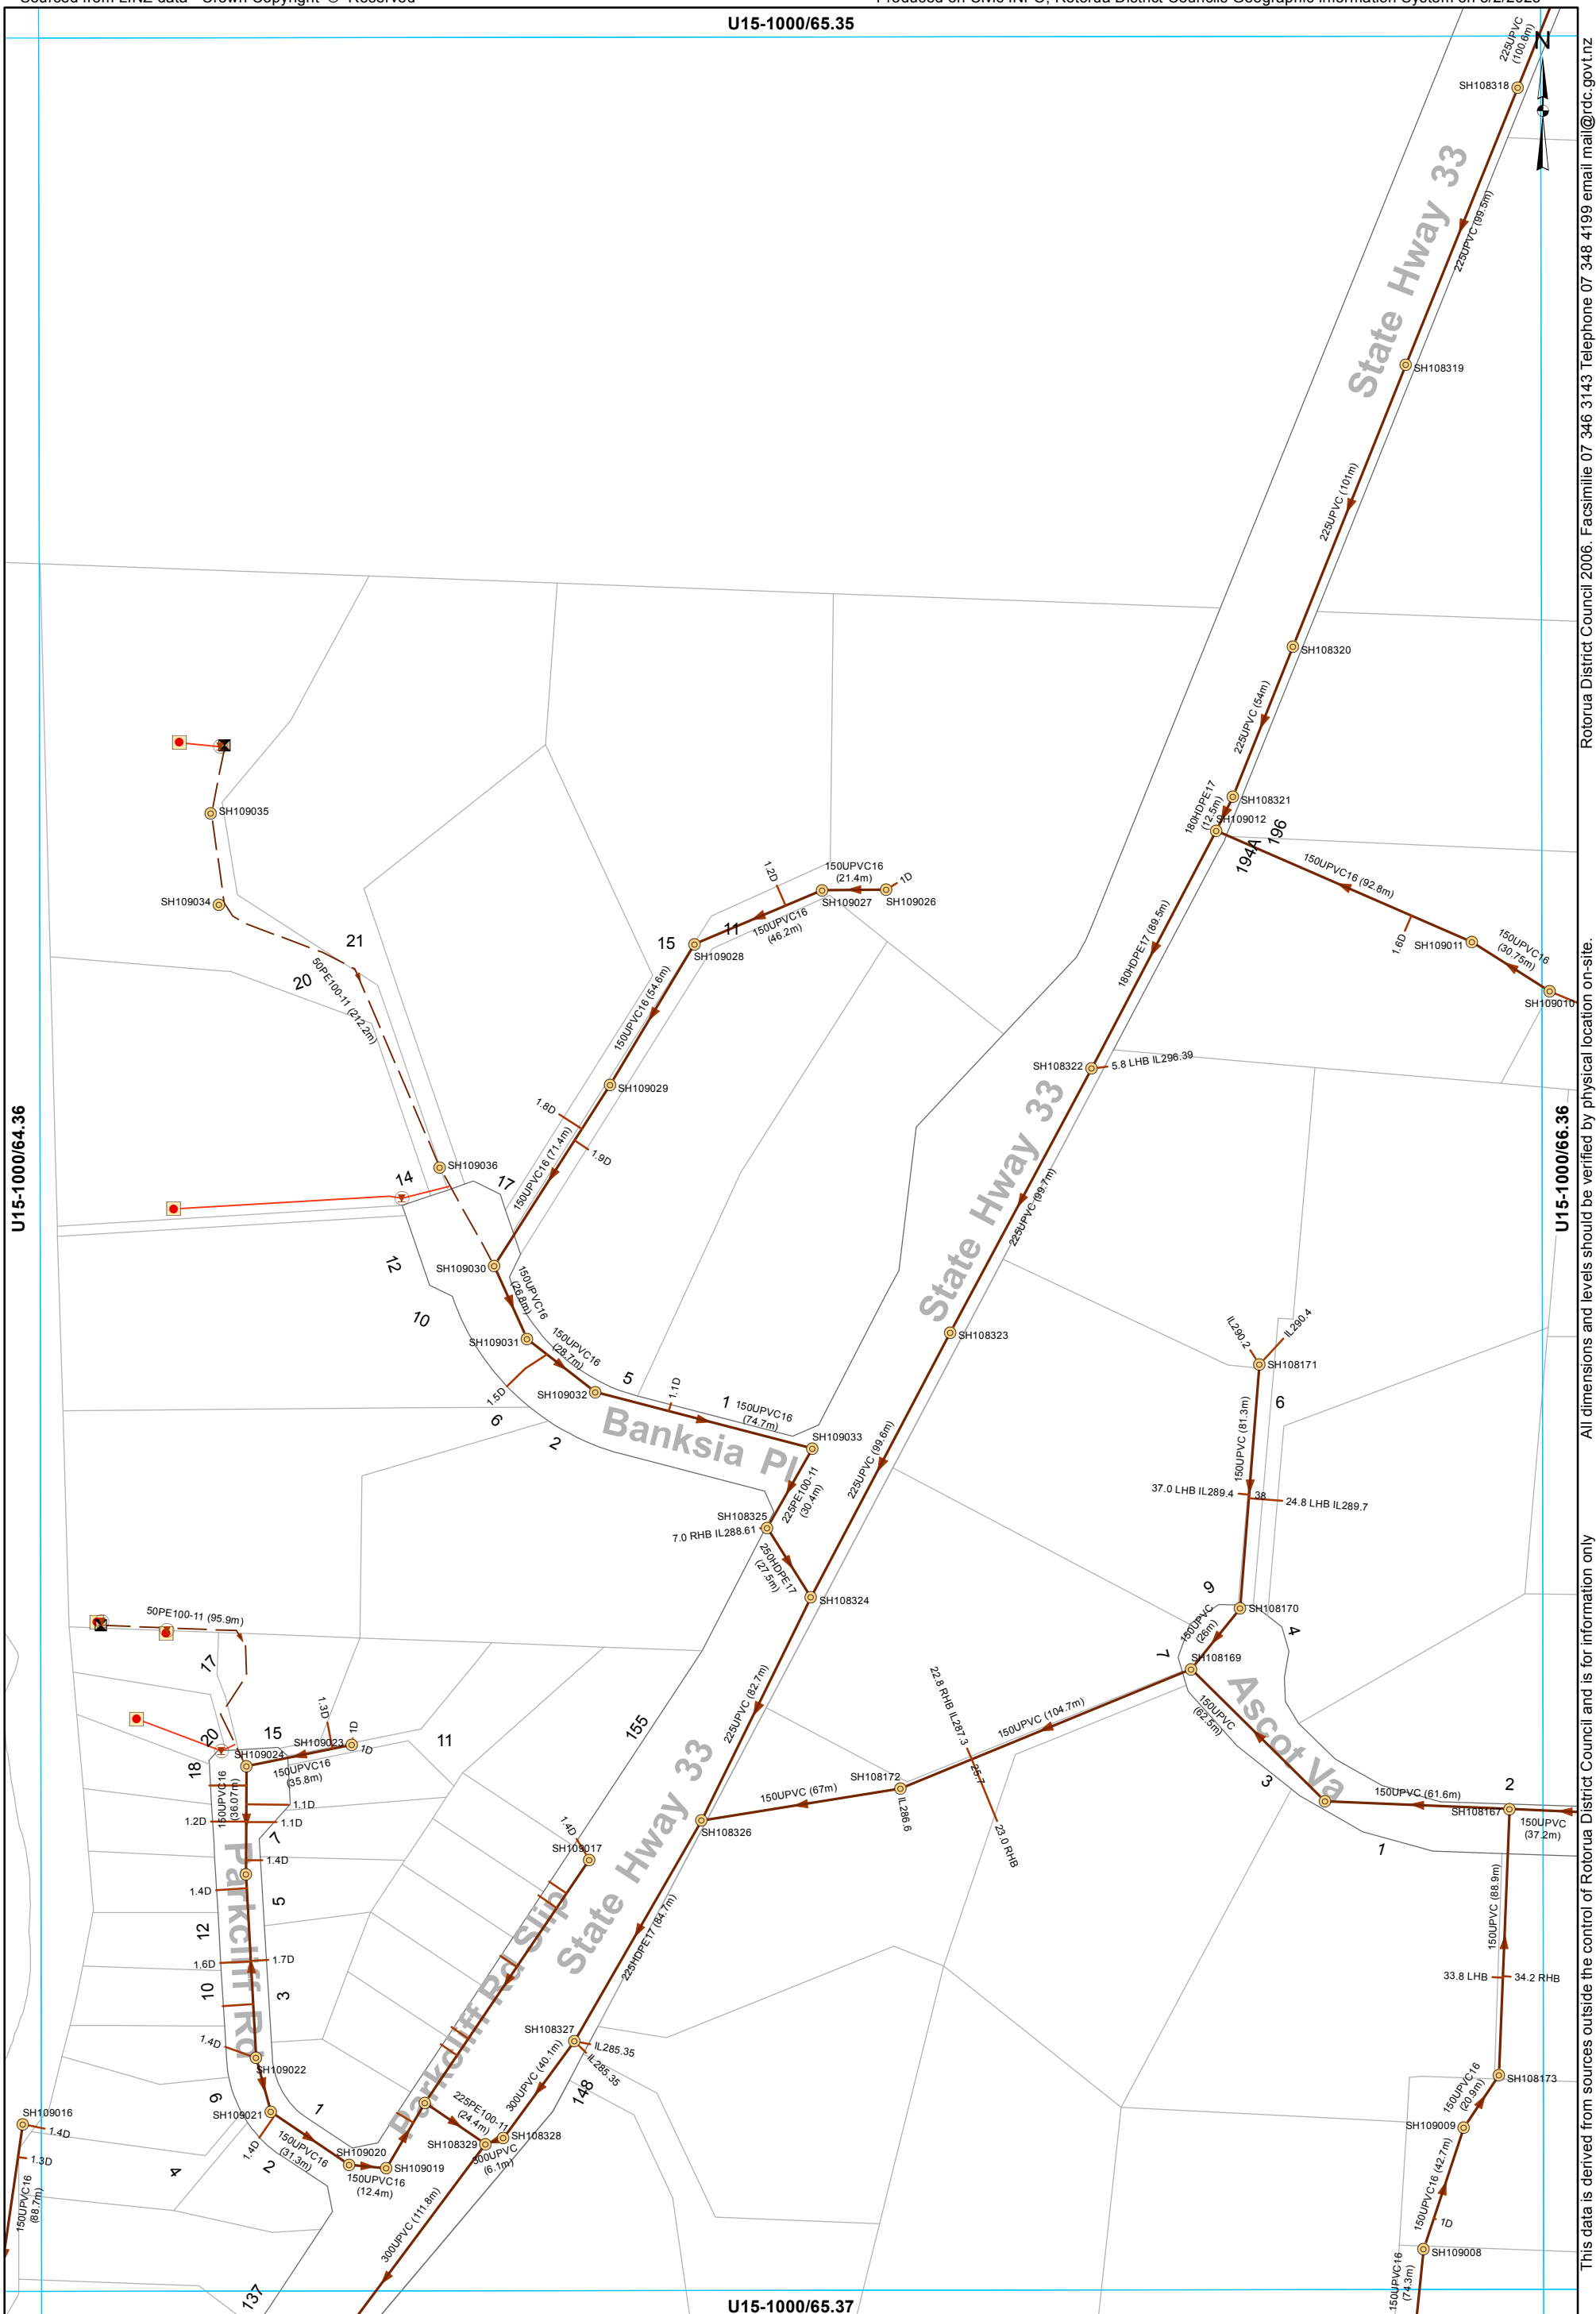

U15-1000/64.36

U15-1000/66.36

U15-1000/65.37

- Manhole
- Grinder Pump Chamber
- LP Grinder Pump
- ▣ Boundary Assembly
- ▣ Clean Out Point
- Low Pressure Main
- Main line
- Service Line
- LPGA Service Line

WASTEWATER SERVICES
1:2000 @ A3 - (U15-1000/65.36)

This data is derived from sources outside the control of Rotorua District Council and is for information only


Rotorua District Council 2006. Facsimile 07 346 3143 Telephone 07 348 4199 email mail@rdc.govt.nz

U15-1000/66.35



248A

248B

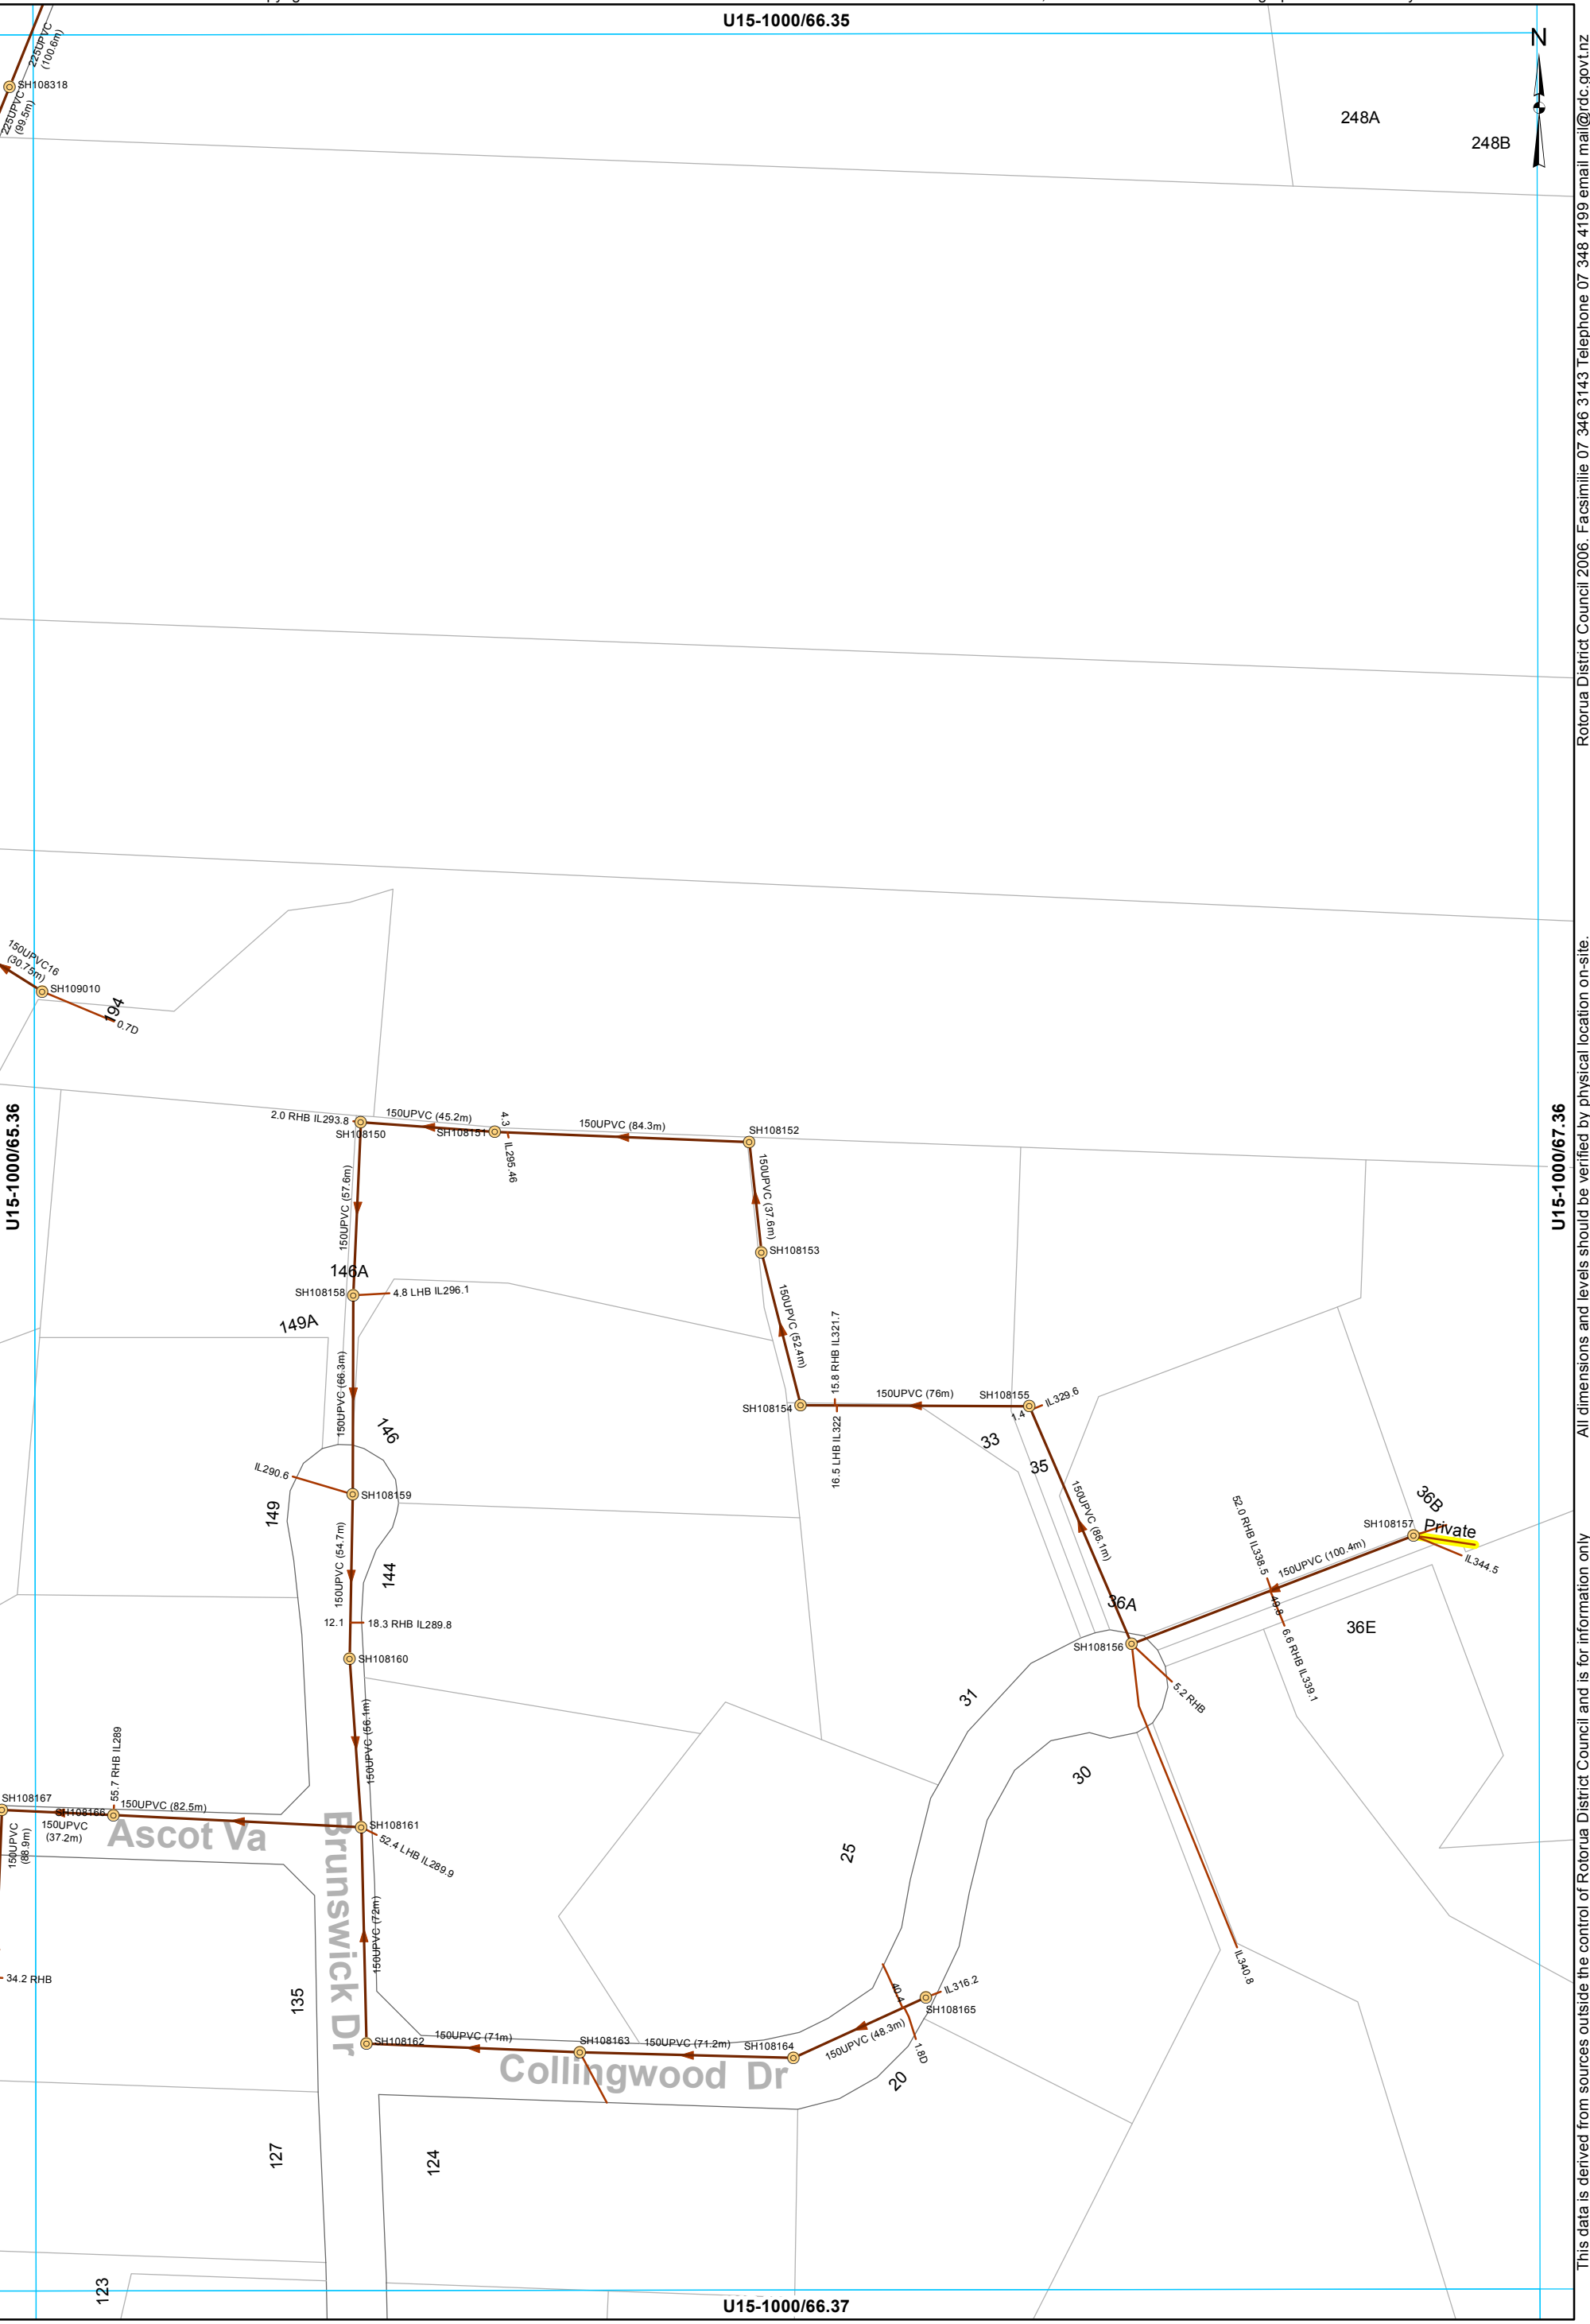

U15-1000/65.36

U15-1000/67.36

U15-1000/66.37

- Manhole
- Main line
- Private Asset
- Service Line

WASTEWATER SERVICES
1:2000 @ A3 - (U15-1000/66.36)

Rotorua District Council 2006. Facsimile 07 346 3143 Telephone 07 348 4199 email mail@rdc.govt.nz
All dimensions and levels should be verified by physical location on-site.
This data is derived from sources outside the control of Rotorua District Council and is for information only







U15-1000/64.36

U15-1000/63.37


Lake Rotorua

U15-1000/64.38

U15-1000/65.37


-  Manhole
-  Pump Station
-  Main line
-  Rising main
-  Service Line
-  LPGP Service Line

WASTEWATER SERVICES
1:2000 @ A3 - (U15-1000/64.37)

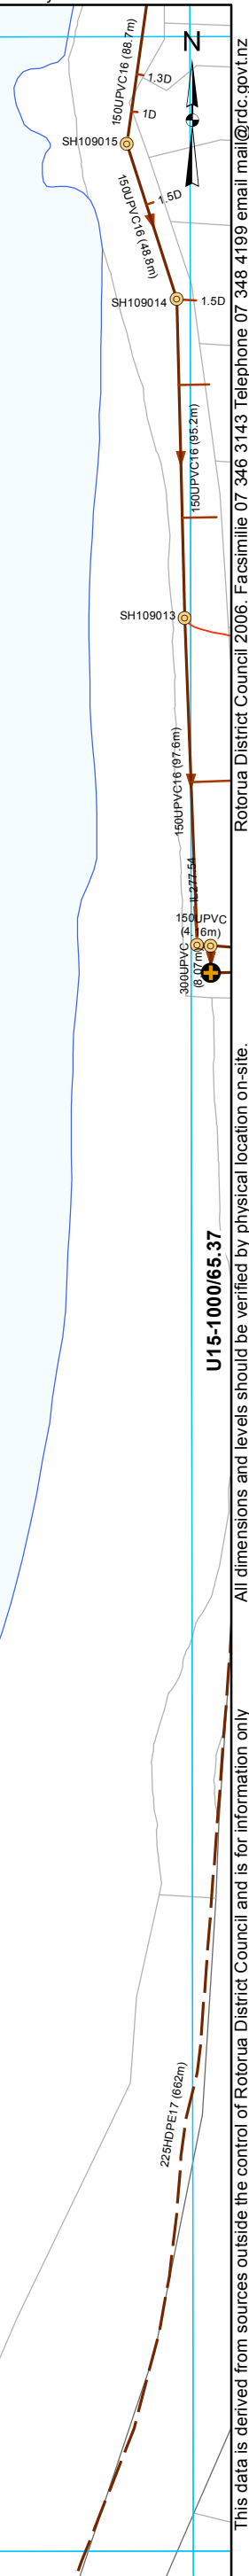

This data is derived from sources outside the control of Rotorua District Council and is for information only

Rotorua District Council 2006. Facsimile 07 346 3143 Telephone 07 348 4199 email mail@rdc.govt.nz

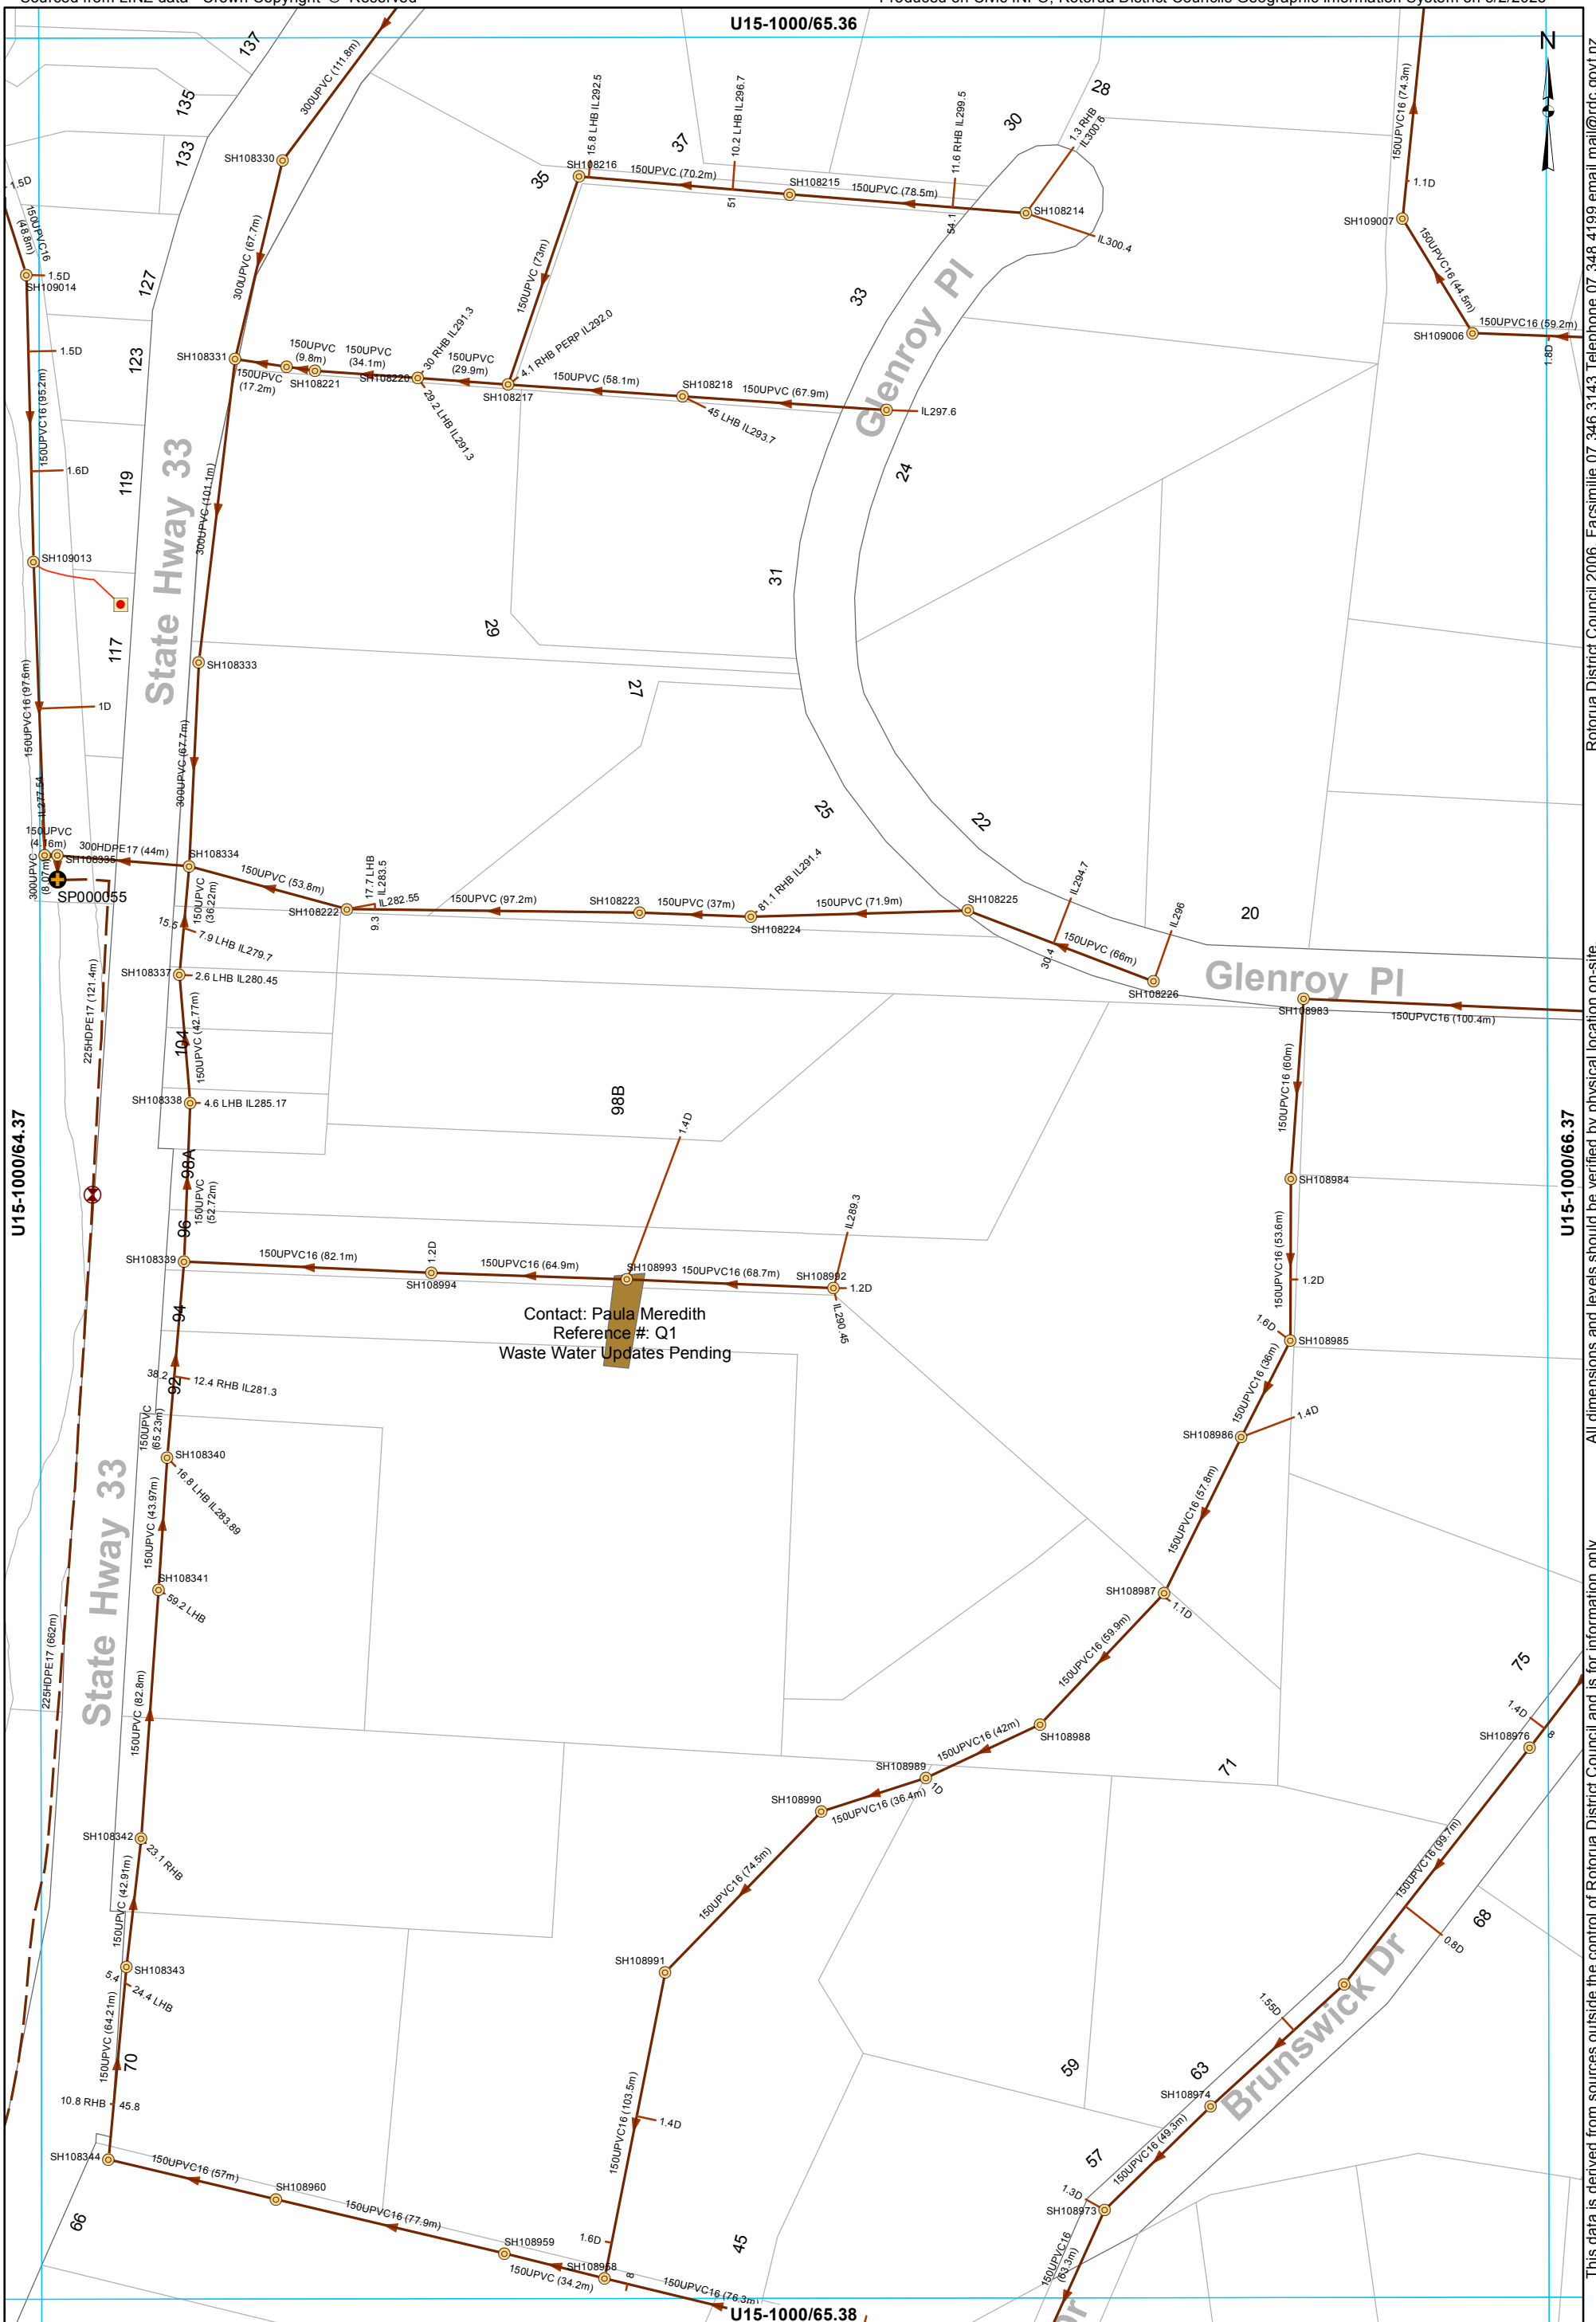


This data is derived from sources outside the control of Rotorua District Council and is for information only. All dimensions and levels should be verified by physical location on-site.

Rotorua District Council 2006. Facsimilie 07 346 3143 Telephone 07 348 4199 email mail@rdc.govt.nz

- Manhole
- ⊕ Pump Station
- Grinder Pump Chamber
- LP Grinder Pump
- Main line
- - - Rising main
- - - Service Line
- - - LPGP Service Line
- ⊗ Air Valve

WASTEWATER SERVICES
1:2000 @ A3 - (U15-1000/65.37)

U15-1000/66.36

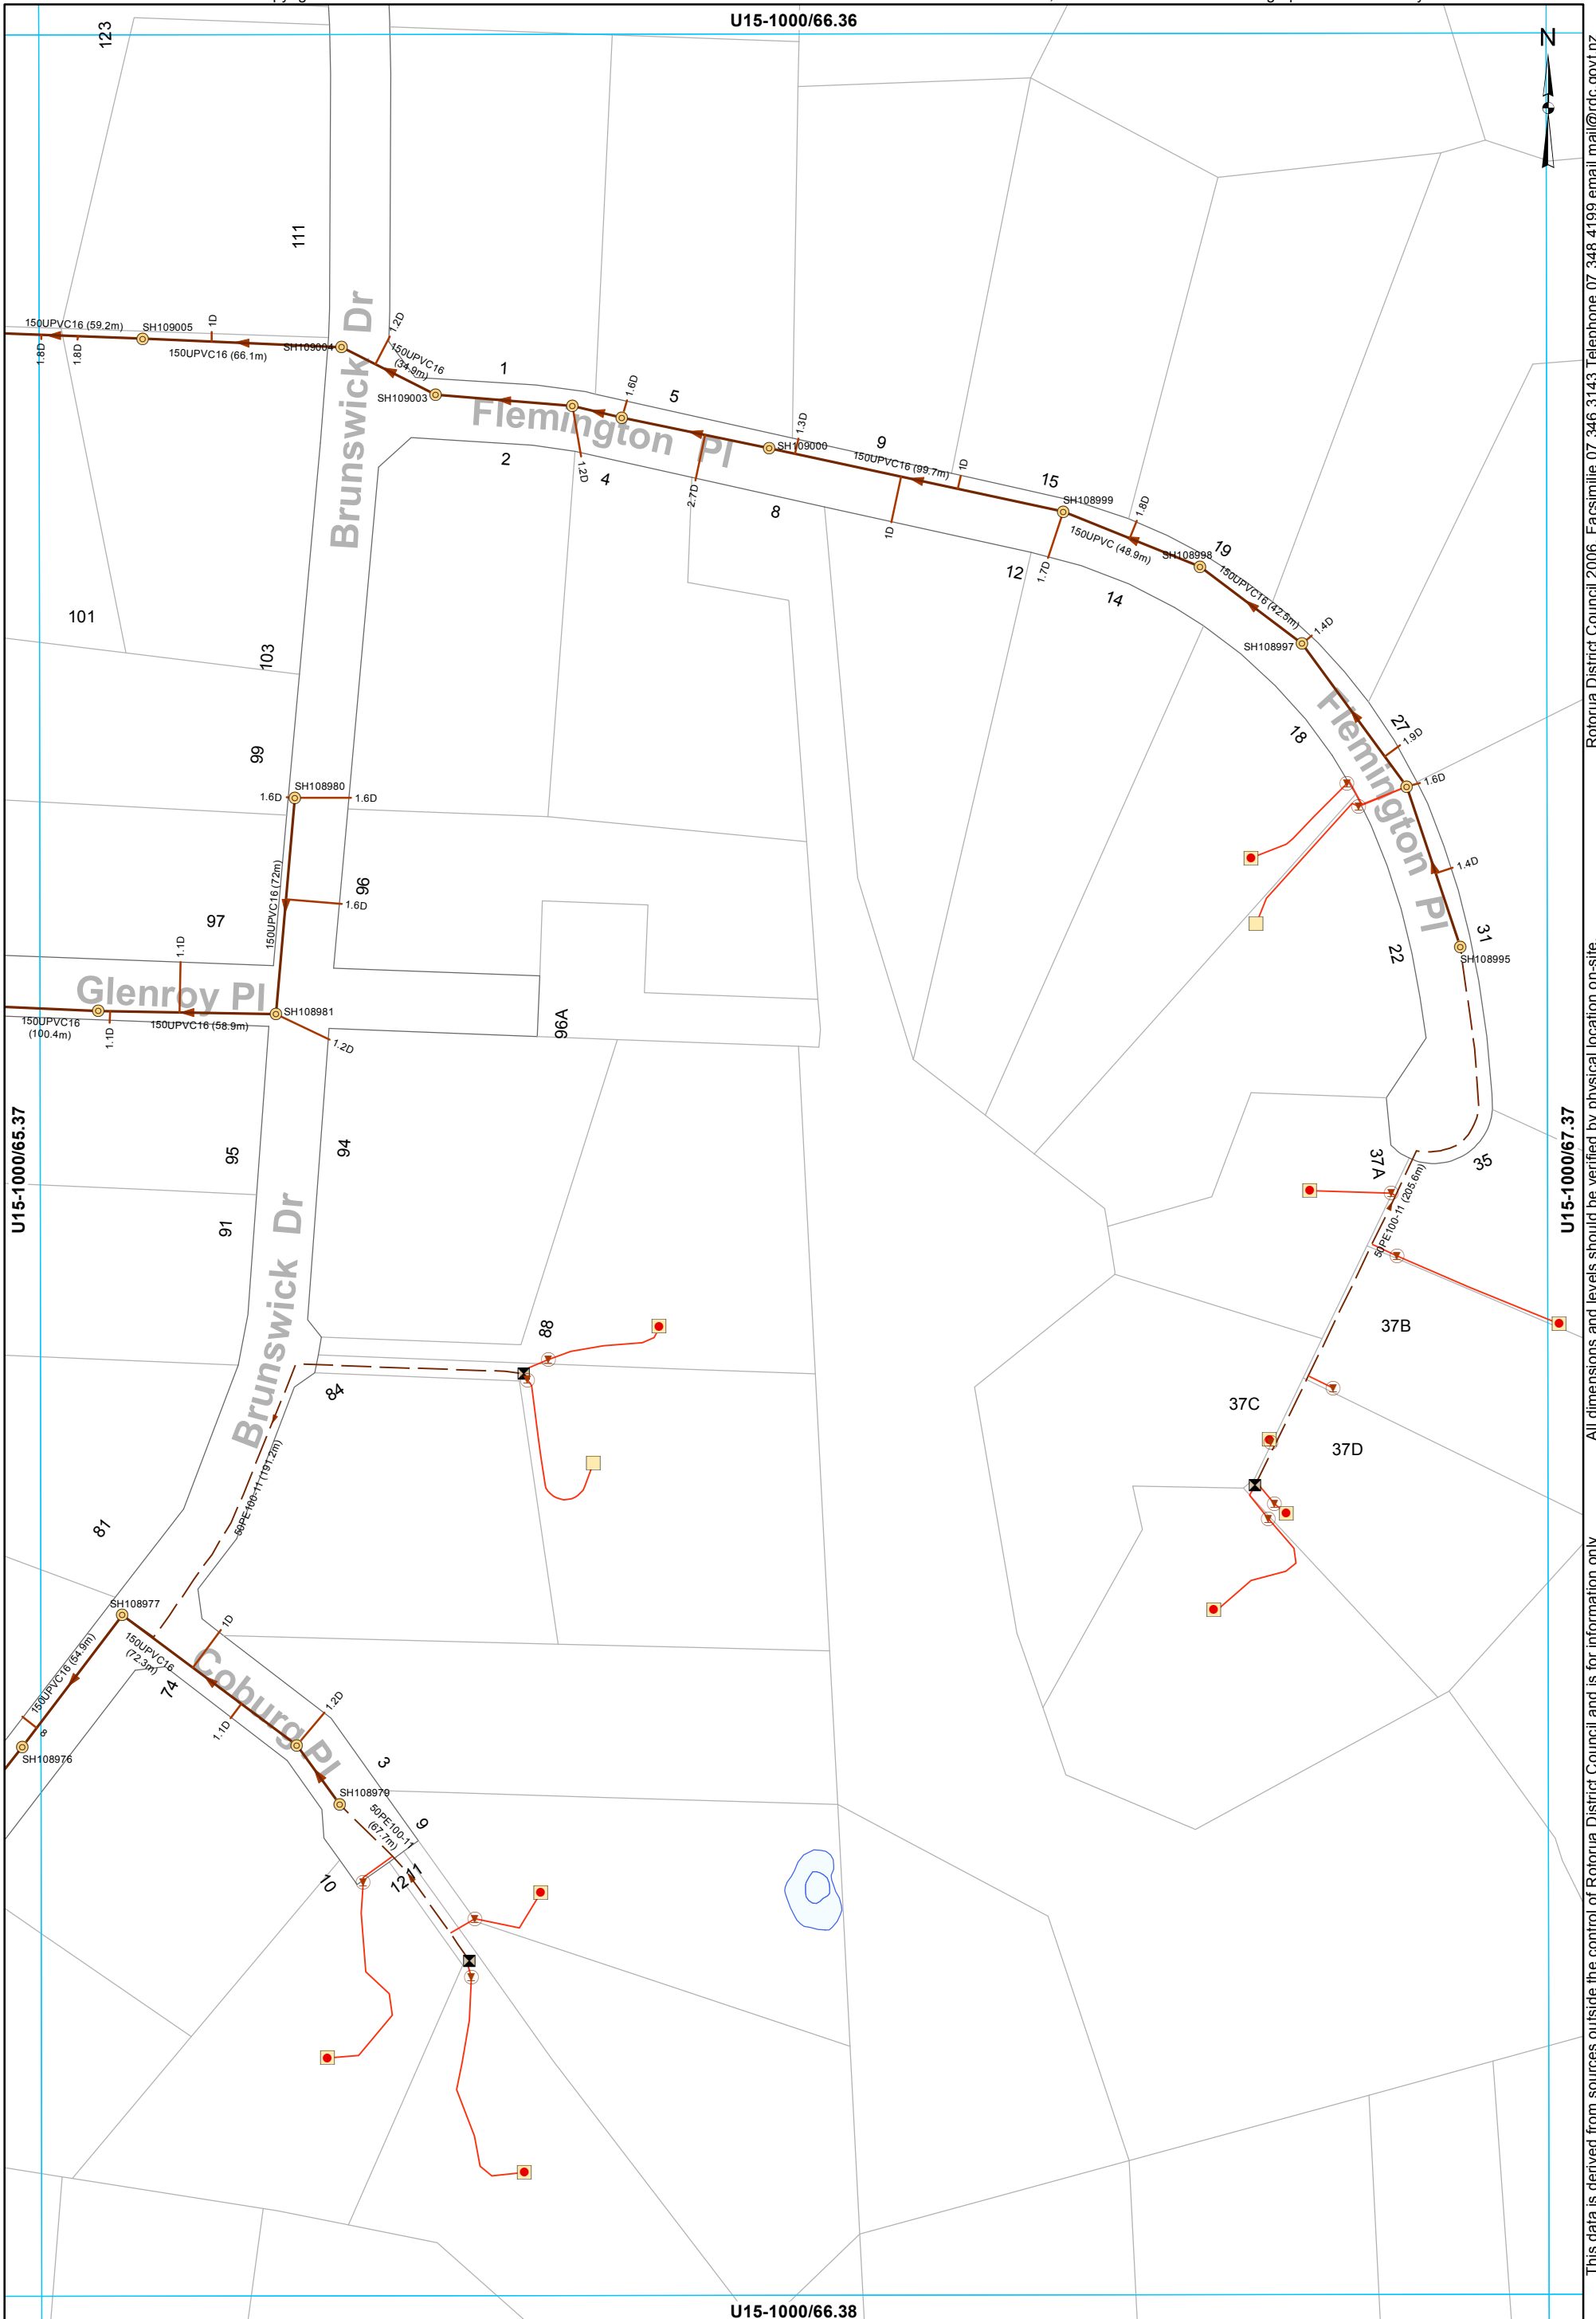


All dimensions and levels should be verified by physical location on-site. Rotorua District Council 2006. Facsimilie 07 346 3143 Telephone 07 348 4199 email mail@rdc.govt.nz

- Manhole
- Grinder Pump Chamber
- LP Grinder Pump
- Boundary Assembly
- Clean Out Point
- Low Pressure Main
- Main line
- Service Line
- LPGP Service Line

WASTEWATER SERVICES
1:2000 @ A3 - (U15-1000/66.37)

U15-1000/67.36

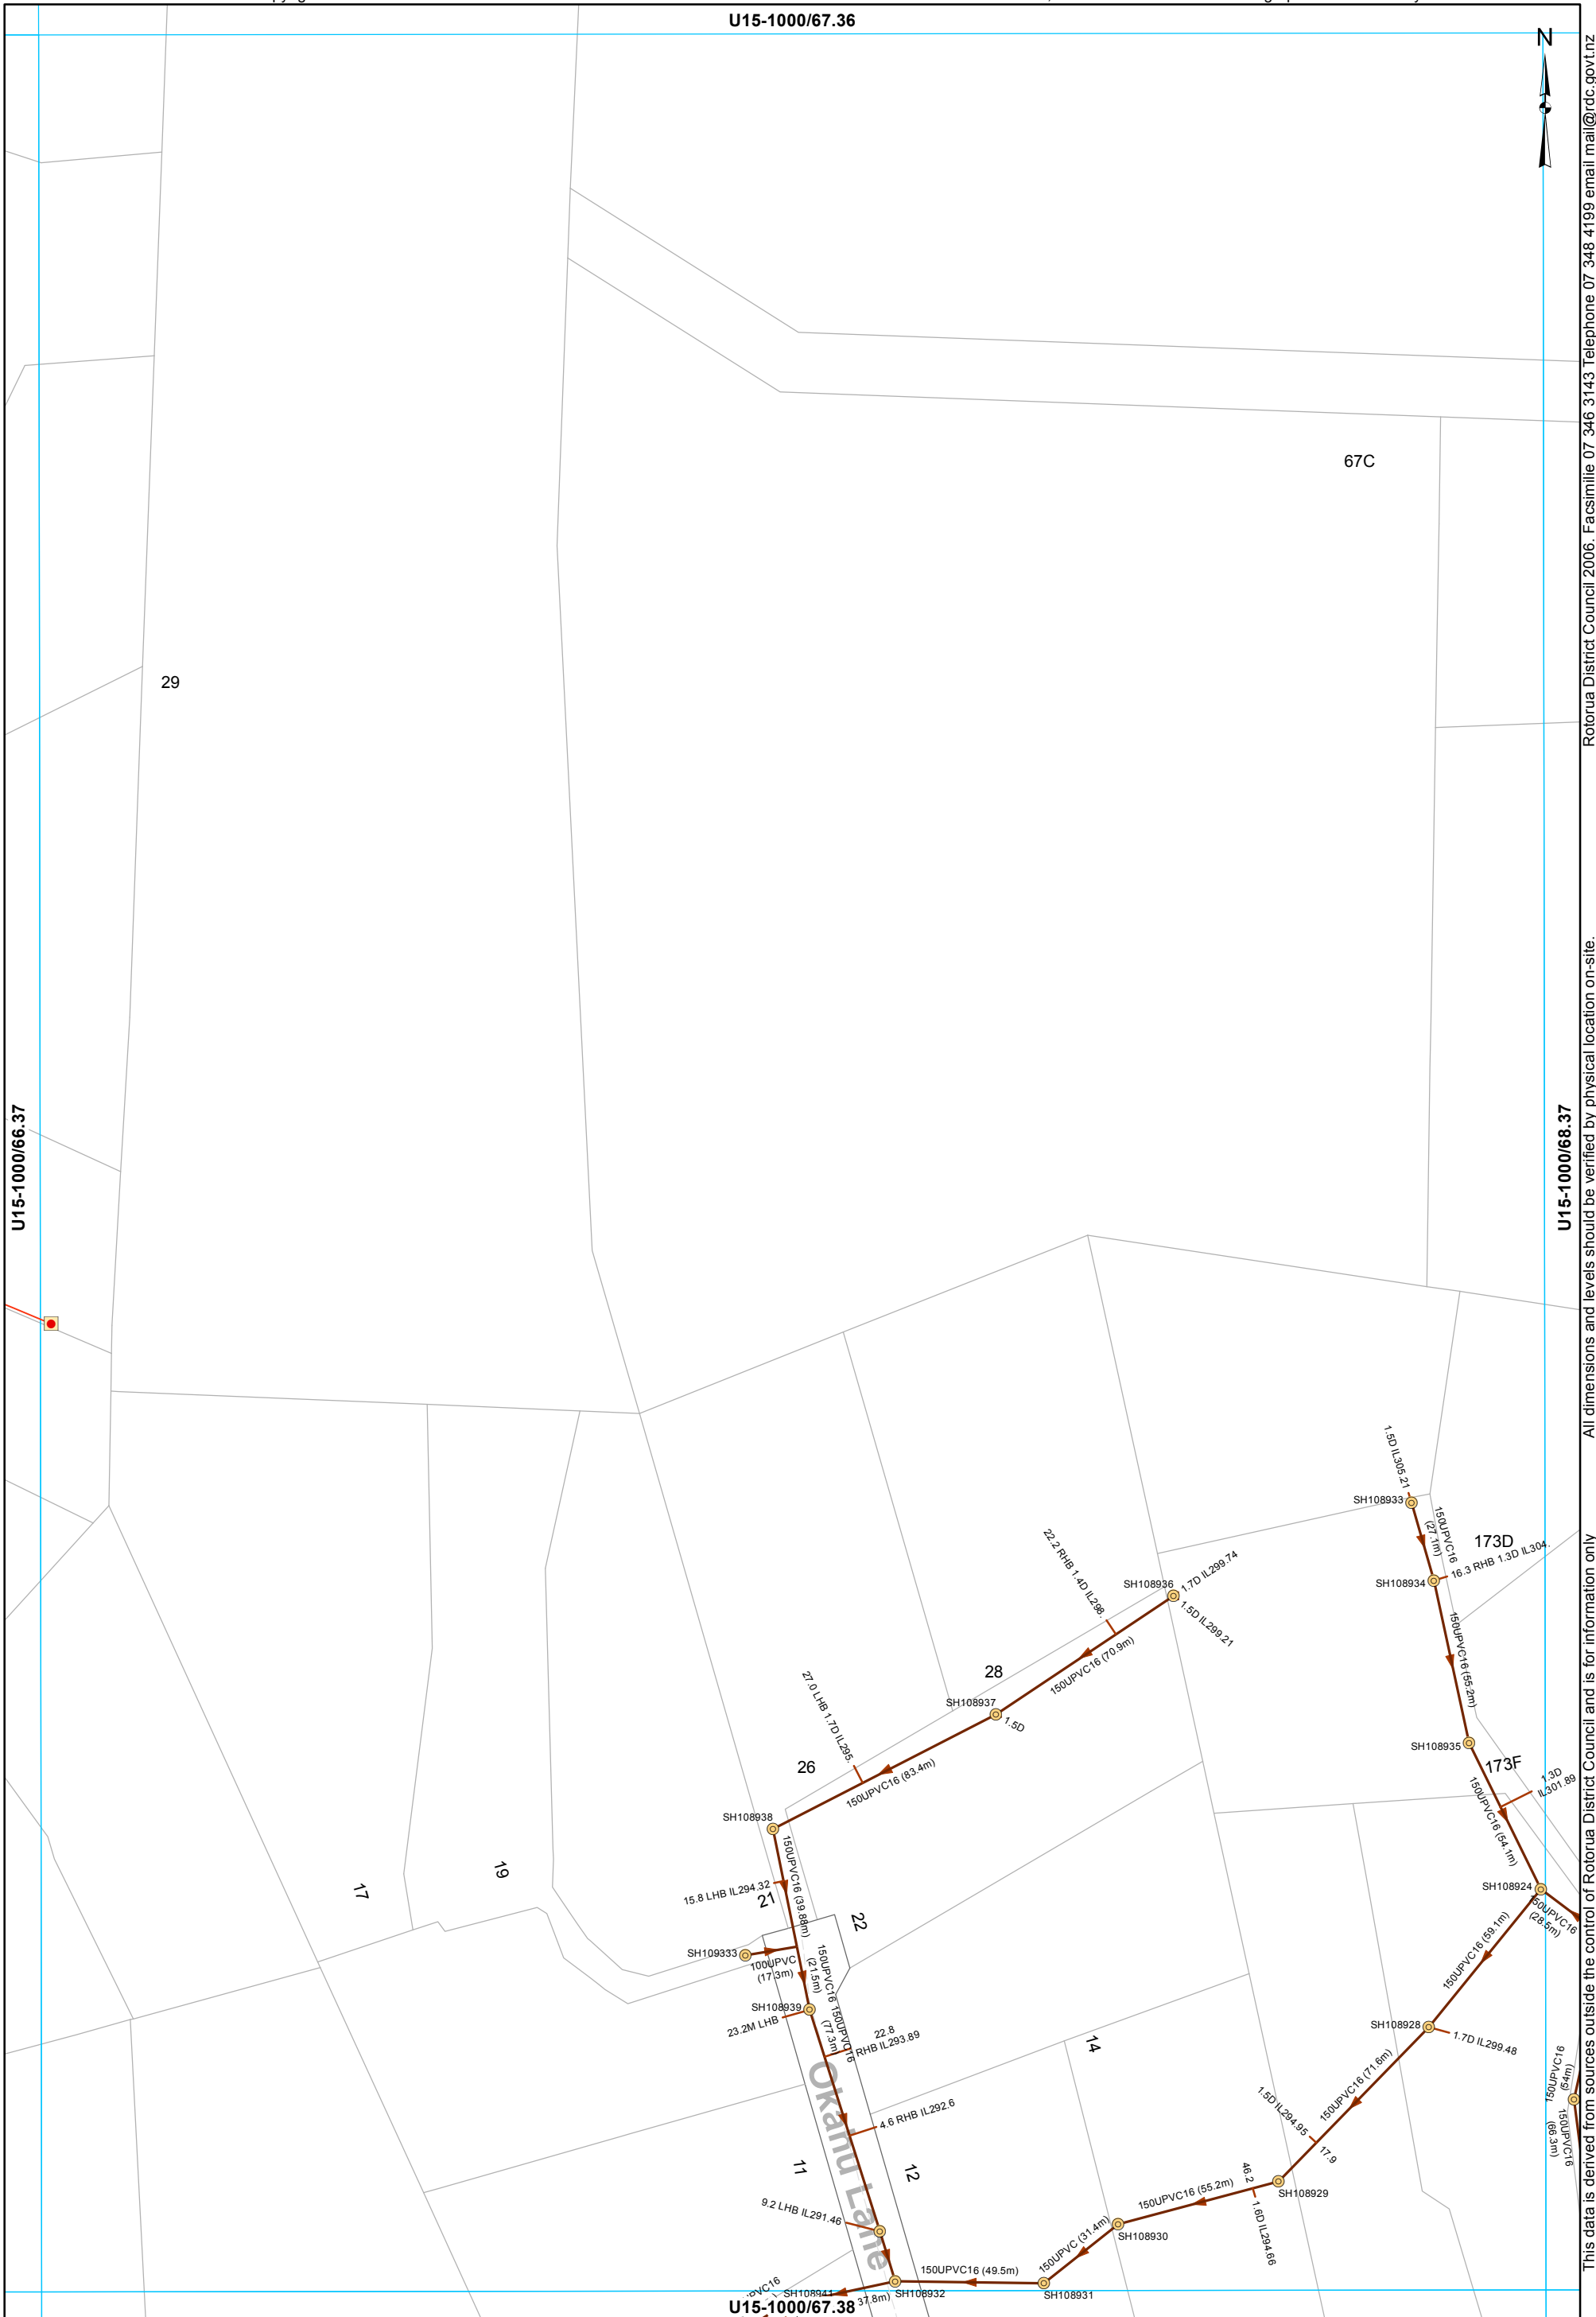


- Manhole
- Grinder Pump Chamber
- LP Grinder Pump
- Main line
- Service Line
- LPGA Service Line

WASTEWATER SERVICES
1:2000 @ A3 - (U15-1000/67.37)

All dimensions and levels should be verified by physical location on-site. Rotorua District Council 2006. Facsimile 07 346 3143 Telephone 07 348 4199 email mail@rdc.govt.nz

U15-1000/67.38



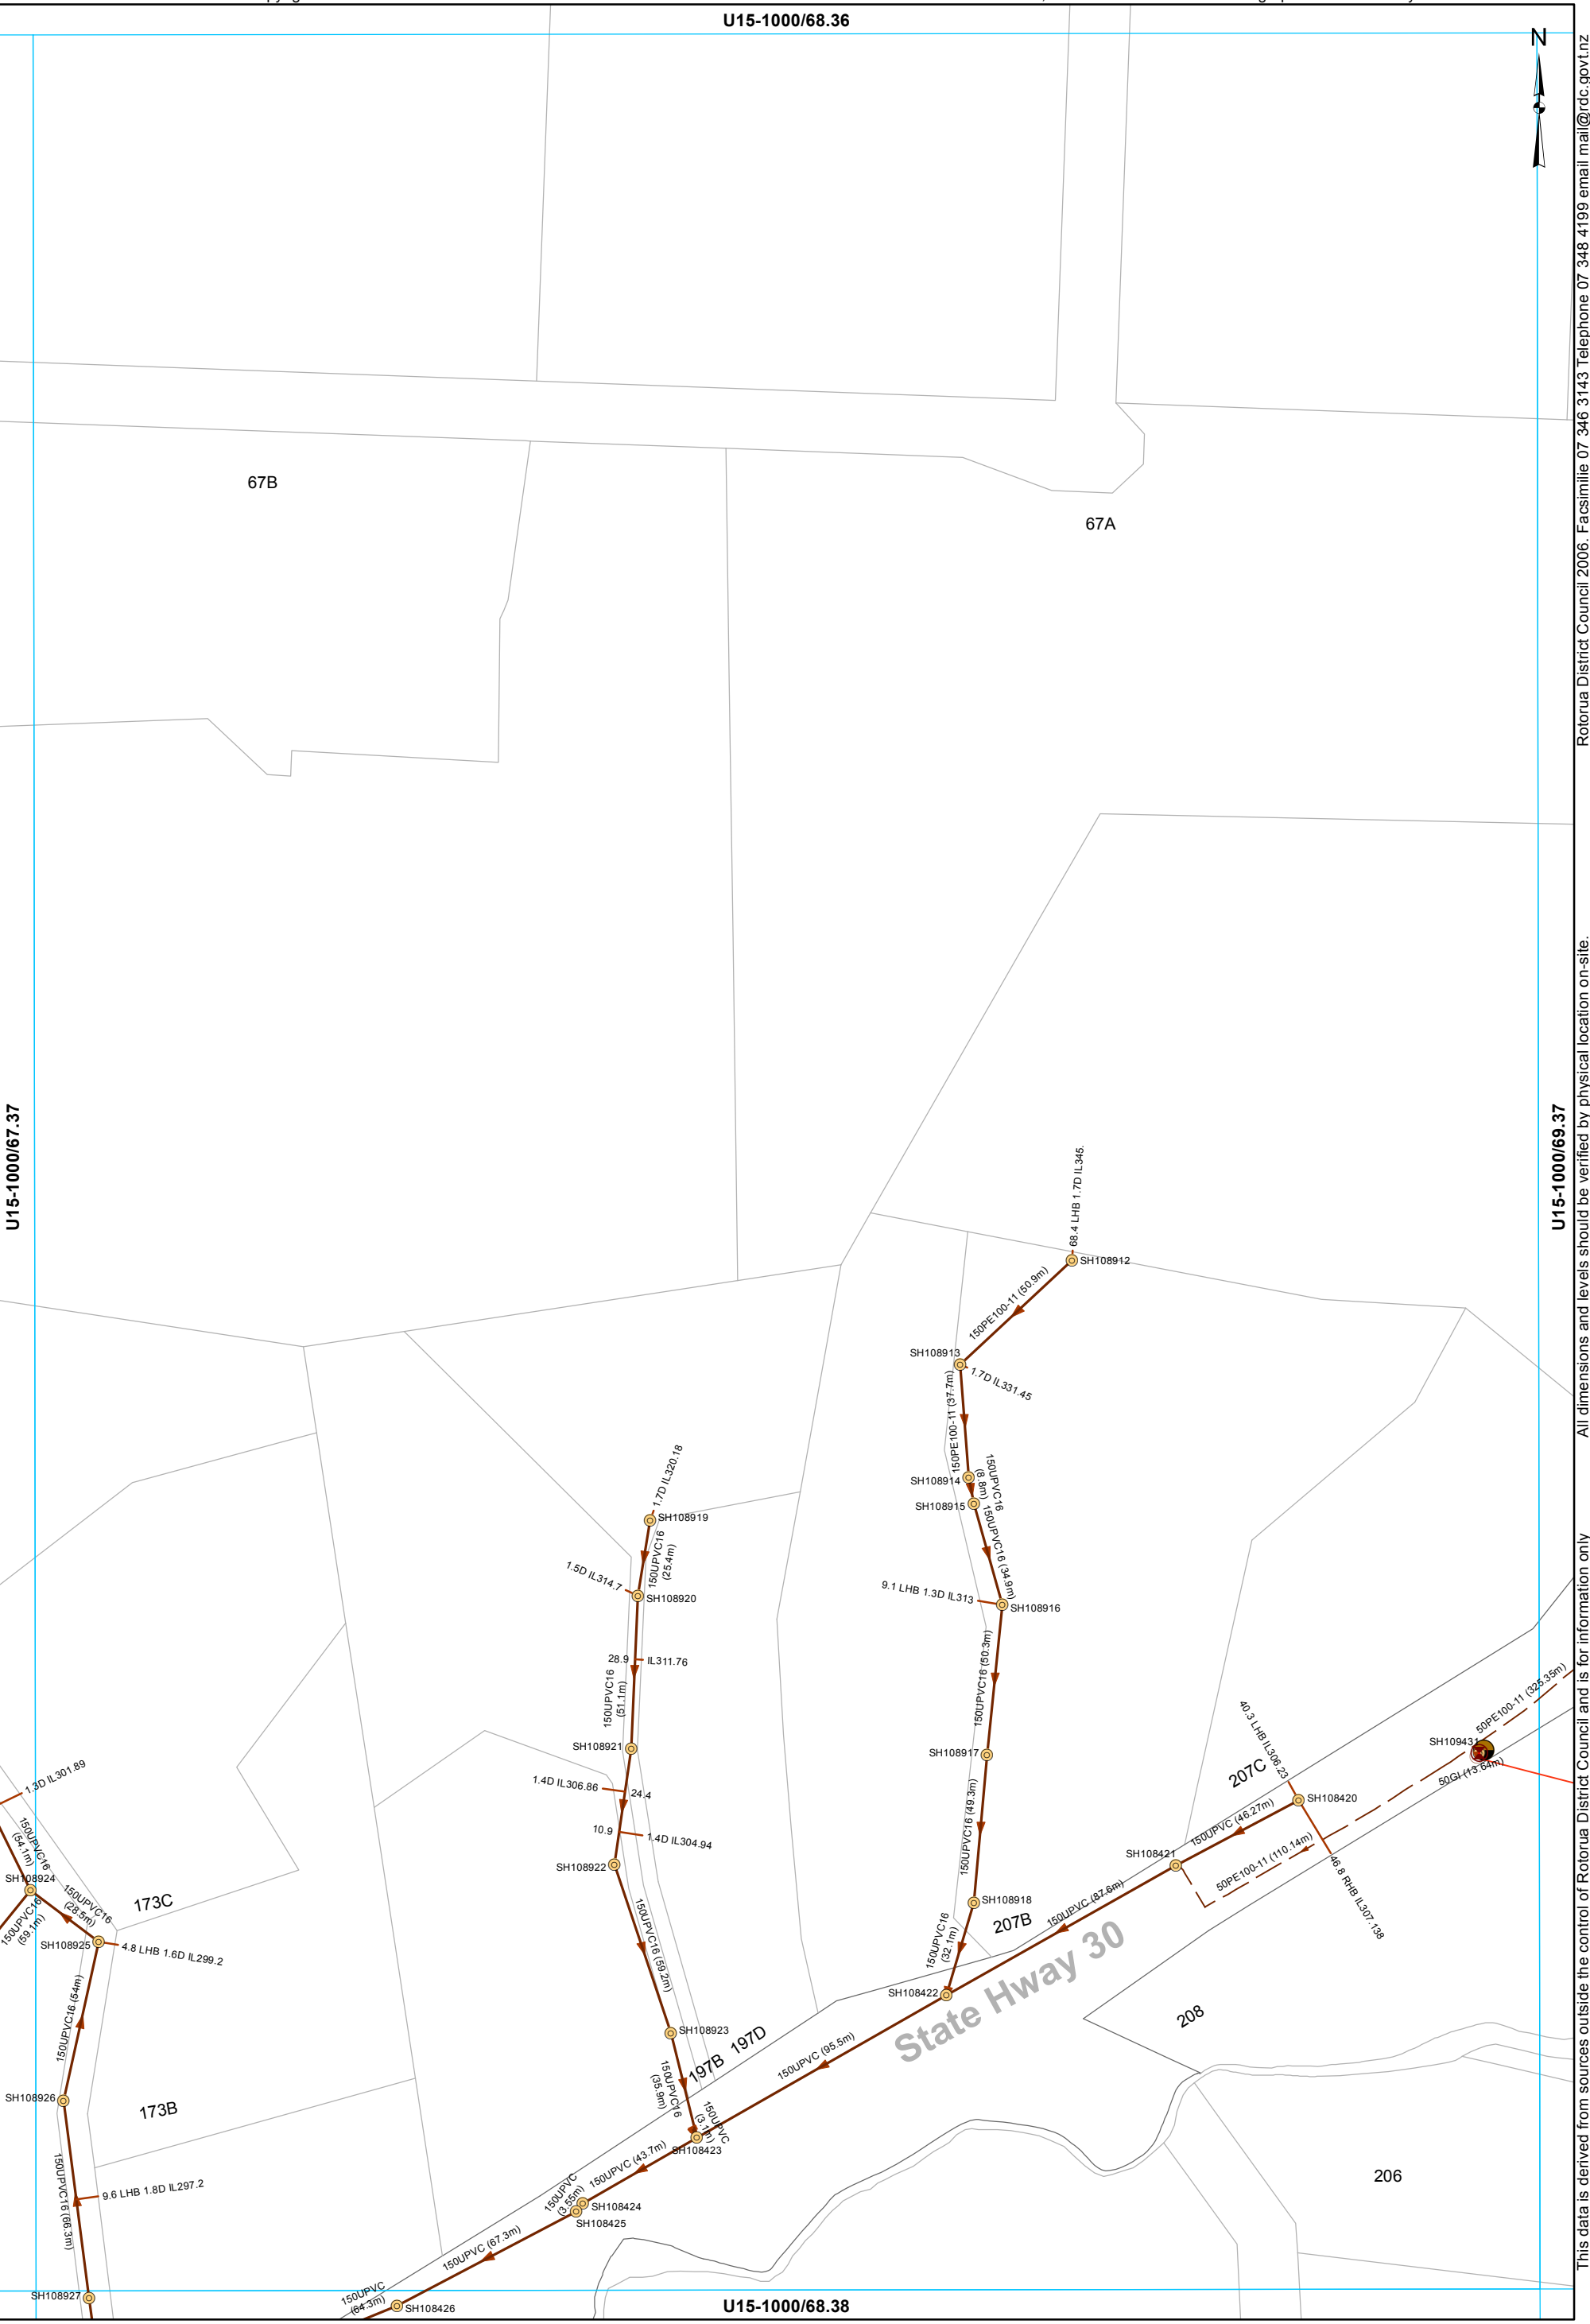






U15-1000/68.36



Rotorua District Council 2006. Facsimile 07 346 3143 Telephone 07 348 4199 email mail@rdc.govt.nz


All dimensions and levels should be verified by physical location on-site.

This data is derived from sources outside the control of Rotorua District Council and is for information only

-  Manhole
-  Odour dome
-  End of line - Capped end
-  Air Valve
-  Boundary Assembly
-  Low Pressure Main
-  Main line
-  Service Line
-  LGP Service Line

WASTEWATER SERVICES
1:2000 @ A3 - (U15-1000/68.37)



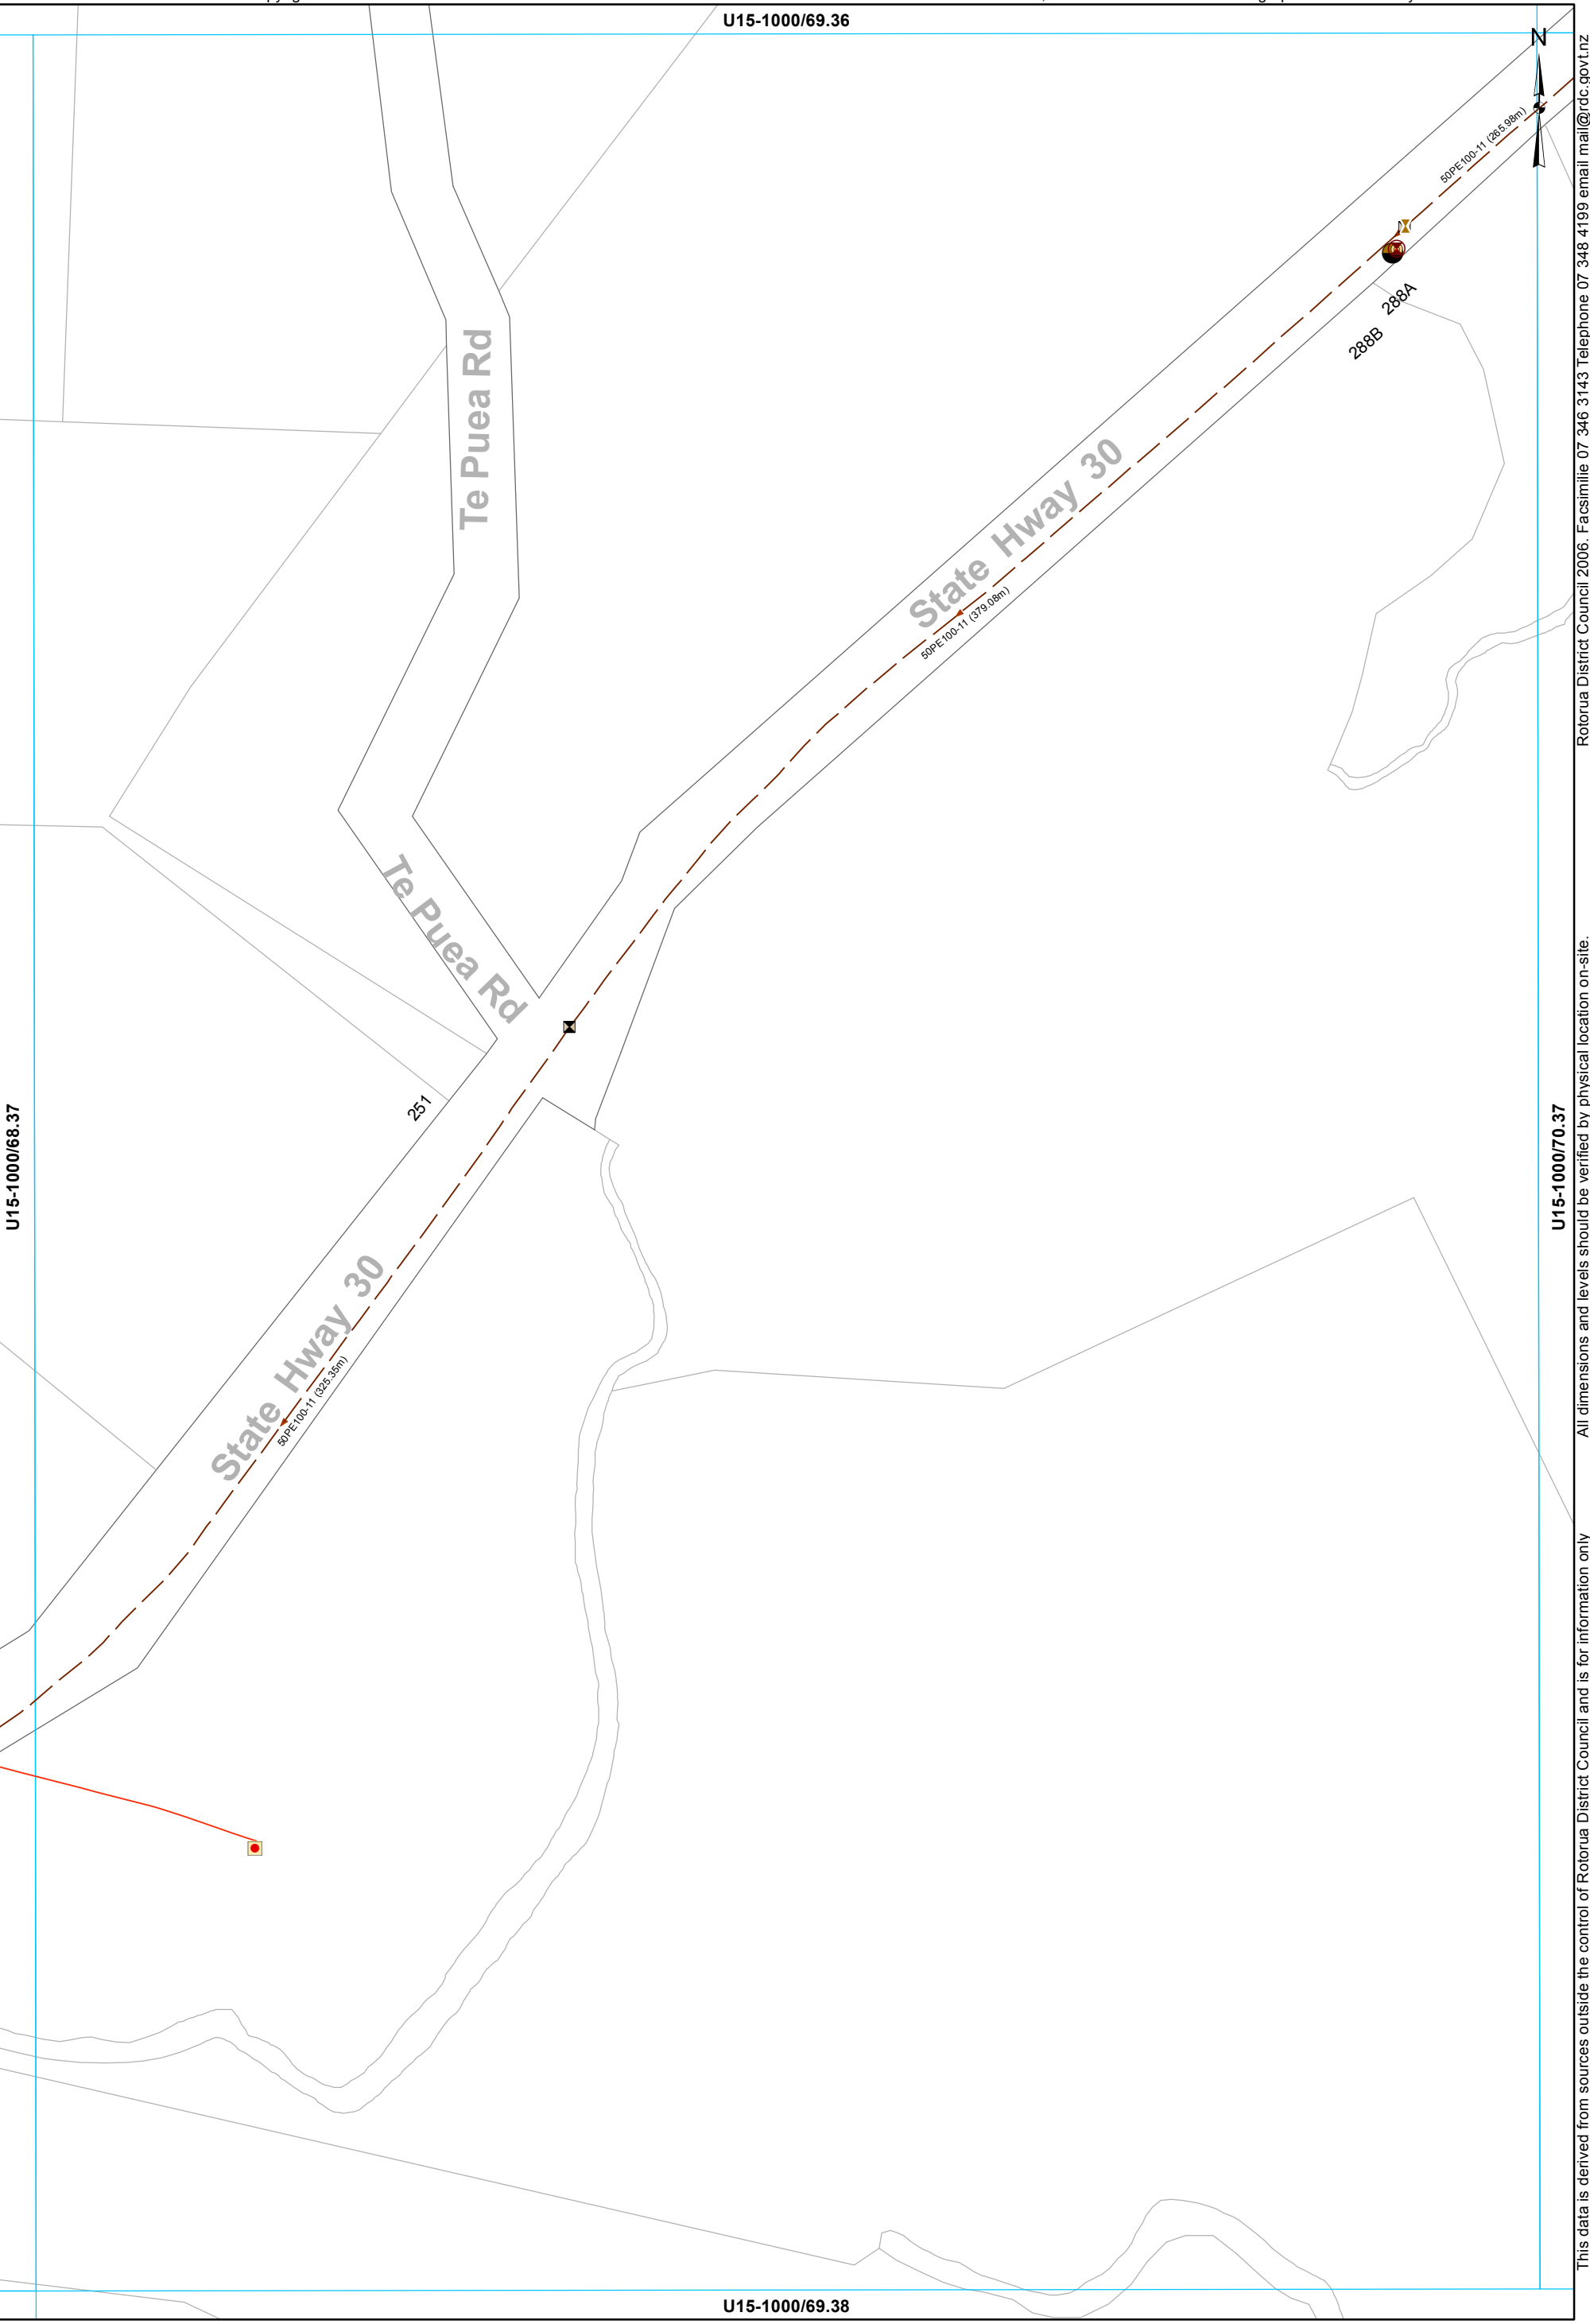






U15-1000/69.36



U15-1000/68.37

U15-1000/70.37

U15-1000/69.38

-  Manhole
-  Odour dome
-  Grinder Pump Chamber
-  LP Grinder Pump
-  Air Valve
-  Clean Out Point
-  Isolating Valve
-  Low Pressure Main
-  LPGP Service Line

WASTEWATER SERVICES
1:2000 @ A3 - (U15-1000/69.37)


This data is derived from sources outside the control of Rotorua District Council and is for information only. Rotorua District Council 2006. Facsimile 07 346 3143 Telephone 07 348 4199 email mail@rdc.govt.nz

U15-1000/64.37

Rotorua District Council 2006. Facsimile 07 346 3143 Telephone 07 348 4199 email mail@rdc.govt.nz

U15-1000/63.38

U15-1000/65.38

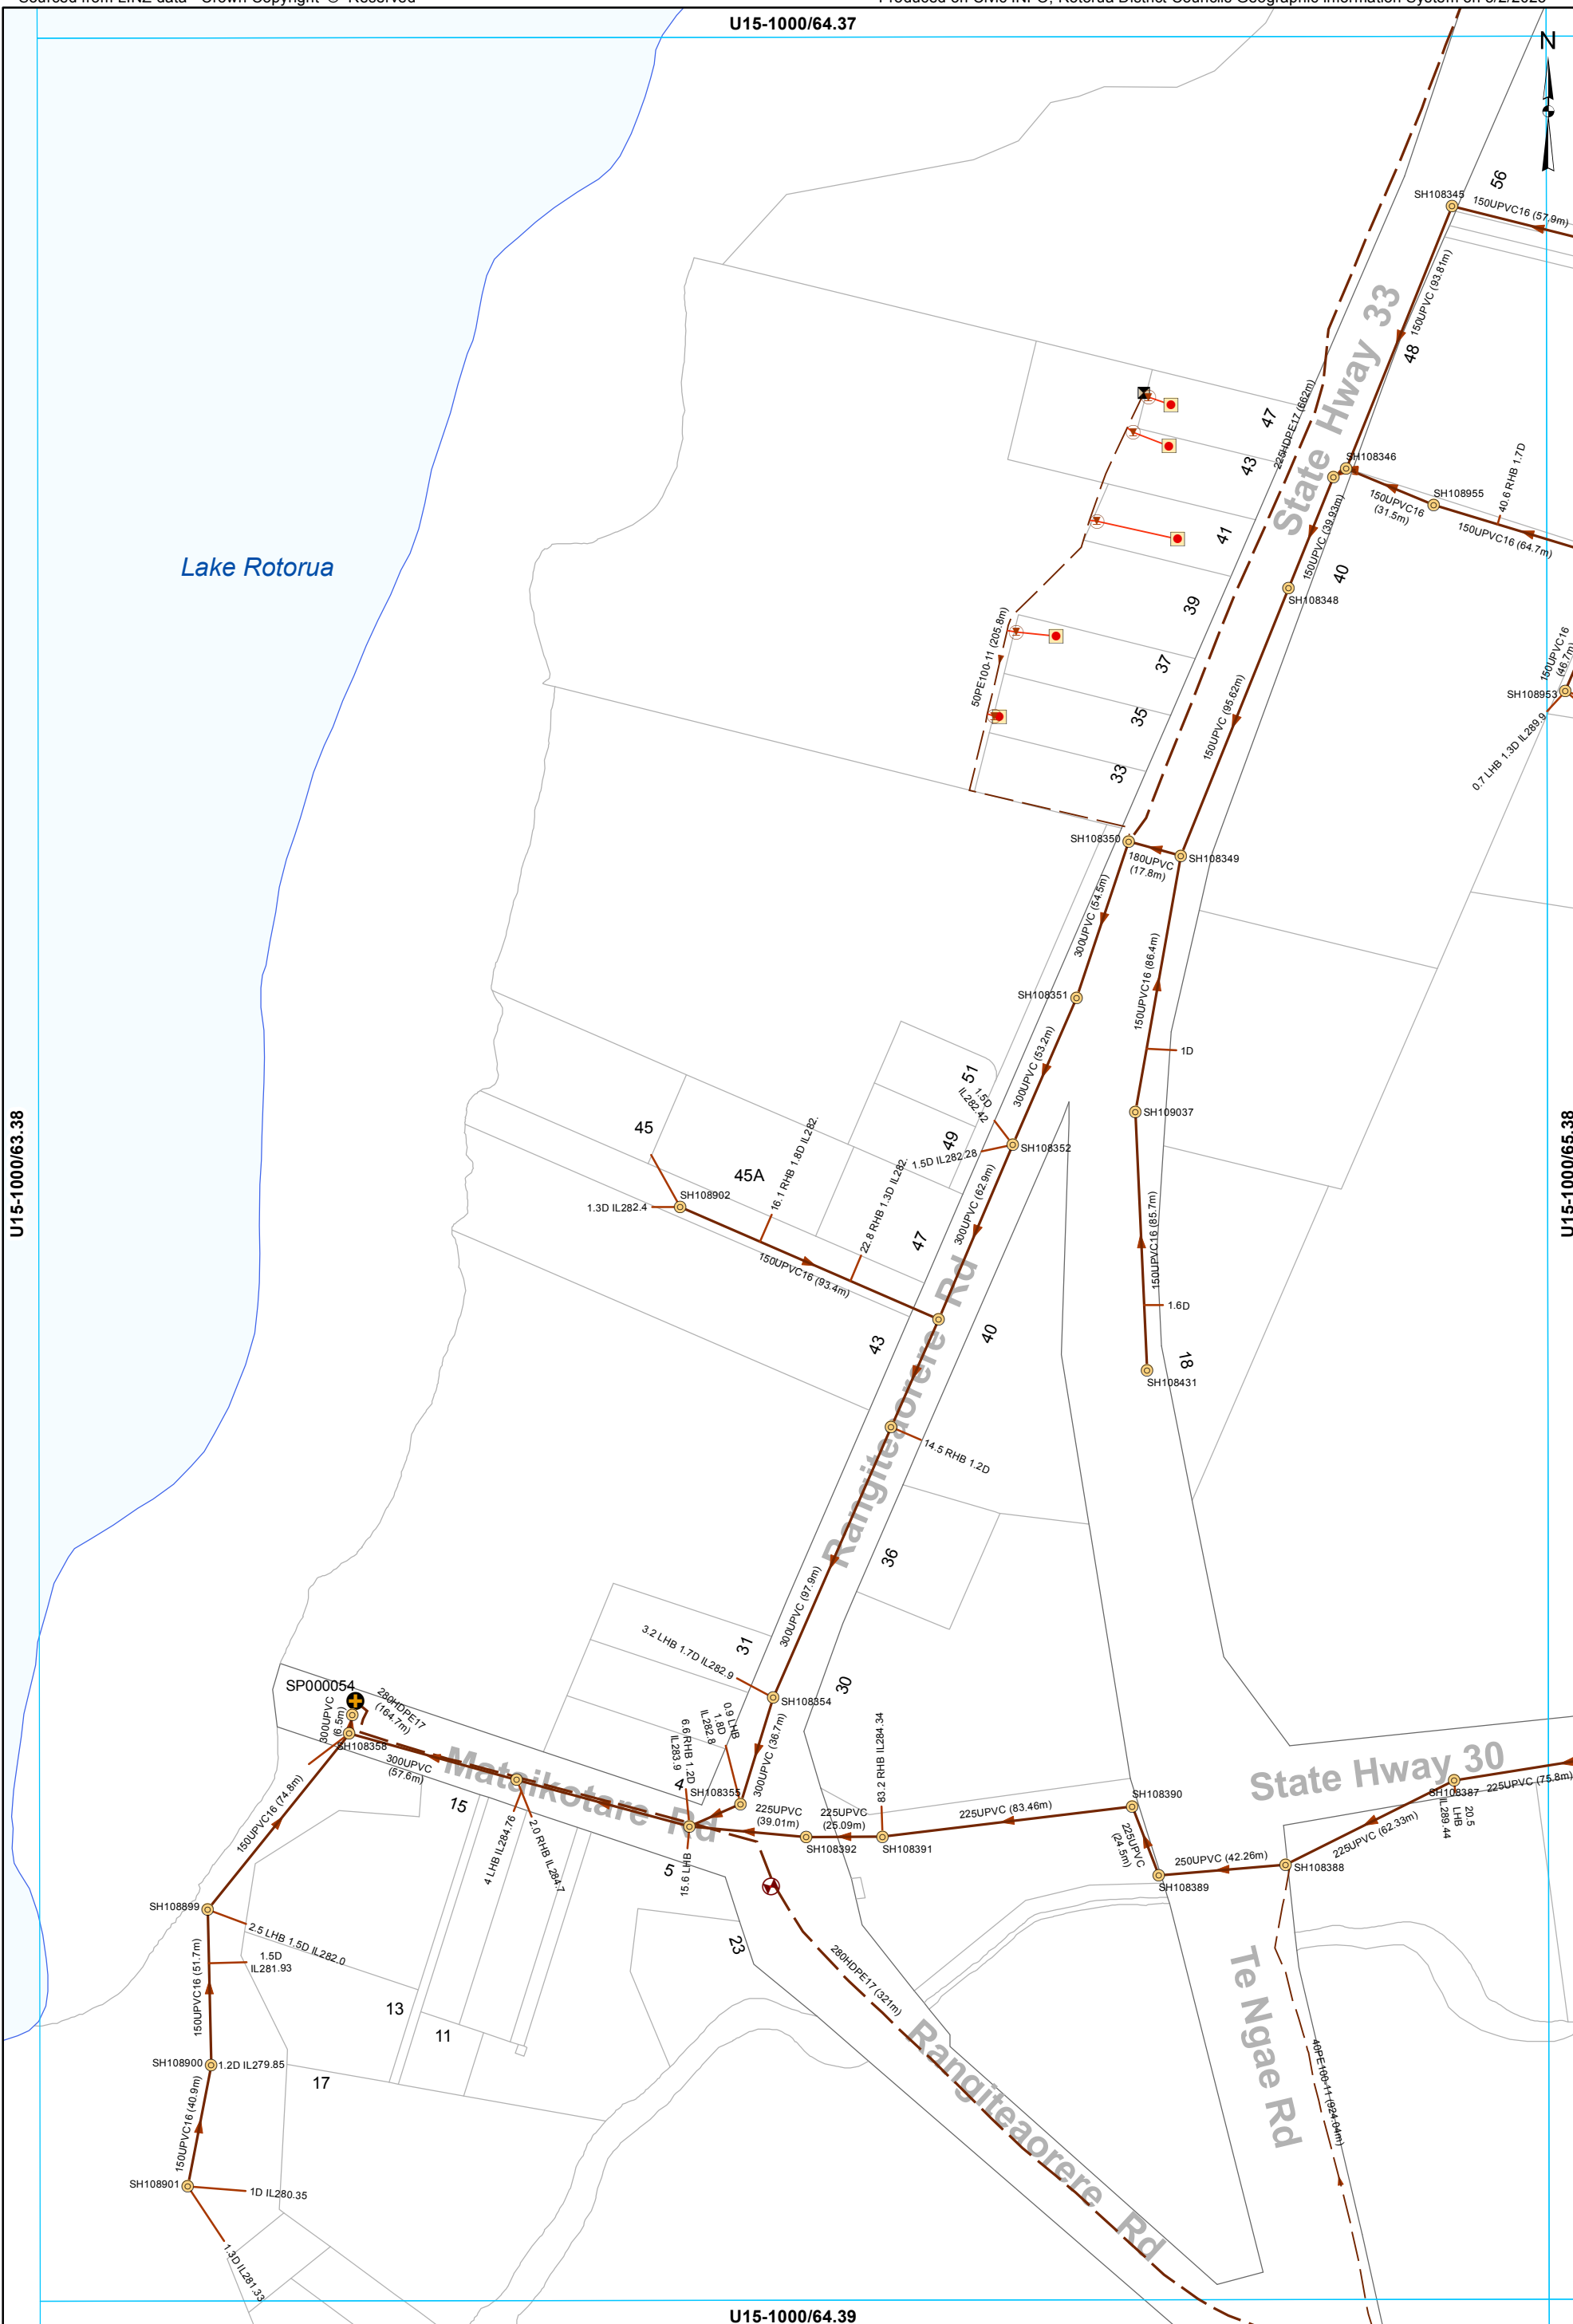


U15-1000/64.39

All dimensions and levels should be verified by physical location on-site. This data is derived from sources outside the control of Rotorua District Council and is for information only

- Manhole
- ⊕ Pump Station
- Grinder Pump Chamber
- LP Grinder Pump
- End of line - Capped end
- ⊗ Air Valve
- ⊕ Boundary Assembly
- Clean Out Point
- Low Pressure Main
- Main line
- Rising main
- Service Line
- LPGP Service Line

WASTEWATER SERVICES
1:2000 @ A3 - (U15-1000/64.38)

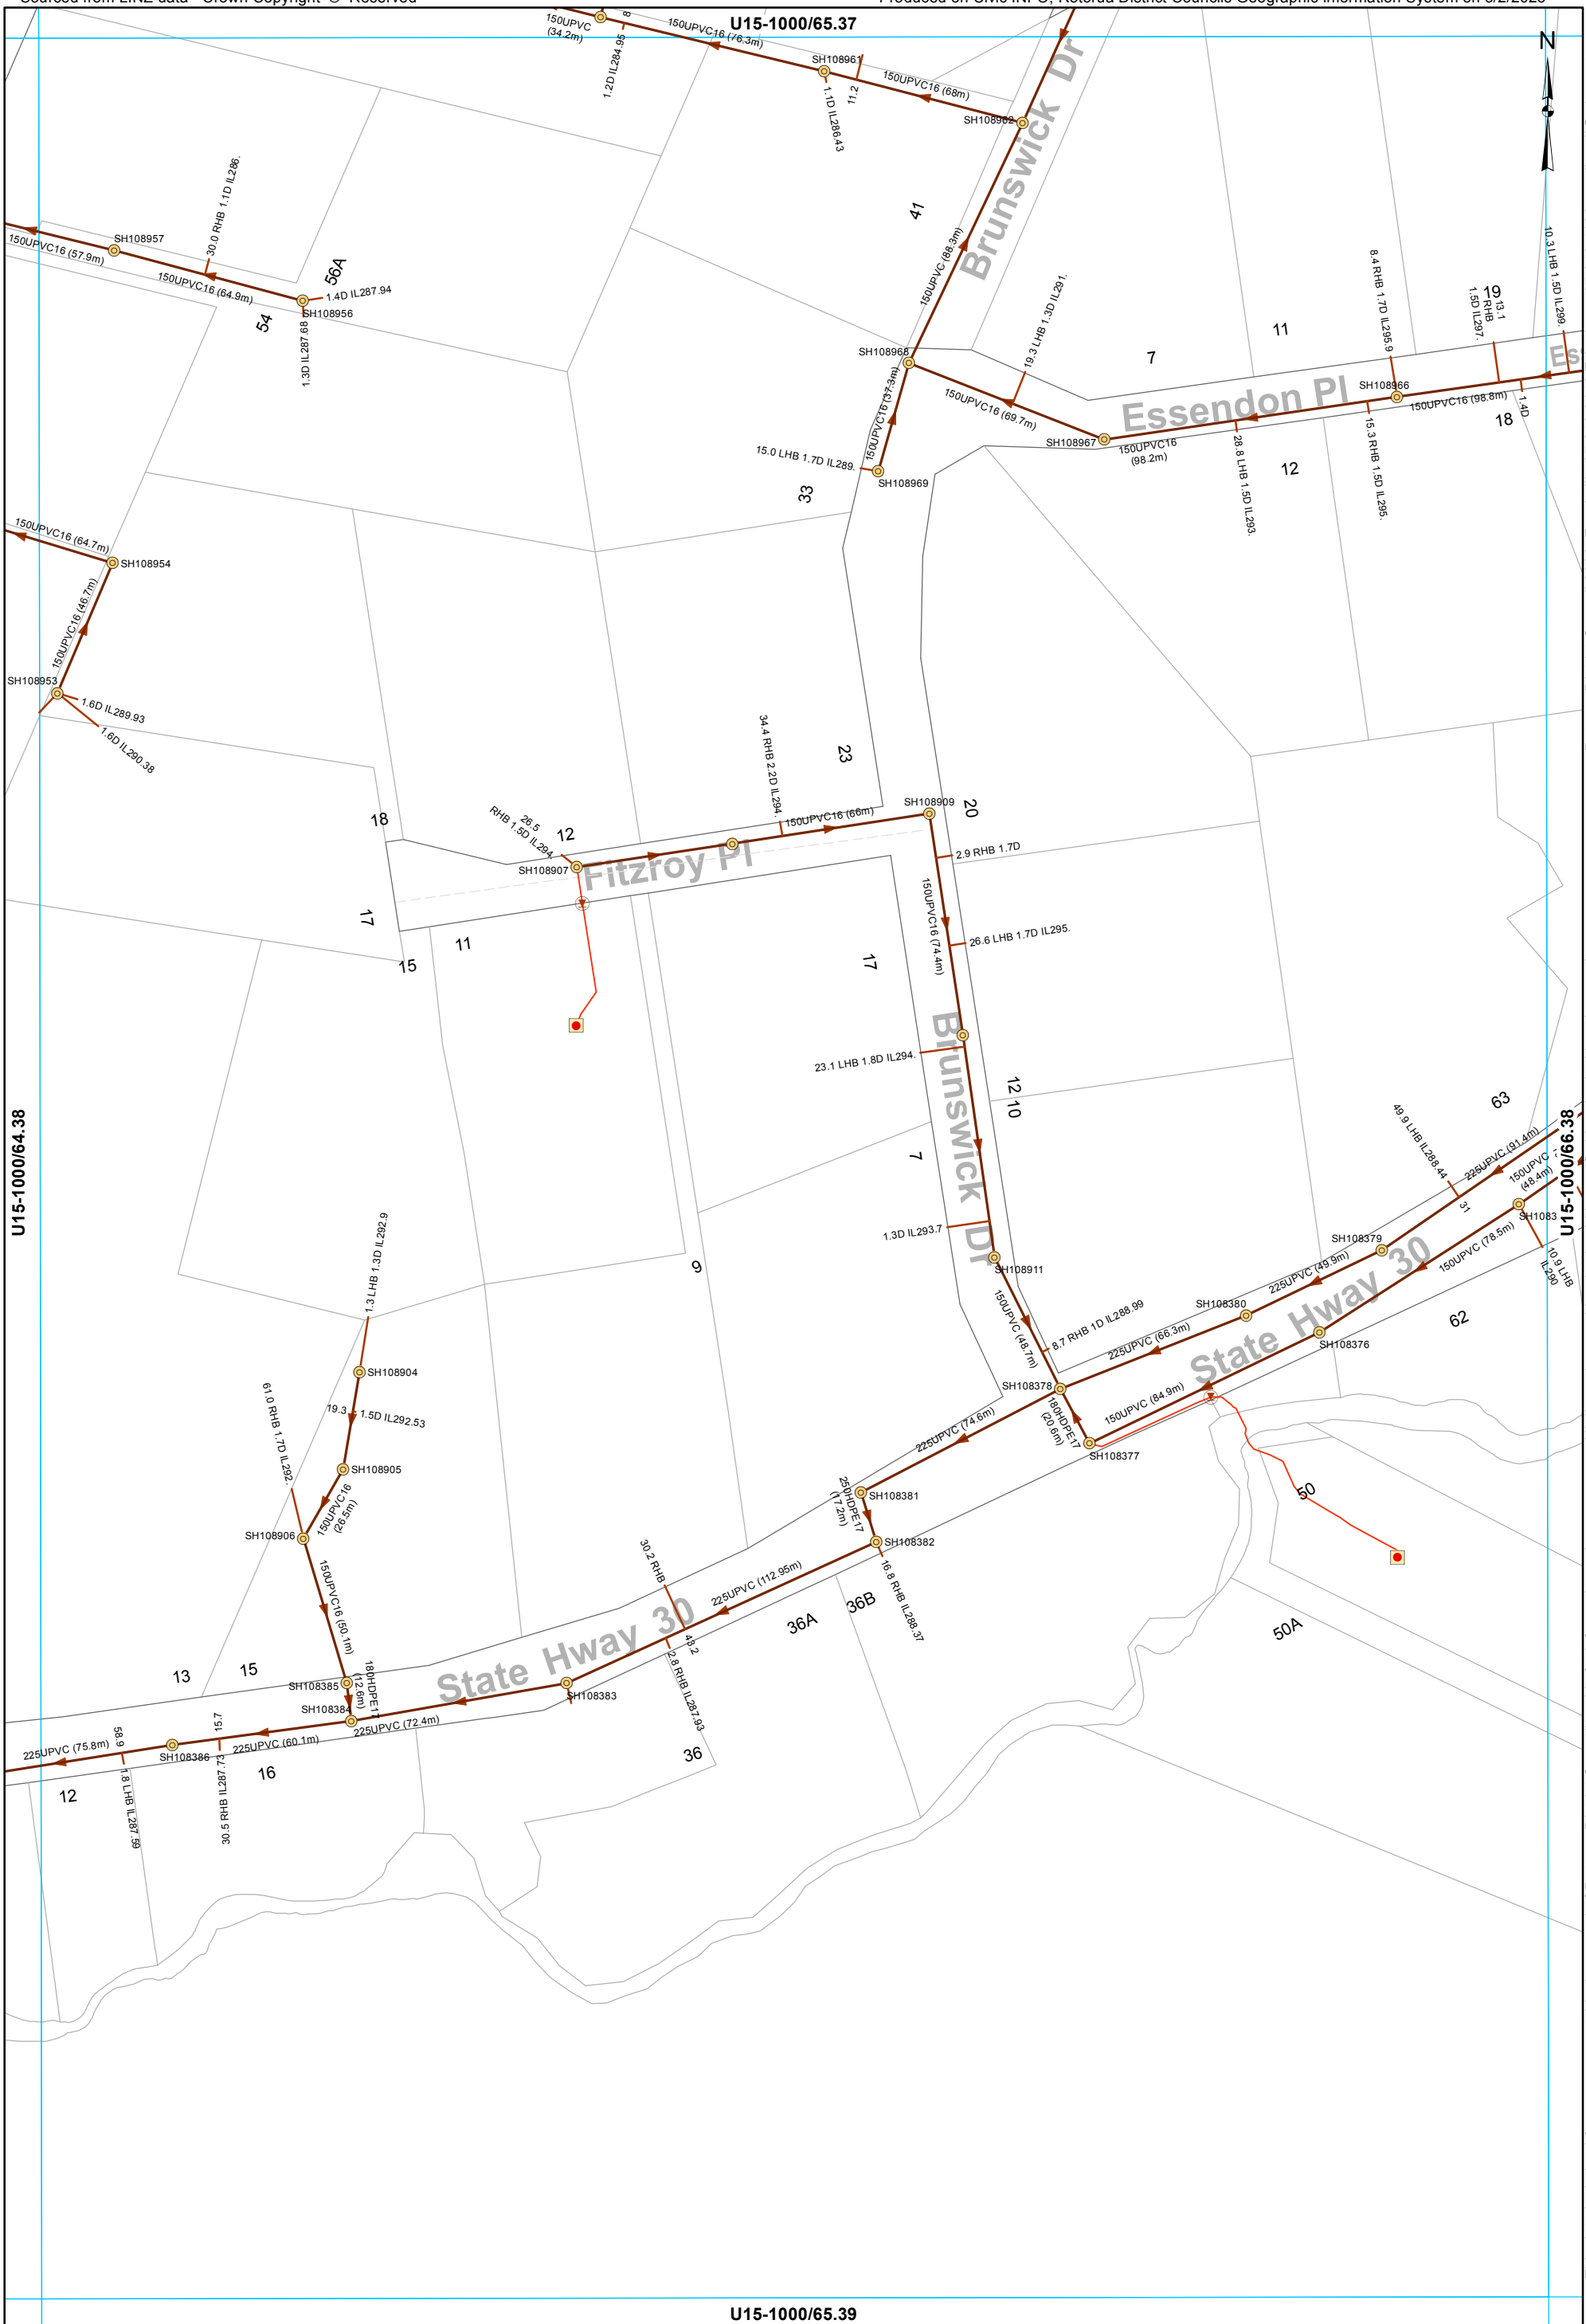


U15-1000/65.39

- Manhole
- Grinder Pump Chamber
- Boundary Assembly
- Main line
- Service Line
- LP Grinder Pump
- LPGP Service Line

WASTEWATER SERVICES
1:2000 @ A3 - (U15-1000/65.38)

This data is derived from sources outside the control of Rotorua District Council and is for information only

Rotorua District Council 2006. Facsimile 07 346 3143 Telephone 07 348 4199 email mail@rdc.govt.nz

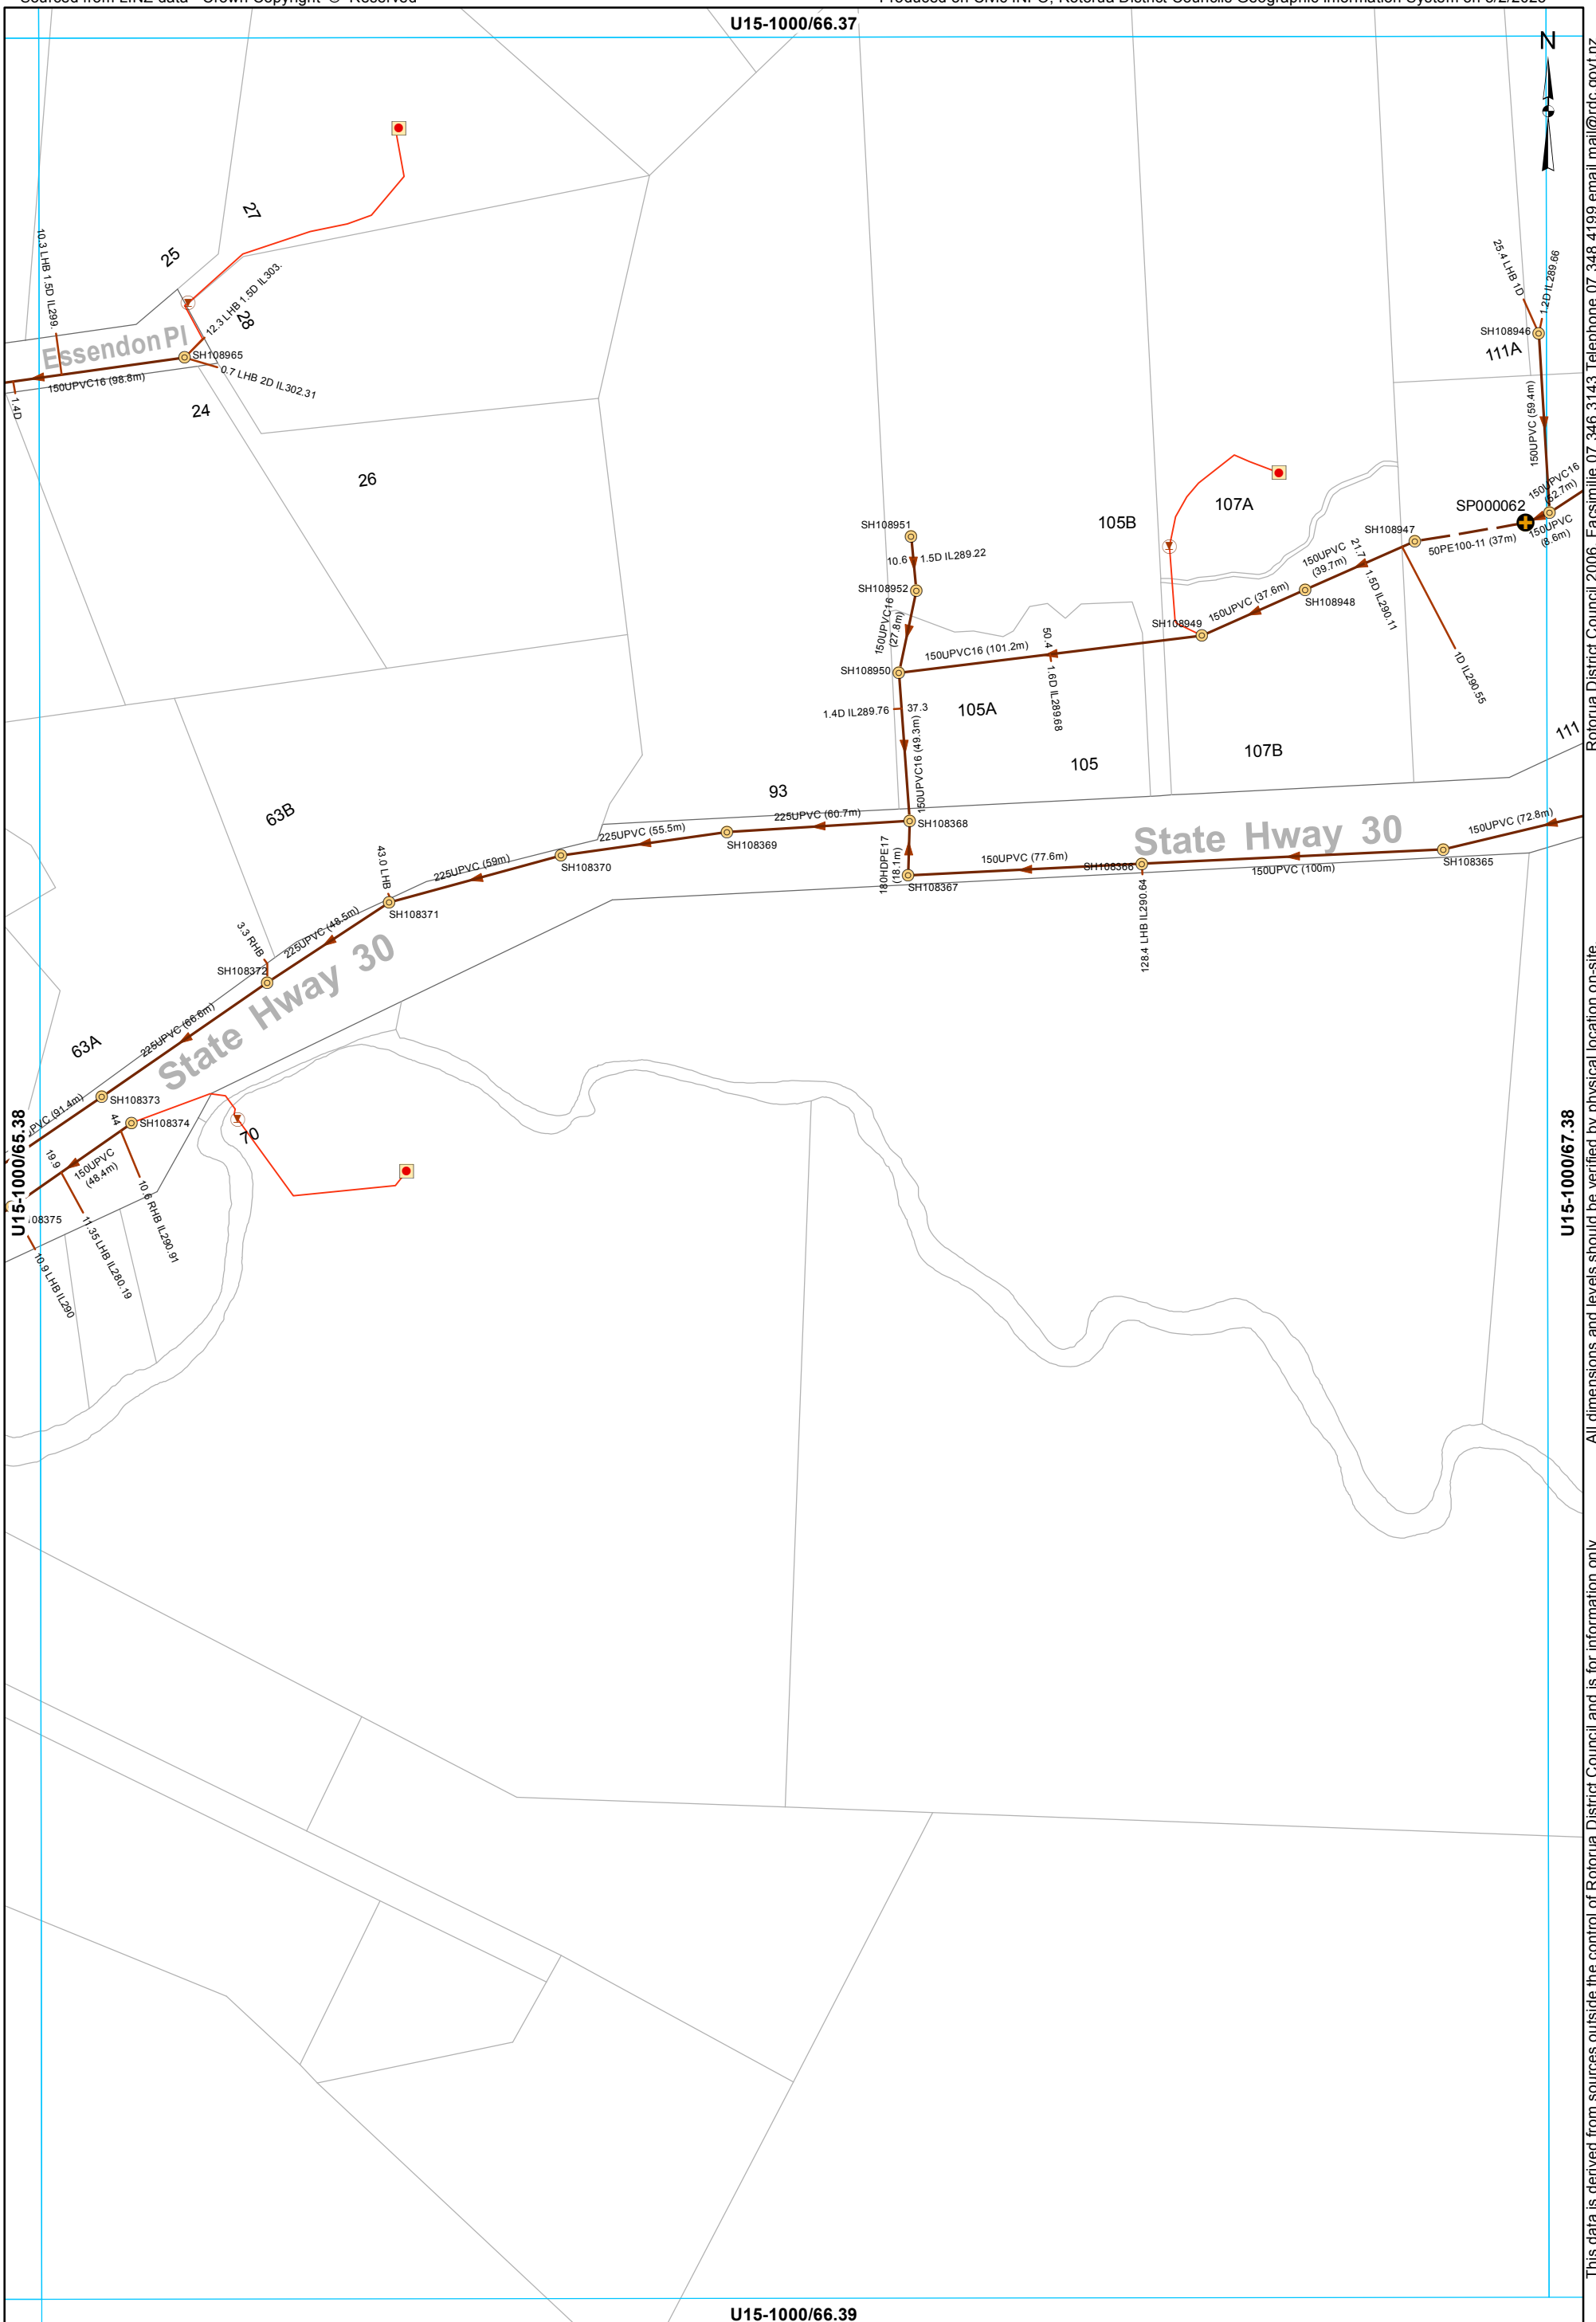


Rotorua District Council 2006. Facsimile 07 346 3143 Telephone 07 348 4199 email mail@rdc.govt.nz

This data is derived from sources outside the control of Rotorua District Council and is for information only

All dimensions and levels should be verified by physical location on-site.

- Manhole
- Pump Station
- Grinder Pump Chamber
- LP Grinder Pump
- Boundary Assembly
- Main line
- Rising main
- Service Line
- LPGP Service Line

WASTEWATER SERVICES
1:2000 @ A3 - (U15-1000/66.38)

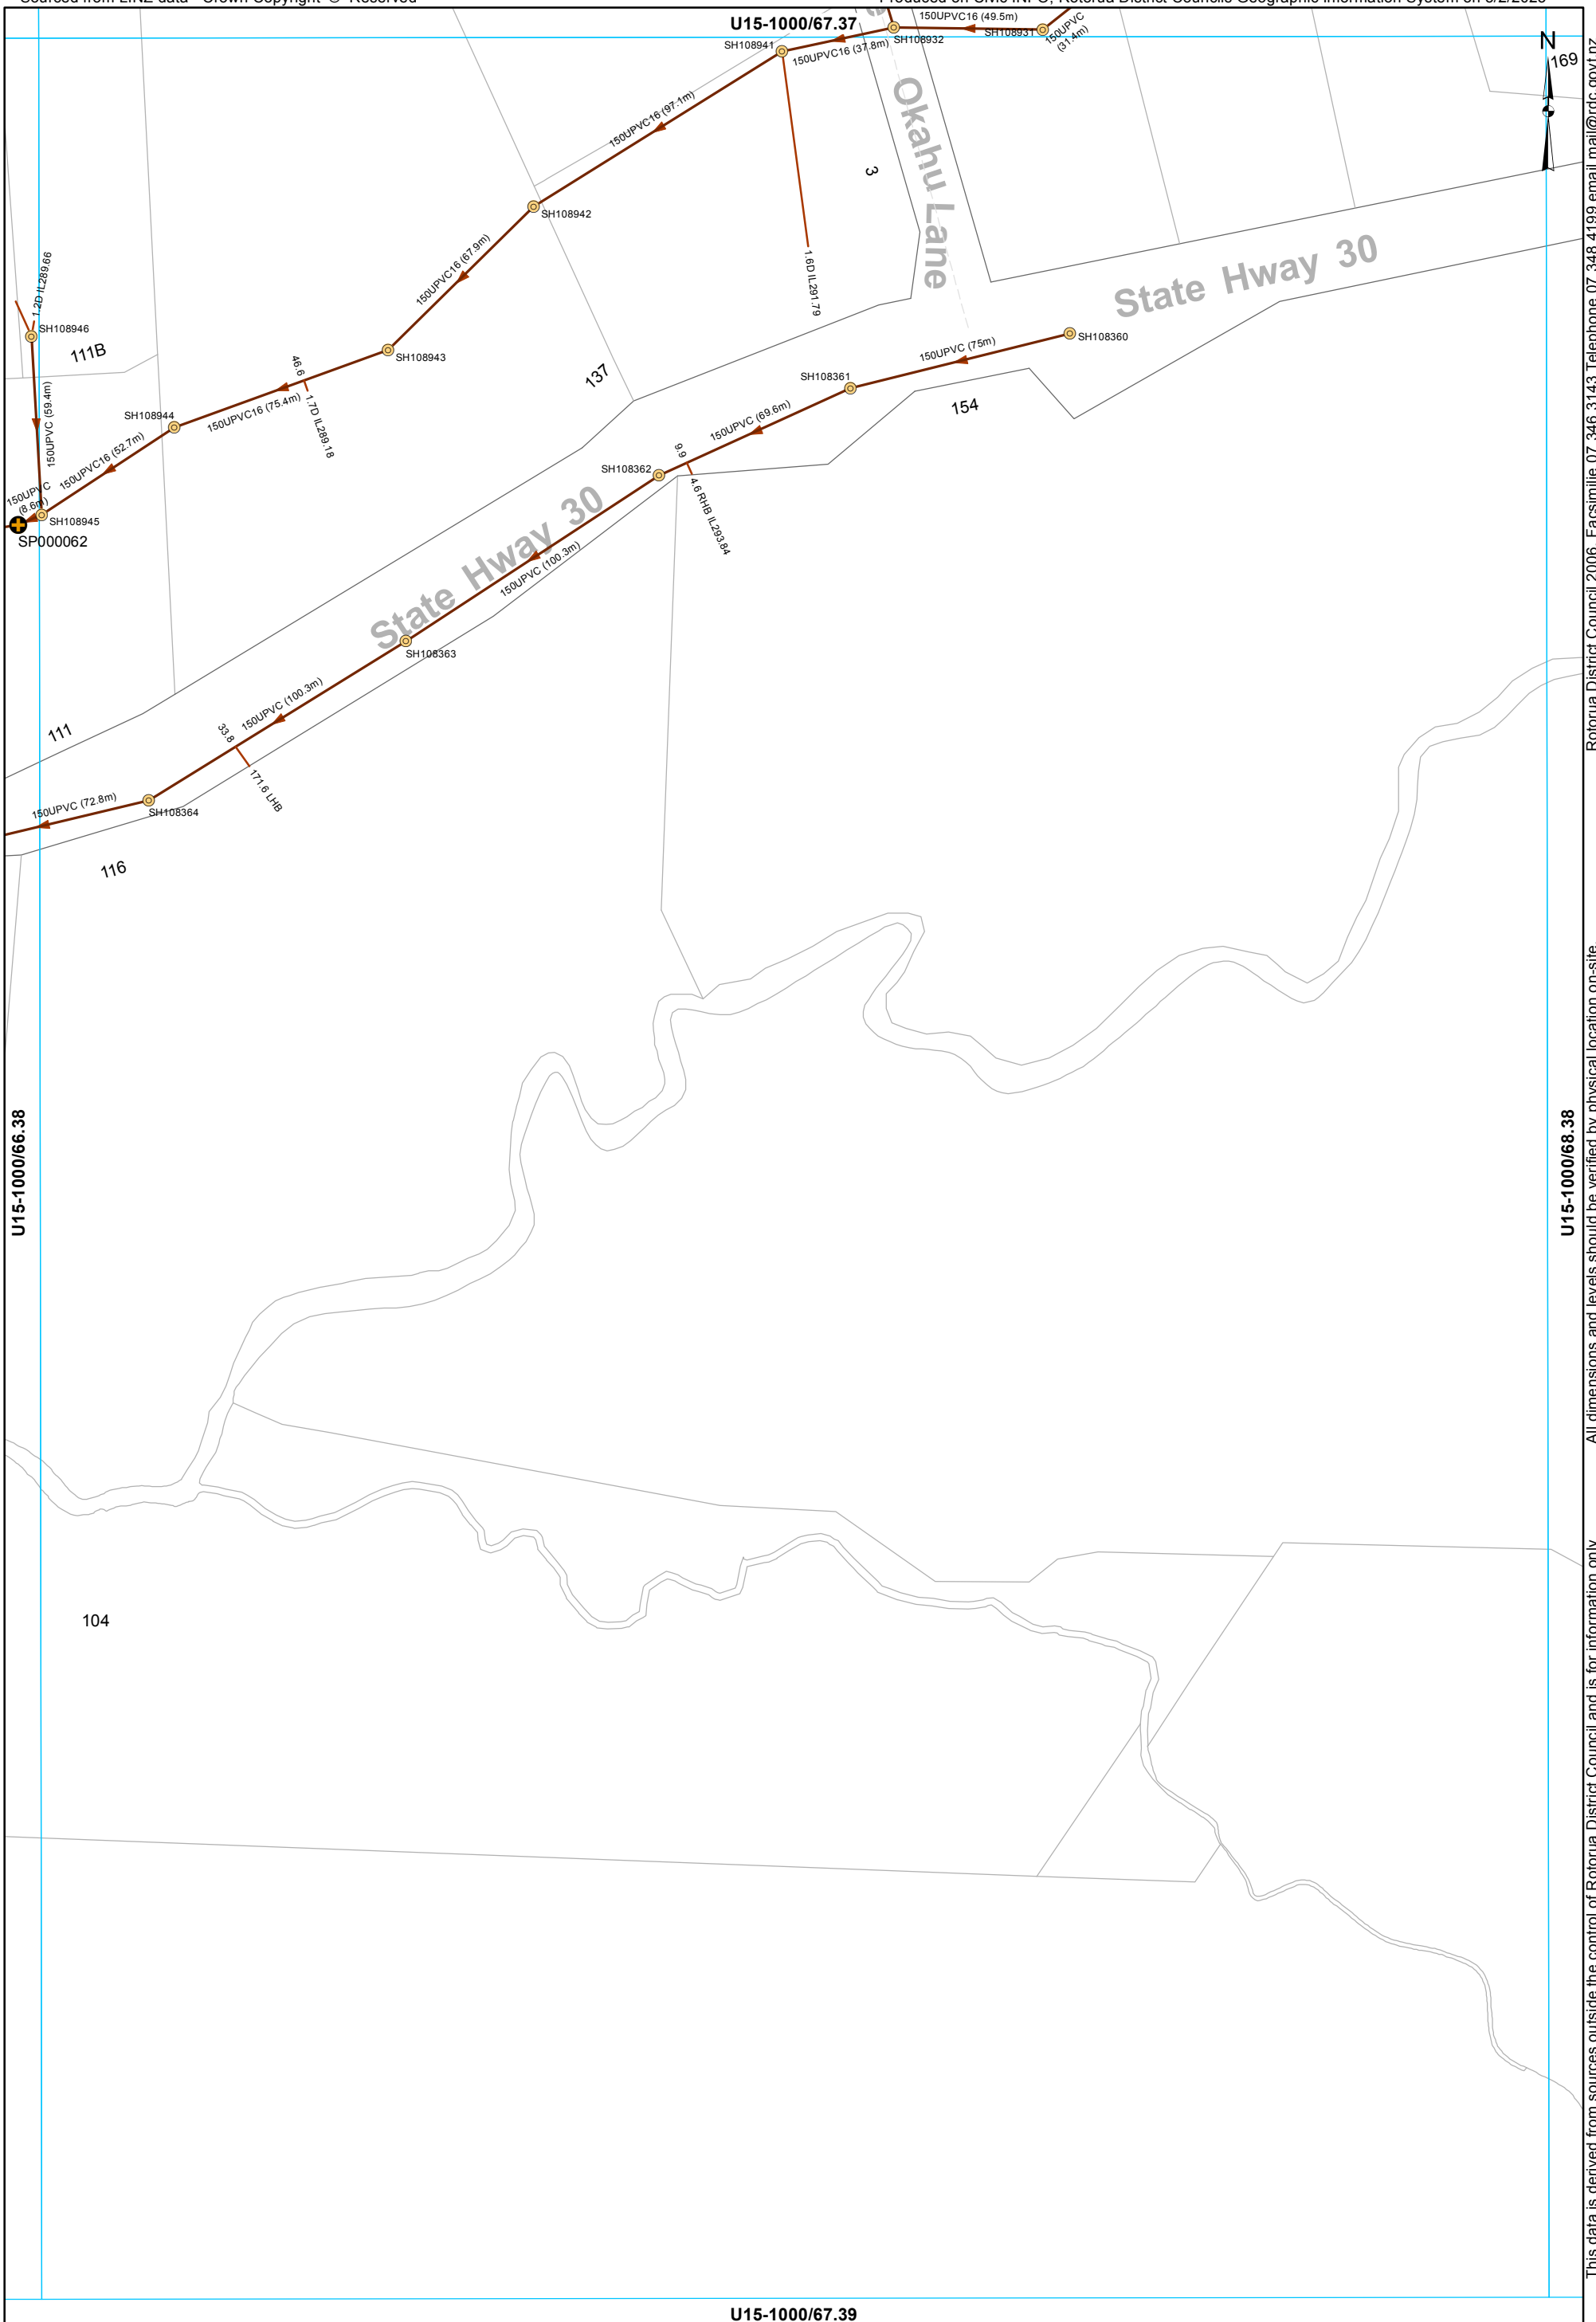

Rotorua District Council 2006. Facsimile 07 346 3143 Telephone 07 348 4199 email mail@rdc.govt.nz

All dimensions and levels should be verified by physical location on-site.

This data is derived from sources outside the control of Rotorua District Council and is for information only

- ⊙ Manhole
- ⊕ Pump Station
- Main line
- - - Rising main
- Service Line

WASTEWATER SERVICES
1:2000 @ A3 - (U15-1000/67.38)

U15-1000/67.39



● Manhole → Main line

WASTEWATER SERVICES
1:2000 @ A3 - (U15-1000/68.38)

This data is derived from sources outside the control of Rotorua District Council and is for information only


Rotorua District Council 2006. Facsimile 07 346 3143 Telephone 07 348 4199 email mail@rdc.govt.nz

U15-1000/64.38



U15-1000/63.39

U15-1000/65.39

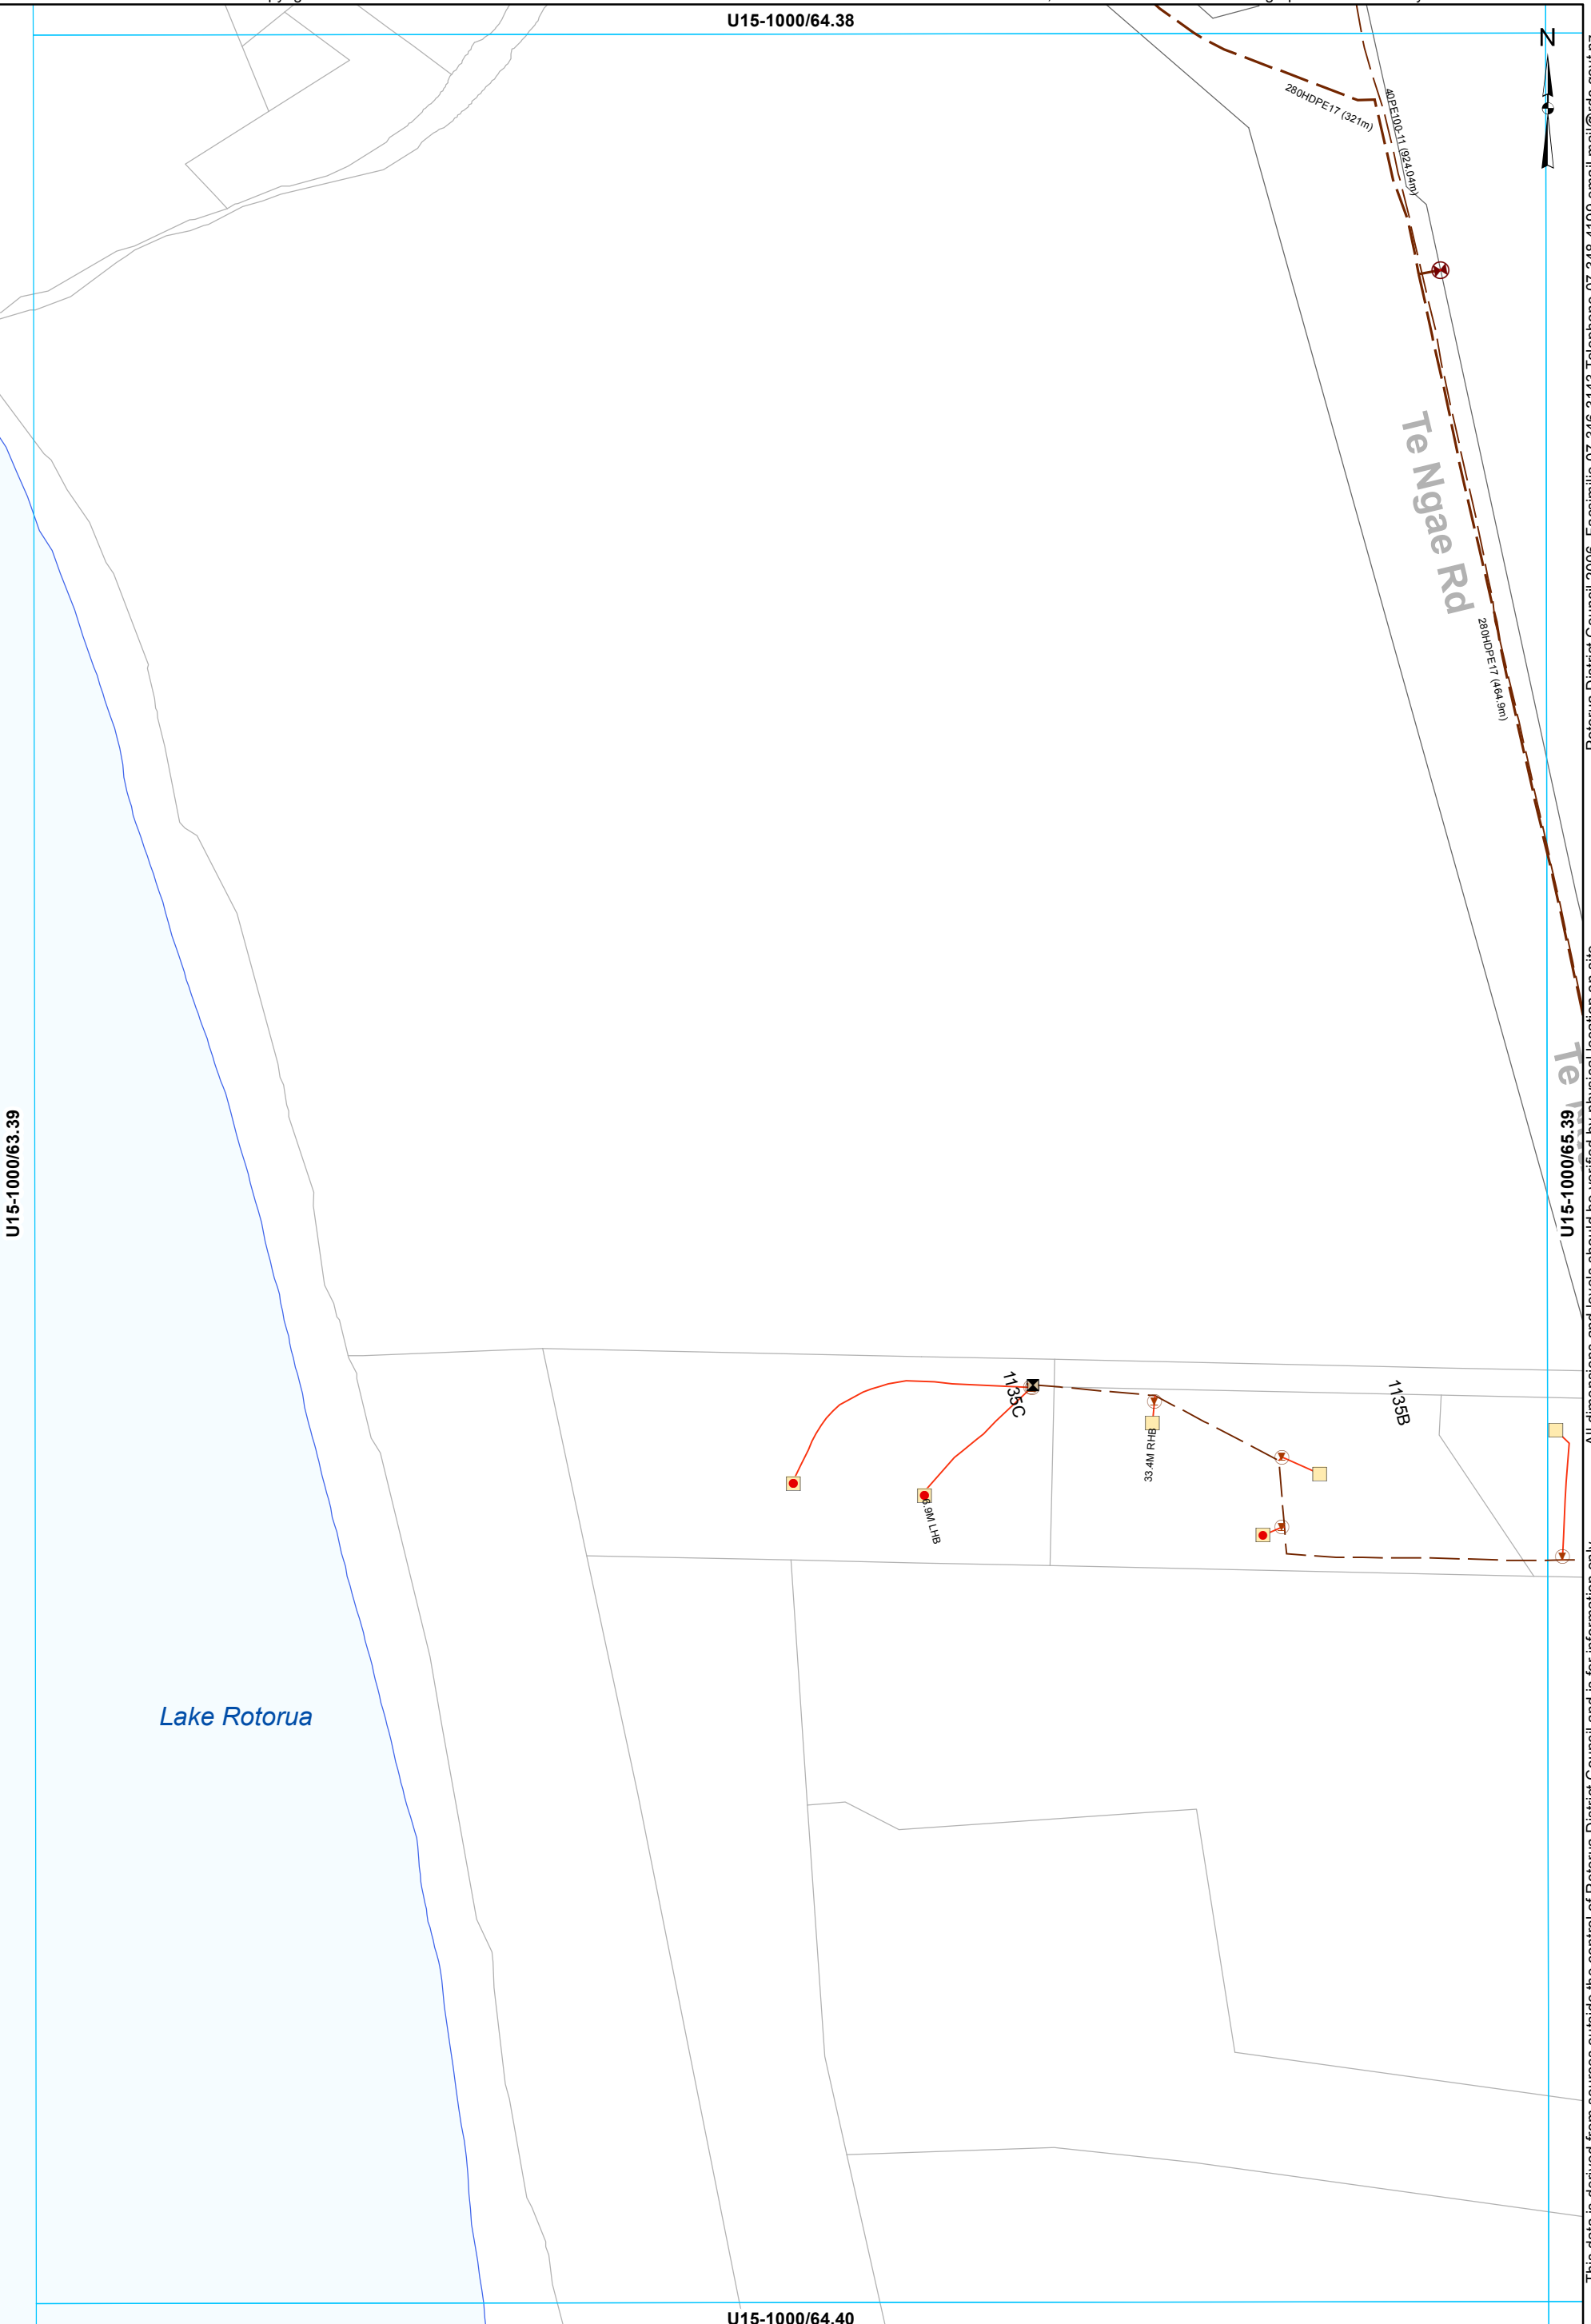

All dimensions and levels outside the control of Rotorua District Council and is for information only. Rotorua District Council 2006. Facsimile 07 346 3143 Telephone 07 348 4199 email mail@rdc.govt.nz

- Grinder Pump Chamber
- LP Grinder Pump
- Air Valve
- Boundary Assembly
- Clean Out Point
- Low Pressure Main
- Rising main
- LPGP Service Line

WASTEWATER SERVICES
1:2000 @ A3 - (U15-1000/64.39)

U15-1000/65.38



- Grinder Pump Chamber
- Air Valve
- Boundary Assembly
- Low Pressure Main
- Rising main
- LPGP Service Line


WASTEWATER SERVICES
1:2000 @ A3 - (U15-1000/65.39)

This data is derived from sources outside the control of Rotorua District Council and is for information only

Rotorua District Council 2006. Facsimile 07 346 3143 Telephone 07 348 4199 email mail@rdc.govt.nz

U15-1000/66.39

U15-1000/65.40

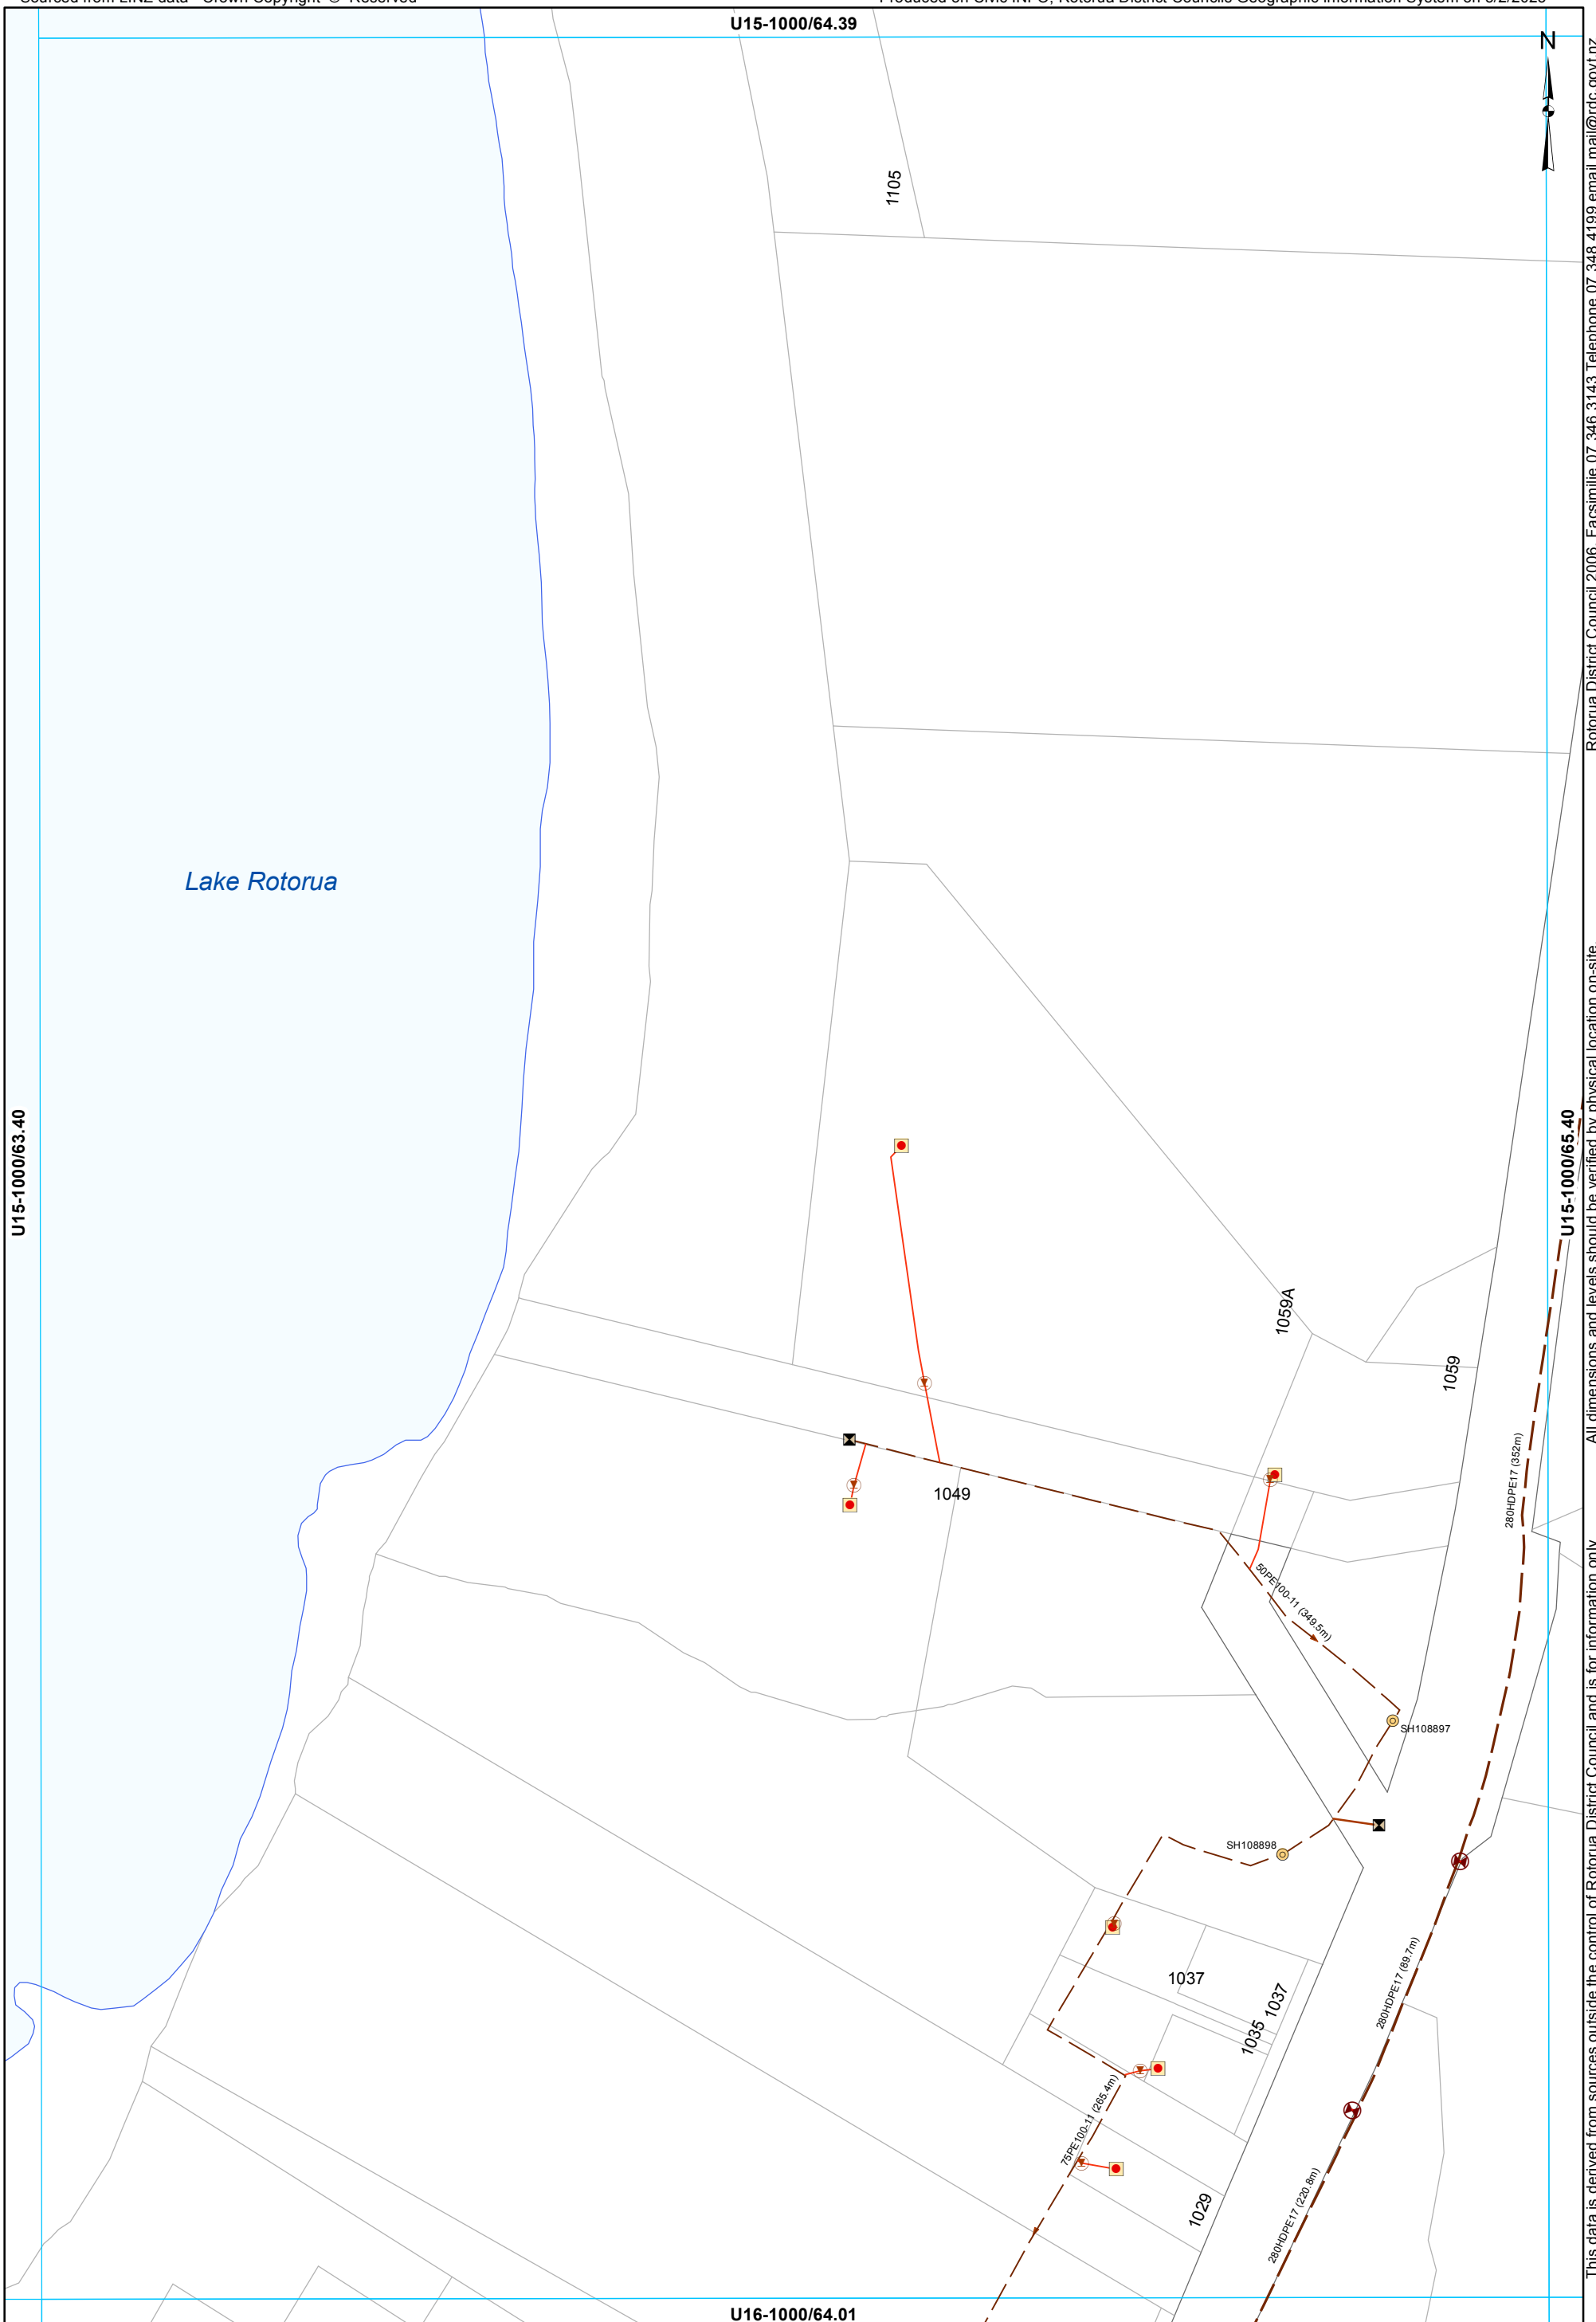

- Manhole
- Grinder Pump Chamber
- LP Grinder Pump
- Air Valve
- Boundary Assembly
- Clean Out Point
- Low Pressure Main
- Rising main
- Service Line
- LPGP Service Line

WASTEWATER SERVICES
1:2000 @ A3 - (U15-1000/64.40)

This data is derived from sources outside the control of Rotorua District Council and is for information only

Rotorua District Council 2006. Facsimile 07 346 3143 Telephone 07 348 4199 email mail@rdc.govt.nz

U15-1000/65.39



1102

Te Ngae Rd

280HDPE17 (479.7m)

U15-1000/64.40

280HDPE17 (932m)

U15-1000/66.40

All dimensions and levels should be verified by physical location on-site.

This data is derived from sources outside the control of Rotorua District Council and is for information only

Rotorua District Council 2006. Facsimile 07 346 3143 Telephone 07 348 4199 email mail@rdc.govt.nz

⊗ Air Valve - Rising main

U16-1000/65.01

41

57

WASTEWATER SERVICES
1:2000 @ A3 - (U15-1000/65.40)

U15-1000/63.40



Lake Rotorua

U16-1000/62.01

U16-1000/64.01

981

50PE100-11 (412.9m)

150UPVC16 (65.9m)
SH108882
150UPVC16 (69.6m)
SH108881
SP000069

SH108885
300UPVC16 (14.3m)
SH108886
150UPVC12 (58.8m)

SH108887
300UPVC16 (43.7m)
SH108888
300UPVC16 (80.4m)

225UPVC16 (80.4m)
SH108888
300UPVC16 (82.3m)
SH108887
300UPVC16 (43.7m)
SH108885
150UPVC12 (58.8m)
300UPVC16 (14.3m)
SH108886
150UPVC16 (69.6m)
SH108882
150UPVC16 (65.9m)
SP000069
5.2 LHB 1.5D IL288.9
12.7 RHB 1.3D IL288.
7.5 LHB 1.3D IL288.7
947
225UPVC16 (76.3m)
SH108889
300UPVC16 (80.4m)
225UPVC16 (80.4m)
SH108889


U16-1000/63.02

- Manhole
- Pump Station
- Grinder Pump Chamber
- LP Grinder Pump
- Boundary Assembly
- Clean Out Point
- Low Pressure Main
- Main line
- Rising main
- Service Line
- LPGP Service Line

WASTEWATER SERVICES
1:2000 @ A3 - (U16-1000/63.01)

All dimensions and levels should be verified by physical location on-site. Rotorua District Council and is for information only. Rotorua District Council 2006. Facsimile 07 346 3143 Telephone 07 348 4199 email mail@rdc.govt.nz

U15-1000/64.40

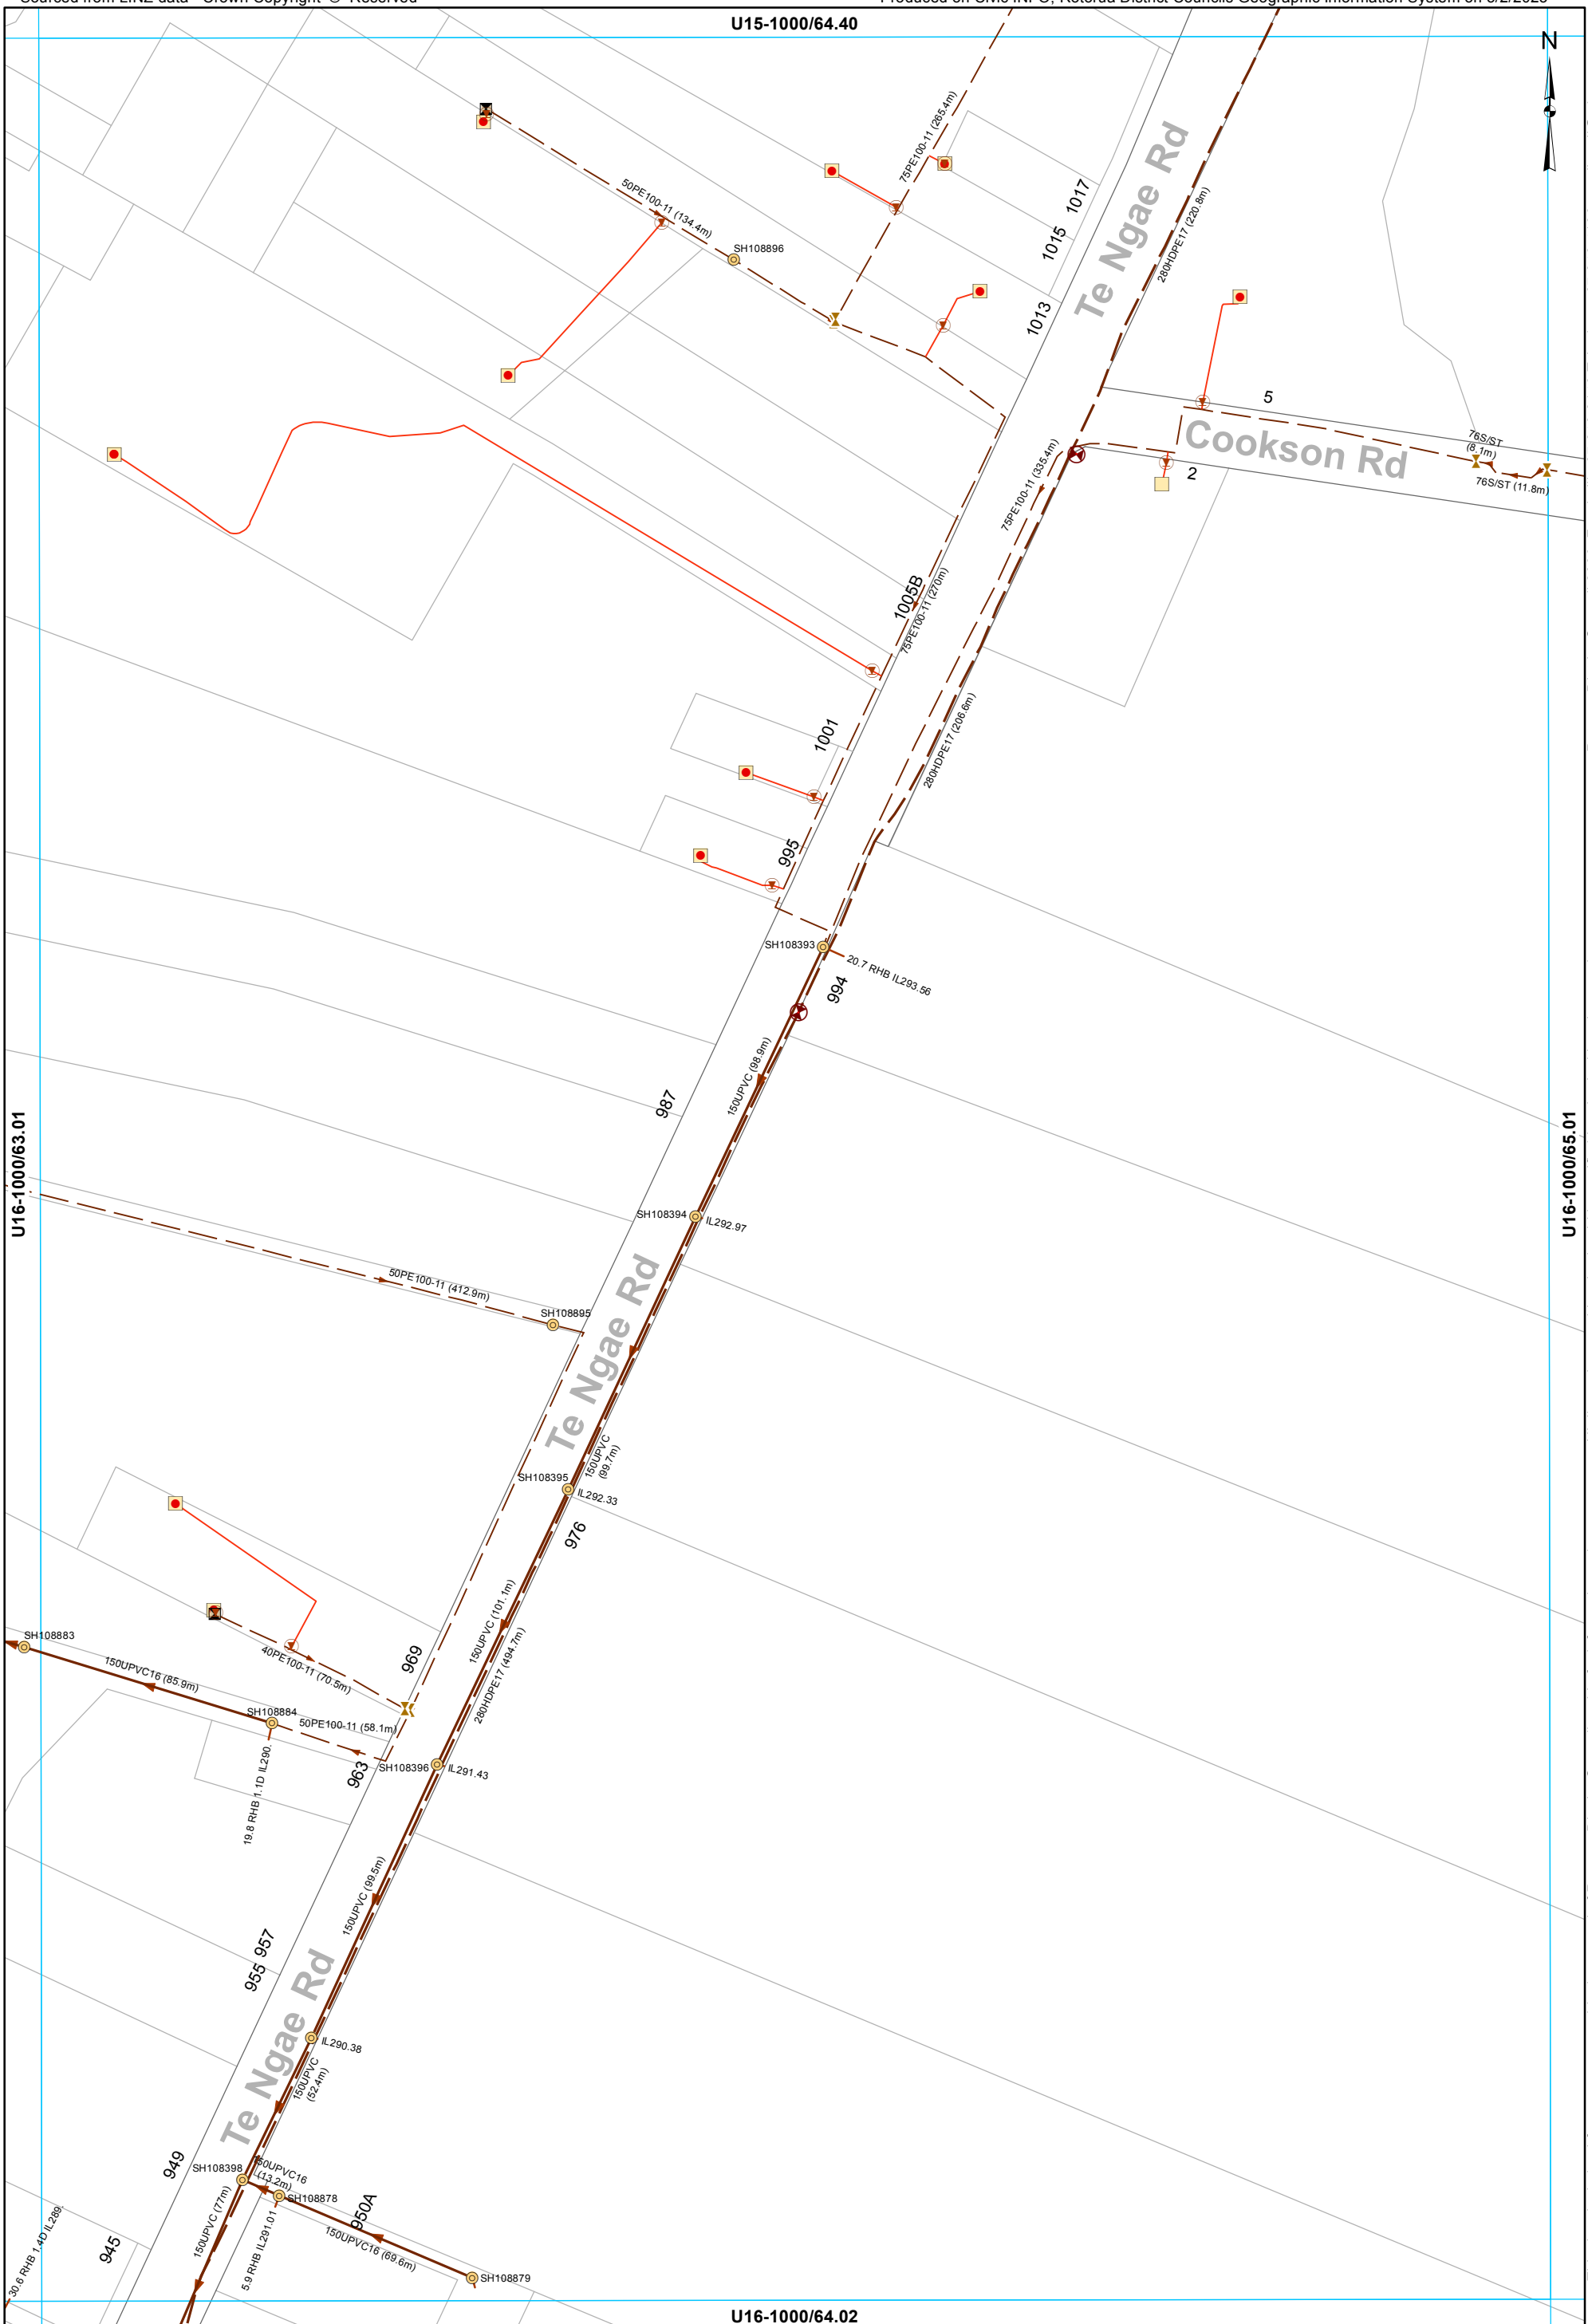

U16-1000/64.02

- Manhole
- Grinder Pump Chamber
- LP Grinder Pump
- Air Valve
- Boundary Assembly
- Clean Out Point
- Isolating Valve
- Low Pressure Main
- Main line
- Rising main
- Service Line
- LPGP Service Line

WASTEWATER SERVICES
1:2000 @ A3 - (U16-1000/64.01)

All dimensions and levels should be verified by physical location on-site. Rotorua District Council 2006. Facsimile 07 346 3143 Telephone 07 348 4199 email mail@rdc.govt.nz



Rotorua District Council 2006. Facsimile 07 346 3143 Telephone 07 348 4199 email mail@rdc.govt.nz

All dimensions and levels should be verified by physical location on-site.

This data is derived from sources outside the control of Rotorua District Council and is for information only

- Grinder Pump Chamber
- LP Grinder Pump
- Boundary Assembly
- Clean Out Point
- Isolating Valve
- Low Pressure Main
- LPGP Service Line

WASTEWATER SERVICES
1:2000 @ A3 - (U16-1000/65.01)

U16-1000/63.01

Lake Rotorua


U16-1000/62.02

U16-1000/64.02

This data is derived from sources outside the control of Rotorua District Council and is for information only

All dimensions and levels should be verified by physical location on-site.


Rotorua District Council 2006. Facsimile 07 346 3143 Telephone 07 348 4199 email mail@rdc.govt.nz

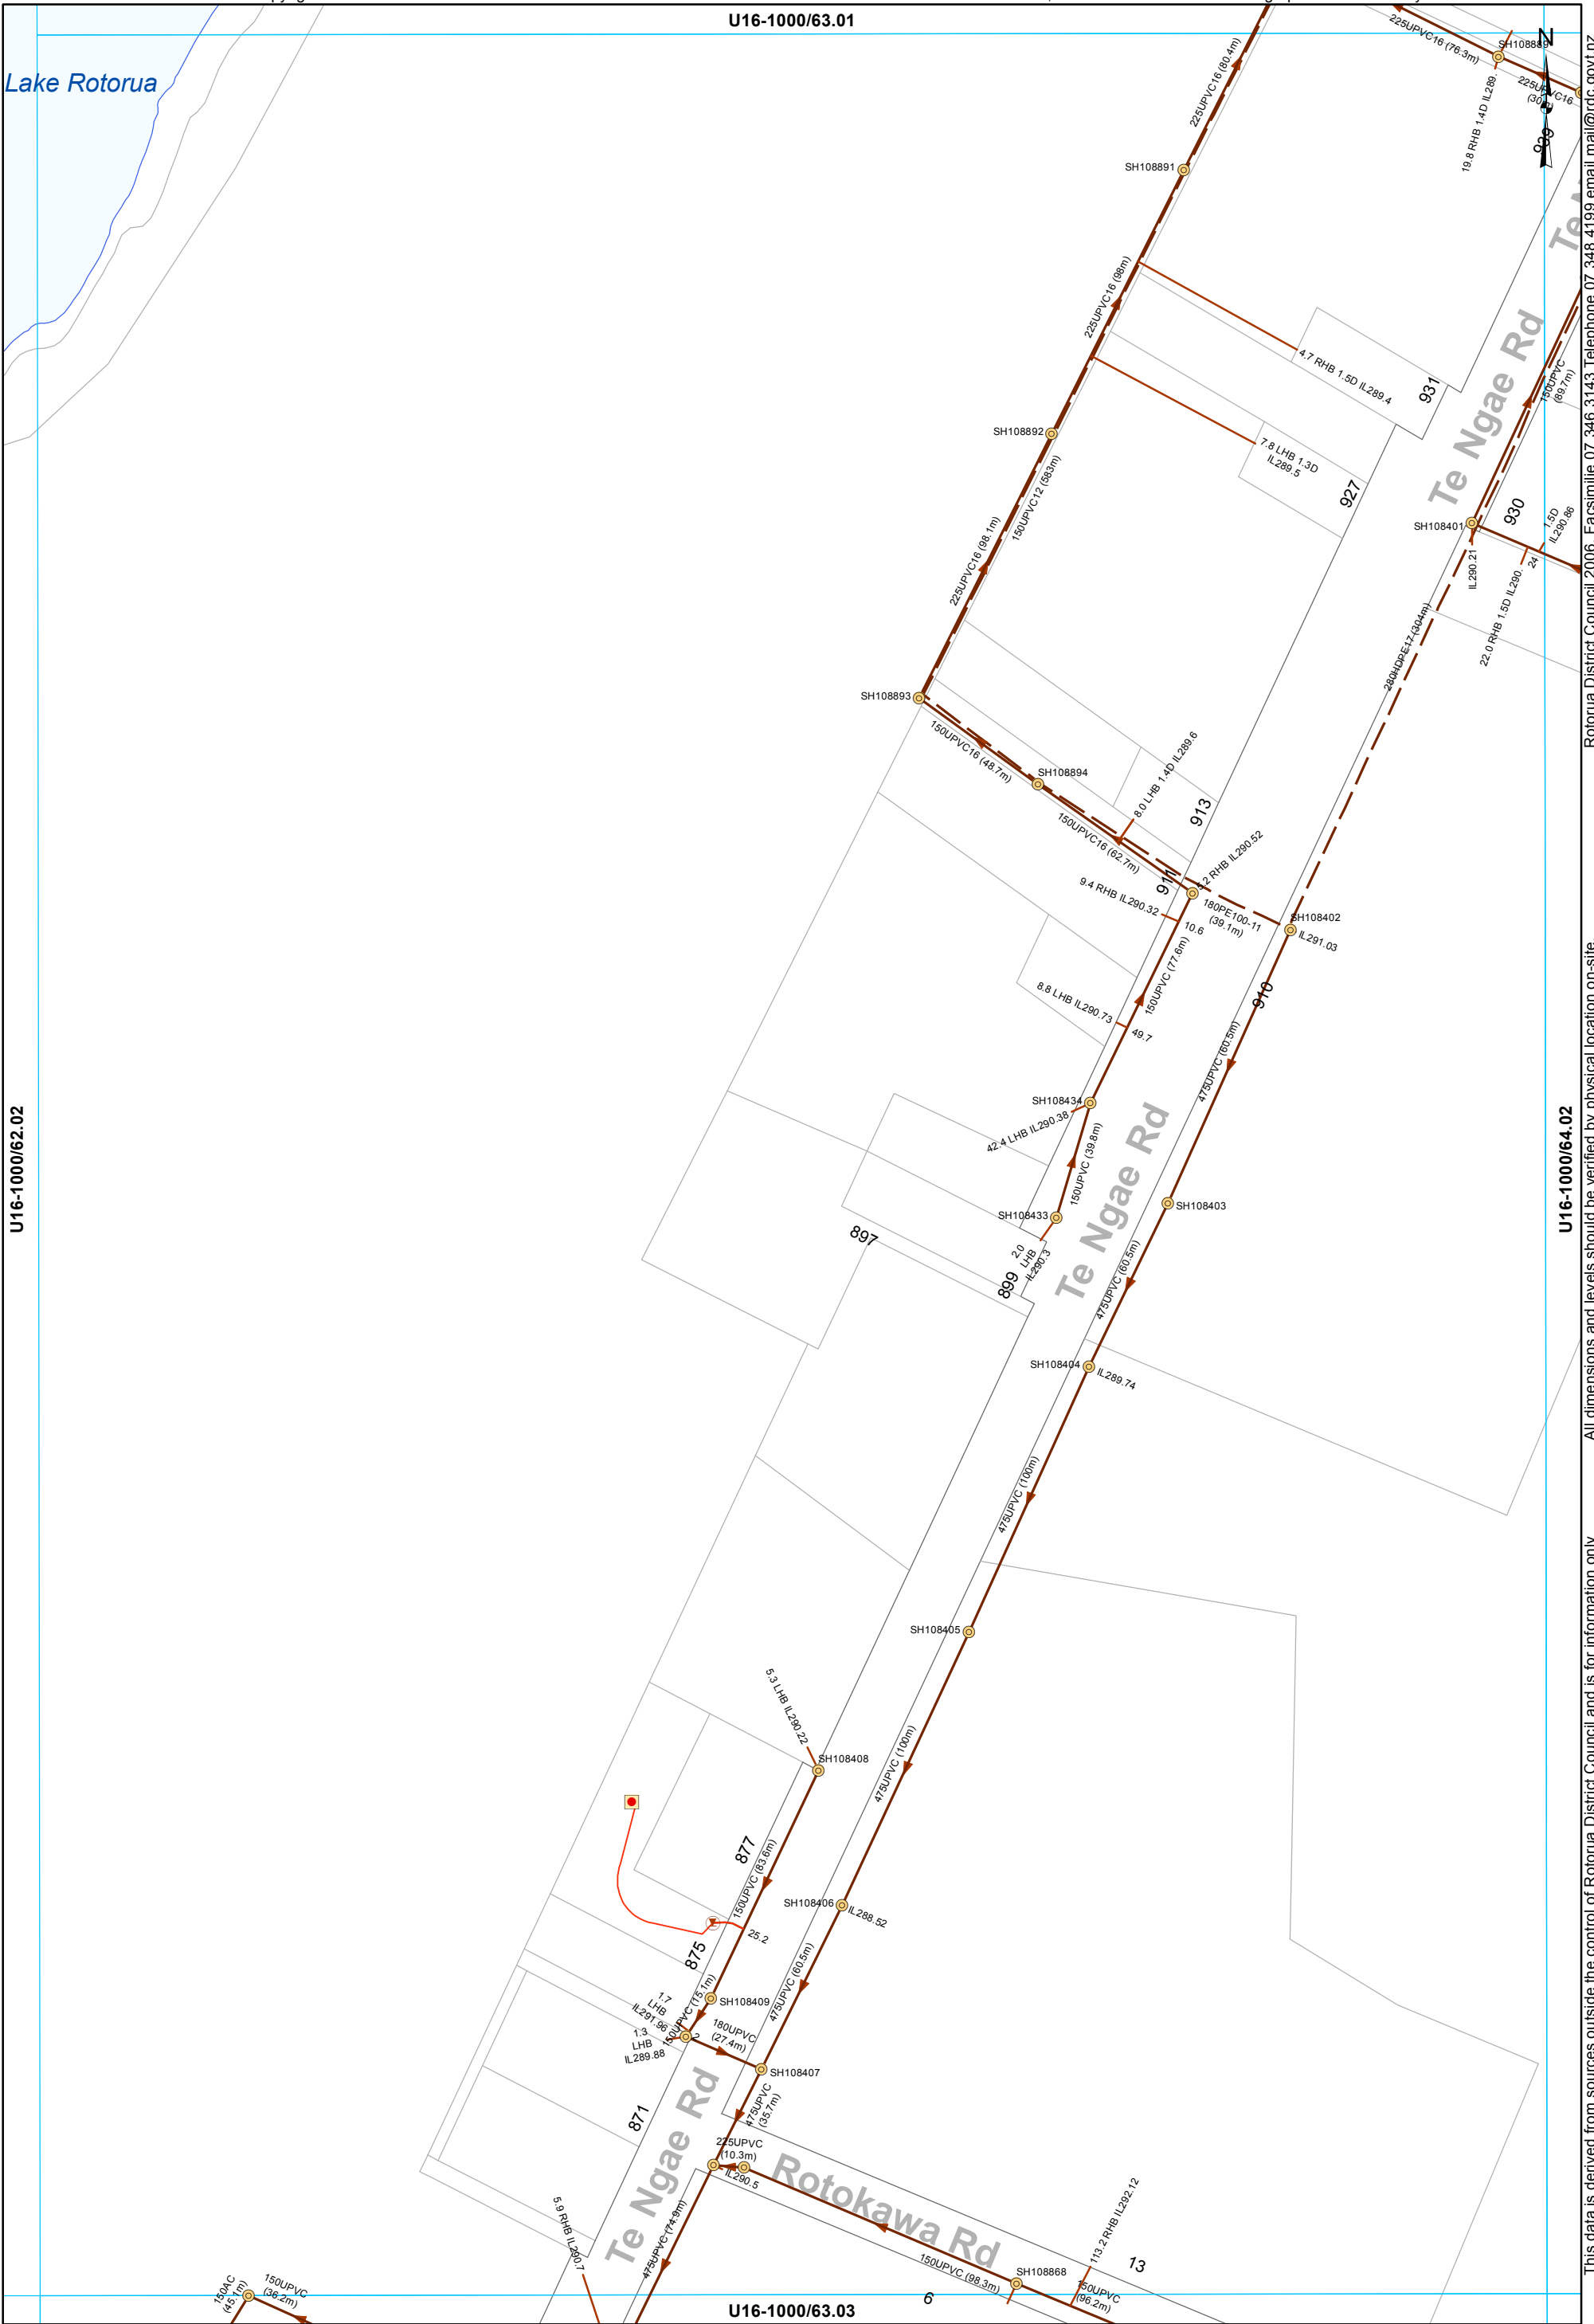

- Manhole
- Grinder Pump Chamber
- LP Grinder Pump
- Boundary Assembly
- Main line
- Rising main
- Service Line
- LPGP Service Line

WASTEWATER SERVICES
1:2000 @ A3 - (U16-1000/63.02)


U16-1000/64.01

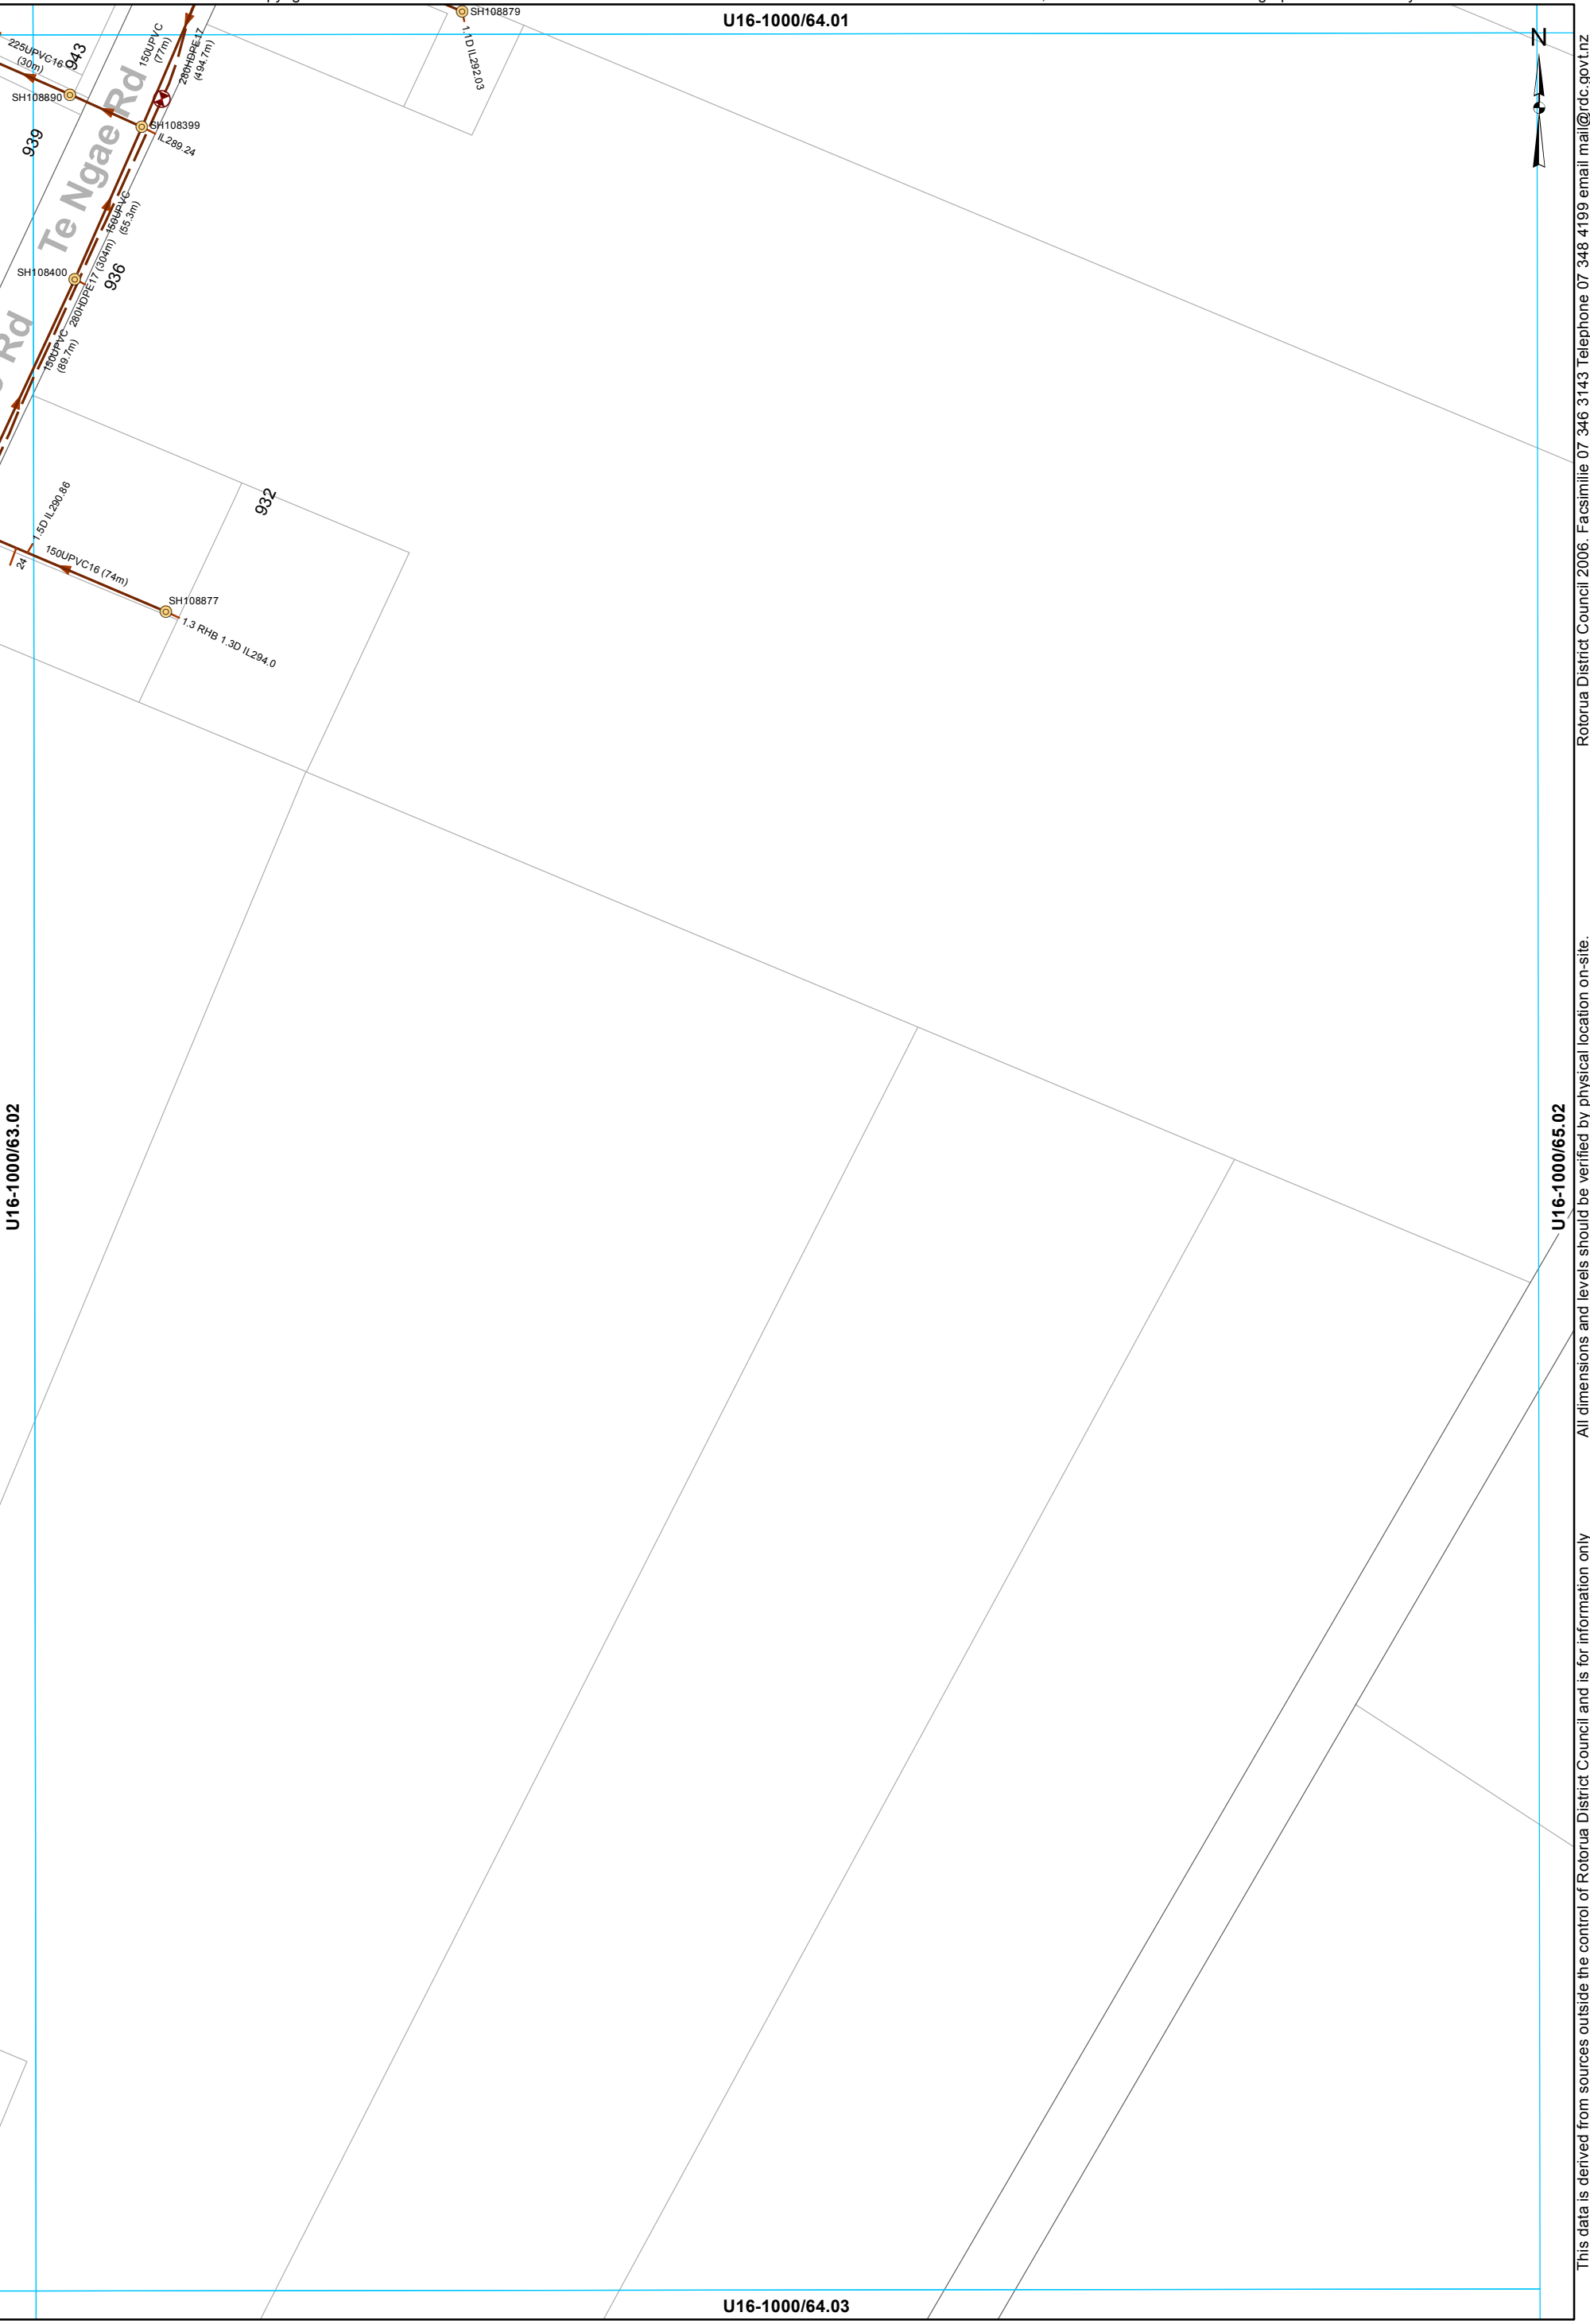

- Manhole
- ⊗ Air Valve
- Main line
- - - Rising main
- Service Line

WASTEWATER SERVICES
1:2000 @ A3 - (U16-1000/64.02)

This data is derived from sources outside the control of Rotorua District Council and is for information only. All dimensions and levels should be verified by physical location on-site. Rotorua District Council 2006. Facsimile 07 346 3143 Telephone 07 348 4199 email mail@rdc.govt.nz

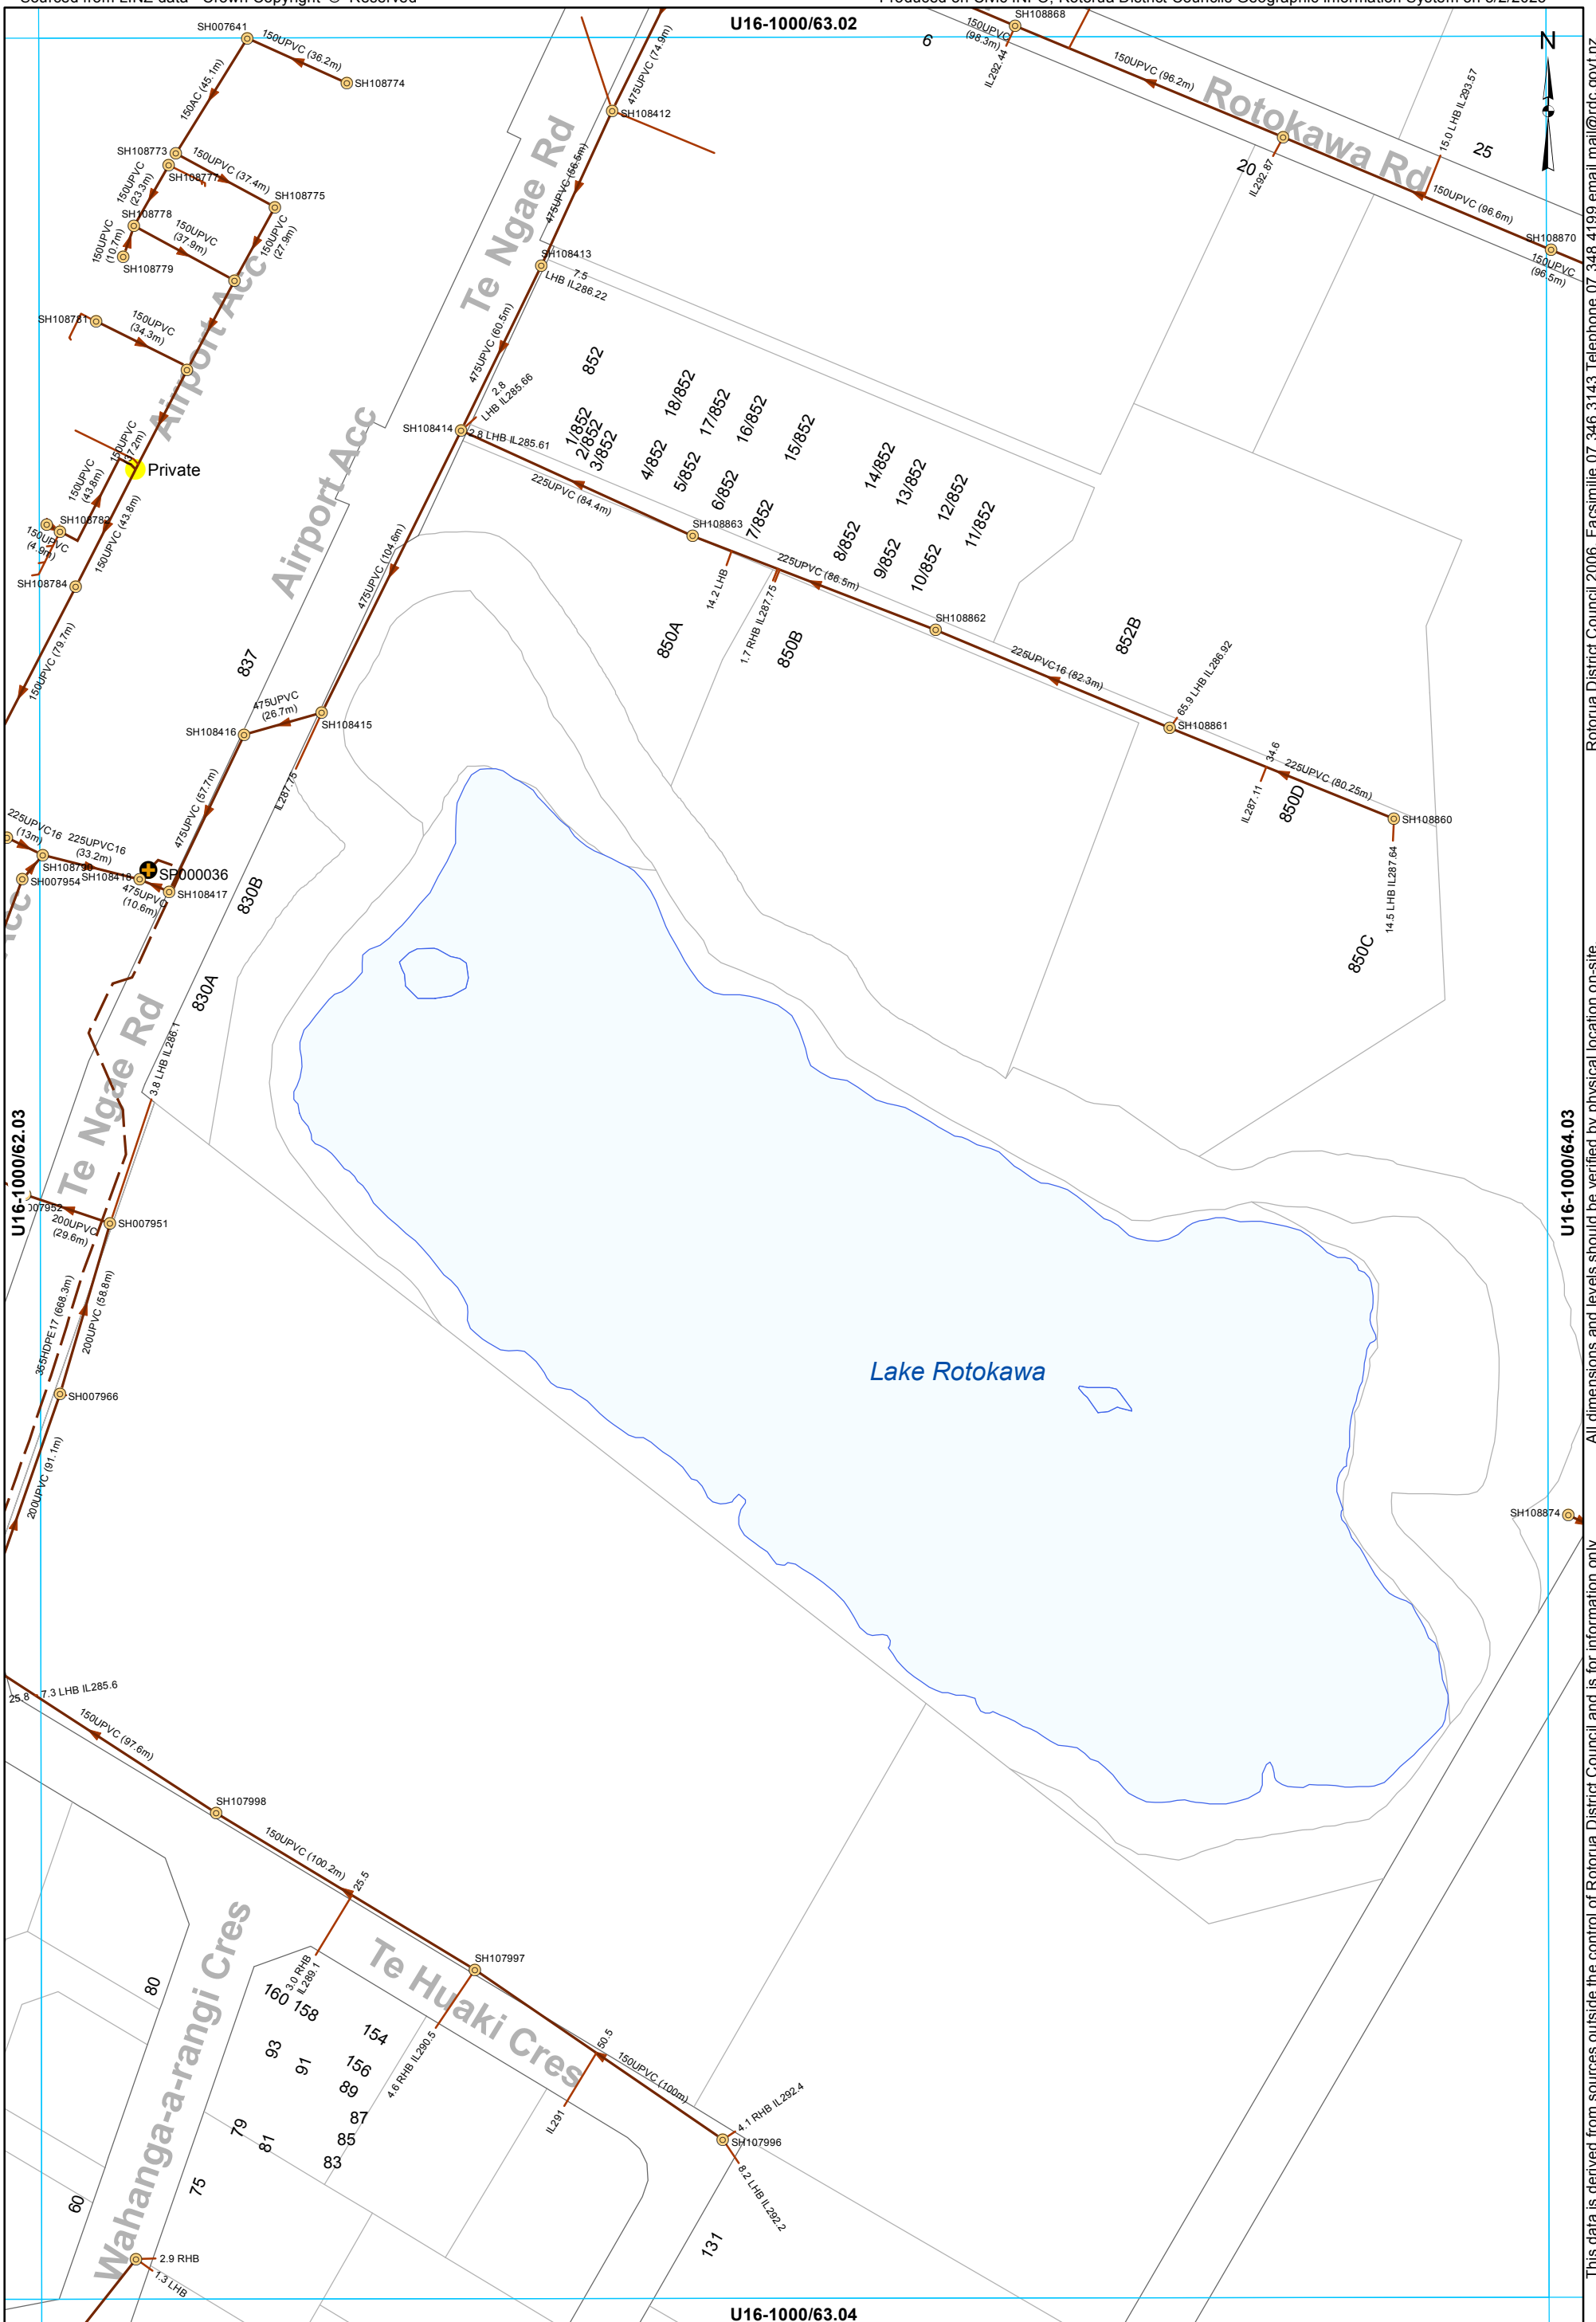


- Manhole
- ⊕ Pump Station
- Private Asset
- Main line
- - - Rising main
- Service Line

WASTEWATER SERVICES
1:2000 @ A3 - (U16-1000/63.03)

This data is derived from sources outside the control of Rotorua District Council and is for information only

Rotorua District Council 2006. Facsimilie 07 346 3143 Telephone 07 348 4199 email mail@rdc.govt.nz

U16-1000/64.02

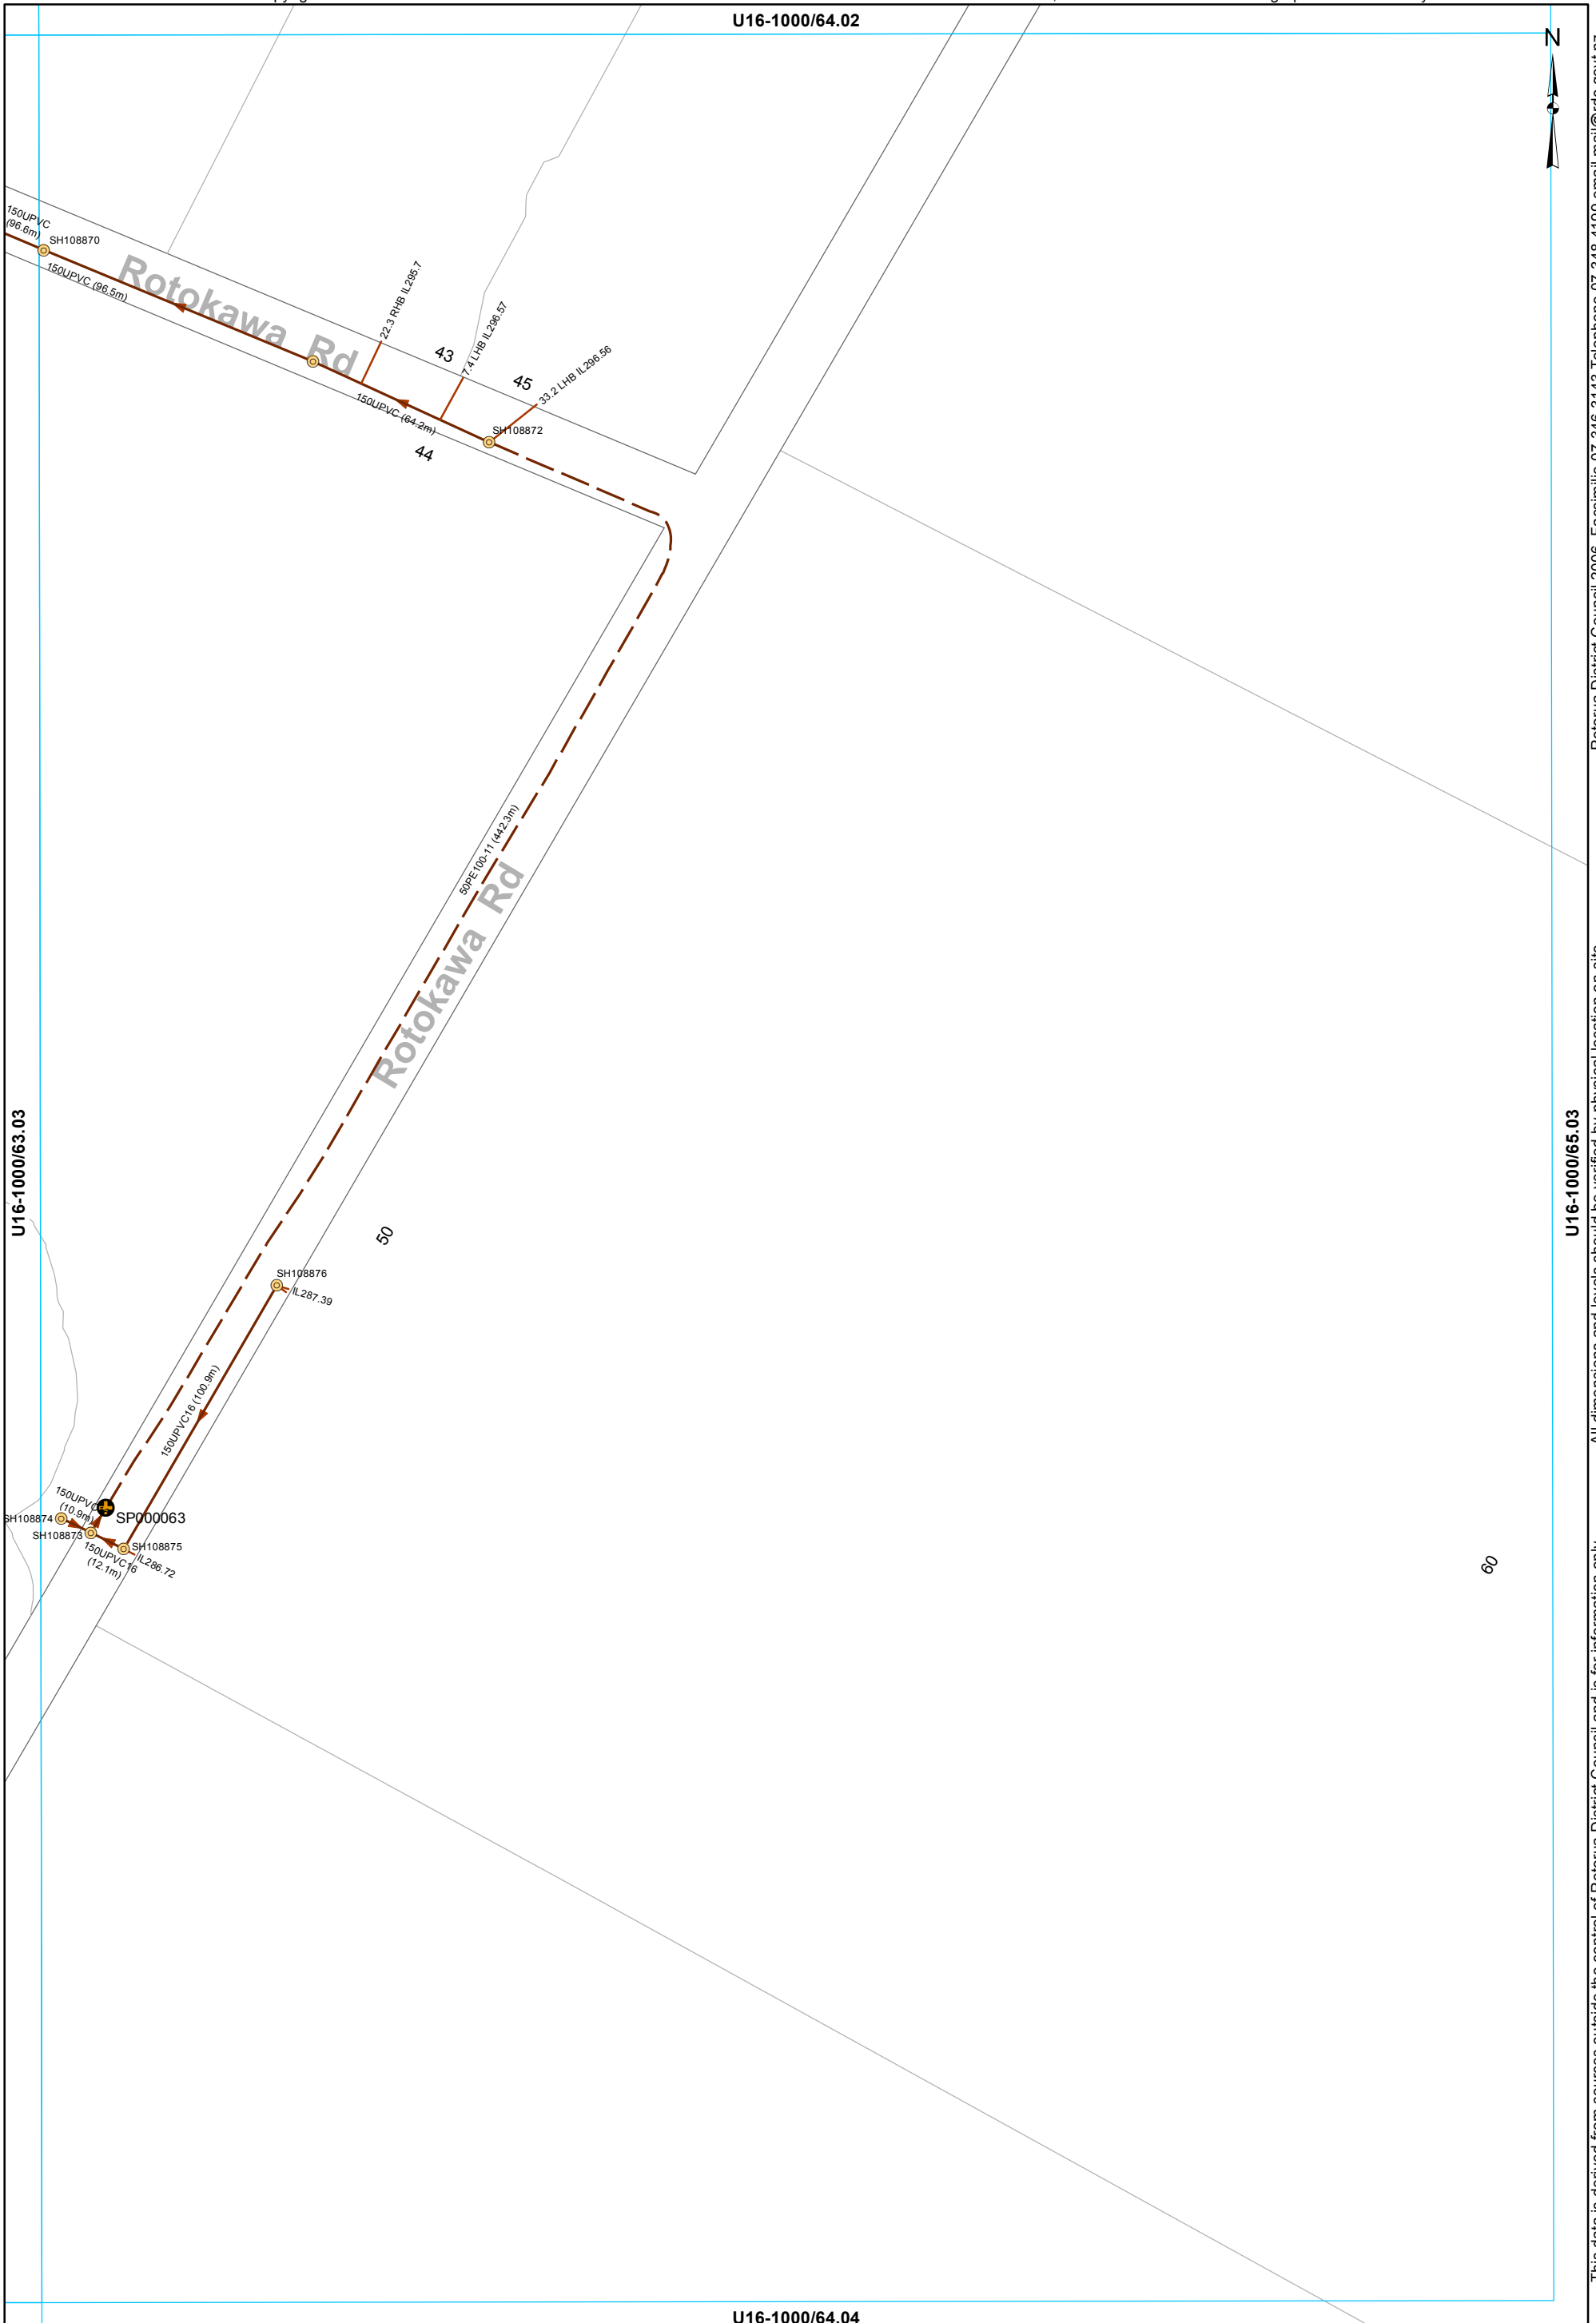

U16-1000/63.03

U16-1000/65.03

U16-1000/64.04

- Manhole
- Pump Station
- Main line
- Rising main
- Service Line

WASTEWATER SERVICES
1:2000 @ A3 - (U16-1000/64.03)

This data is derived from sources outside the control of Rotorua District Council and is for information only. All dimensions and levels should be verified by physical location on-site. Rotorua District Council 2006. Facsimile 07 346 3143 Telephone 07 348 4199 email mail@rdc.govt.nz