





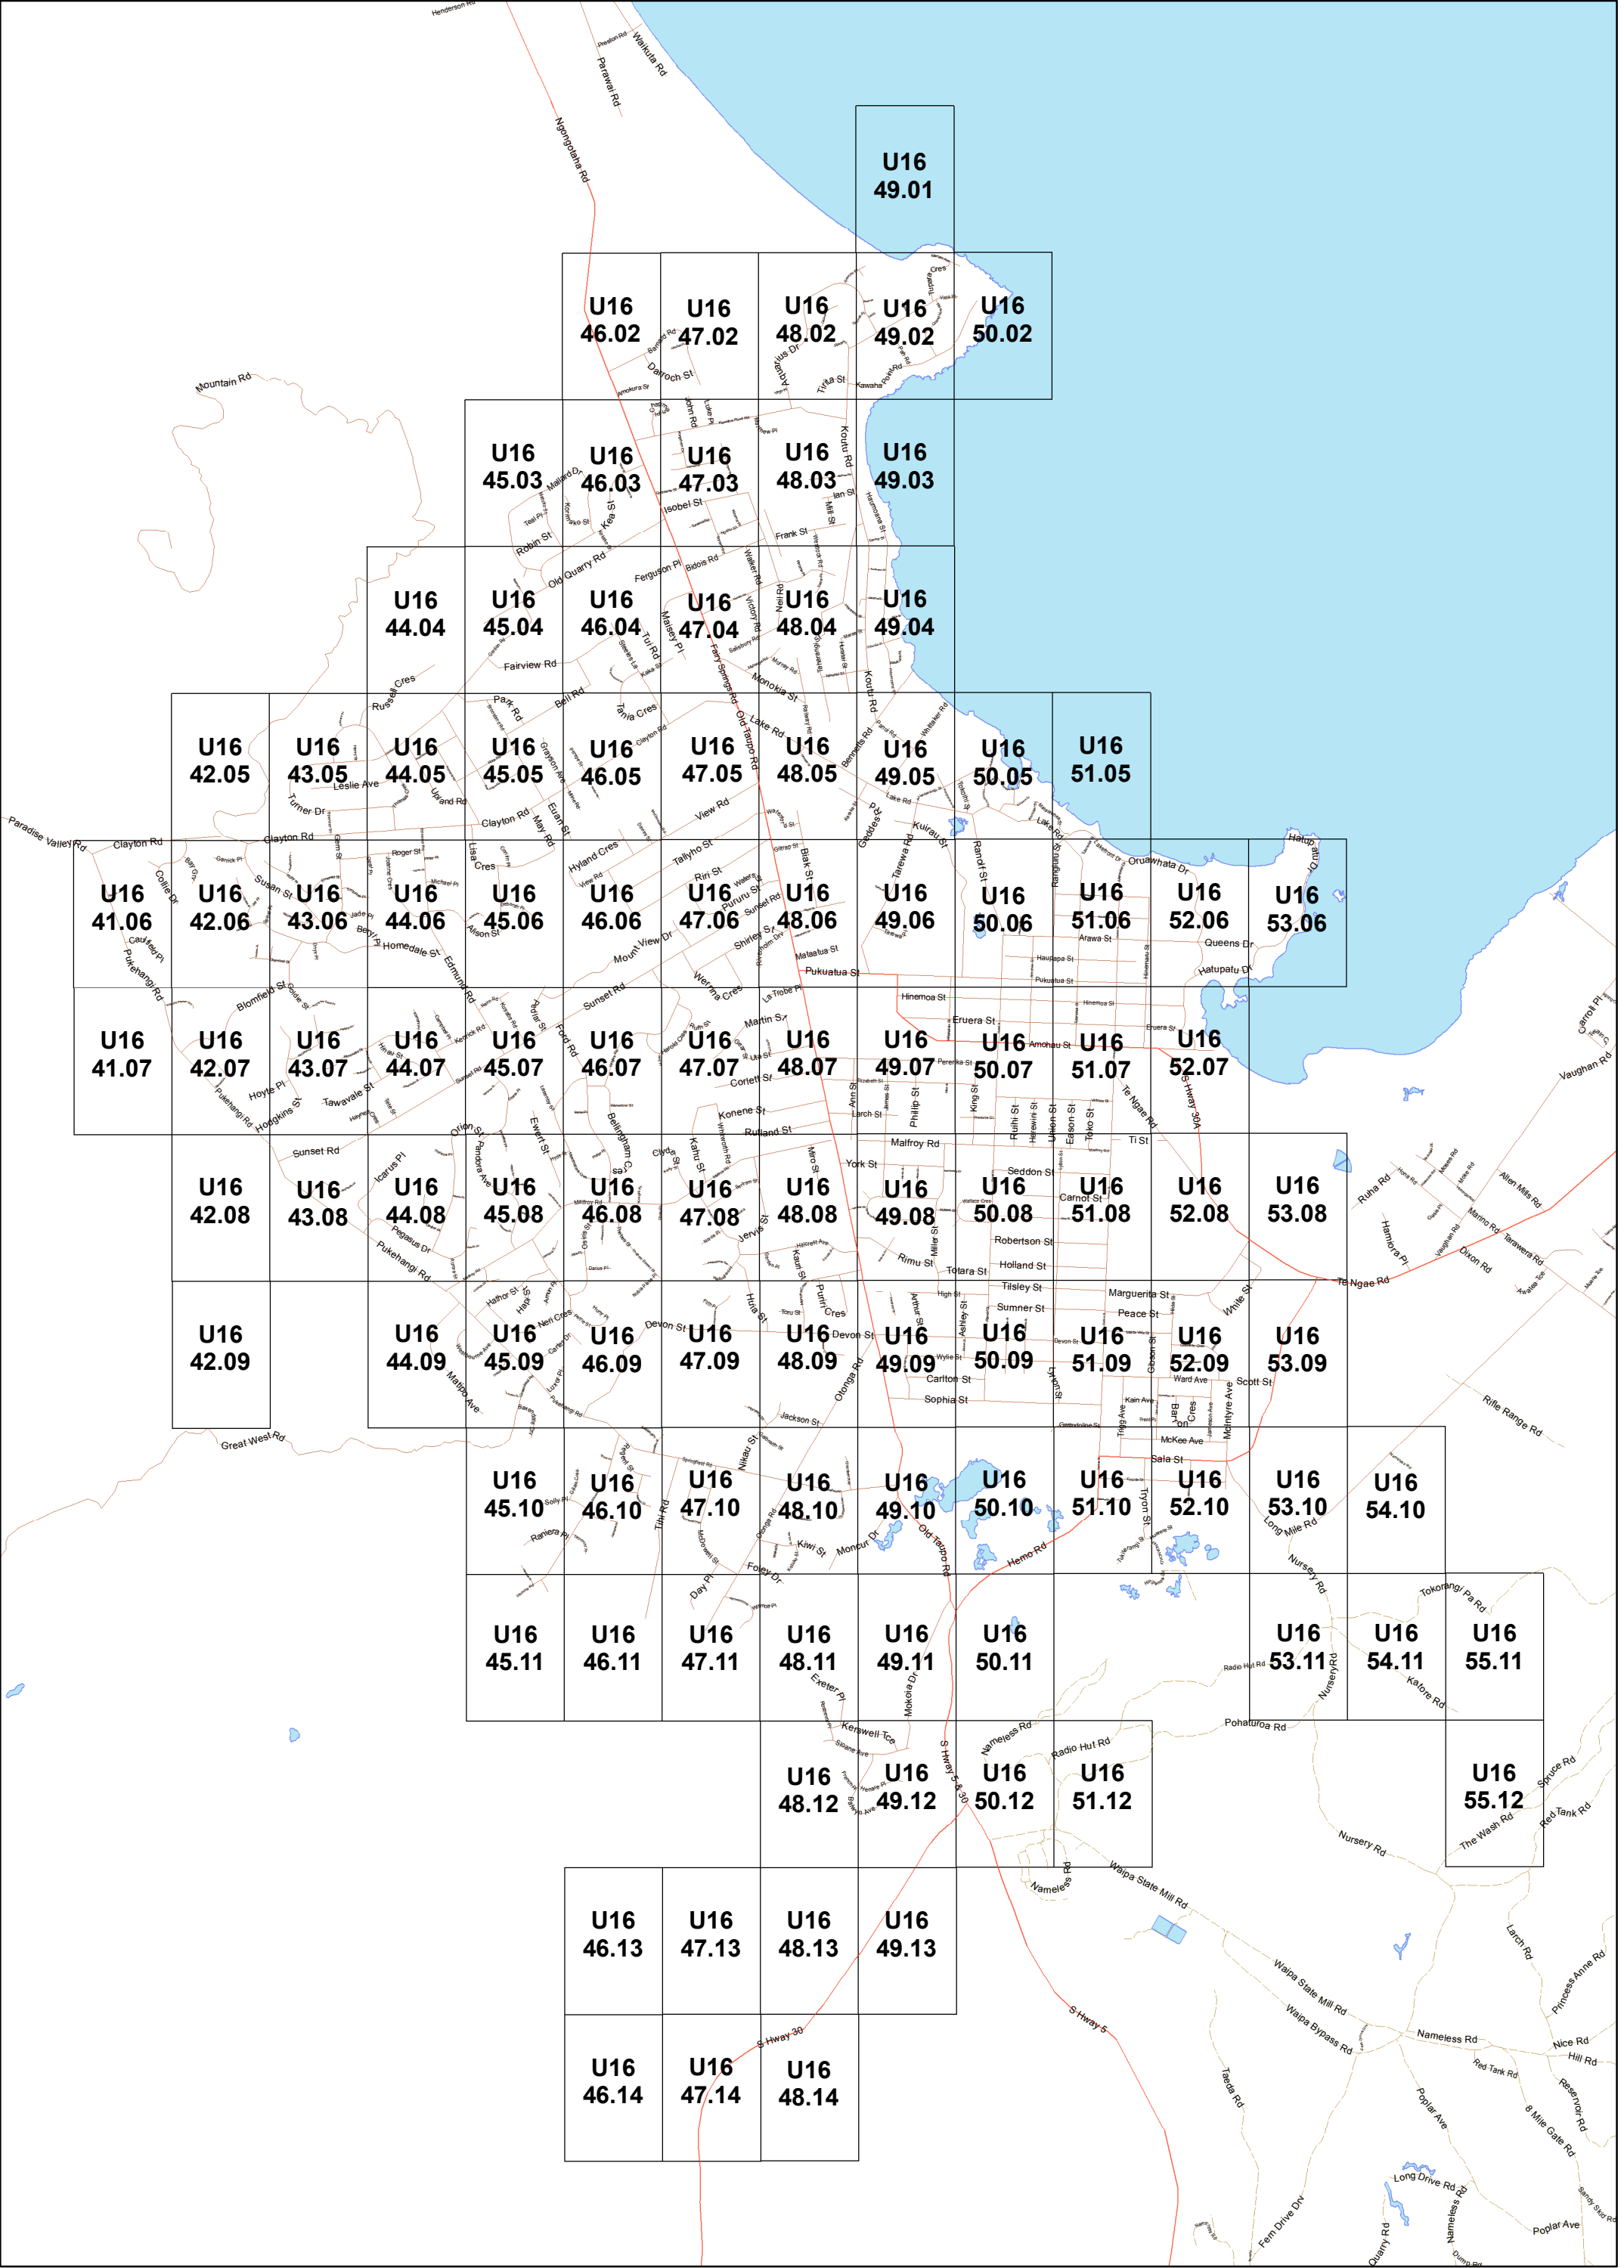

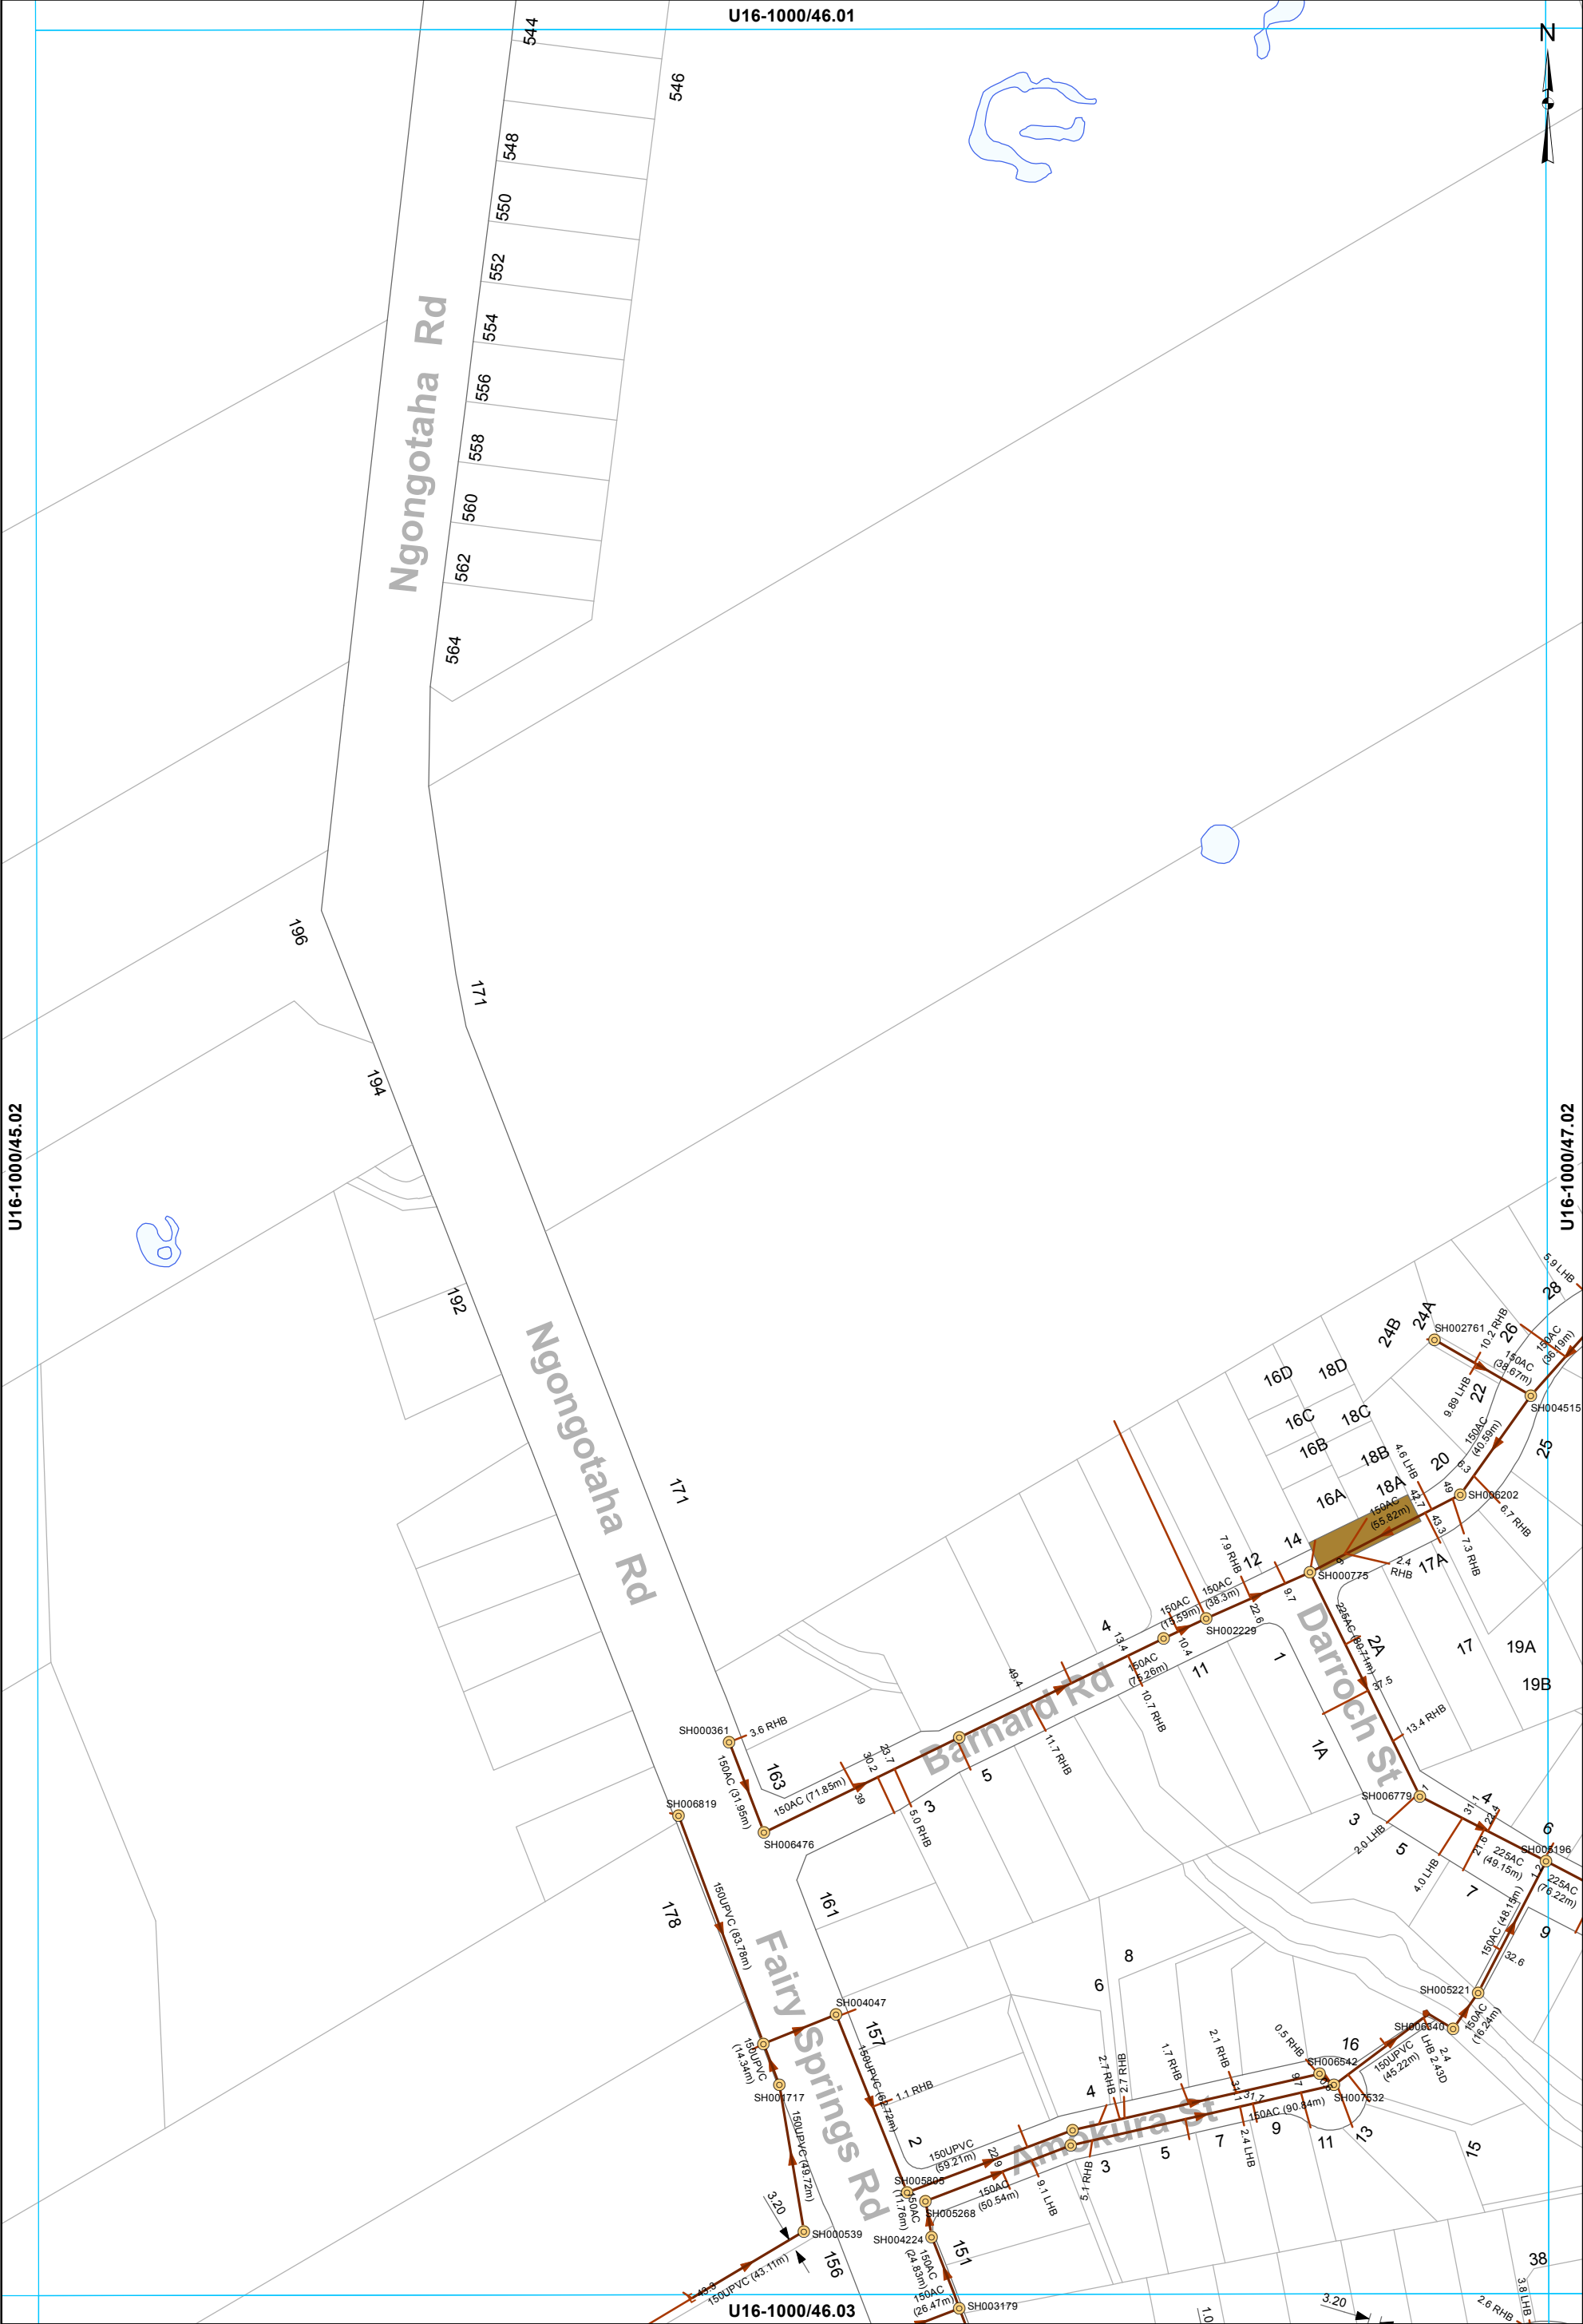


- Manhole
- End of line - Capped end
- End of line - Cleaning eye
- Main line
- Service Line

WASTEWATER SERVICES
1:2000 @ A3 - (U16-1000/46.02)

This data is derived from sources outside the control of Rotorua District Council and is for information only

Rotorua District Council 2006. Facsimile 07 346 3143 Telephone 07 348 4199 email mail@rdc.govt.nz

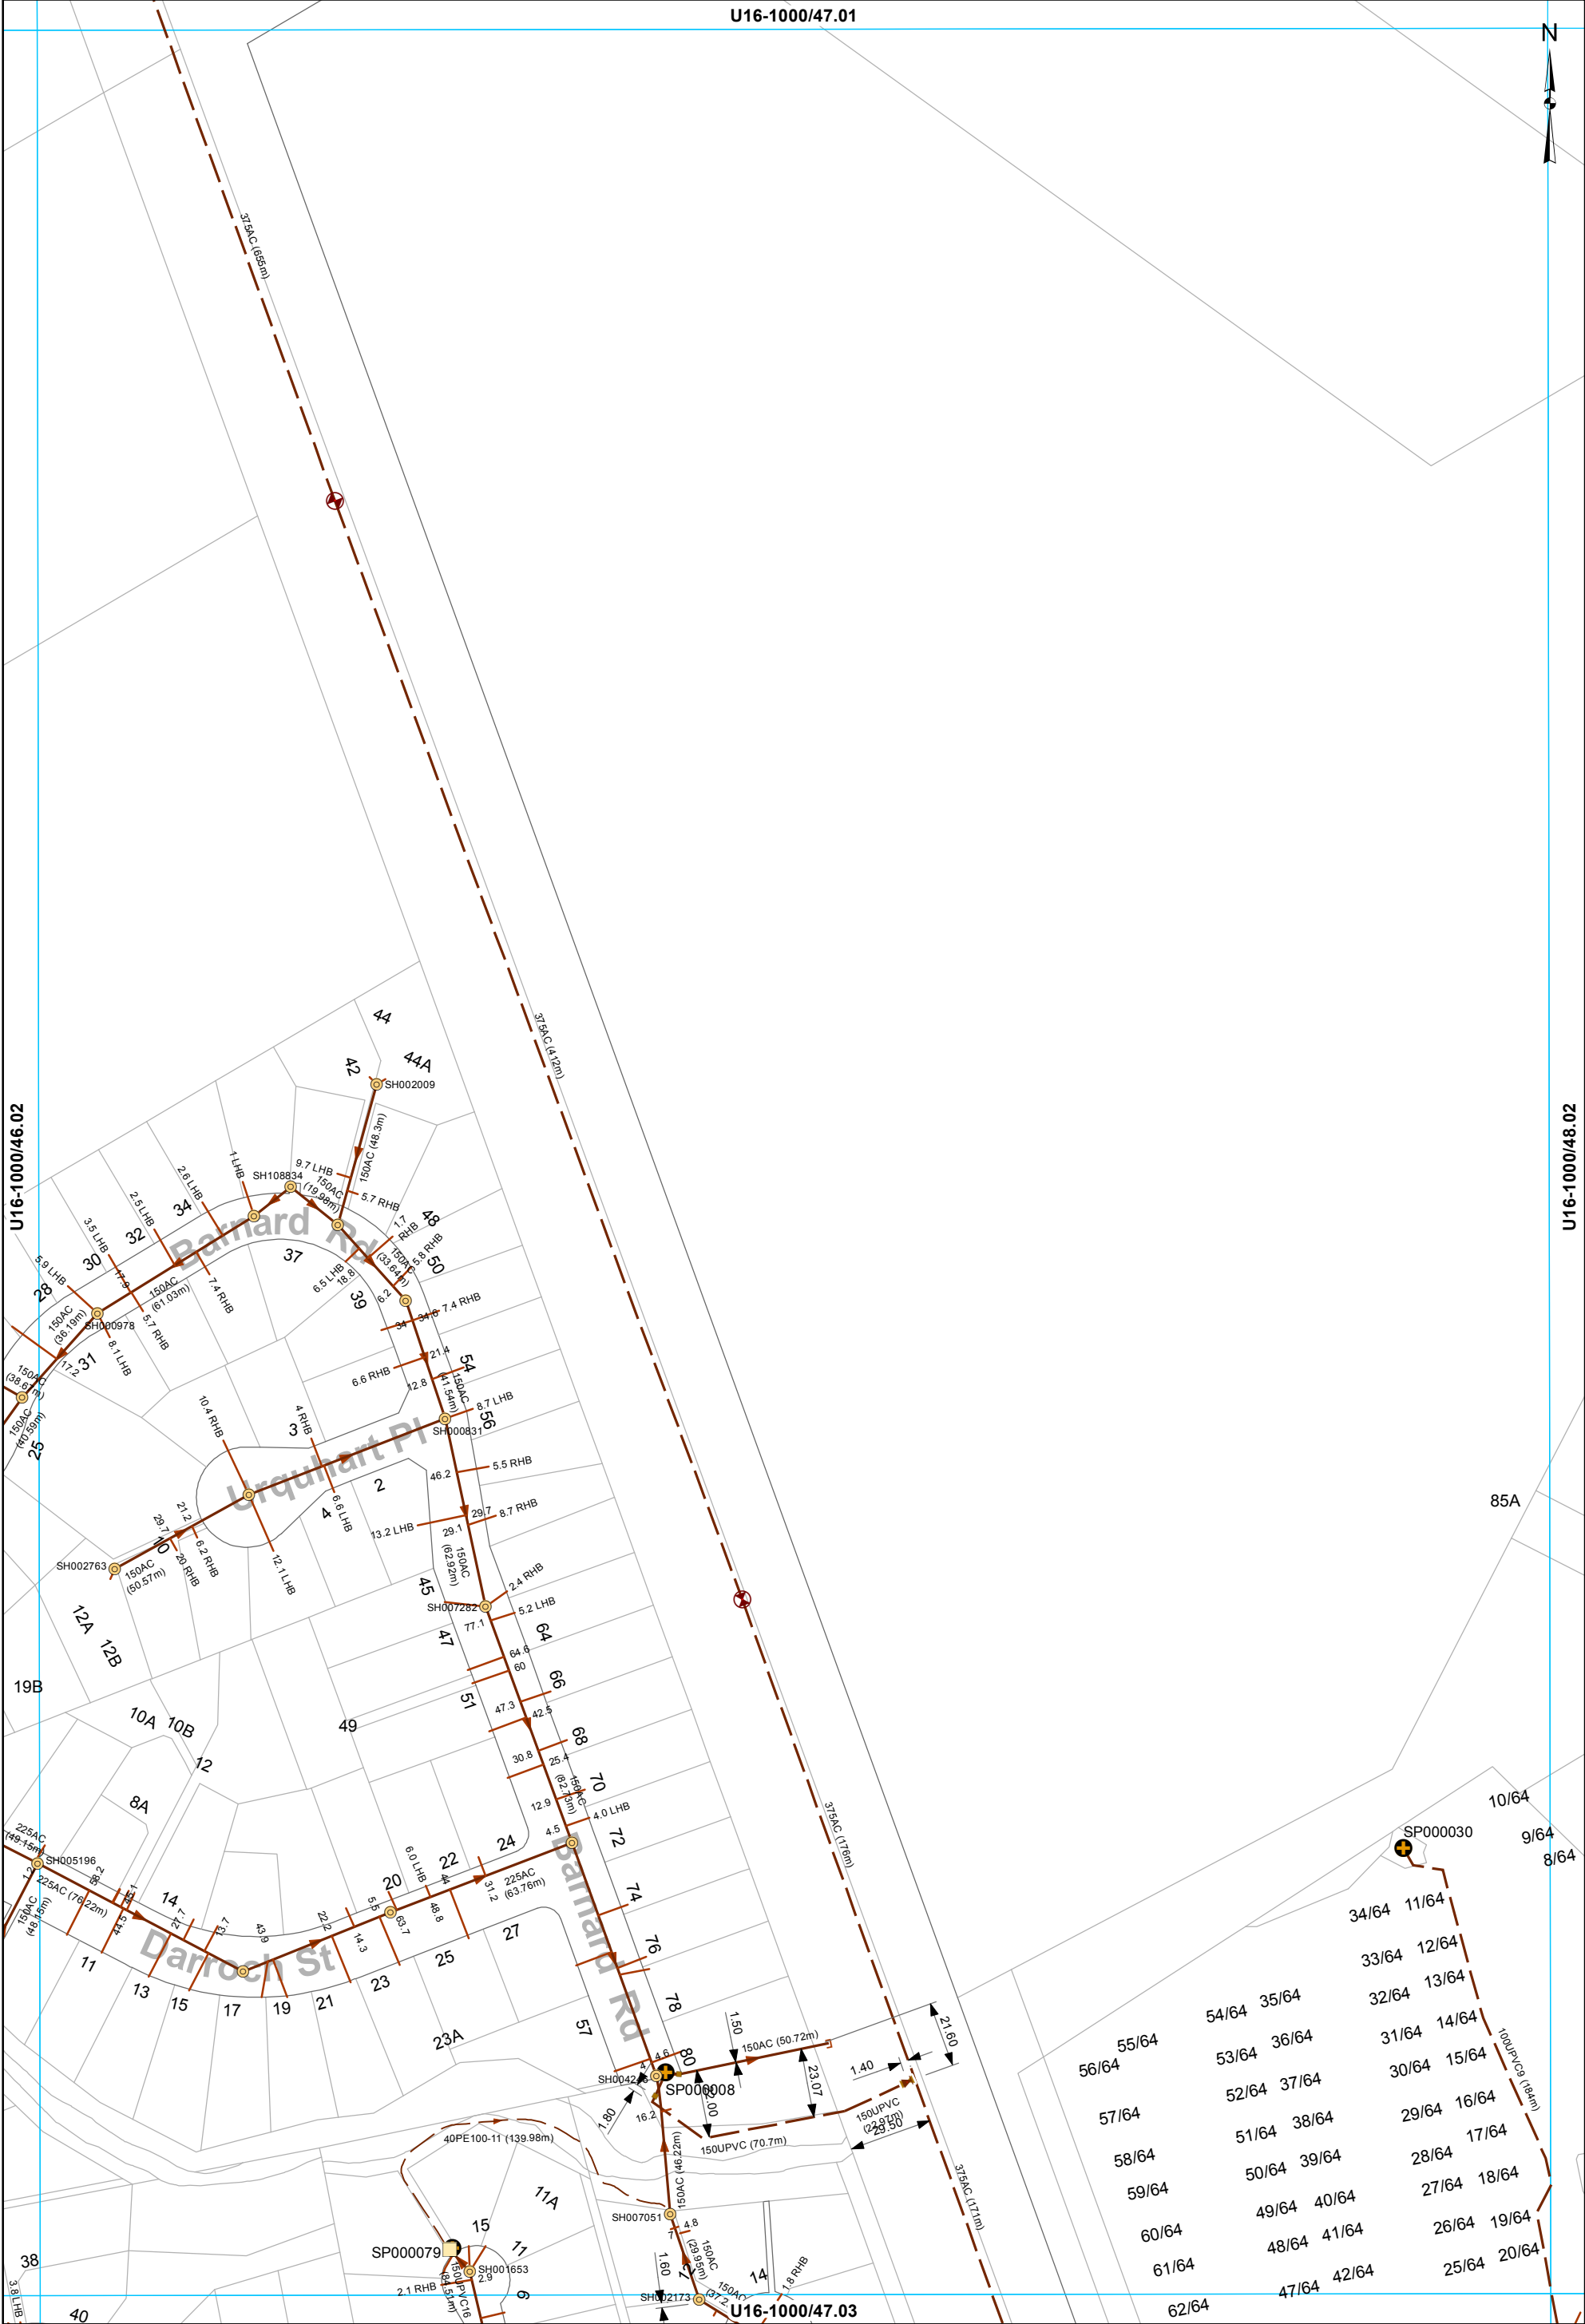

- Manhole

Pump Station

Grinder Pump Chamber

Chamber - Inspection

End of line - Capped end

Air Valve

Isolating Valve

Non return Valve

Low Pressure Main

Main line

Rising main

Service Line
- WASTEWATER SERVICES
1:2000 @ A3 - (U16-1000/47.02)
- All dimensions and levels should be verified by physical location on-site.
- This data is derived from sources outside the control of Rotorua District Council and is for information only
- Rotorua District Council 2006. Facsimilie 07 346 3143 Telephone 07 346 4199 email mail@rdc.govt.nz

U16-1000/48.01

Rotorua District Council 2006. Facsimile 07 346 3143 Telephone 07 348 4199 email mail@rdc.govt.nz

U16-1000/47.02


U16-1000/49.02

All dimensions and levels should be verified by physical location on-site.

This data is derived from sources outside the control of Rotorua District Council and is for information only

- Manhole
- Pump Station
- End of line - Capped end
- Inspection point
- Main line
- Rising main
- Service Line

WASTEWATER SERVICES
1:2000 @ A3 - (U16-1000/48.02)

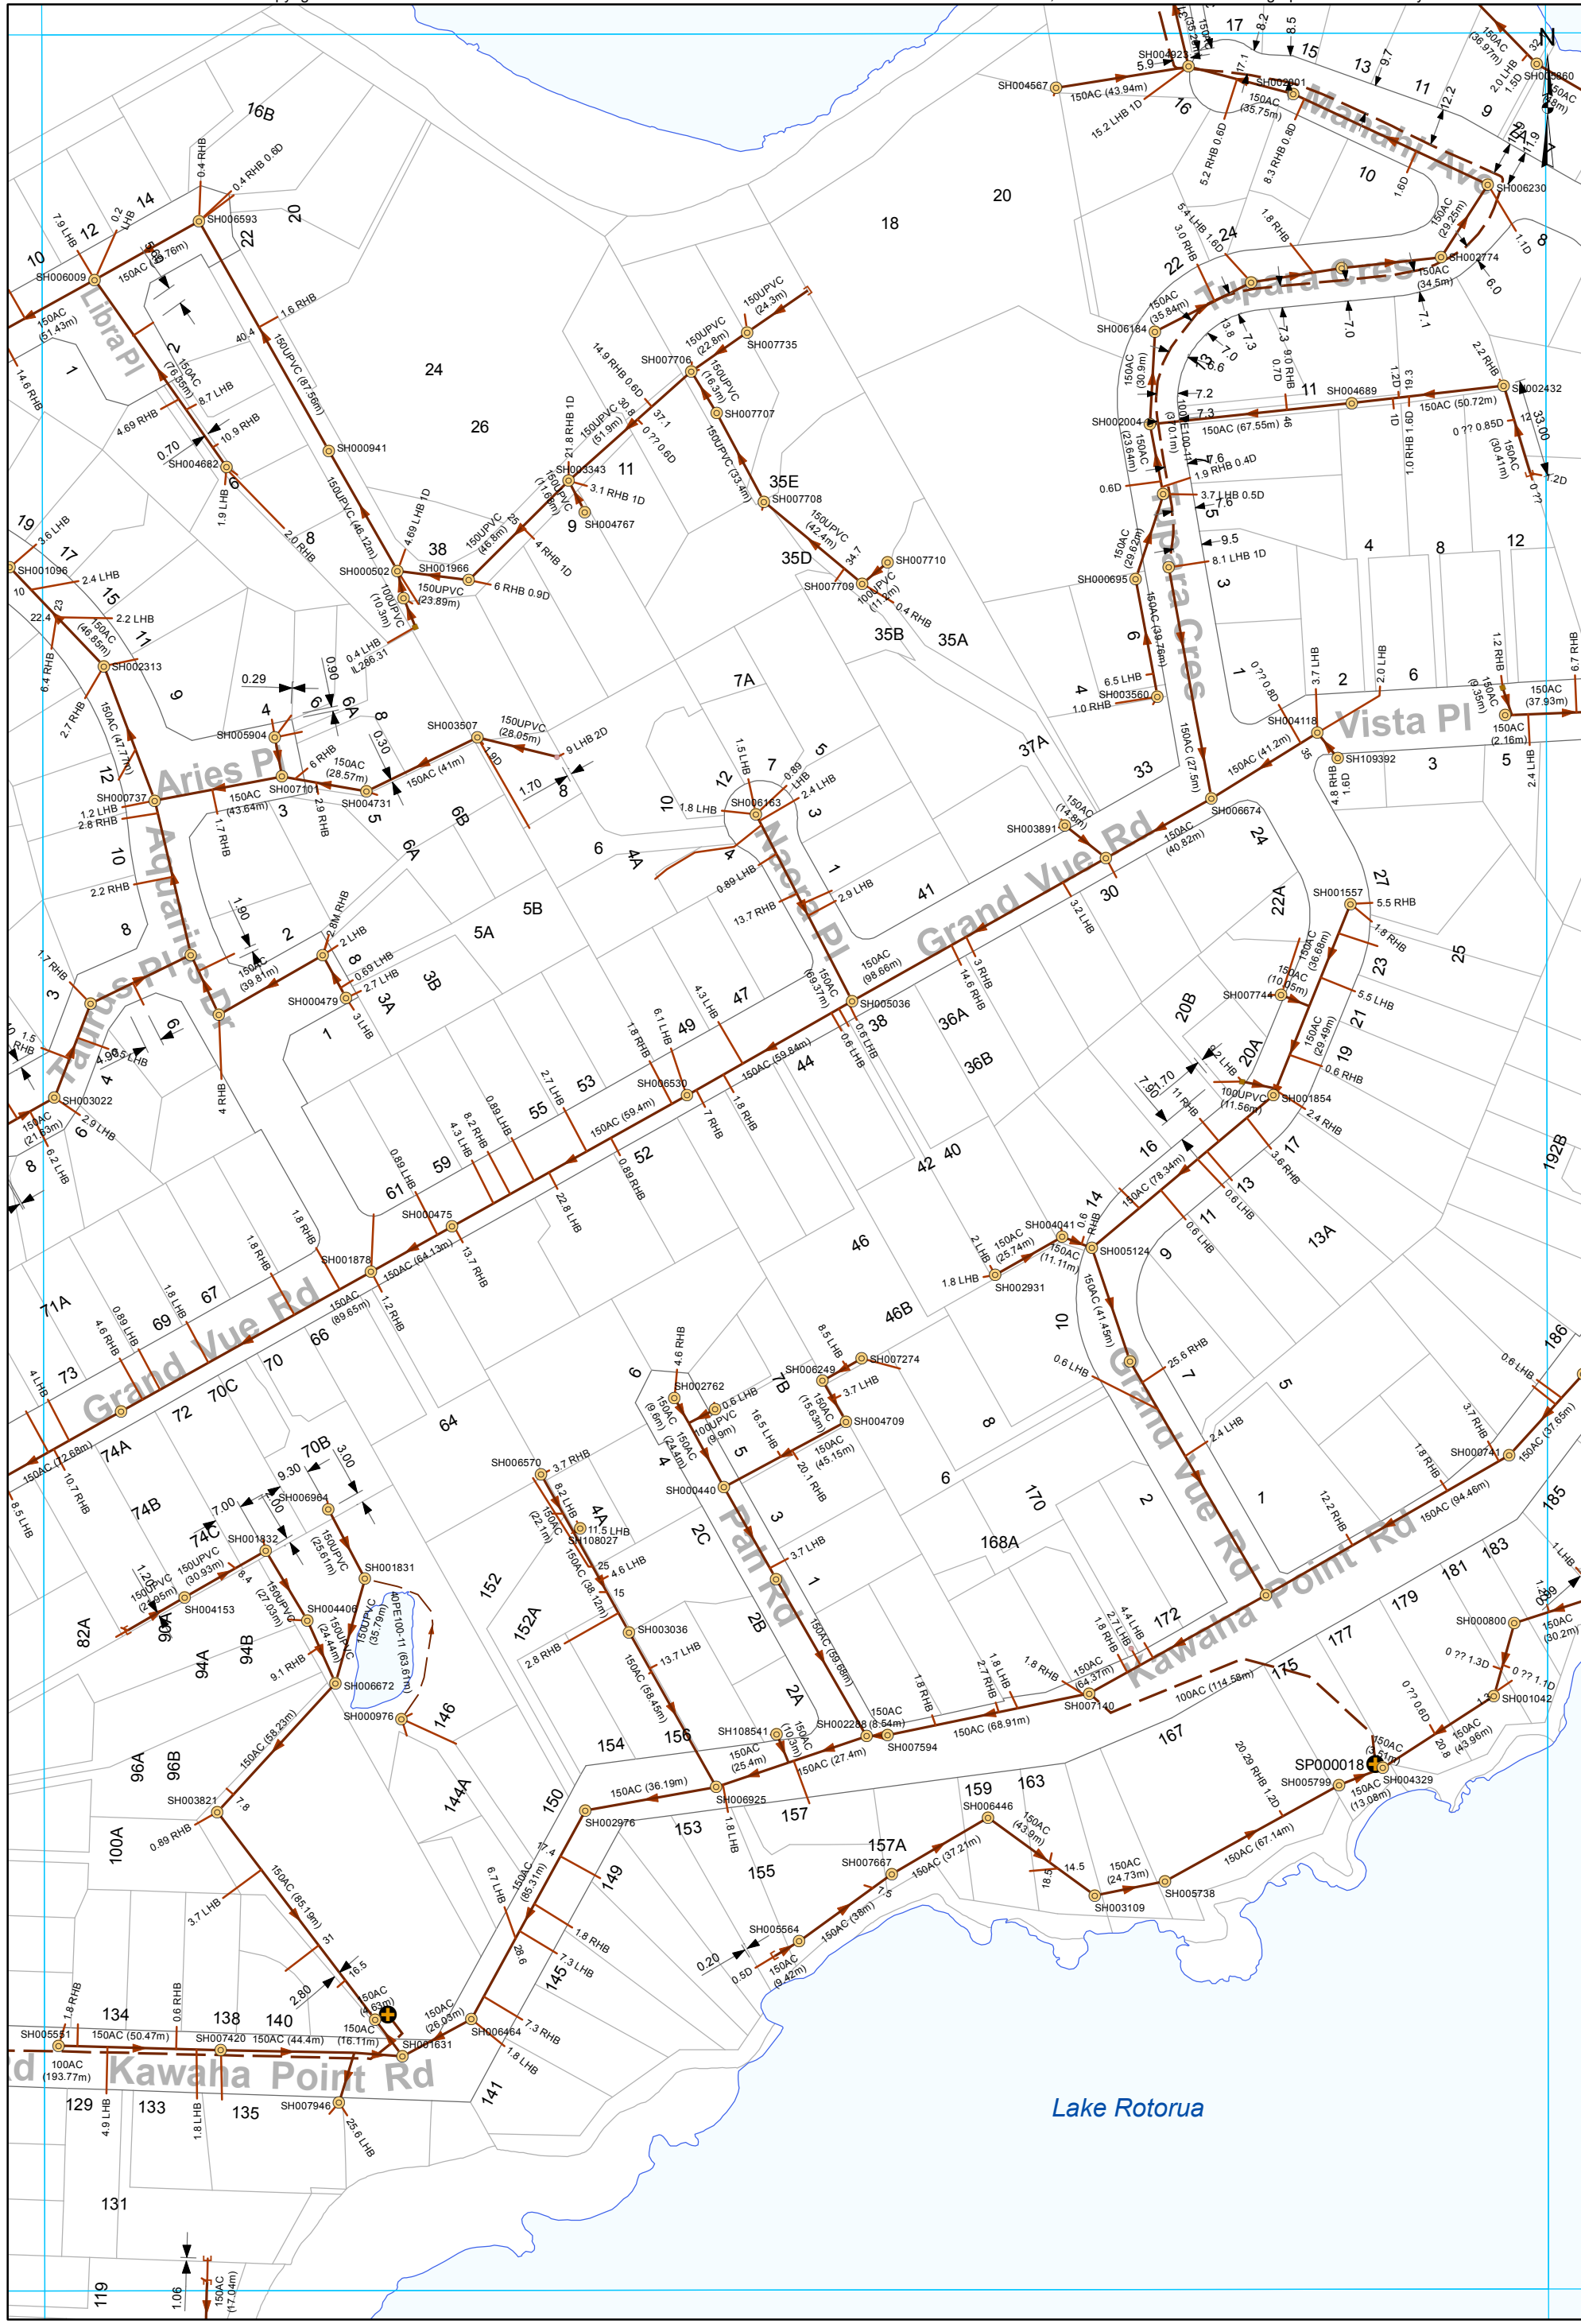

- | | | |
|------------------------|----------------------------|---------------------|
| ● Manhole | □ End of line - Capped end | — Low Pressure Main |
| ⊕ Pump Station | ● Inspection point | — Main line |
| ● LP Grinder Pump | | — Rising main |
| ■ Chamber - Inspection | | — Service Line |

WASTEWATER SERVICES
1:2000 @ A3 - (U16-1000/49.02)


This data is derived from sources outside the control of Rotorua District Council and is for information only

Rotorua District Council 2006. Facsimile 07 346 3143 Telephone 07 348 4199 email mail@rdc.govt.nz



 Manhole  End of line - Capped end  Main line
 Pump Station  Rising main
 Chamber - Inspection  Service Line



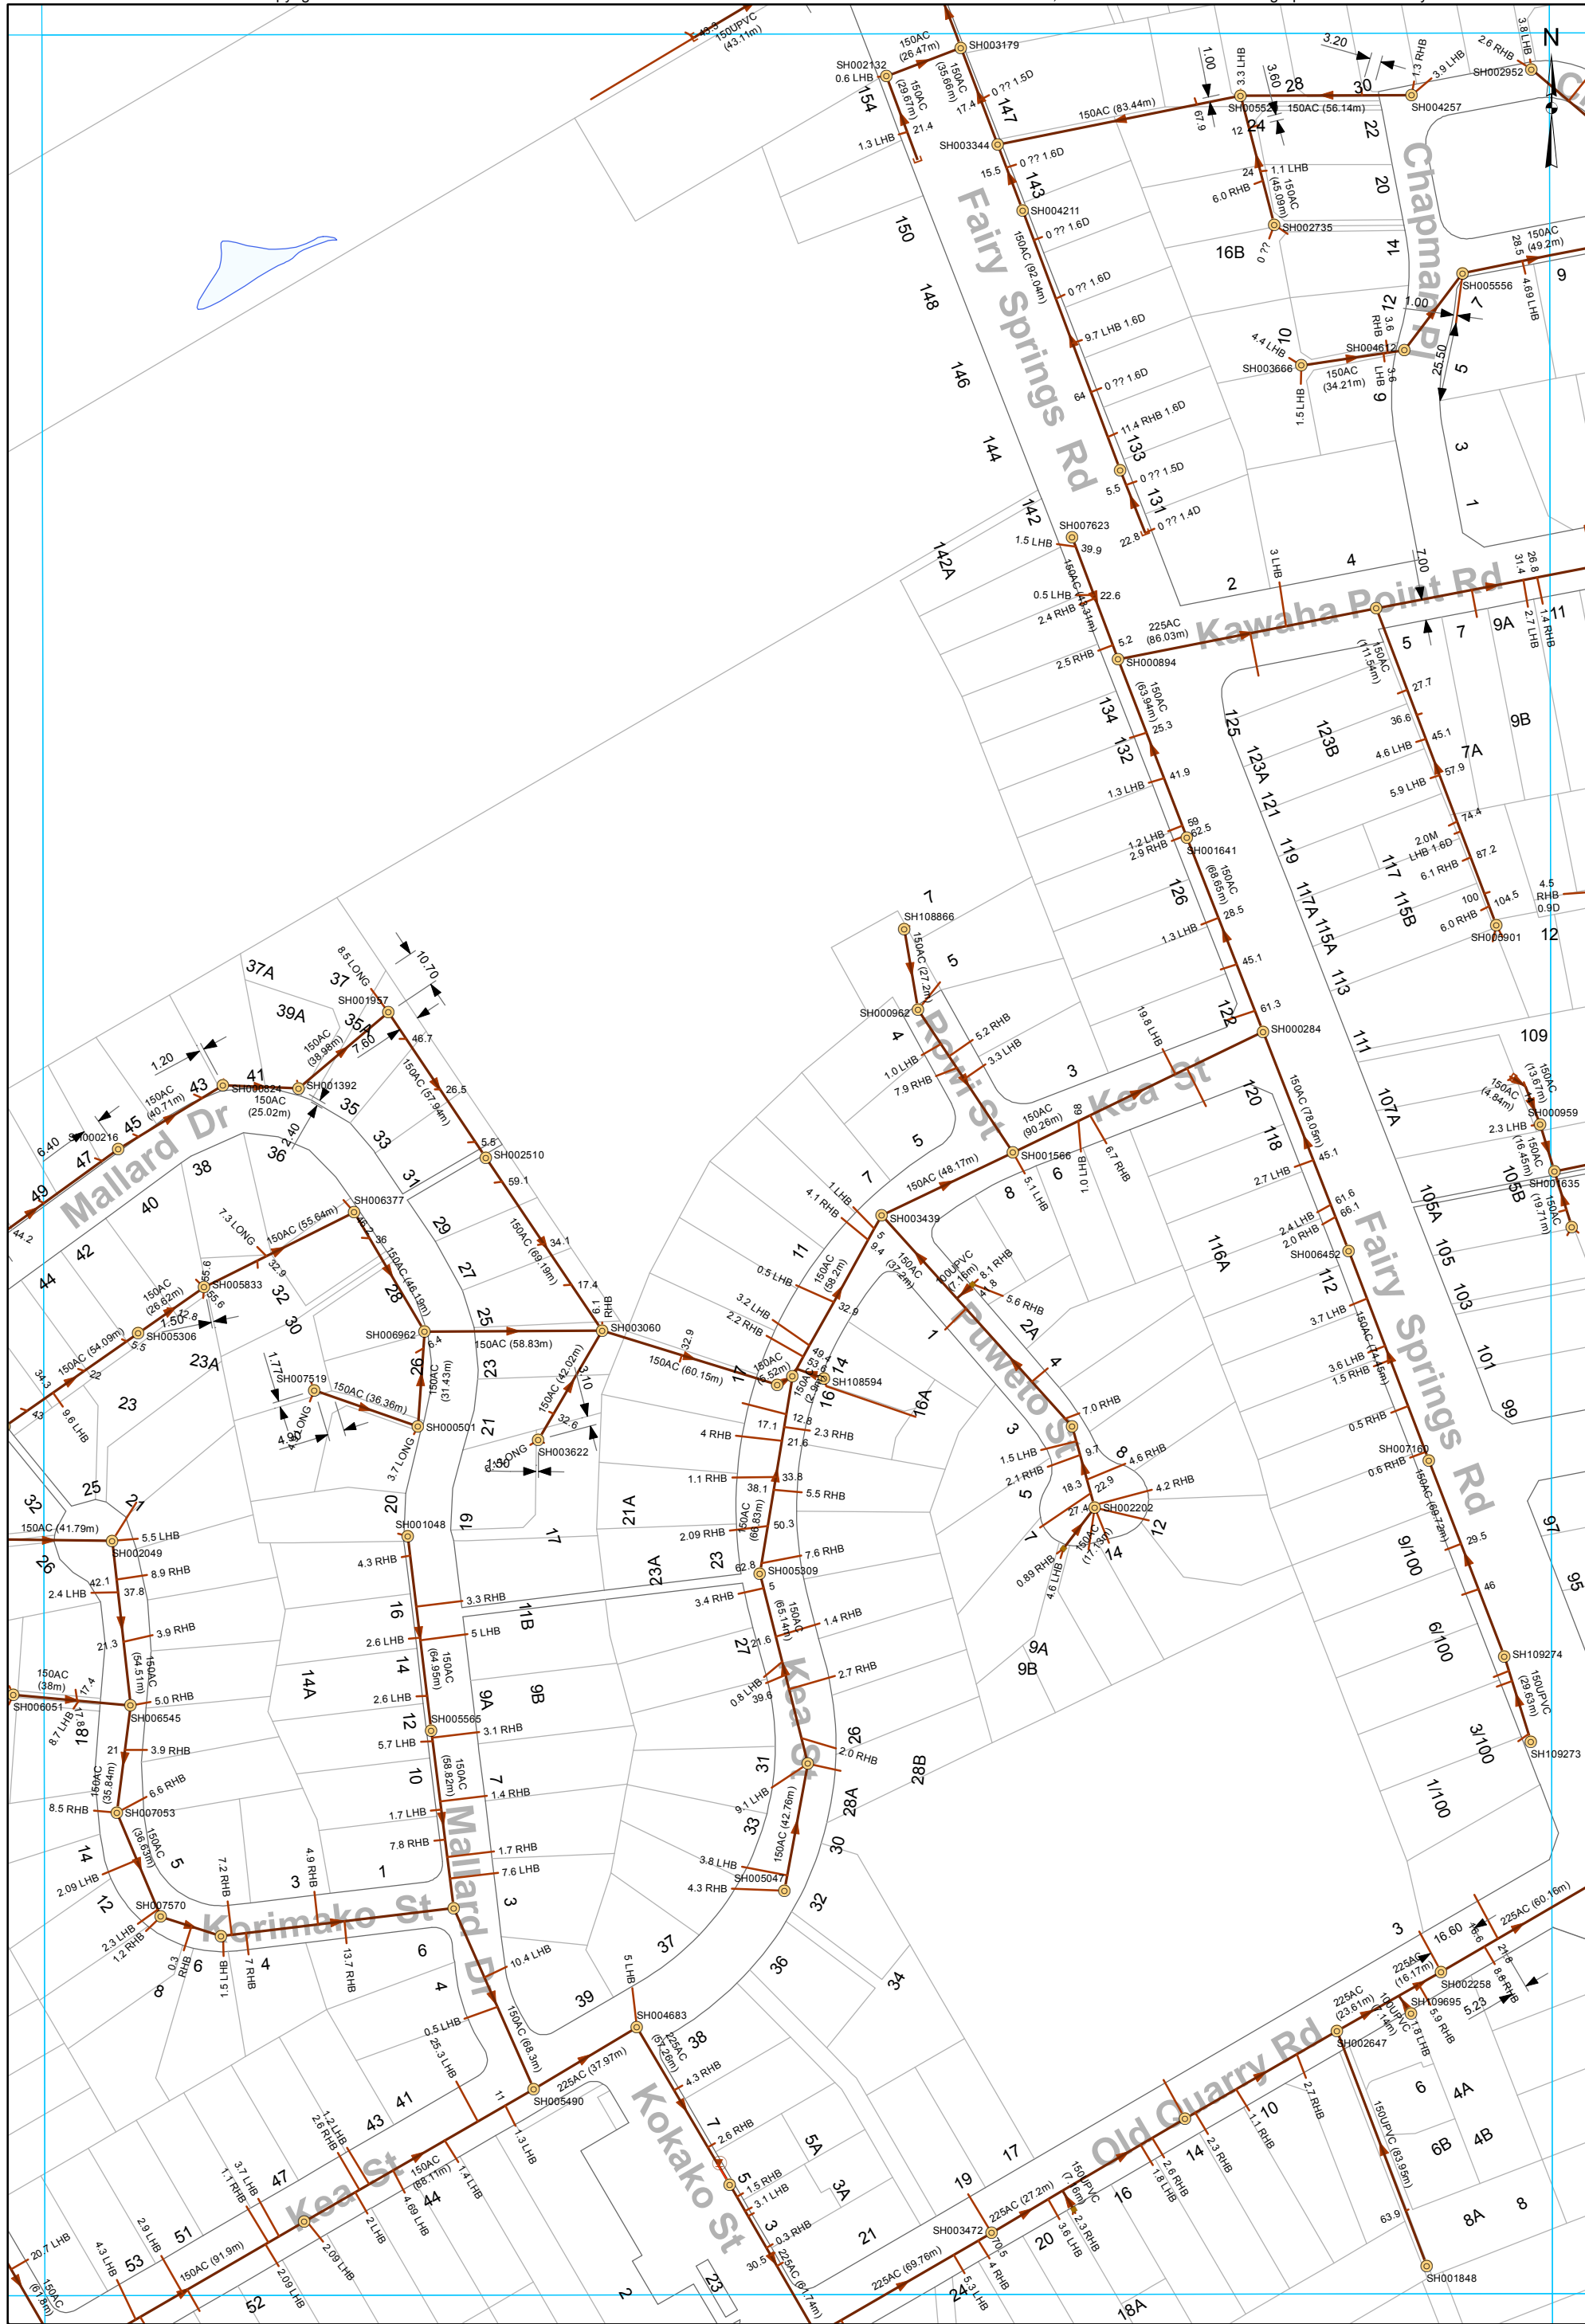

- Manhole
- Chamber - Inspection
- End of line - Capped end
- Boundary Assembly
- Main line
- Service Line
- LPGP Service Line

WASTEWATER SERVICES
1:2000 @ A3 - (U16-1000/46.03)

This data is derived from sources outside the control of Rotorua District Council and is for information only

All dimensions and levels should be verified by physical location on-site.

Rotorua District Council 2006. Facsimile 07 346 3143 Telephone 07 348 4199 email mail@rdc.govt.nz



- WASTEWATER SERVICES**
1:2000 @ A3 - (U16-1000/47.03)



Contact: CAR1957912
Reference #: W/O 77489
Waste Water Updates Pending

Contact: Paula Meredith
Reference #: Q6
Waste Water Updates Pending

- Manhole
- Pump Station
- Chamber - Inspection
- End of line - Capped end
- Main line
- Rising main
- Service Line

WASTEWATER SERVICES
1:2000 @ A3 - (U16-1000/48.03)

All dimensions and levels should be verified by physical location on-site.

Rotorua District Council 2006. Facsimile 07 346 3143 Telephone 07 348 4199 email mail@rdc.govt.nz



All dimensions and levels should be verified by physical location on-site.


This data is derived from sources outside the control of Rotorua District Council and is for information only

Rotorua District Council 2006. Facsimilie 07 346 3143 Telephone 07 348 4199 email mail@rdc.govt.nz

 Manhole
  Main line

 End of line - Capped end
 Service Line

WASTEWATER SERVICES
1:2000 @ A3 - (U16-1000/49.03)

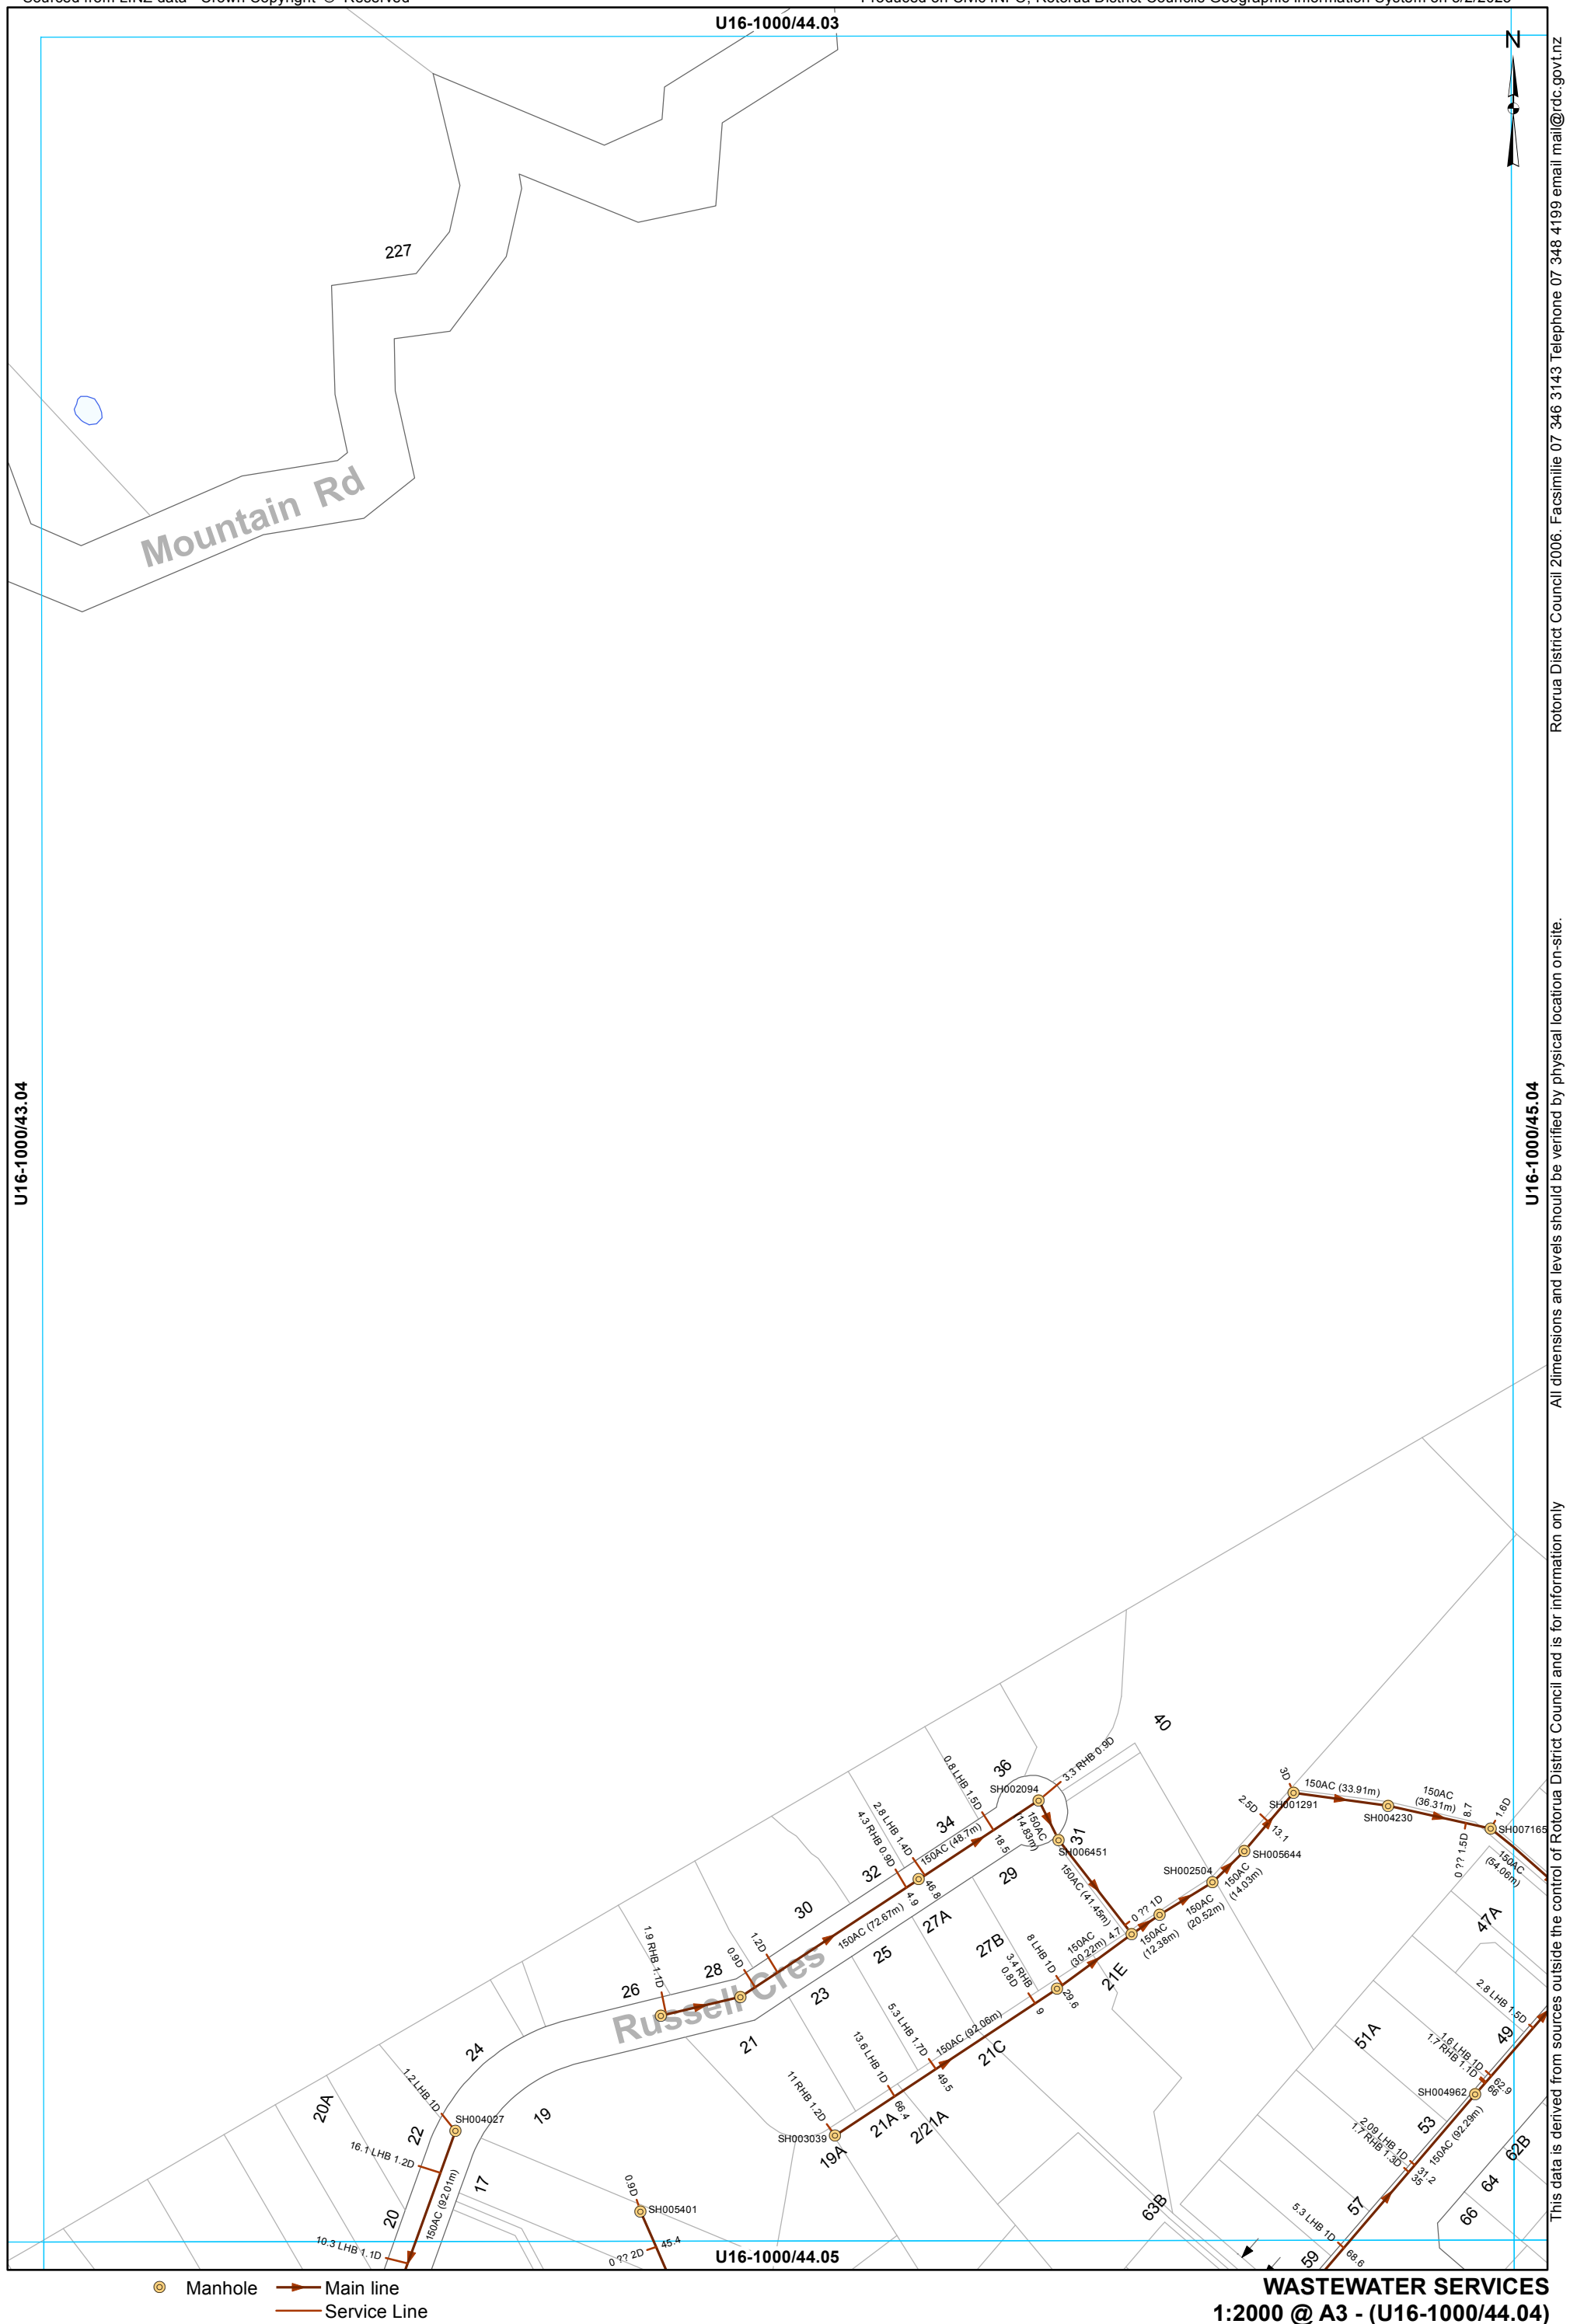




All dimensions and levels should be verified by physical location on-site.

This data is derived from sources outside the control of Rotorua District Council and is for information only

WASTEWATER SERVICES
1:2000 @ A3 - (U16-1000/45.04)

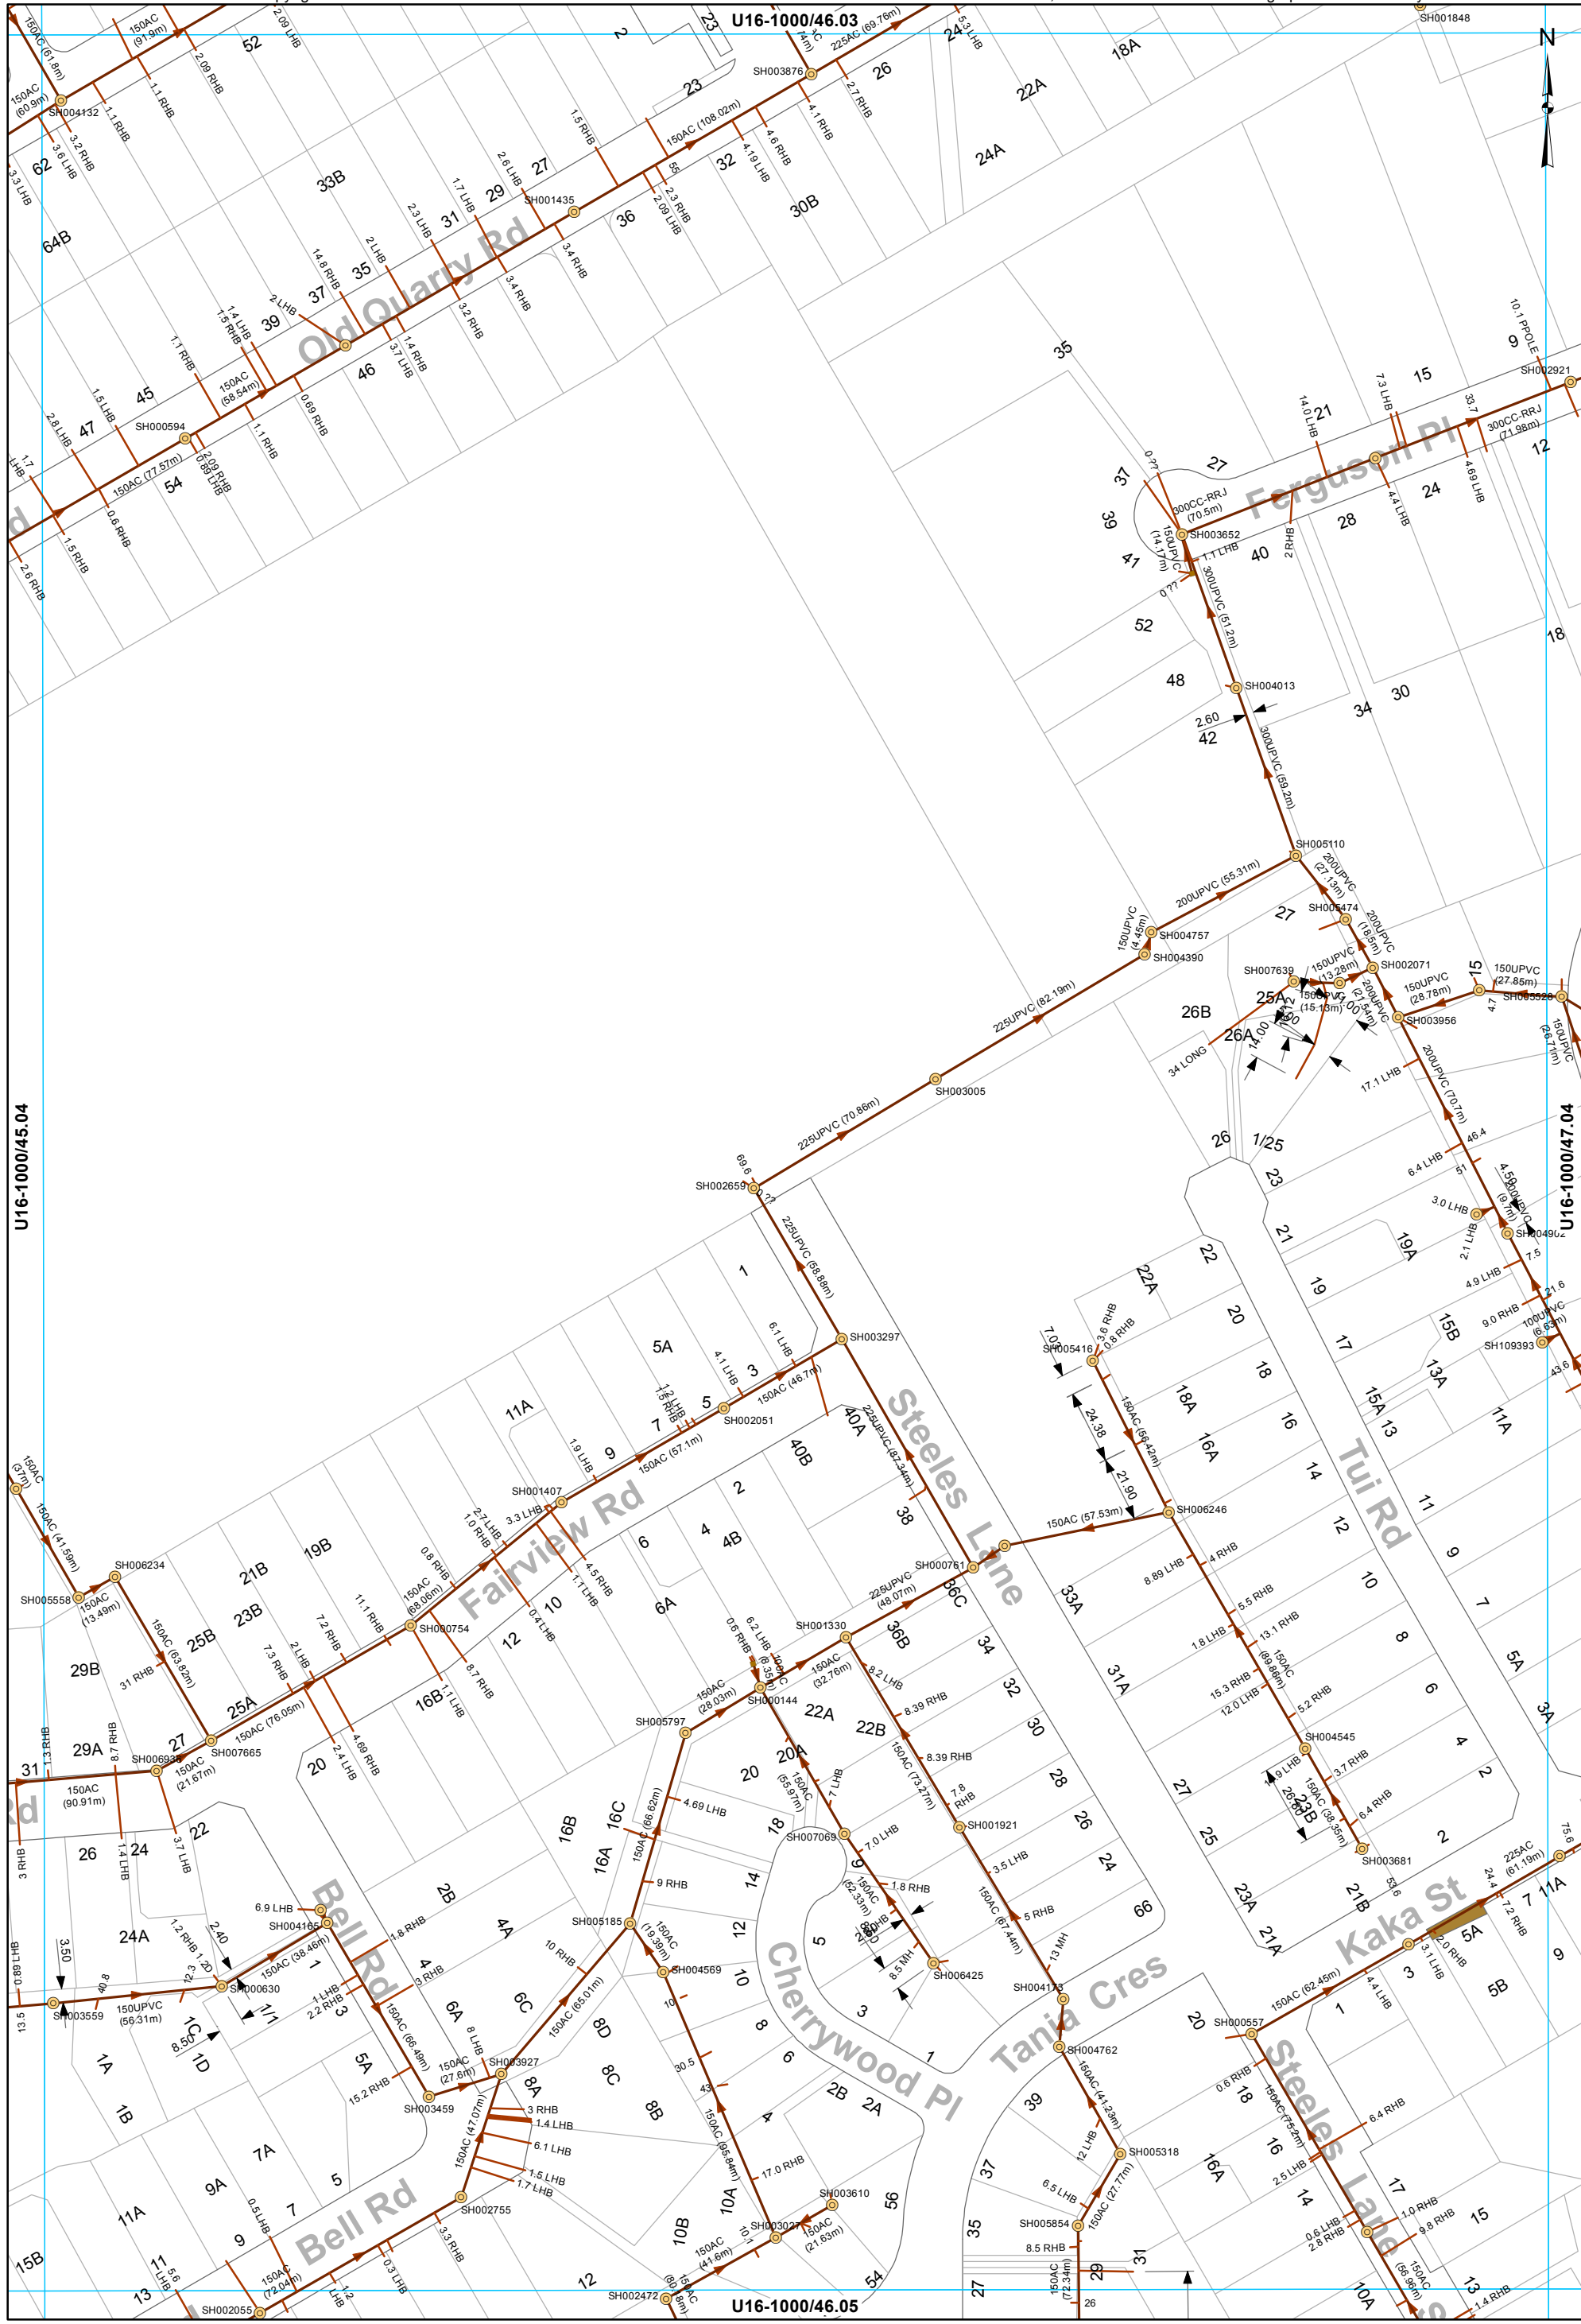


- Manhole
- Chamber - Inspection
- Main line
- Service Line

WASTEWATER SERVICES
1:2000 @ A3 - (U16-1000/46.04)

This data is derived from sources outside the control of Rotorua District Council and is for information only

All dimensions and levels should be verified by physical location on-site.

Rotorua District Council 2006. Facsimile 07 346 3143 Telephone 07 348 4199 email mail@rdc.govt.nz

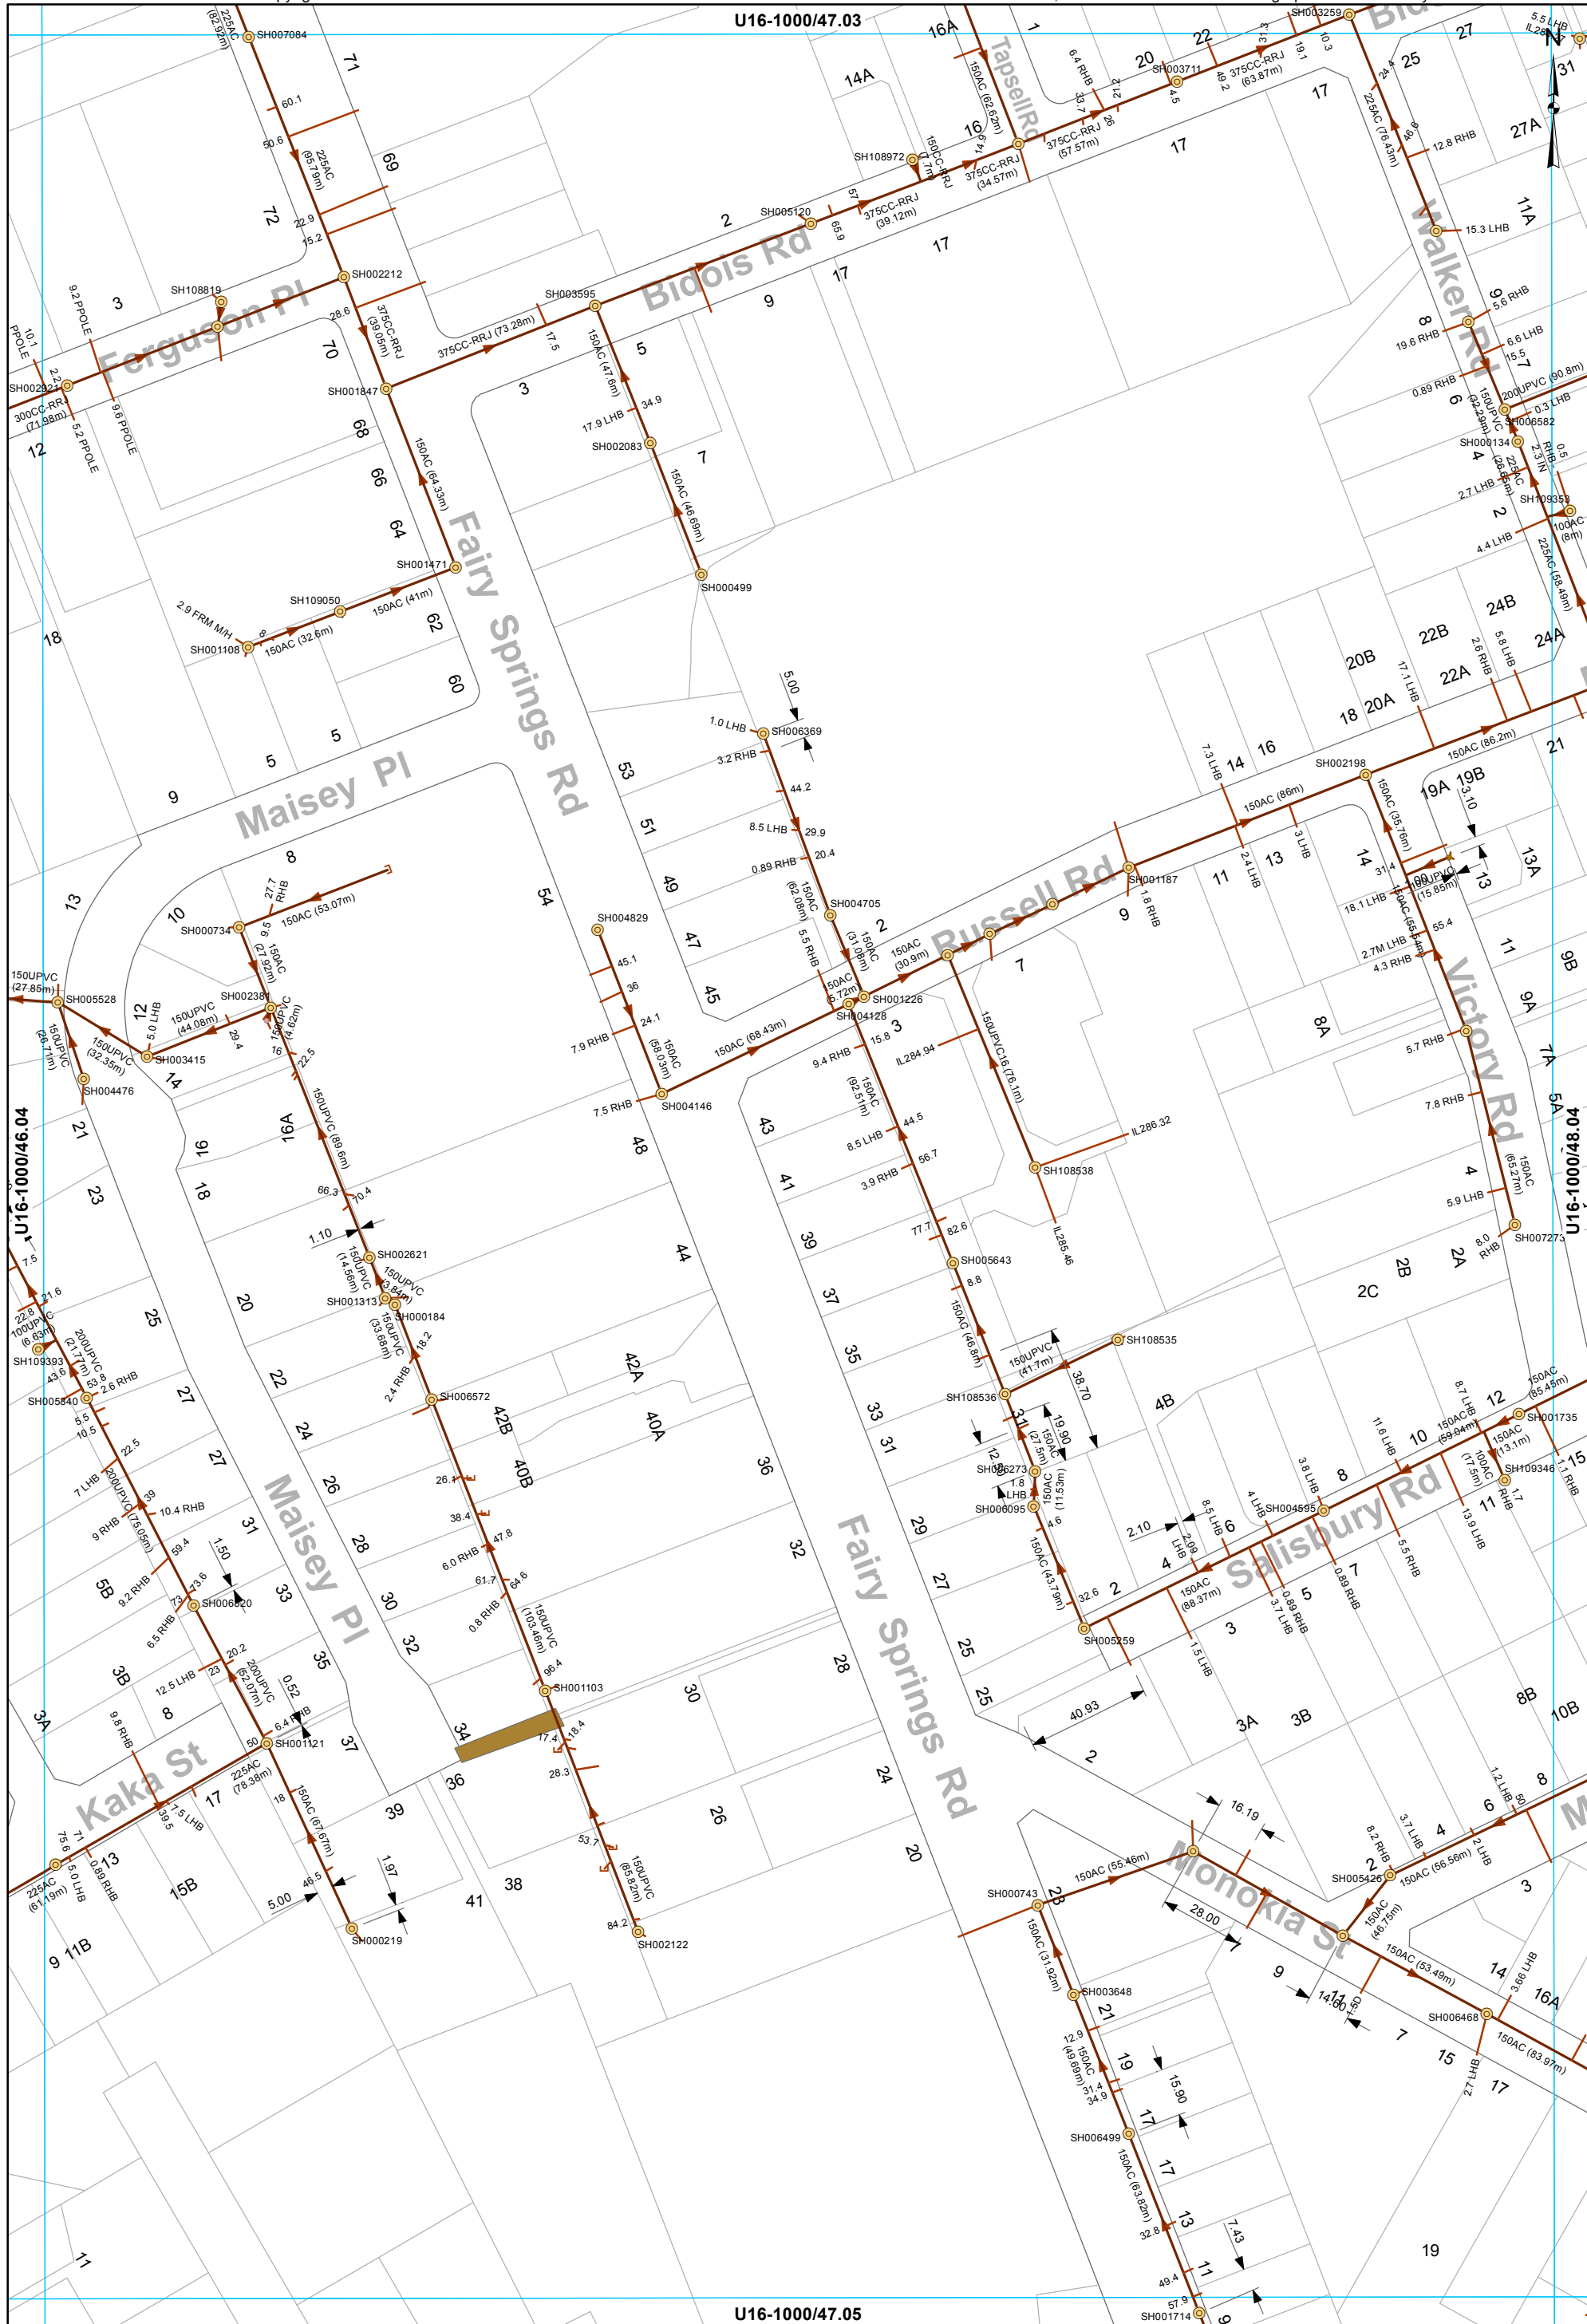


- Manhole
- Chamber - Inspection
- End of line - Capped end
- Inspection point
- Main line
- Service Line

WASTEWATER SERVICES
1:2000 @ A3 - (U16-1000/47.04)

All dimensions and levels should be verified by physical location on-site.

 Rotorua District Council 2006. Facsimile 07 346 3143 Telephone 07 348 4199 email mail@rdc.govt.nz




All dimensions and levels should be verified by physical location on-site.

This data is derived from sources outside the control of Rotorua District Council and is for information only

Rotorua District Council 2006. Facsimilie 07 346 3143 Telephone 07 348 4199 email mail@rdc.govt.nz

- | | | | | | |
|---|----------------------|---|--------------------------|---|--------------|
| | Manhole | | End of line - Capped end | | Main line |
|  | Pump Station |  | Inspection point |  | Rising main |
|  | Odour dome |  | Backflow Preventer |  | Service Line |
|  | Chamber - Inspection | | | | |

WASTEWATER SERVICES
1:2000 @ A3 - (U16-1000/48.04)

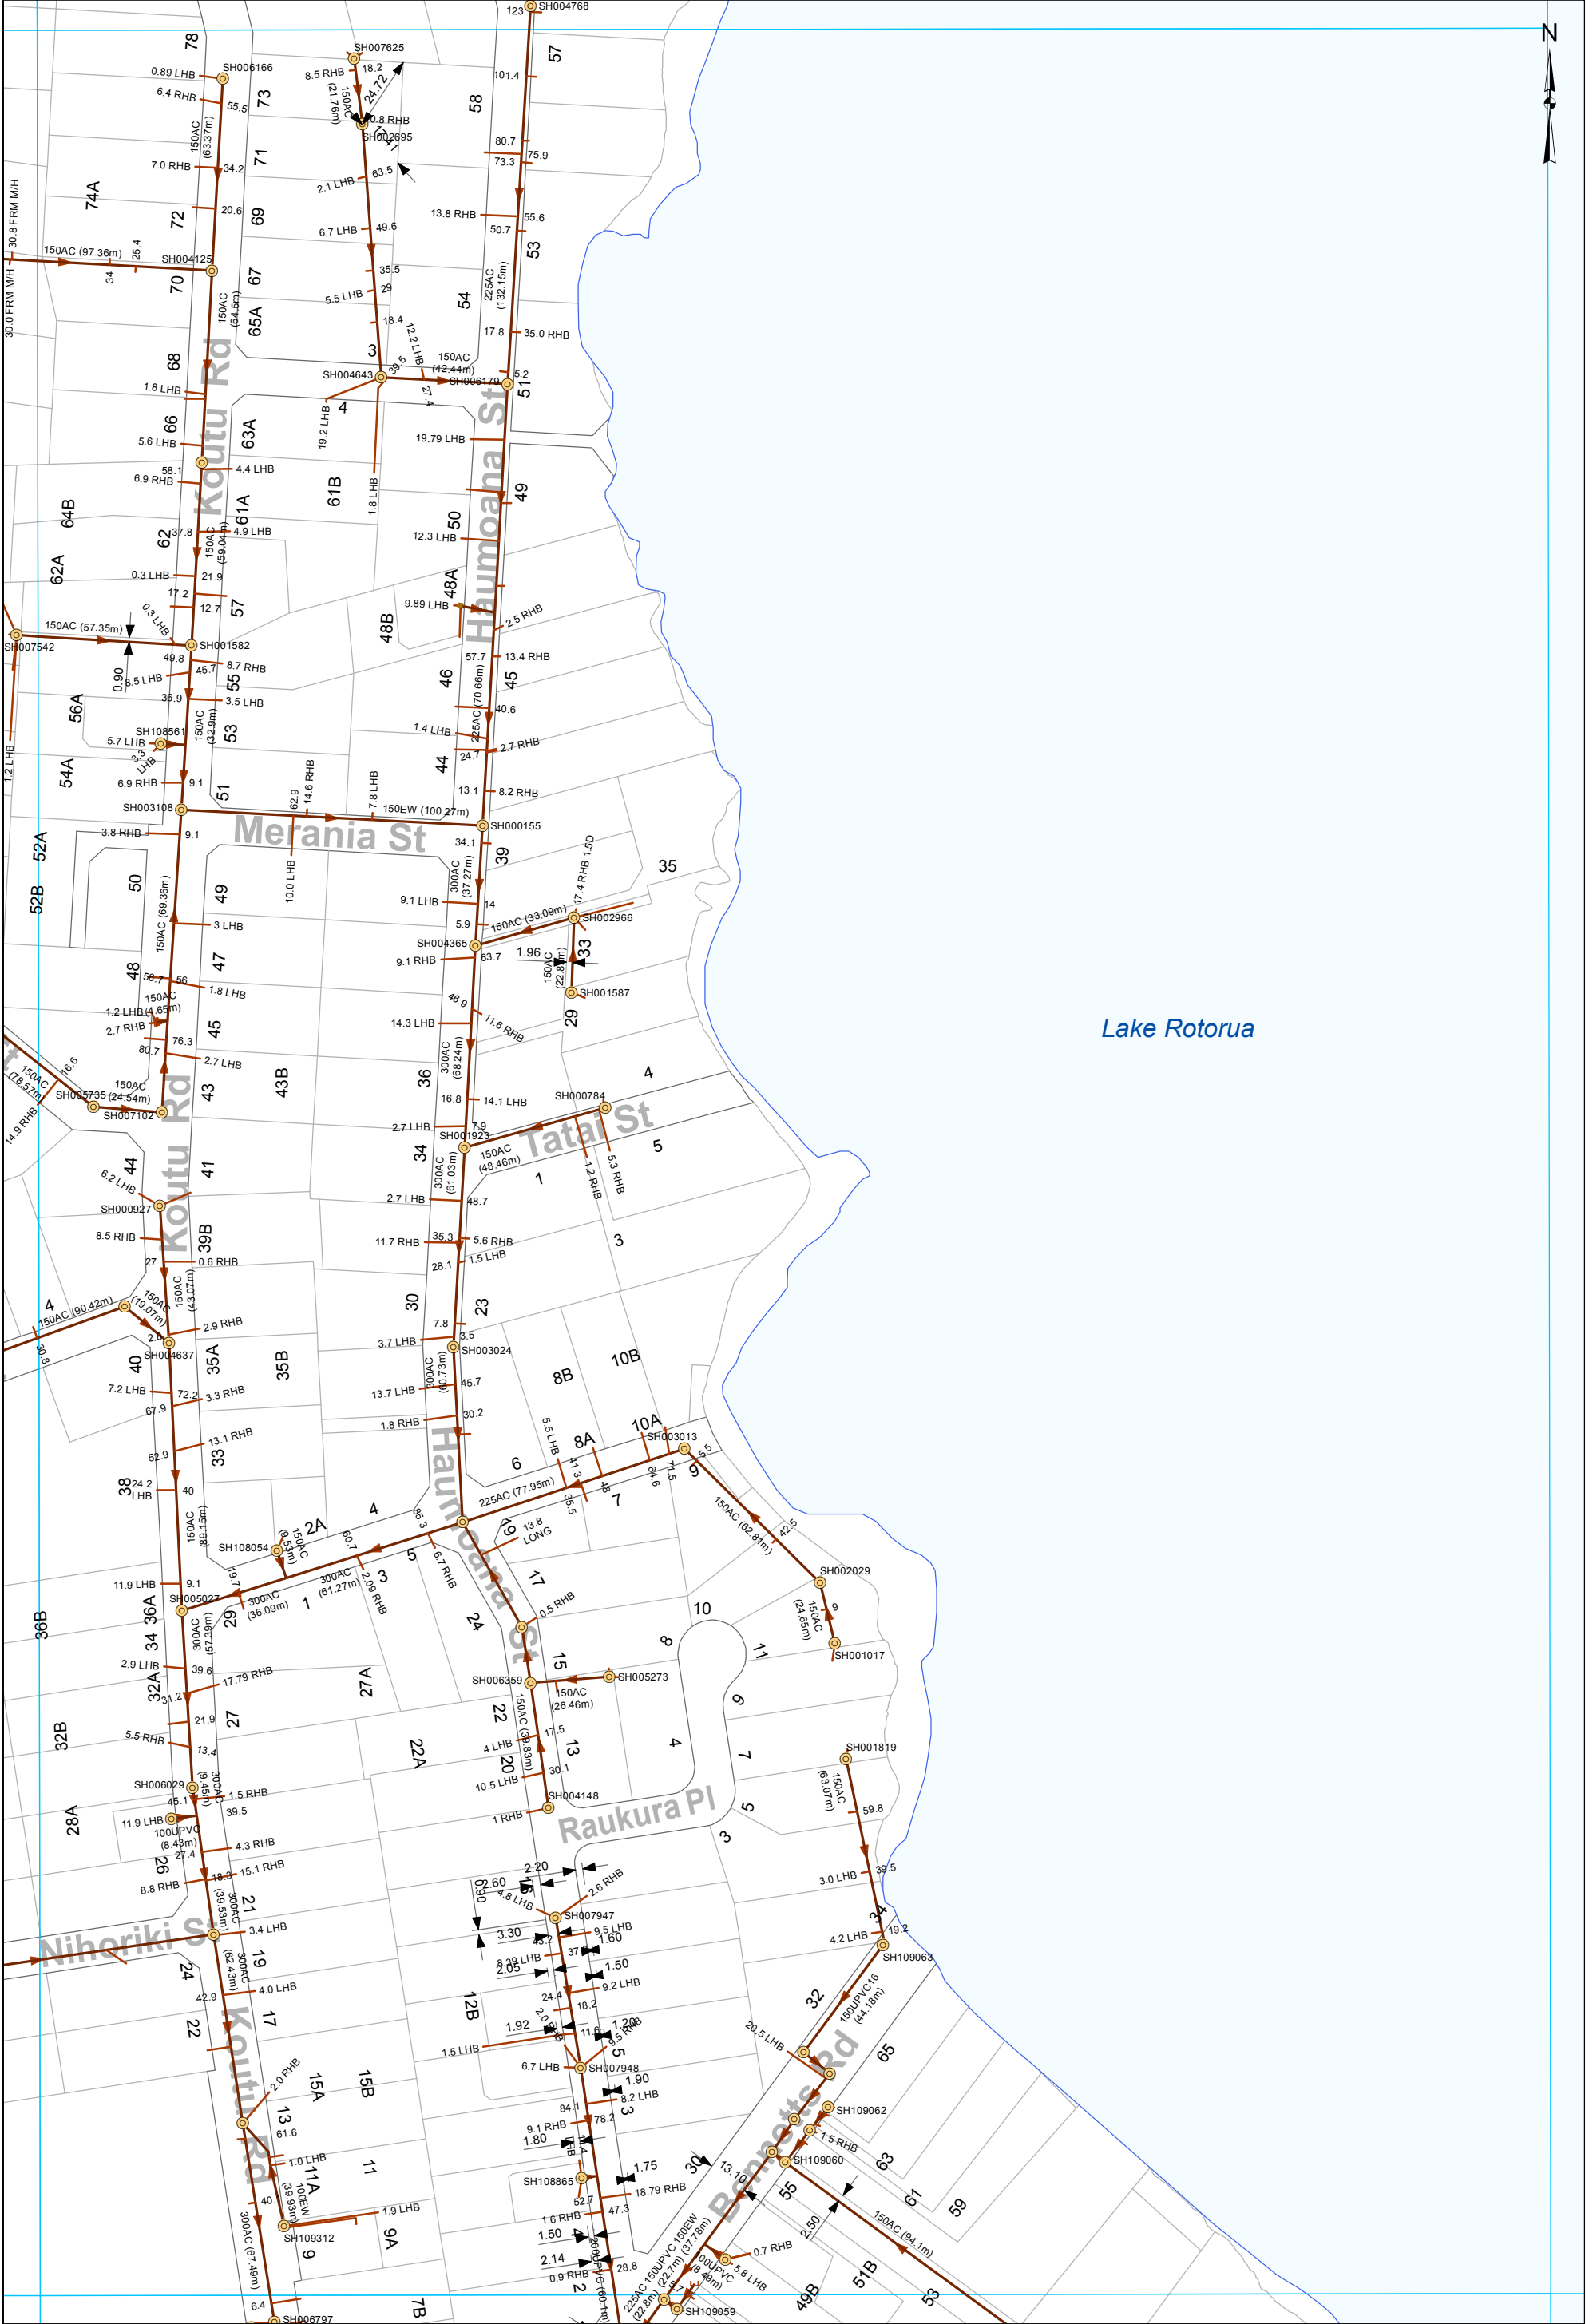


- Manhole
- Chamber - Inspection
- End of line - Capped end
- Main line
- Service Line

WASTEWATER SERVICES
1:2000 @ A3 - (U16-1000/49.04)

This data is derived from sources outside the control of Rotorua District Council and is for information only

Rotorua District Council 2006. Facsimilie 07 346 3143 Telephone 07 348 4199 email mail@rdc.govt.nz

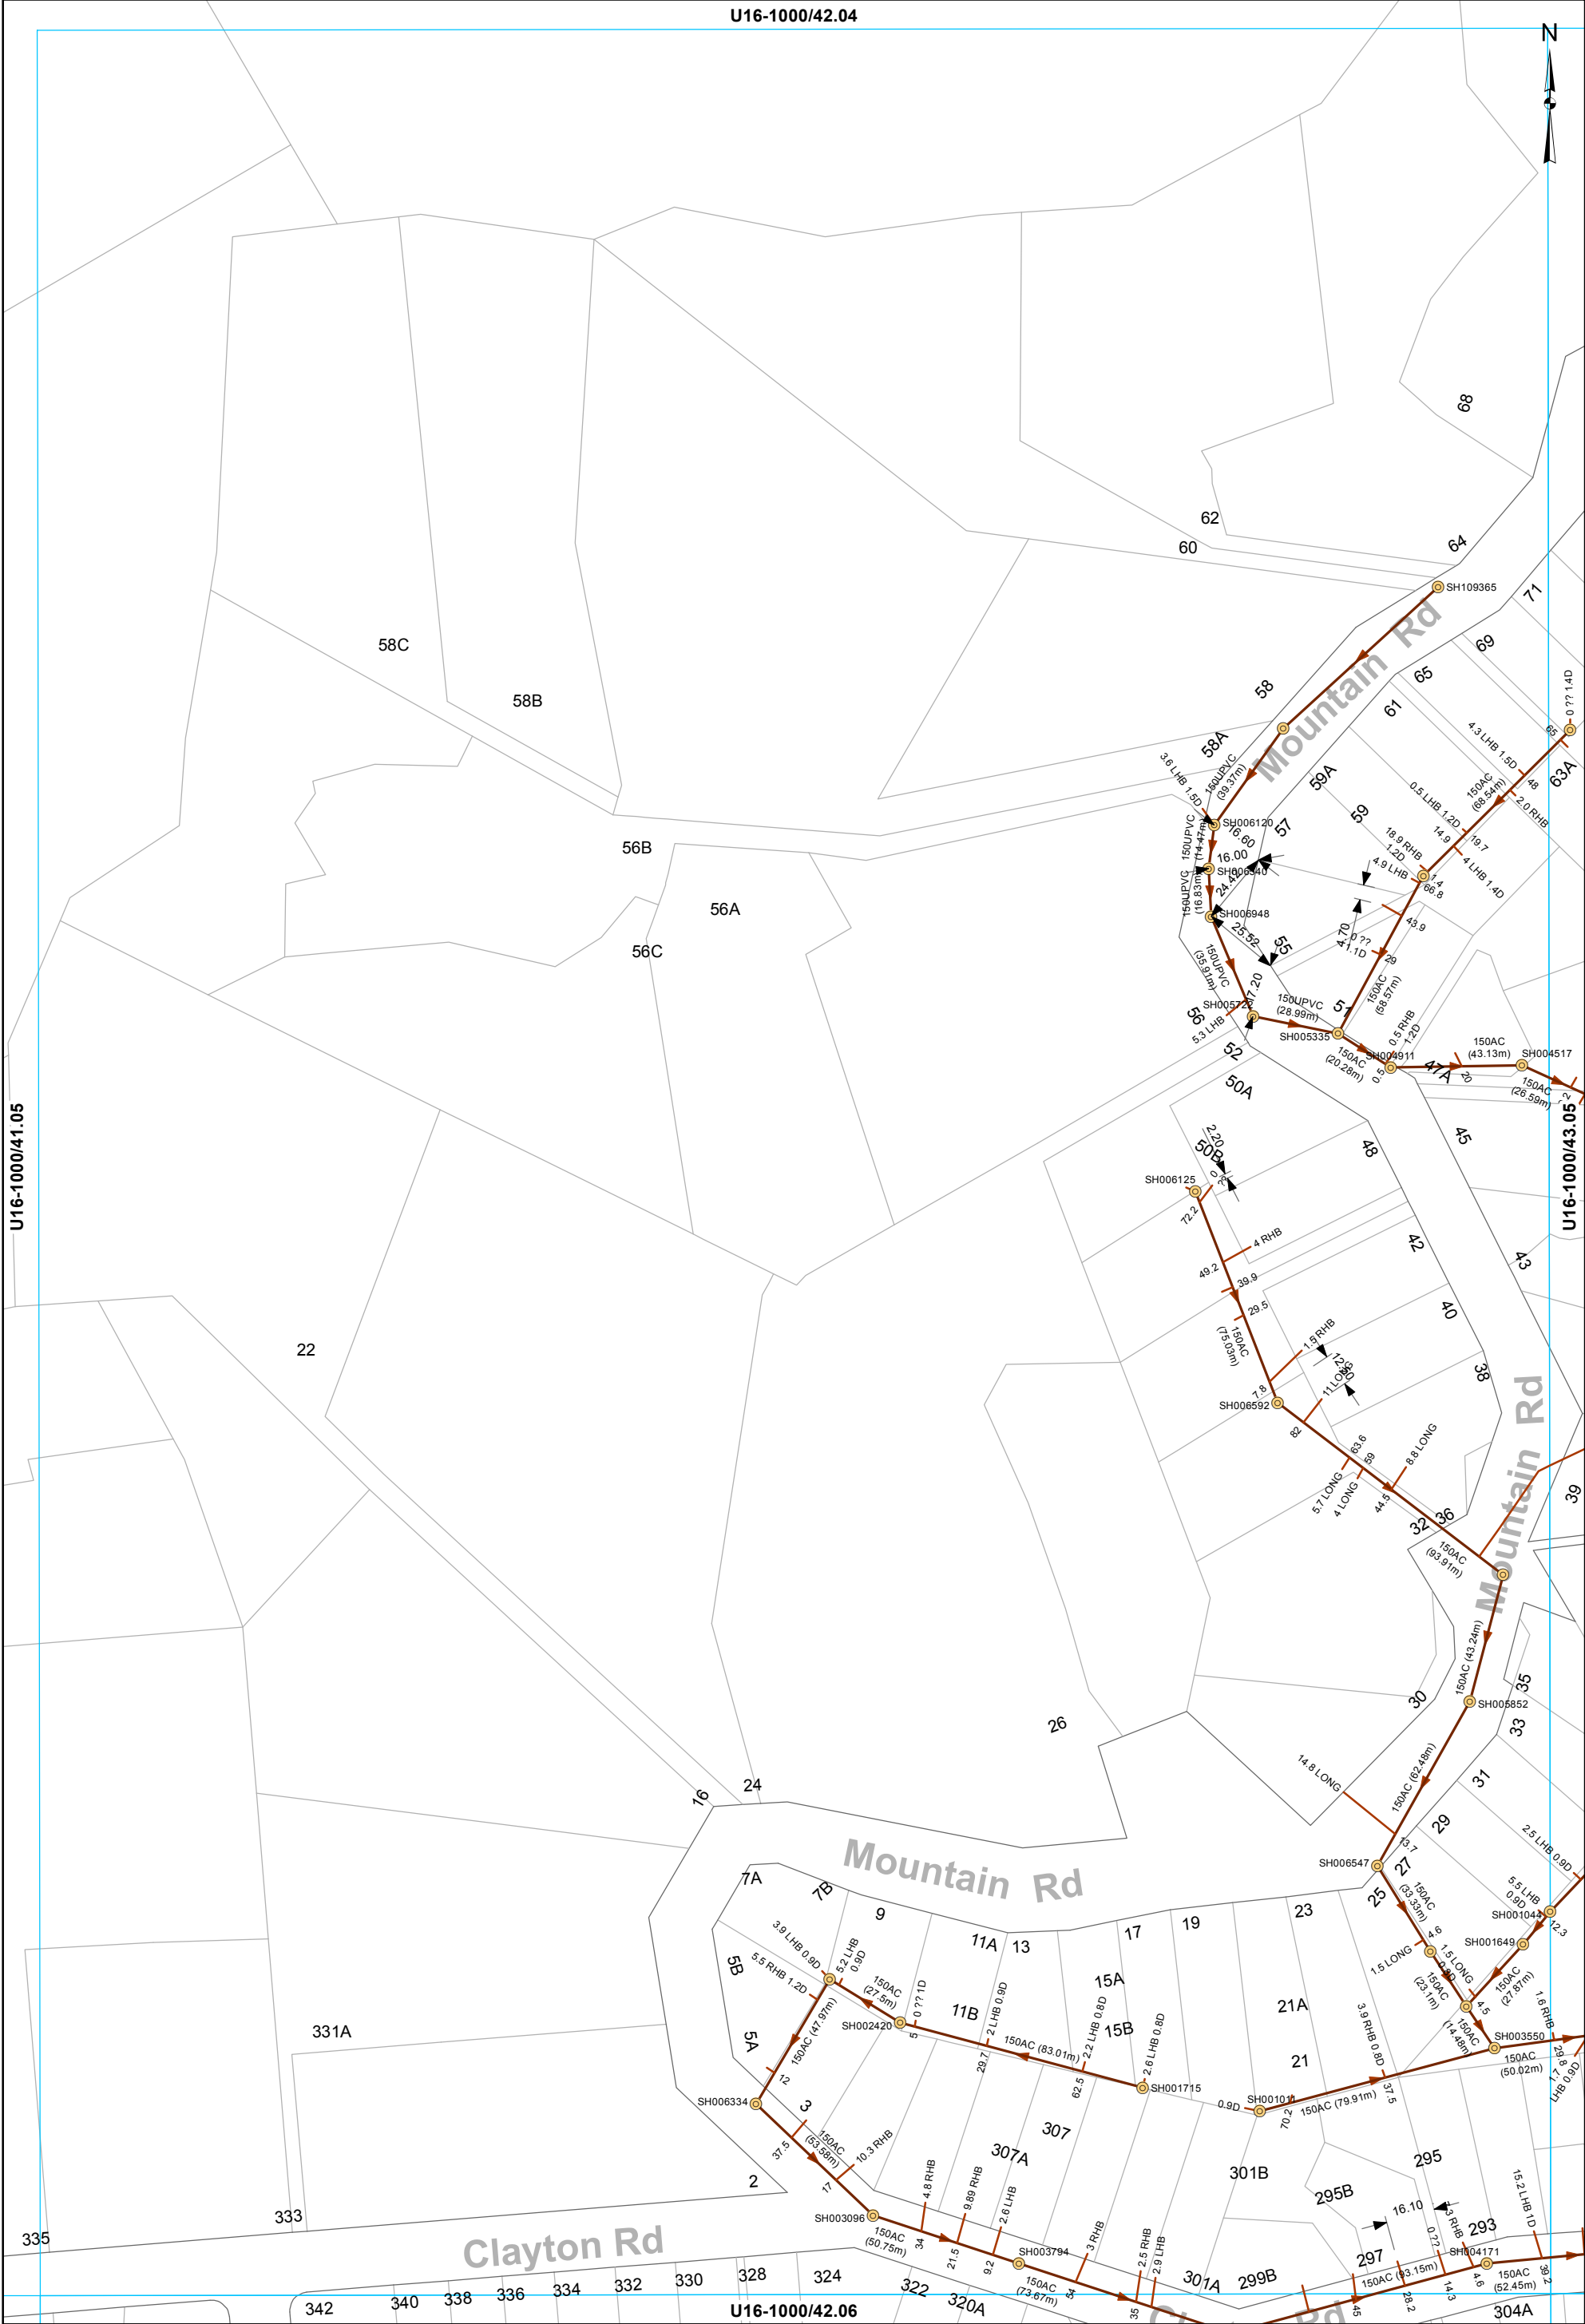


Manhole Main line Service Line

WASTEWATER SERVICES
1:2000 @ A3 - (U16-1000/42.05)

This data is derived from sources outside the control of Rotorua District Council and is for information only

All dimensions and levels should be verified by physical location on-site.

Rotorua District Council 2006. Facsimile 07 346 3143 Telephone 07 348 4199 email mail@rdc.govt.nz

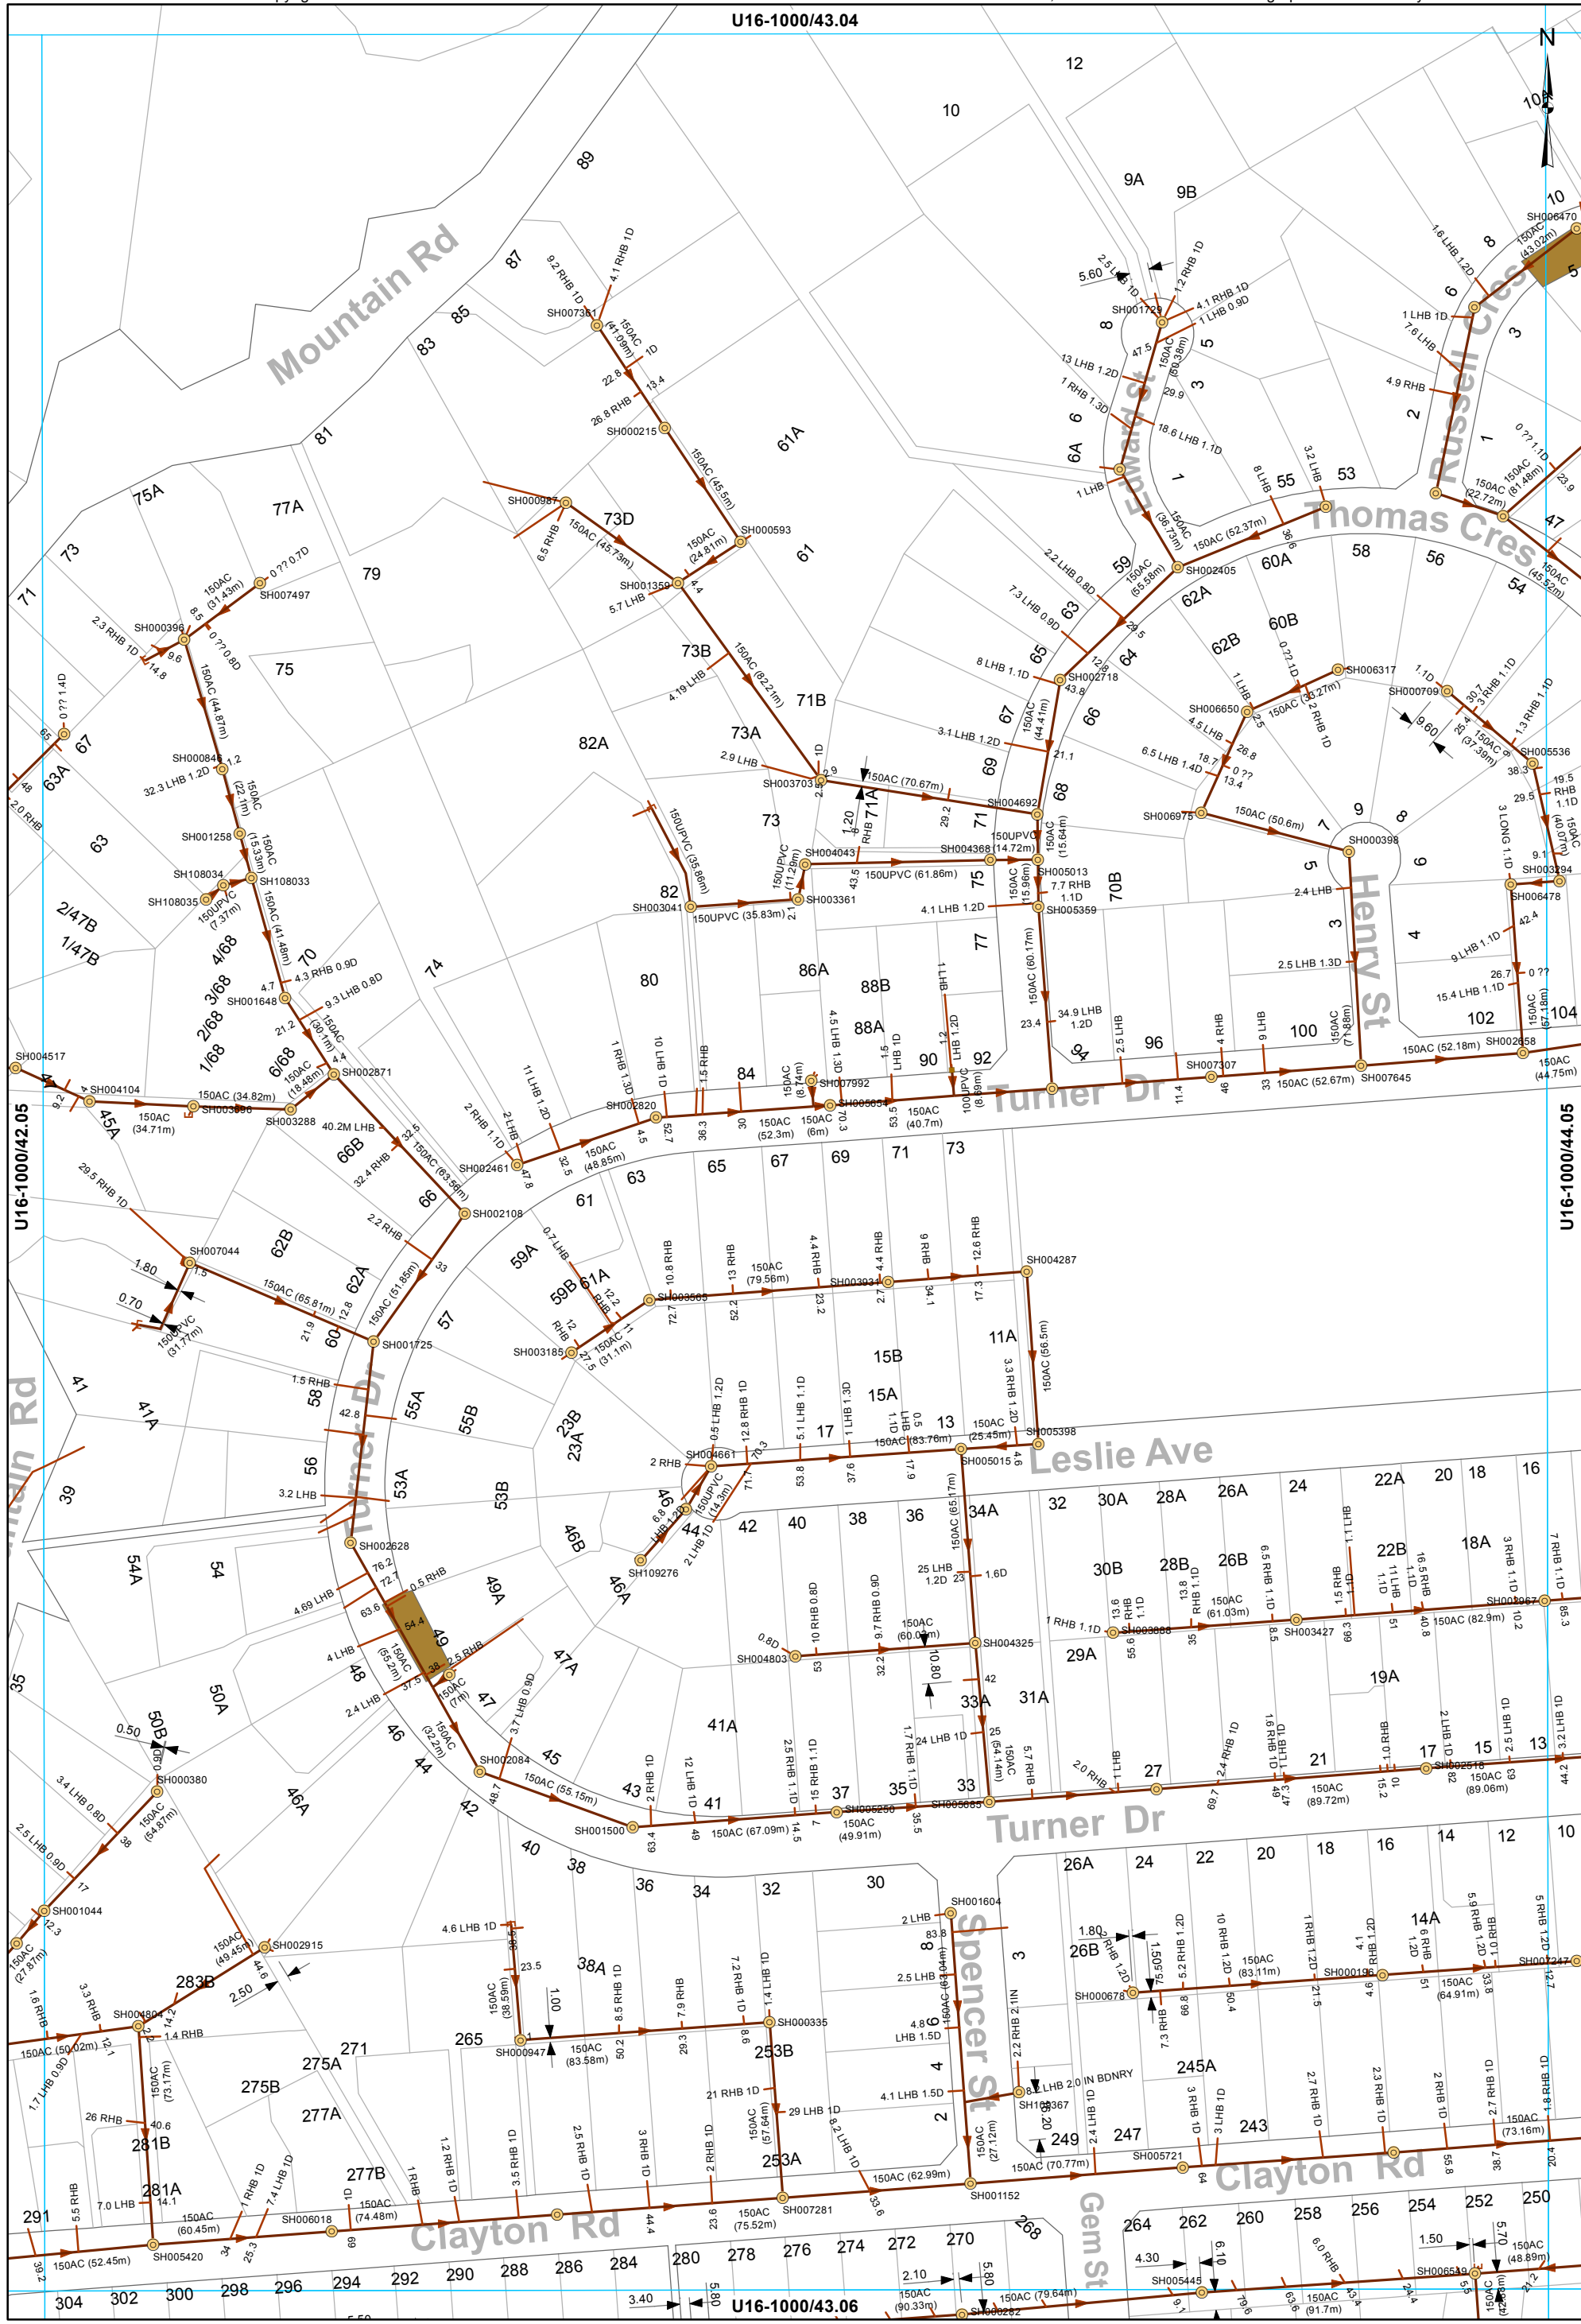

- Manhole
- Chamber - Inspection
- End of line - Capped end
- Main line
- Service Line


WASTEWATER SERVICES
1:2000 @ A3 - (U16-1000/43.05)

This data is derived from sources outside the control of Rotorua District Council and is for information only

All dimensions and levels should be verified by physical location on-site.

Rotorua District Council 2006. Facsimile 07 346 3143 Telephone 07 348 4199 email mail@rdc.govt.nz



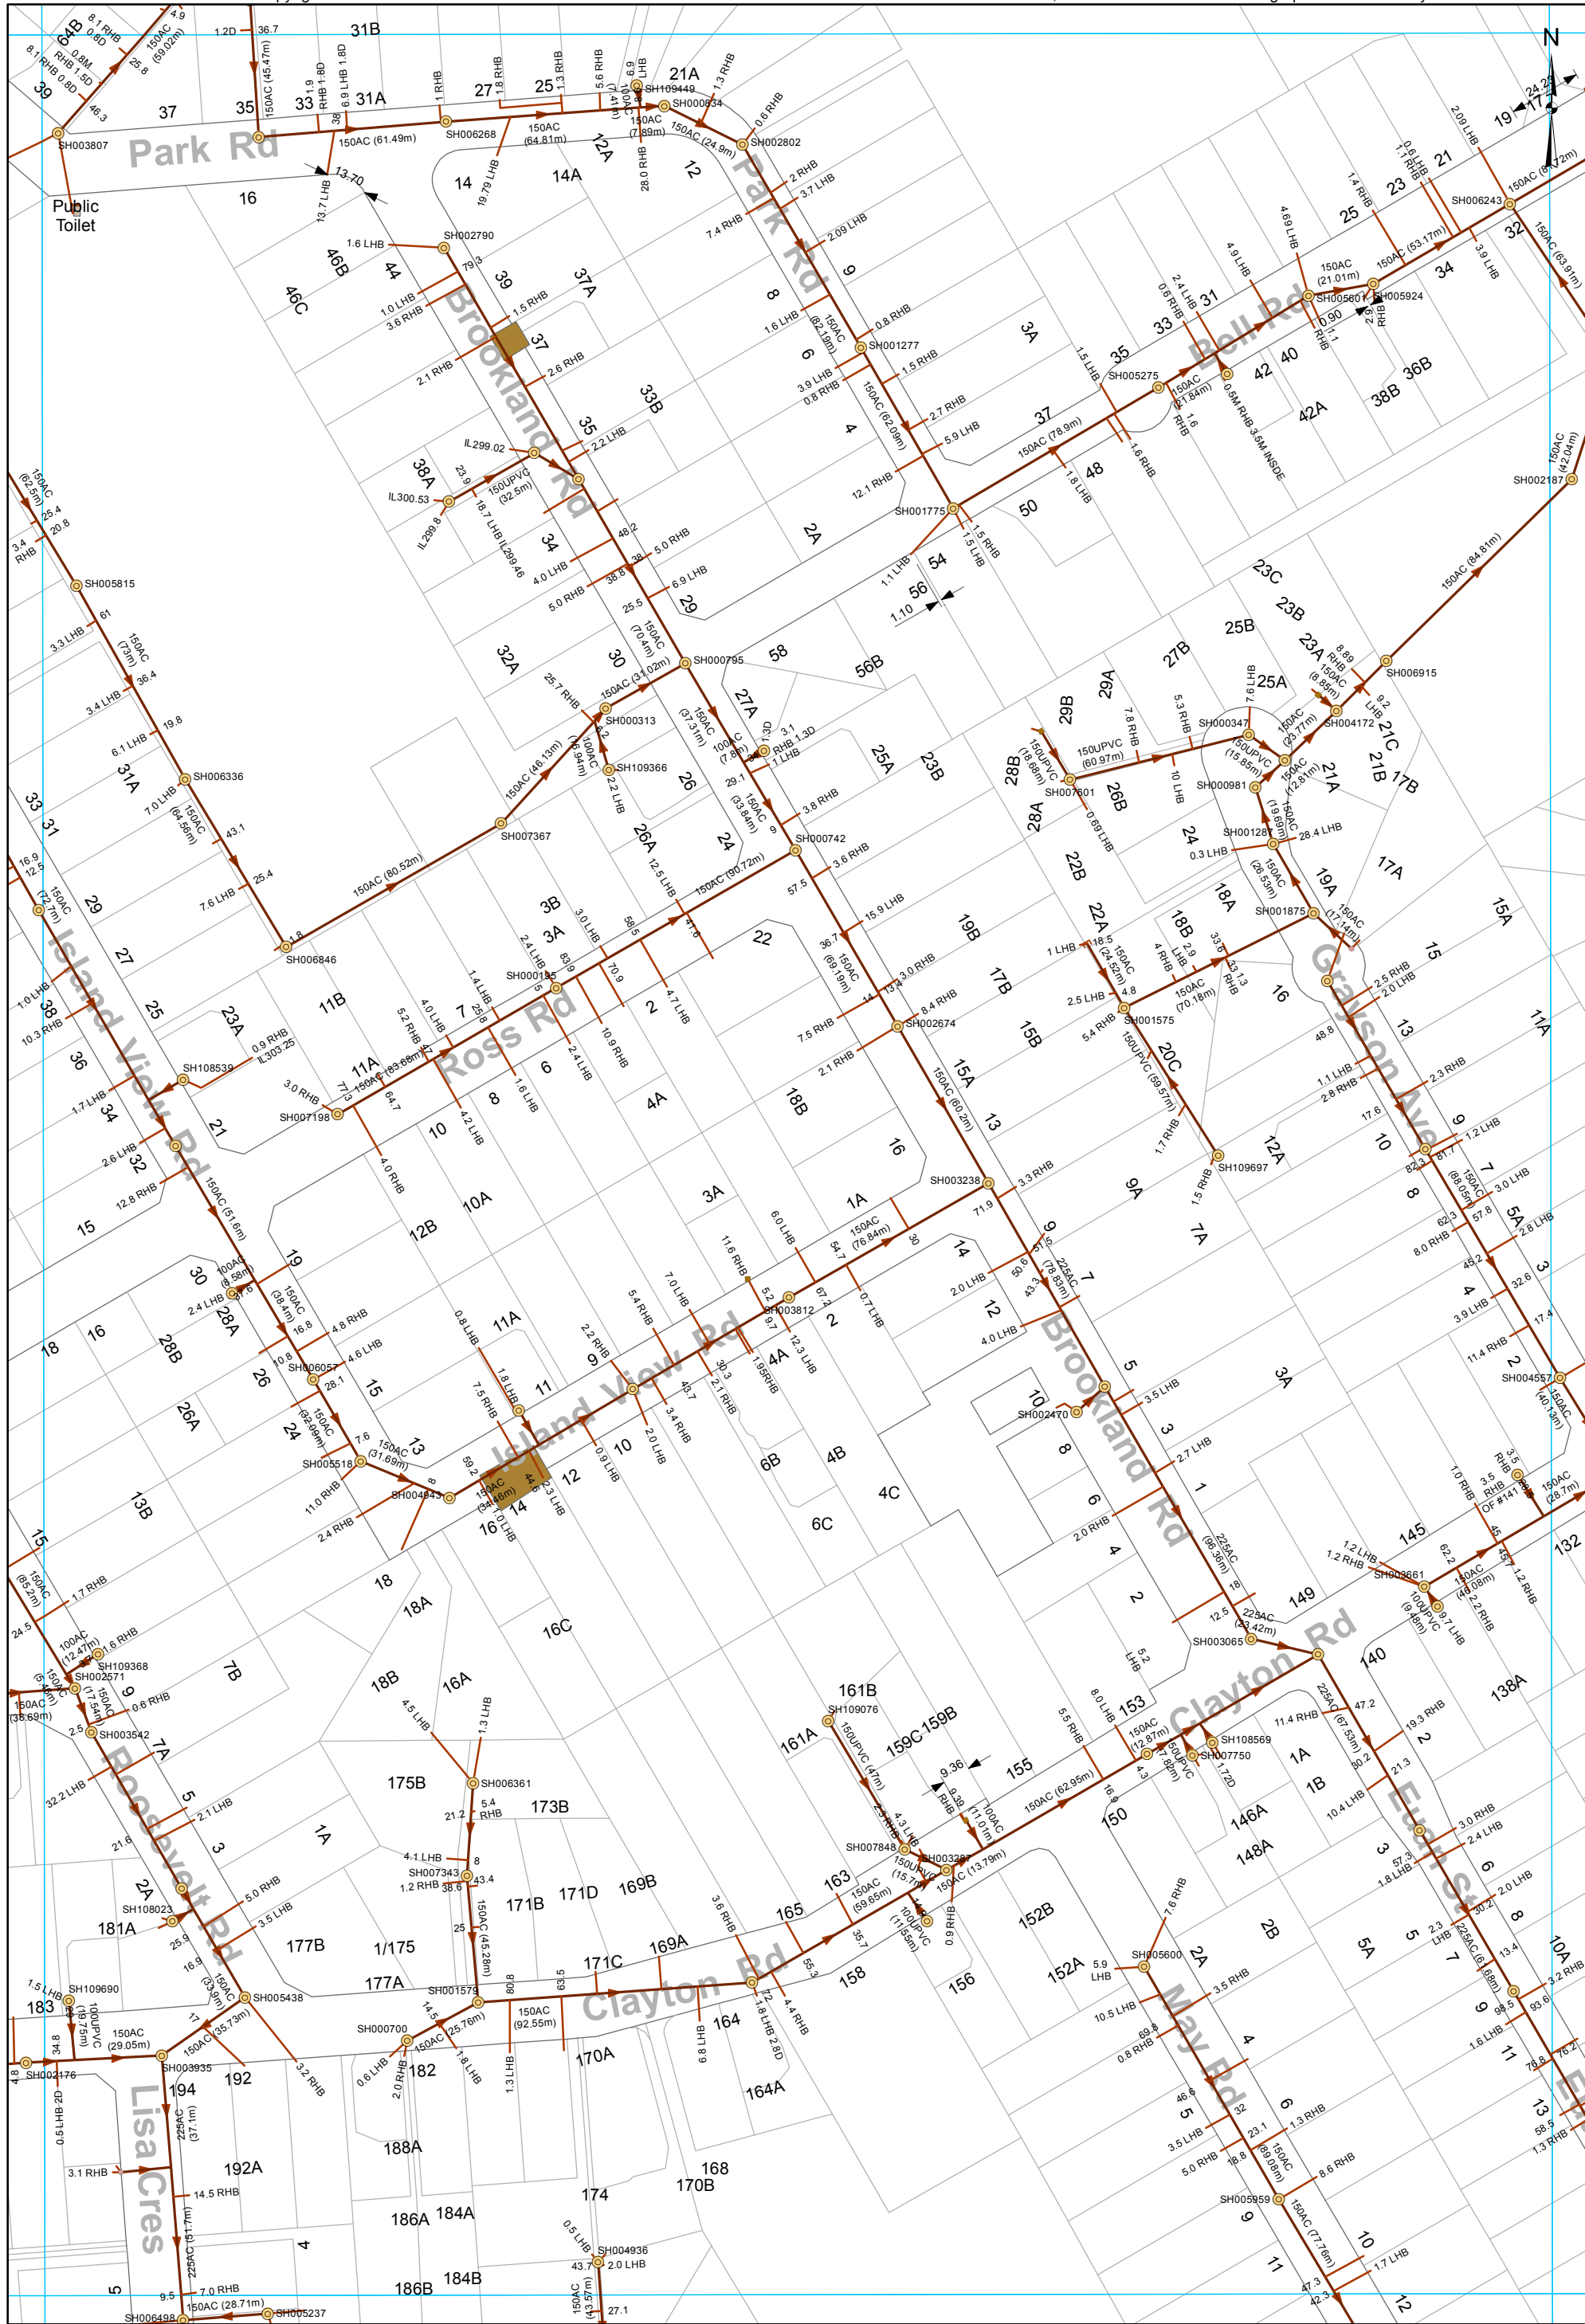



All dimensions and levels should be verified by physical location on-site.


This data is derived from sources outside the control of Rotorua District Council and is for information only

ould be verified by pl

 Manhole
  End of line - Capped end
  Main line

 Chamber - Inspection
 Service Line

WASTEWATER SERVICES
1:2000 @ A3 - (U16-1000/46.05)

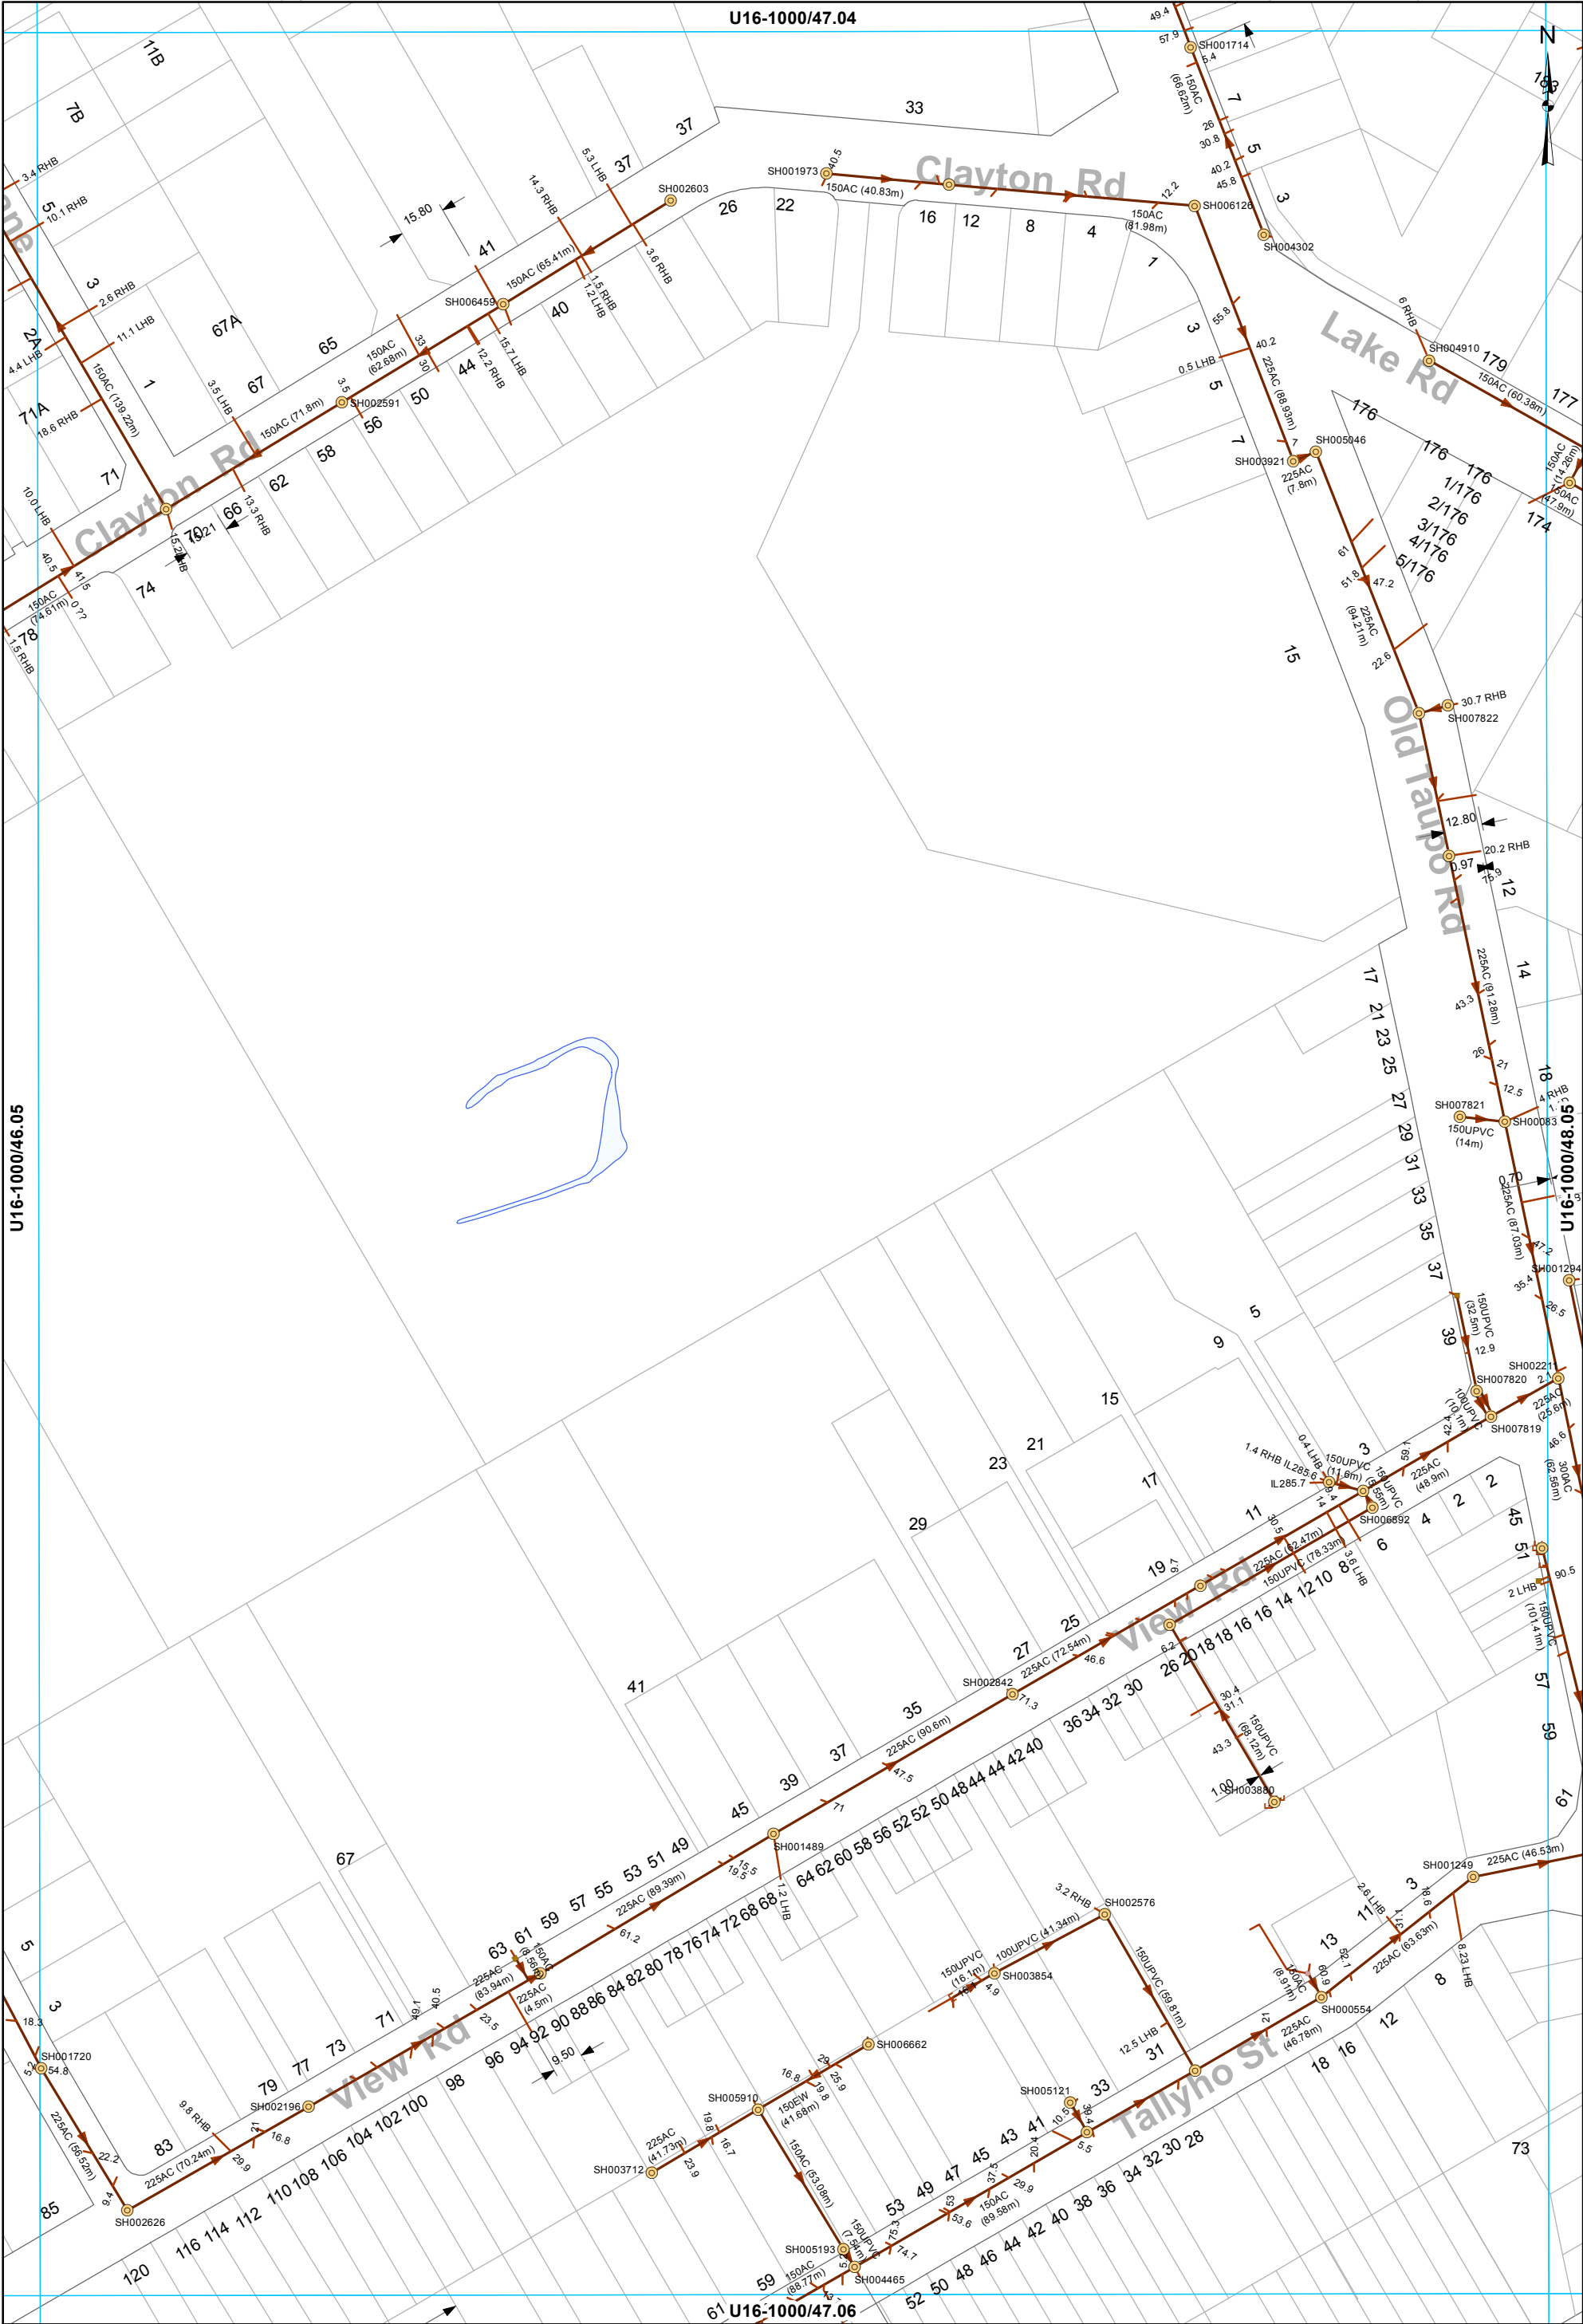

- Manhole
- Chamber - Inspection
- End of line - Capped end
- Inspection point
- Main line
- Service Line

WASTEWATER SERVICES
1:2000 @ A3 - (U16-1000/47.05)

This data is derived from sources outside the control of Rotorua District Council and is for information only.

Rotorua District Council 2006. Facsimile 07 346 3143 Telephone 07 348 4199 email mail@rdc.govt.nz



WASTEWATER SERVICES
1:2000 @ A3 - (U16-1000/48.05)




- WASTEWATER SERVICES**
1:2000 @ A3 - (U16-1000/49.05)

U16-1000/50.04




Lake Rotorua

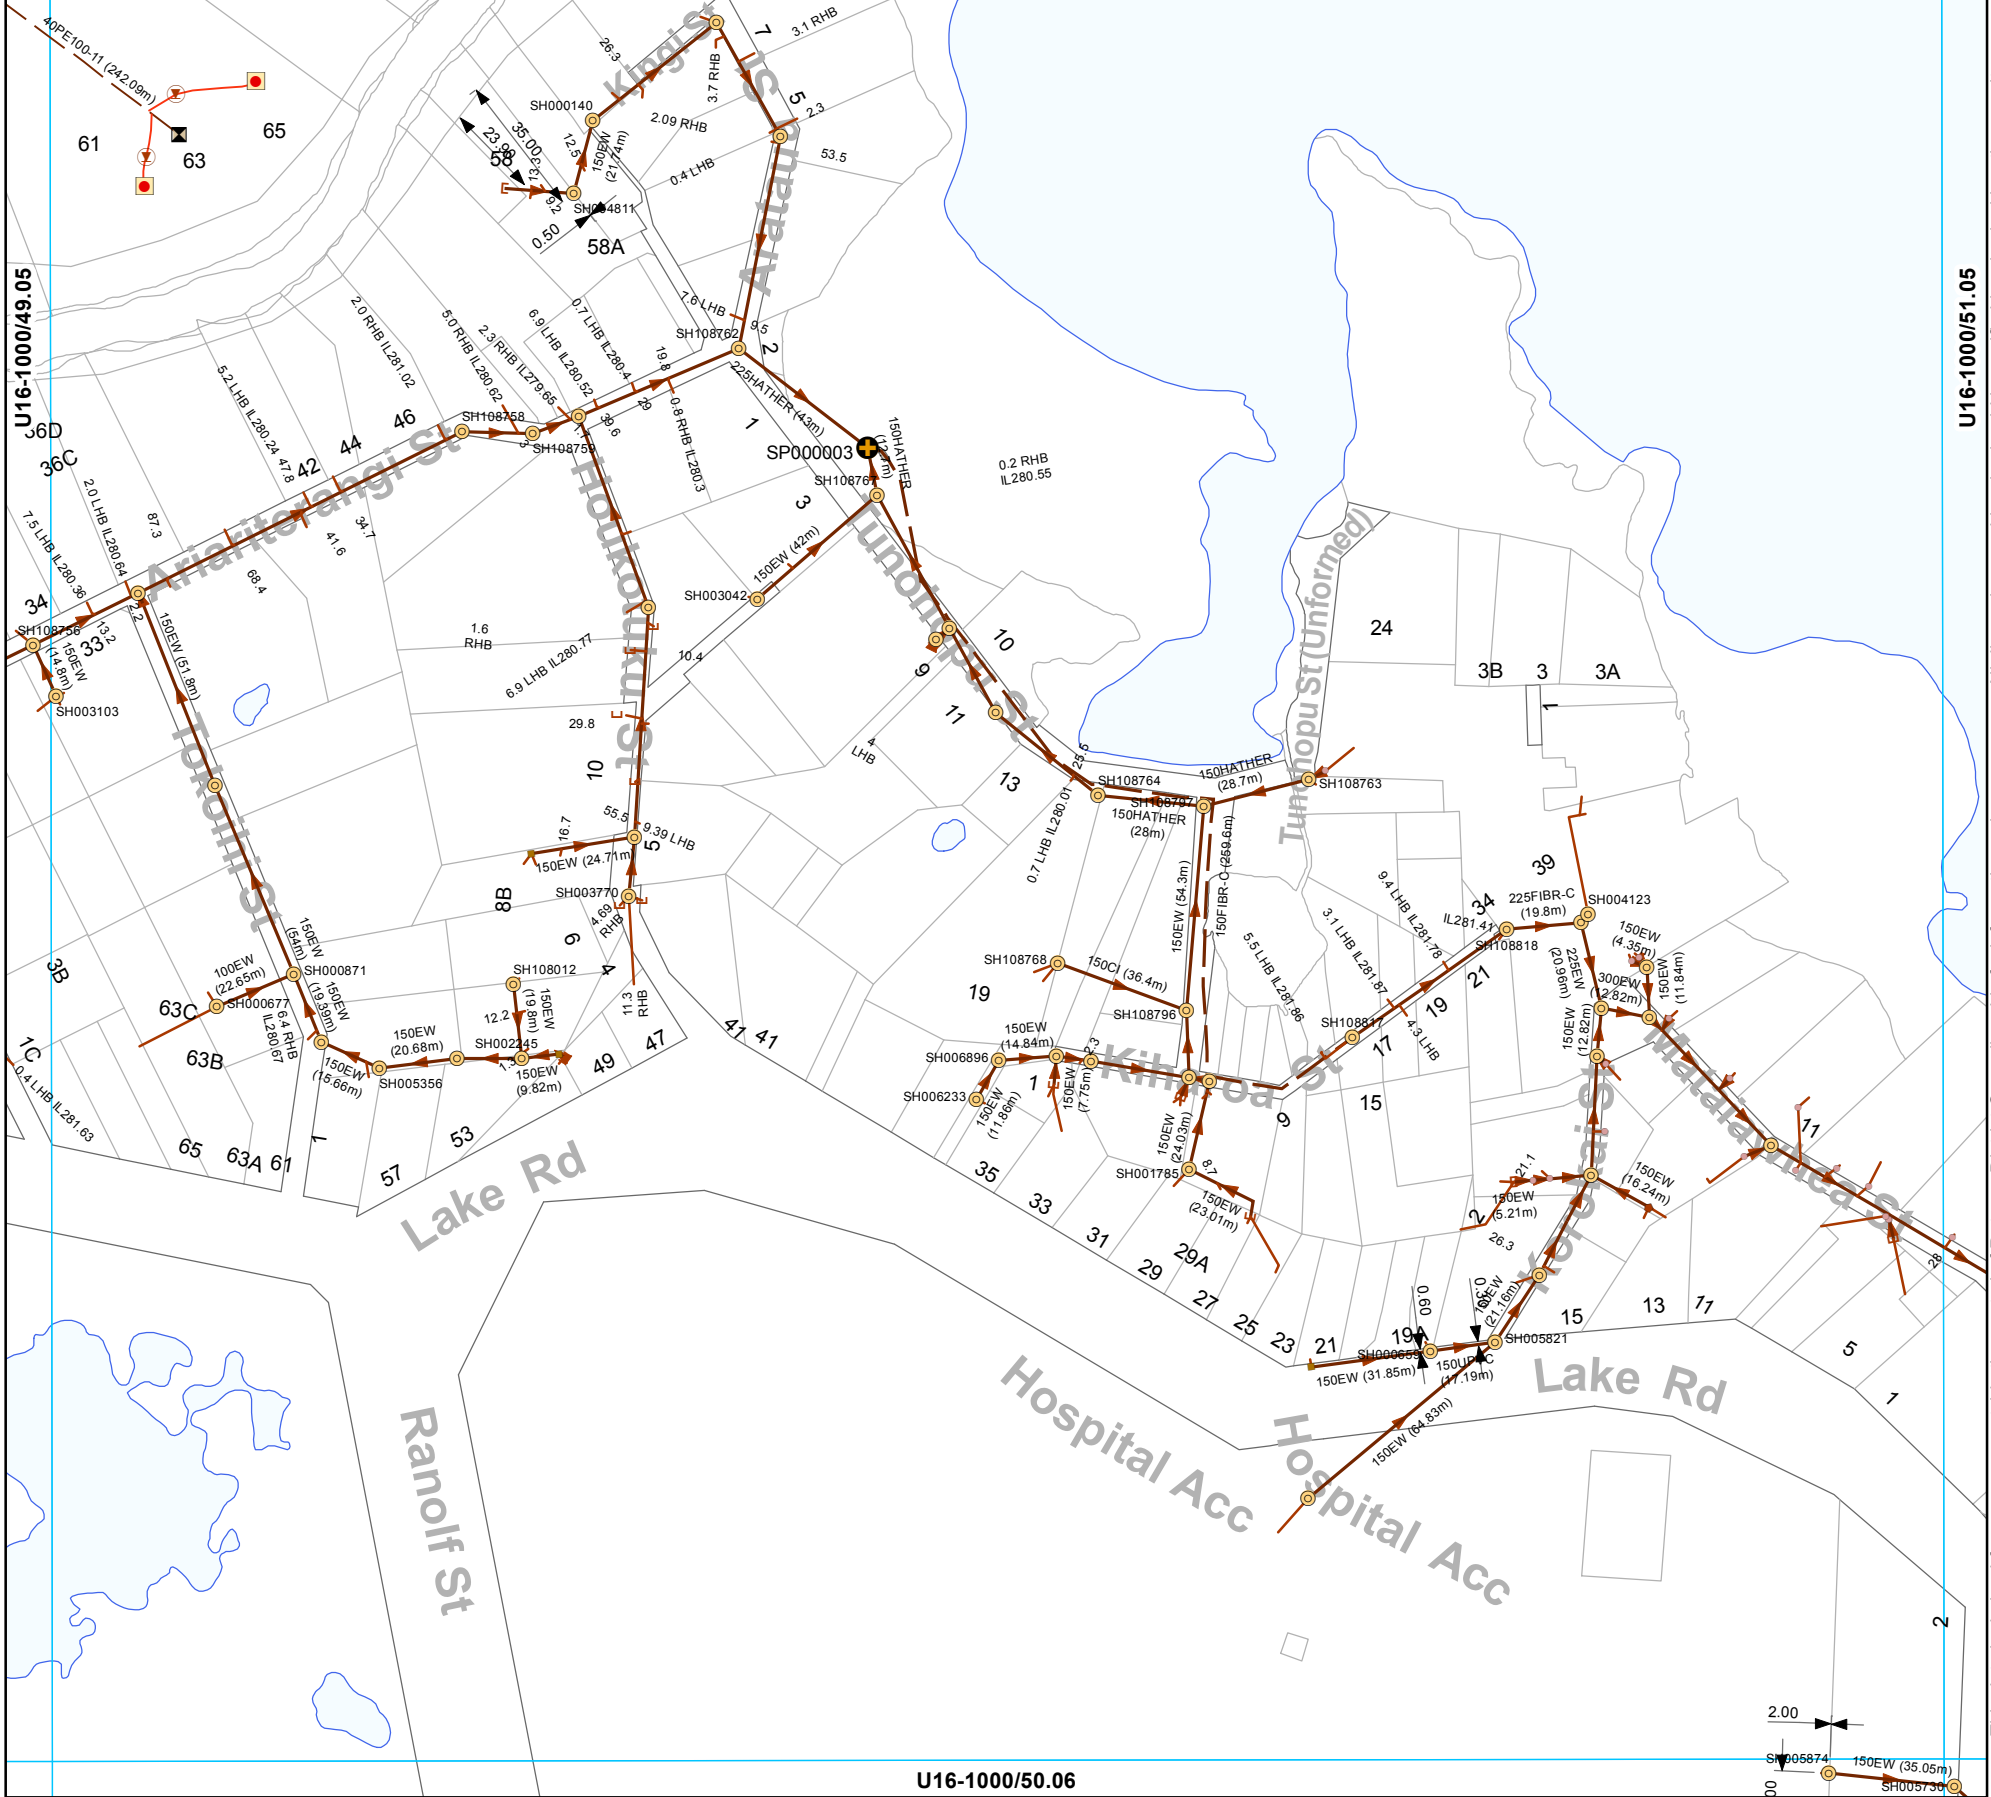



Manhole
Inspection point
Main line
Service Line

WASTEWATER SERVICES
1:2000 @ A3 - (U16-1000/51.05)

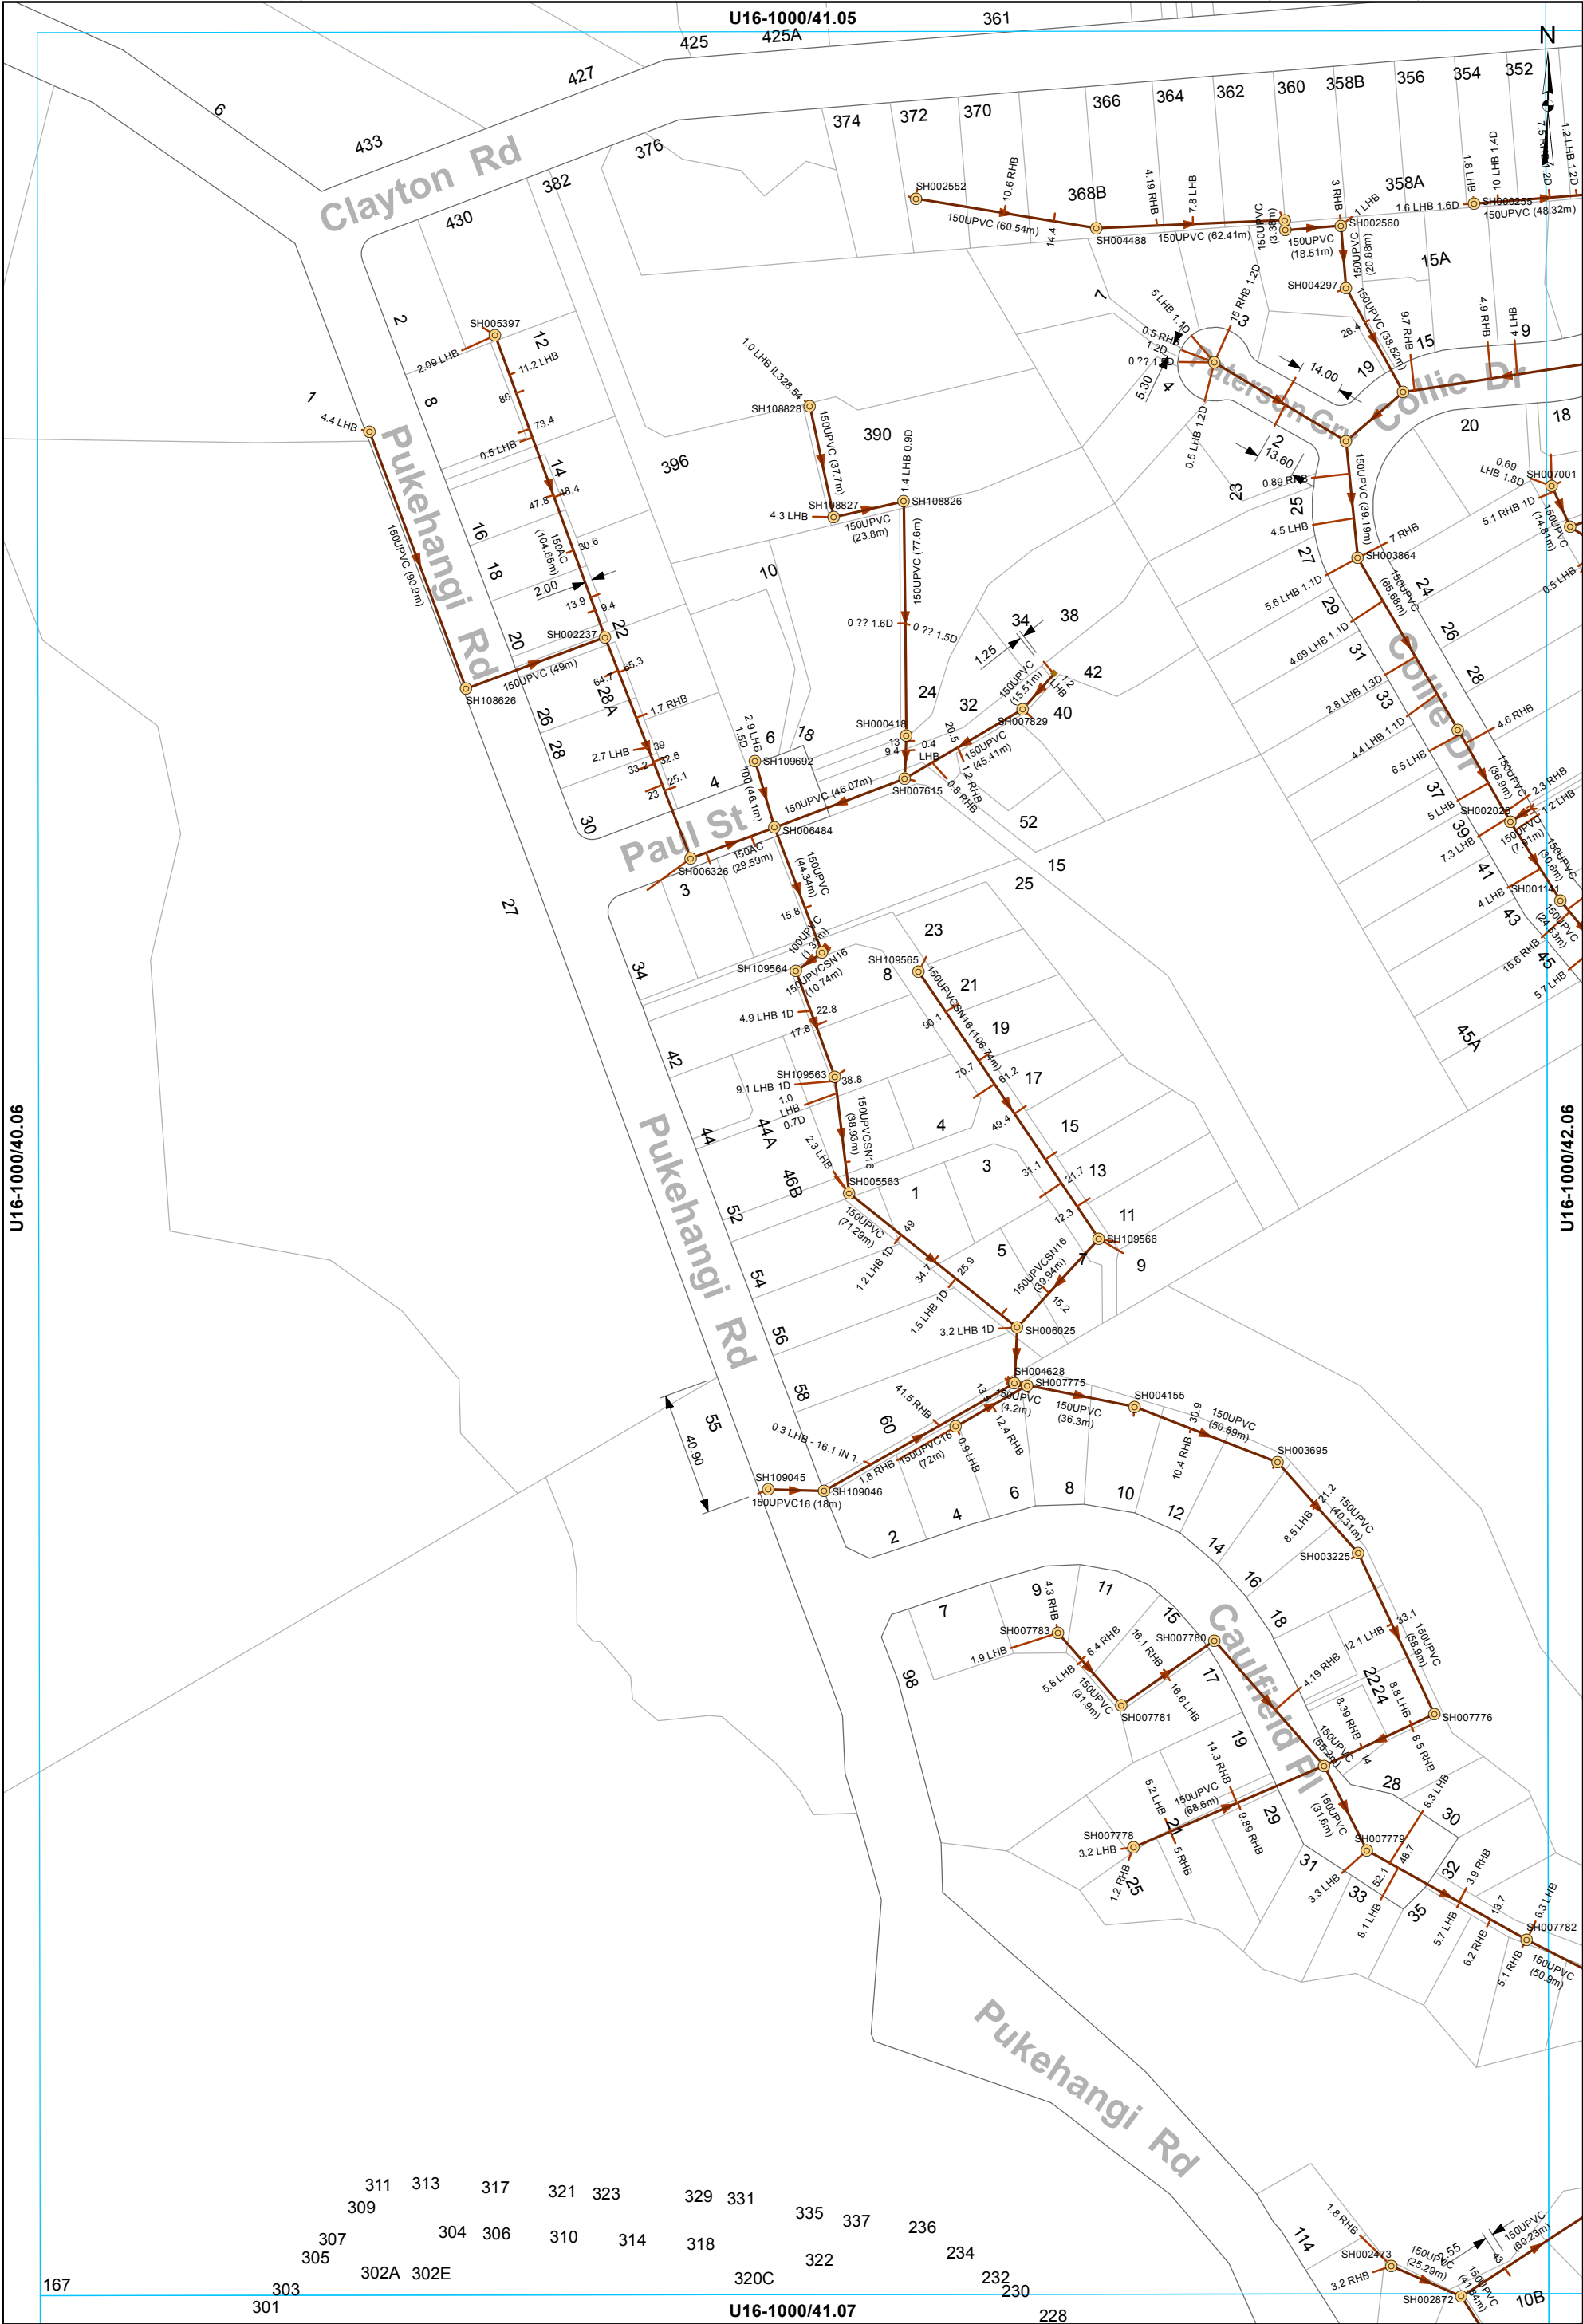

- Manhole
- Chamber - Inspection
- End of line - Capped end
- Main line
- Service Line


WASTEWATER SERVICES
1:2000 @ A3 - (U16-1000/41.06)

This data is derived from sources outside the control of Rotorua District Council and is for information only

U16-1000/42.06

All dimensions and levels should be verified by physical location on-site.

Rotorua District Council 2006. Facsimile 07 346 3143 Telephone 07 348 4199 email mail@rdc.govt.nz

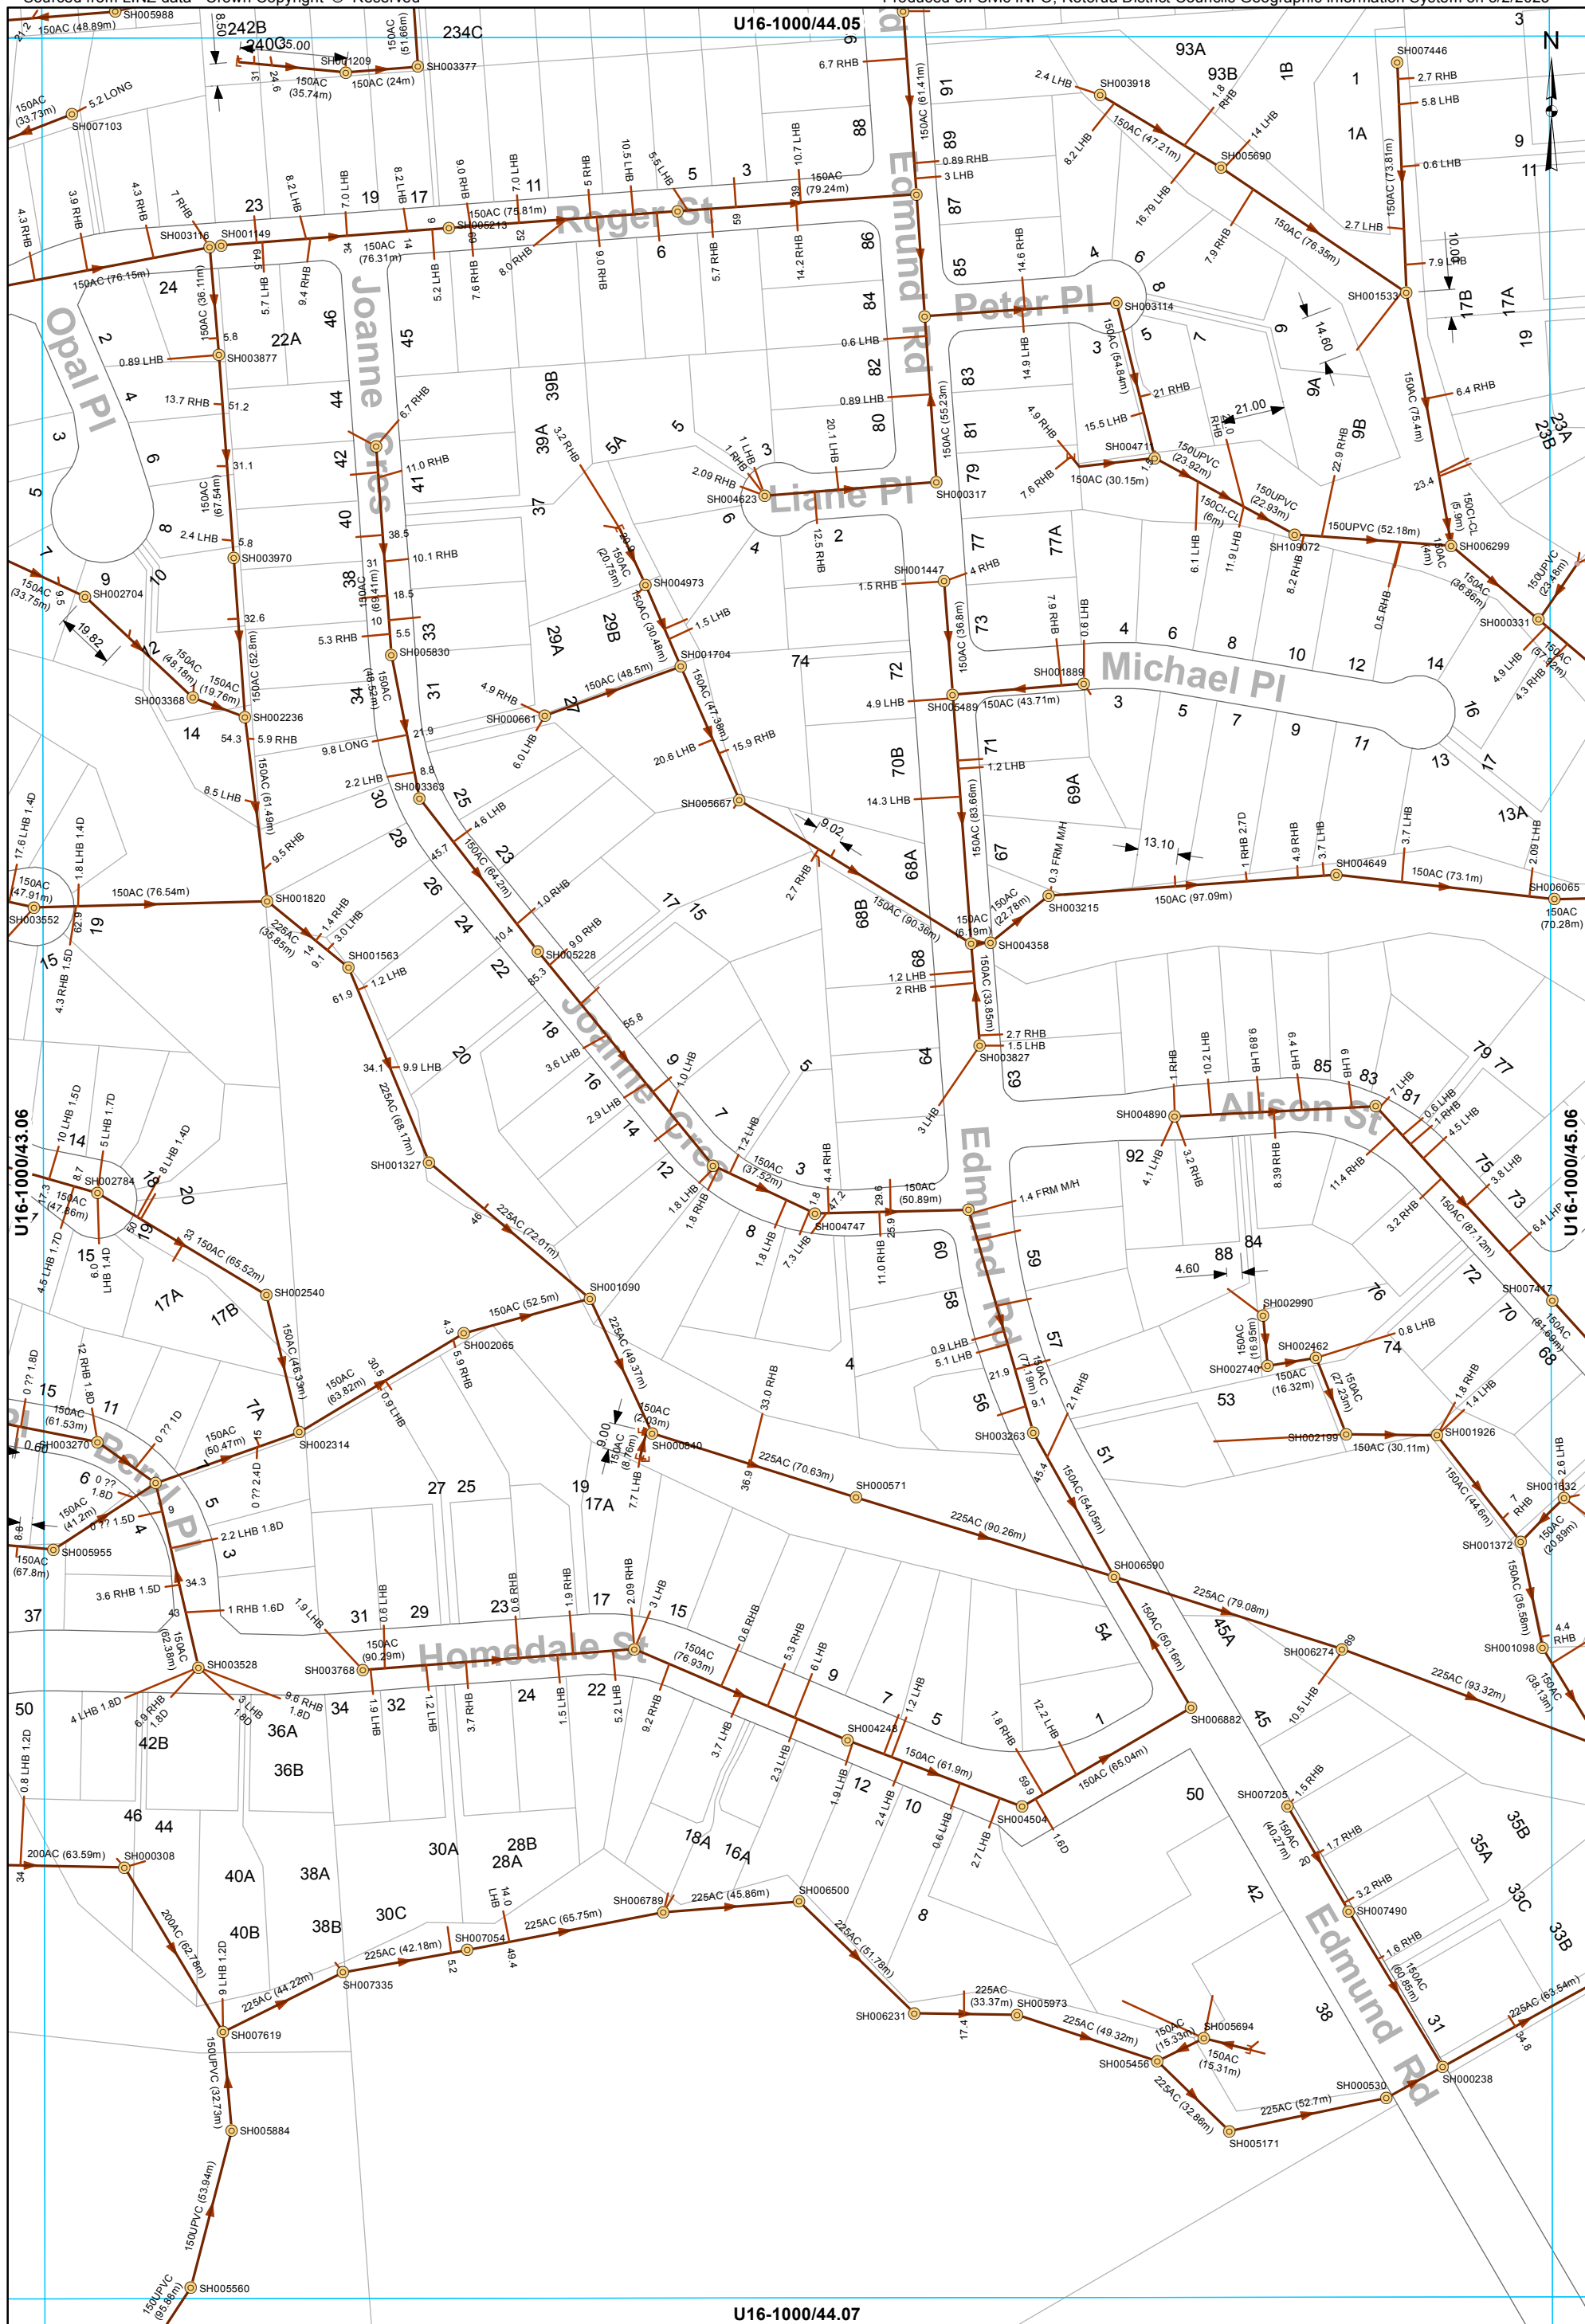


- Manhole
- End of line - Capped end
- Inspection point
- Main line
- Service Line

WASTEWATER SERVICES
1:2000 @ A3 - (U16-1000/44.06)

This data is derived from sources outside the control of Rotorua District Council and is for information only

All dimensions and levels should be verified by physical location on-site.

Rotorua District Council 2006. Facsimile 07 348 3143 Telephone 07 348 4199 email mail@rdc.govt.nz

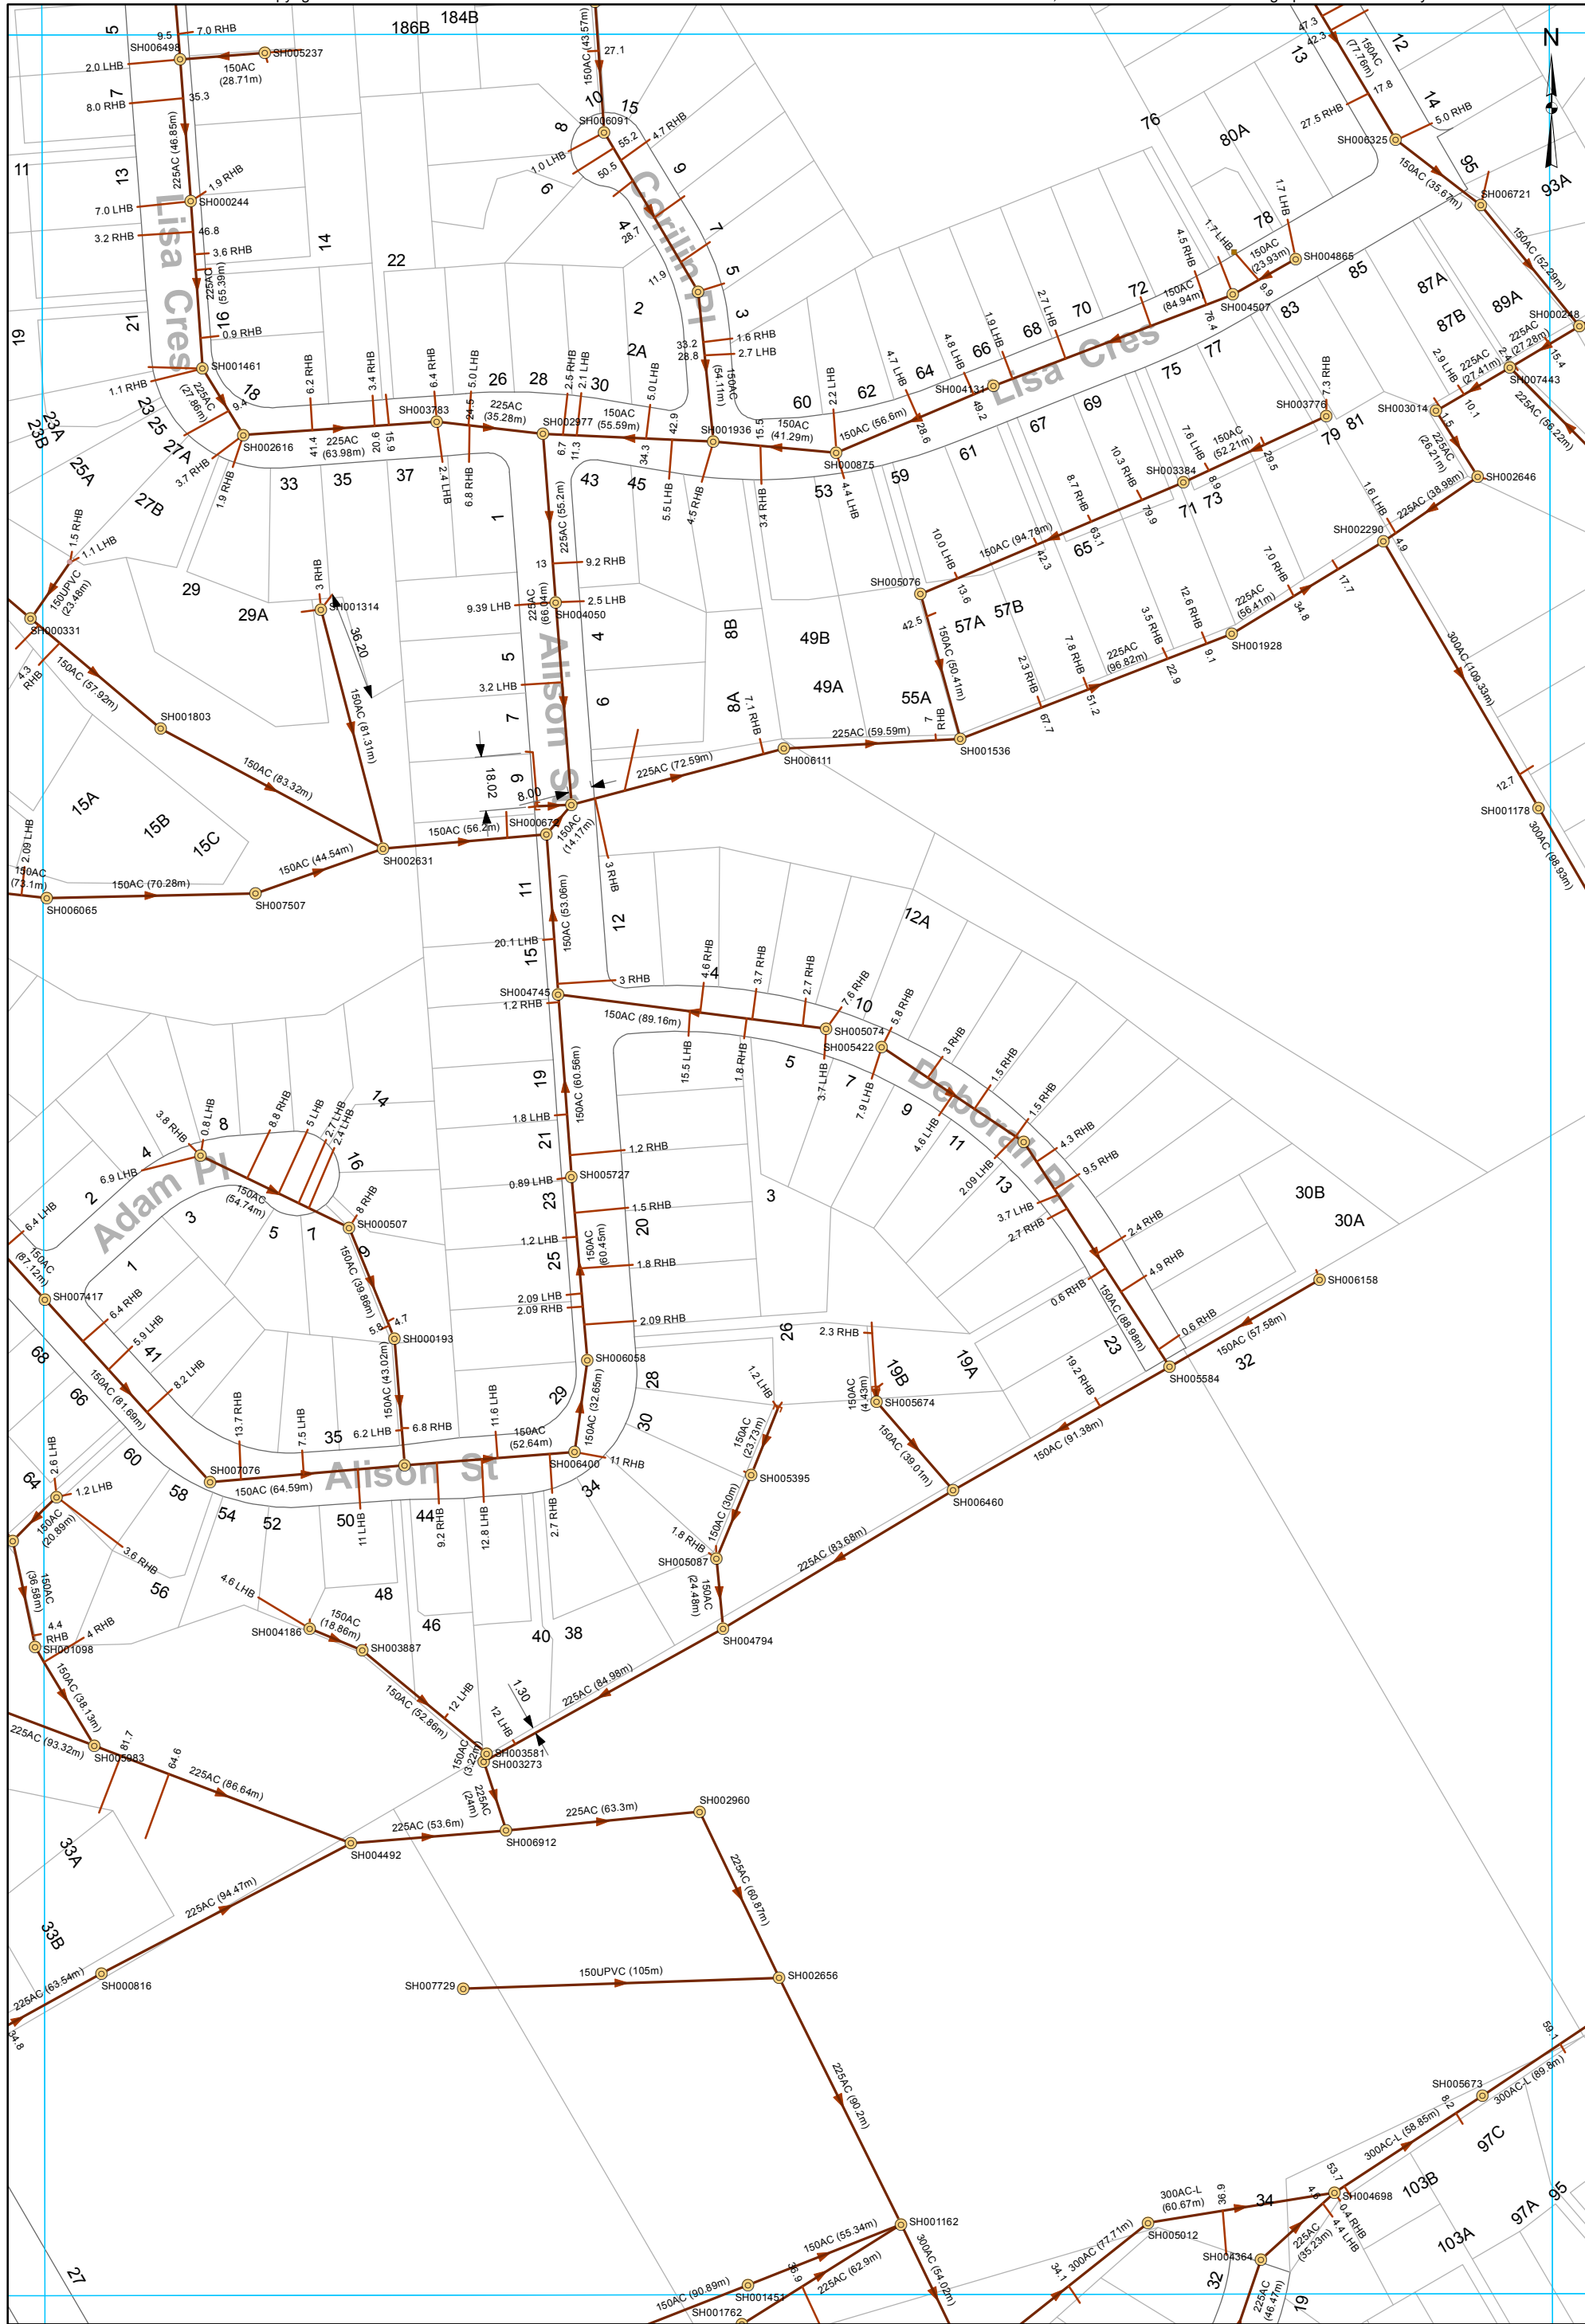


- | | | |
|------------------------|----------------------------|----------------|
| ● Manhole | □ End of line - Capped end | → Main line |
| ■ Chamber - Inspection | ● Inspection point | — Service Line |

WASTEWATER SERVICES
1:2000 @ A3 - (U16-1000/45.06)

This data is derived from sources outside the control of Rotorua District Council and is for information only

All dimensions and levels should be verified by physical location on-site.

Rotorua District Council 2006. Facsimile 07 346 3143 Telephone 07 348 4199 email mail@rdc.govt.nz

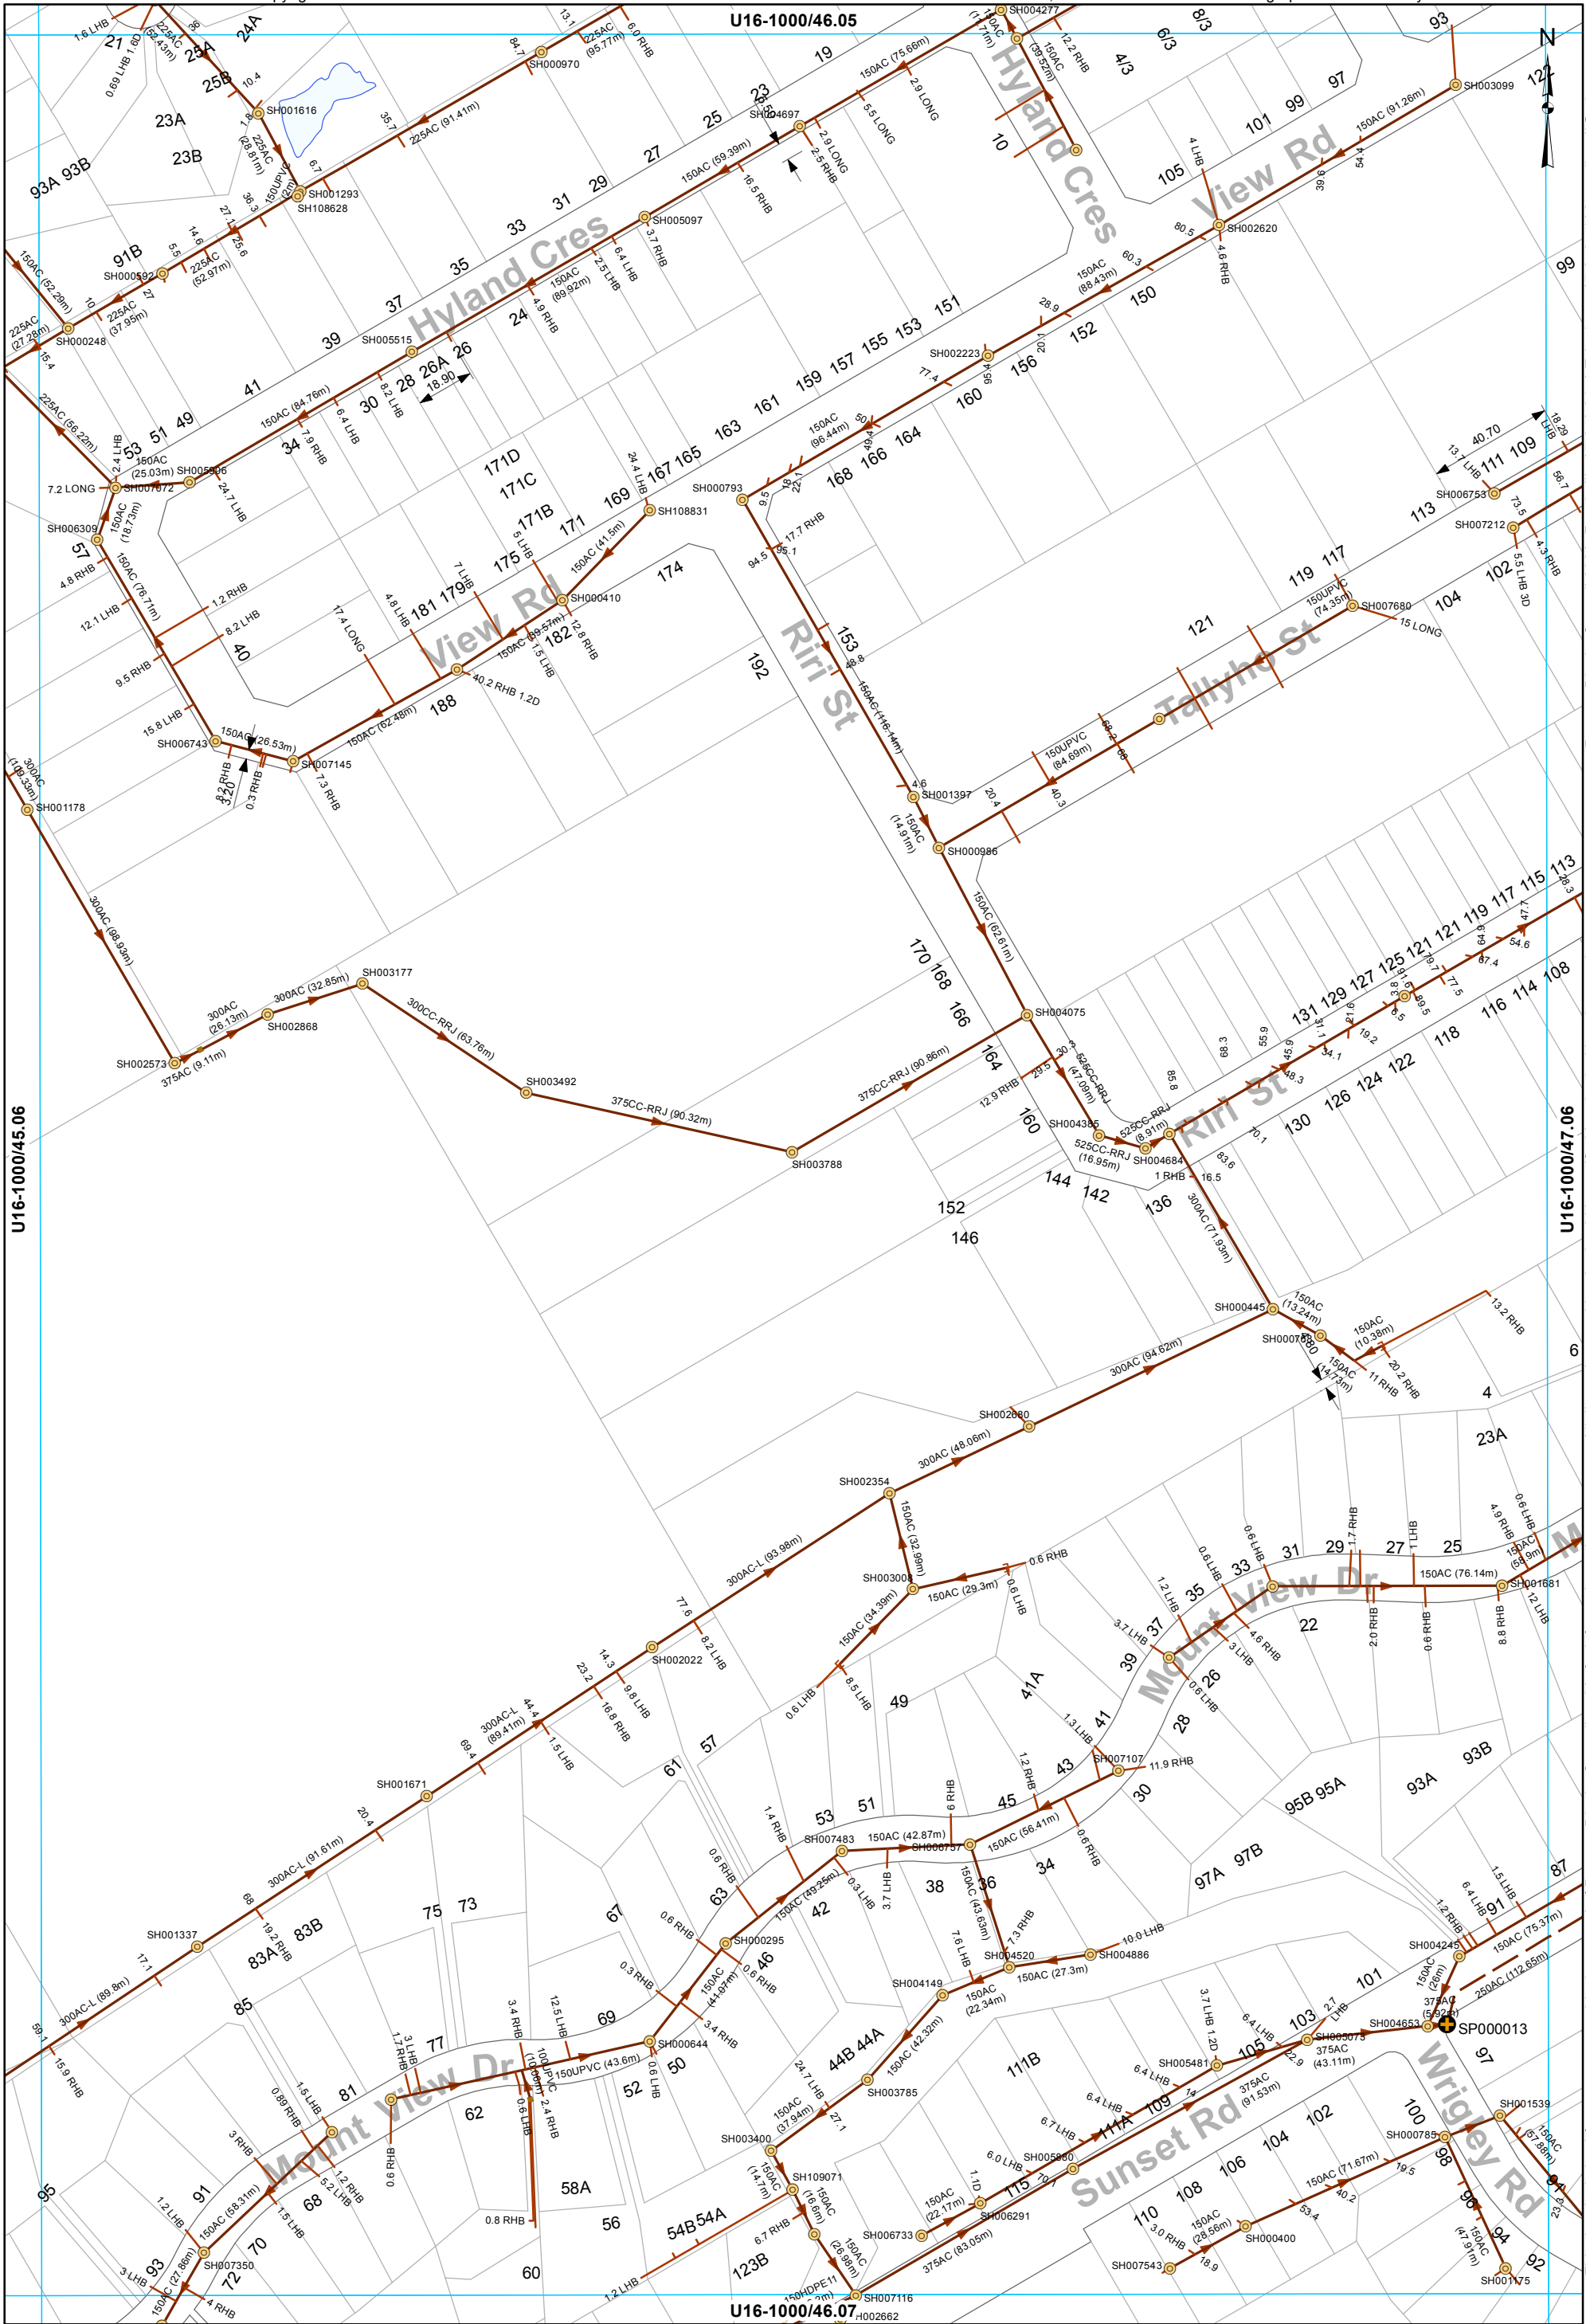

- Manhole
- Pump Station
- Chamber - Inspection
- End of line - Capped end
- Main line
- Rising main
- Service Line

 
WASTEWATER SERVICES
1:2000 @ A3 - (U16-1000/46.06)

This data is derived from sources outside the control of Rotorua District Council and is for information only


All dimensions and levels should be verified by physical location on-site.

Rotorua District Council 2006. Facsimile 07 346 3143 Telephone 07 348 4199 email mail@rdc.govt.nz





This data is derived from sources outside the control of Rotorua District Council and is for information only	All dimensions and levels should be verified by physical location on-site.
	

 - WASTEWATER SERVICES**
1:2000 @ A3 - (U16-1000/47.06)



 - WASTEWATER SERVICES**
1:2000 @ A3 - (U16-1000/48.06)



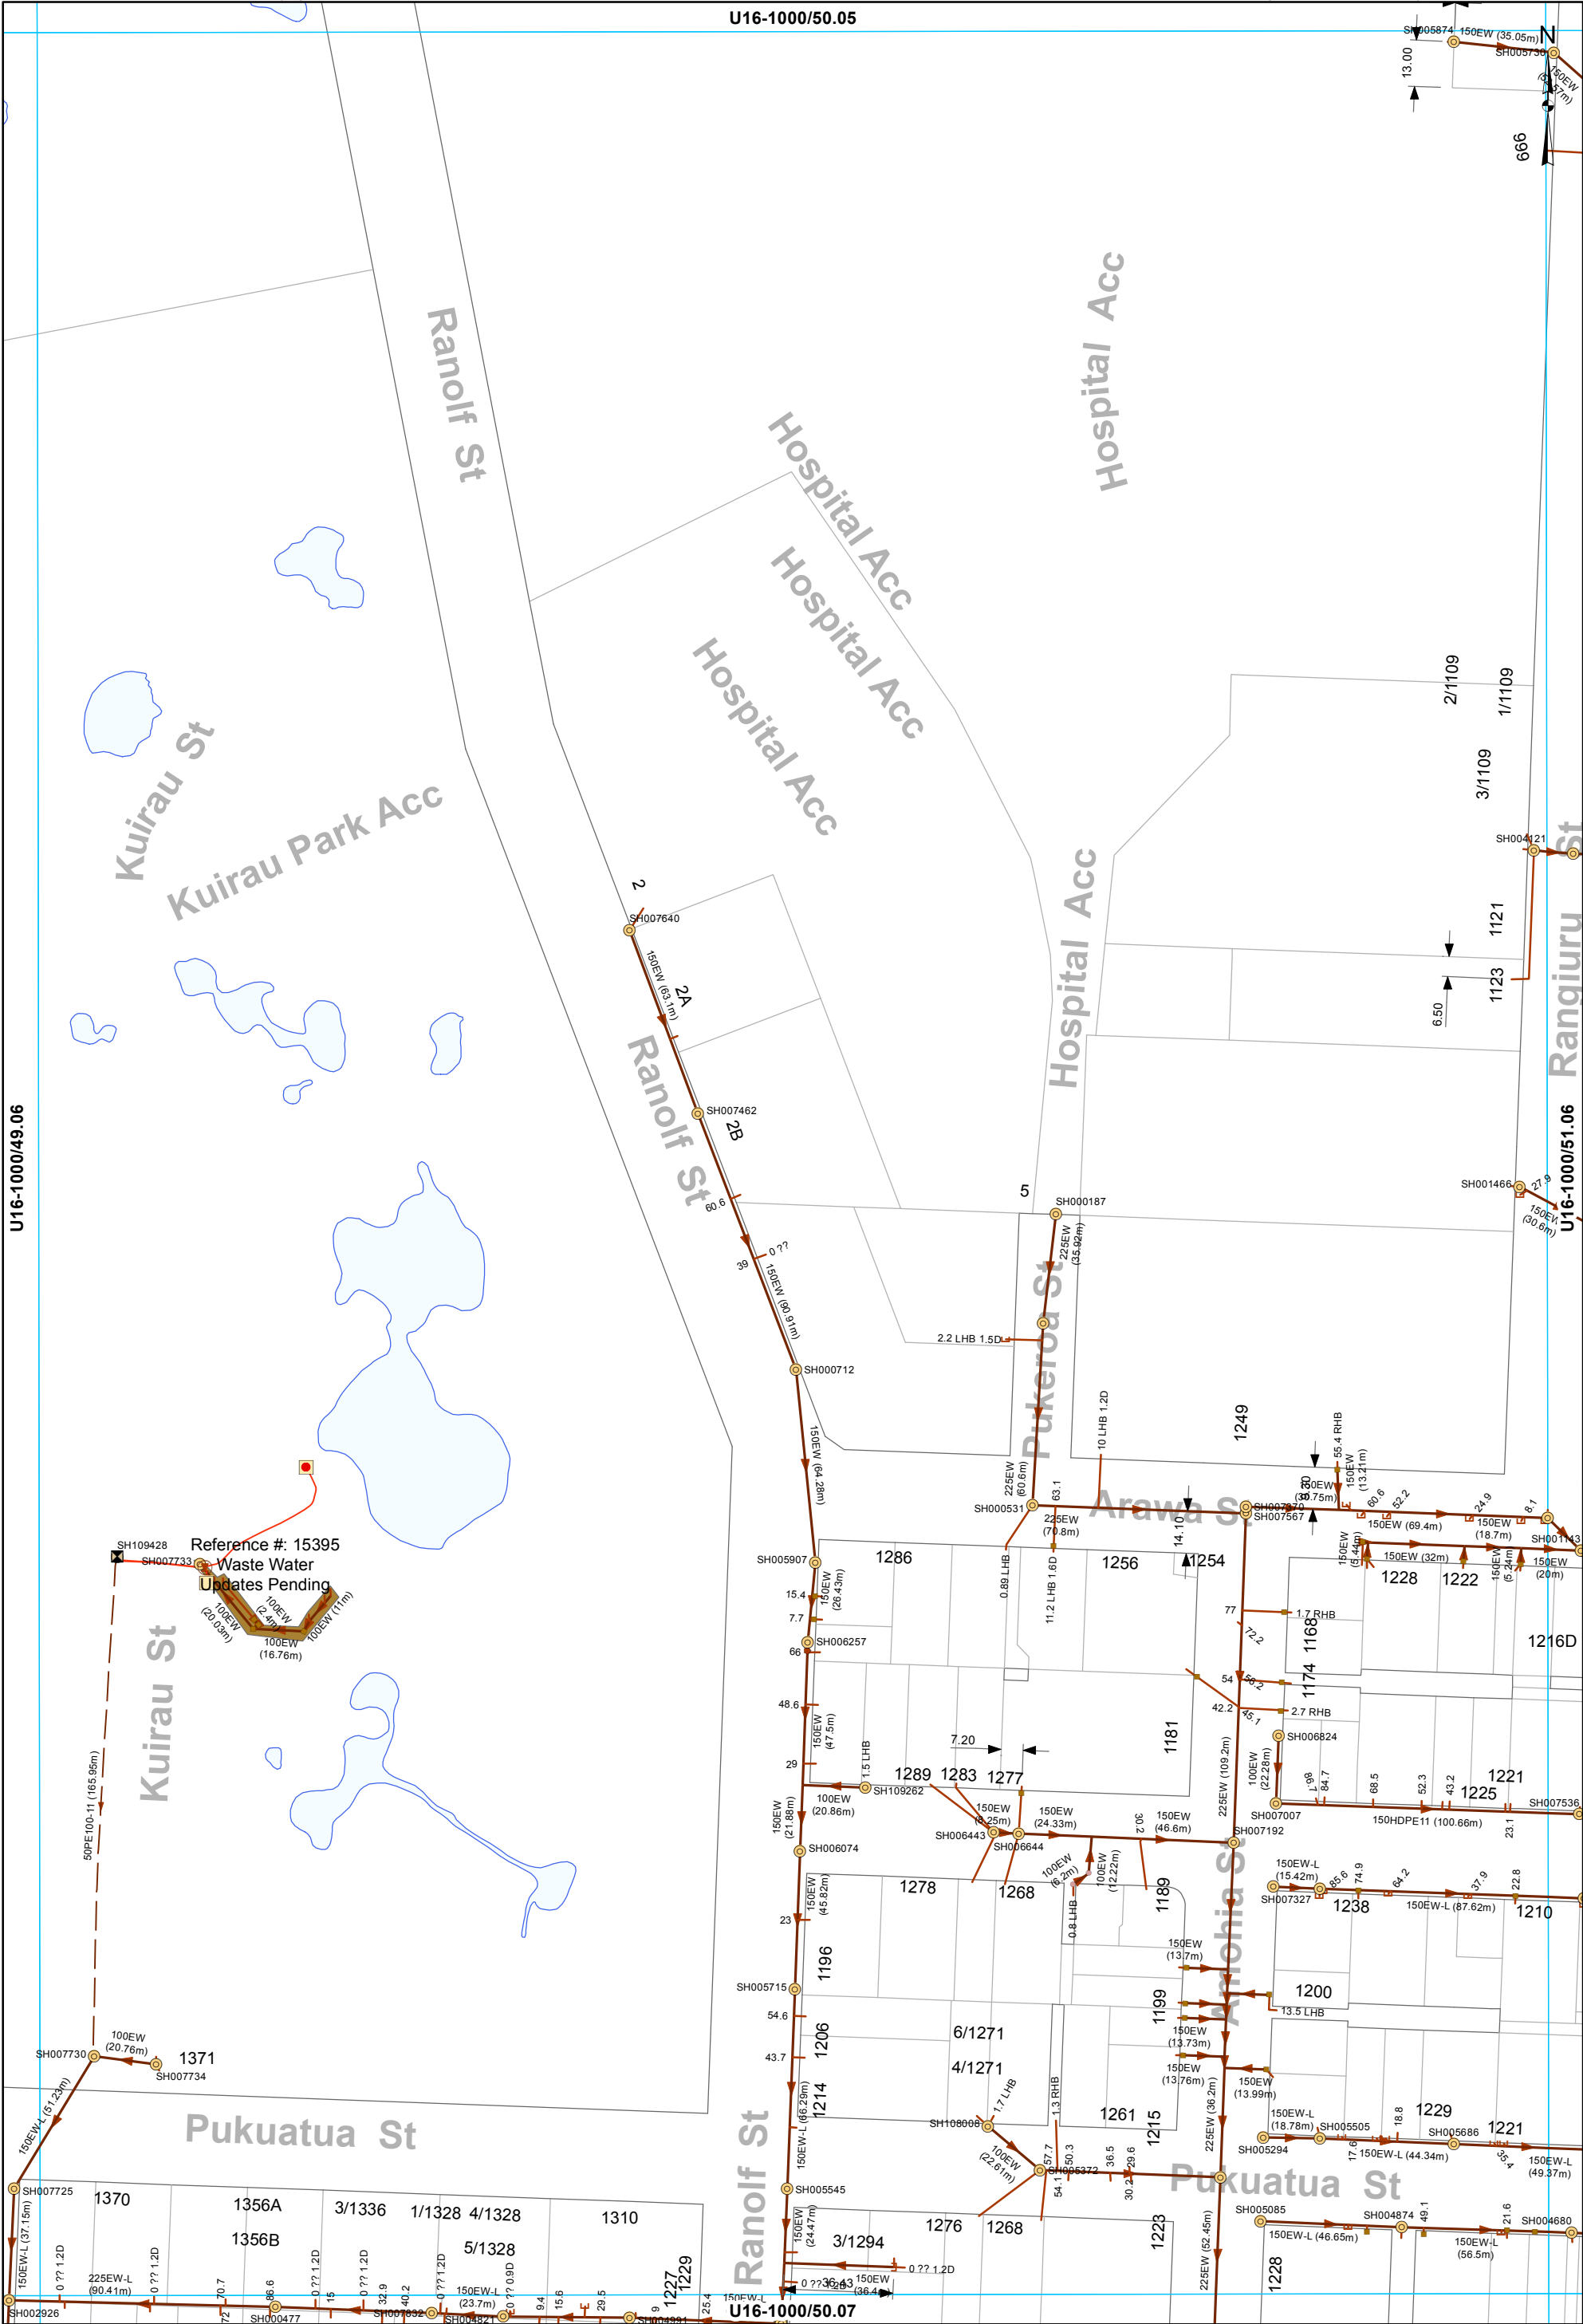


- | | | | |
|----------------------|----------------------------|-------------------|-------------------|
| Manhole | End of line - Capped end | Boundary Assembly | Low Pressure Main |
| Grinder Pump Chamber | End of line - Cleaning eye | Clean Out Point | Main line |
| LP Grinder Pump | Inspection point | | Service Line |
| Chamber - Inspection | | | LPGP Service Line |

WASTEWATER SERVICES
1:2000 @ A3 - (U16-1000/50.06)

This data is derived from sources outside the control of Rotorua District Council and is for information only

All dimensions and levels should be verified by physical location on-site.

Rotorua District Council 2006. Facsimile 07 346 3143 Telephone 07 348 4199 email mail@rdc.govt.nz

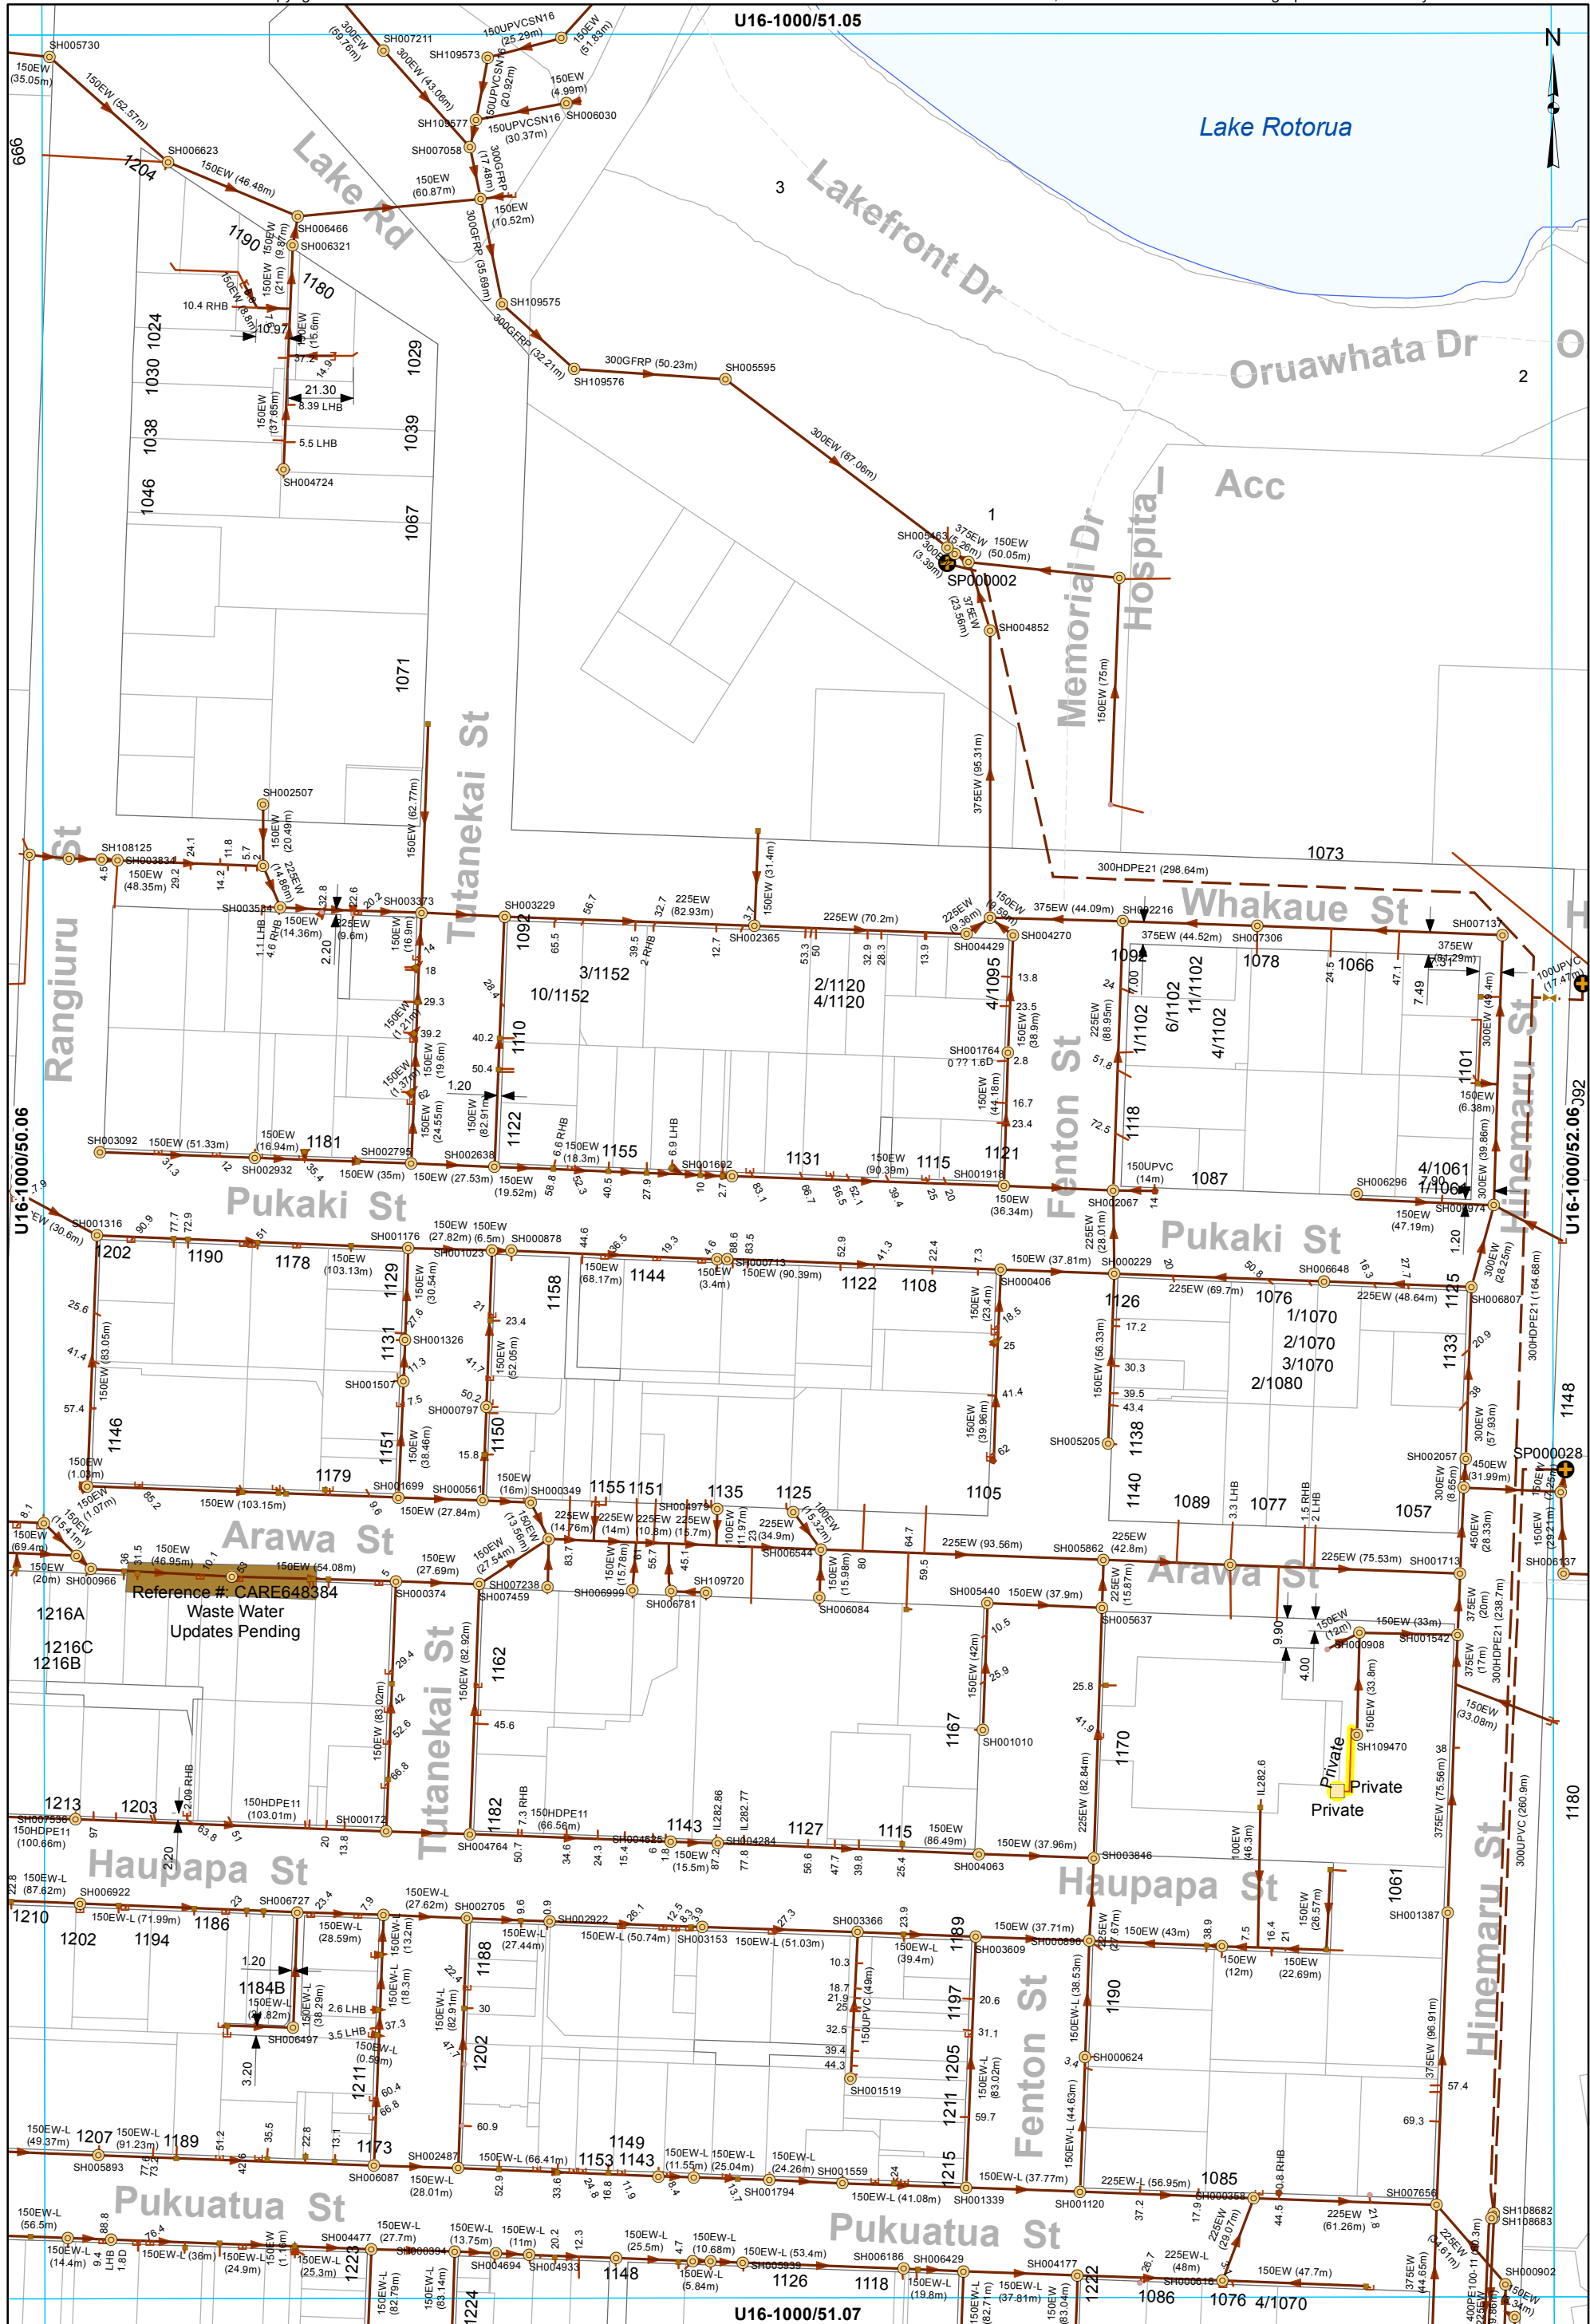

- | | | | |
|----------------------|----------------------------|-------------------|--------------|
| Manhole | End of line - Capped end | Isolating Valve | Main line |
| Pump Station | End of line - Cleaning eye | Private Asset | Rising main |
| Grinder Pump Chamber | Inspection point | Private Asset | Service Line |
| Chamber - Inspection | | LPGP Service Line | |

WASTEWATER SERVICES
1:2000 @ A3 - (U16-1000/51.06)

This data is derived from sources outside the control of Rotorua District Council and is for information only

All dimensions and levels should be verified by physical location on-site.

Rotorua District Council 2006. Facsimile 07 346 3143 Telephone 07 348 4199 email mail@rdc.govt.nz

U16-1000/52.05



Lake Rotorua

Oruawhata Dr

Hospital Acc

Hospital Acc

Hospital Acc

Oruawhata Dr

Queens Dr

Queens Dr

Hatupatu Dr

U16-1000/52.07

U16-1000/53.06

- Manhole
- Pump Station
- Grinder Pump Chamber
- LP Grinder Pump
- Chamber - Inspection

- End of line - Capped end
- End of line - Cleaning eye

- Boundary Assembly
- Isolating Valve


- Main line
- Rising main
- Service Line
- LPGP Service Line

WASTEWATER SERVICES
1:2000 @ A3 - (U16-1000/52.06)


All dimensions and levels should be verified by physical location on-site.

This data is derived from sources outside the control of Rotorua District Council and is for information only

Rotorua District Council 2006. Facsimile 07 348 3143 Telephone 07 348 4199 email mail@rdc.govt.nz

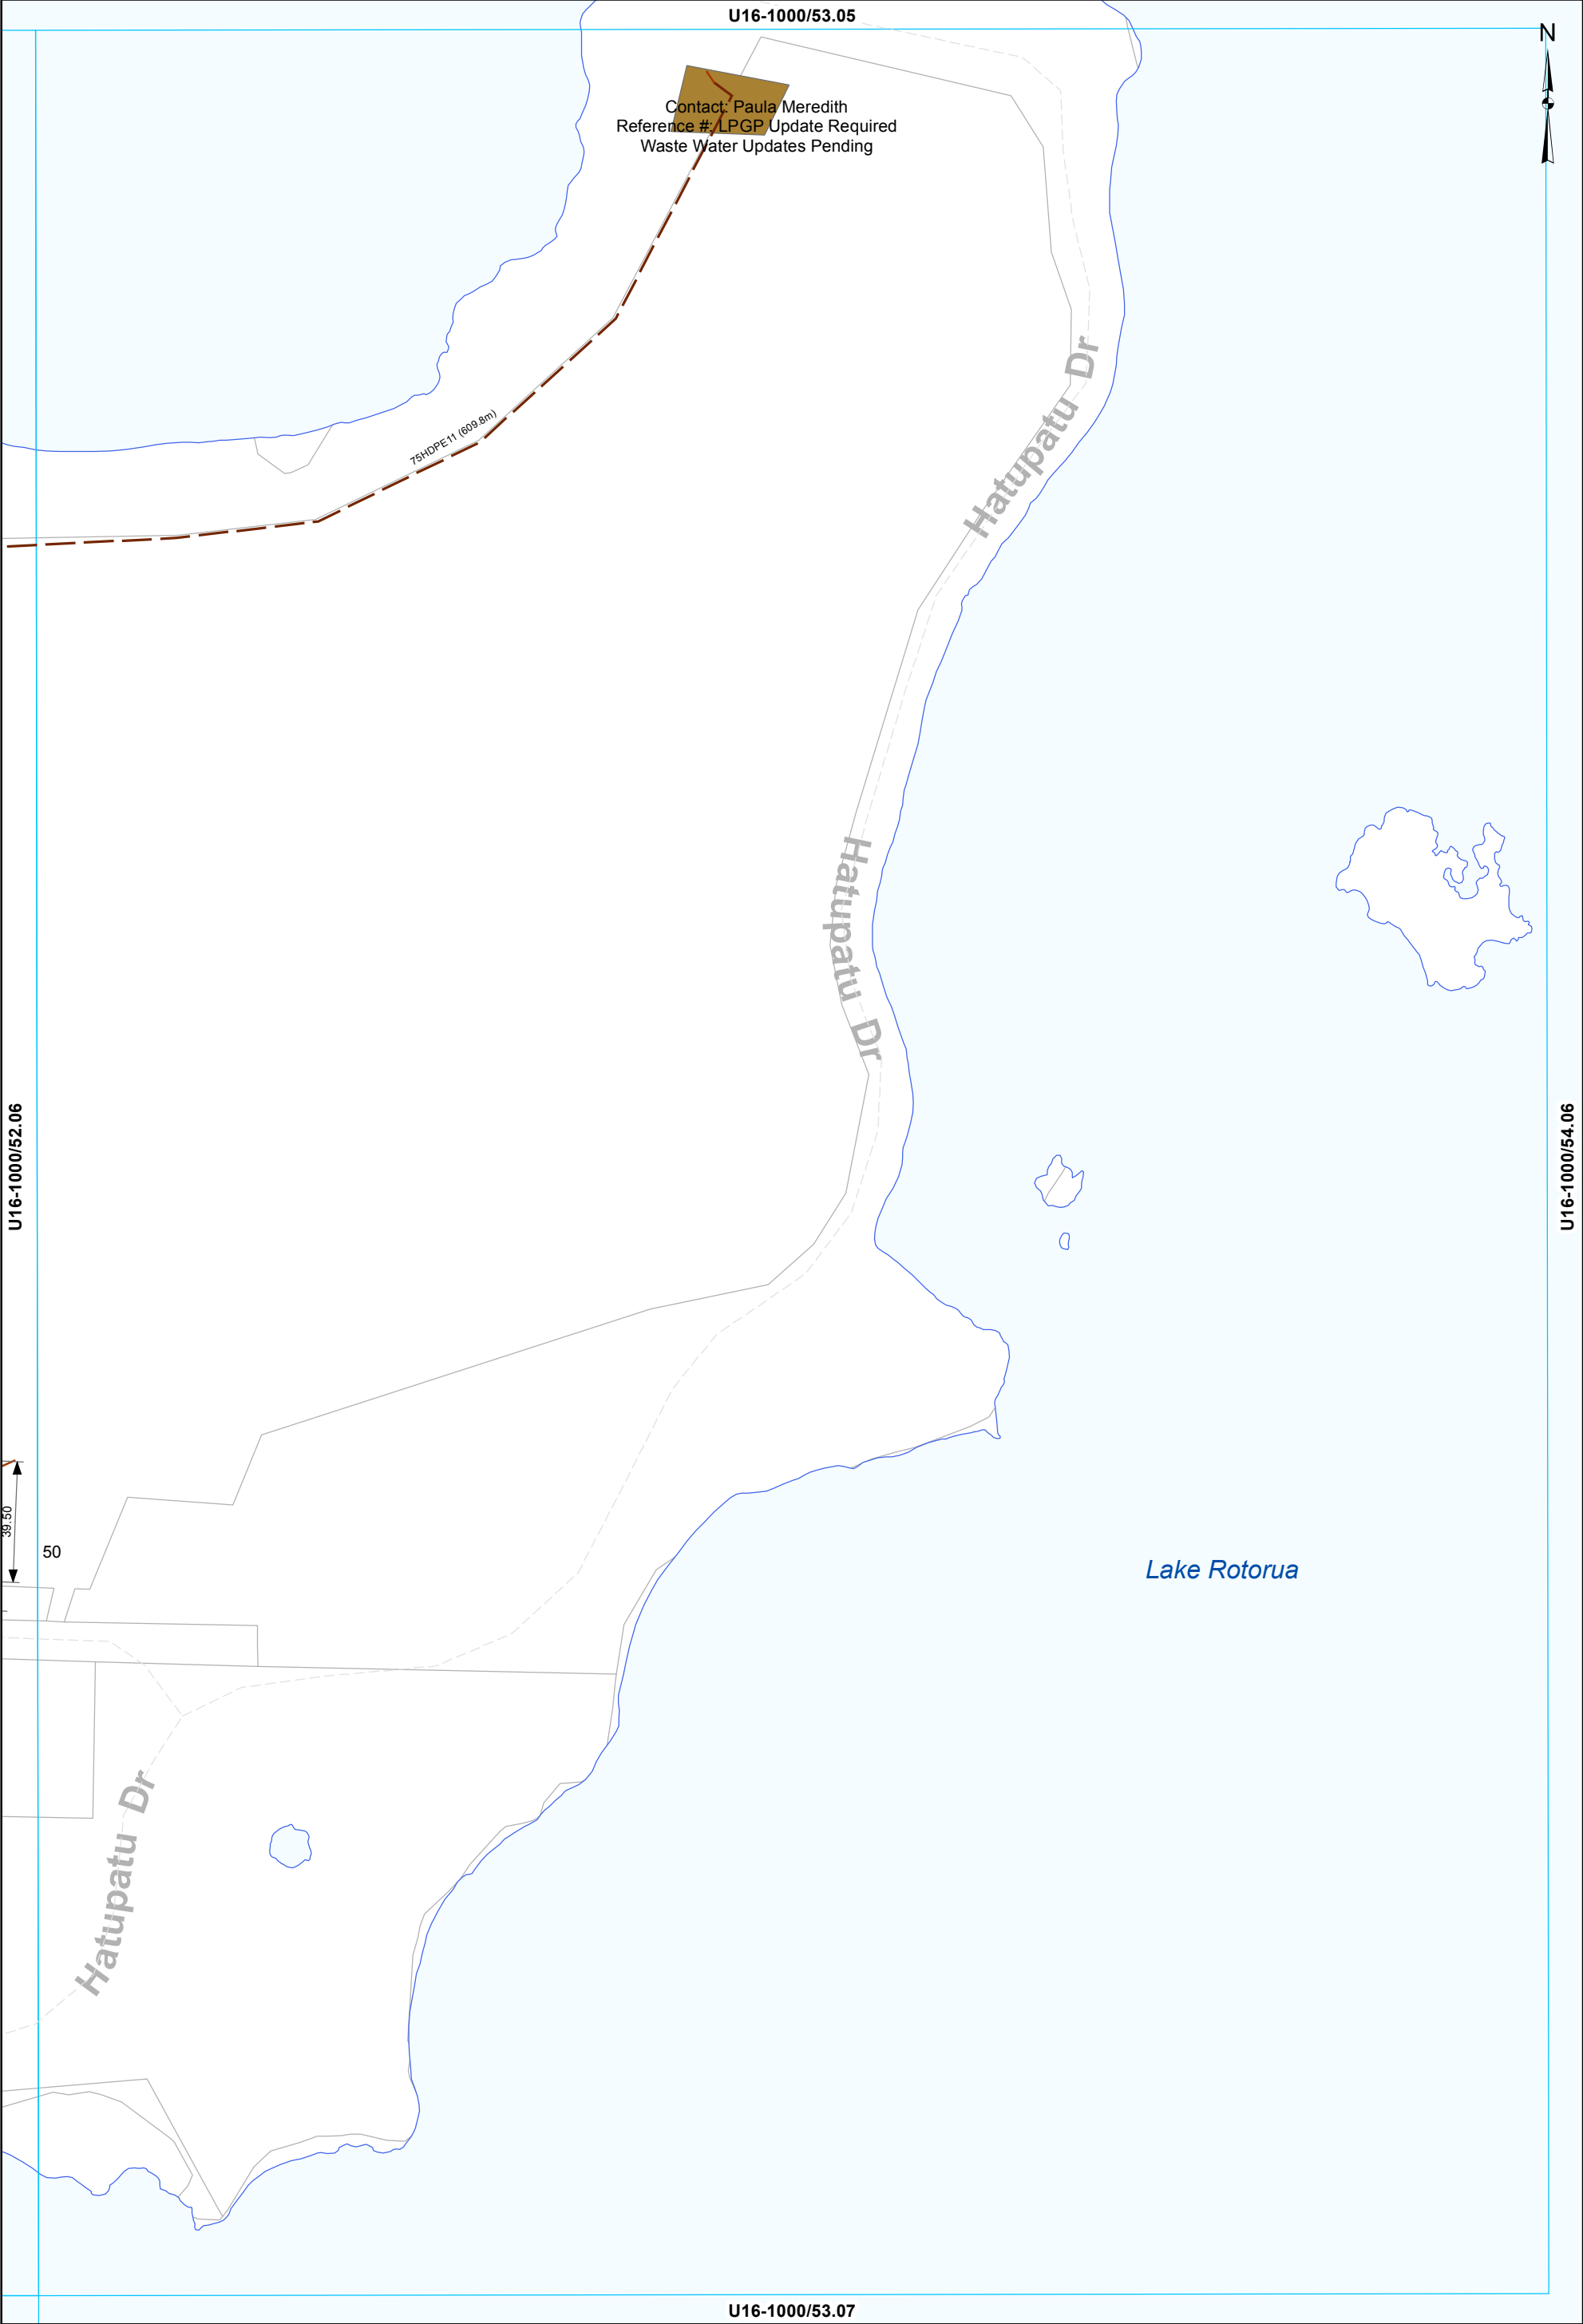

— Rising main
— Service Line

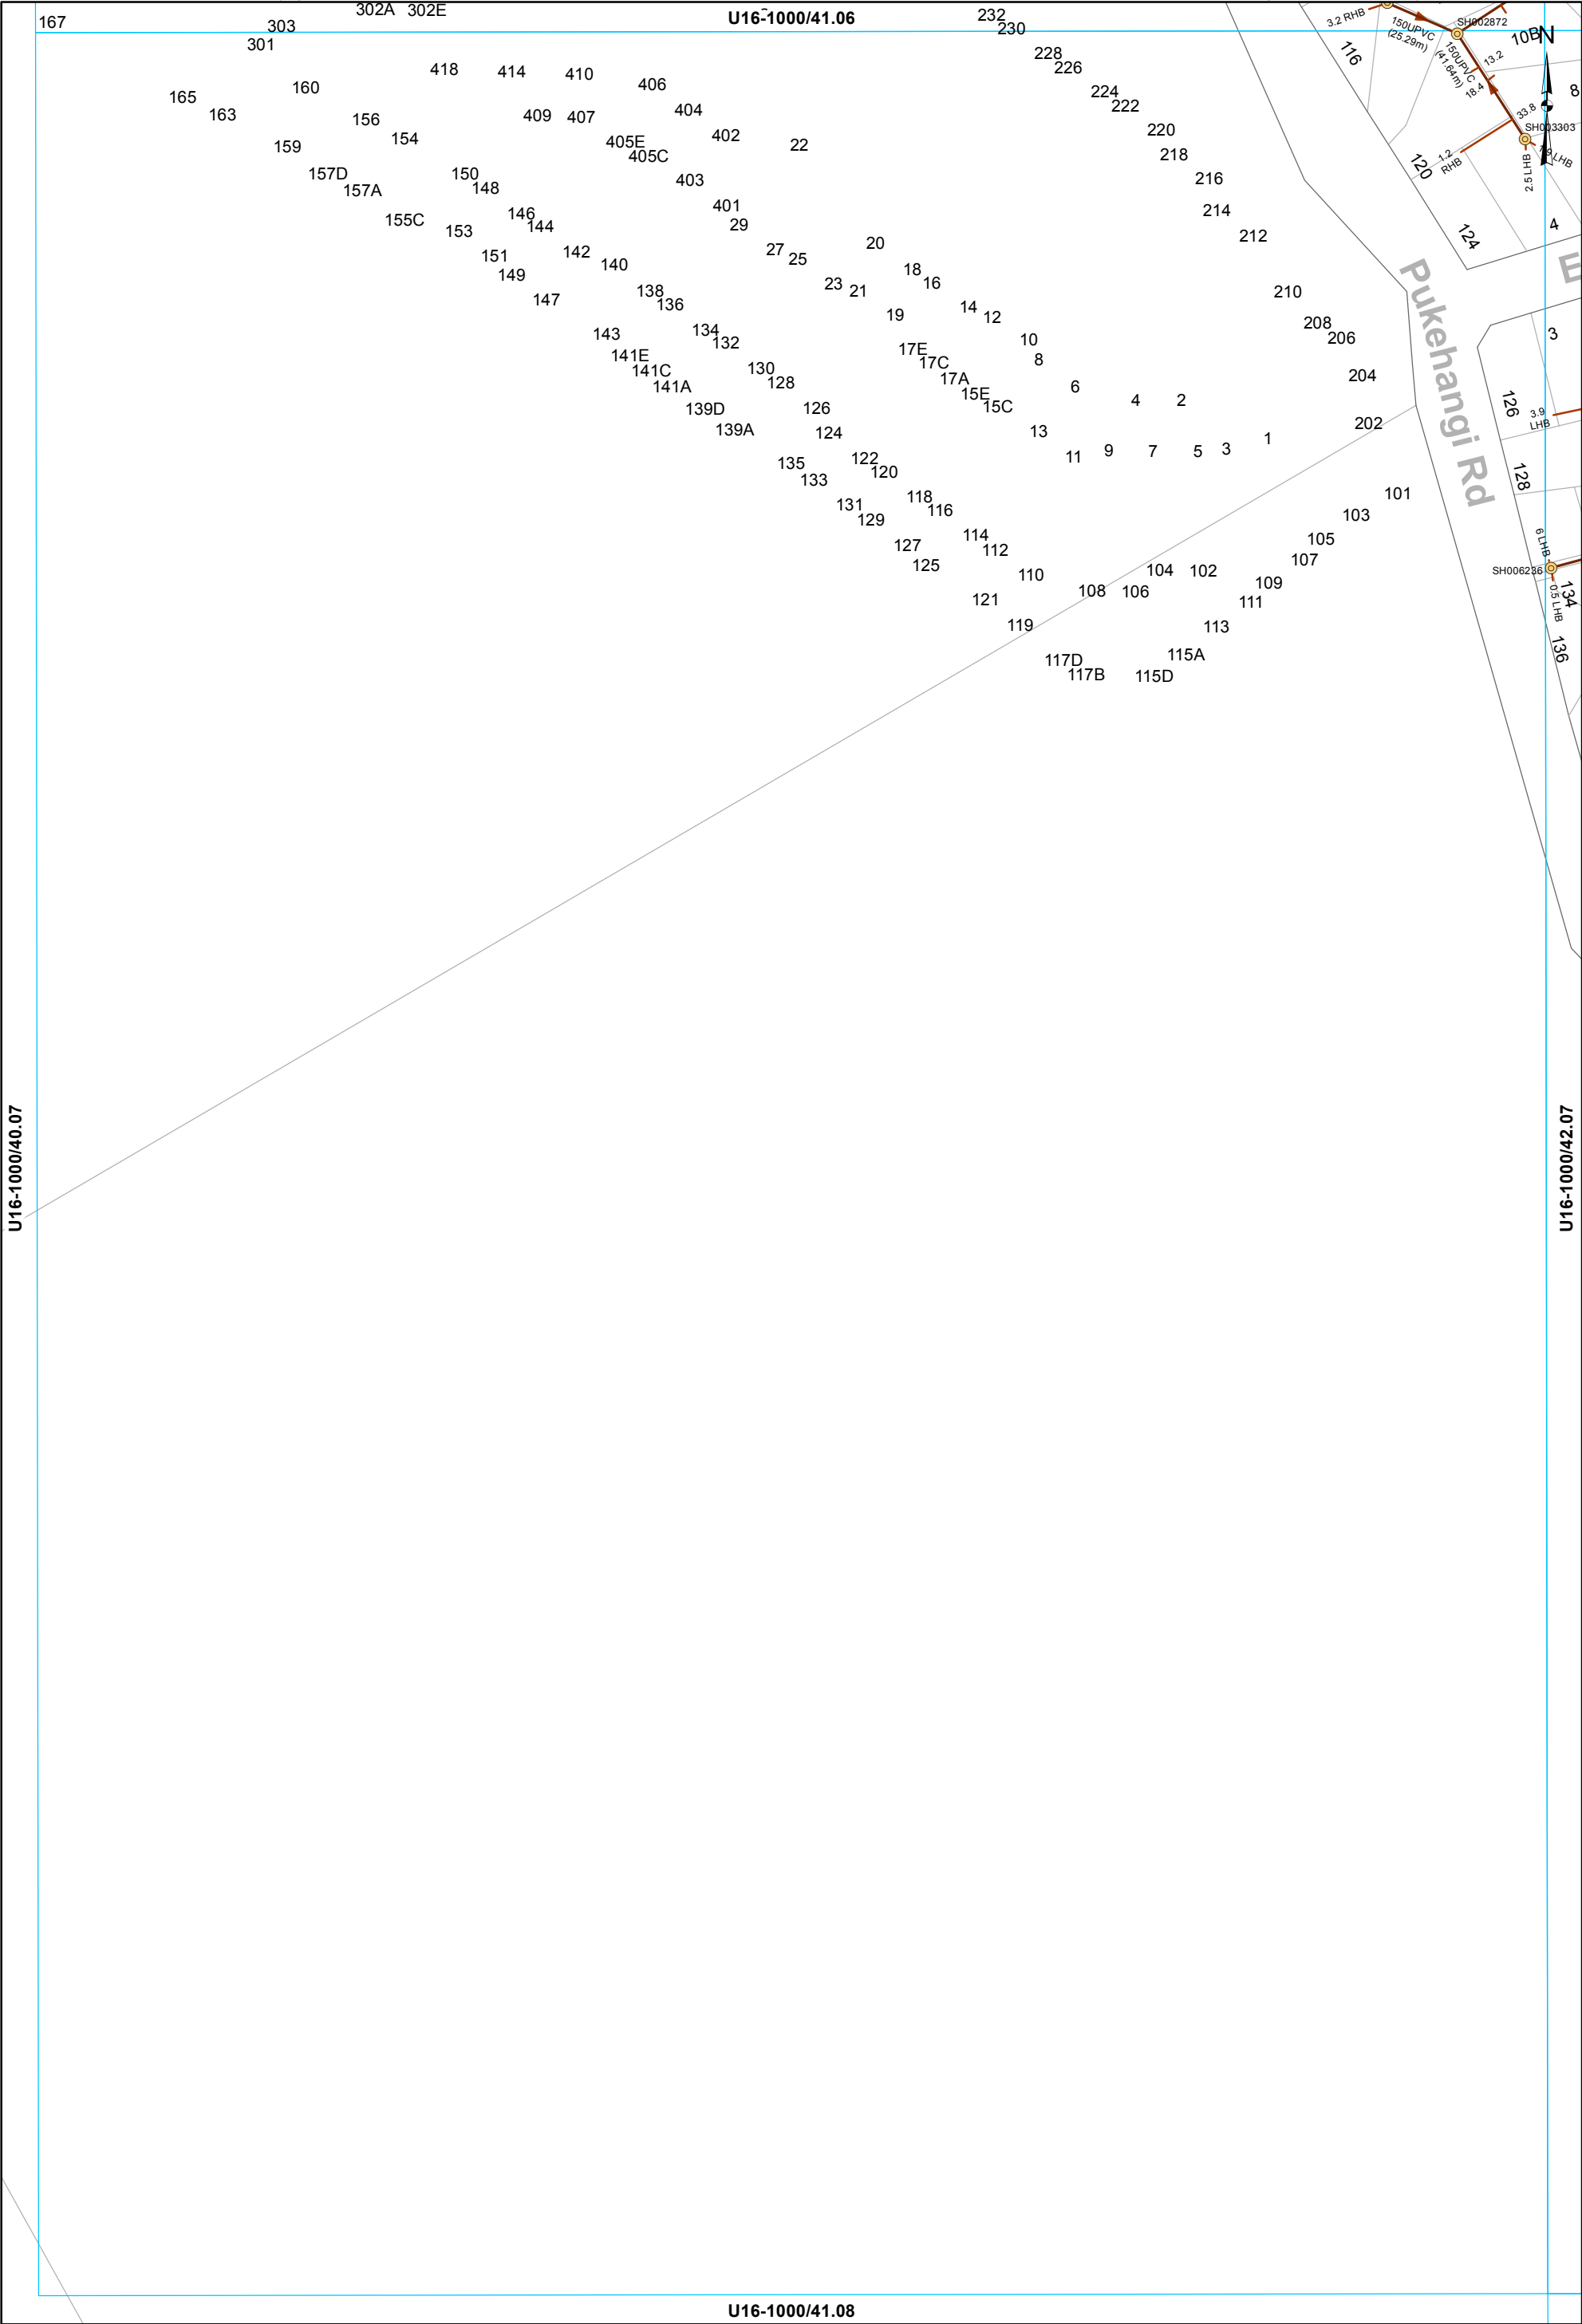

Manhole Main line Service Line

WASTEWATER SERVICES
1:2000 @ A3 - (U16-1000/41.07)

This data is derived from sources outside the control of Rotorua District Council and is for information only

Rotorua District Council 2006. Facsimile 07 346 3143 Telephone 07 348 4199 email mail@rdc.govt.nz



This data is derived from sources outside the control of Rotorua District Council and is for information only

WASTEWATER SERVICES
1:2000 @ A3 - (U16-1000/42.07)

-  Manhole
  Main line
-  End of line - Capped end
  Service Line




All dimensions and levels should be verified by physical location on-site.

This data is derived from sources outside the control of Rotorua District Council and is for information only

 Manhole
 End of line - Capped end
 Main line

 Chamber - Inspection
  Service Line


WASTEWATER SERVICES
1:2000 @ A3 - (U16-1000/43.07)

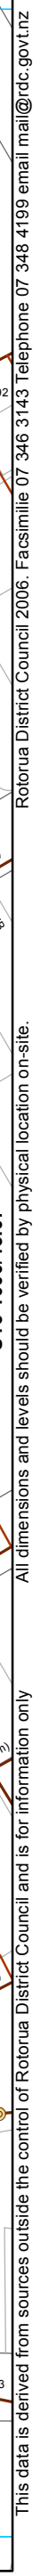

All dimensions and levels should be verified by physical location on-site.

This data is derived from sources outside the control of Rotorua District Council and is for information only

 WASTEWATER SERVICES
1:2000 @ A3 - (U16-1000/44.07)




All dimensions and levels should be verified by physical location on-site.

This data is derived from sources outside the control of Rotorua District Council and is for information only


Rotorua District Council 2006. Facsimilie 07 346 3143 Telephone 07 348 4199 email mail@rdc.govt.nz

 Manhole
 Main line
 End of line - Capped end
  Service Line

 WASTEWATER SERVICES
1:2000 @ A3 - (U16-1000/45.07)



 WASTEWATER SERVICES
1:2000 @ A3 - (U16-1000/46.07)



All dimensions and levels should be verified by physical location on-site.

This data is derived from sources outside the control of Rotunda District Council and is for information only

WASTEWATER SERVICES
1:2000 @ A3 - (U16-1000/47.07)




- Manhole
- Chamber - Inspection
- End of line - Capped end
- End of line - Cleaning eye
- Main line
- Service Line

WASTEWATER SERVICES
1:2000 @ A3 - (U16-1000/48.07)

This data is derived from sources outside the control of Rotorua District Council and is for information only

All dimensions and levels should be verified by physical location on-site.

Rotorua District Council 2006. Facsimilie 07 346 3143 Telephone 07 348 4199 email mail@rdc.govt.nz

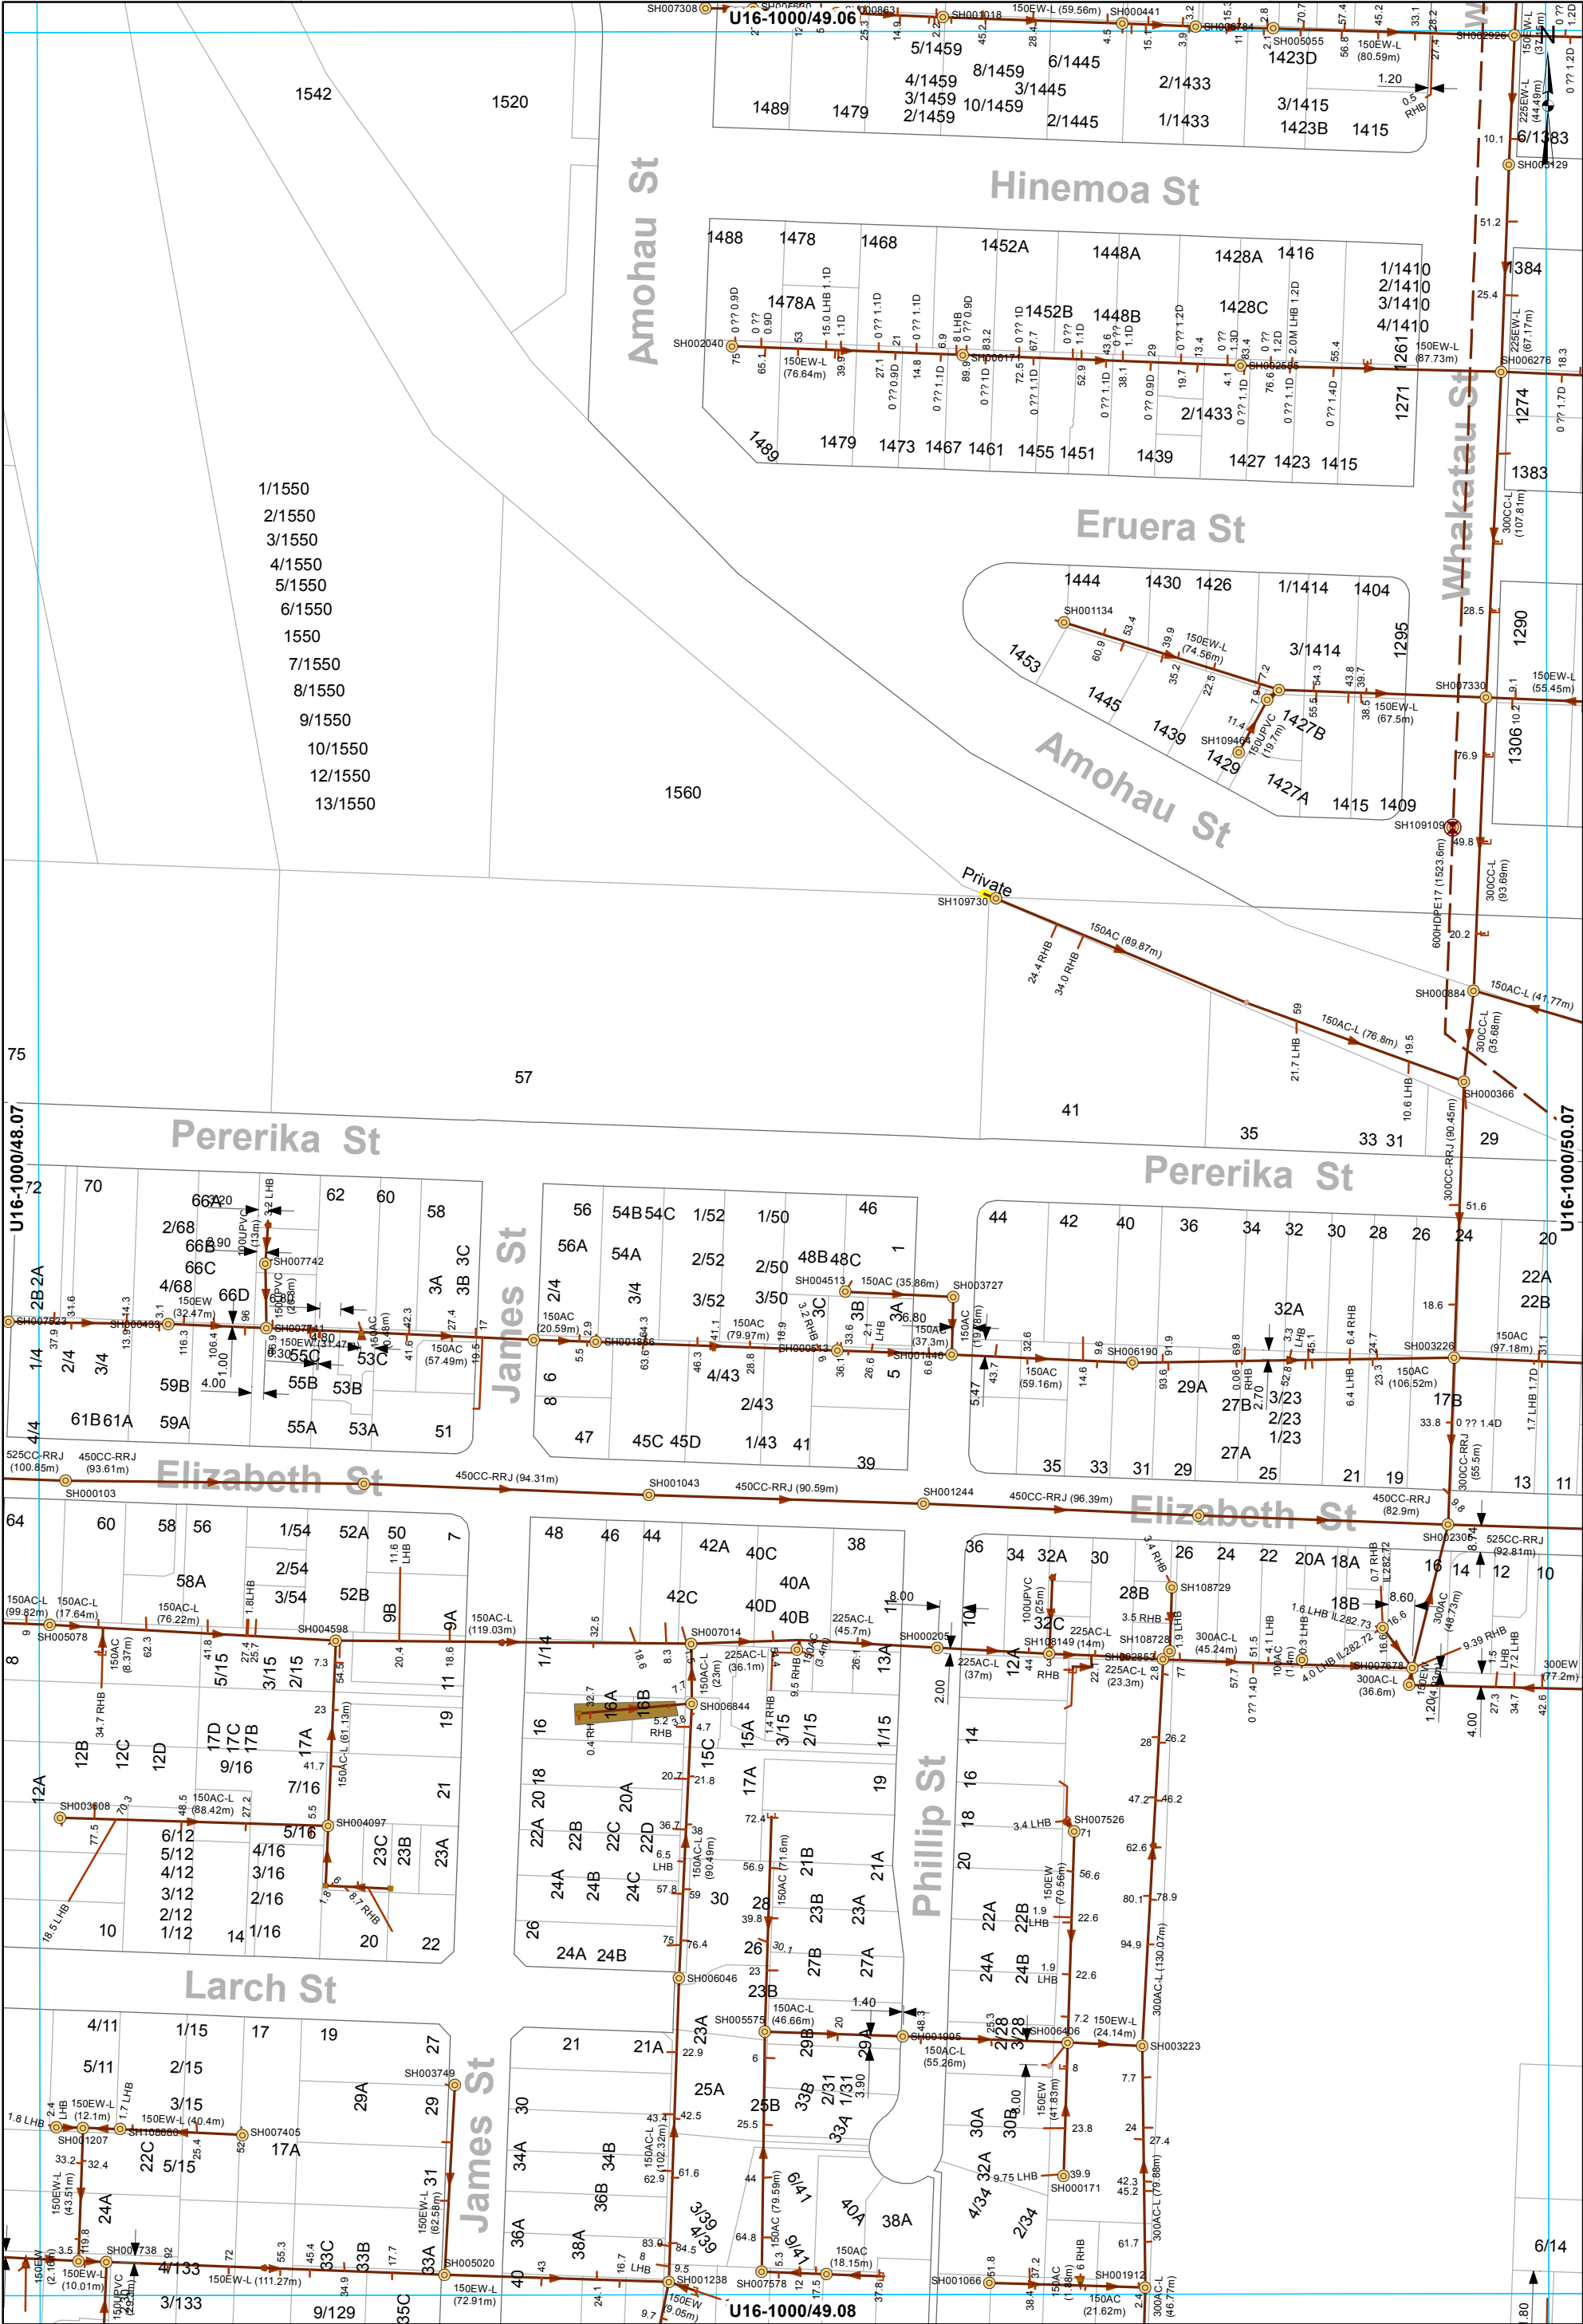


- Manhole
- Chamber - Inspection
- End of line - Capped end
- End of line - Cleaning eye
- Inspection point
- Air Valve
- Private Asset
- Main line
- Rising main
- Service Line

WASTEWATER SERVICES
1:2000 @ A3 - (U16-1000/49.07)

This data is derived from sources outside the control of Rotorua District Council and is for information only

All dimensions and levels should be verified by physical location on-site.

 Rotorua District Council 2006. Facsimile 07 346 3143 Telephone 07 348 4199 email mail@rdc.govt.nz



All dimensions and levels should be verified by physical location on-site.

This data is derived from sources outside the control of Rotorua District Council and is for information only

-  Manhole
  End of line - Cleaning eye
  Main line
-  Pump Station
 Inline cleaning eye
  Rising main
-  Chamber - Inspection
  Inspection point
  Service Line
-  End of line - Capped end

WASTEWATER SERVICES
1:2000 @ A3 - (U16-1000/50.07)




- | | | |
|----------------------------|------------------------------|----------------|
| ● Manhole | ● End of line - Cleaning eye | → Main line |
| ■ Chamber - Inspection | ● Inspection point | → Rising main |
| □ End of line - Capped end | | → Service Line |

WASTEWATER SERVICES
1:2000 @ A3 - (U16-1000/51.07)

This data is derived from sources outside the control of Rotorua District Council and is for information only

All dimensions and levels should be verified by physical location on-site.

Rotorua District Council 2006. Facsimile 07 346 3143 Telephone 07 348 4199 email mail@rdc.govt.nz

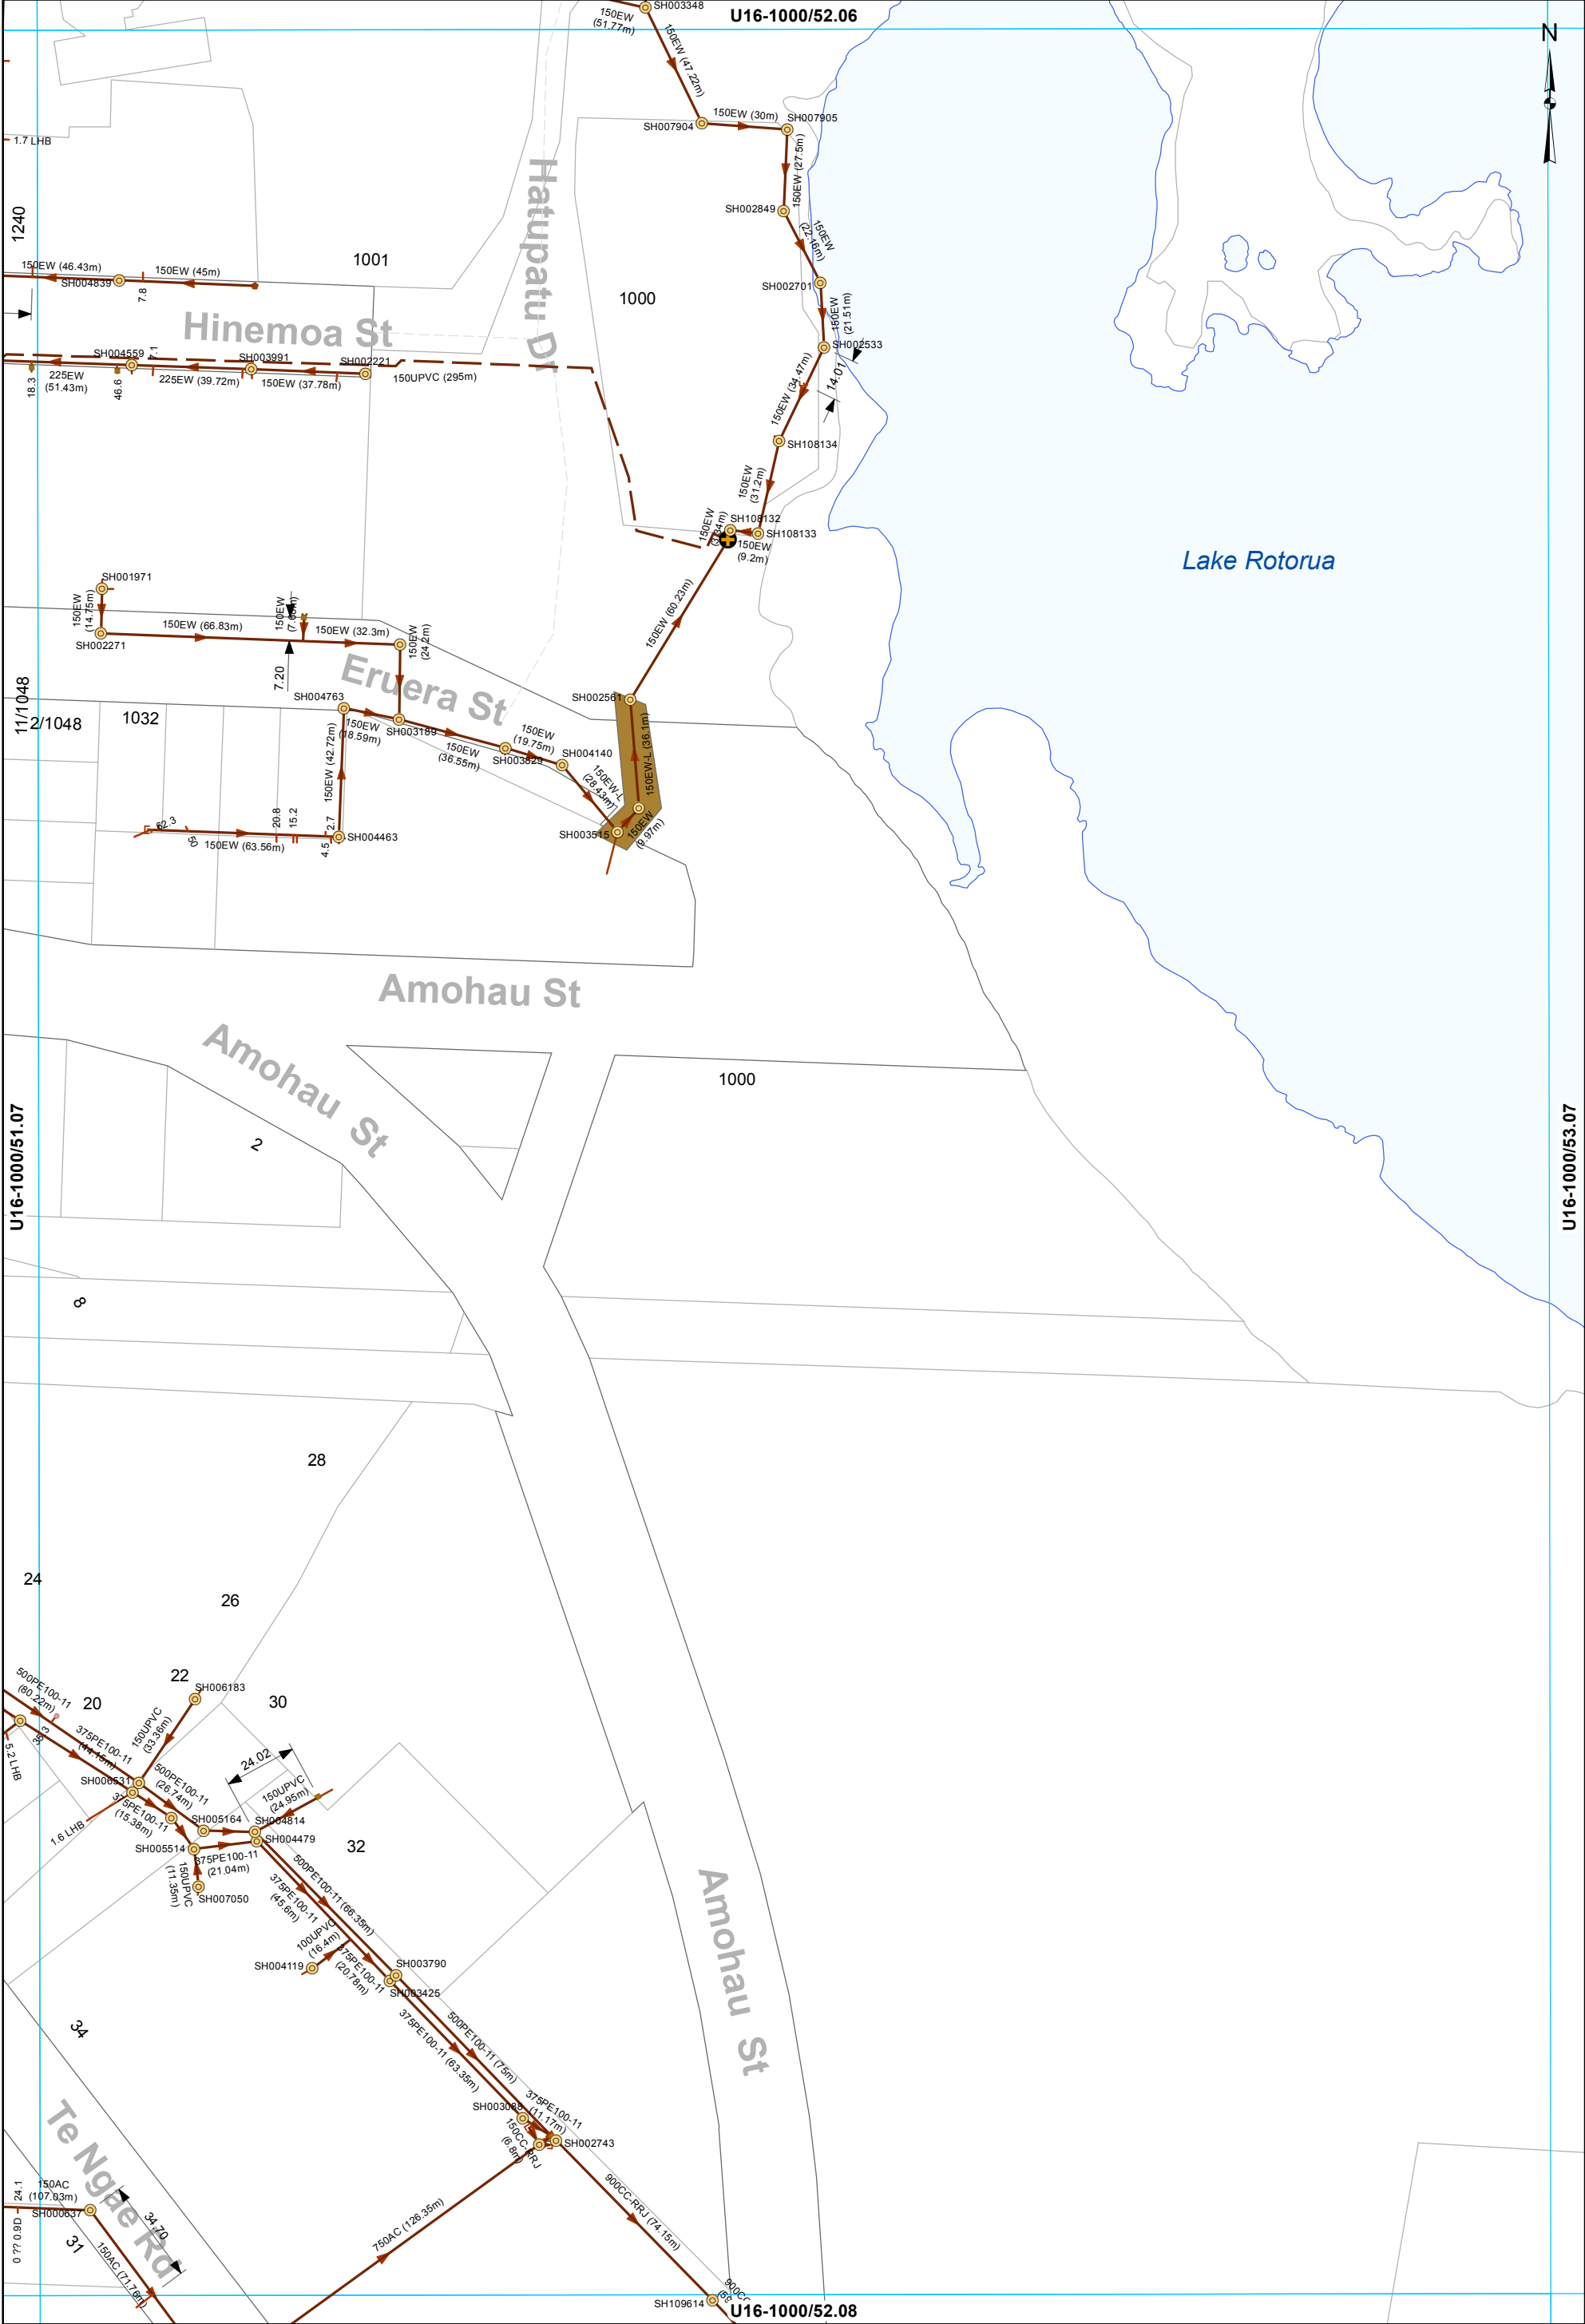

- | | | |
|------------------------|------------------------------|-------------------|
| ● Manhole | □ End of line - Capped end | → Main line |
| ⊕ Pump Station | ● End of line - Cleaning eye | - - - Rising main |
| ■ Chamber - Inspection | ● Inspection point | — Service Line |

WASTEWATER SERVICES
1:2000 @ A3 - (U16-1000/52.07)

This data is derived from sources outside the control of Rotorua District Council and is for information only

U16-1000/53.07

All dimensions and levels should be verified by physical location on-site.


Rotorua District Council 2006. Facsimilie 07 346 3143 Telephone 07 348 4199 email mail@rdc.govt.nz

Rotorua District Council 2006. Facsimile 07 346 3143 Telephone 07 348 4199 email mail@rdc.govt.nz



This data is derived from sources outside the control of Rotorua District Council and is for information only

WASTEWATER SERVICES
1:2000 @ A3 - (U16-1000/42.08)

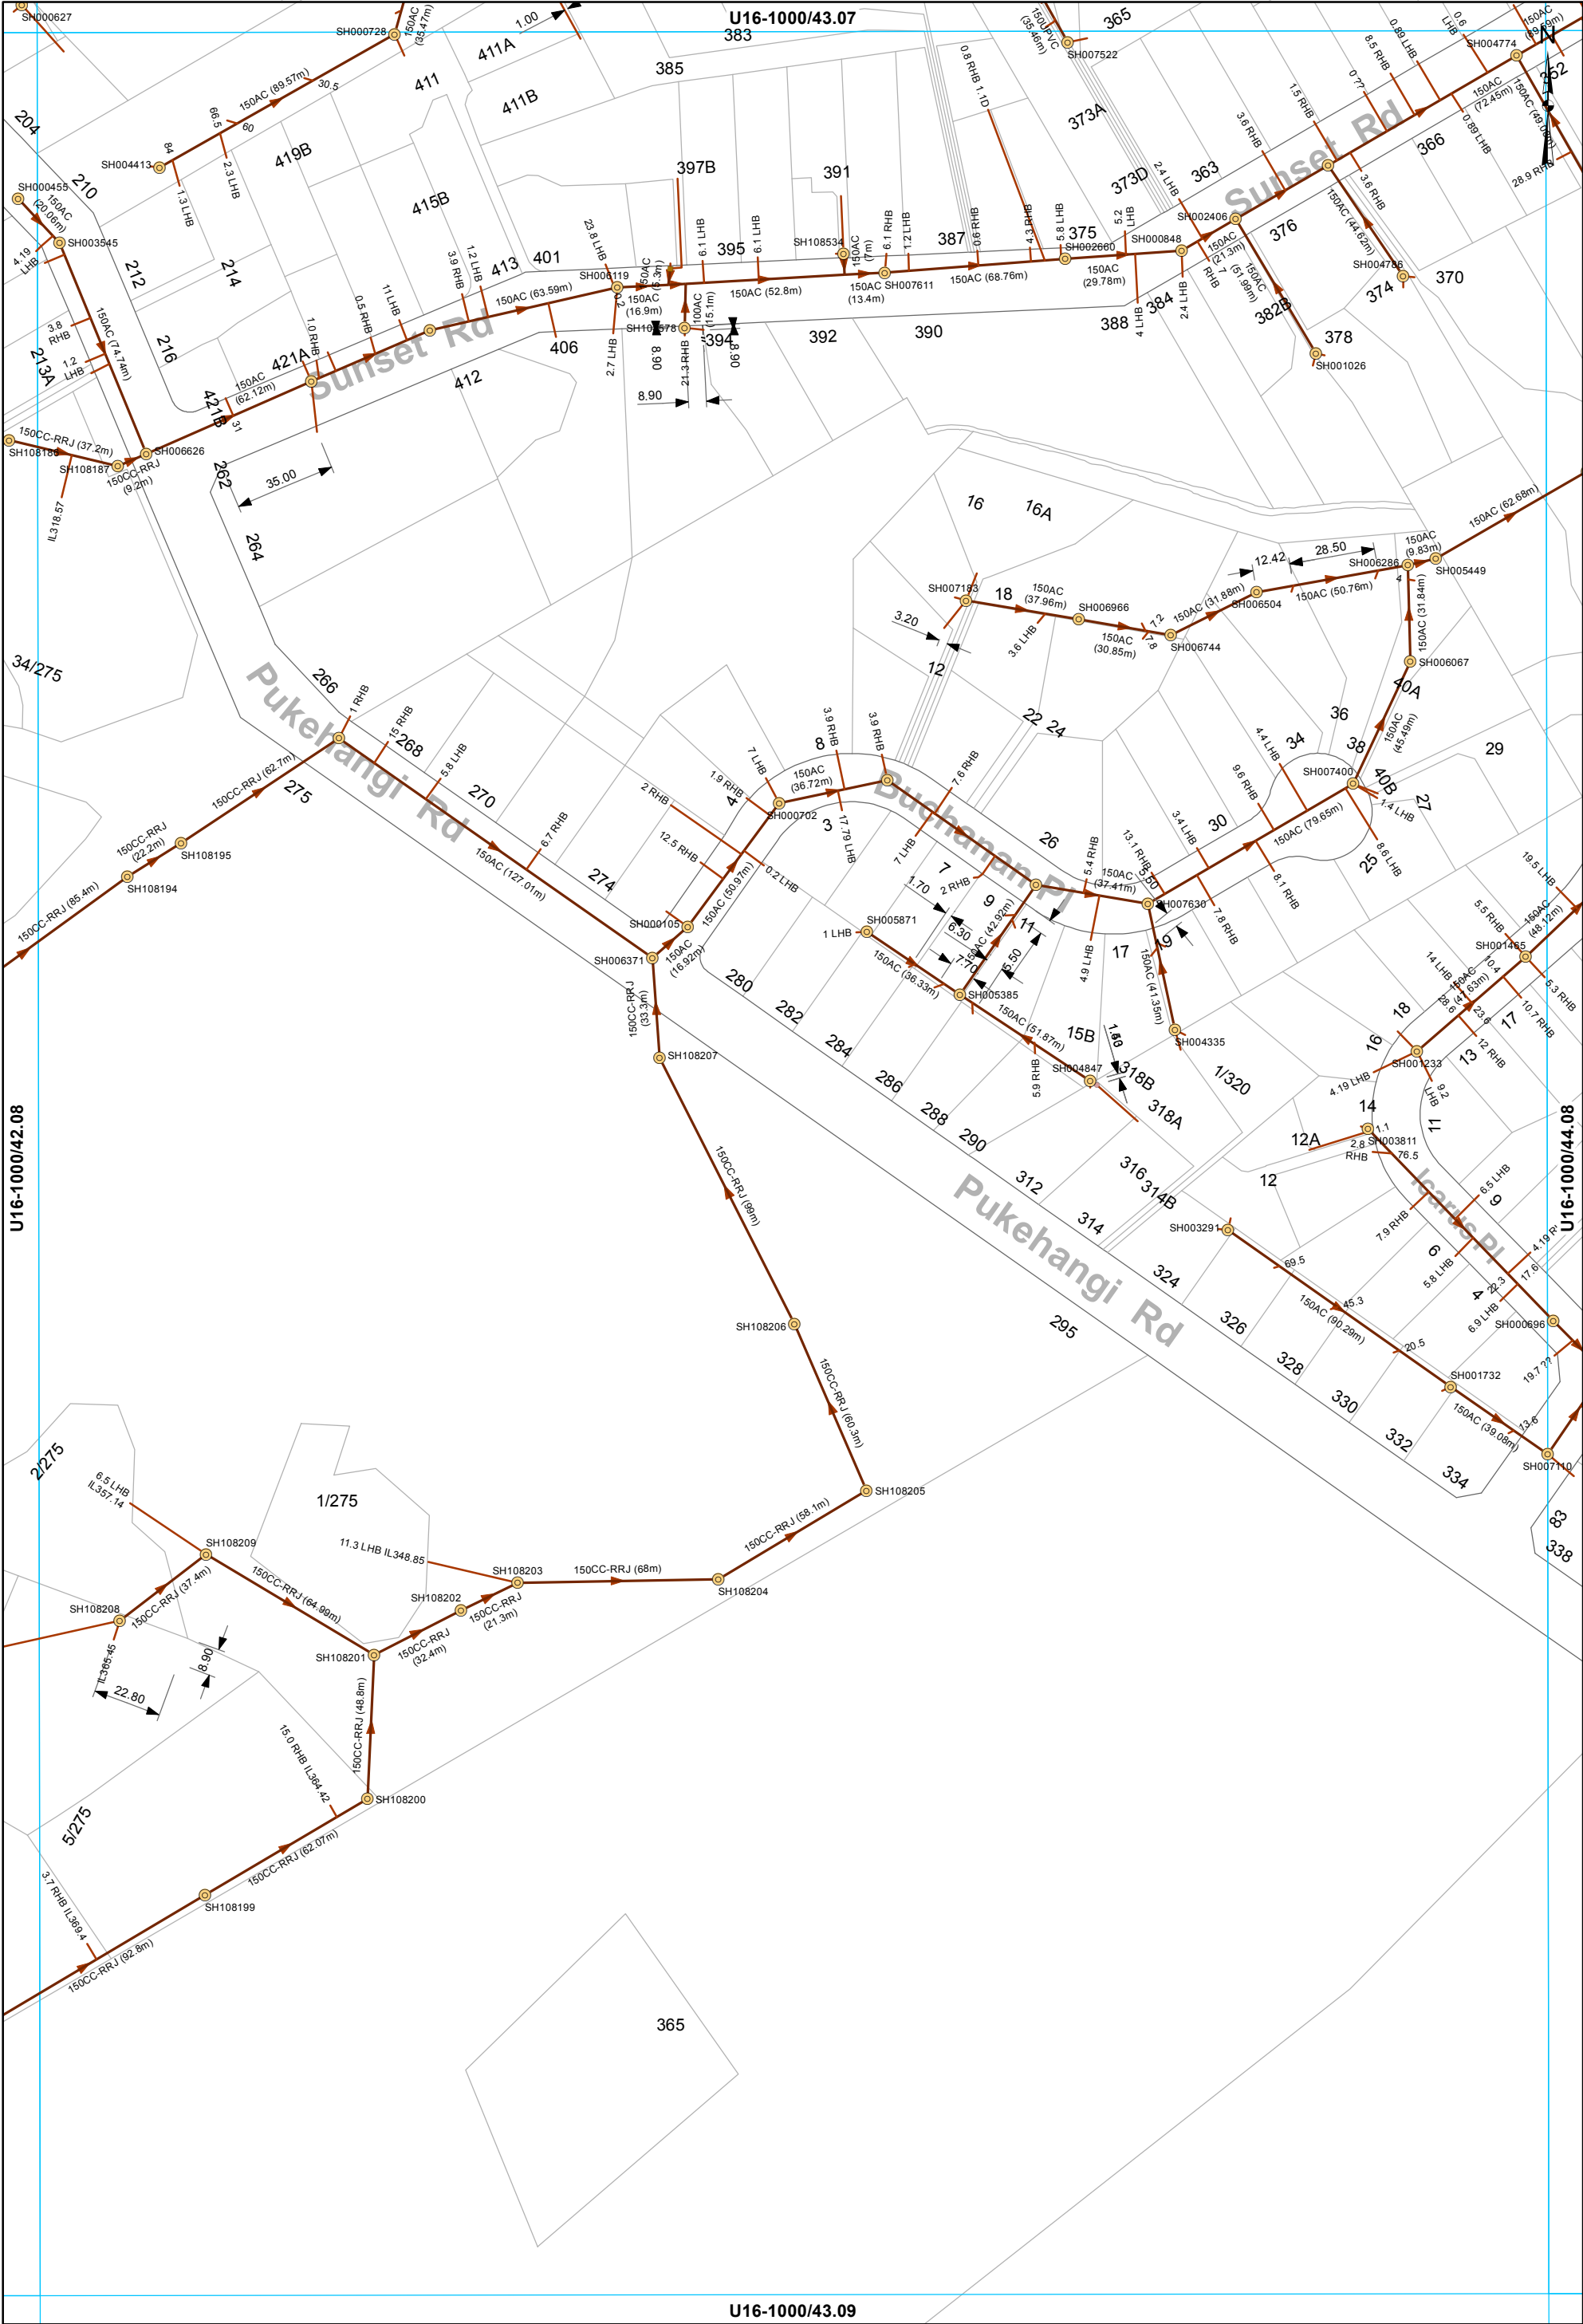


- Manhole
- Chamber - Inspection
- Inspection point
- Main line
- Service Line

WASTEWATER SERVICES
1:2000 @ A3 - (U16-1000/43.08)

This data is derived from sources outside the control of Rotorua District Council and is for information only

All dimensions and levels should be verified by physical location on-site.

Rotorua District Council 2006. Facsimile 07 346 3143 Telephone 07 348 4199 email mail@rdc.govt.nz

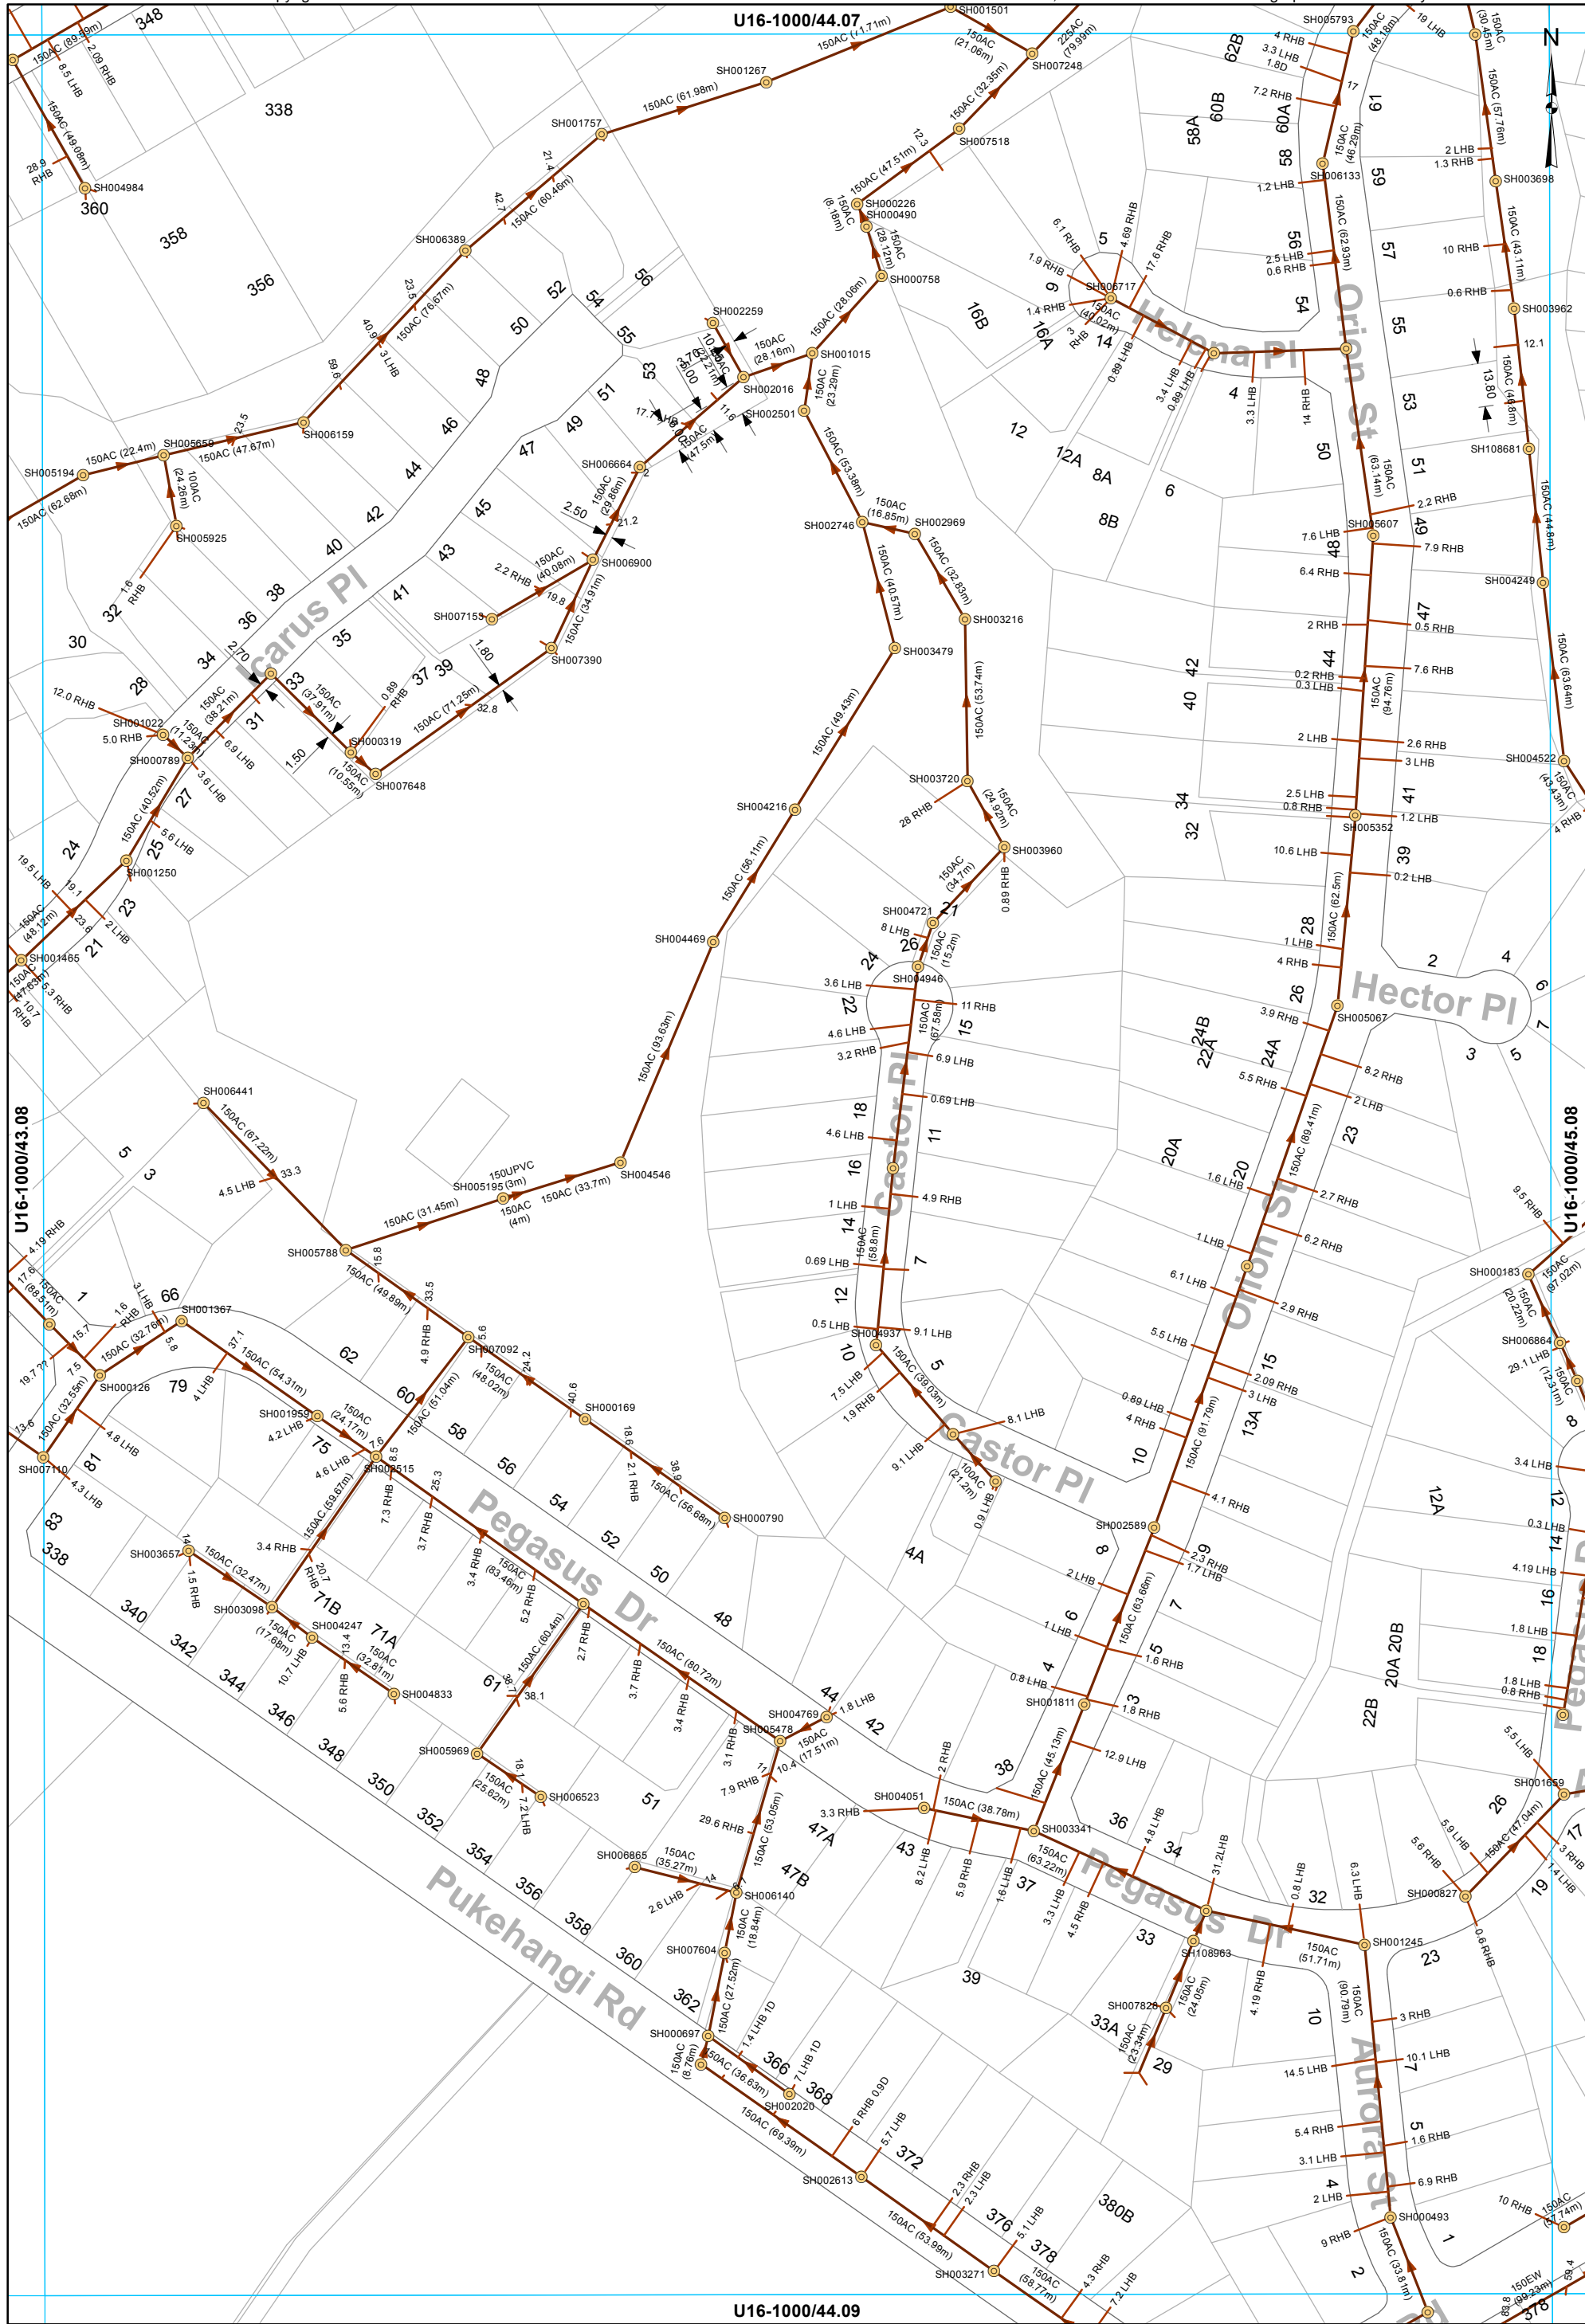


Manhole Main line Service Line

WASTEWATER SERVICES
1:2000 @ A3 - (U16-1000/44.08)


This data is derived from sources outside the control of Rotorua District Council and is for information only

All dimensions and levels should be verified by physical location on-site.

Rotorua District Council 2006. Facsimile 07 346 3143 Telephone 07 348 4199 email mail@rdc.govt.nz

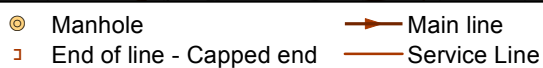

This data is derived from sources outside the control of Rotunda District Council and is for information only

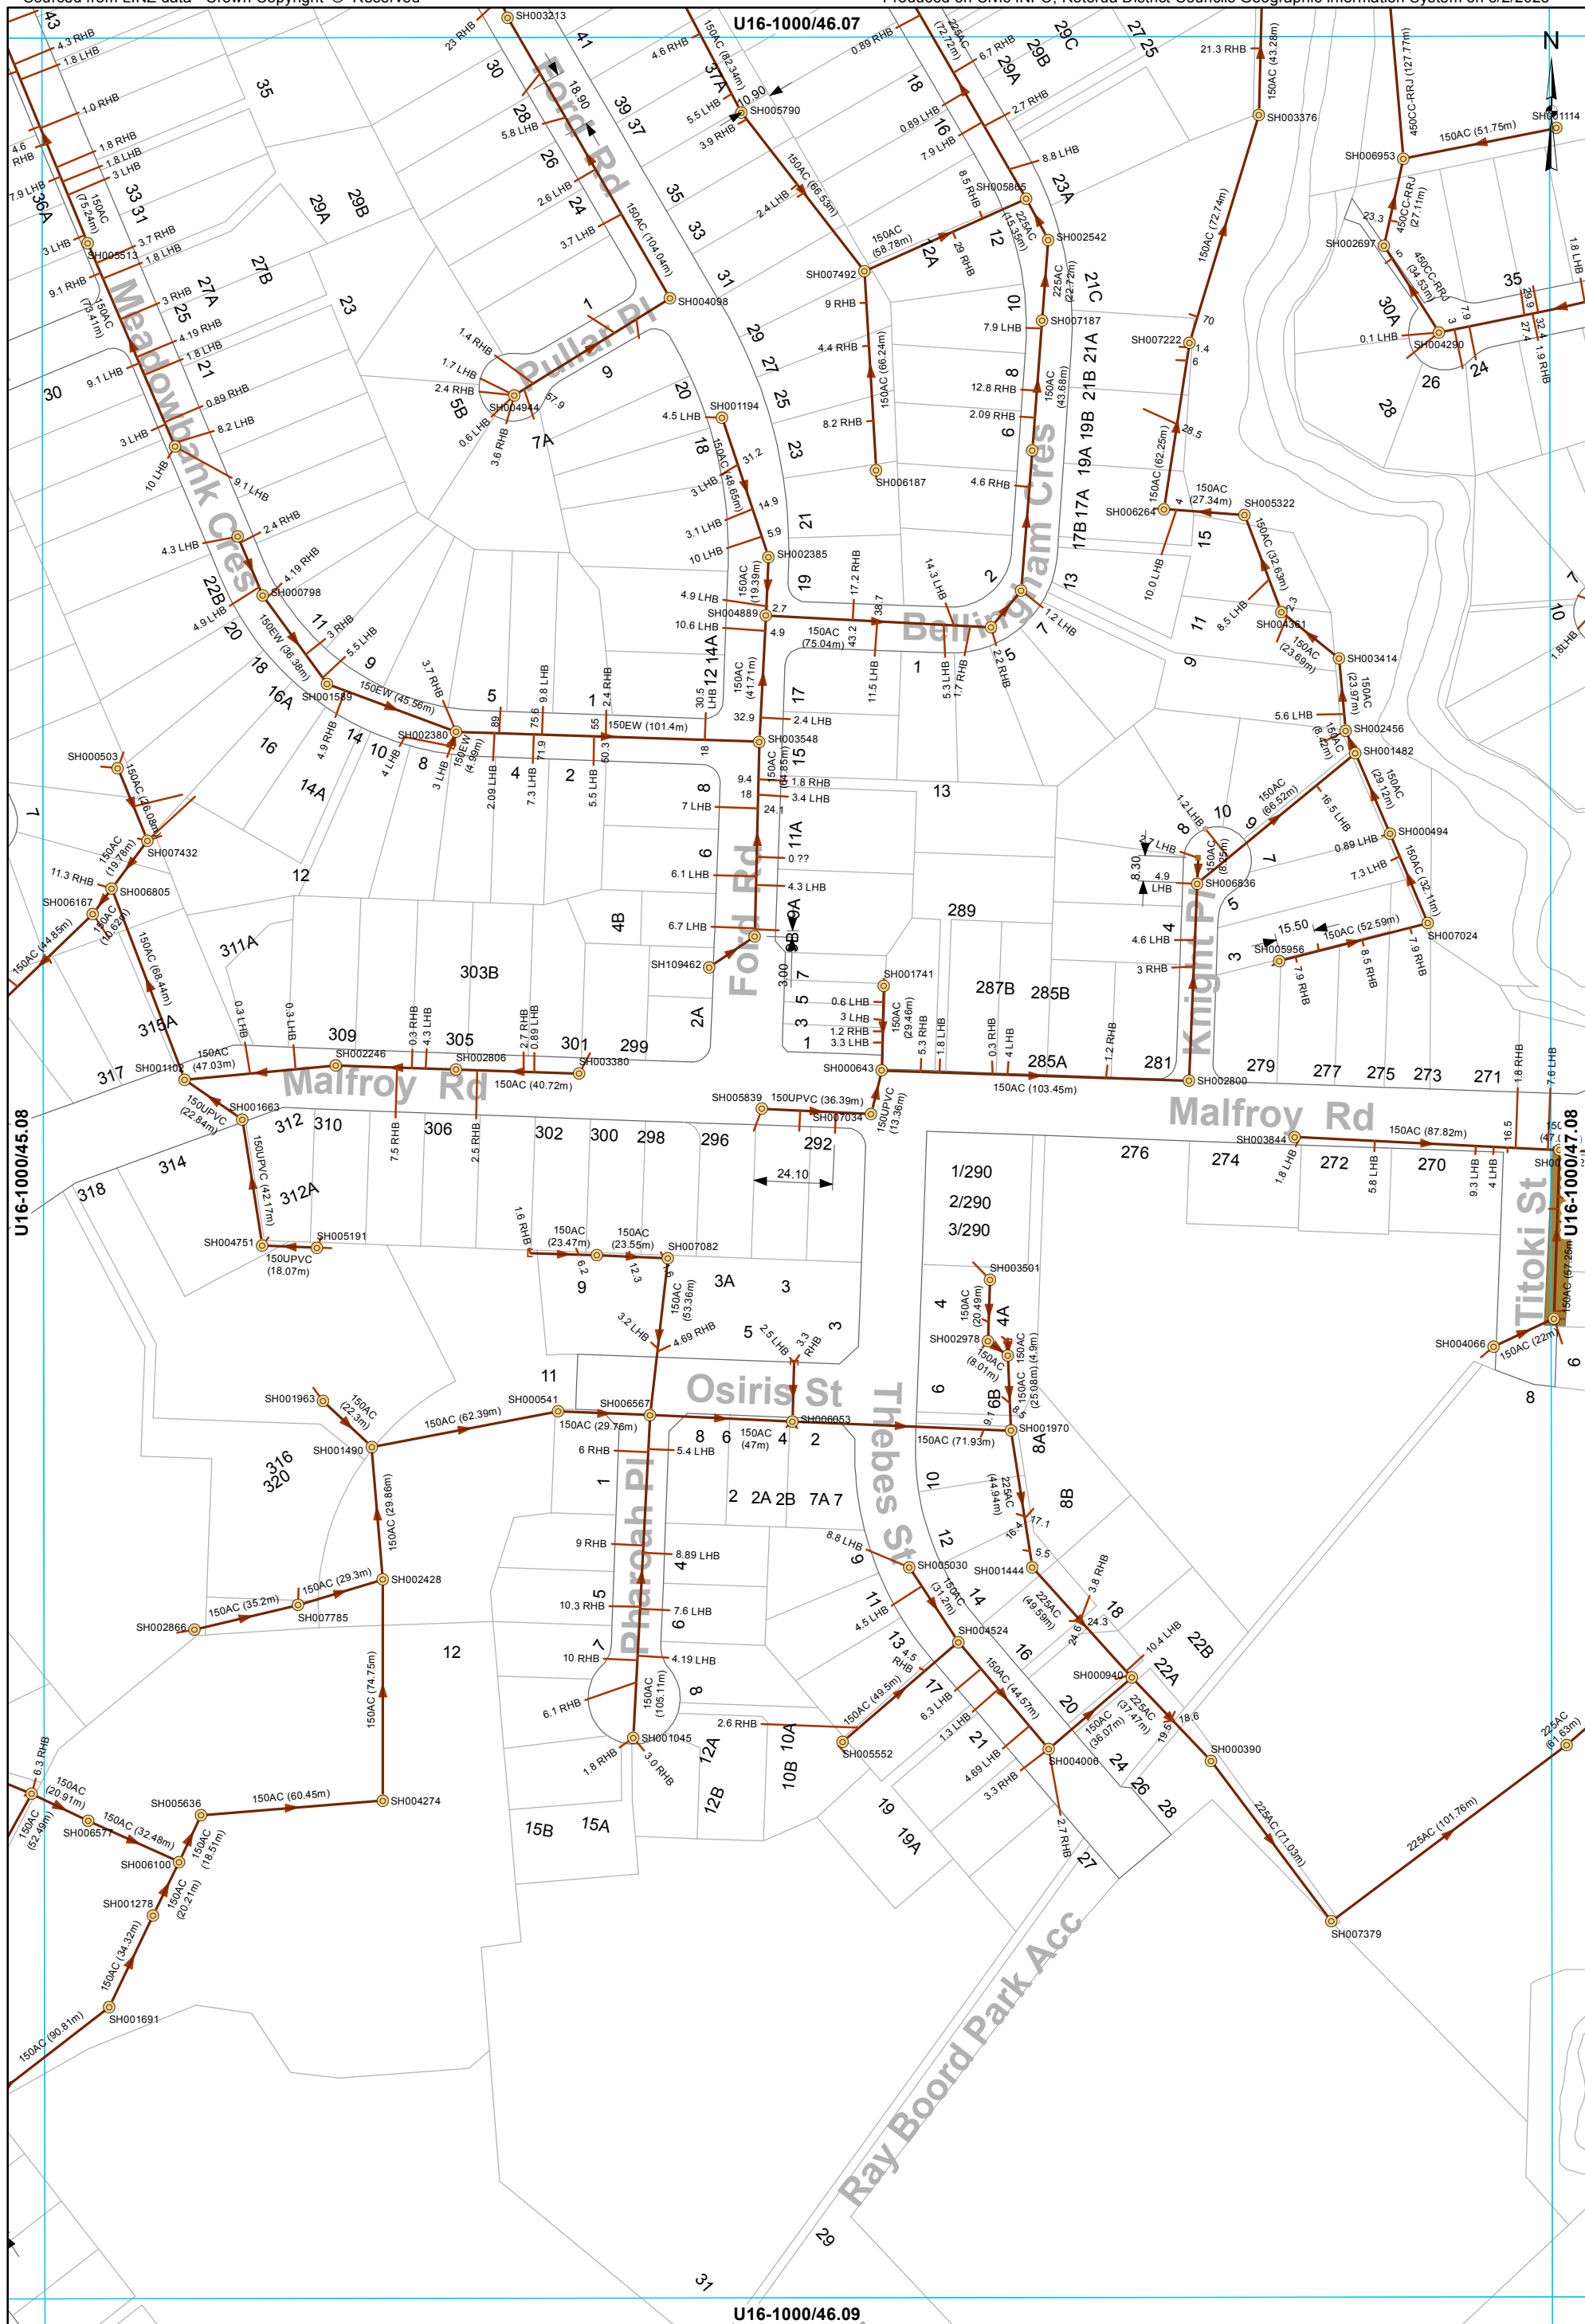

- Manhole
- Chamber - Inspection
- End of line - Capped end
- Inspection point
- Main line
- Service Line

WASTEWATER SERVICES
1:2000 @ A3 - (U16-1000/46.08)

This data is derived from sources outside the control of Rotorua District Council and is for information only

All dimensions and levels should be verified by physical location on-site.

Rotorua District Council 2006. Facsimile 07 346 3143 Telephone 07 348 4199 email mail@rdc.govt.nz




- Inspection point  Main line
- - Rising main
- Service Line

WASTEWATER SERVICES
1:2000 @ A3 - (U16-1000/47.08)



- Manhole
- Chamber - Inspection
- End of line - Capped end
- End of line - Cleaning eye
- Main line
- Service Line

WASTEWATER SERVICES
1:2000 @ A3 - (U16-1000/48.08)

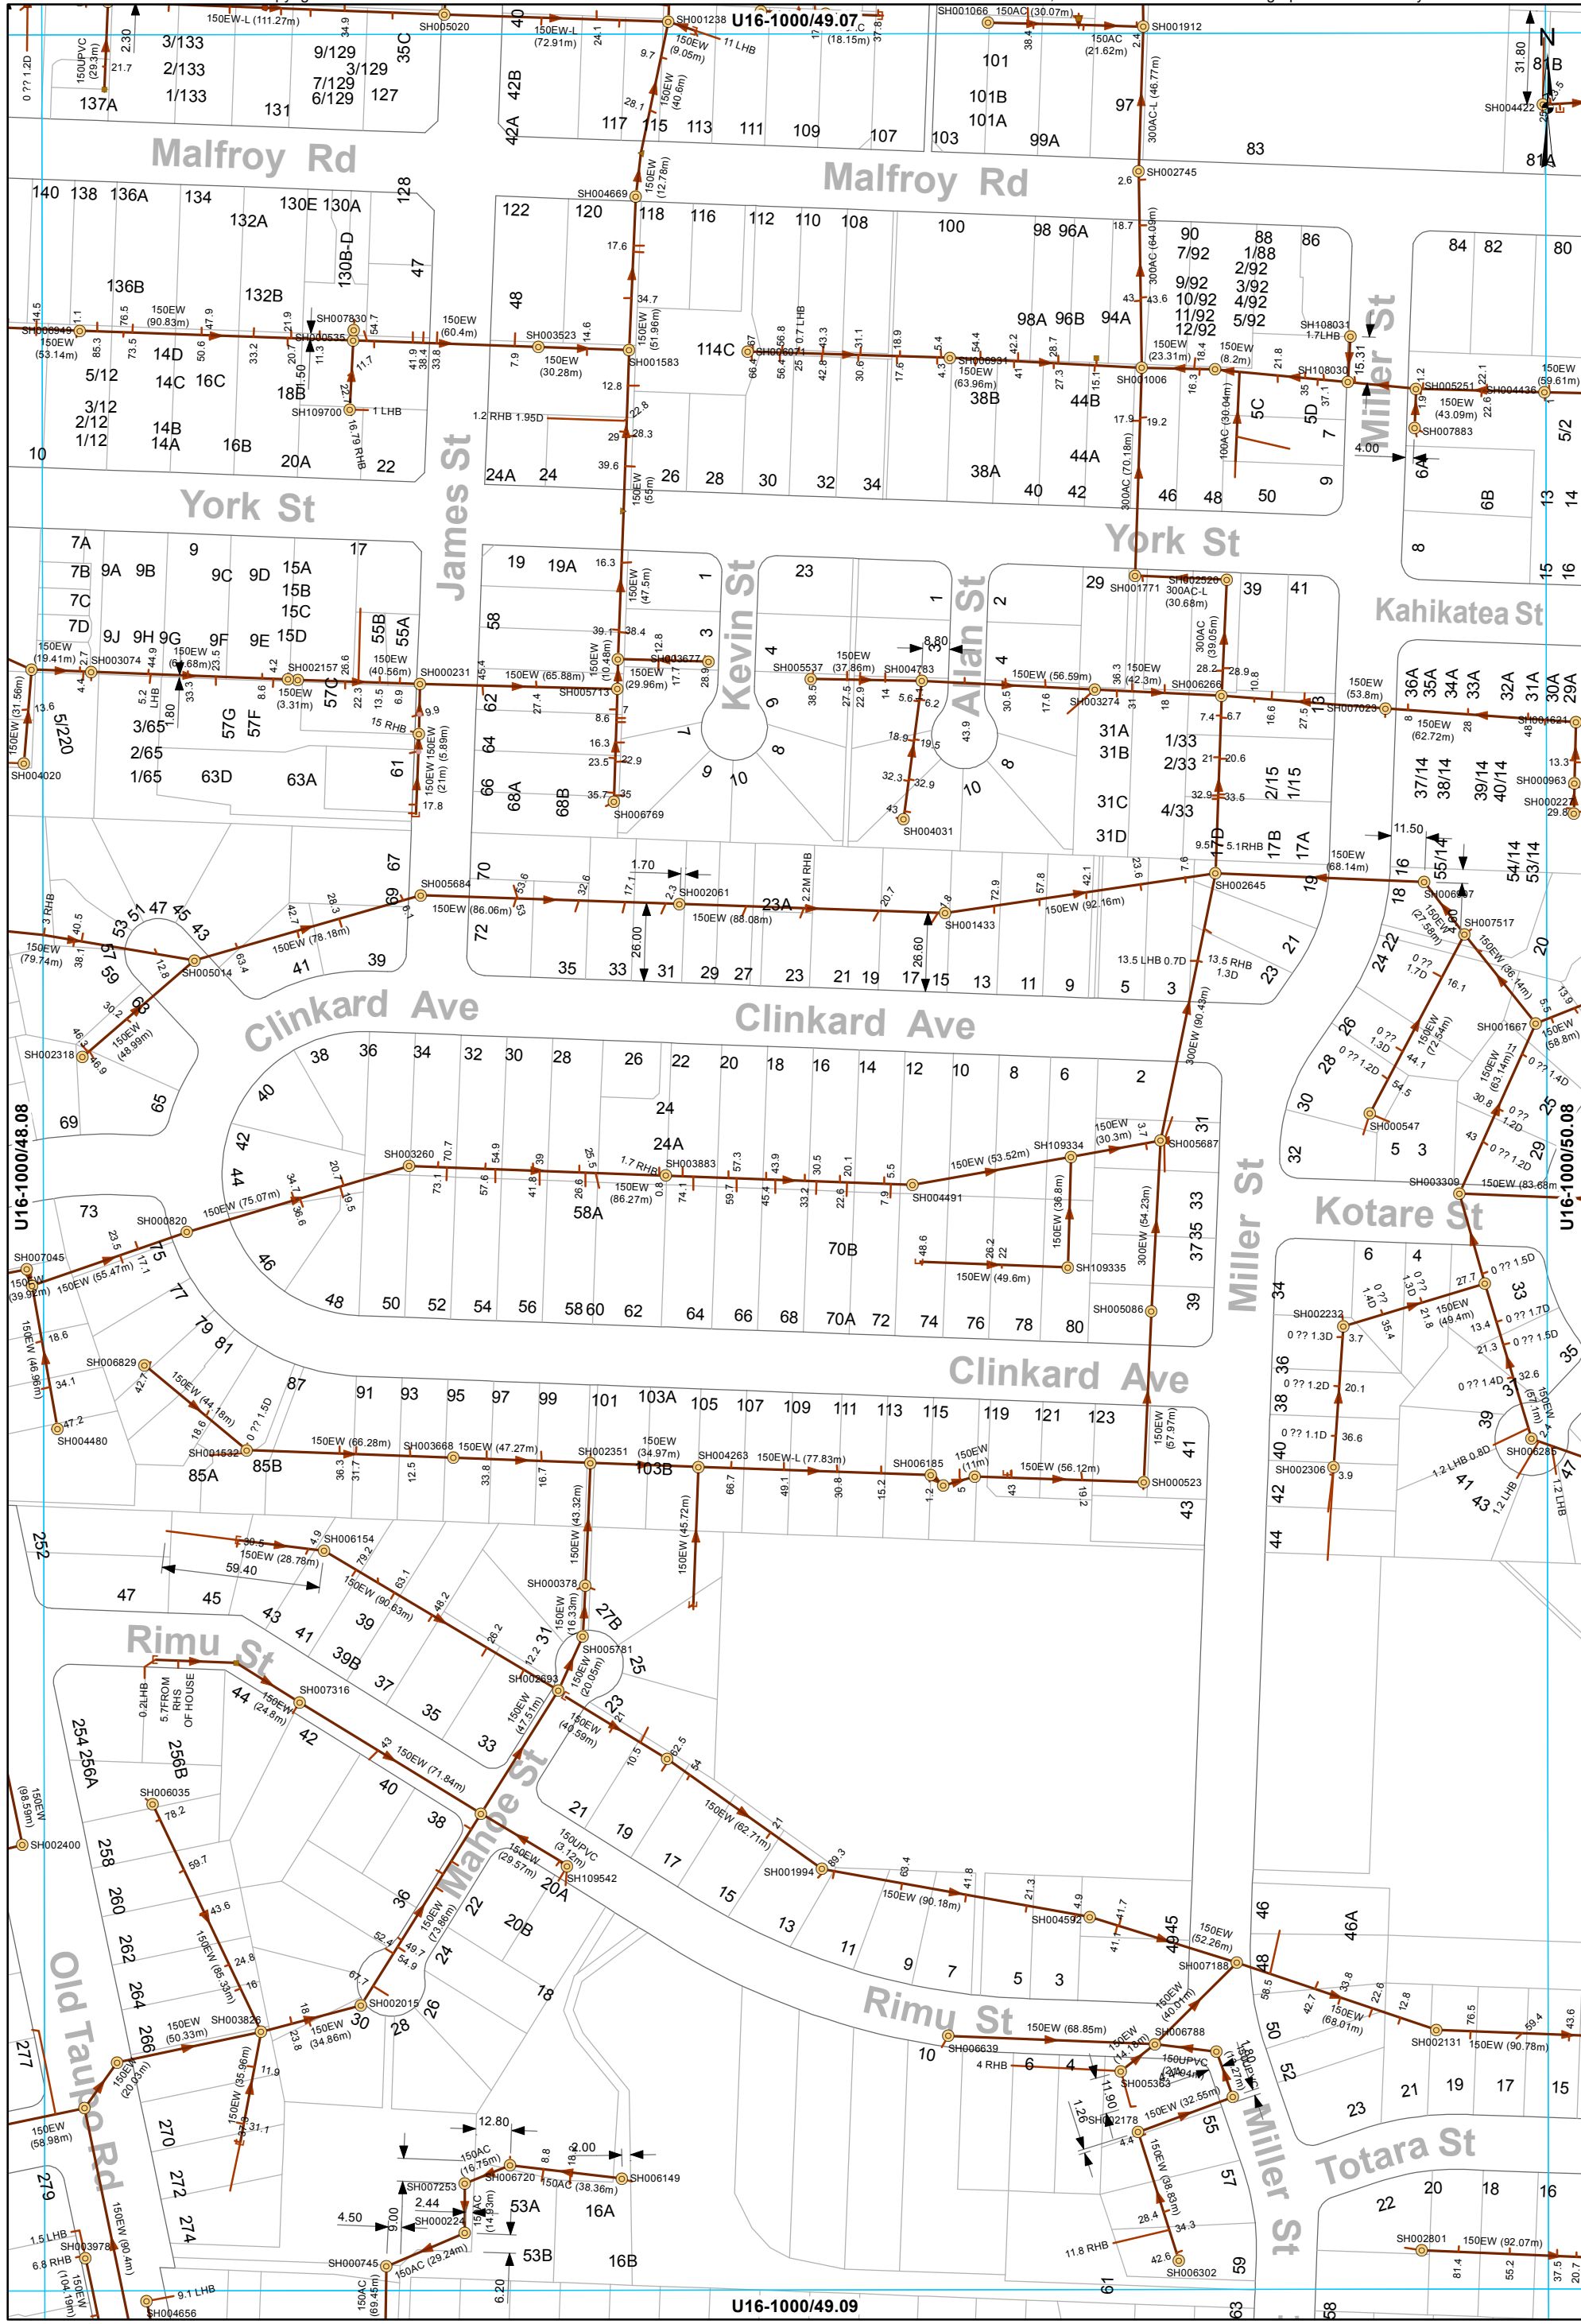


- Manhole
- Chamber - Inspection
- End of line - Capped end
- End of line - Cleaning eye
- Inline cleaning eye
- Inspection point
- Main line
- Service Line

WASTEWATER SERVICES
1:2000 @ A3 - (U16-1000/49.08)

This data is derived from sources outside the control of Rotorua District Council and is for information only


All dimensions and levels should be verified by physical location on-site.

Rotorua District Council 2006. Facsimile 07 346 3143 Telephone 07 348 4199 email mail@rdc.govt.nz

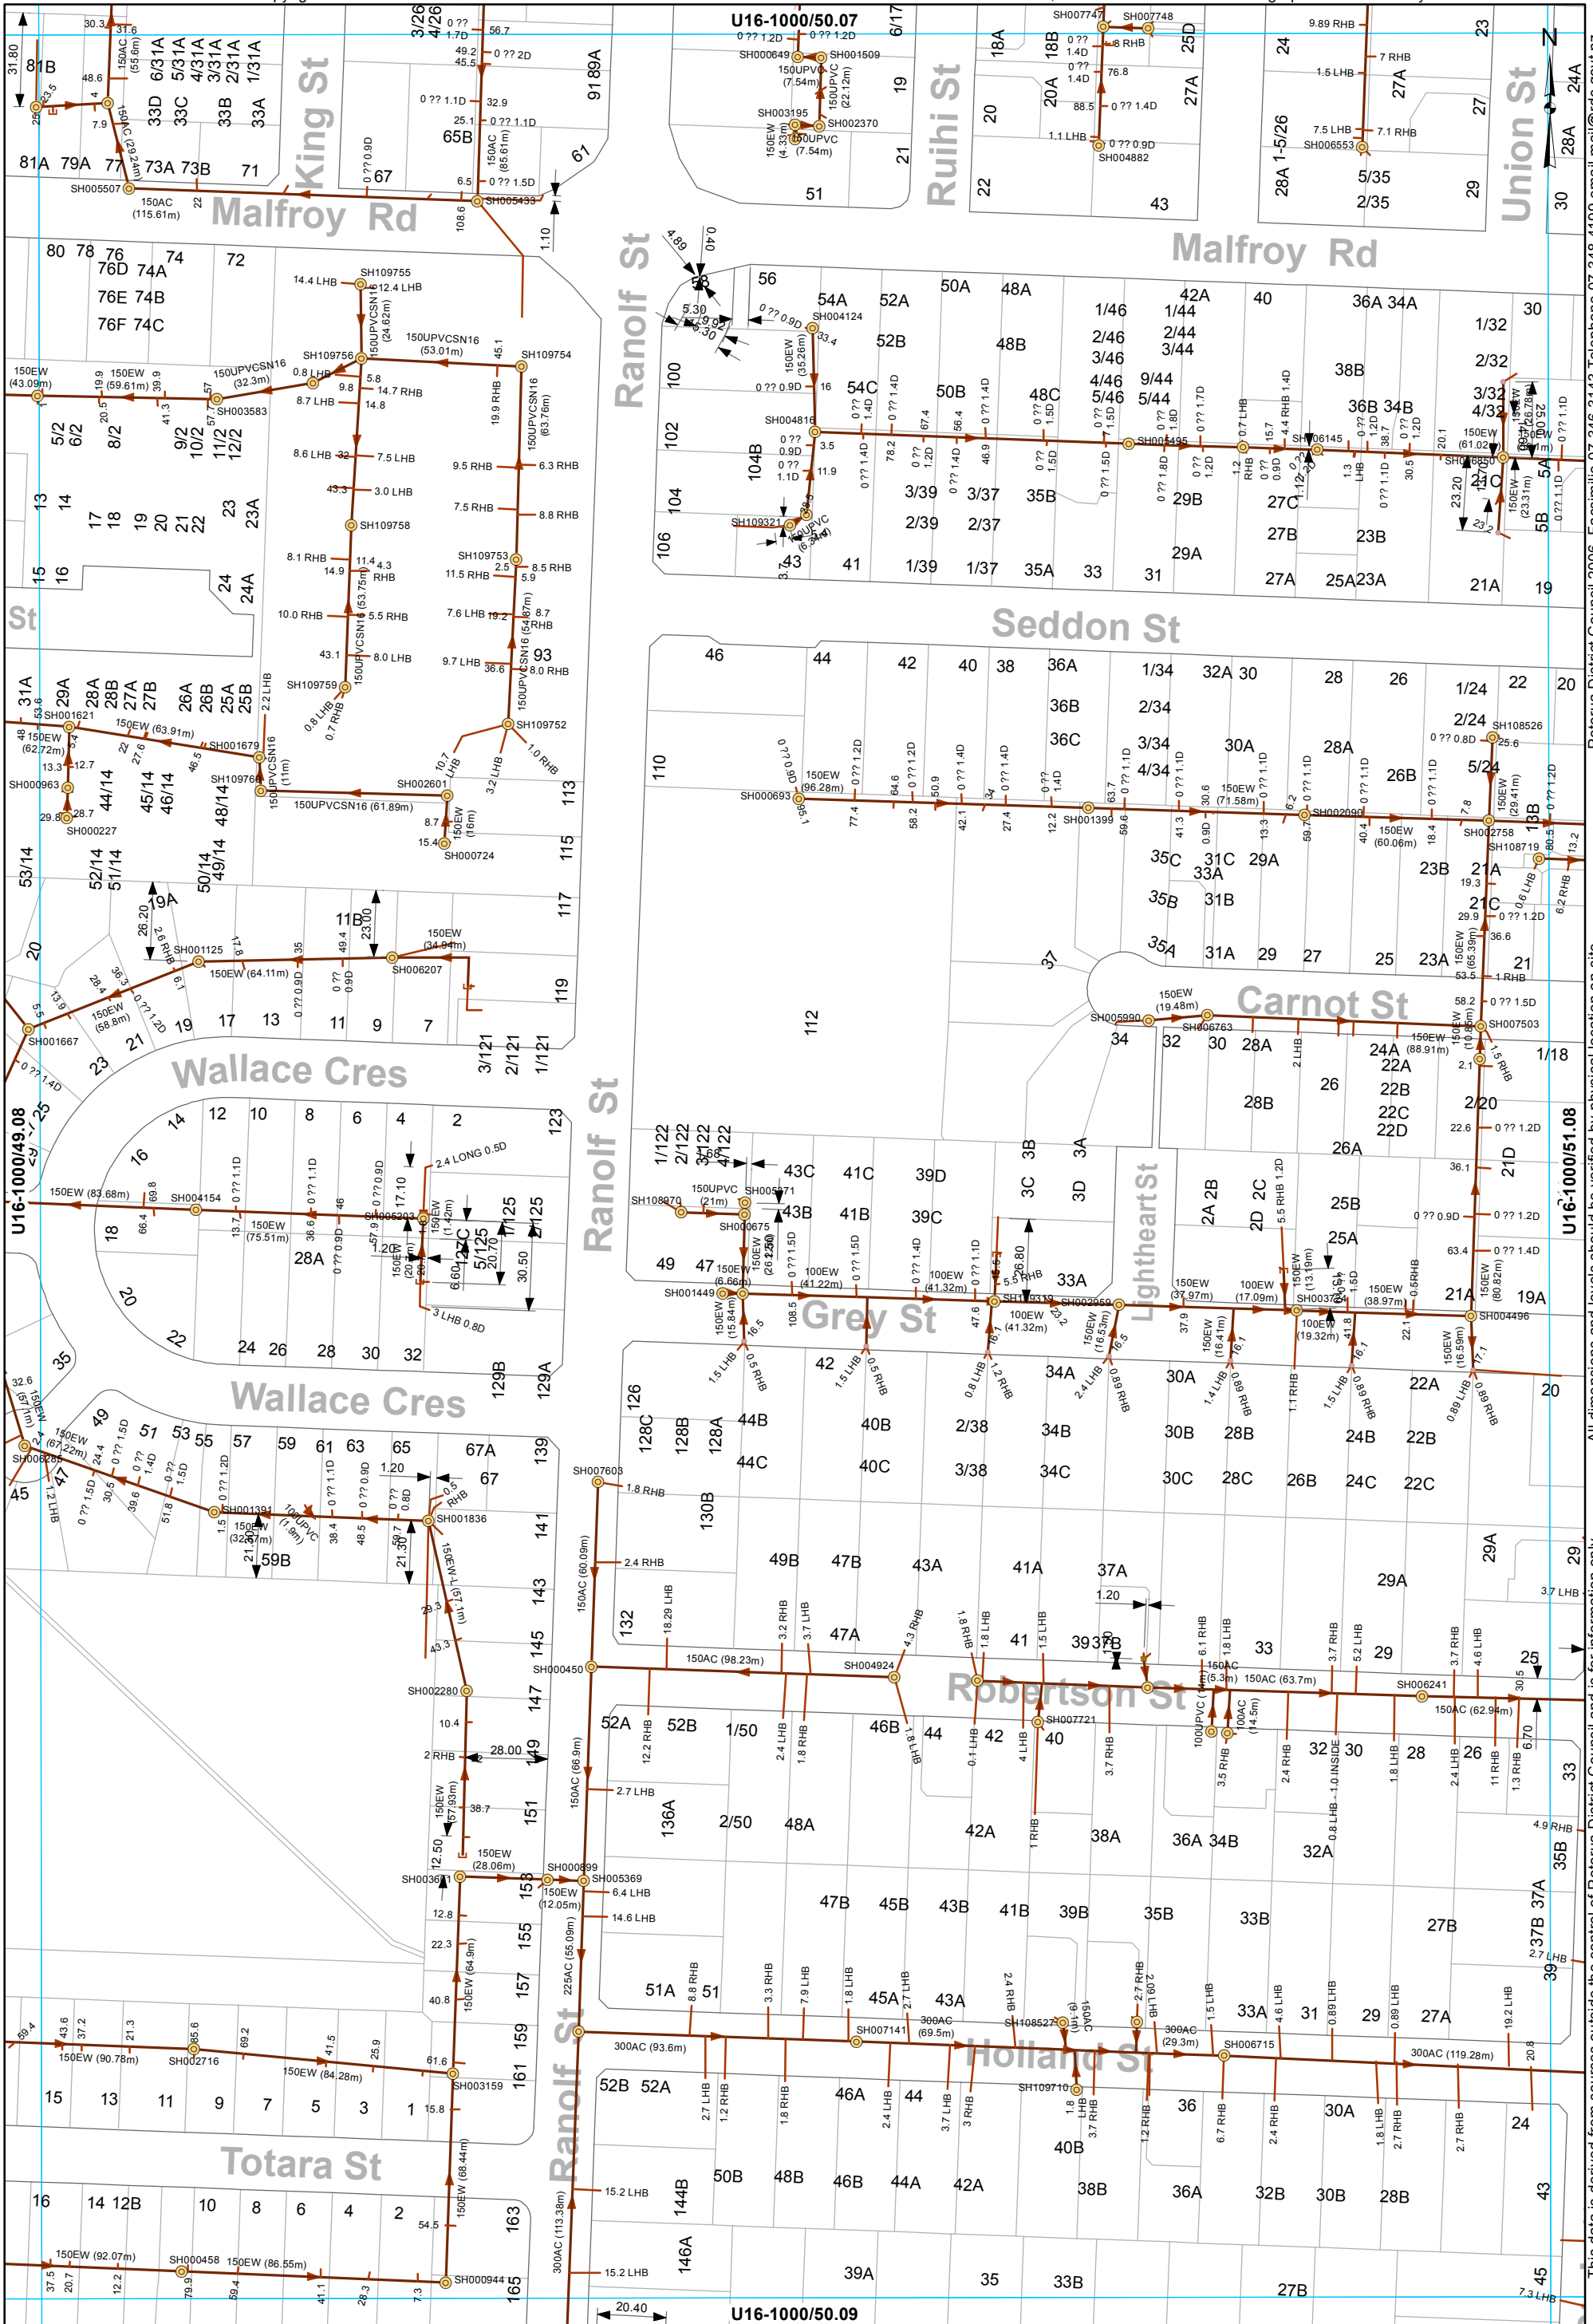

All dimensions and levels outside the control of Rotorua District Council and is for information only

Rotorua District Council 2006. Facsimile 07 346 3143 Telephone 07 348 4199 email mail@rdc.govt.nz

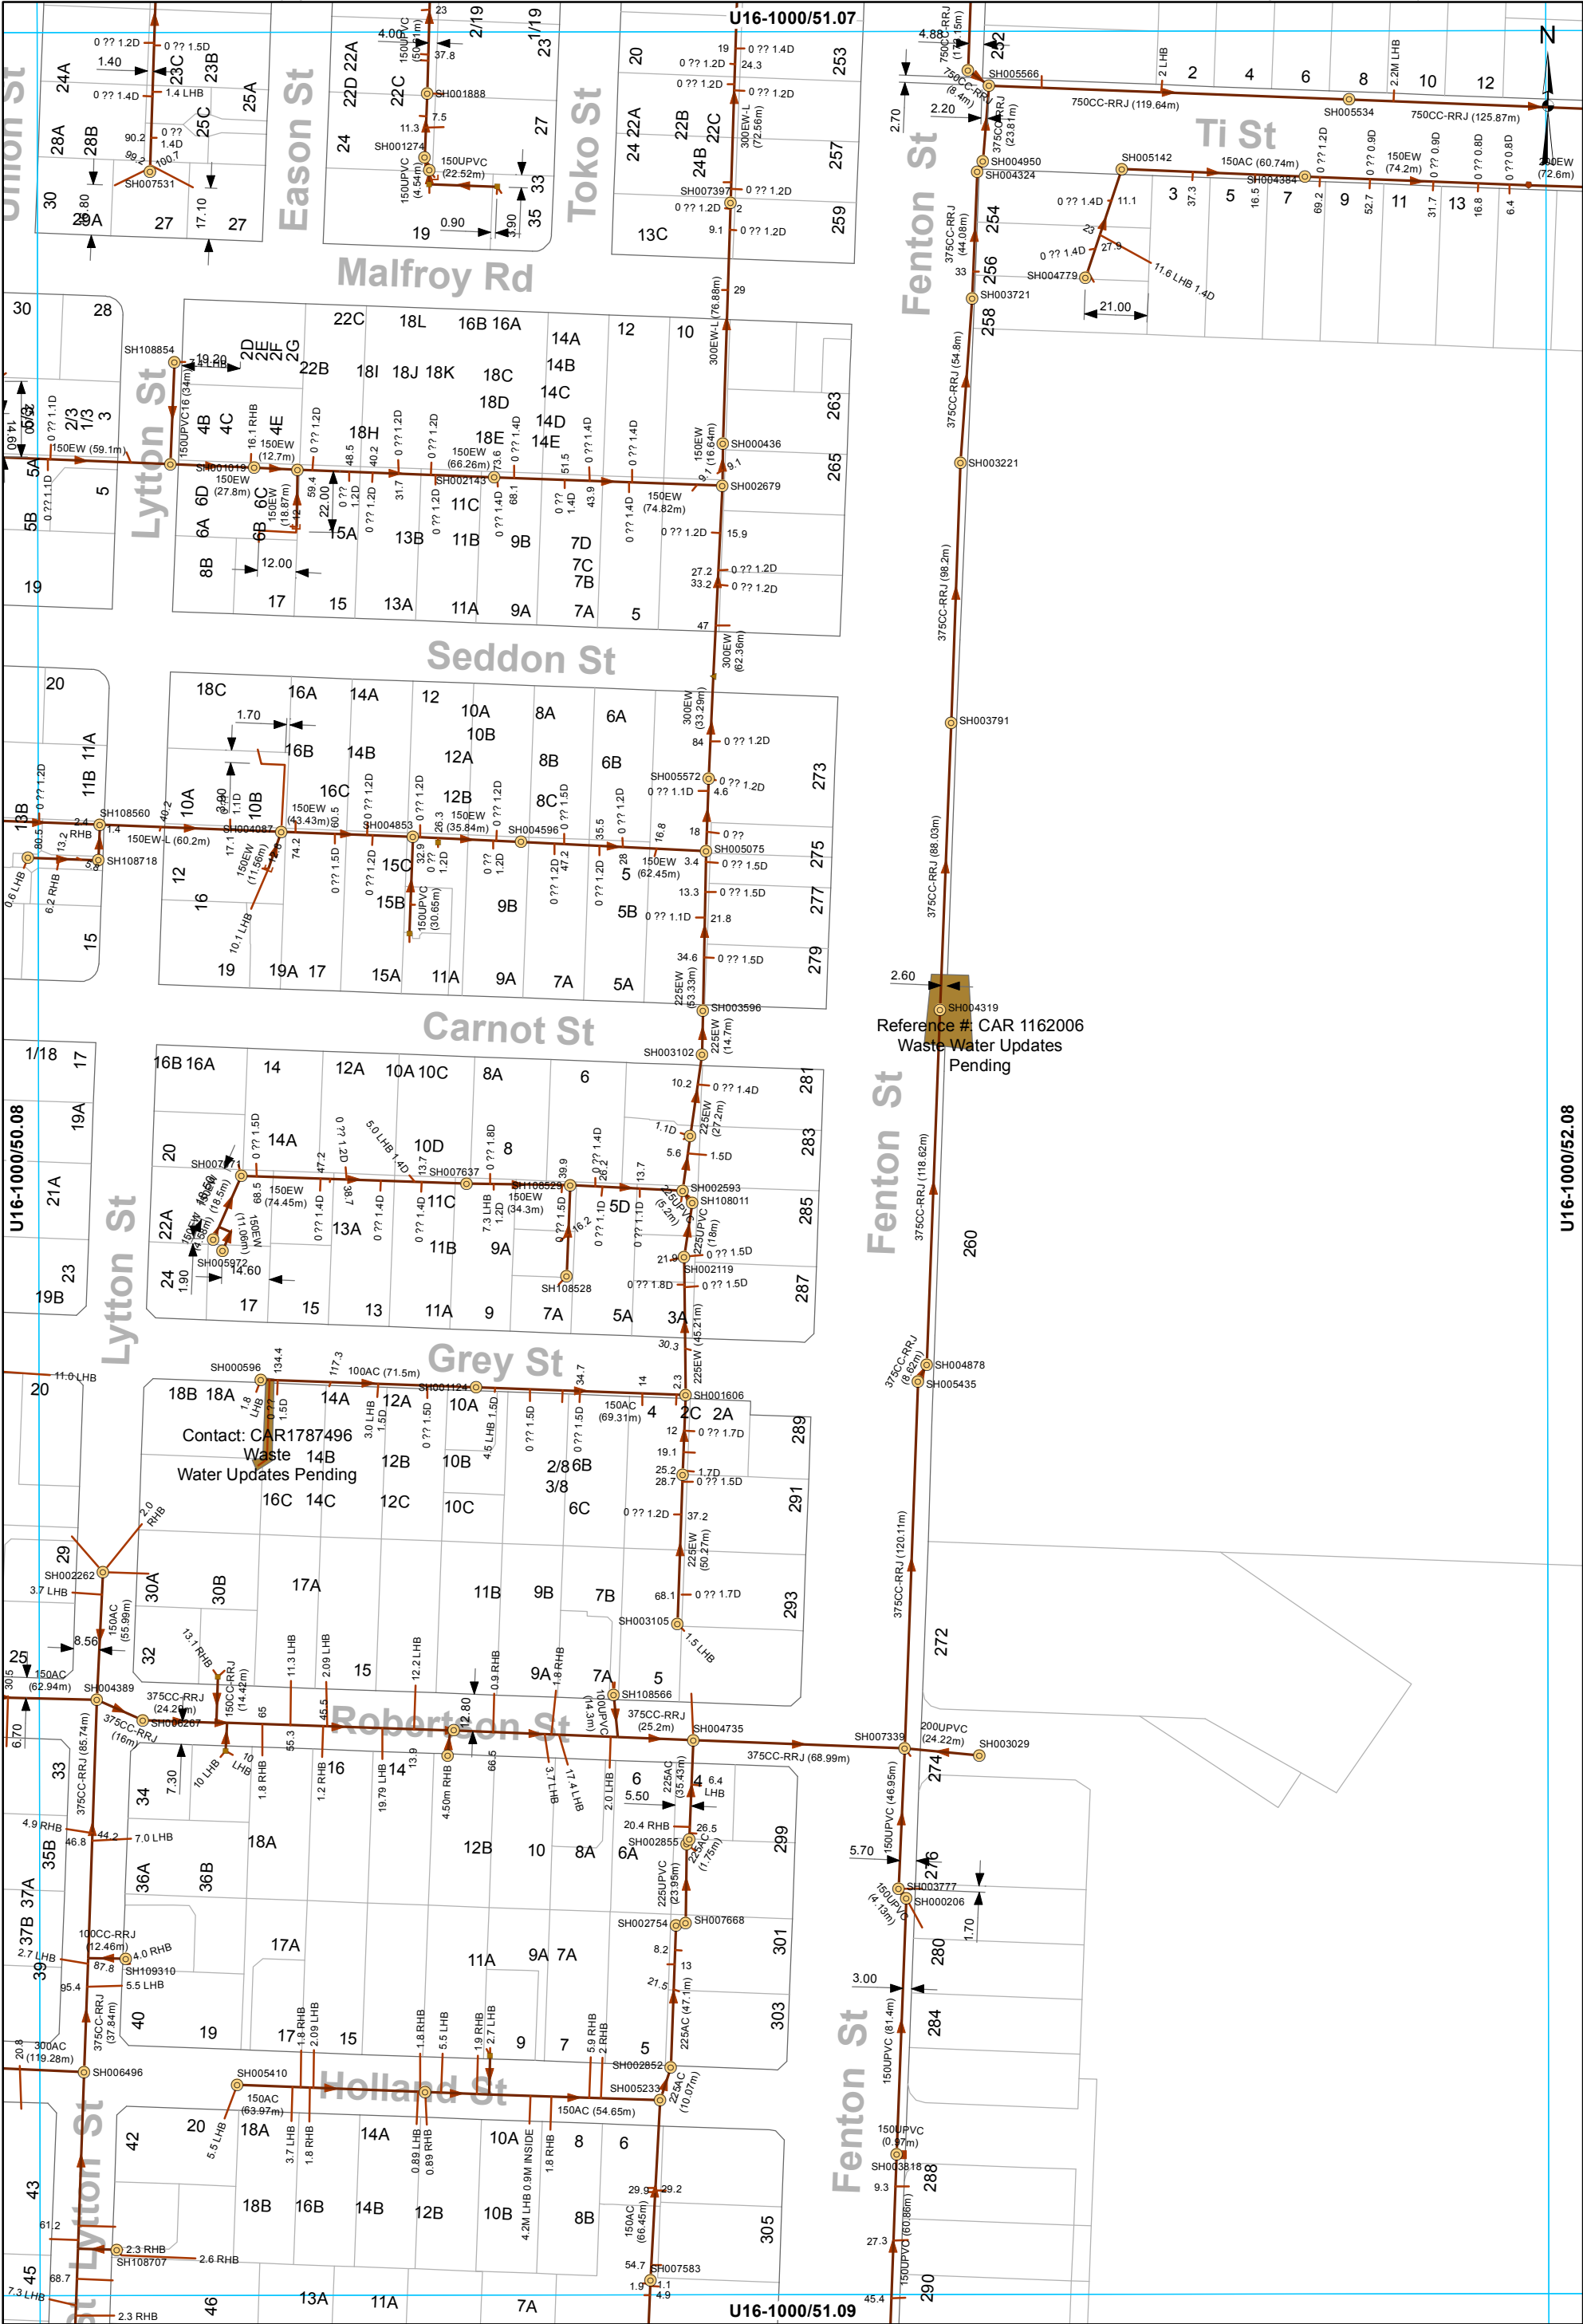

-  Manhole

 Chamber - Inspection

 End of line - Capped end
-  End of line - Cleaning eye

 Inline cleaning eye
-  Main line

 Service Line

WASTEWATER SERVICES
1:2000 @ A3 - (U16-1000/51.08)


This data is derived from sources outside the control of Rotorua District Council and is for information only

U16-1000/52.08

Rotorua District Council 2006. Facsimilie 07 346 3143 Telephone 07 348 4199 email mail@rdc.govt.nz



WASTEWATER SERVICES
1:2000 @ A3 - (U16-1000/52.08)

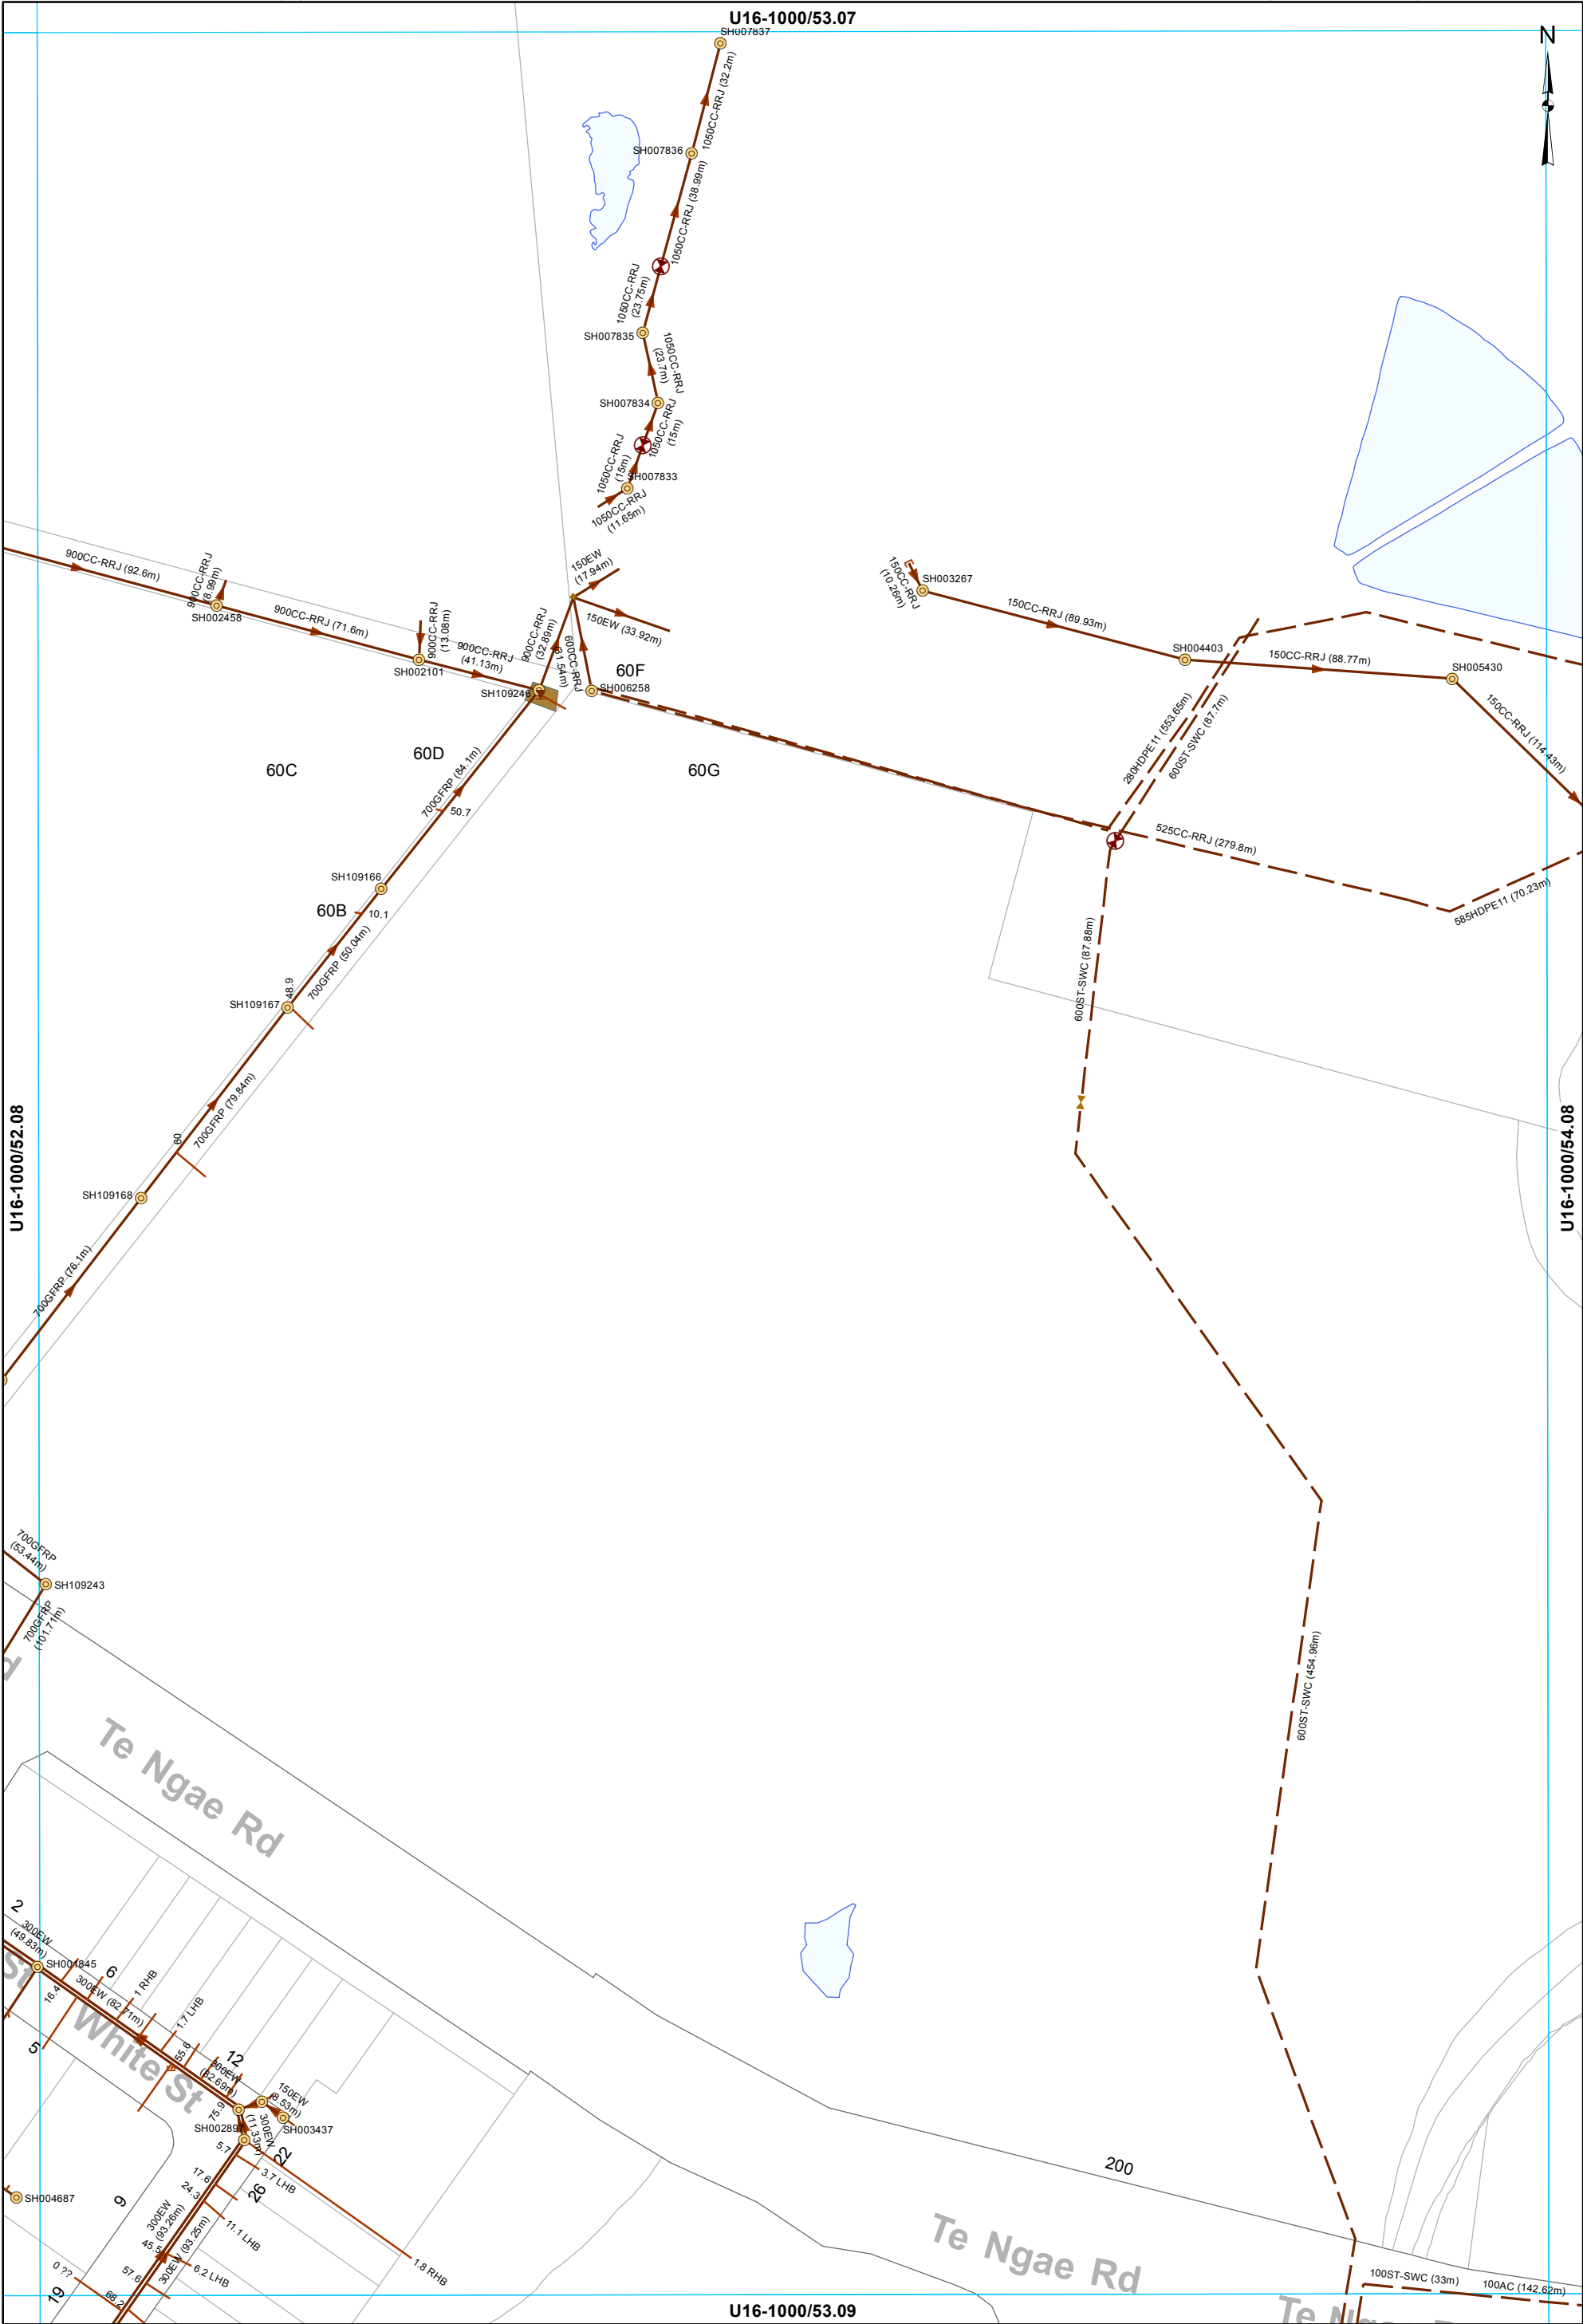


- | | | | |
|----------------------|--------------------------|------------------|--------------|
| Manhole | End of line - Capped end | Air Valve | Main line |
| Chamber - Inspection | | Isolating Valve | Rising main |
| | | Non return Valve | Service Line |

WASTEWATER SERVICES
1:2000 @ A3 - (U16-1000/53.08)

This data is derived from sources outside the control of Rotorua District Council and is for information only

Rotorua District Council 2006. Facsimilie 07 346 3143 Telephone 07 348 4199 email mail@rdc.govt.nz

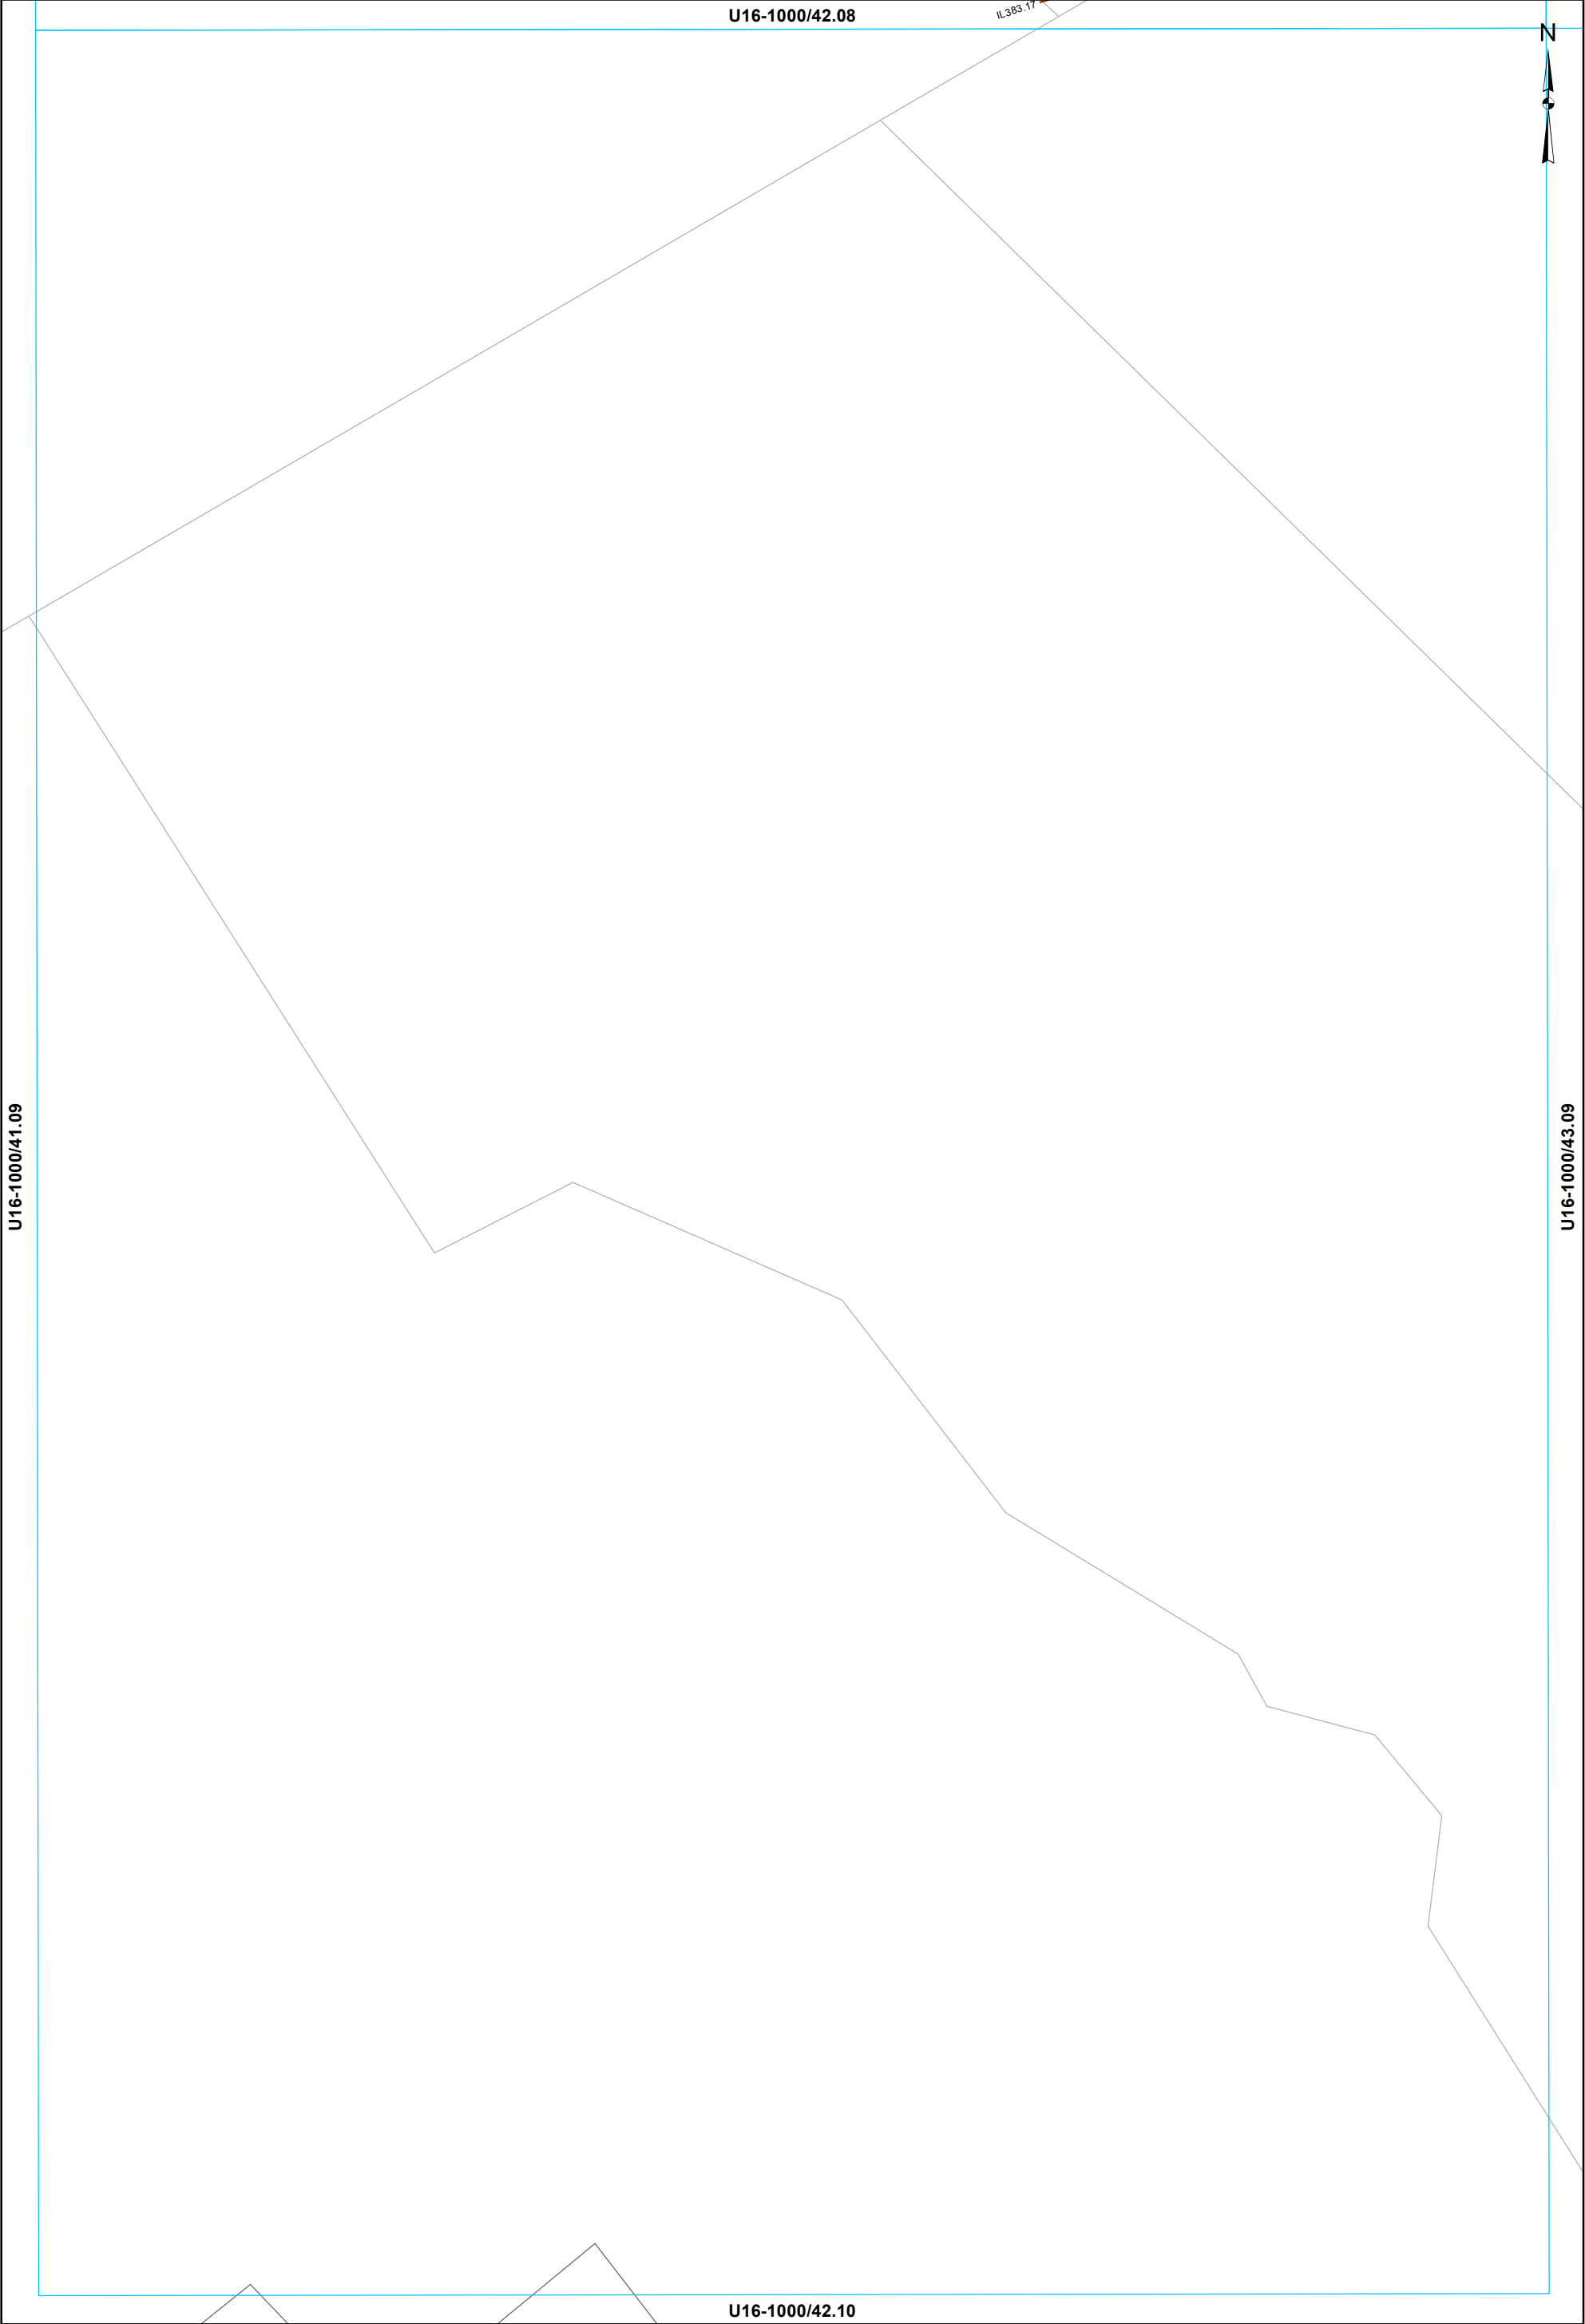


This data is derived from sources outside the control of Rotorua District Council and is for information only

All dimensions and levels should be verified by physical location on-site.


Rotorua District Council 2006. Facsimile 07 346 3143 Telephone 07 348 4199 email mail@rdc.govt.nz

U16-1000/44.10

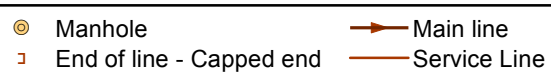

This data is derived from sources outside the control of Rotorua District Council and is for information only

Rotorua District Council 2006. Facsimile 07 346 3143 Telephone 07 348 4199 email mail@rdc.govt.nz

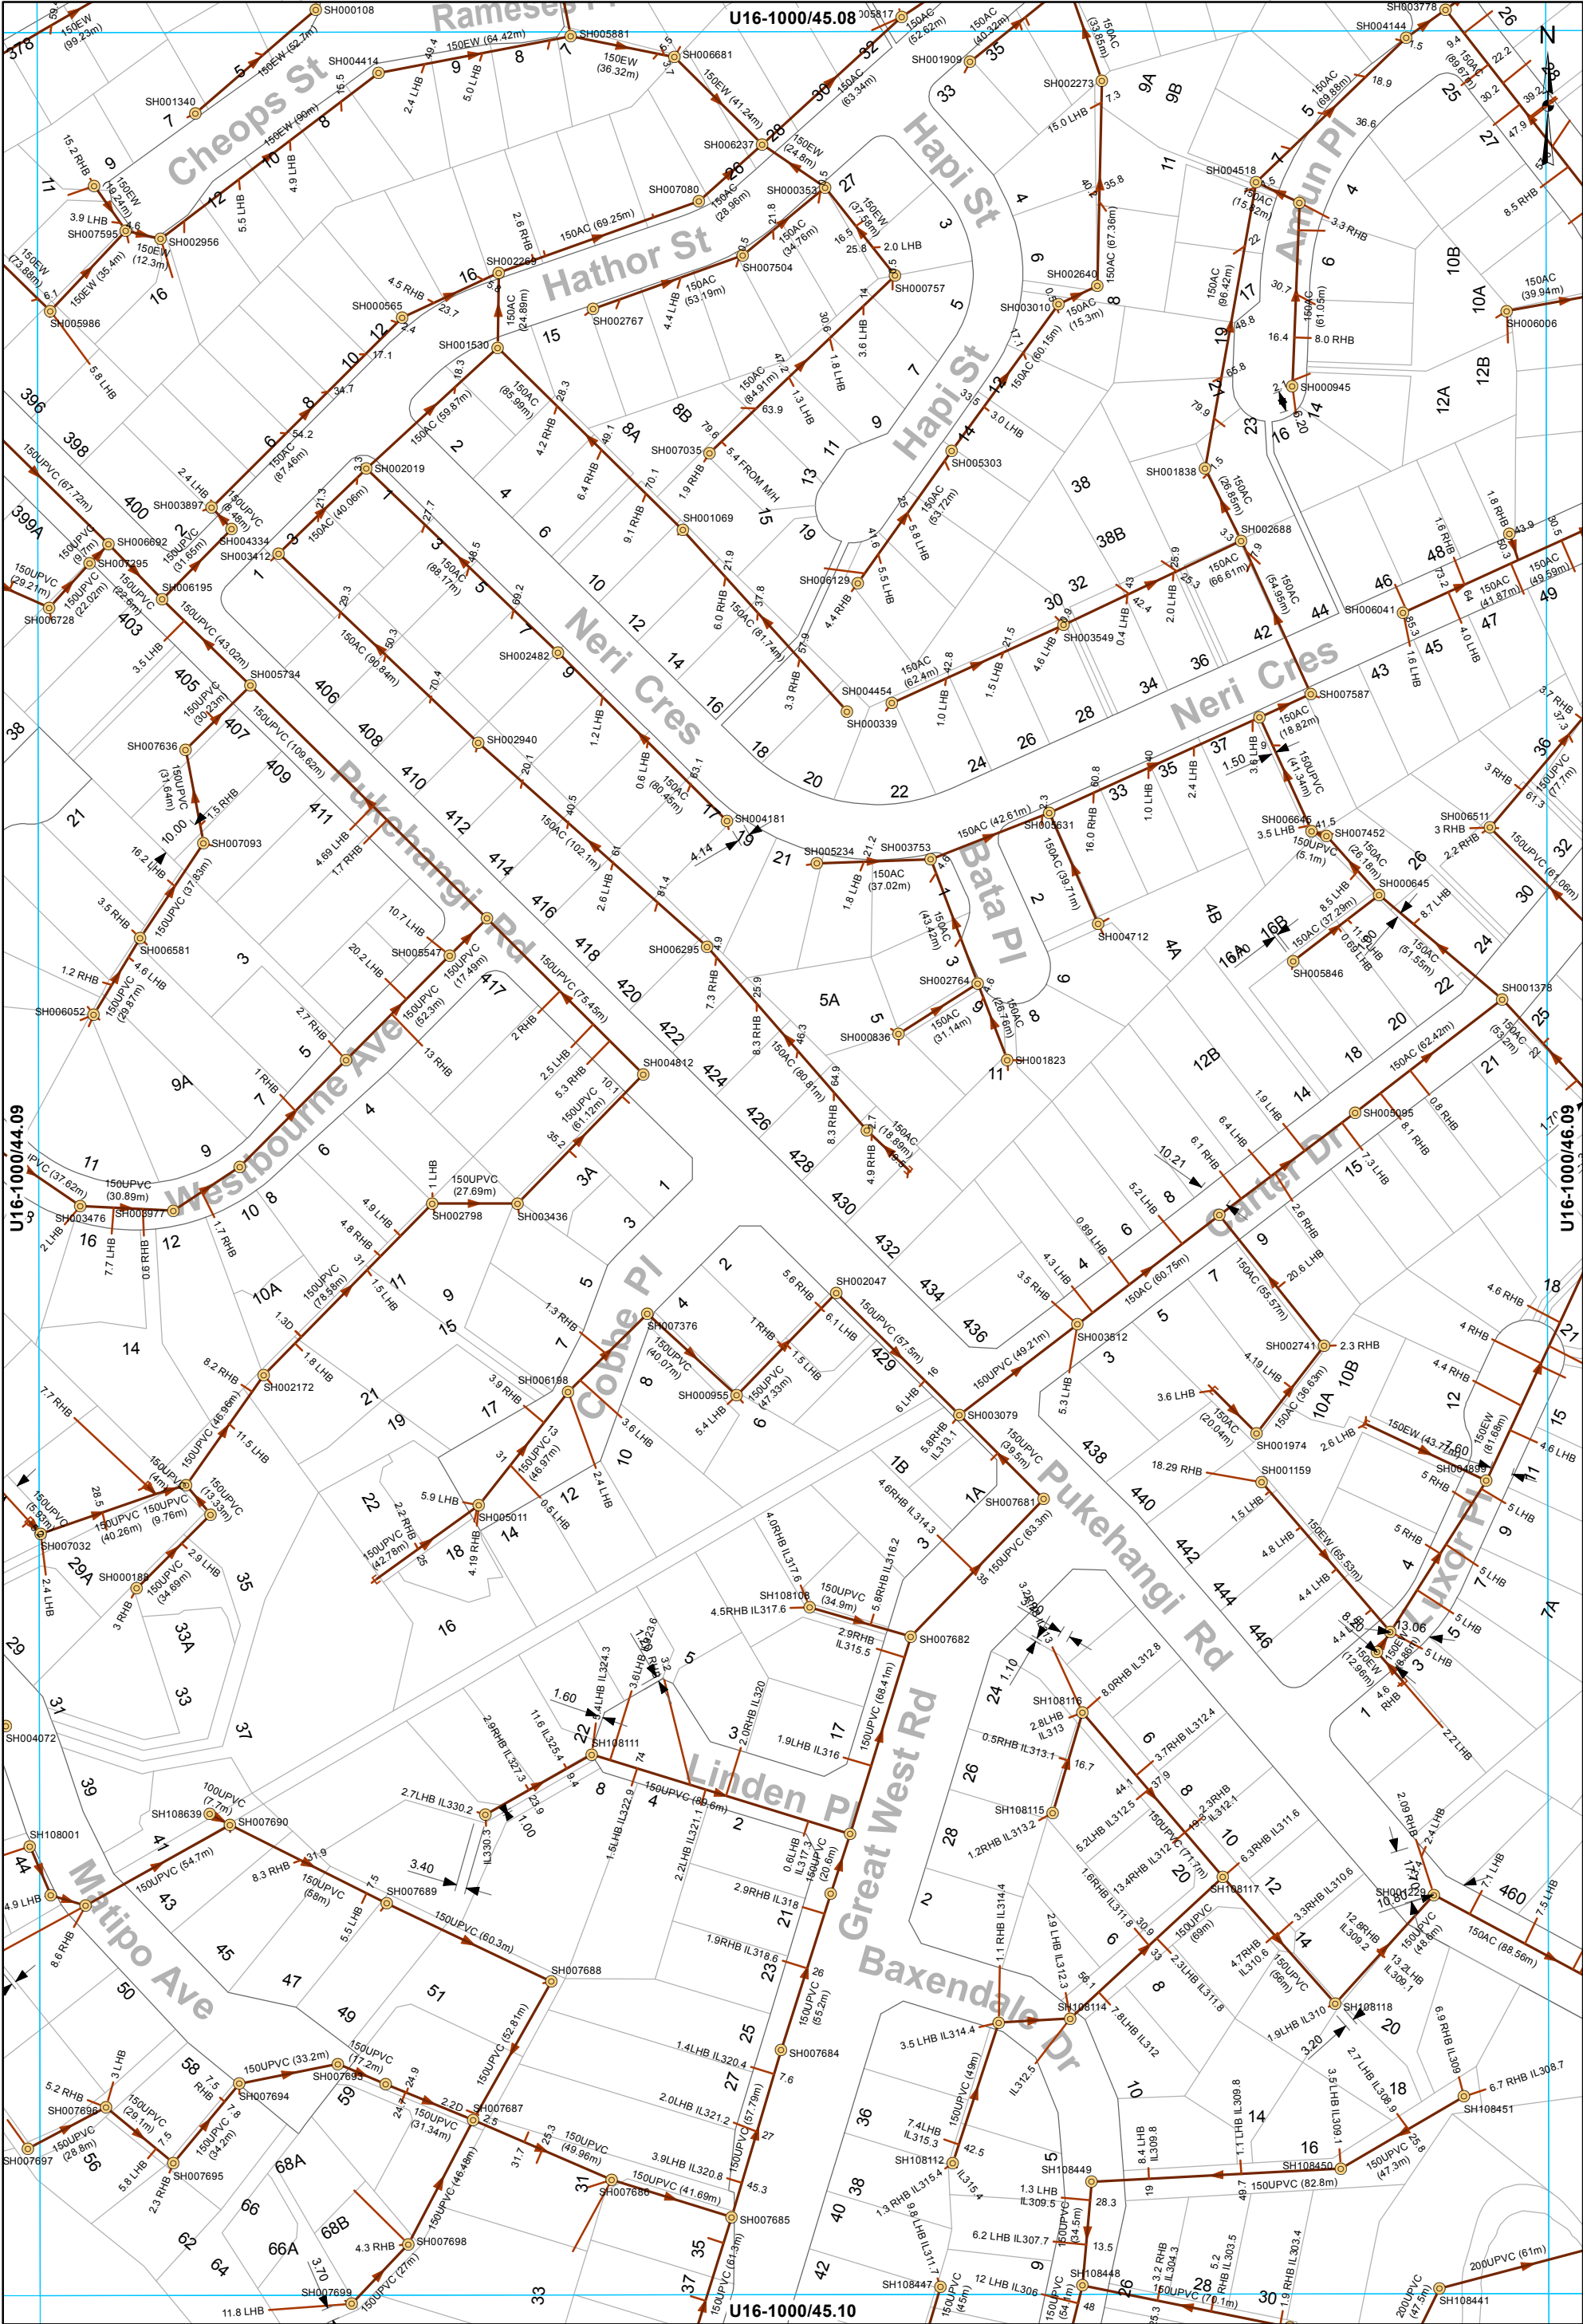


- Manhole
- End of line - Capped end
- Main line
- Service Line

WASTEWATER SERVICES
1:2000 @ A3 - (U16-1000/45.09)

This data is derived from sources outside the control of Rotorua District Council and is for information only

All dimensions and levels should be verified by physical location on-site.

Rotorua District Council 2006. Facsimile 07 346 3143 Telephone 07 348 4199 email mail@rdc.govt.nz

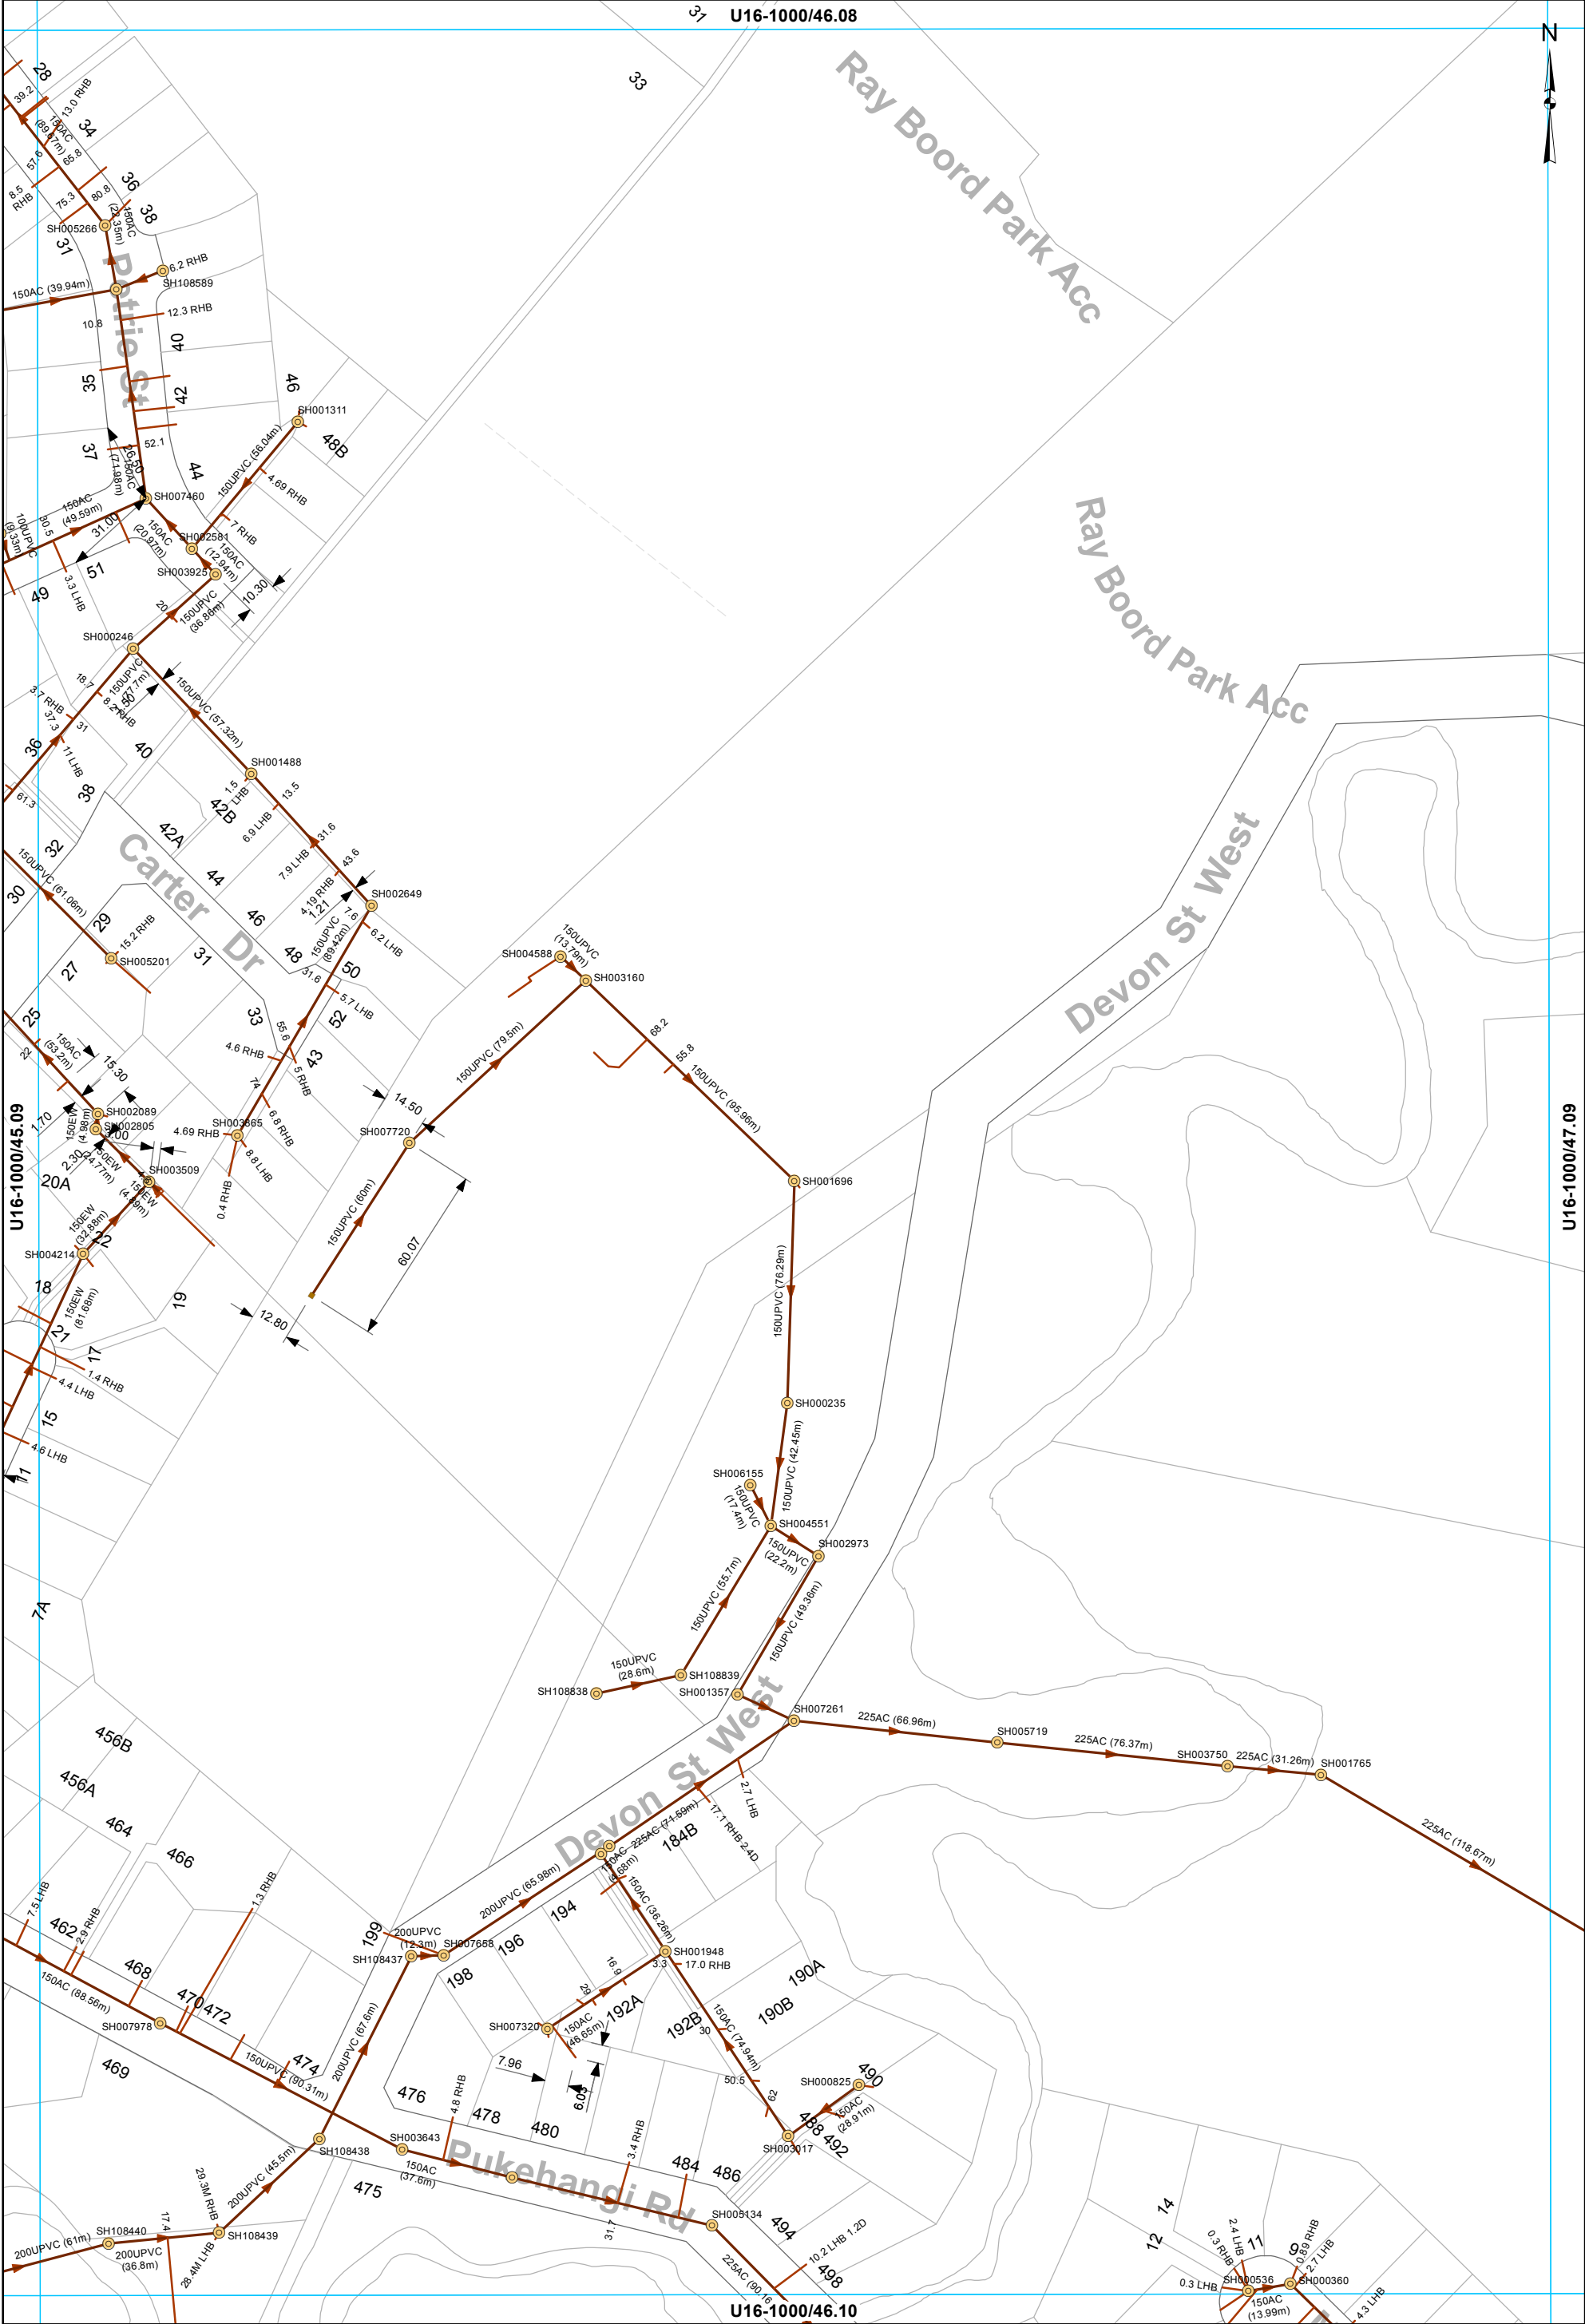


- Manhole
- Chamber - Inspection
- End of line - Capped end
- Main line
- Service Line

WASTEWATER SERVICES
1:2000 @ A3 - (U16-1000/46.09)

This data is derived from sources outside the control of Rotorua District Council and is for information only

U16-1000/47.09

Rotorua District Council 2006. Facsimilie 07 346 3143 Telephone 07 348 4199 email mail@rdc.govt.nz

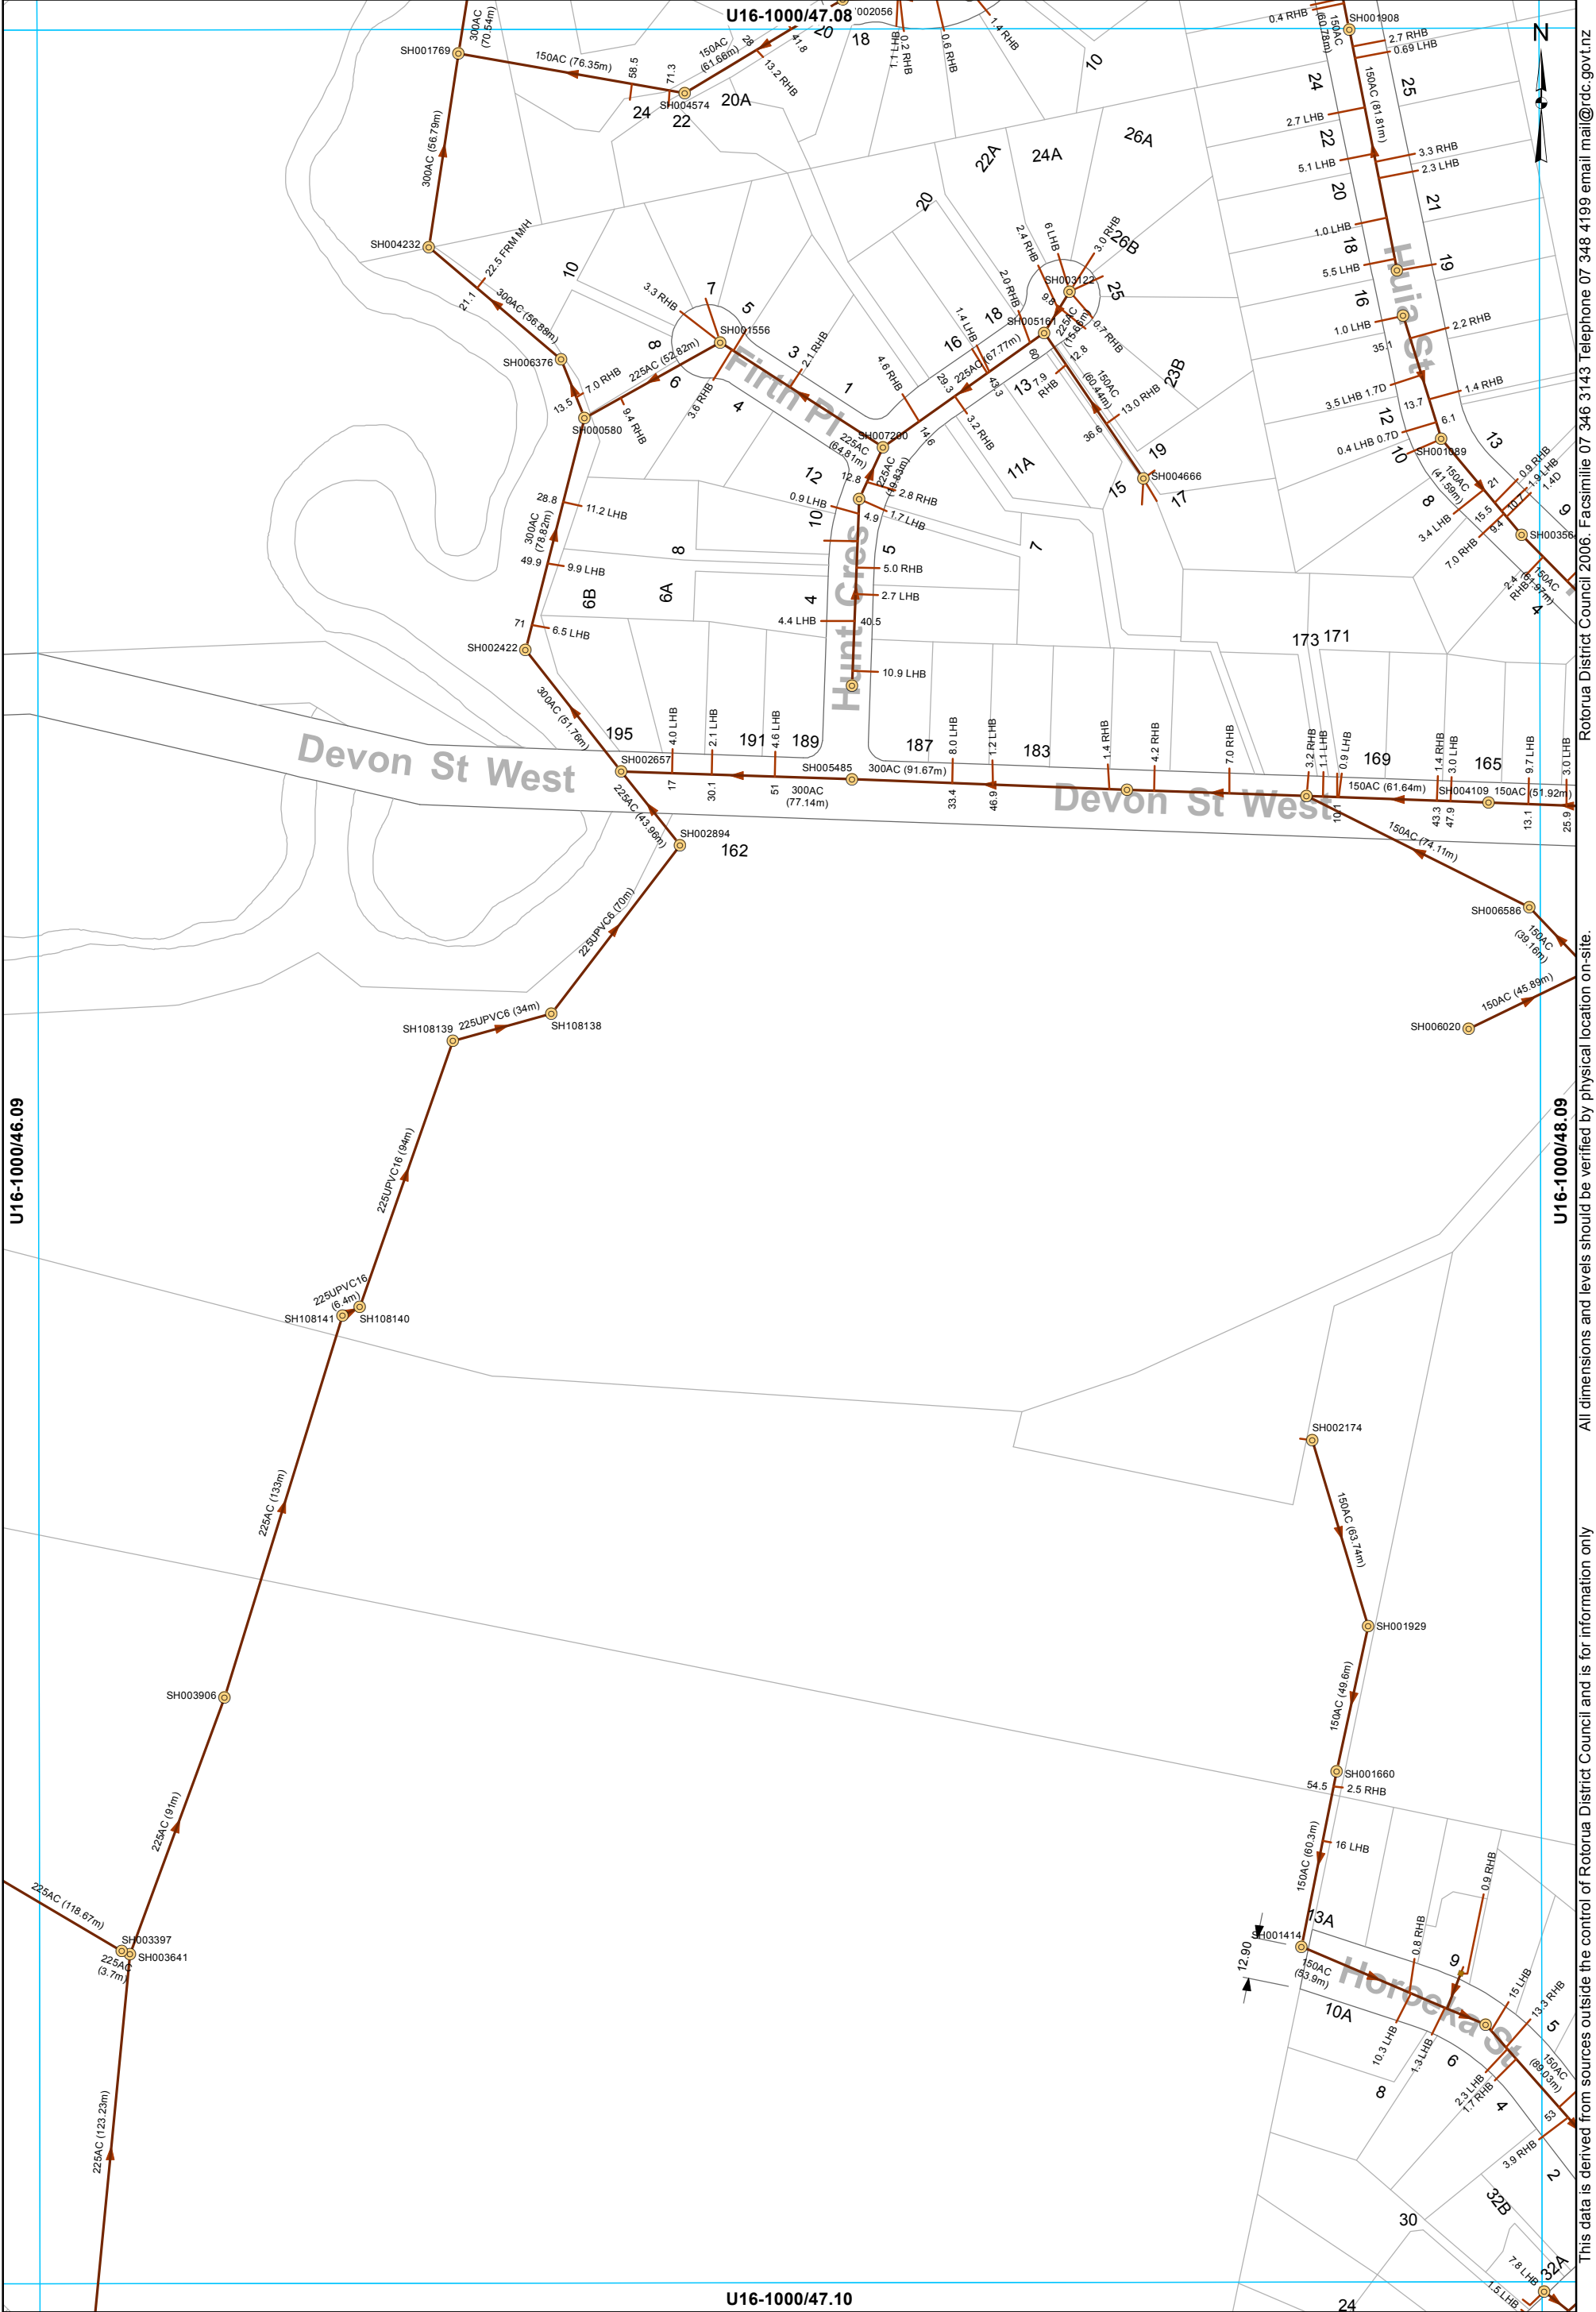


- Manhole
- Chamber - Inspection
- Main line
- Service Line

WASTEWATER SERVICES
1:2000 @ A3 - (U16-1000/47.09)

This data is derived from sources outside the control of Rotorua District Council and is for information only

All dimensions and levels should be verified by physical location on-site.

Rotorua District Council 2006. Facsimile 07 346 3143 Telephone 07 348 4199 email mail@rdc.govt.nz

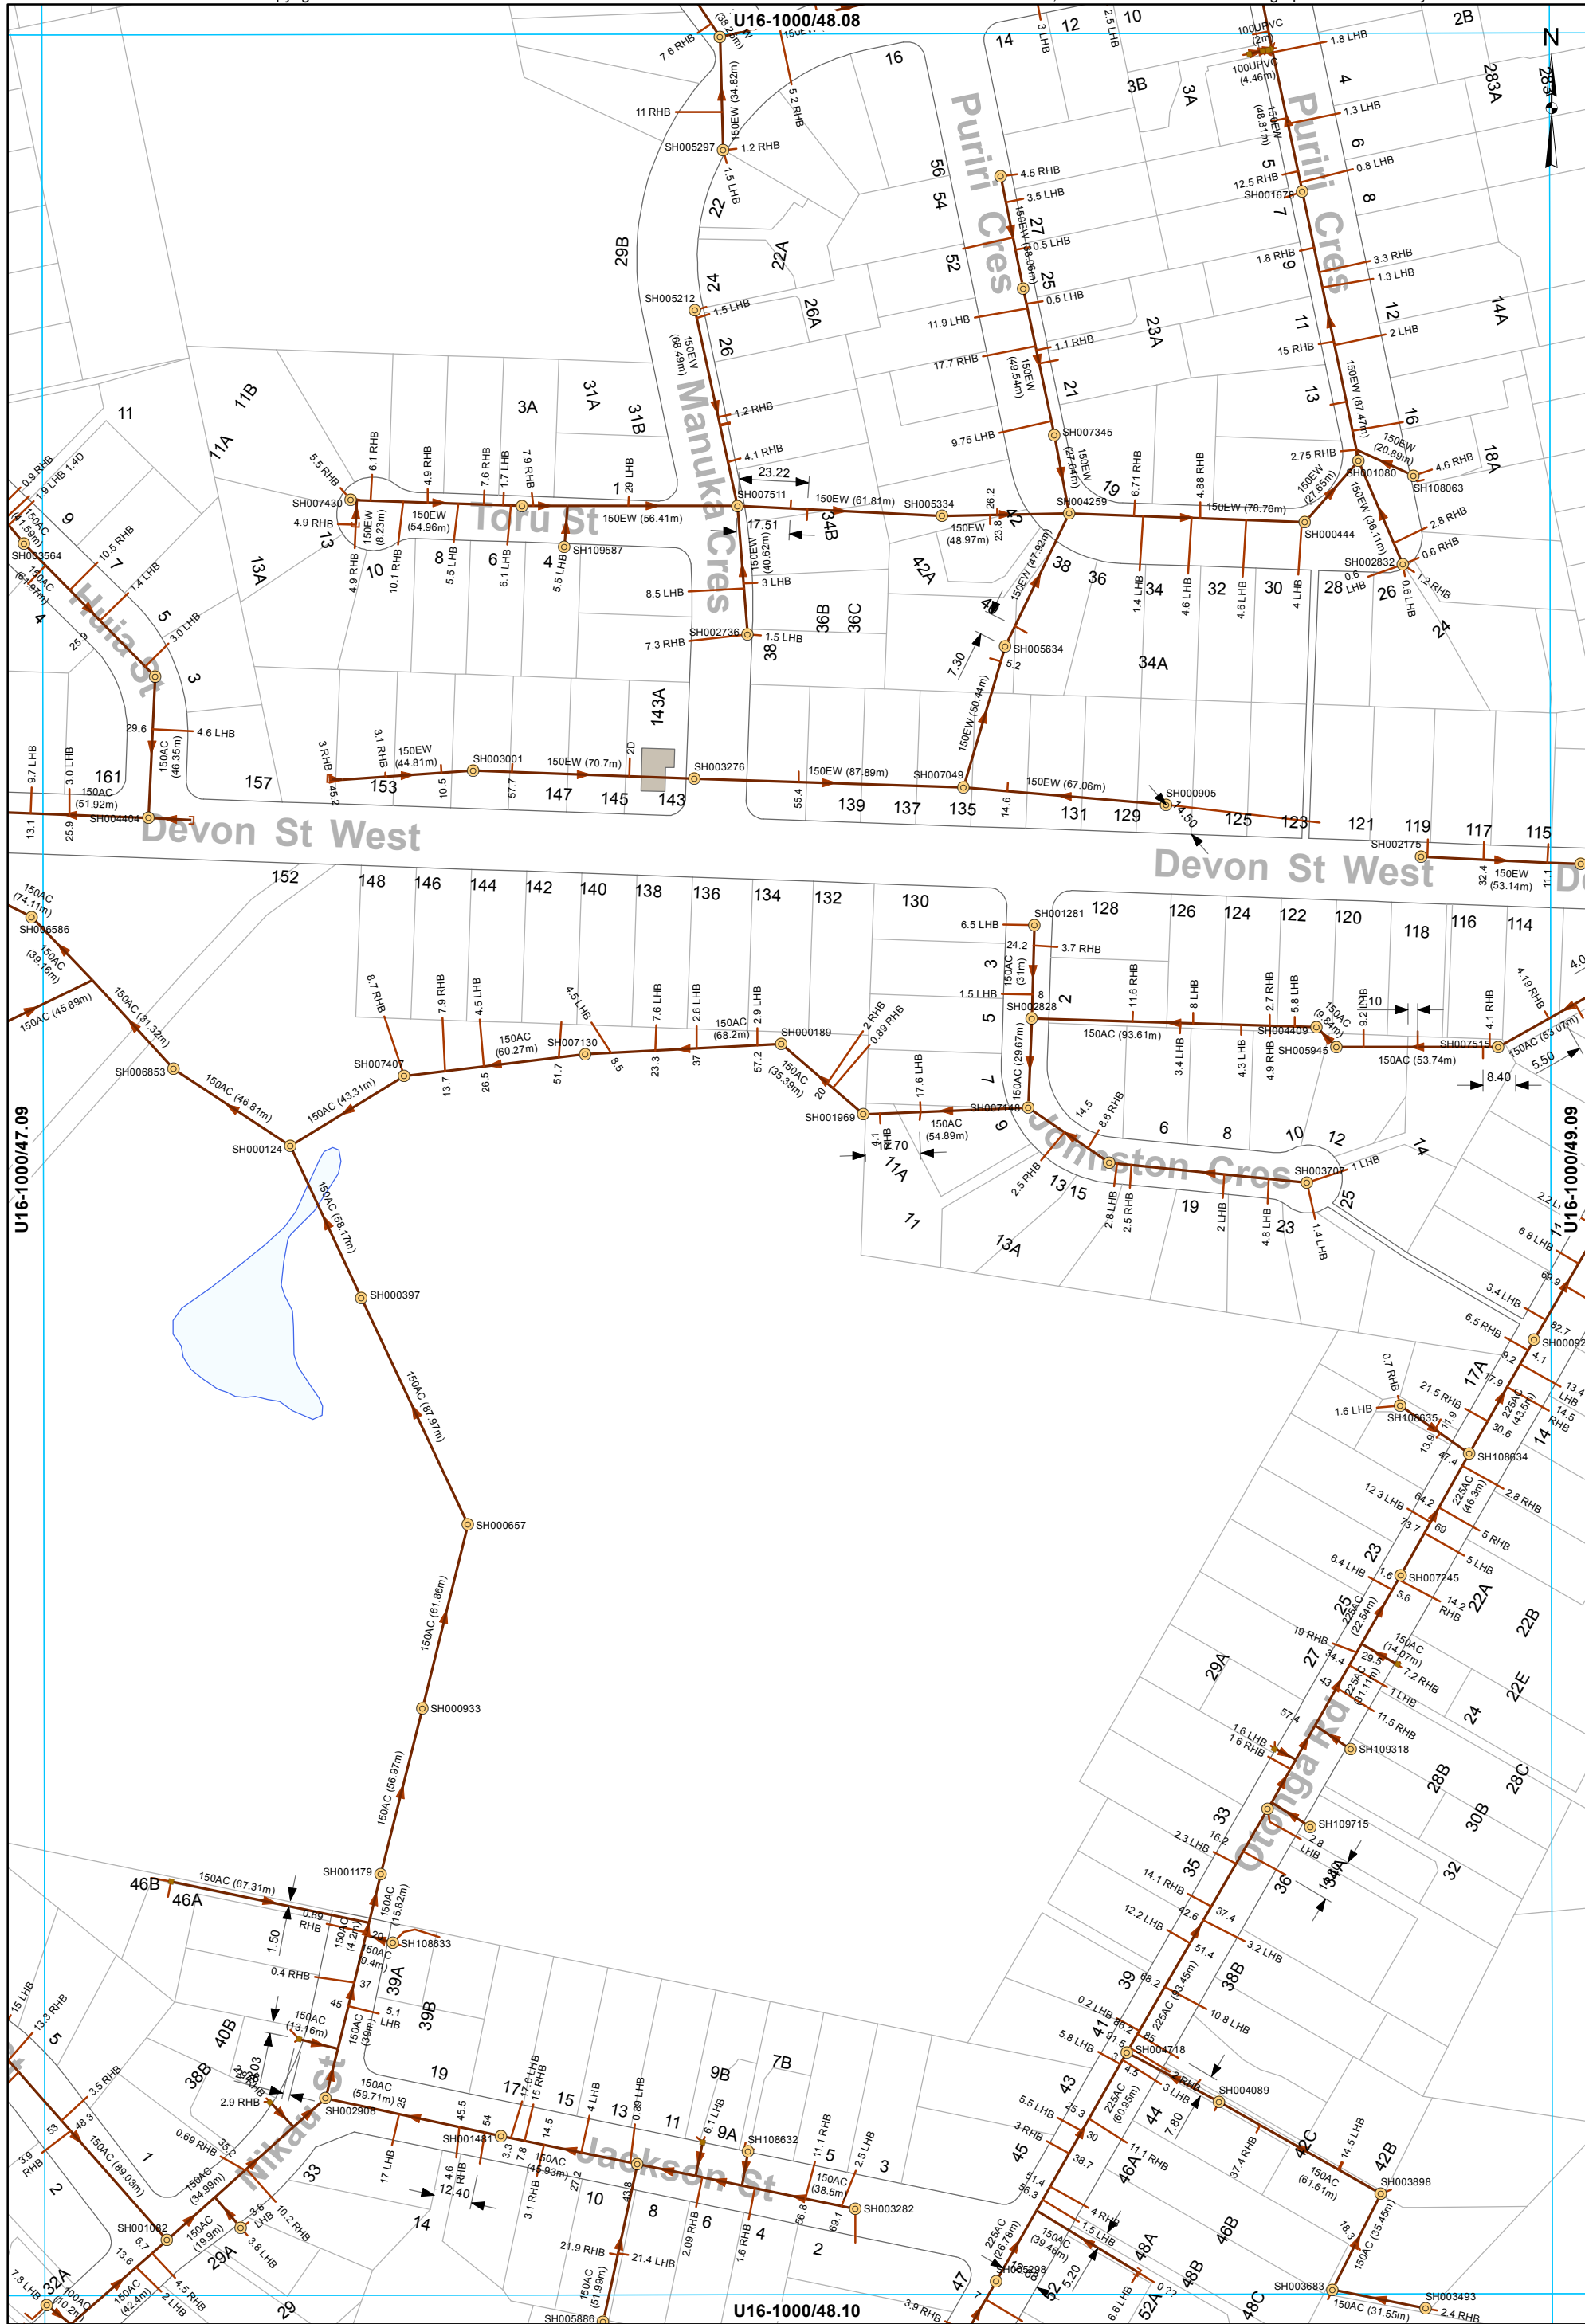

- Manhole
- Chamber - Inspection
- End of line - Capped end
- Main line
- Service Line

WASTEWATER SERVICES
1:2000 @ A3 - (U16-1000/48.09)

This data is derived from sources outside the control of Rotorua District Council and is for information only

All dimensions and levels should be verified by physical location on-site.

Rotorua District Council 2006. Facsimile 07 346 3143 Telephone 07 348 4199 email mail@rdc.govt.nz



- Manhole
- Chamber - Inspection
- Inspection point
- Main line
- Service Line

WASTEWATER SERVICES
1:2000 @ A3 - (U16-1000/49.09)

This data is derived from sources outside the control of Rotorua District Council and is for information only

All dimensions and levels should be verified by physical location on-site.

Rotorua District Council 2006. Facsimile 07 346 3143 Telephone 07 348 4199 email mail@rdc.govt.nz



WASTEWATER SERVICES
1:2000 @ A3 - (U16-1000/50.09)



- Manhole
- Chamber - Inspection
- End of line - Capped end
- End of line - Cleaning eye
- Inspection point
- Main line
- Service Line

WASTEWATER SERVICES
1:2000 @ A3 - (U16-1000/51.09)

This data is derived from sources outside the control of Rotorua District Council and is for information only. All dimensions and levels should be verified by physical location on-site.

Rotorua District Council 2006. Facsimile 07 346 3143 Telephone 07 348 4199 email mail@rdc.govt.nz




- Manhole
- Chamber - Inspection
- End of line - Capped end
- End of line - Cleaning eye
- Inline cleaning eye
- Main line
- Service Line

WASTEWATER SERVICES
1:2000 @ A3 - (U16-1000/52.09)

This data is derived from sources outside the control of Rotorua District Council and is for information only

All dimensions and levels should be verified by physical location on-site.

Rotorua District Council 2006. Facsimile 07 346 3143 Telephone 07 348 4199 email mail@rdc.govt.nz

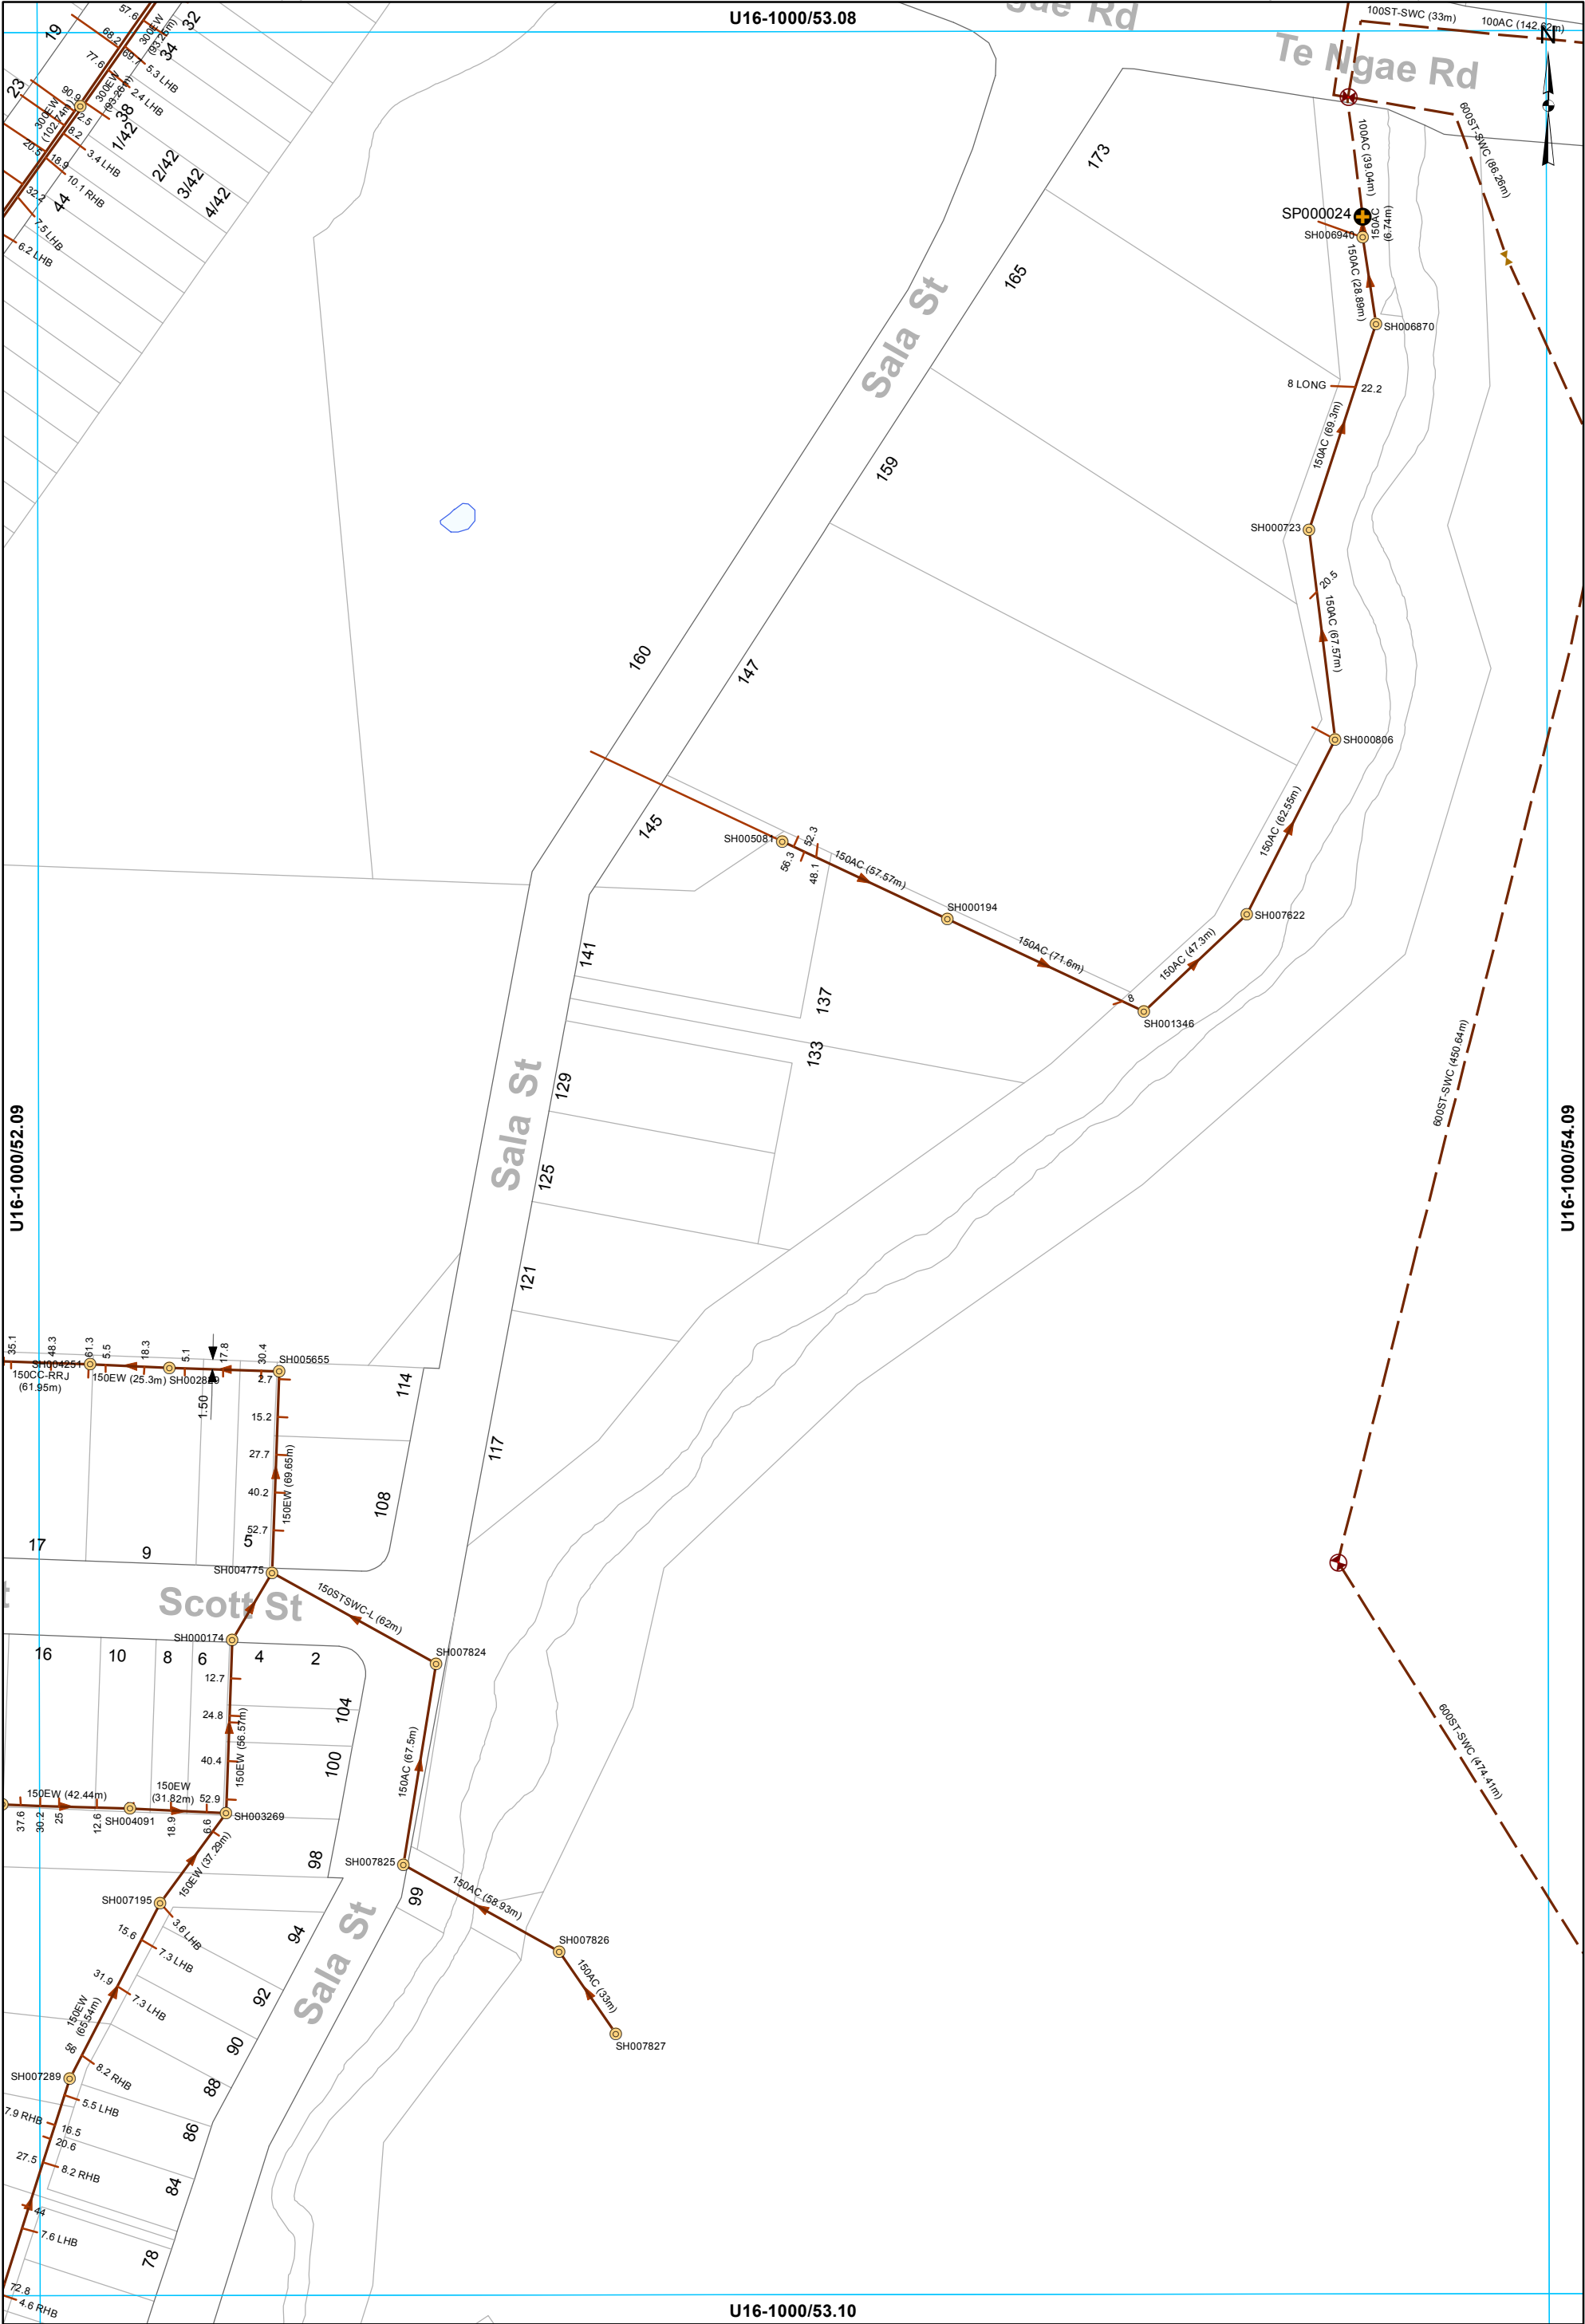


- Manhole
- Pump Station
- Air Valve
- Isolating Valve
- Main line
- Rising main
- Service Line

WASTEWATER SERVICES
1:2000 @ A3 - (U16-1000/53.09)

This data is derived from sources outside the control of Rotorua District Council and is for information only

All dimensions and levels should be verified by physical location on-site.

 Rotorua District Council 2006. Facsimilie 07 346 3143 Telephone 07 348 4199 email mail@rdc.govt.nz




All dimensions and levels should be verified by physical location on-site.

This data is derived from sources outside the control of Rotorua District Council and is for information only

- | | | | | | |
|---|----------------------|---|----------------------------|---|--------------|
| | Manhole | | End of line - Capped end | | Main line |
|  | Pump Station |  | End of line - Cleaning eye |  | Rising main |
|  | Chamber - Inspection | | |  | Service Line |

WASTEWATER SERVICES
1:2000 @ A3 - (U16-1000/46.10)

U16-1000/47.09

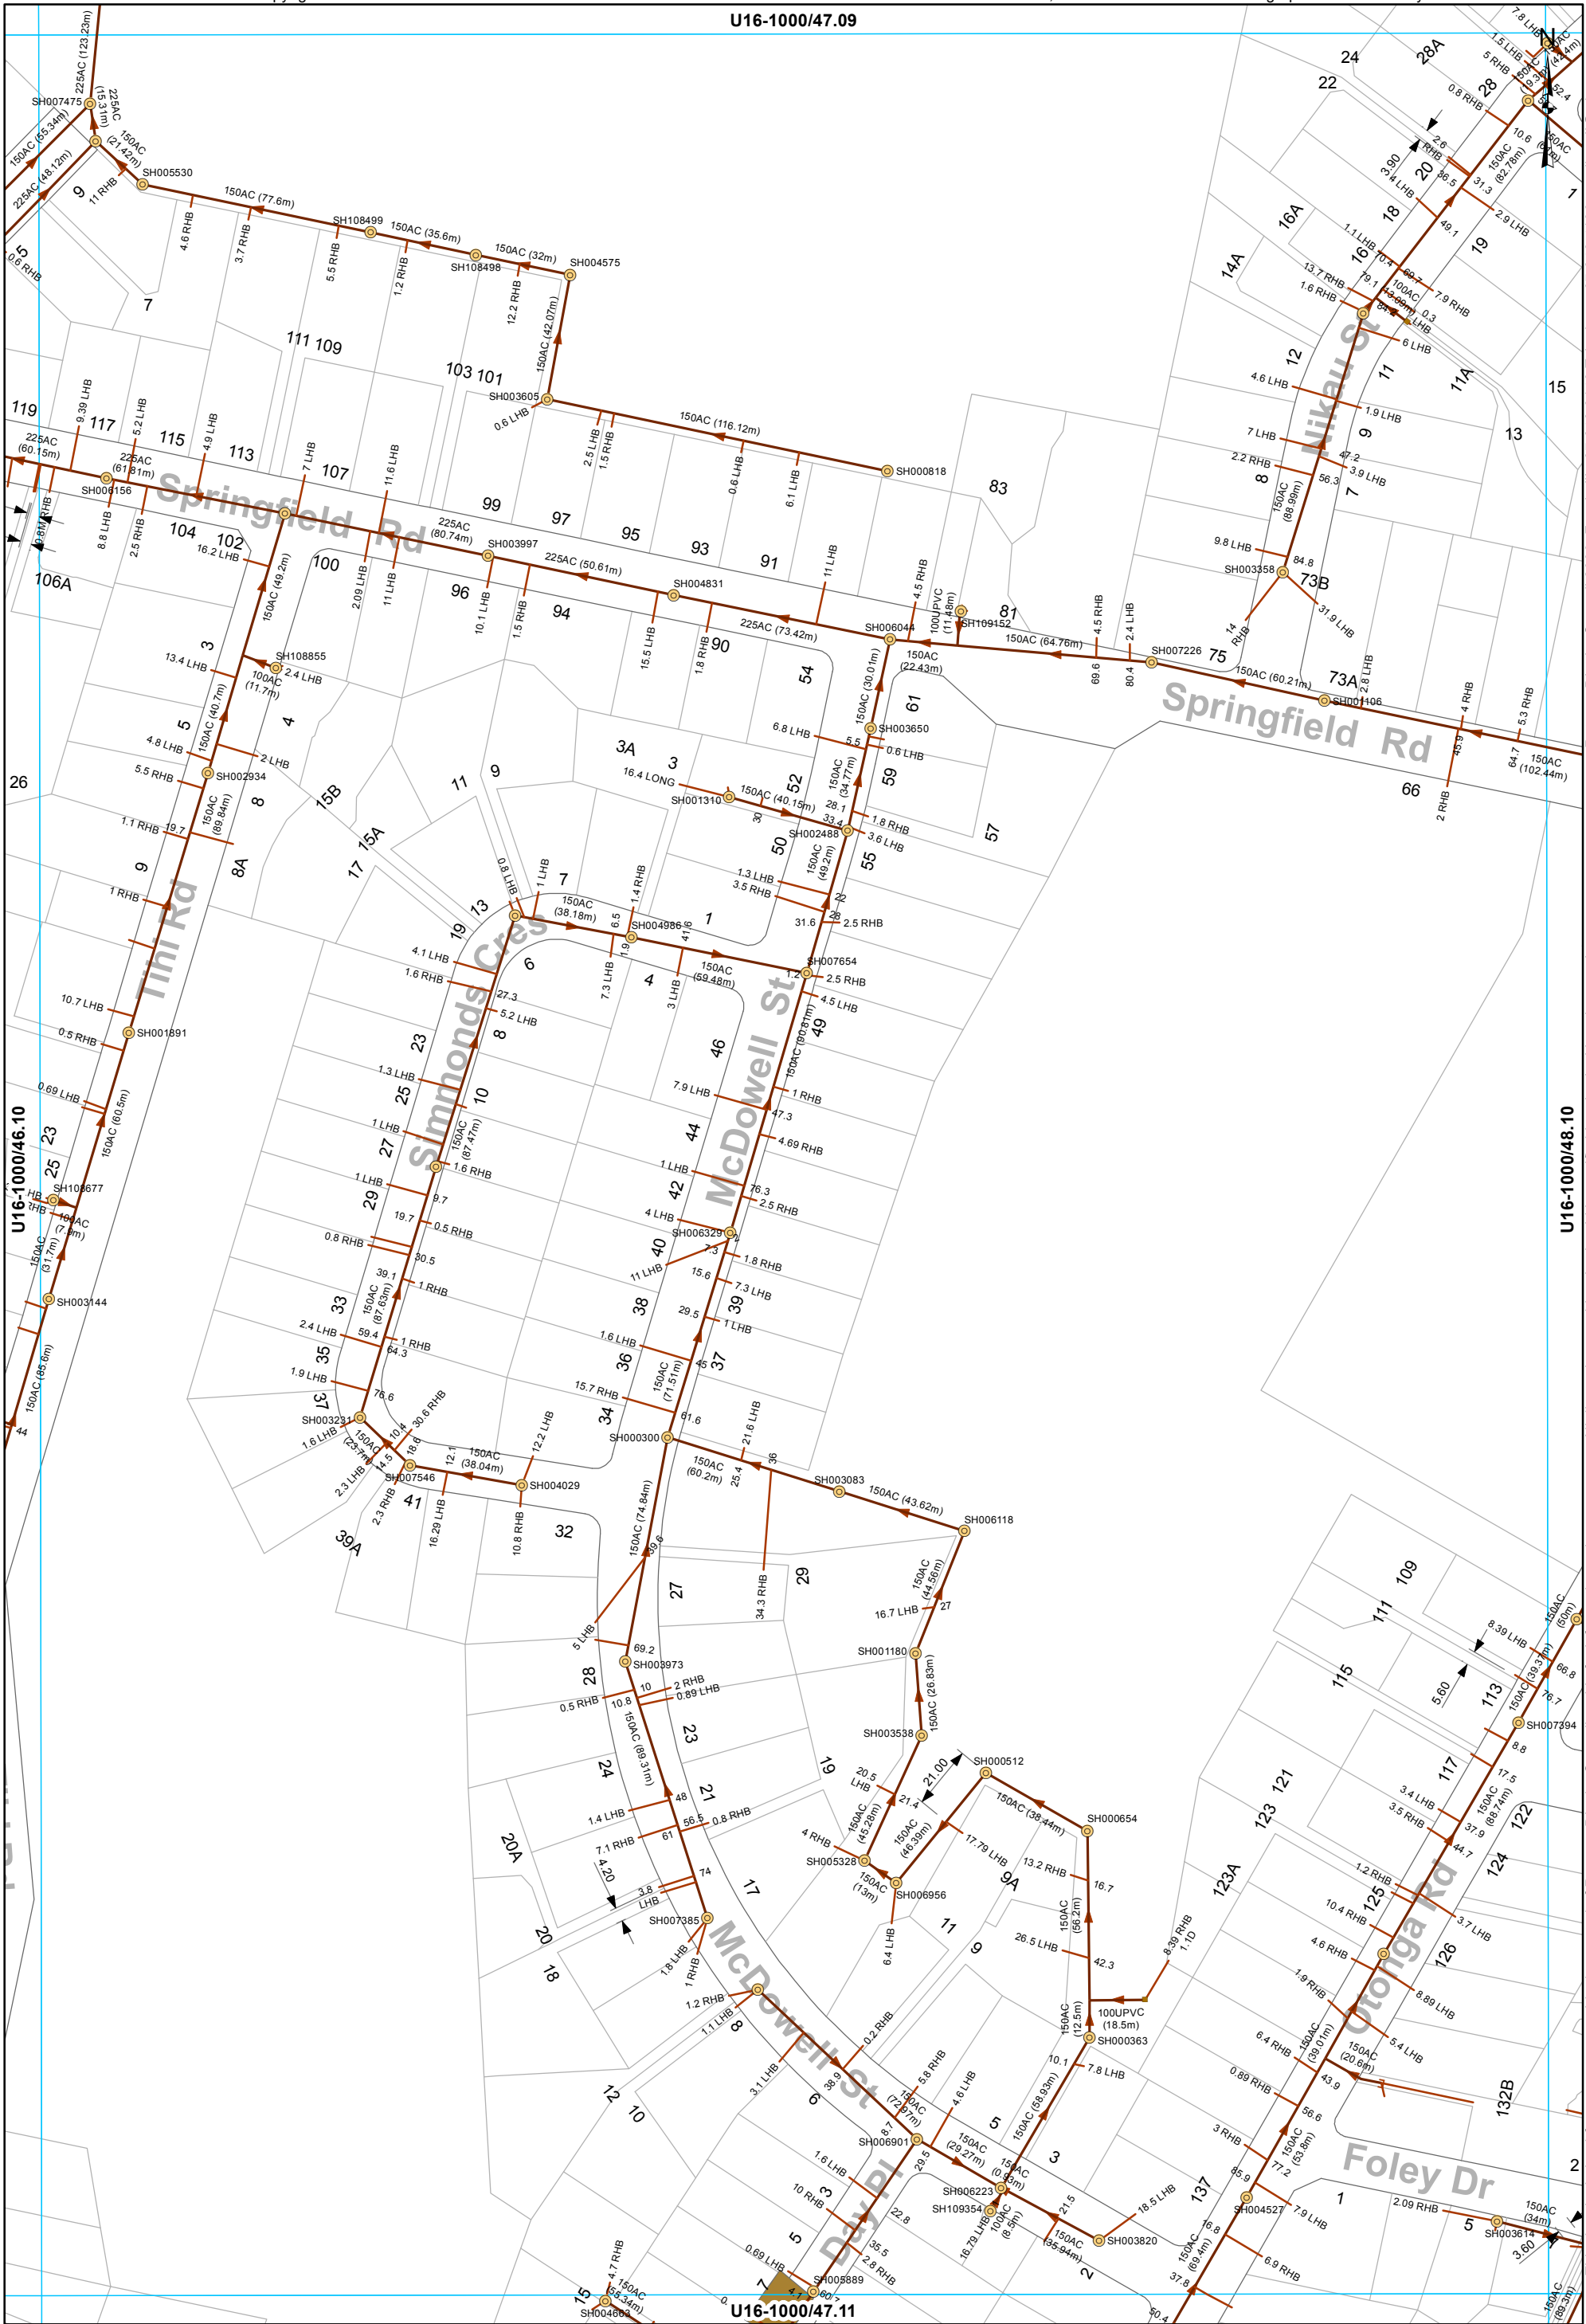


- Manhole
- Chamber - Inspection
- End of line - Capped end
- Main line
- Service Line

WASTEWATER SERVICES
1:2000 @ A3 - (U16-1000/47.10)

All dimensions and levels should be verified by physical location on-site.

This data is derived from sources outside the control of Rotorua District Council and is for information only

Rotorua District Council 2006. Facsimile 07 346 3143 Telephone 07 348 4199 email mail@rdc.govt.nz

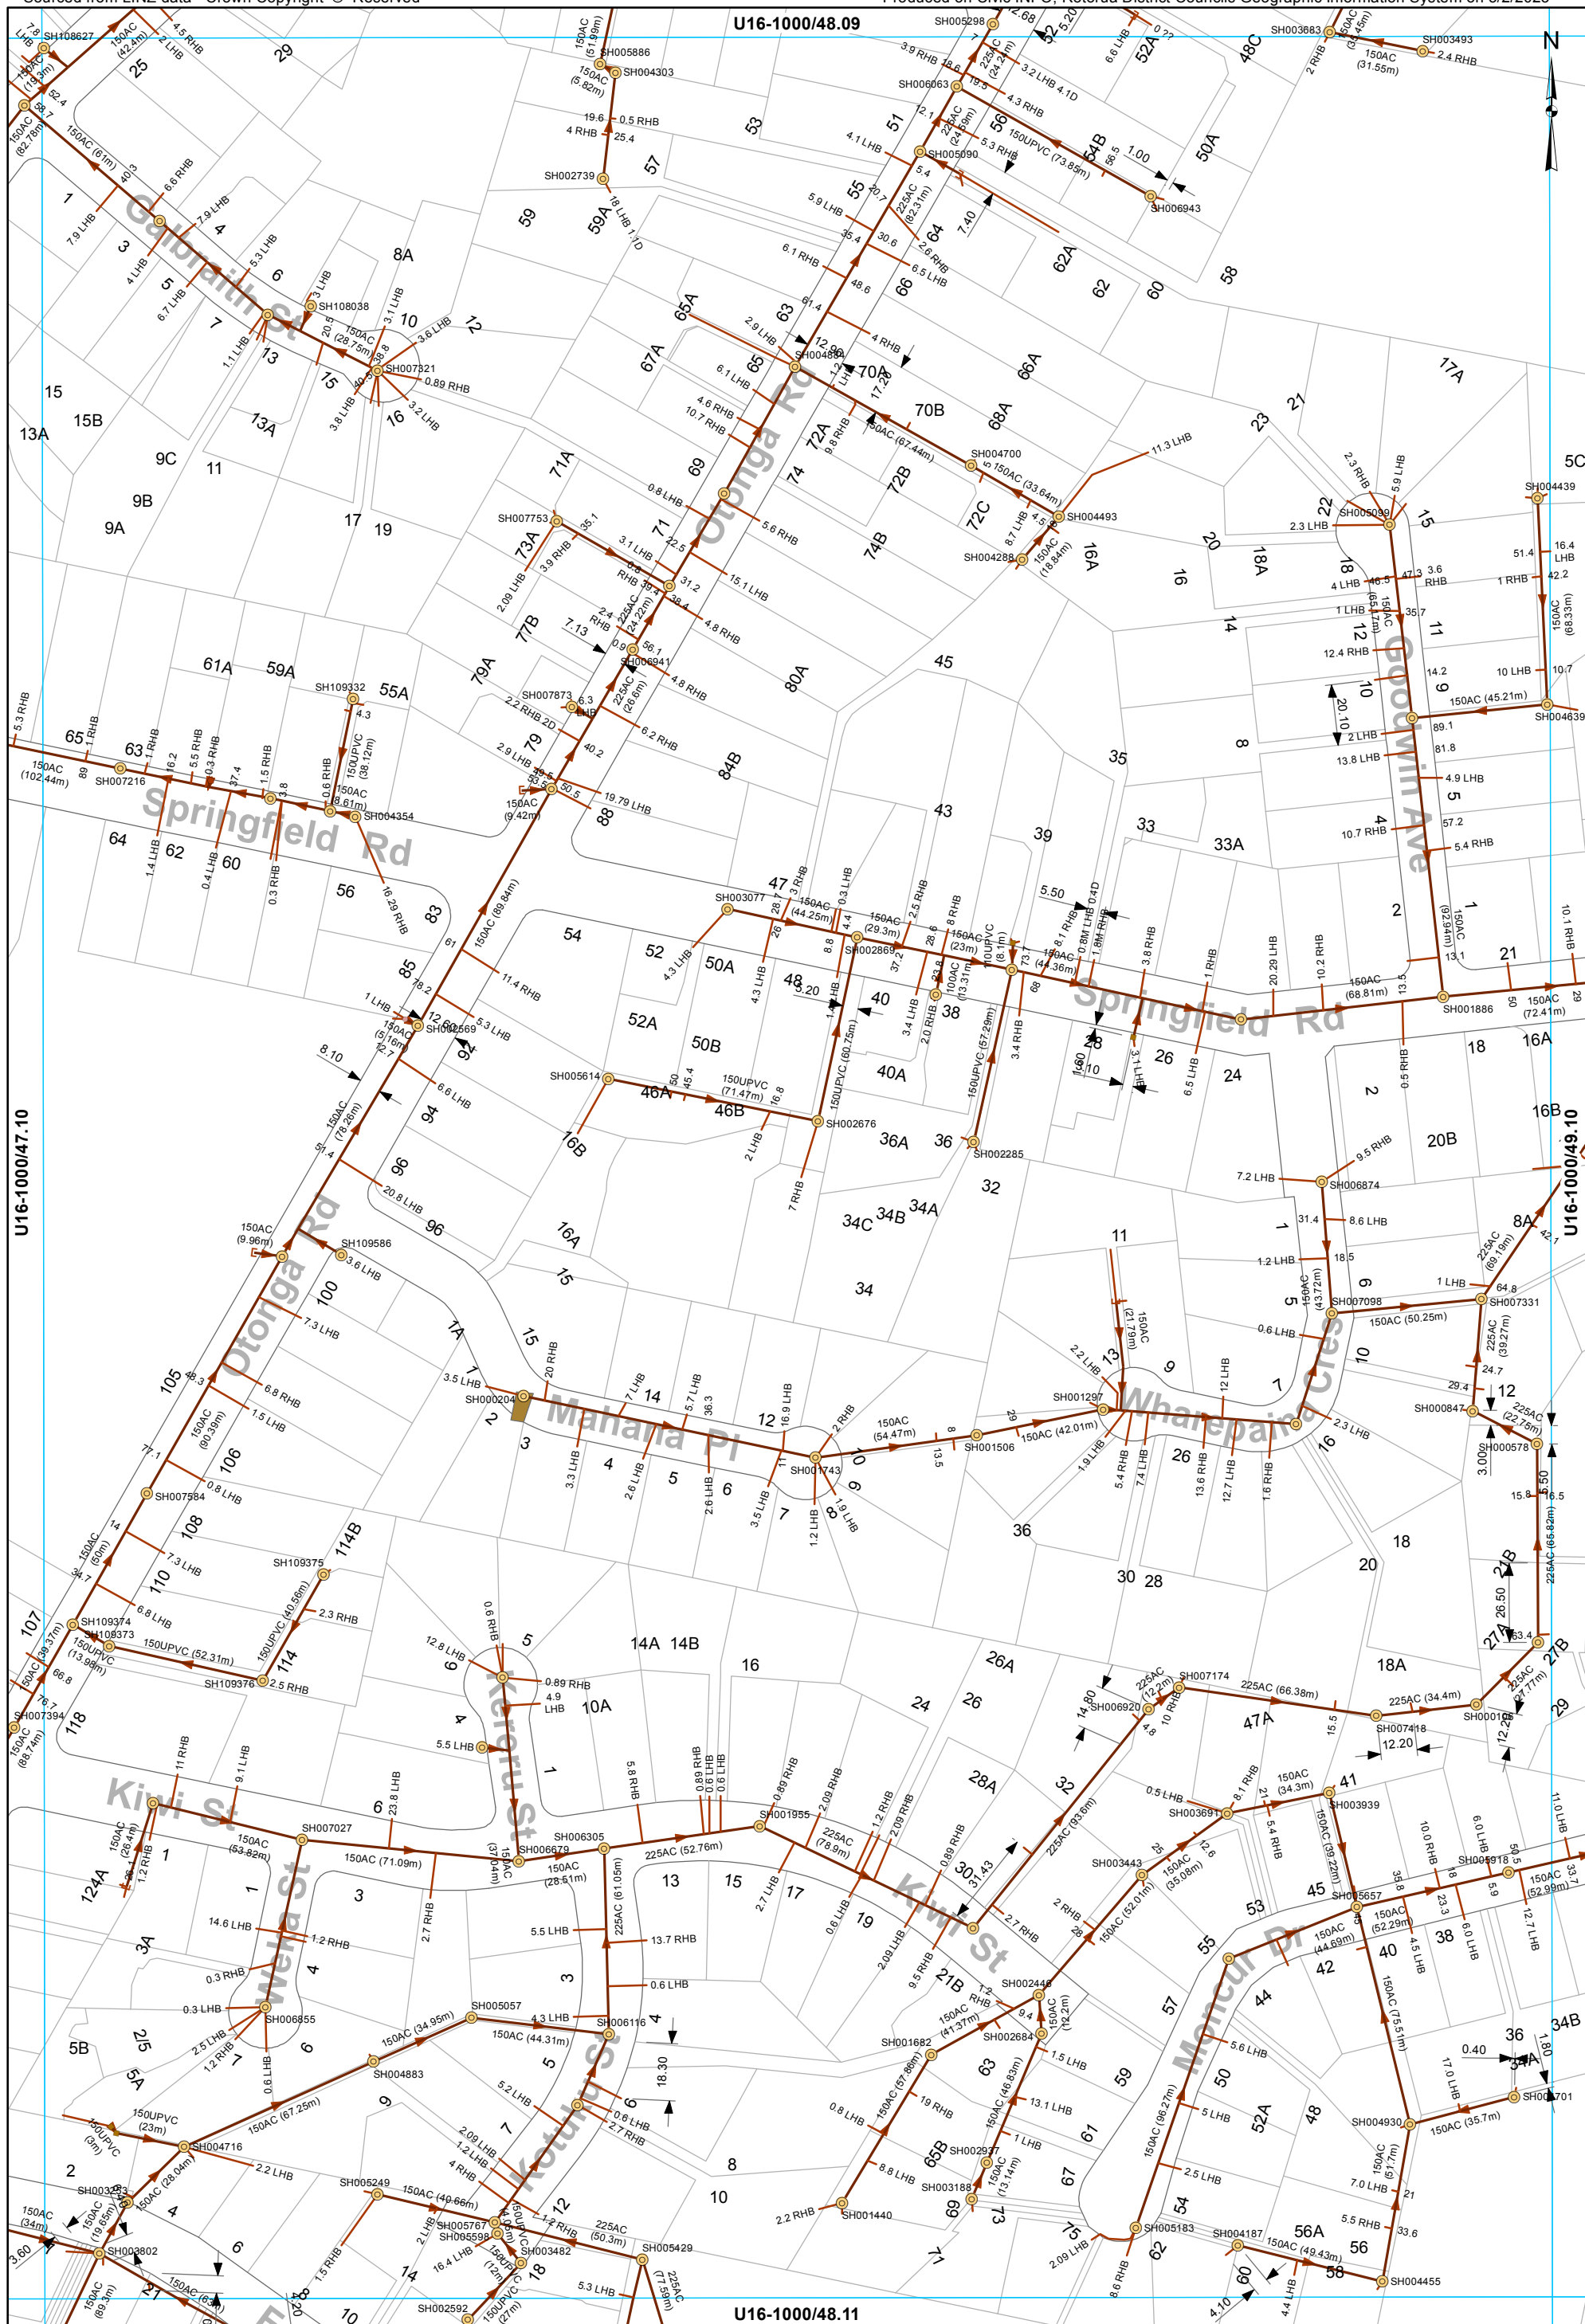


- Manhole
- Chamber - Inspection
- End of line - Capped end
- End of line - Cleaning eye
- Inspection point
- Main line
- Service Line

WASTEWATER SERVICES
1:2000 @ A3 - (U16-1000/48.10)

This data is derived from sources outside the control of Rotorua District Council and is for information only

All dimensions and levels should be verified by physical location on-site.

Rotorua District Council 2006. Facsimile 07 346 3143 Telephone 07 348 4199 email mail@rdc.govt.nz

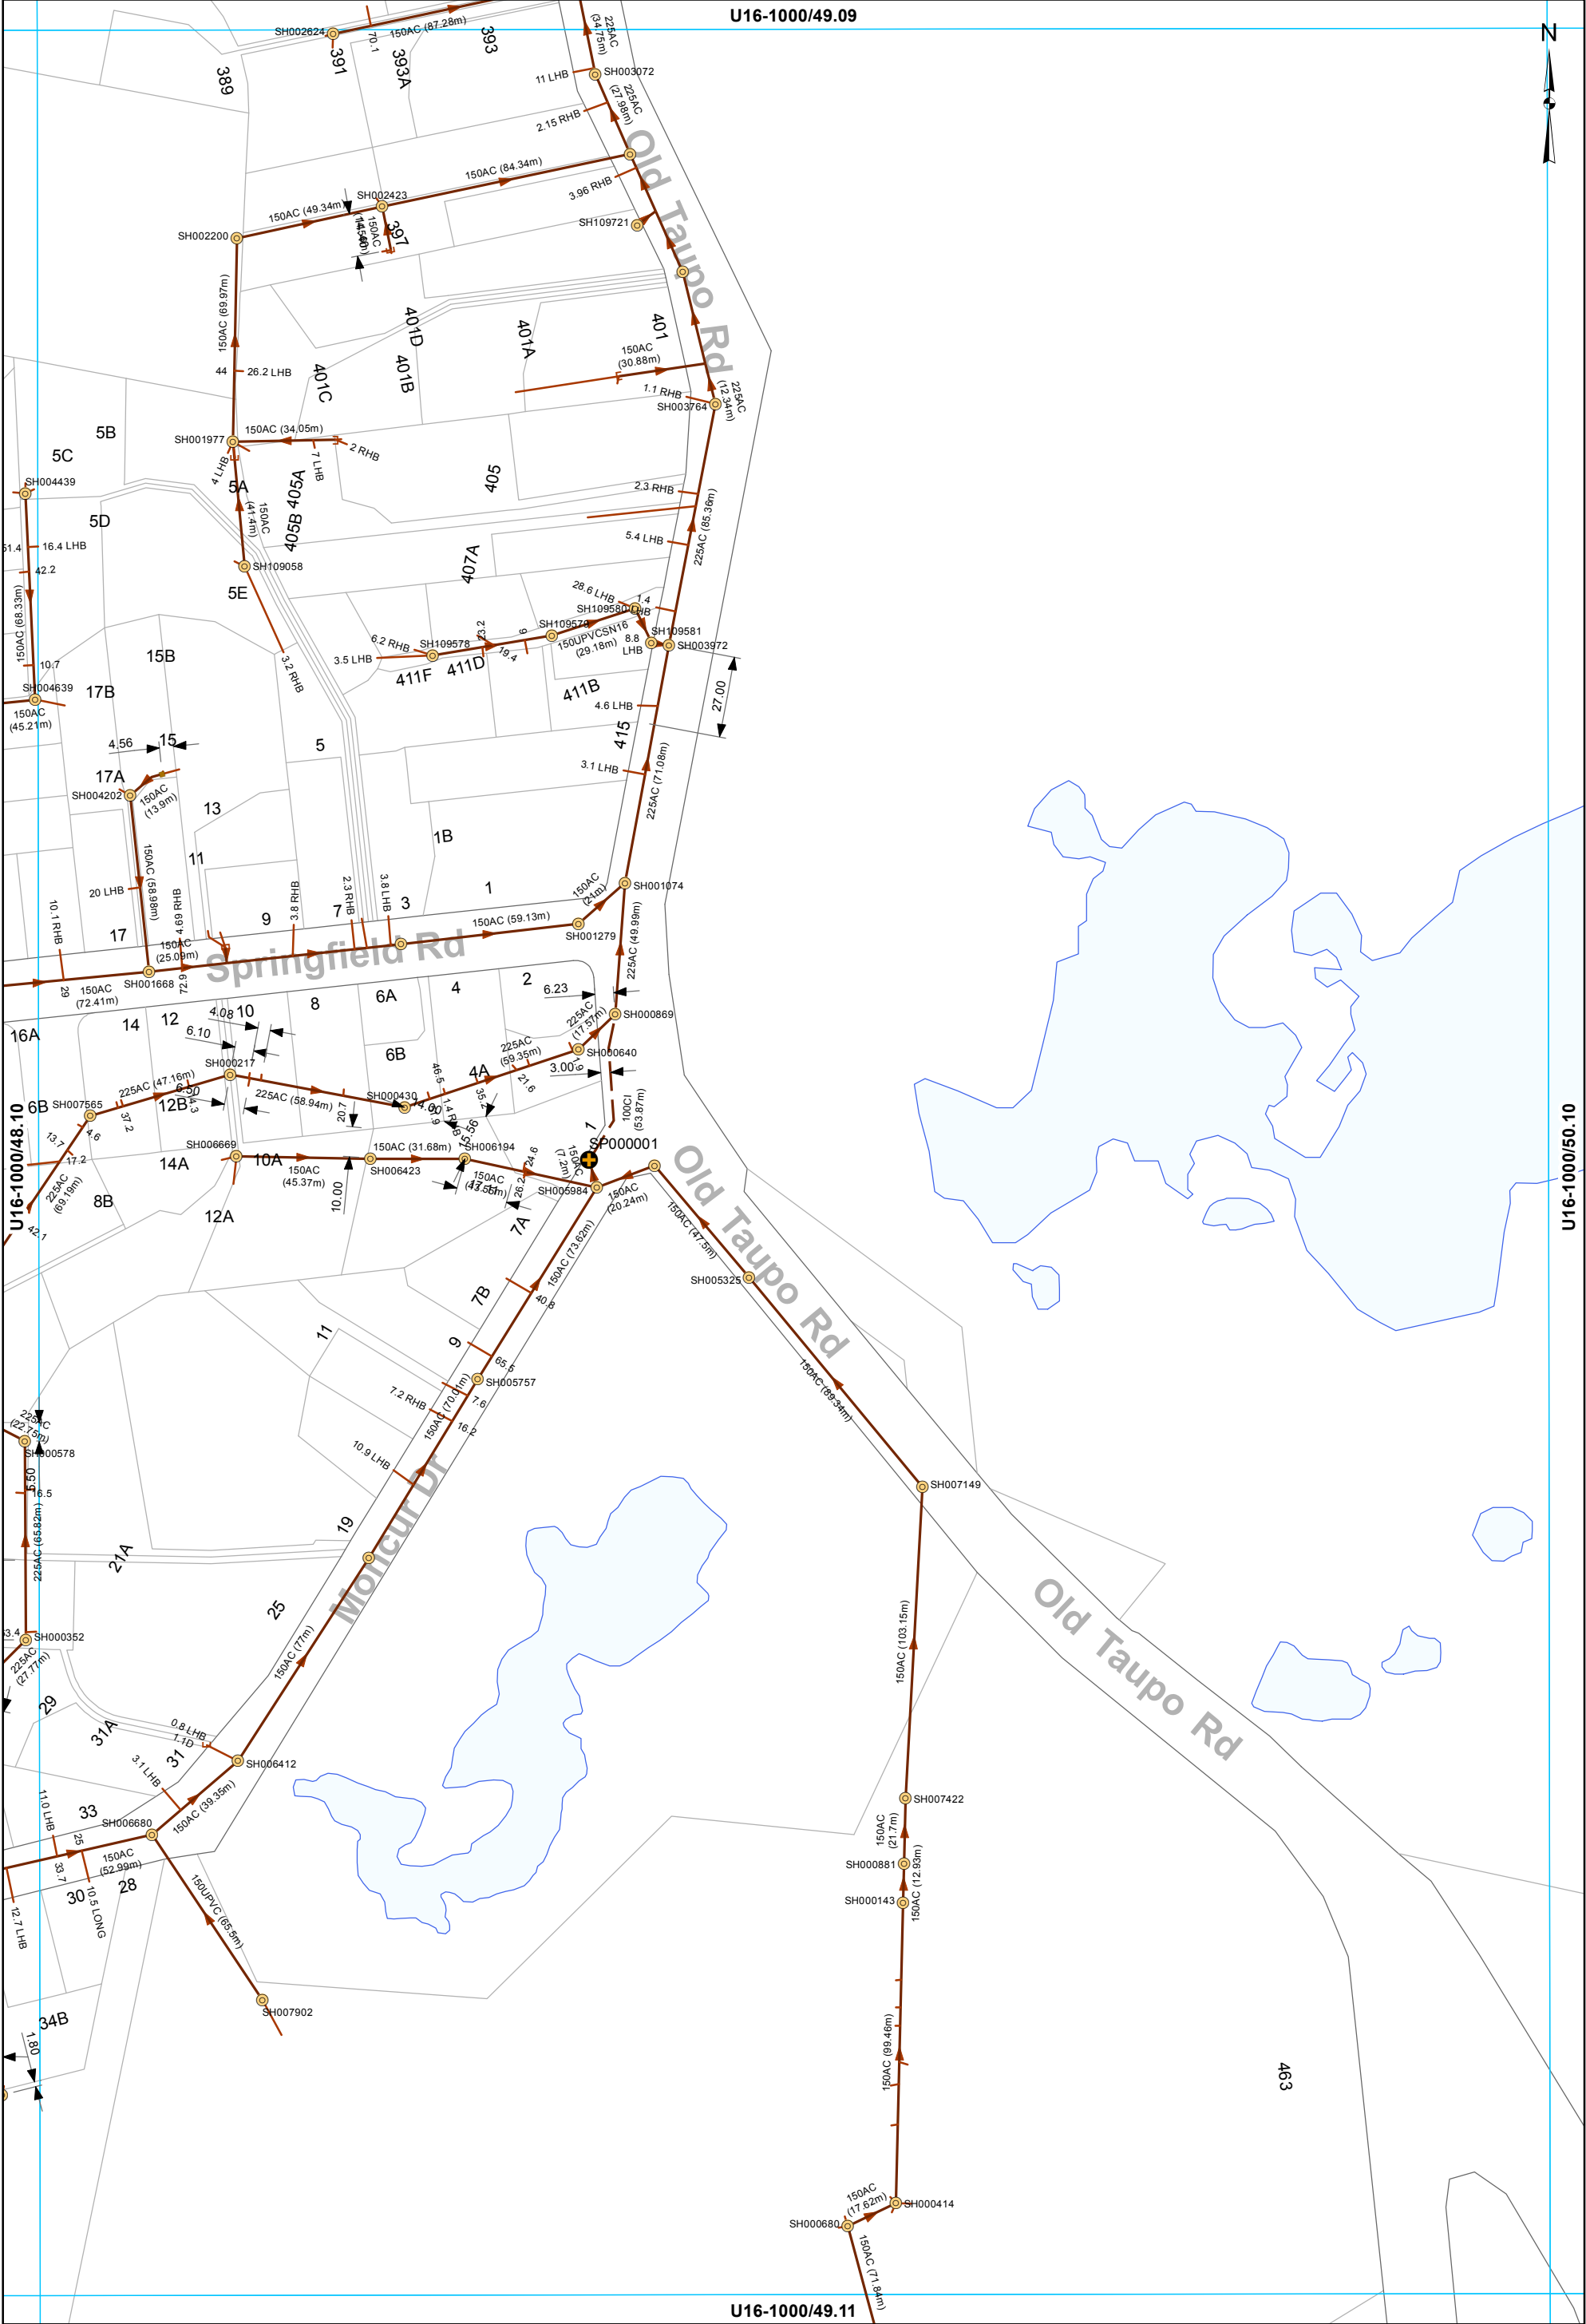

-  Manhole

 Pump Station

 Chamber - Inspection
-  End of line - Capped end

 Main line

 Rising main


 Service Line

WASTEWATER SERVICES
1:2000 @ A3 - (U16-1000/49.10)

This data is derived from sources outside the control of Rotorua District Council and is for information only

All dimensions and levels should be verified by physical location on-site.

Rotorua District Council 2006. Facsimile 07 346 3143 Telephone 07 348 4199 email mail@rdc.govt.nz

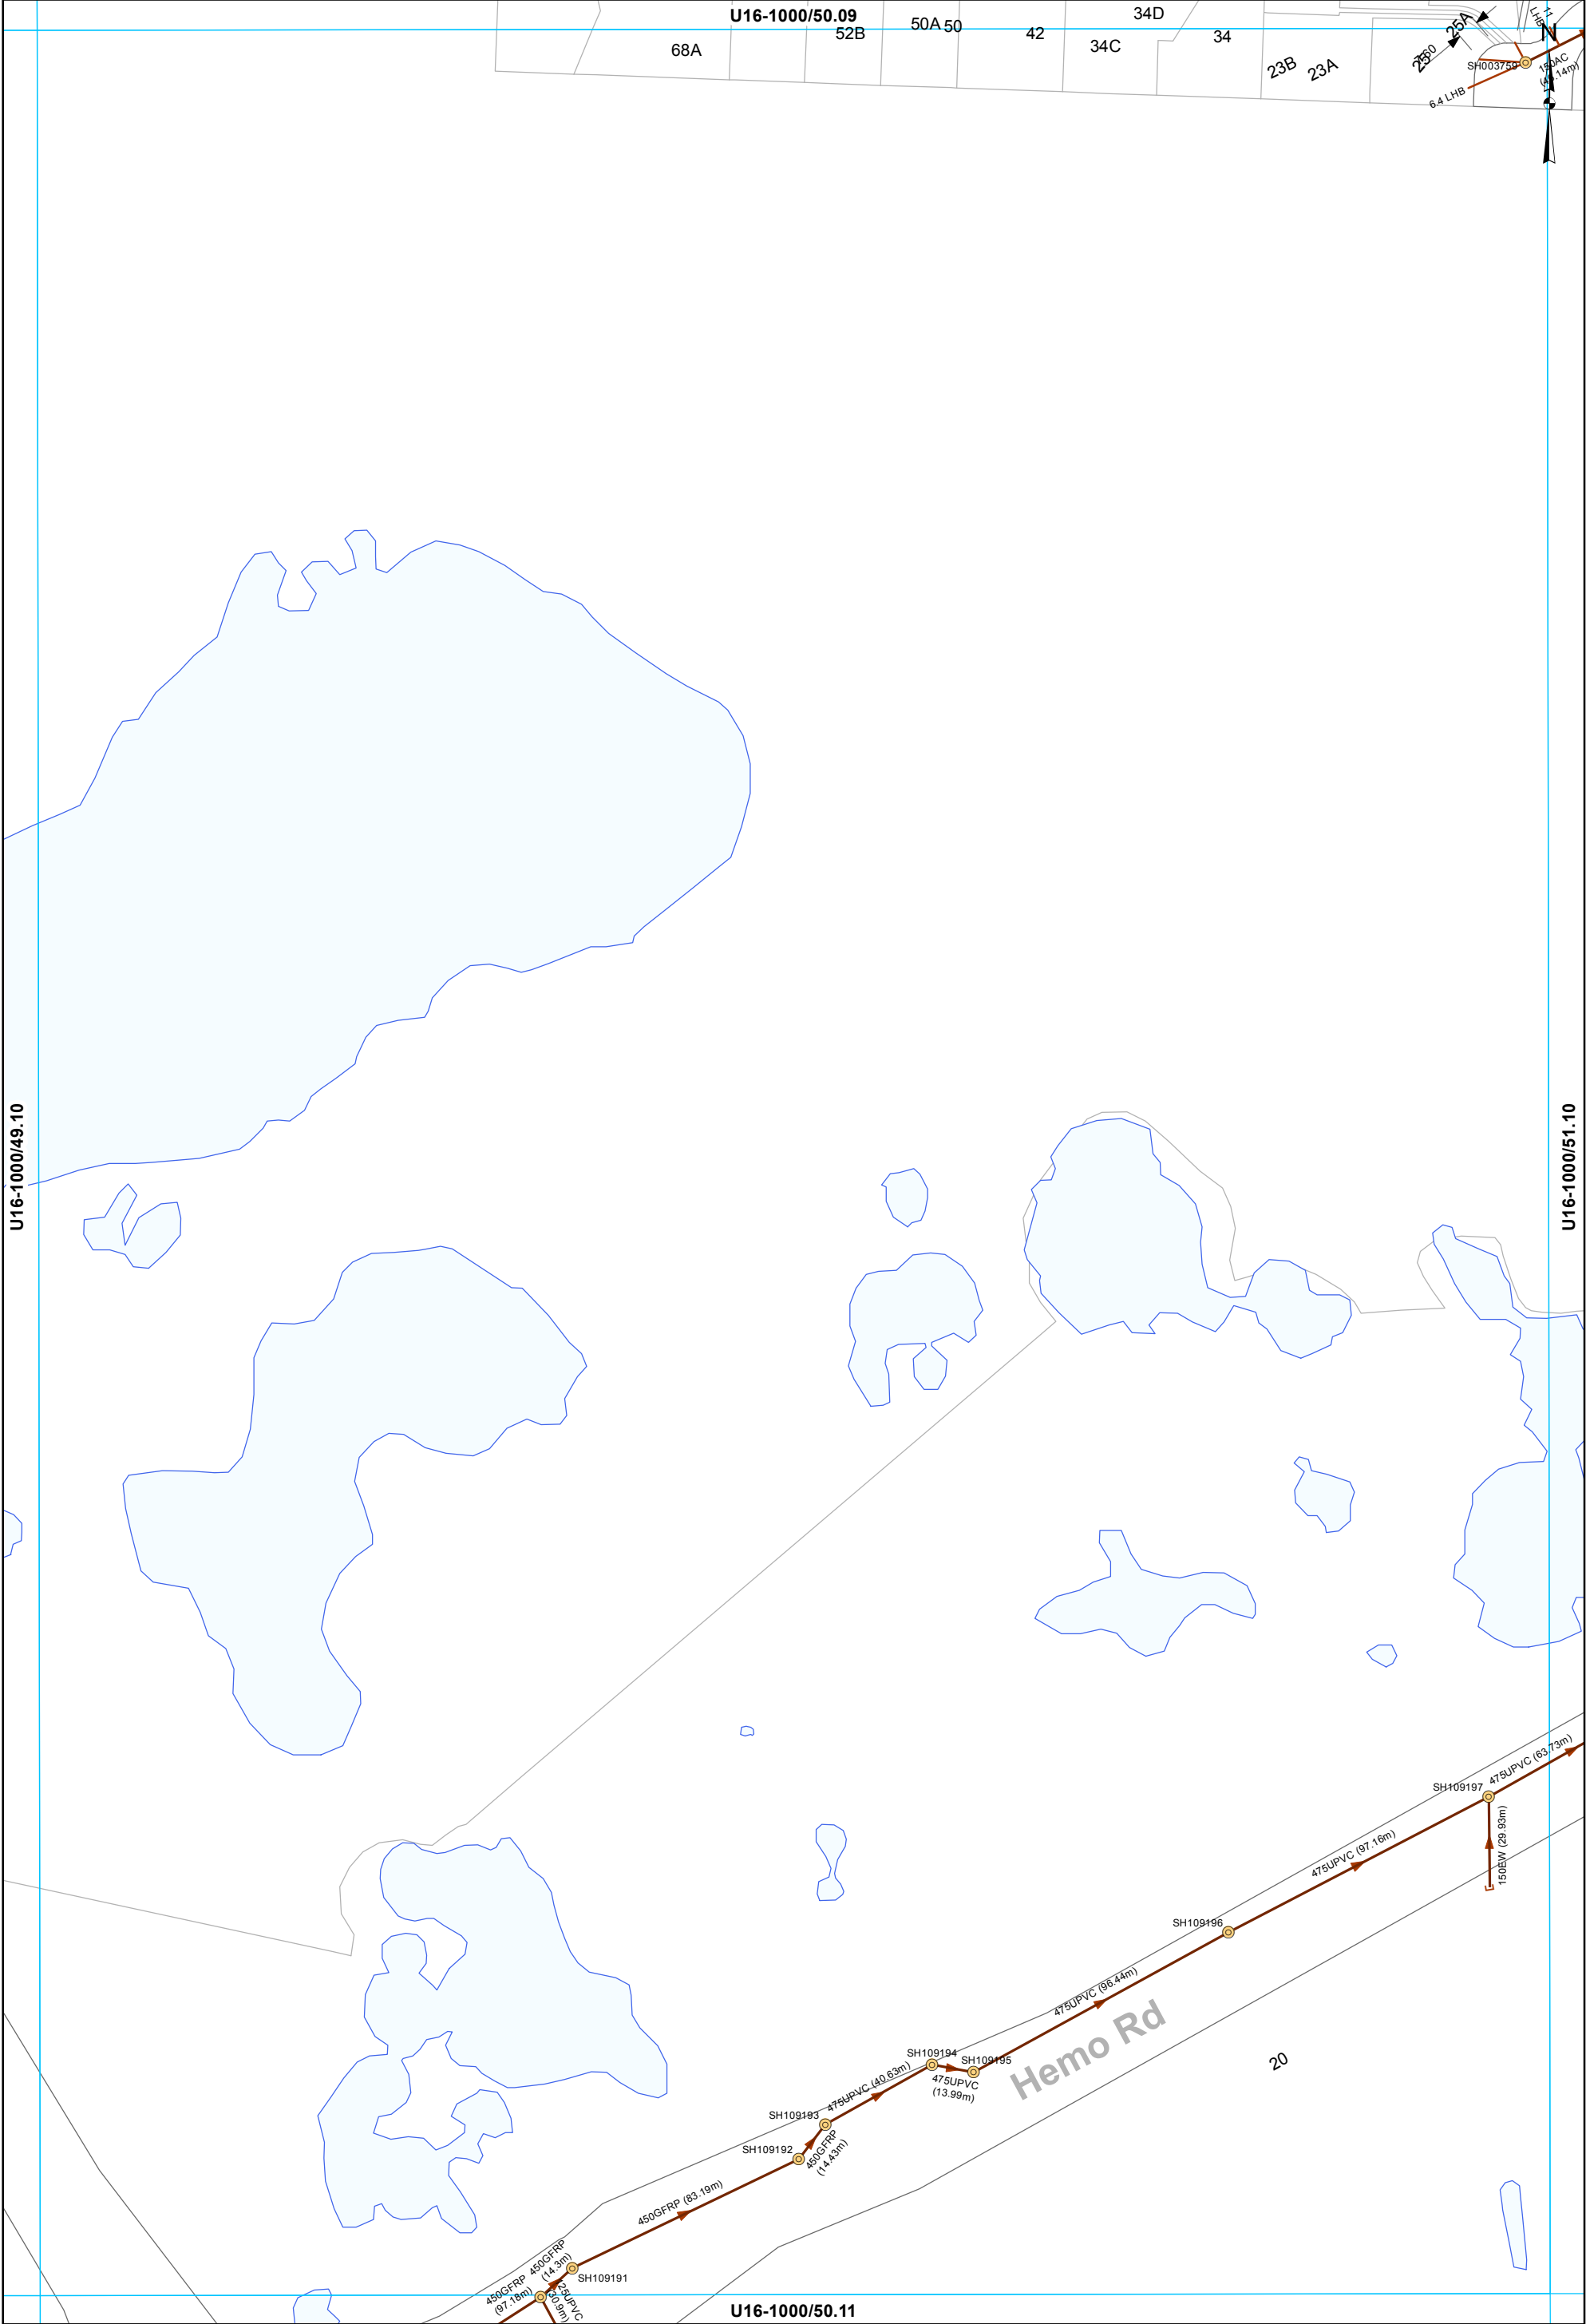

- Manhole
- Main line
- End of line - Capped end
- Service Line


WASTEWATER SERVICES
1:2000 @ A3 - (U16-1000/50.10)

This data is derived from sources outside the control of Rotorua District Council and is for information only

U16-1000/51.10

All dimensions and levels should be verified by physical location on-site.

Rotorua District Council 2006. Facsimile 07 346 3143 Telephone 07 348 4199 email mail@rdc.govt.nz

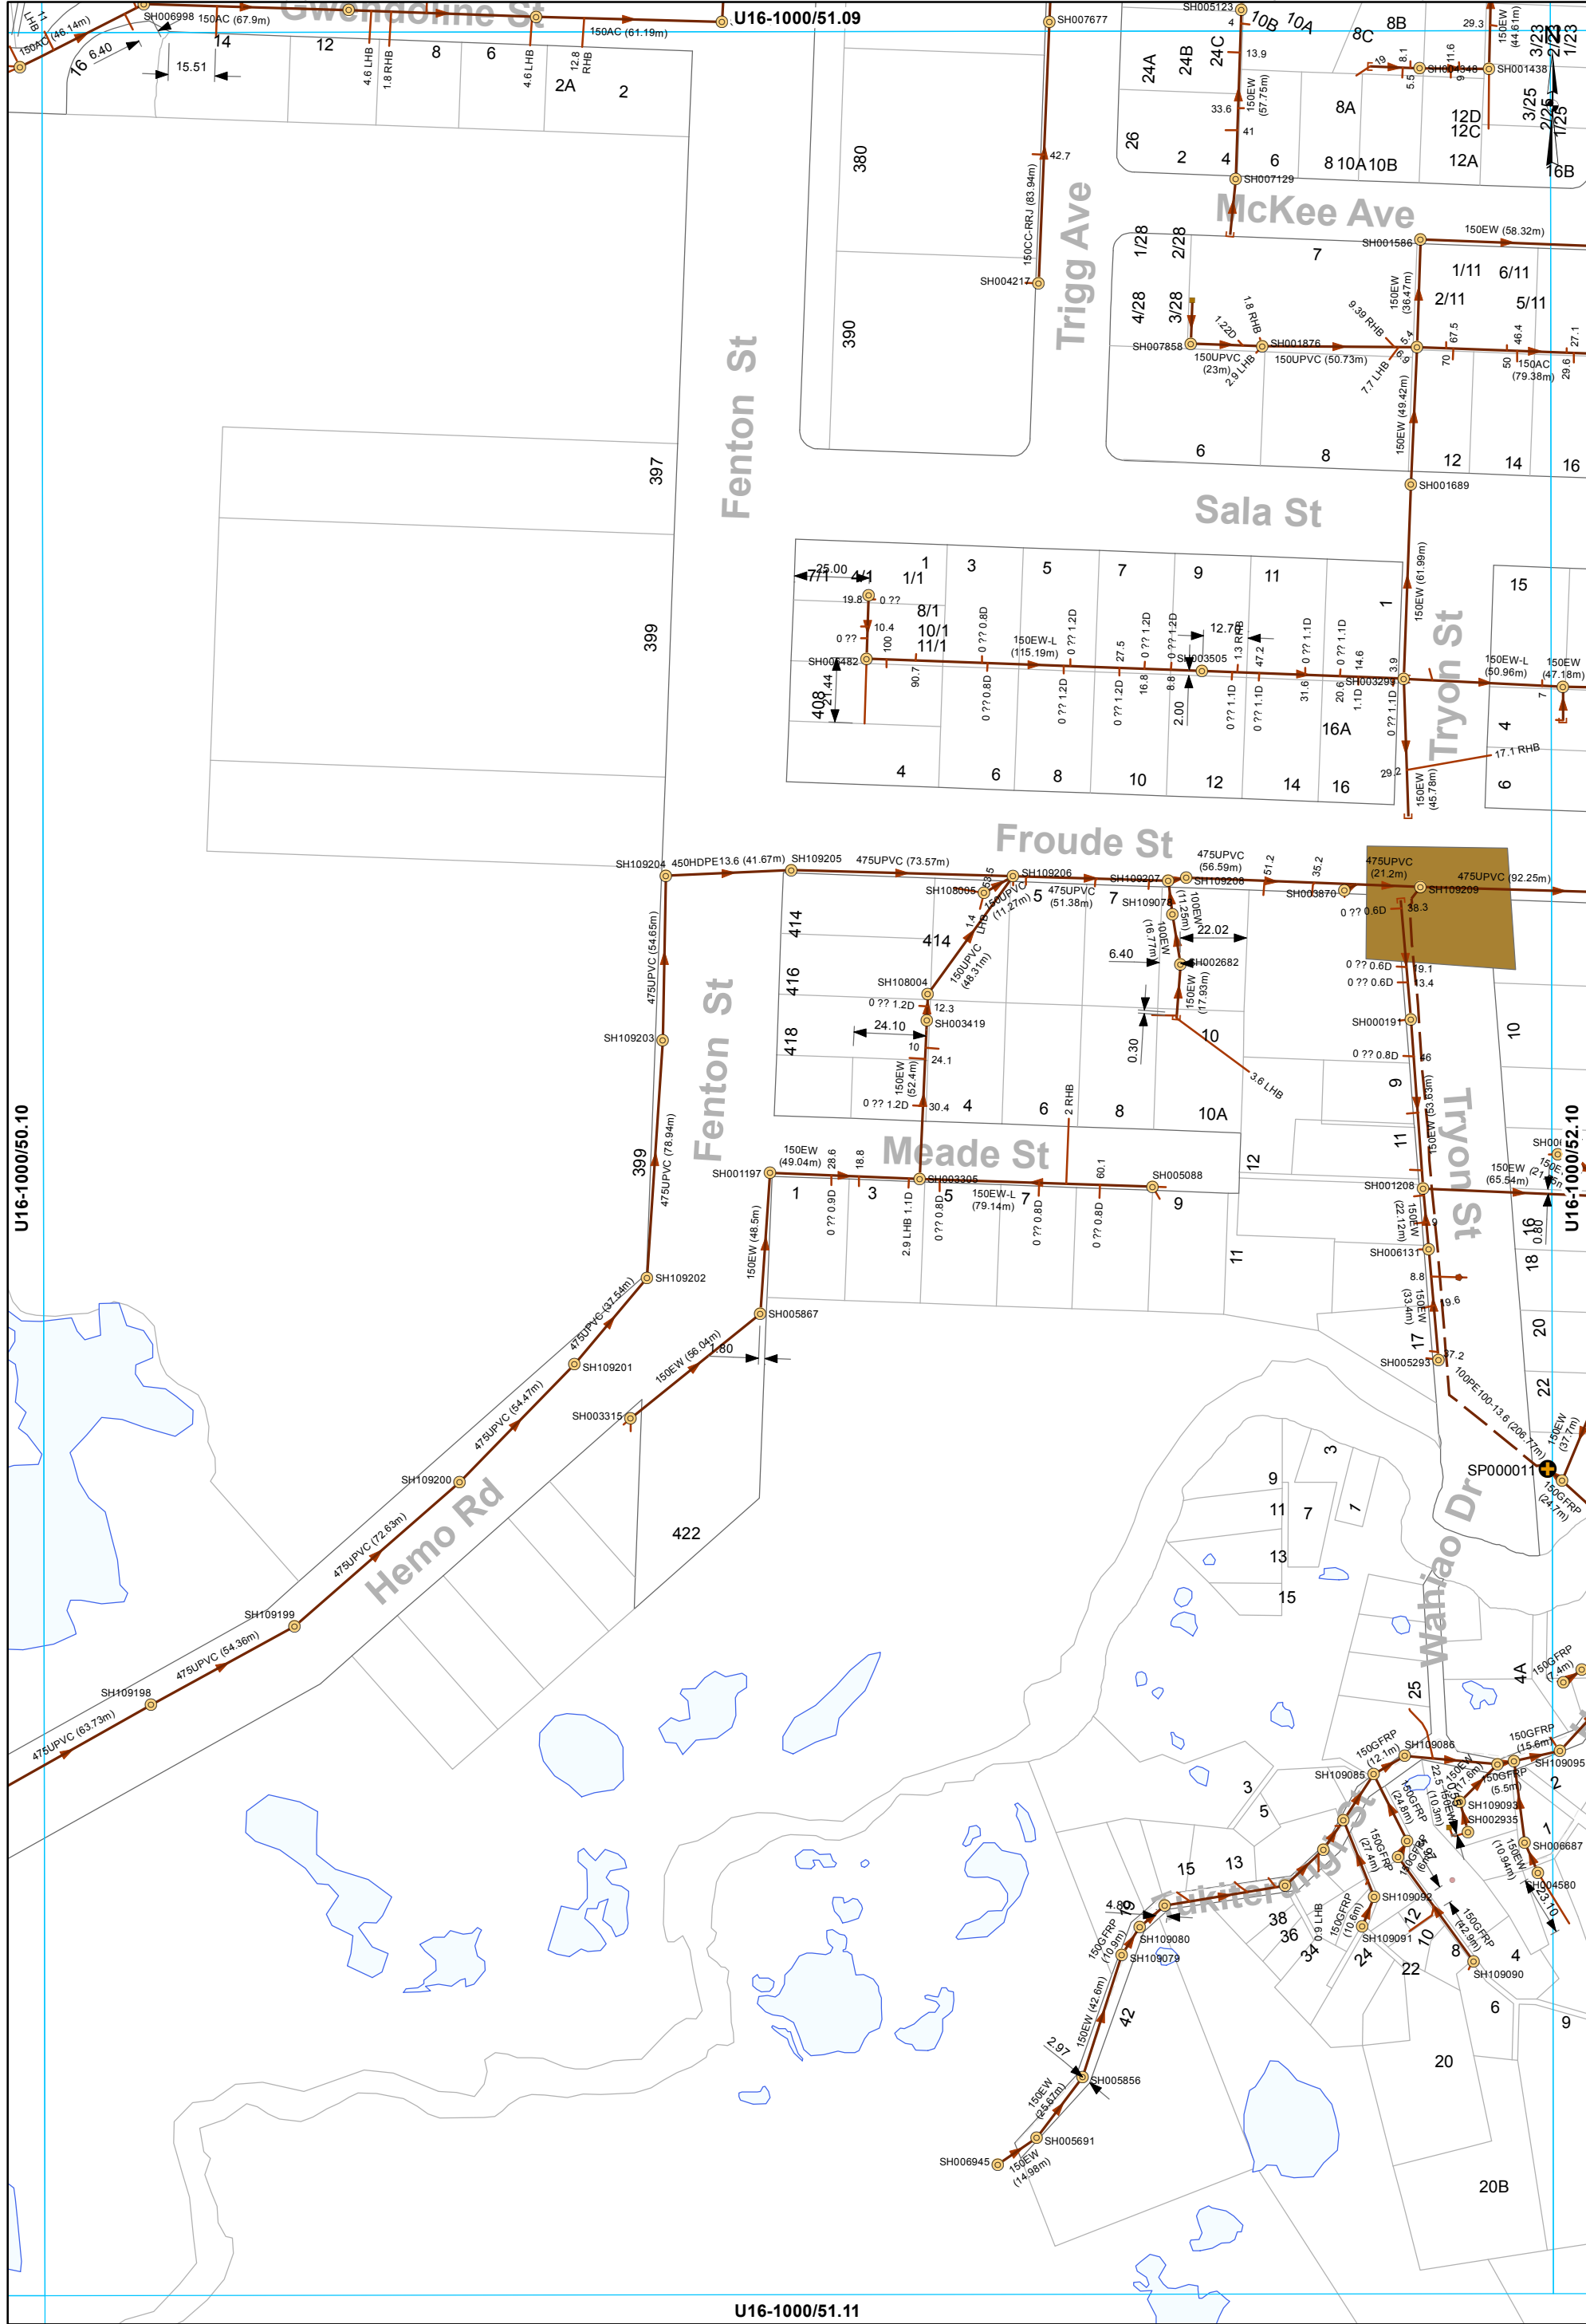


This data is derived from sources outside the control of Rotorua District Council and is for information only. All dimensions and levels should be verified by physical location on-site.

Rotorua District Council 2006. Facsimile 07 346 3143 Telephone 07 348 4199 email mail@rdc.govt.nz


- | | | |
|----------------------|----------------------------|--------------|
| Manhole | End of line - Capped end | Main line |
| Pump Station | End of line - Cleaning eye | Rising main |
| Chamber - Inspection | Inspection point | Service Line |

WASTEWATER SERVICES
1:2000 @ A3 - (U16-1000/51.10)

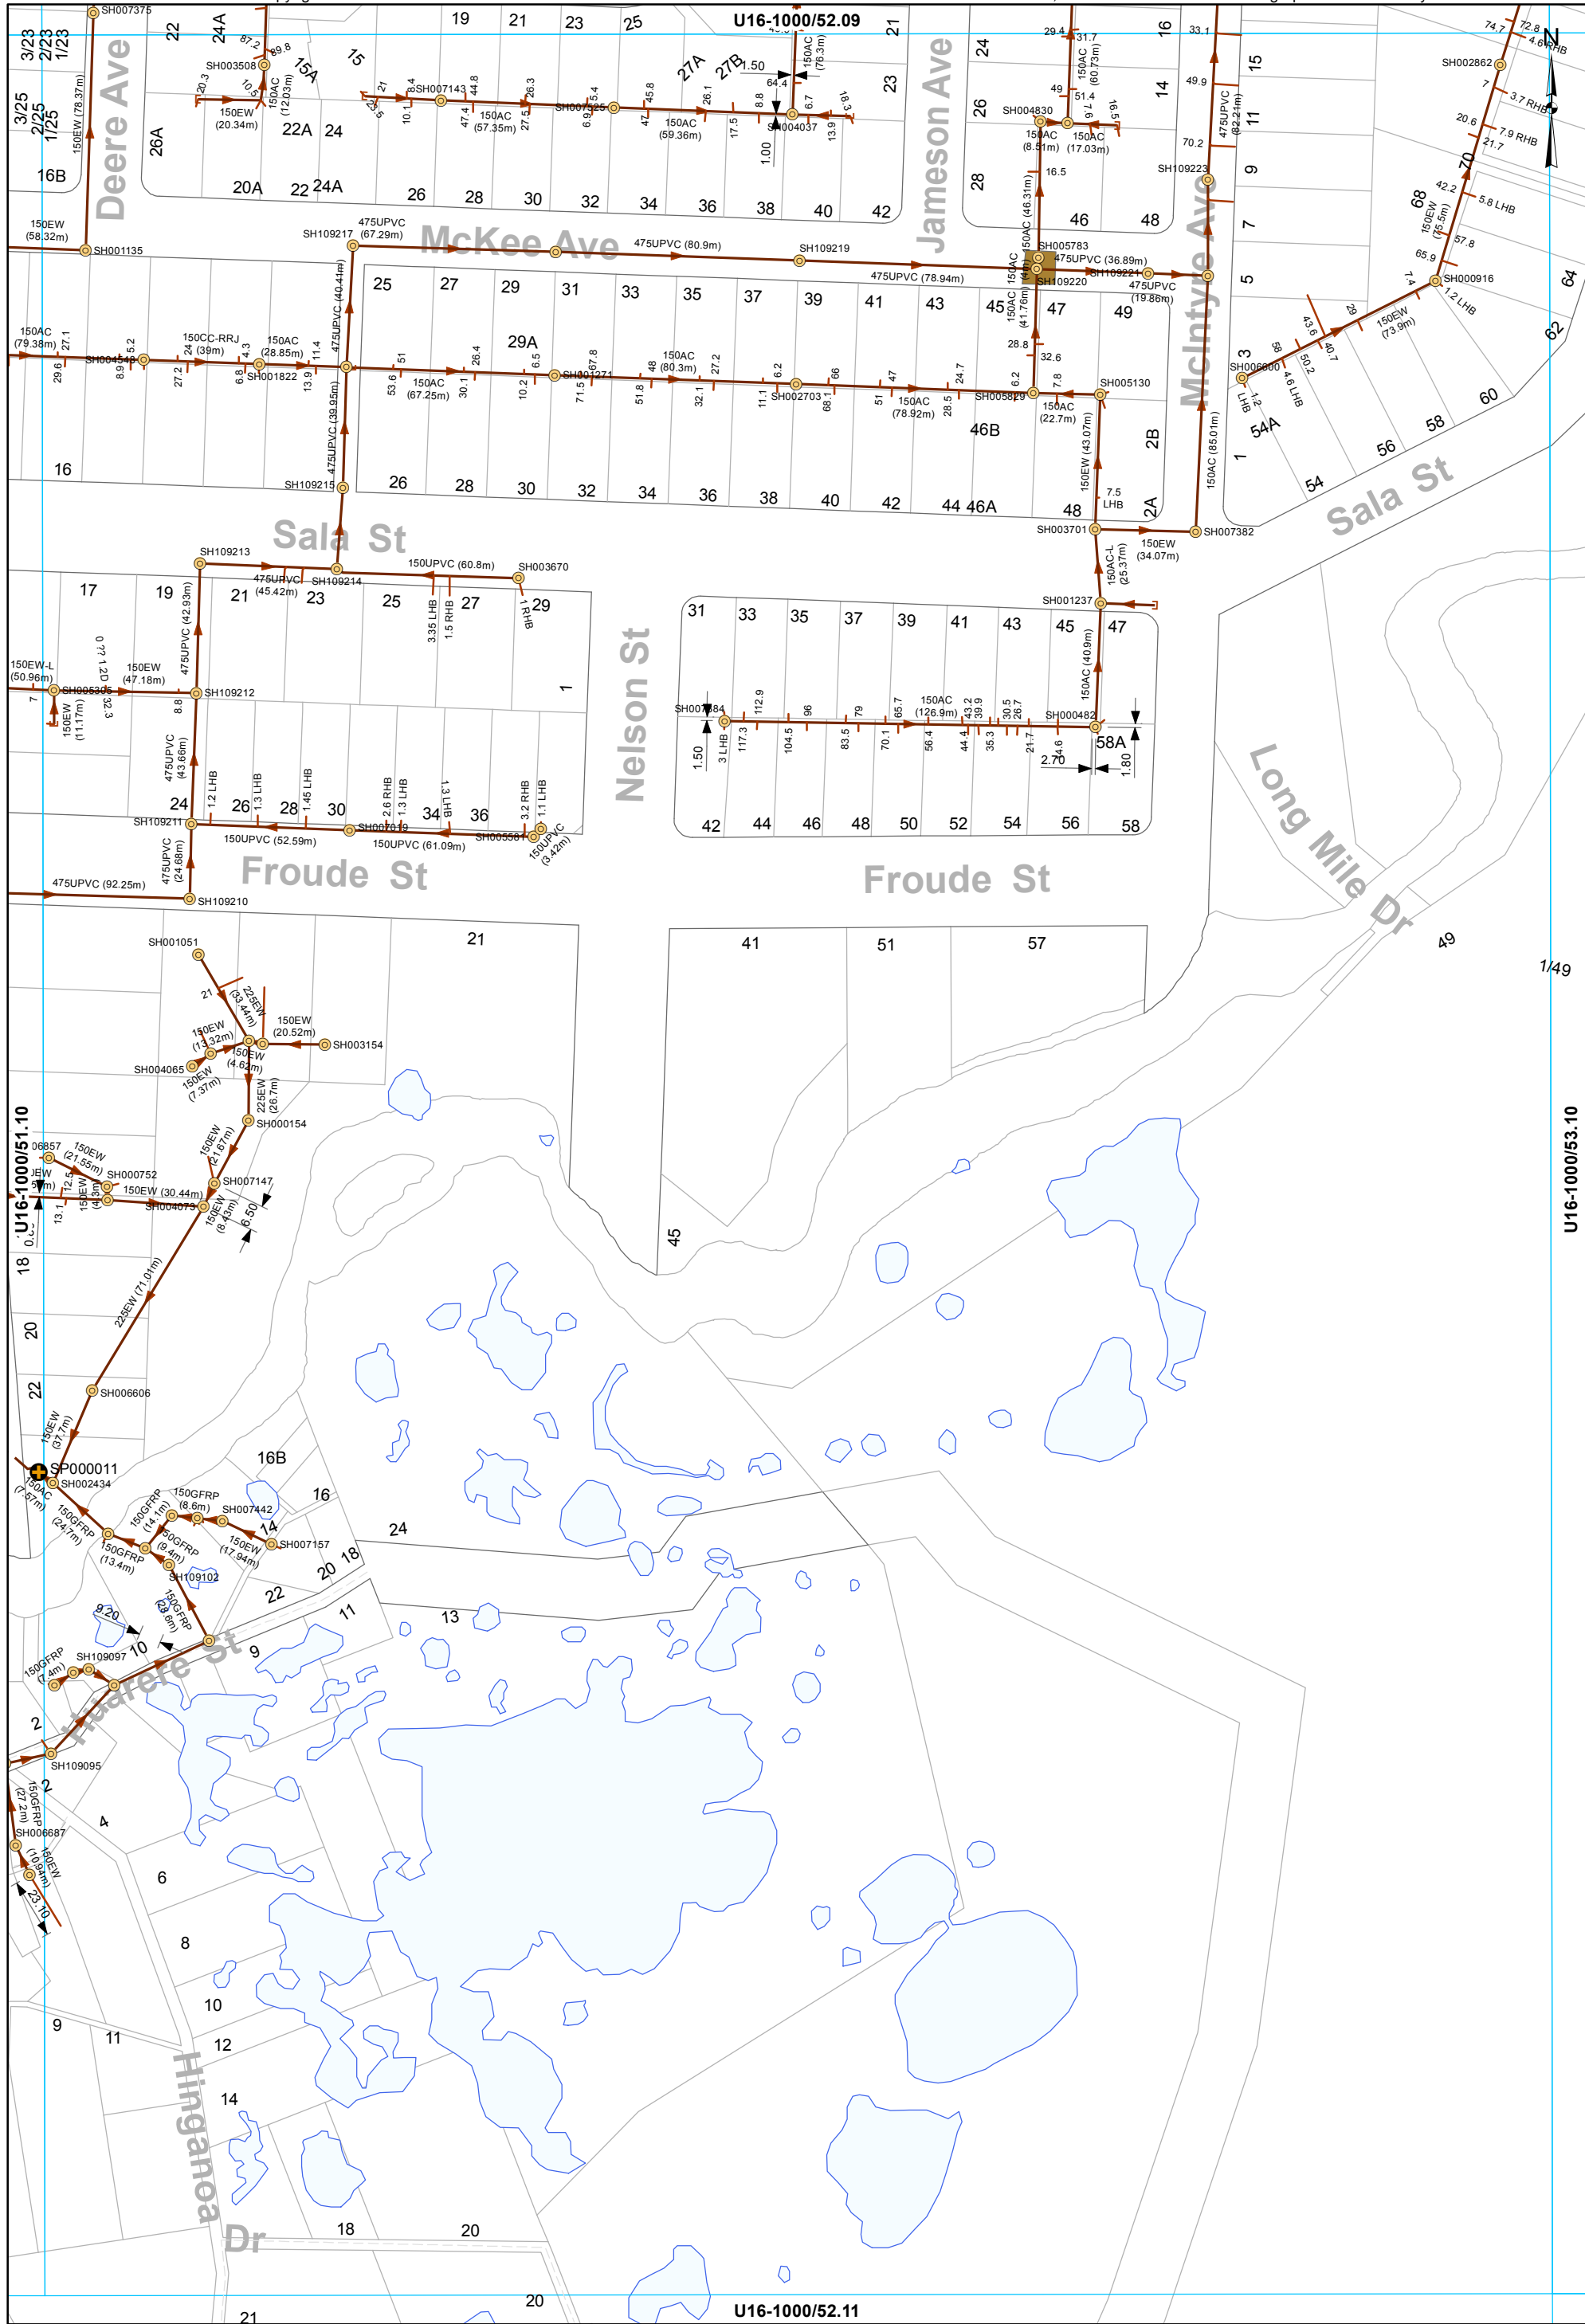

- Manhole
- Pump Station
- End of line - Capped end
- Main line
- Rising main
- Service Line

WASTEWATER SERVICES
1:2000 @ A3 - (U16-1000/52.10)

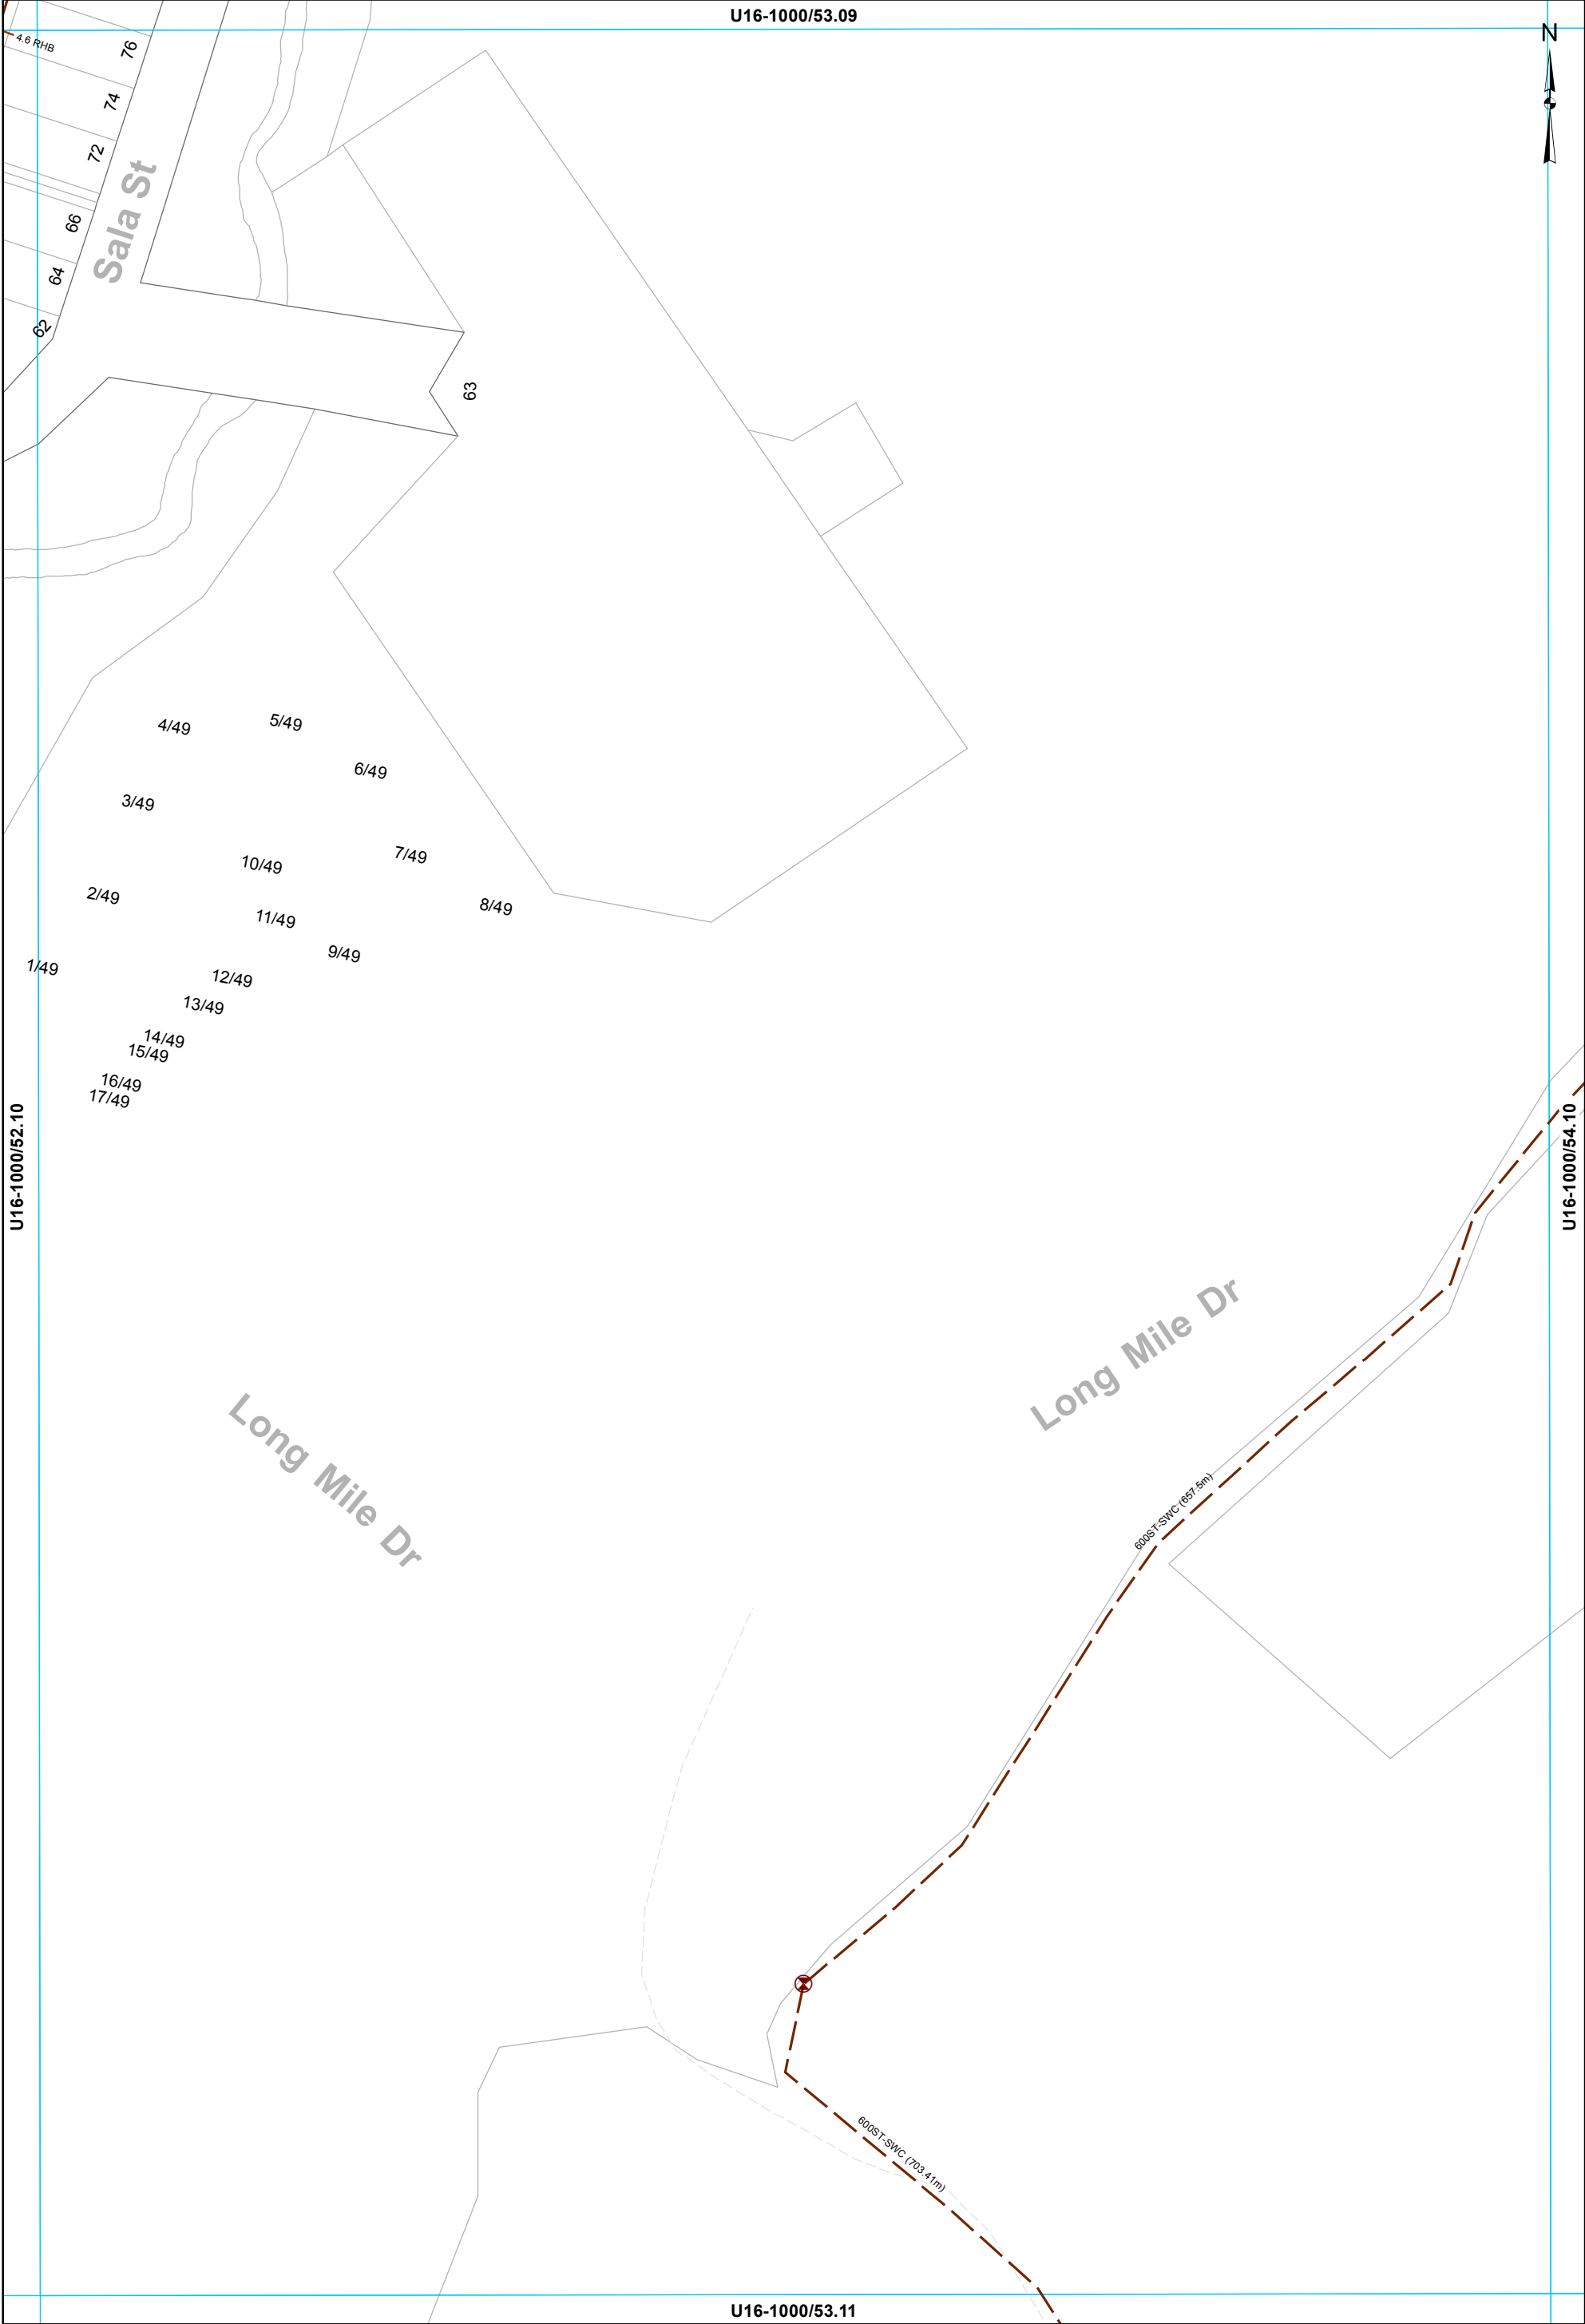


- Air Valve
- Main line
- Rising main
- Service Line

WASTEWATER SERVICES
1:2000 @ A3 - (U16-1000/53.10)

This data is derived from sources outside the control of Rotorua District Council and is for information only

Rotorua District Council 2006. Facsimile 07 346 3143 Telephone 07 348 4199 email mail@rdc.govt.nz

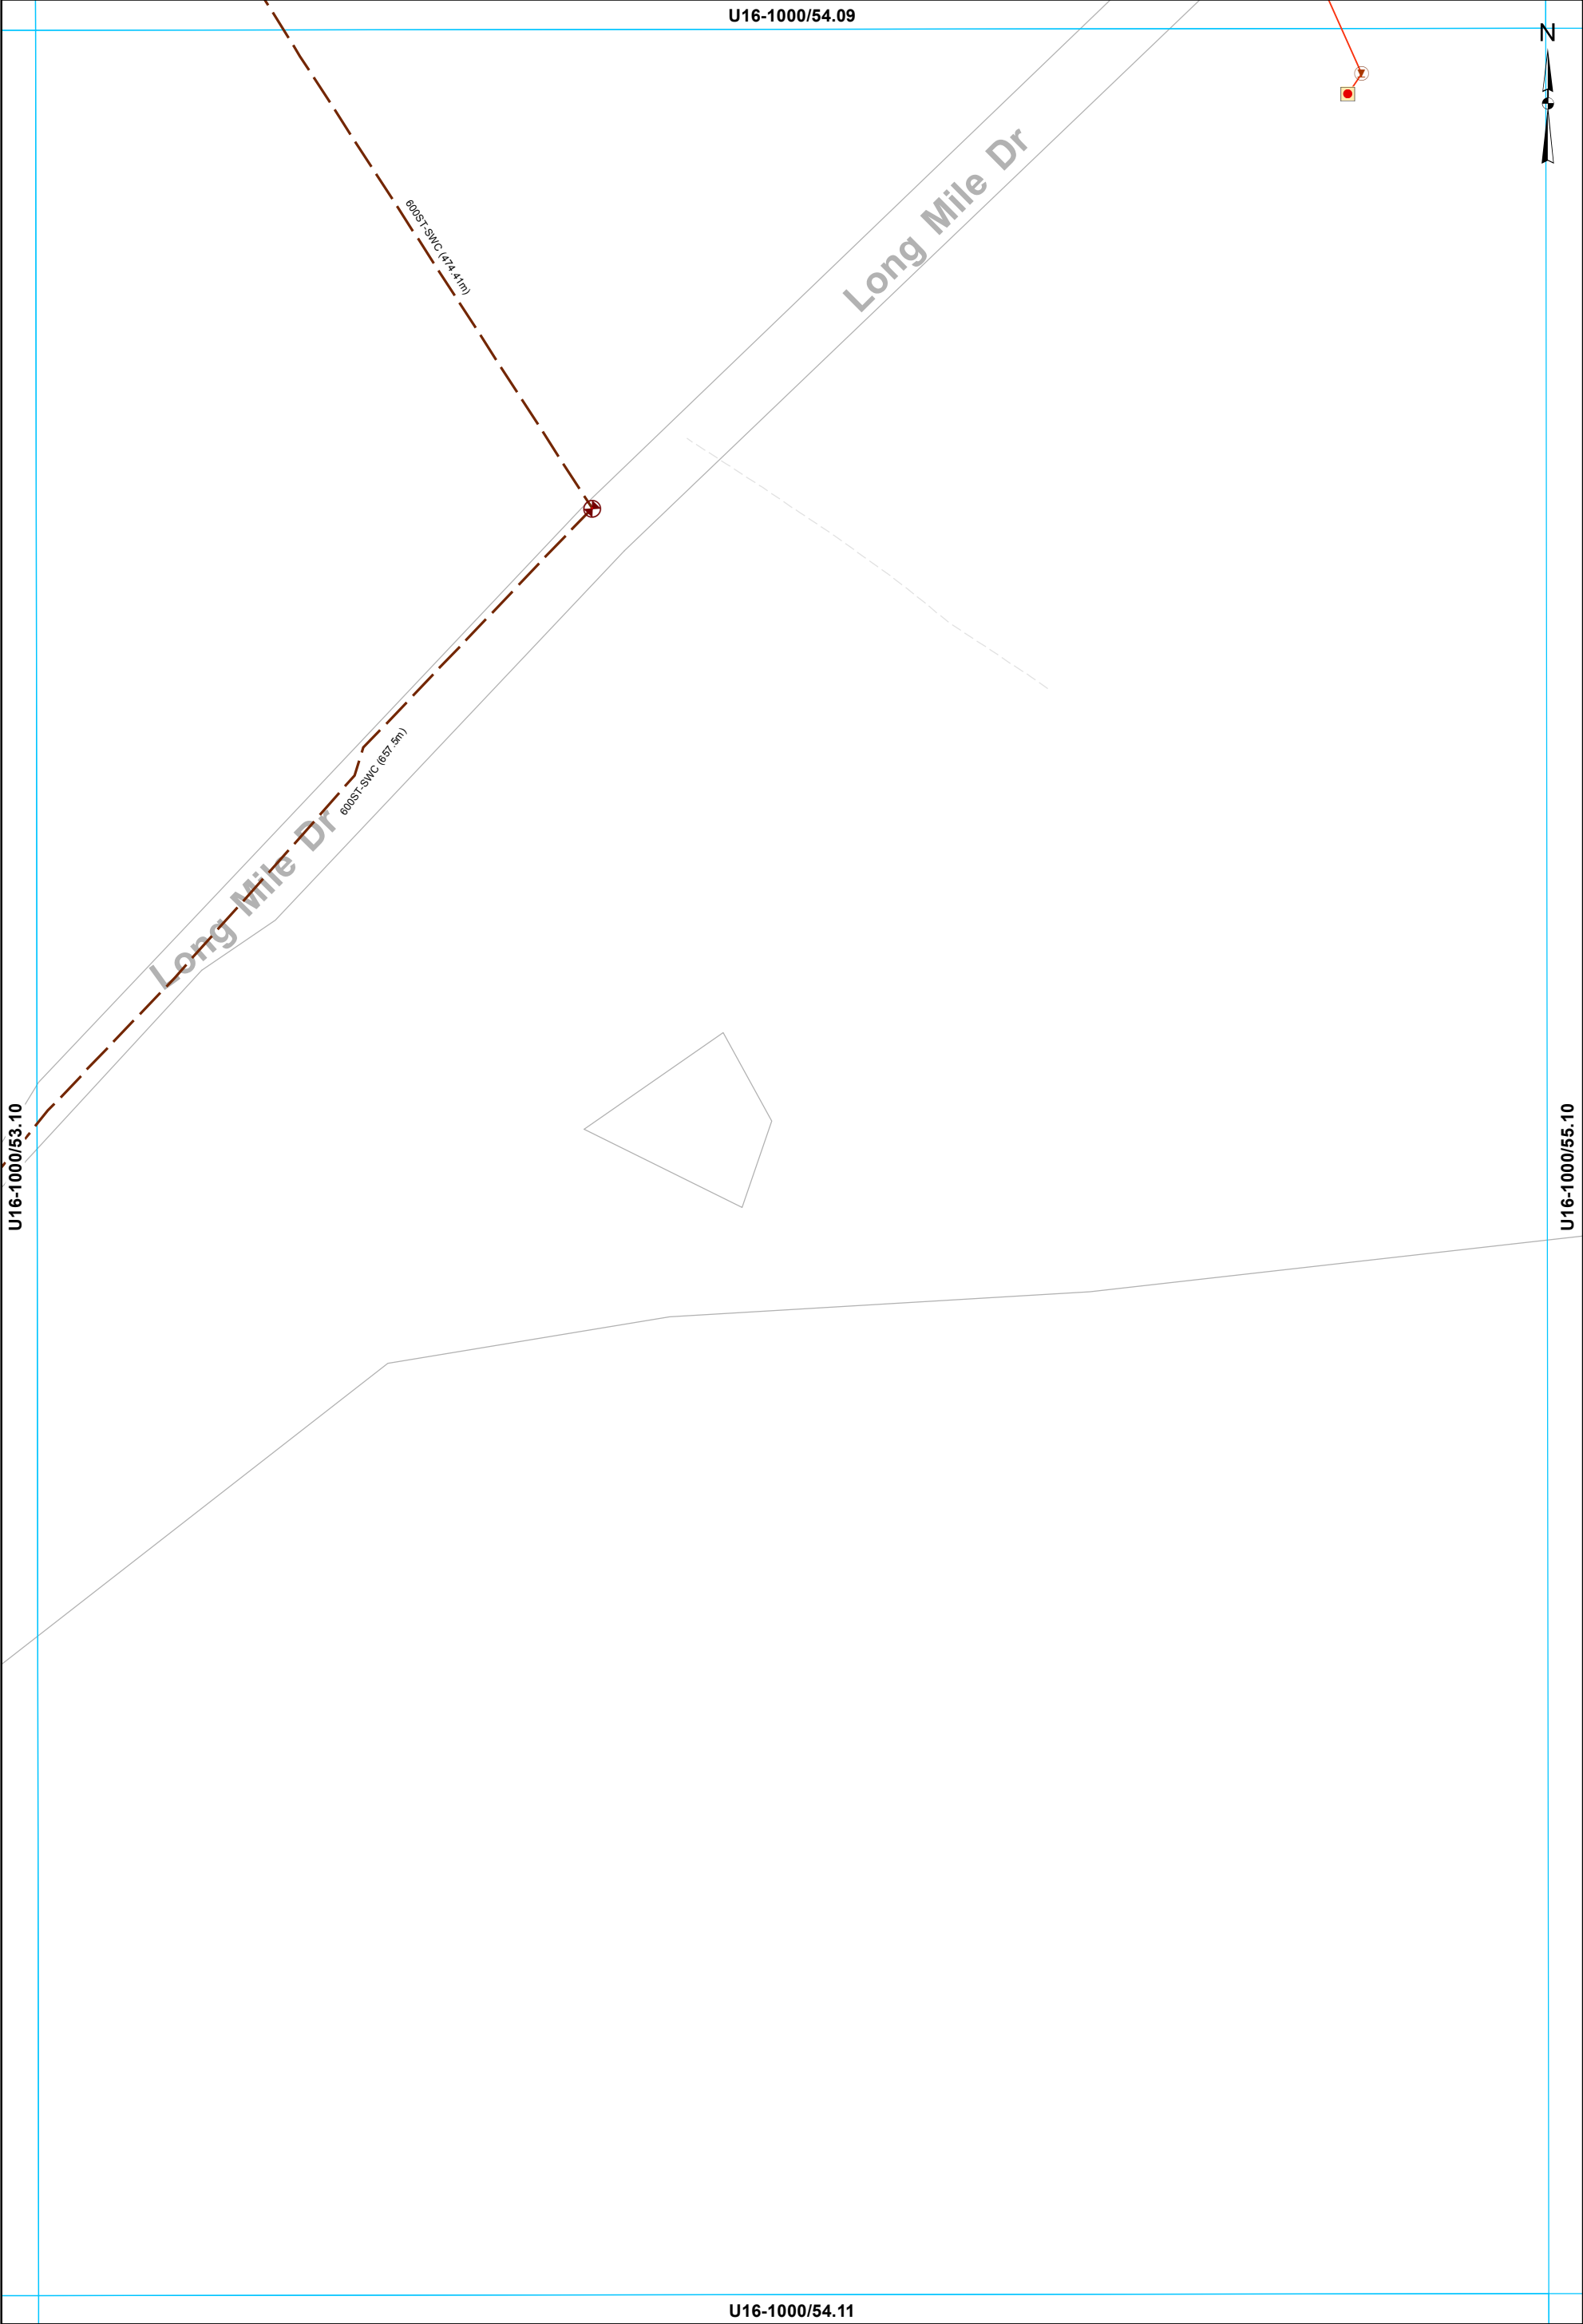


- | | | |
|----------------------|-------------------|-------------------|
| Grinder Pump Chamber | Air Valve | Rising main |
| LP Grinder Pump | Boundary Assembly | LPGP Service Line |

WASTEWATER SERVICES
1:2000 @ A3 - (U16-1000/54.10)

This data is derived from sources outside the control of Rotorua District Council and is for information only

Rotorua District Council 2006. Facsimile 07 346 3143 Telephone 07 348 4199 email mail@rdc.govt.nz

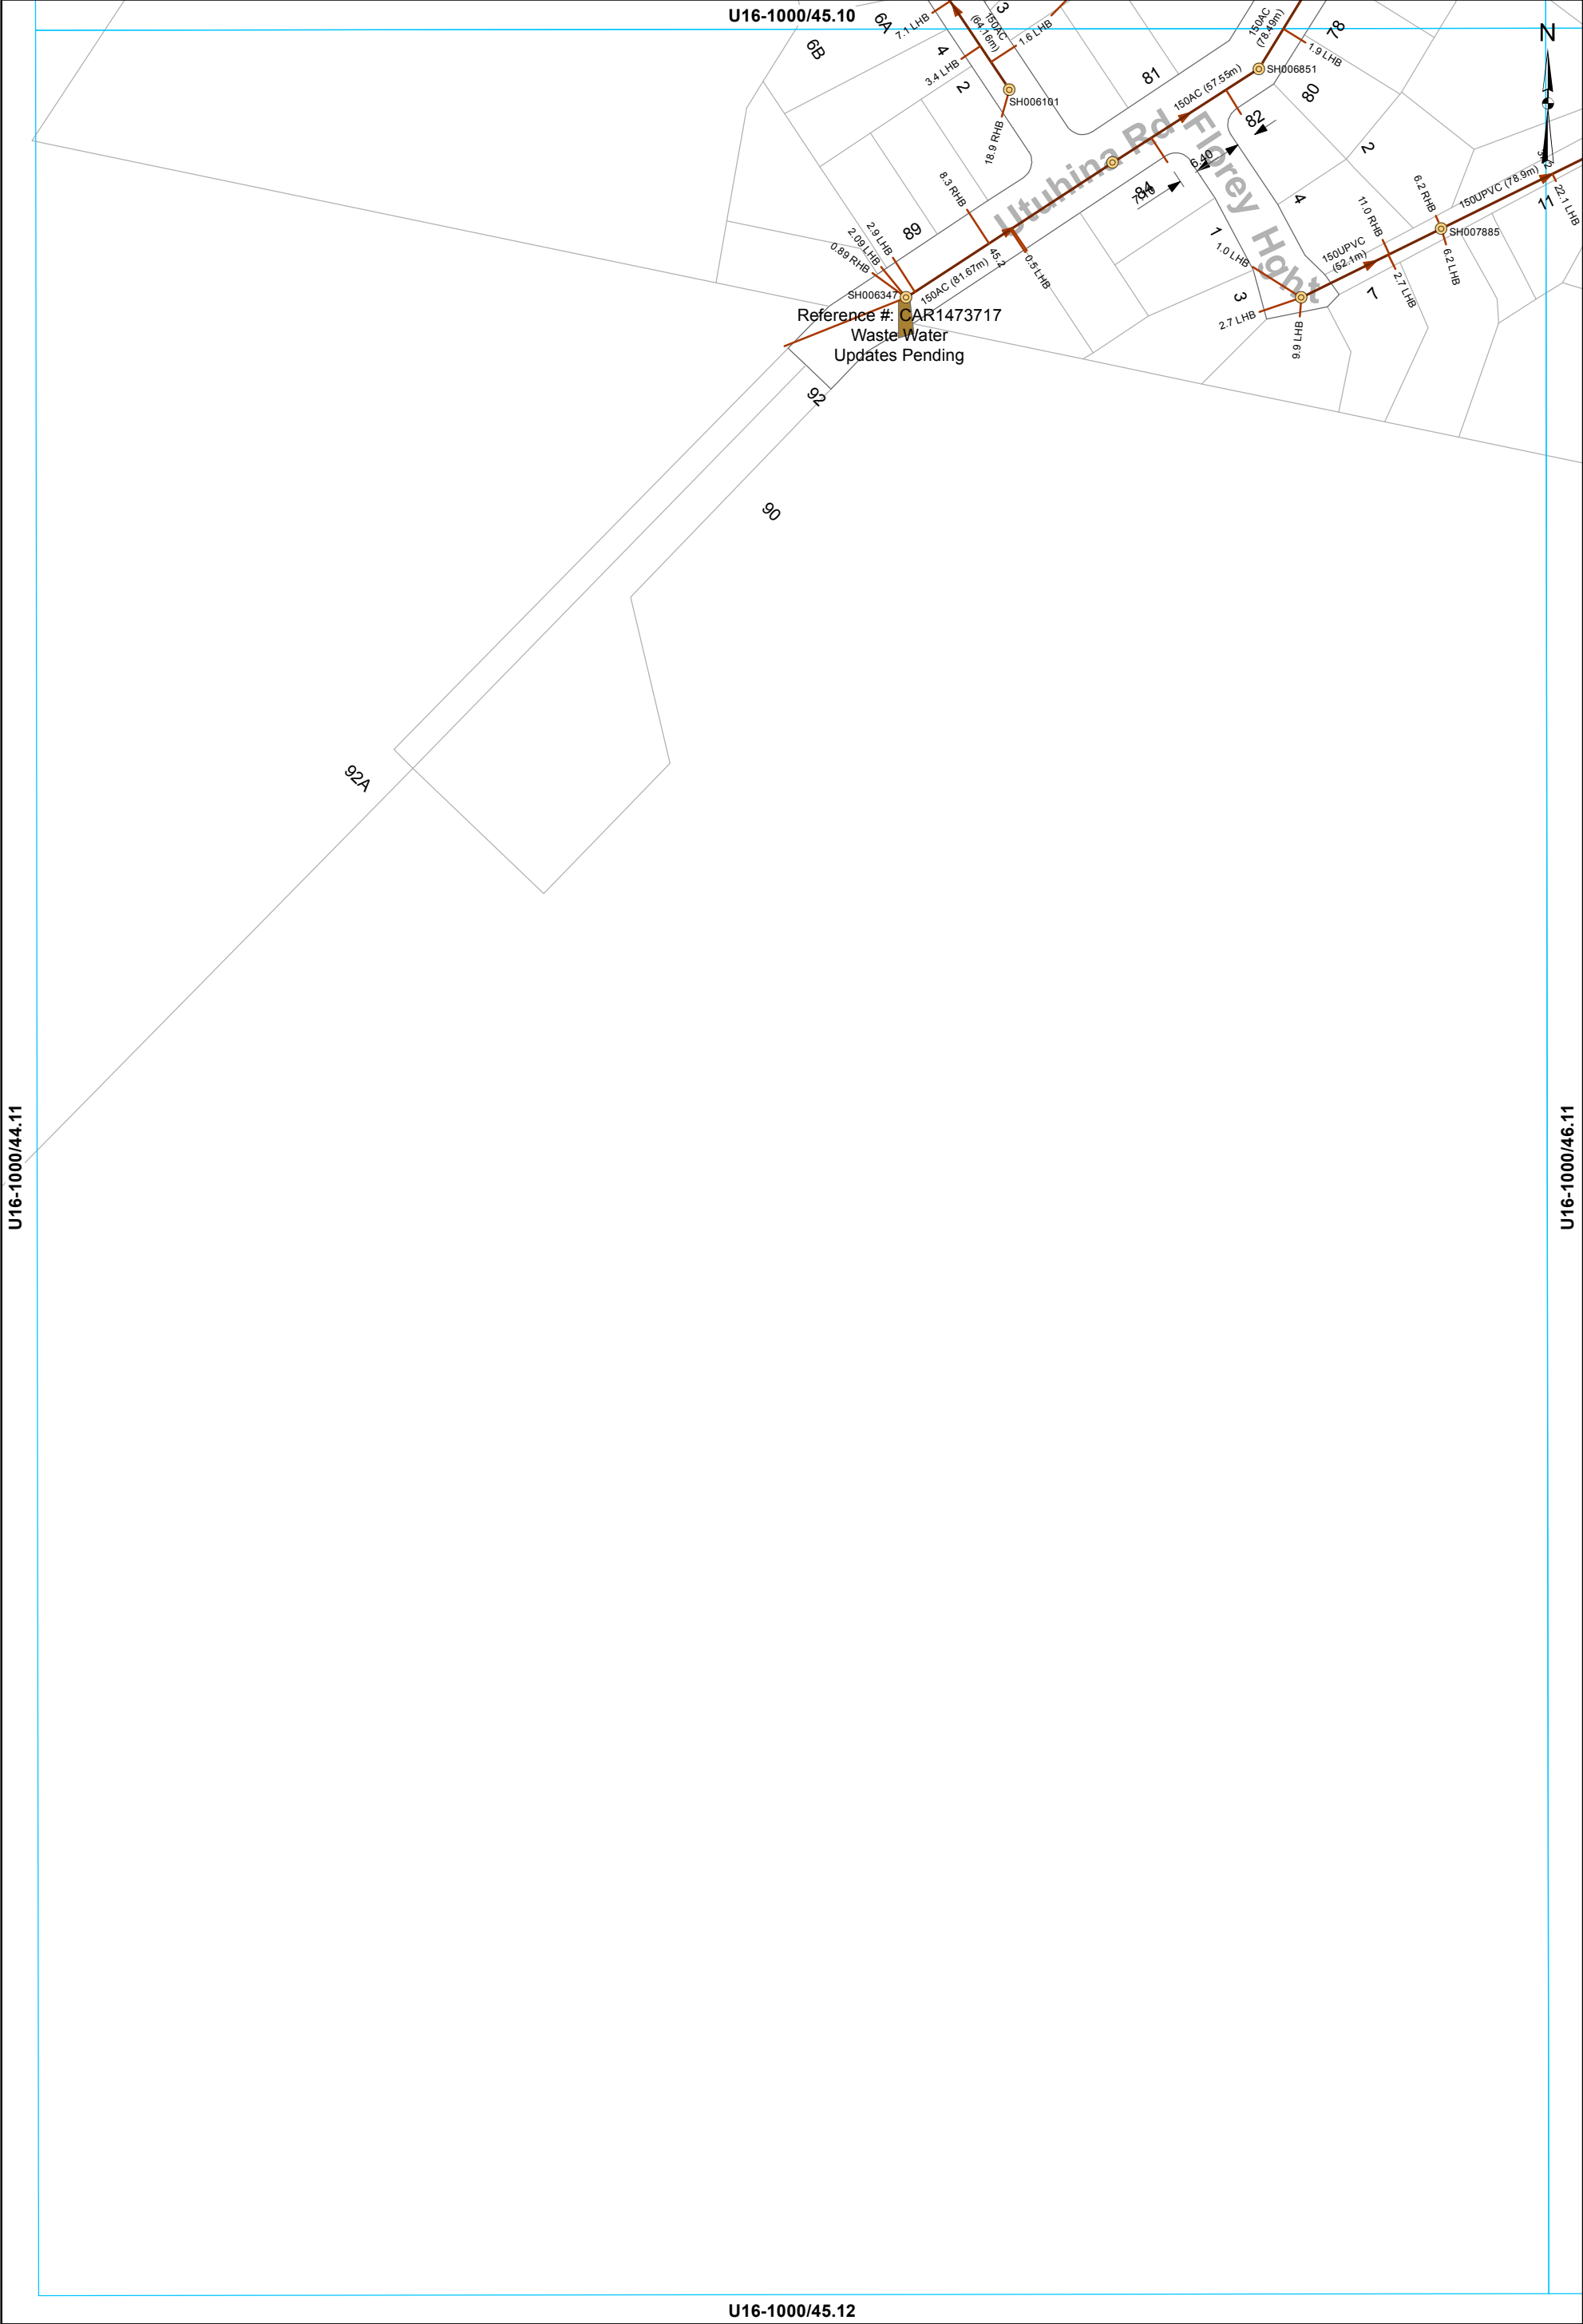


Manhole Main line Service Line

WASTEWATER SERVICES
1:2000 @ A3 - (U16-1000/45.11)

This data is derived from sources outside the control of Rotorua District Council and is for information only

Rotorua District Council 2006. Facsimilie 07 346 3143 Telephone 07 348 4199 email mail@rdc.govt.nz



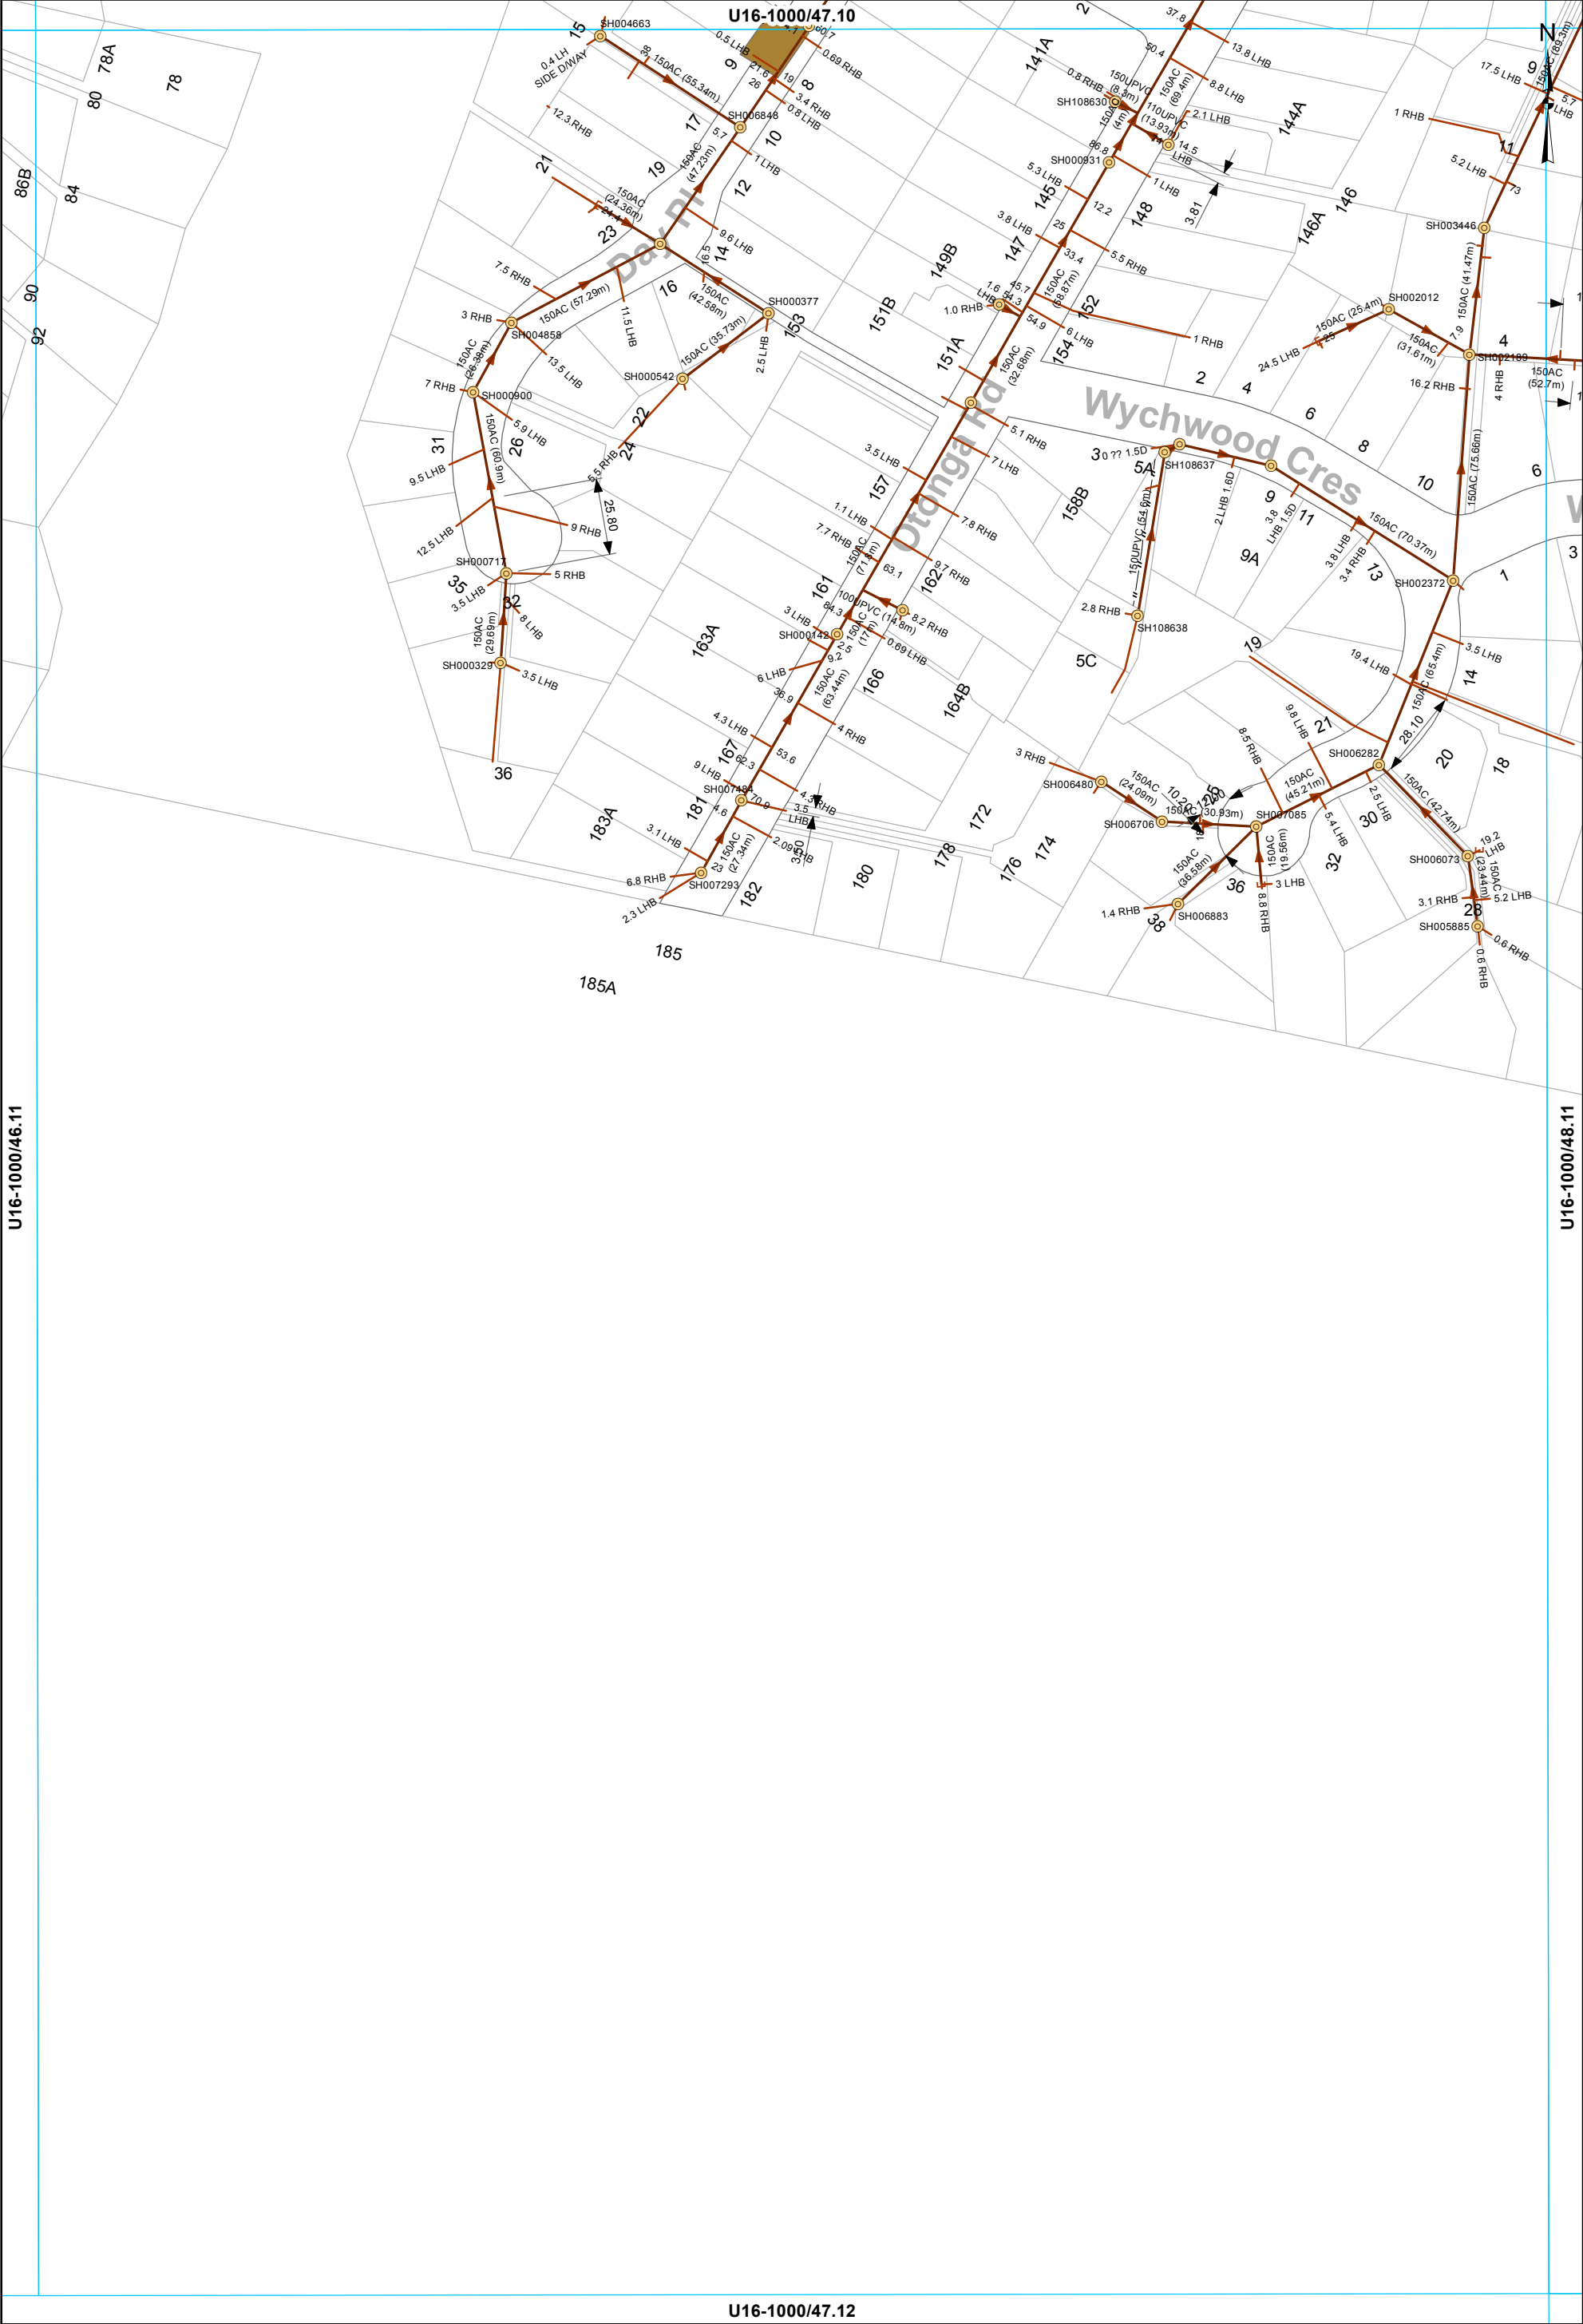

U16-1000/46.11

U16-1000/48.11

U16-1000/47.12

 
- Manhole
- End of line - Capped end
- Main line
- Service Line

WASTEWATER SERVICES
1:2000 @ A3 - (U16-1000/47.11)


This data is derived from sources outside the control of Rotorua District Council and is for information only


All dimensions and levels should be verified by physical location on-site.

Rotorua District Council 2006. Facsimile 07 346 3143 Telephone 07 348 4199 email mail@rdc.govt.nz



WASTEWATER SERVICES
1:2000 @ A3 - (U16-1000/48.11)

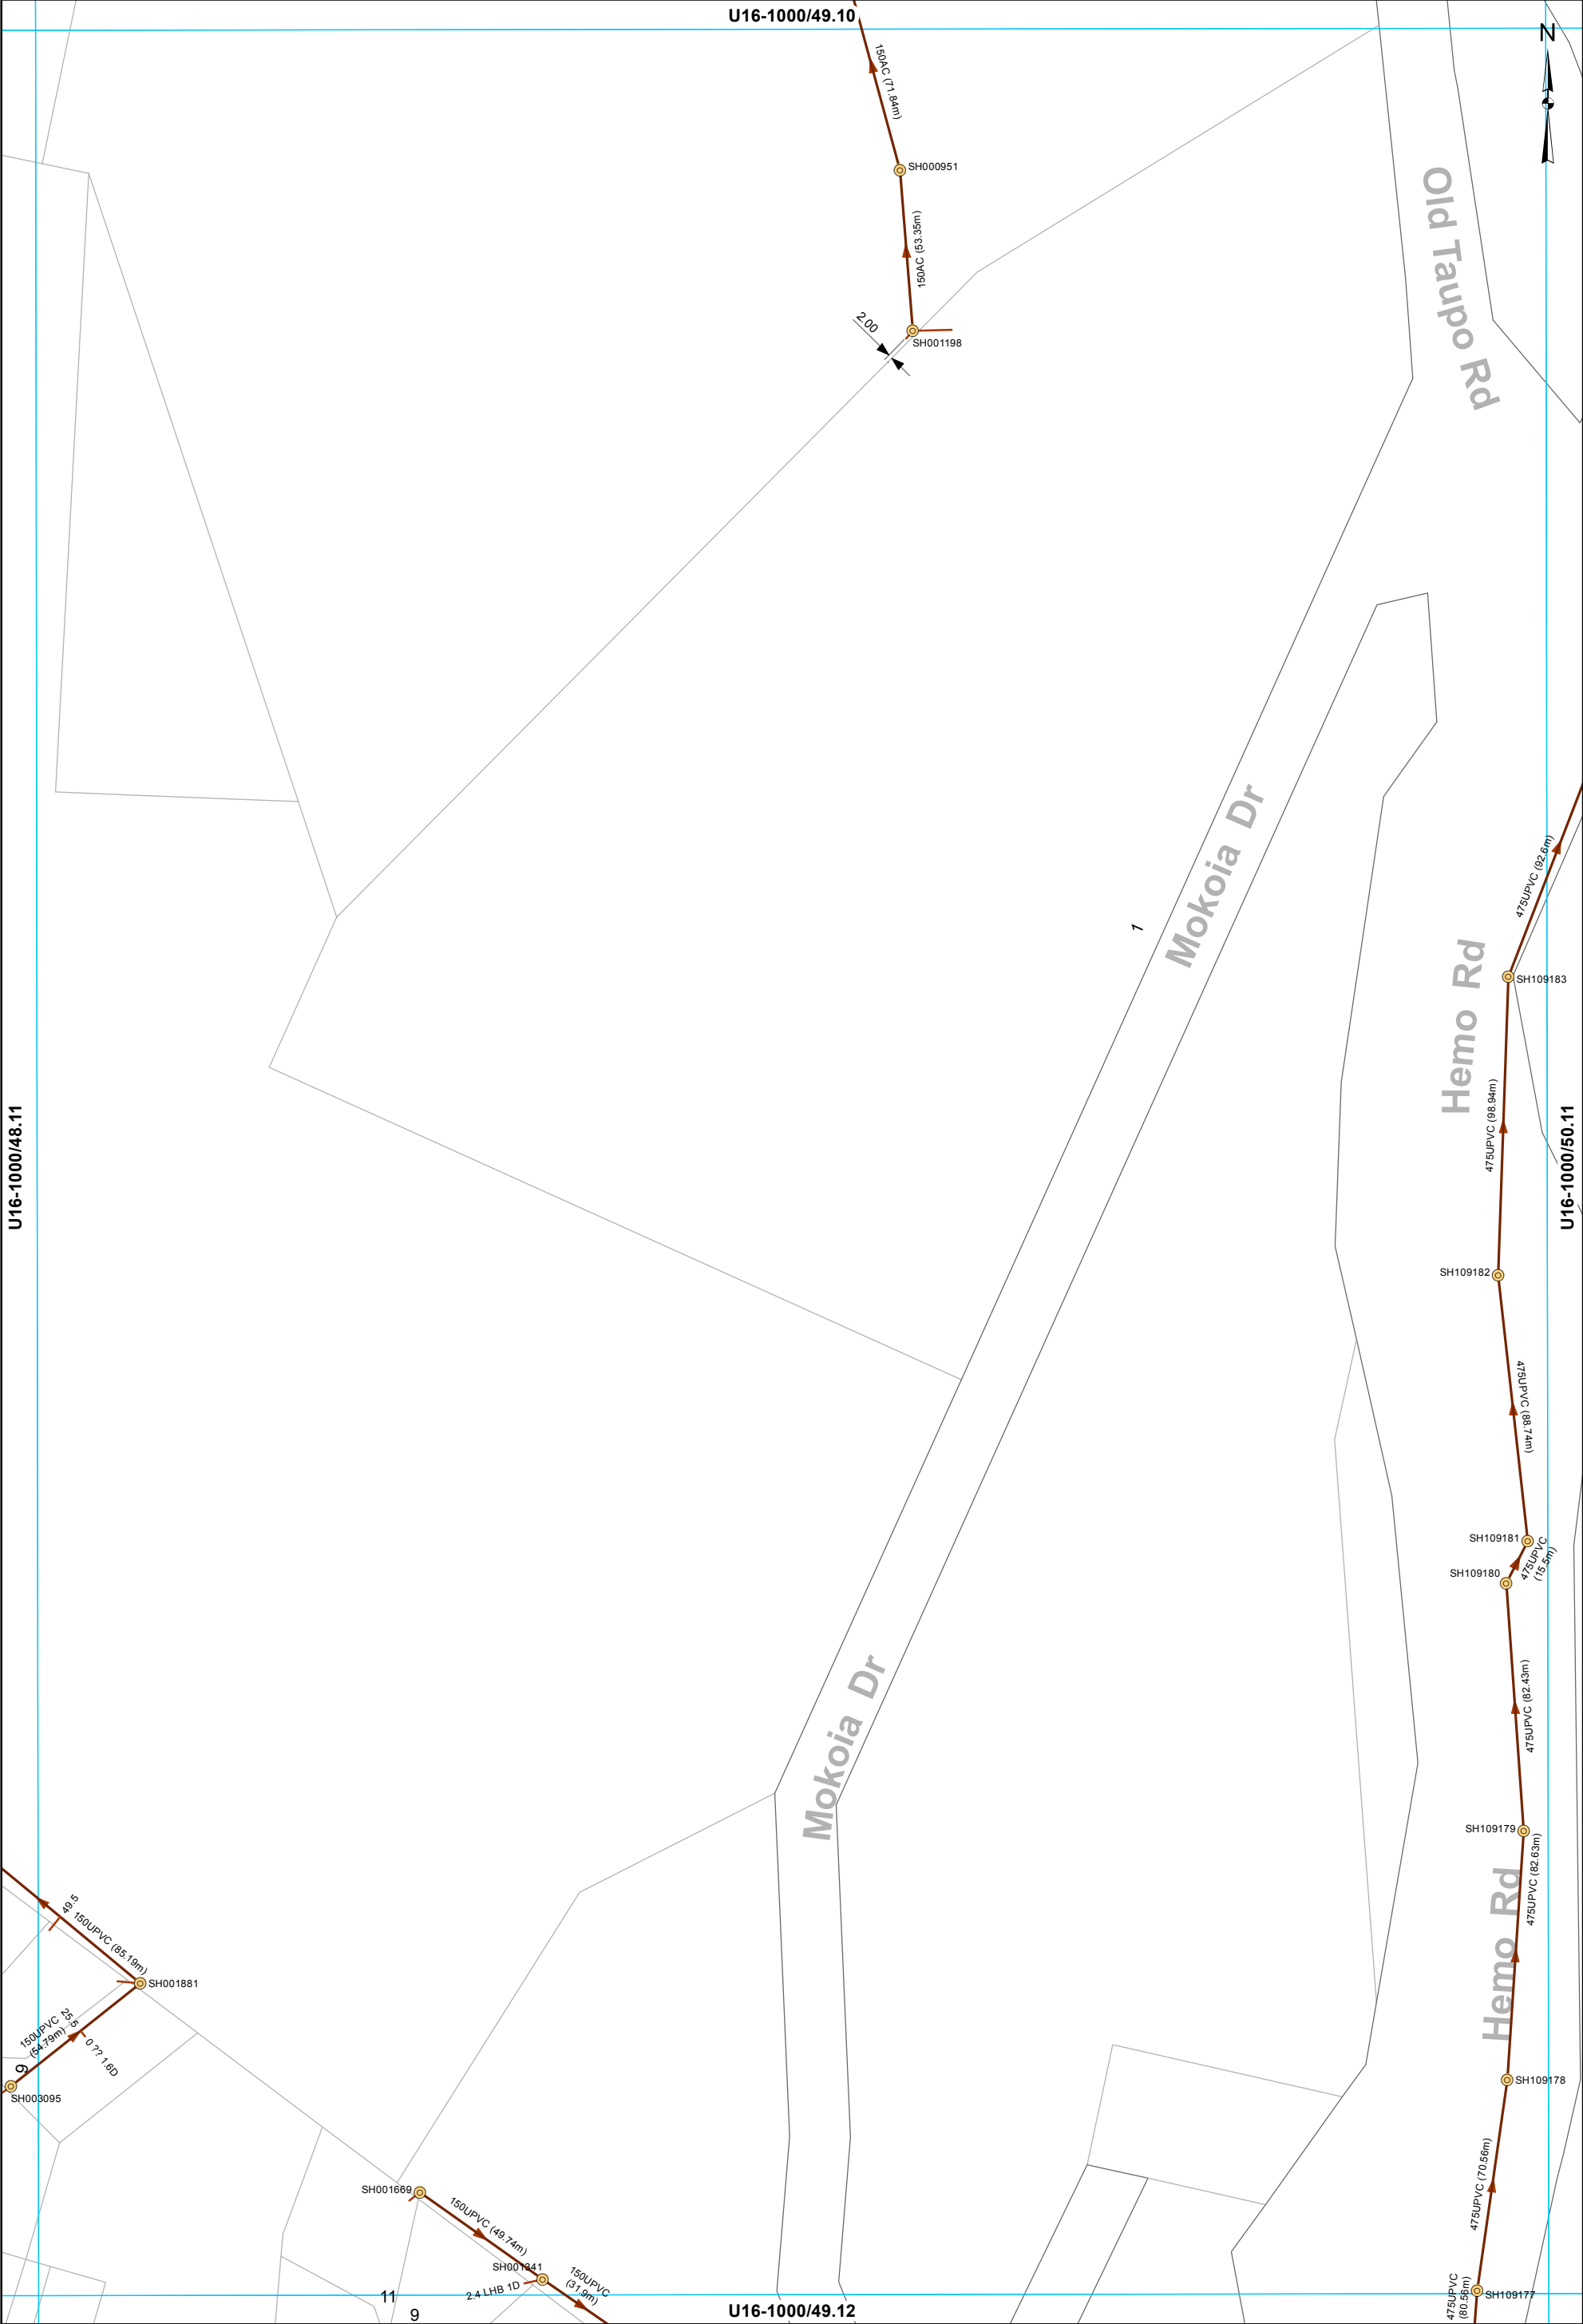

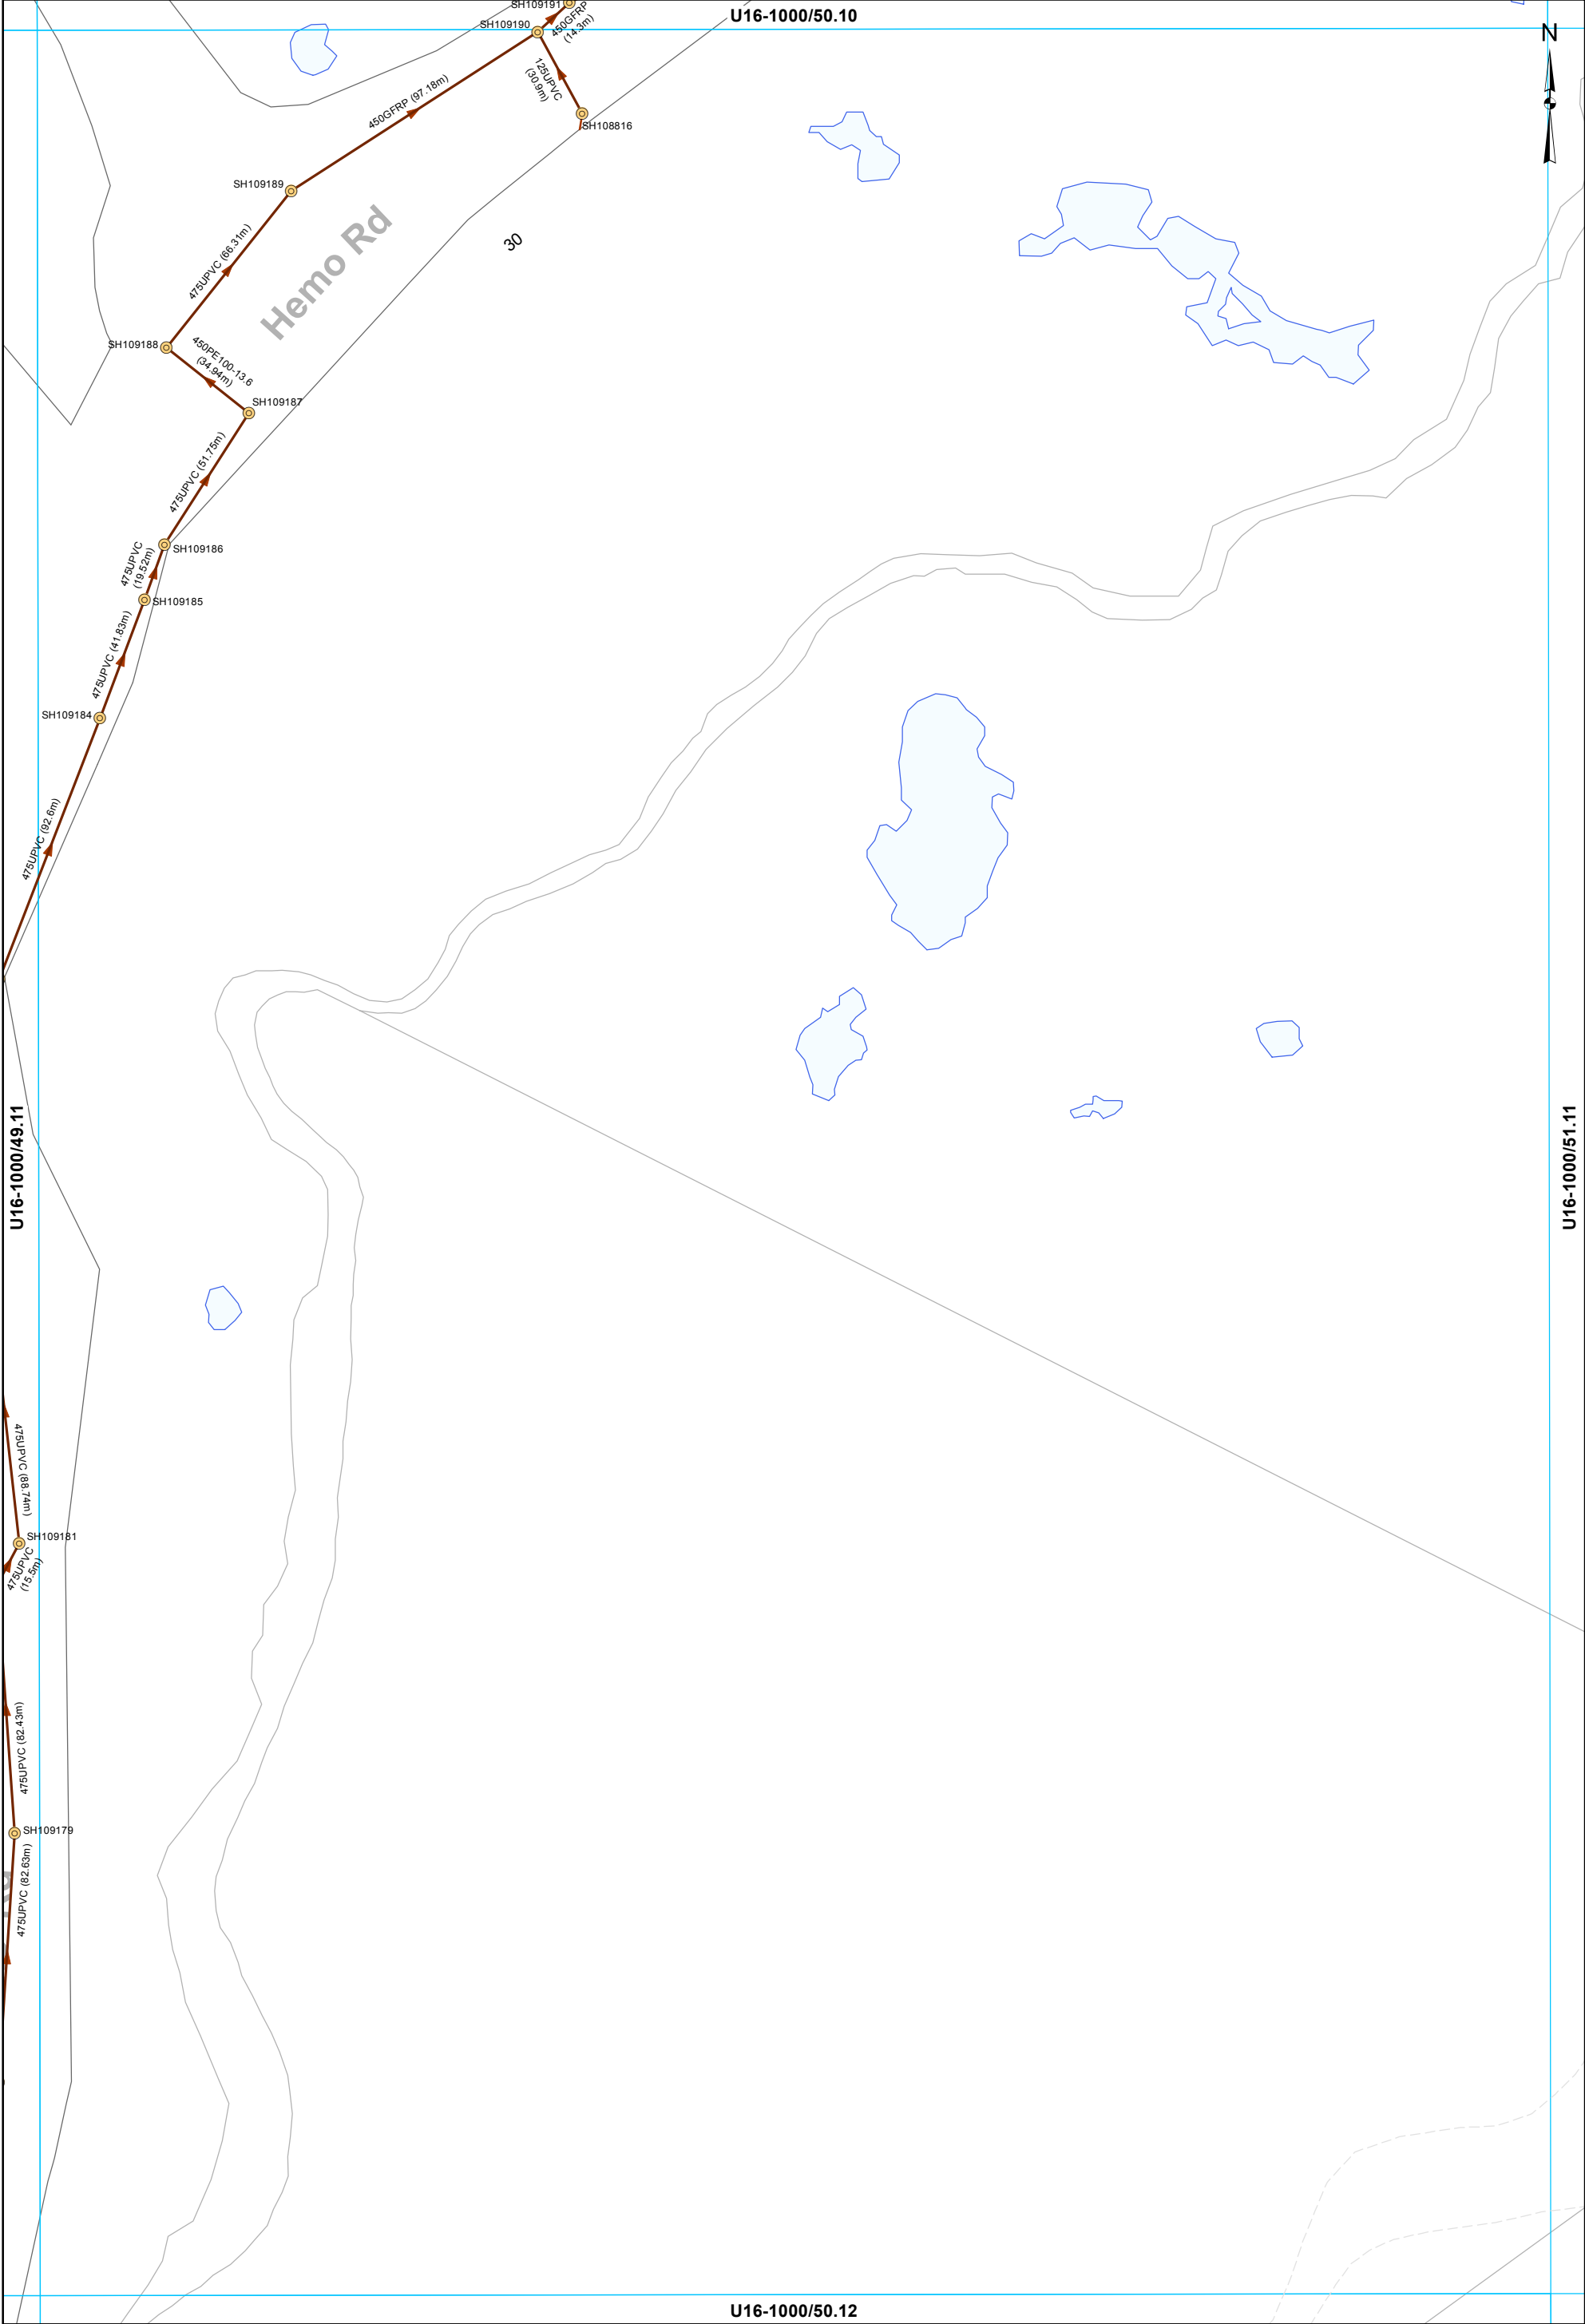


Manhole Main line Service Line

WASTEWATER SERVICES
1:2000 @ A3 - (U16-1000/50.11)

This data is derived from sources outside the control of Rotorua District Council and is for information only

All dimensions and levels should be verified by physical location on-site.

Rotorua District Council 2006. Facsimile 07 346 3143 Telephone 07 348 4199 email mail@rdc.govt.nz

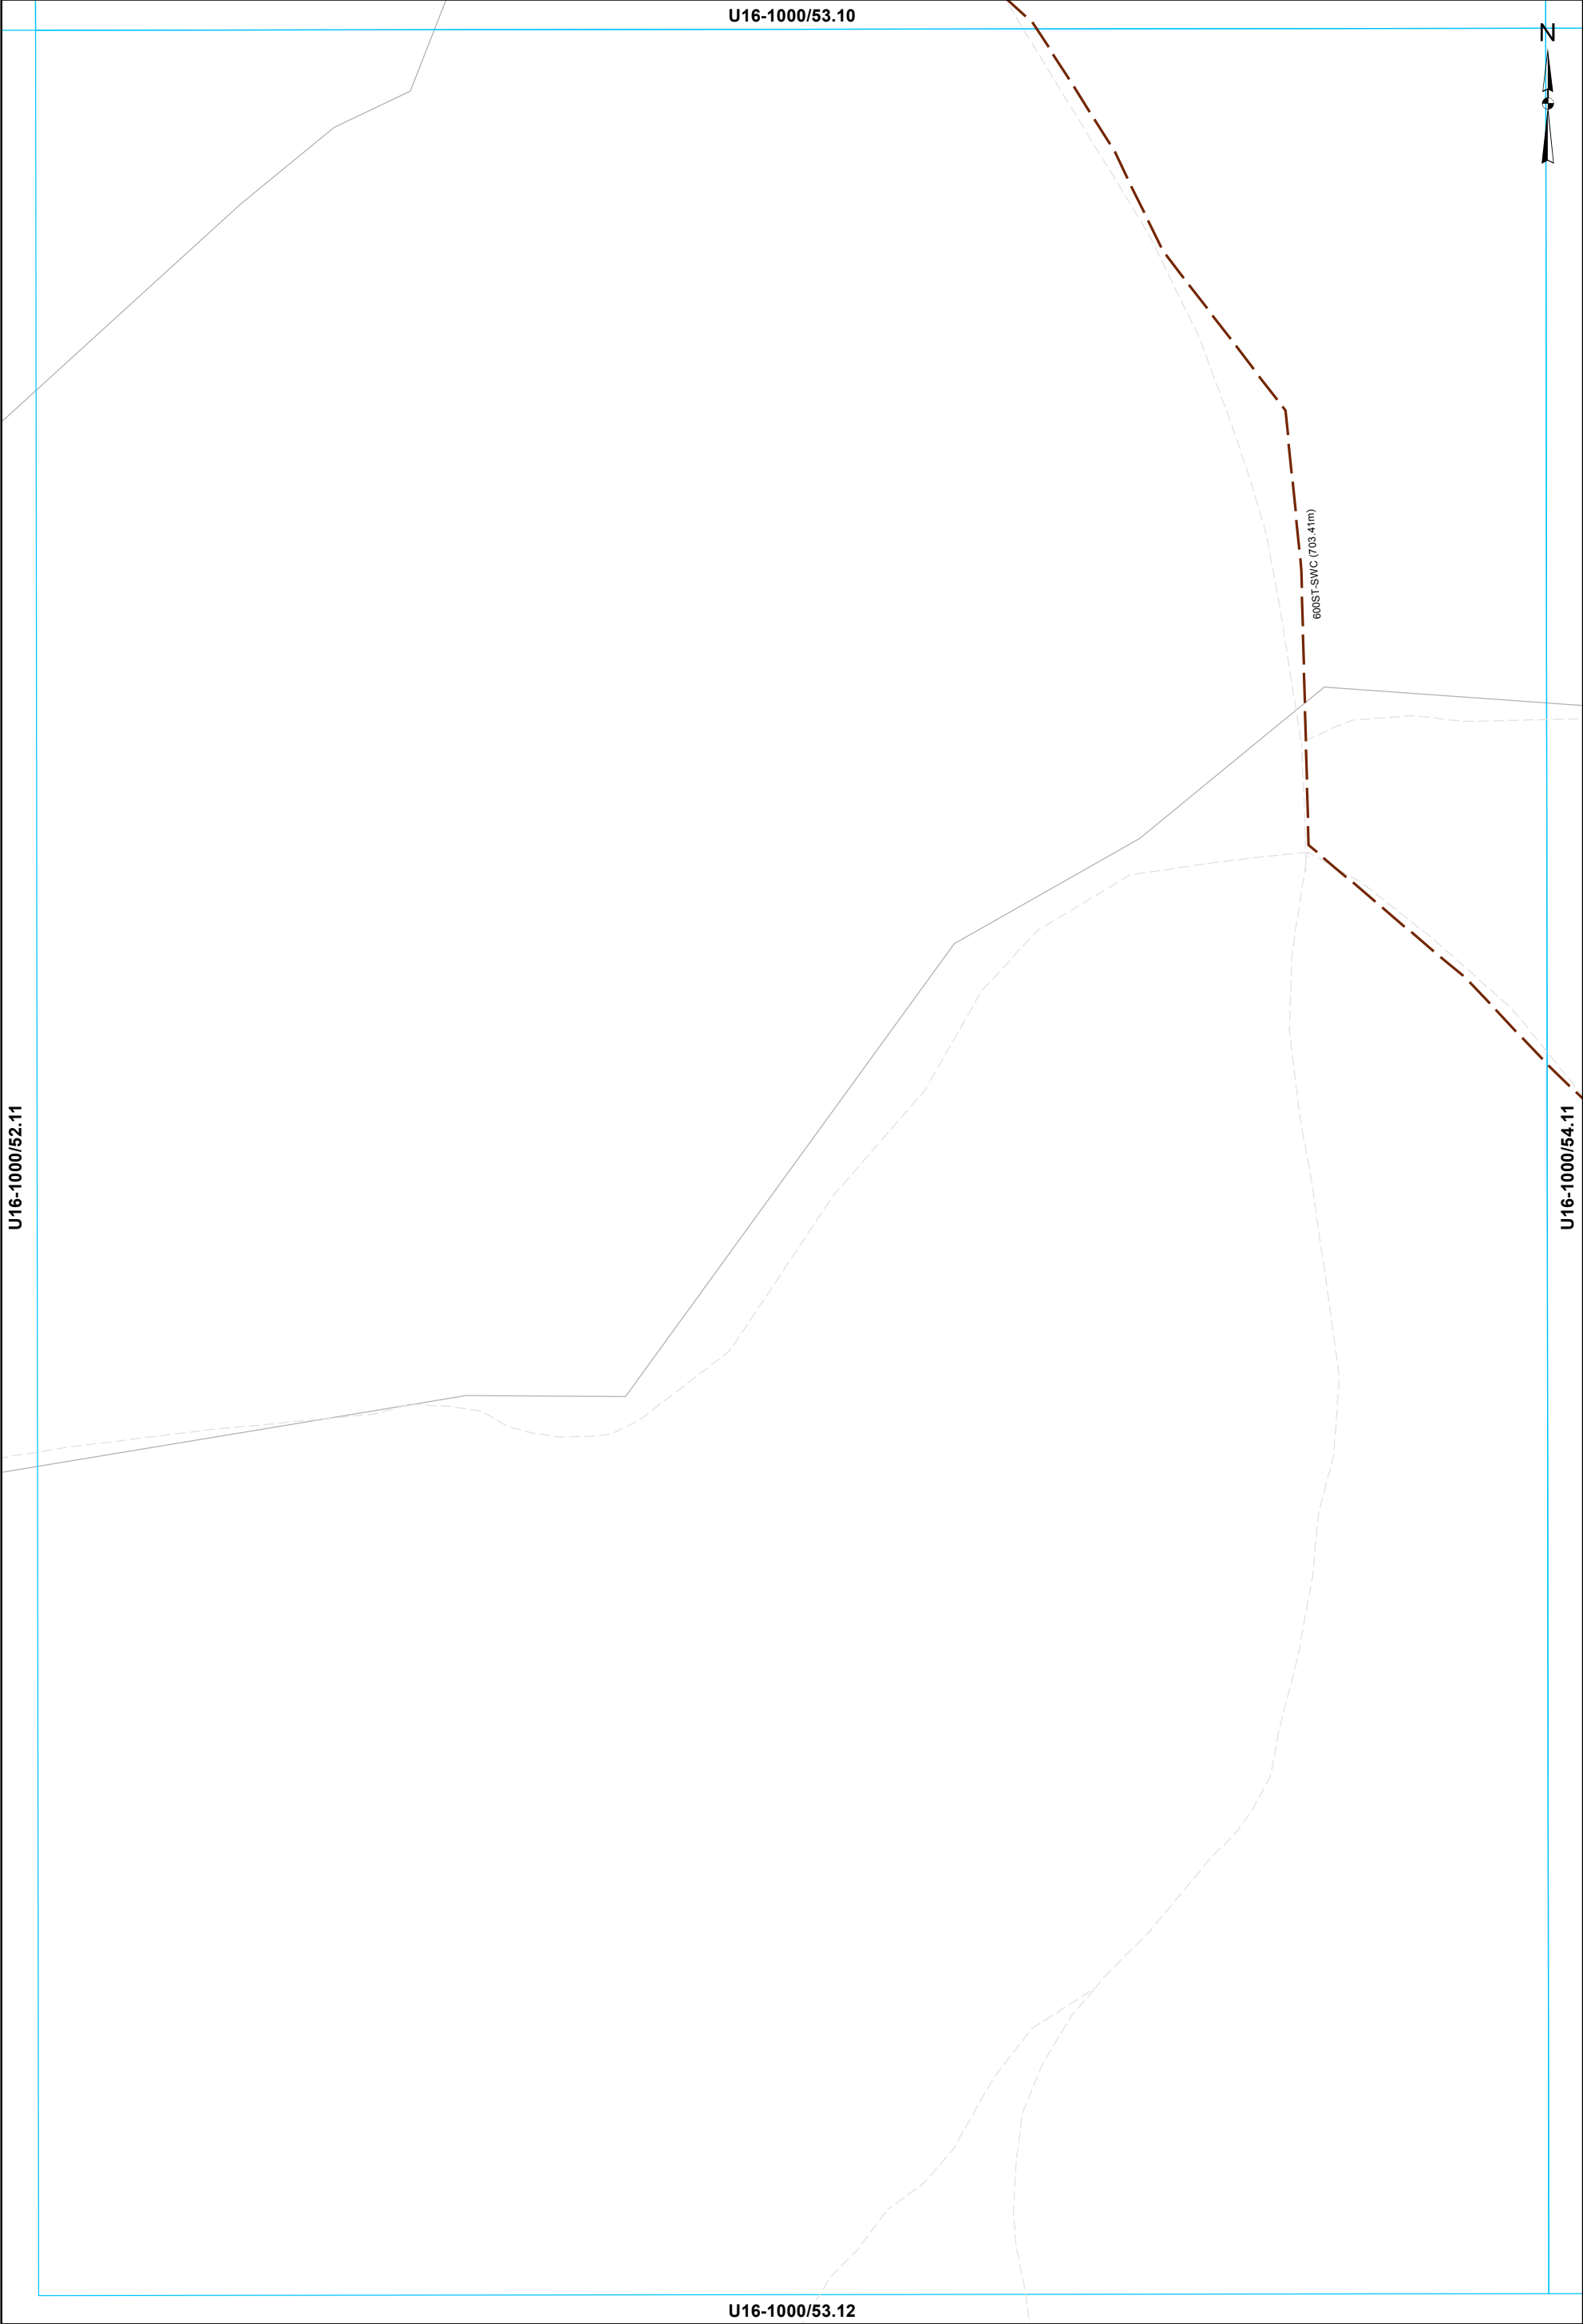

— Rising main

This data is derived from sources outside the control of Rotorua District Council and is for information only


Rotorua District Council 2006. Facsimile 07 346 3143 Telephone 07 348 4199 email mail@rdc.govt.nz



 Air Valve

 - Rising main

 Isolating Valve

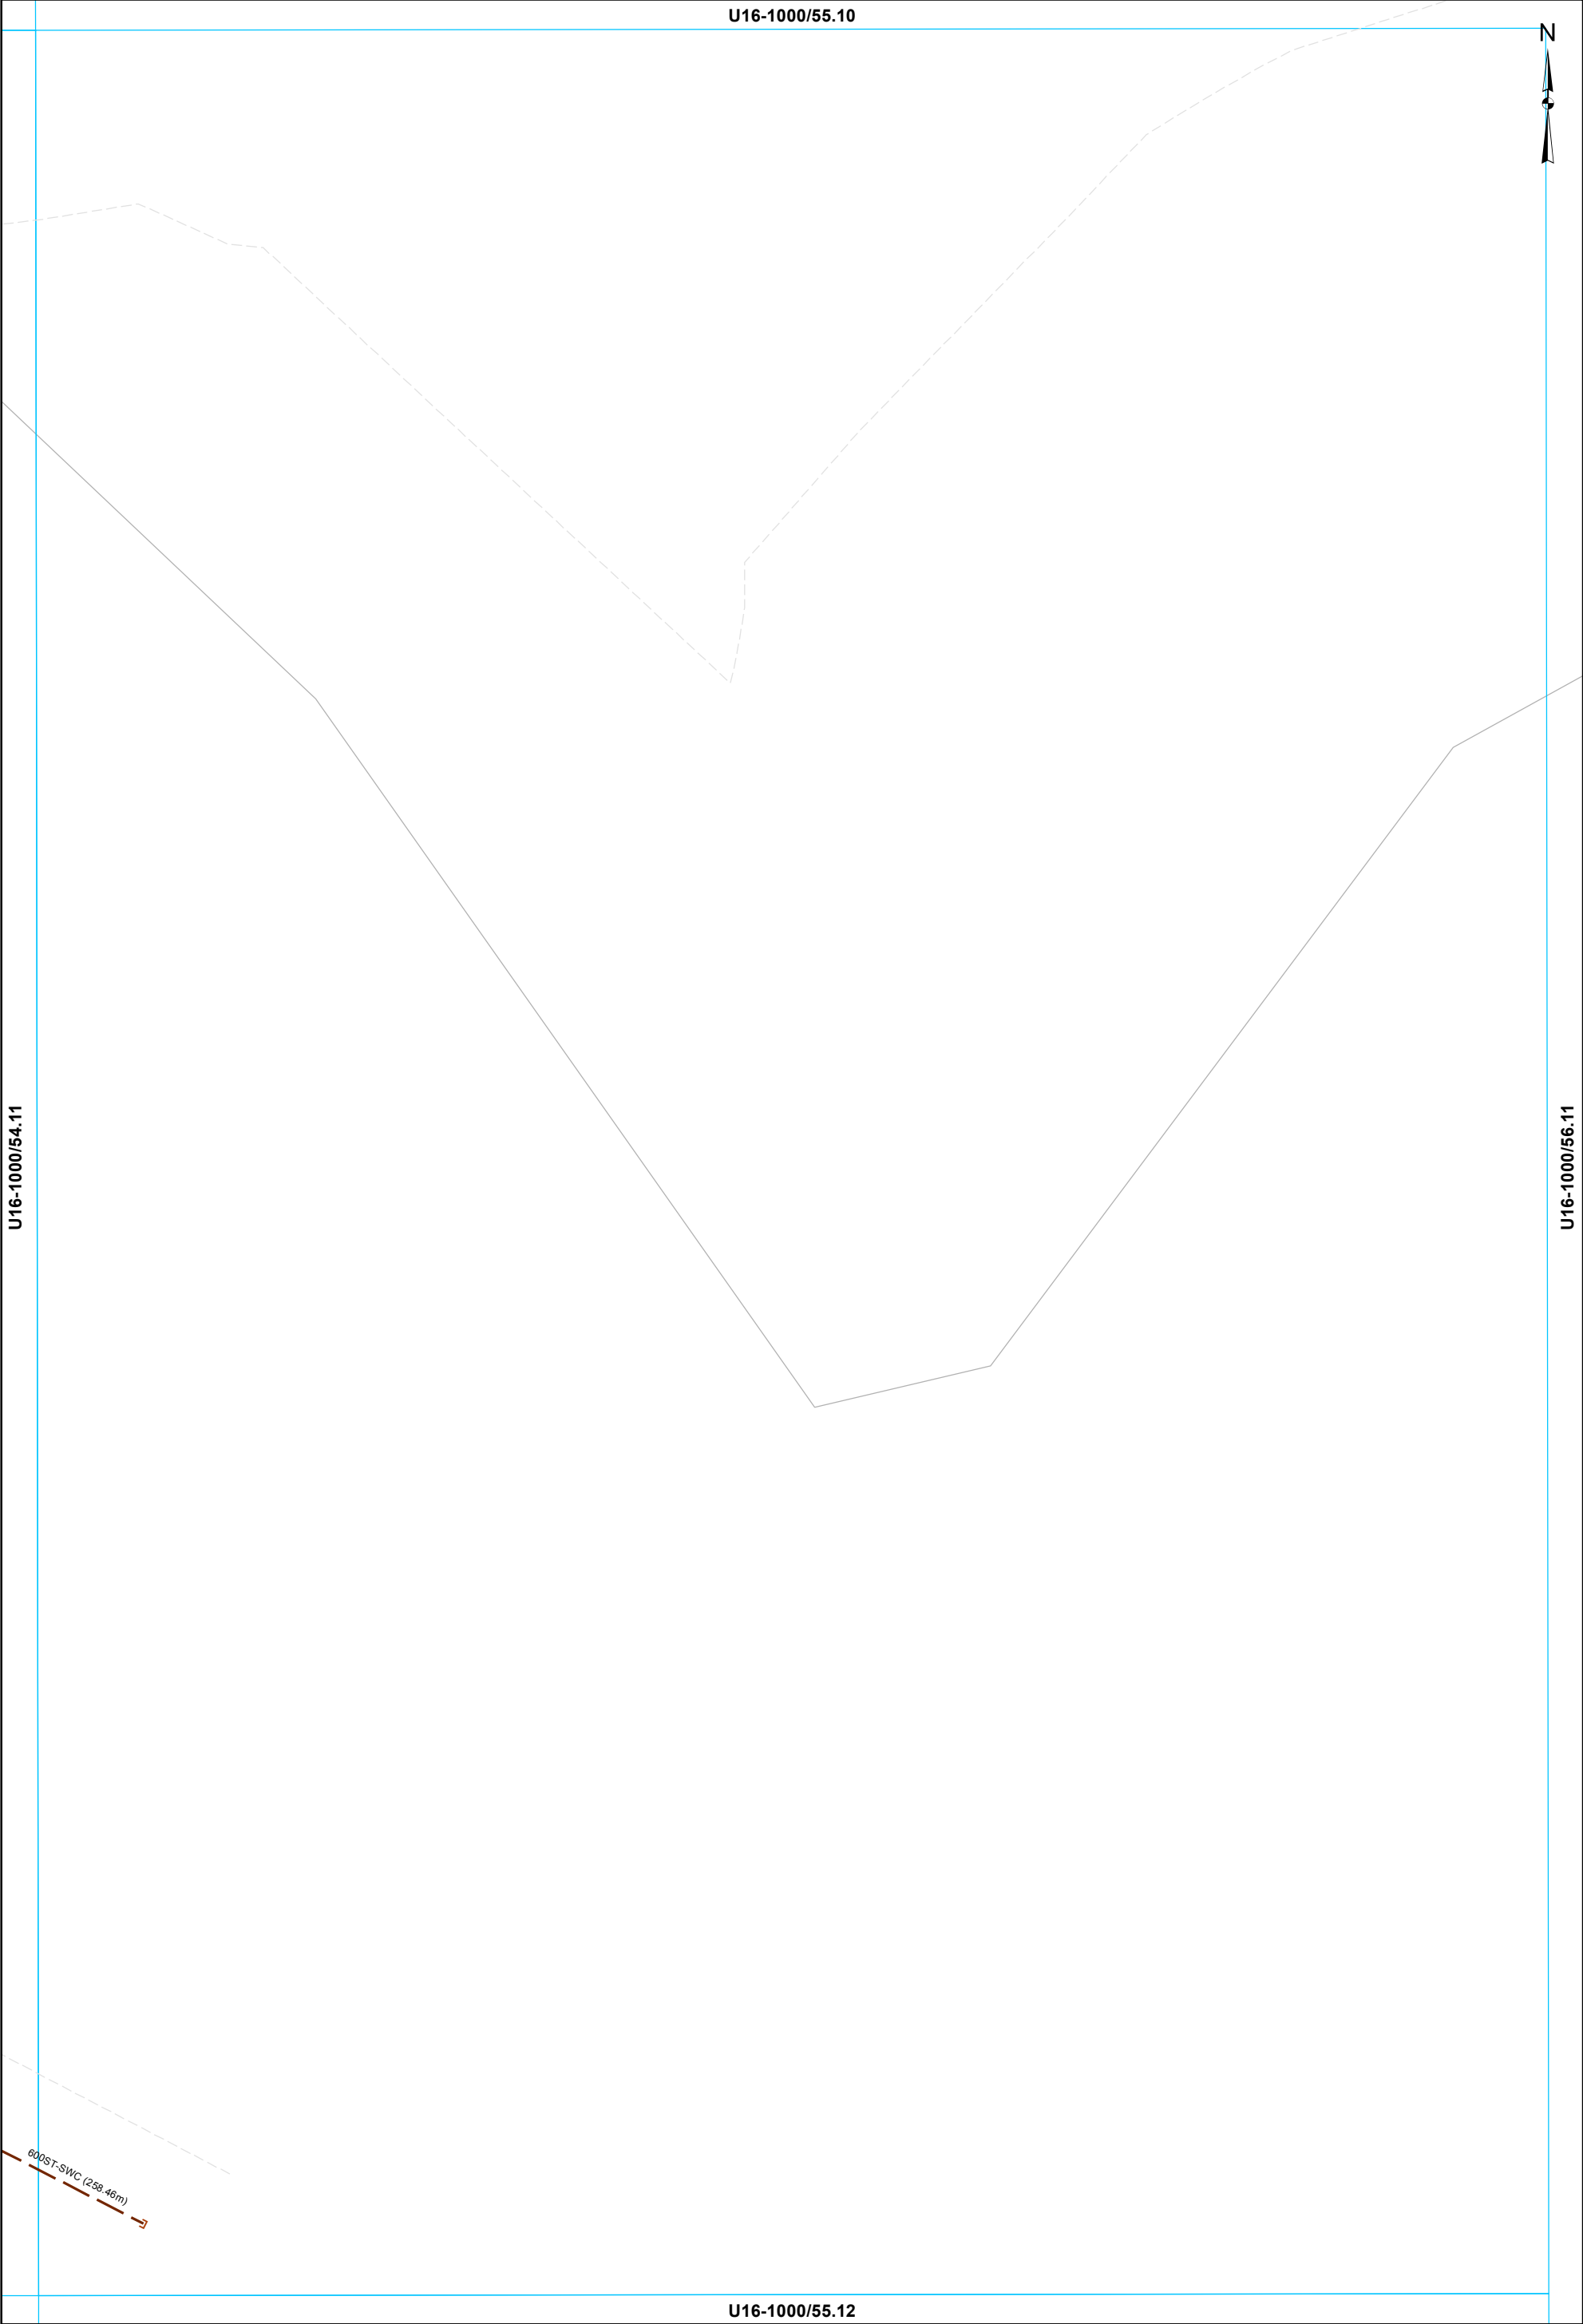

This data is derived from sources outside the control of Rotorua District Council and is for information only

Rotarua District Council 2006. Facsimilie 07 346 3143 Telephone 07 348 4199 email mail@rdc.govt.nz


U16-1000/48.13



This data is derived from sources outside the control of Rotorua District Council and is for information only

Rotorua District Council 2006. Facsimile 07 346 3143 telephone 07 348 4199 email mail@rdc.govt.nz

WASTEWATER SERVICES
1:2000 @ A3 - (U16-1000/48.12)

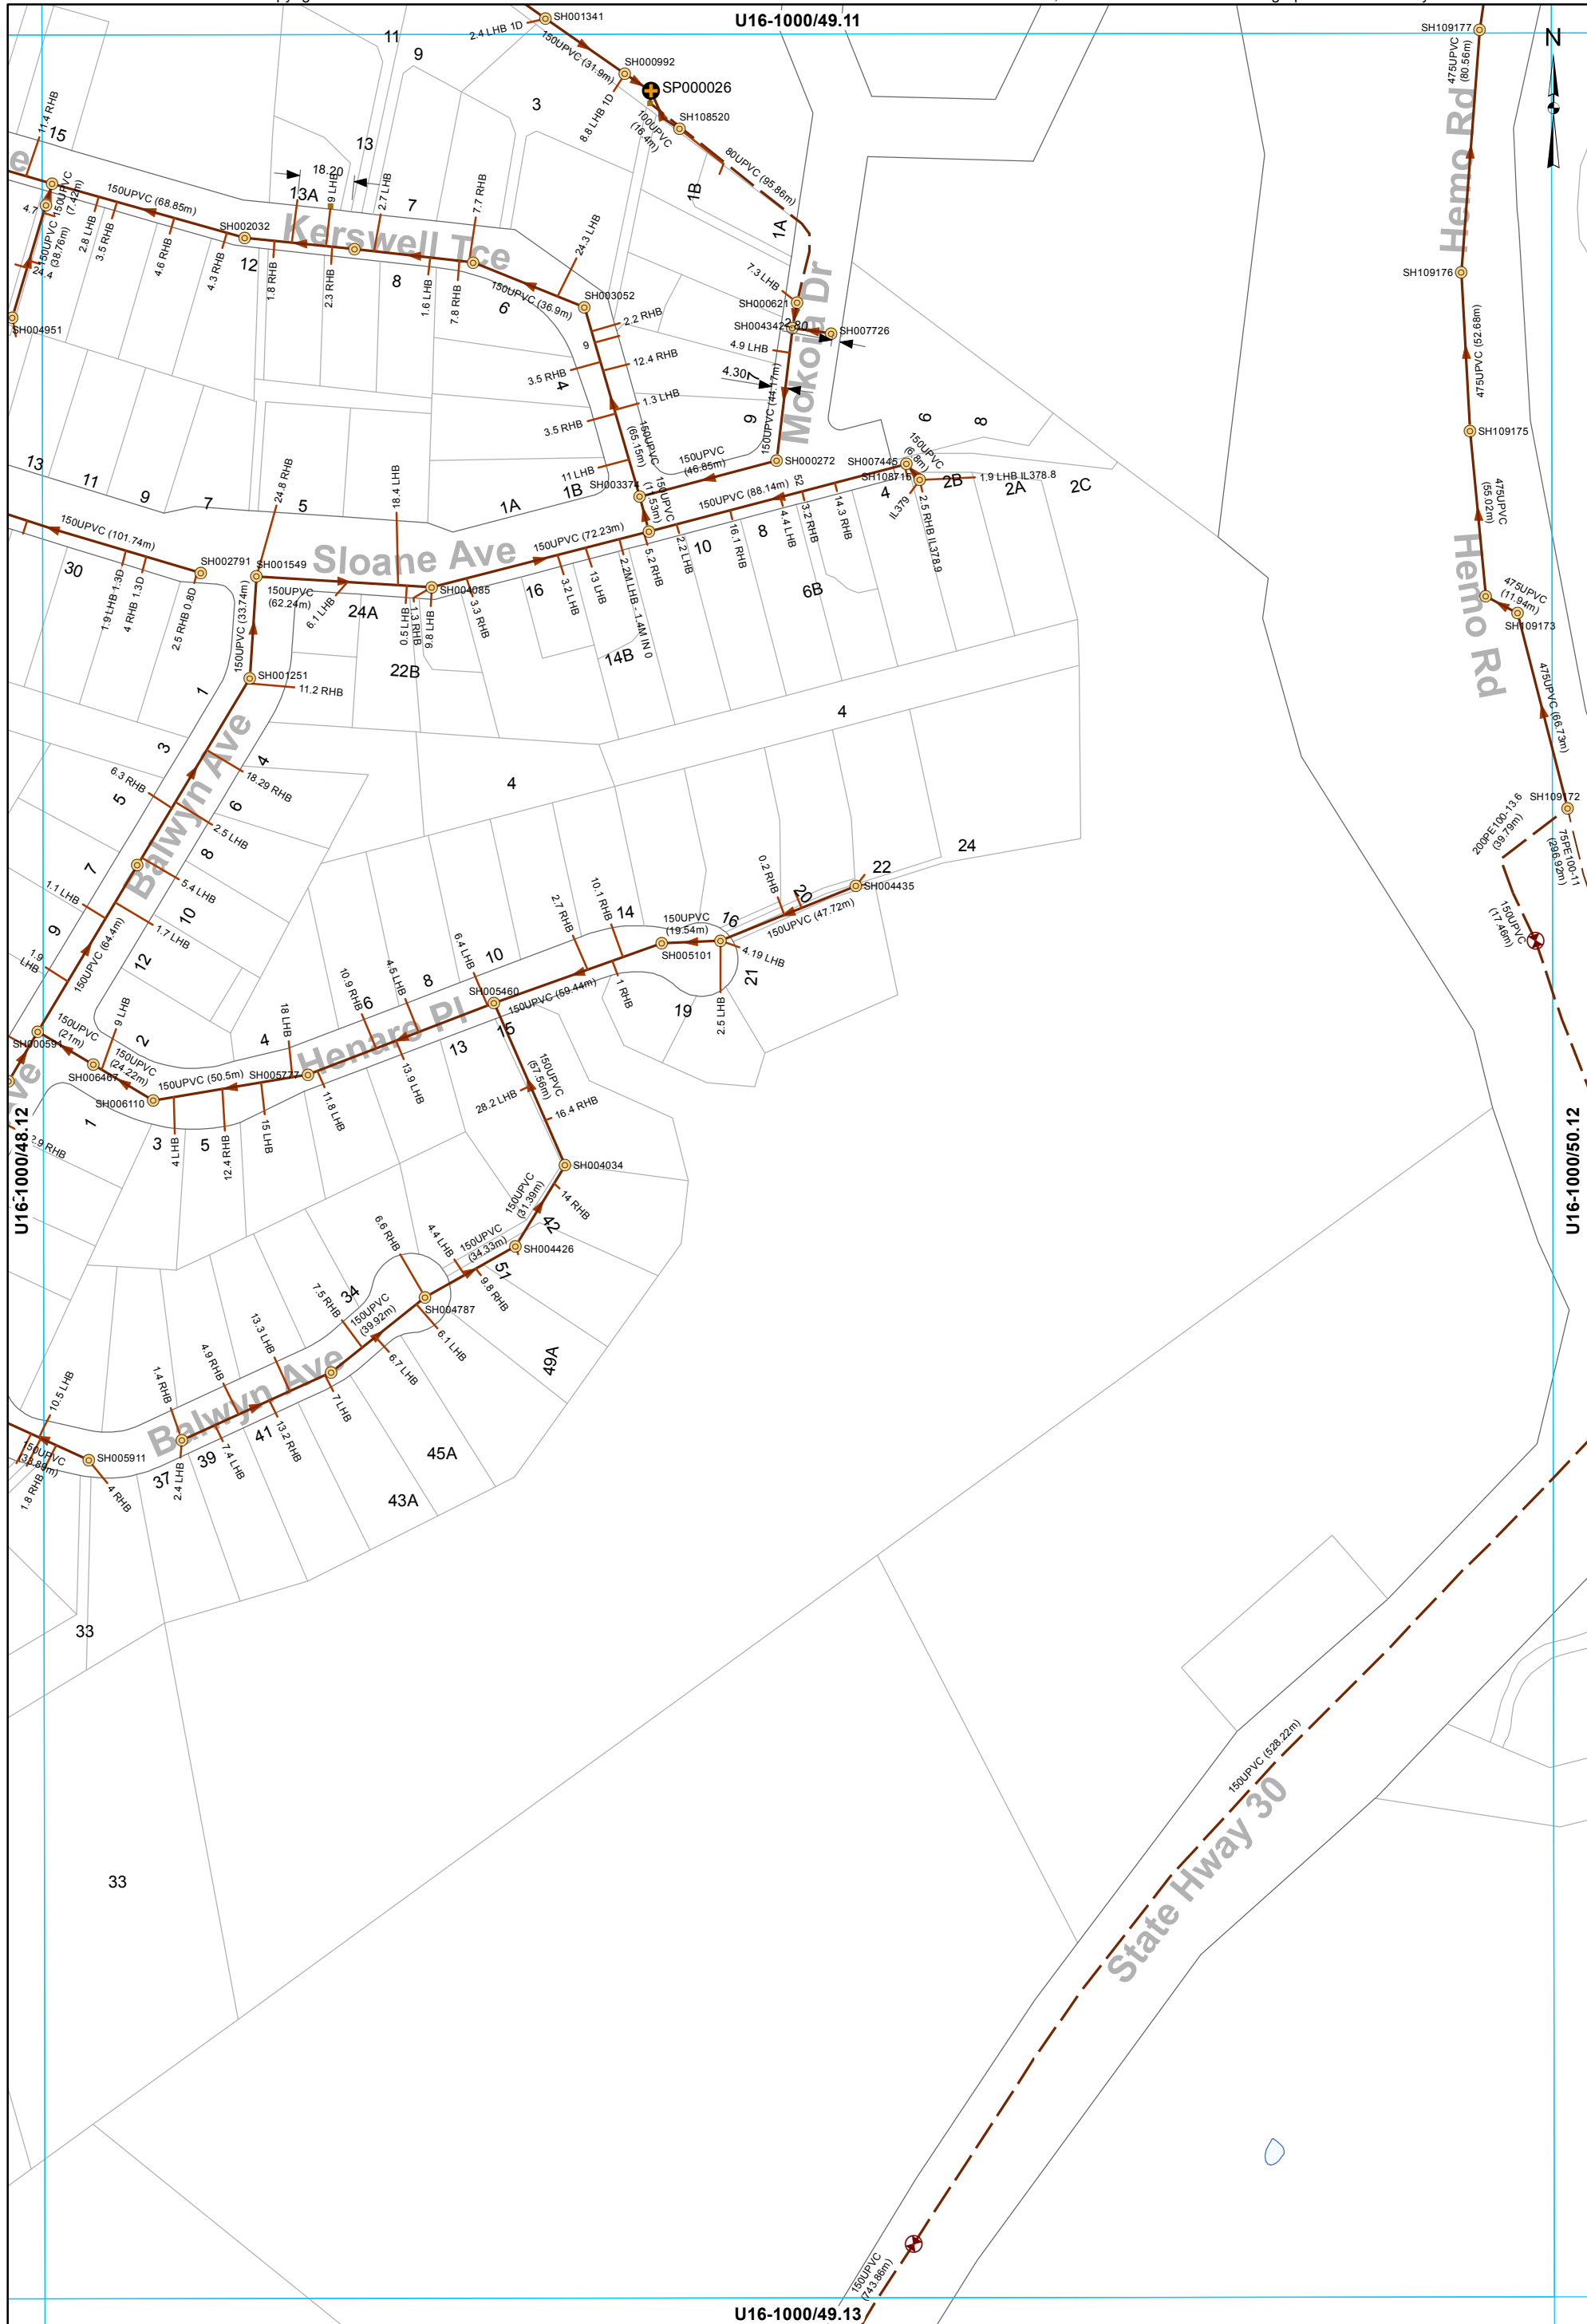


- Manhole
- Pump Station
- Chamber - Inspection
- Air Valve
- Low Pressure Main
- Main line
- Rising main
- Service Line

WASTEWATER SERVICES
1:2000 @ A3 - (U16-1000/49.12)

This data is derived from sources outside the control of Rotorua District Council and is for information only

Rotorua District Council 2006. Facsimile 07 346 3143 Telephone 07 348 4199 email mail@rdc.govt.nz

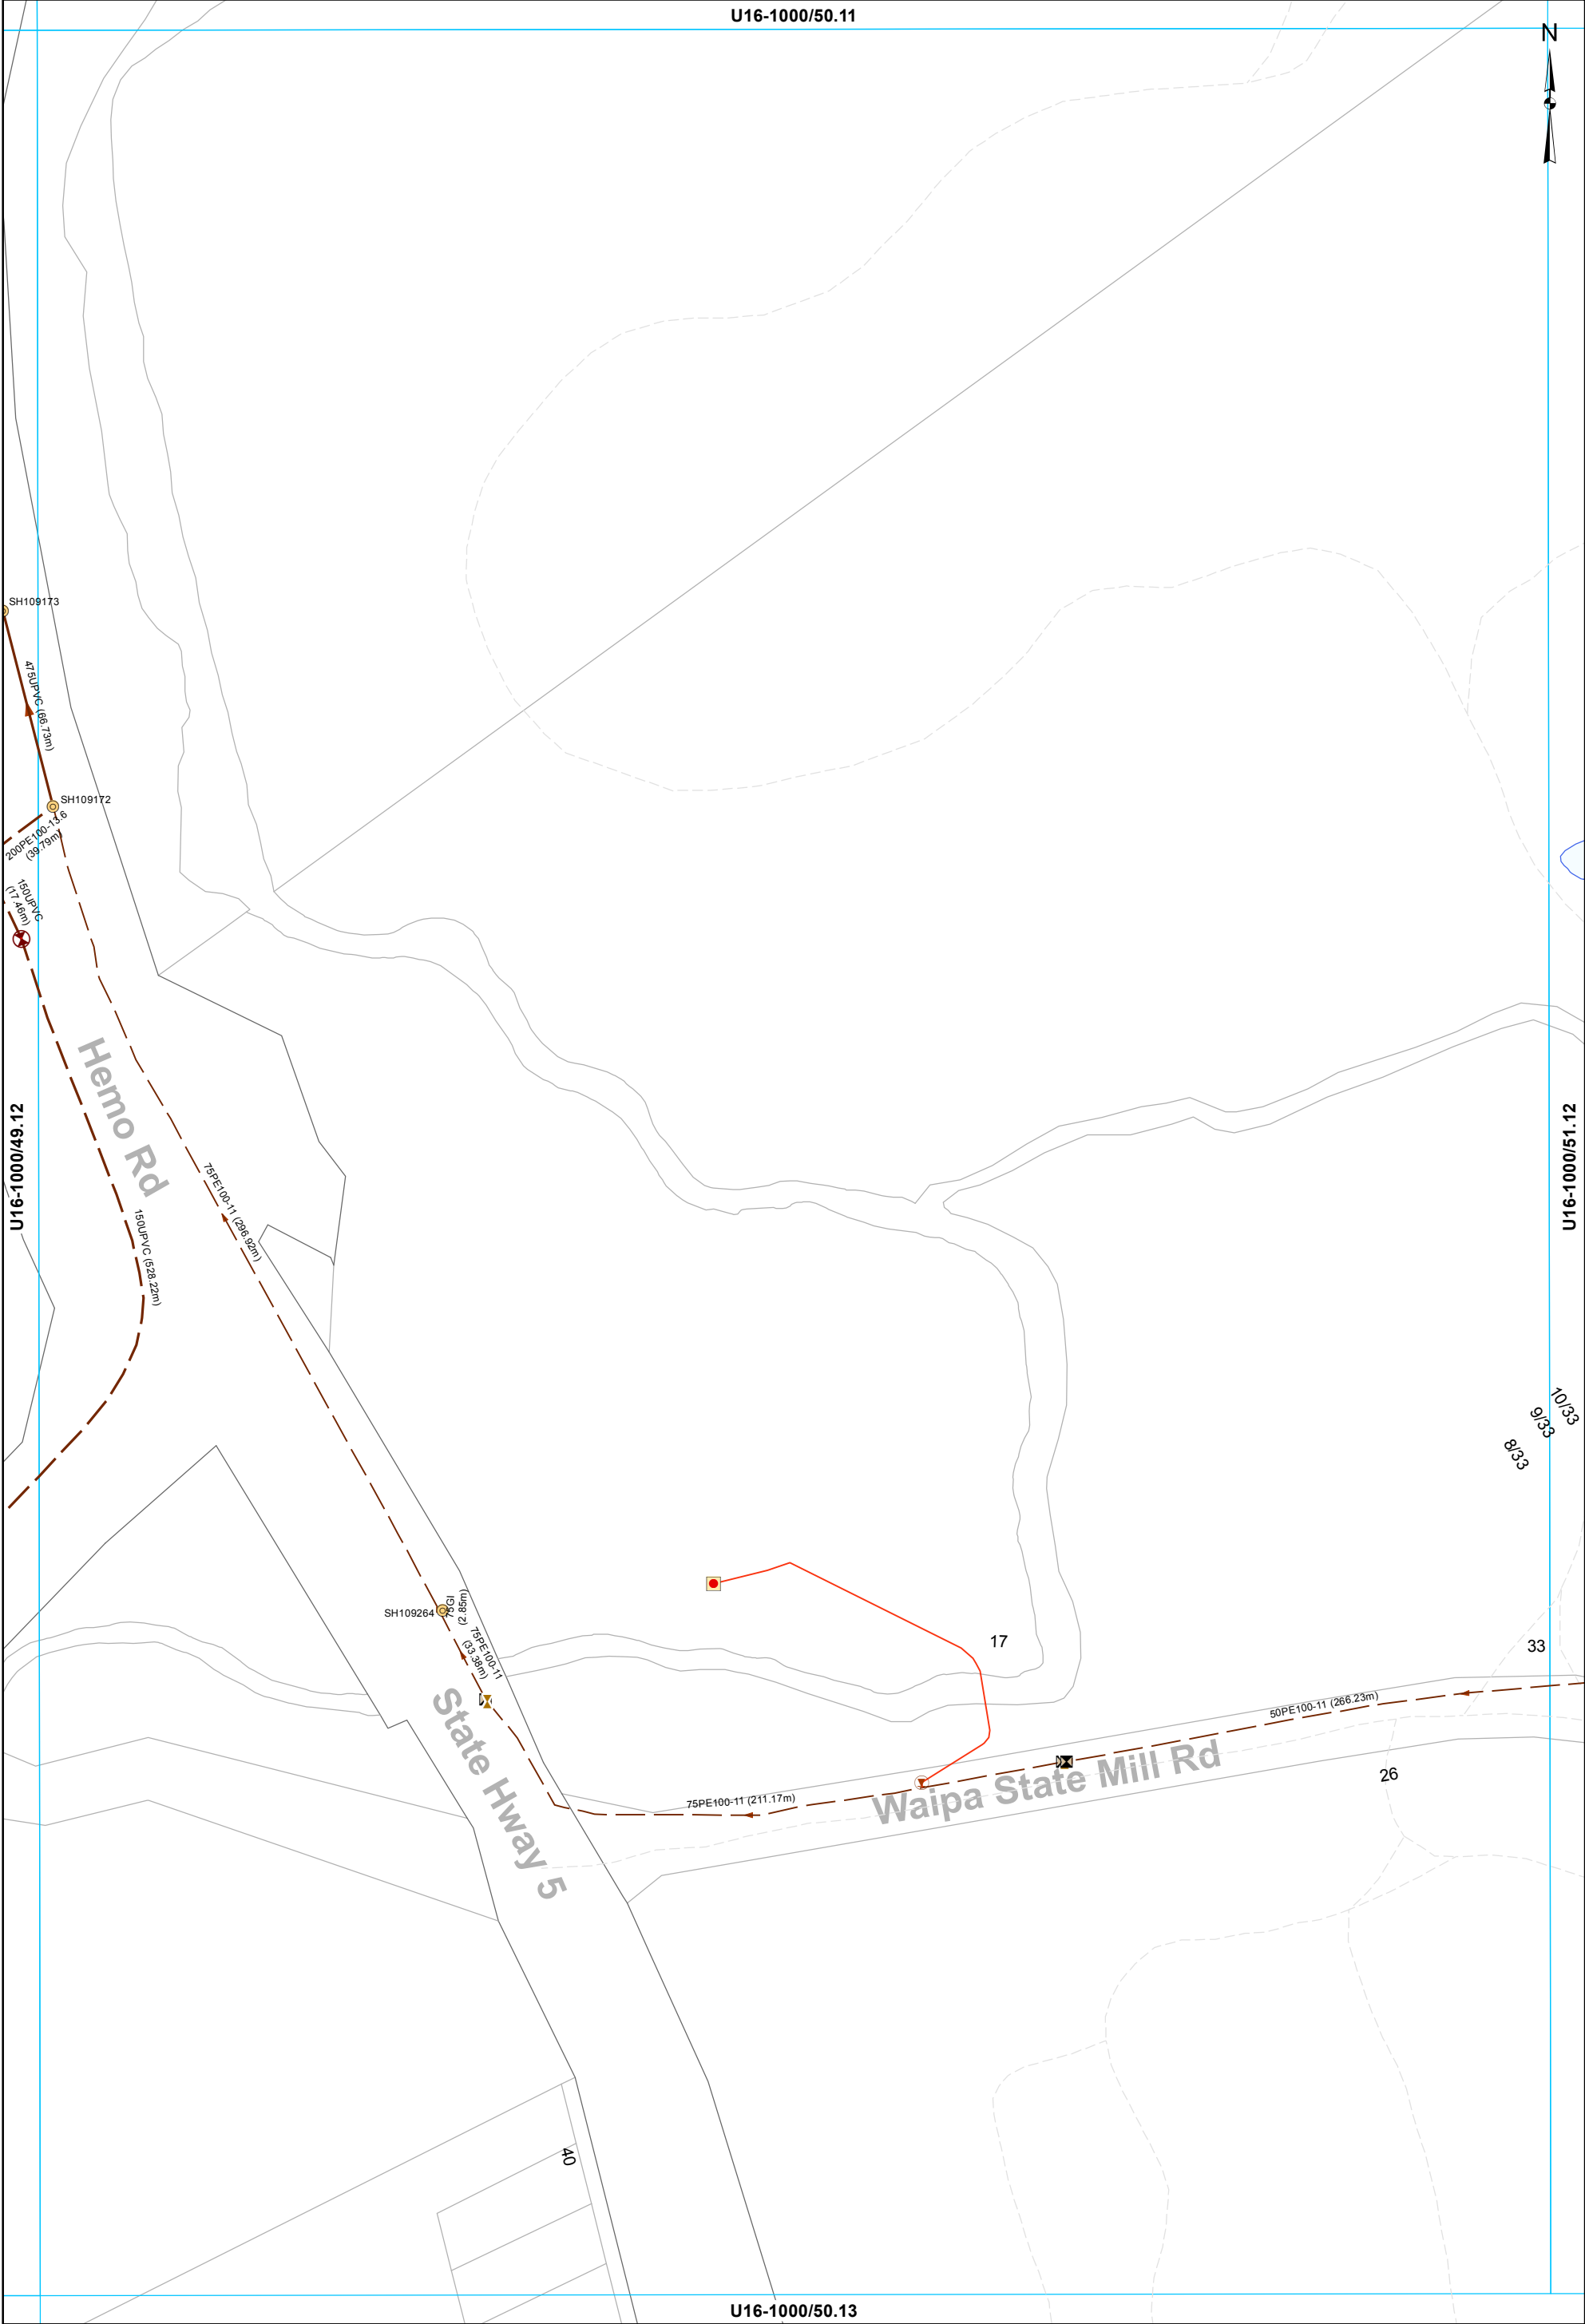


- | | | |
|----------------------|-------------------|---------------------|
| Manhole | Air Valve | - Low Pressure Main |
| Grinder Pump Chamber | Boundary Assembly | Main line |
| LP Grinder Pump | Clean Out Point | - Rising main |
| | Isolating Valve | LPGP Service Line |

WASTEWATER SERVICES
1:2000 @ A3 - (U16-1000/50.12)

This data is derived from sources outside the control of Rotorua District Council and is for information only

All dimensions and levels should be verified by physical location on-site.

Rotorua District Council 2006. Facsimile 07 346 3143 Telephone 07 348 4199 email mail@rdc.govt.nz

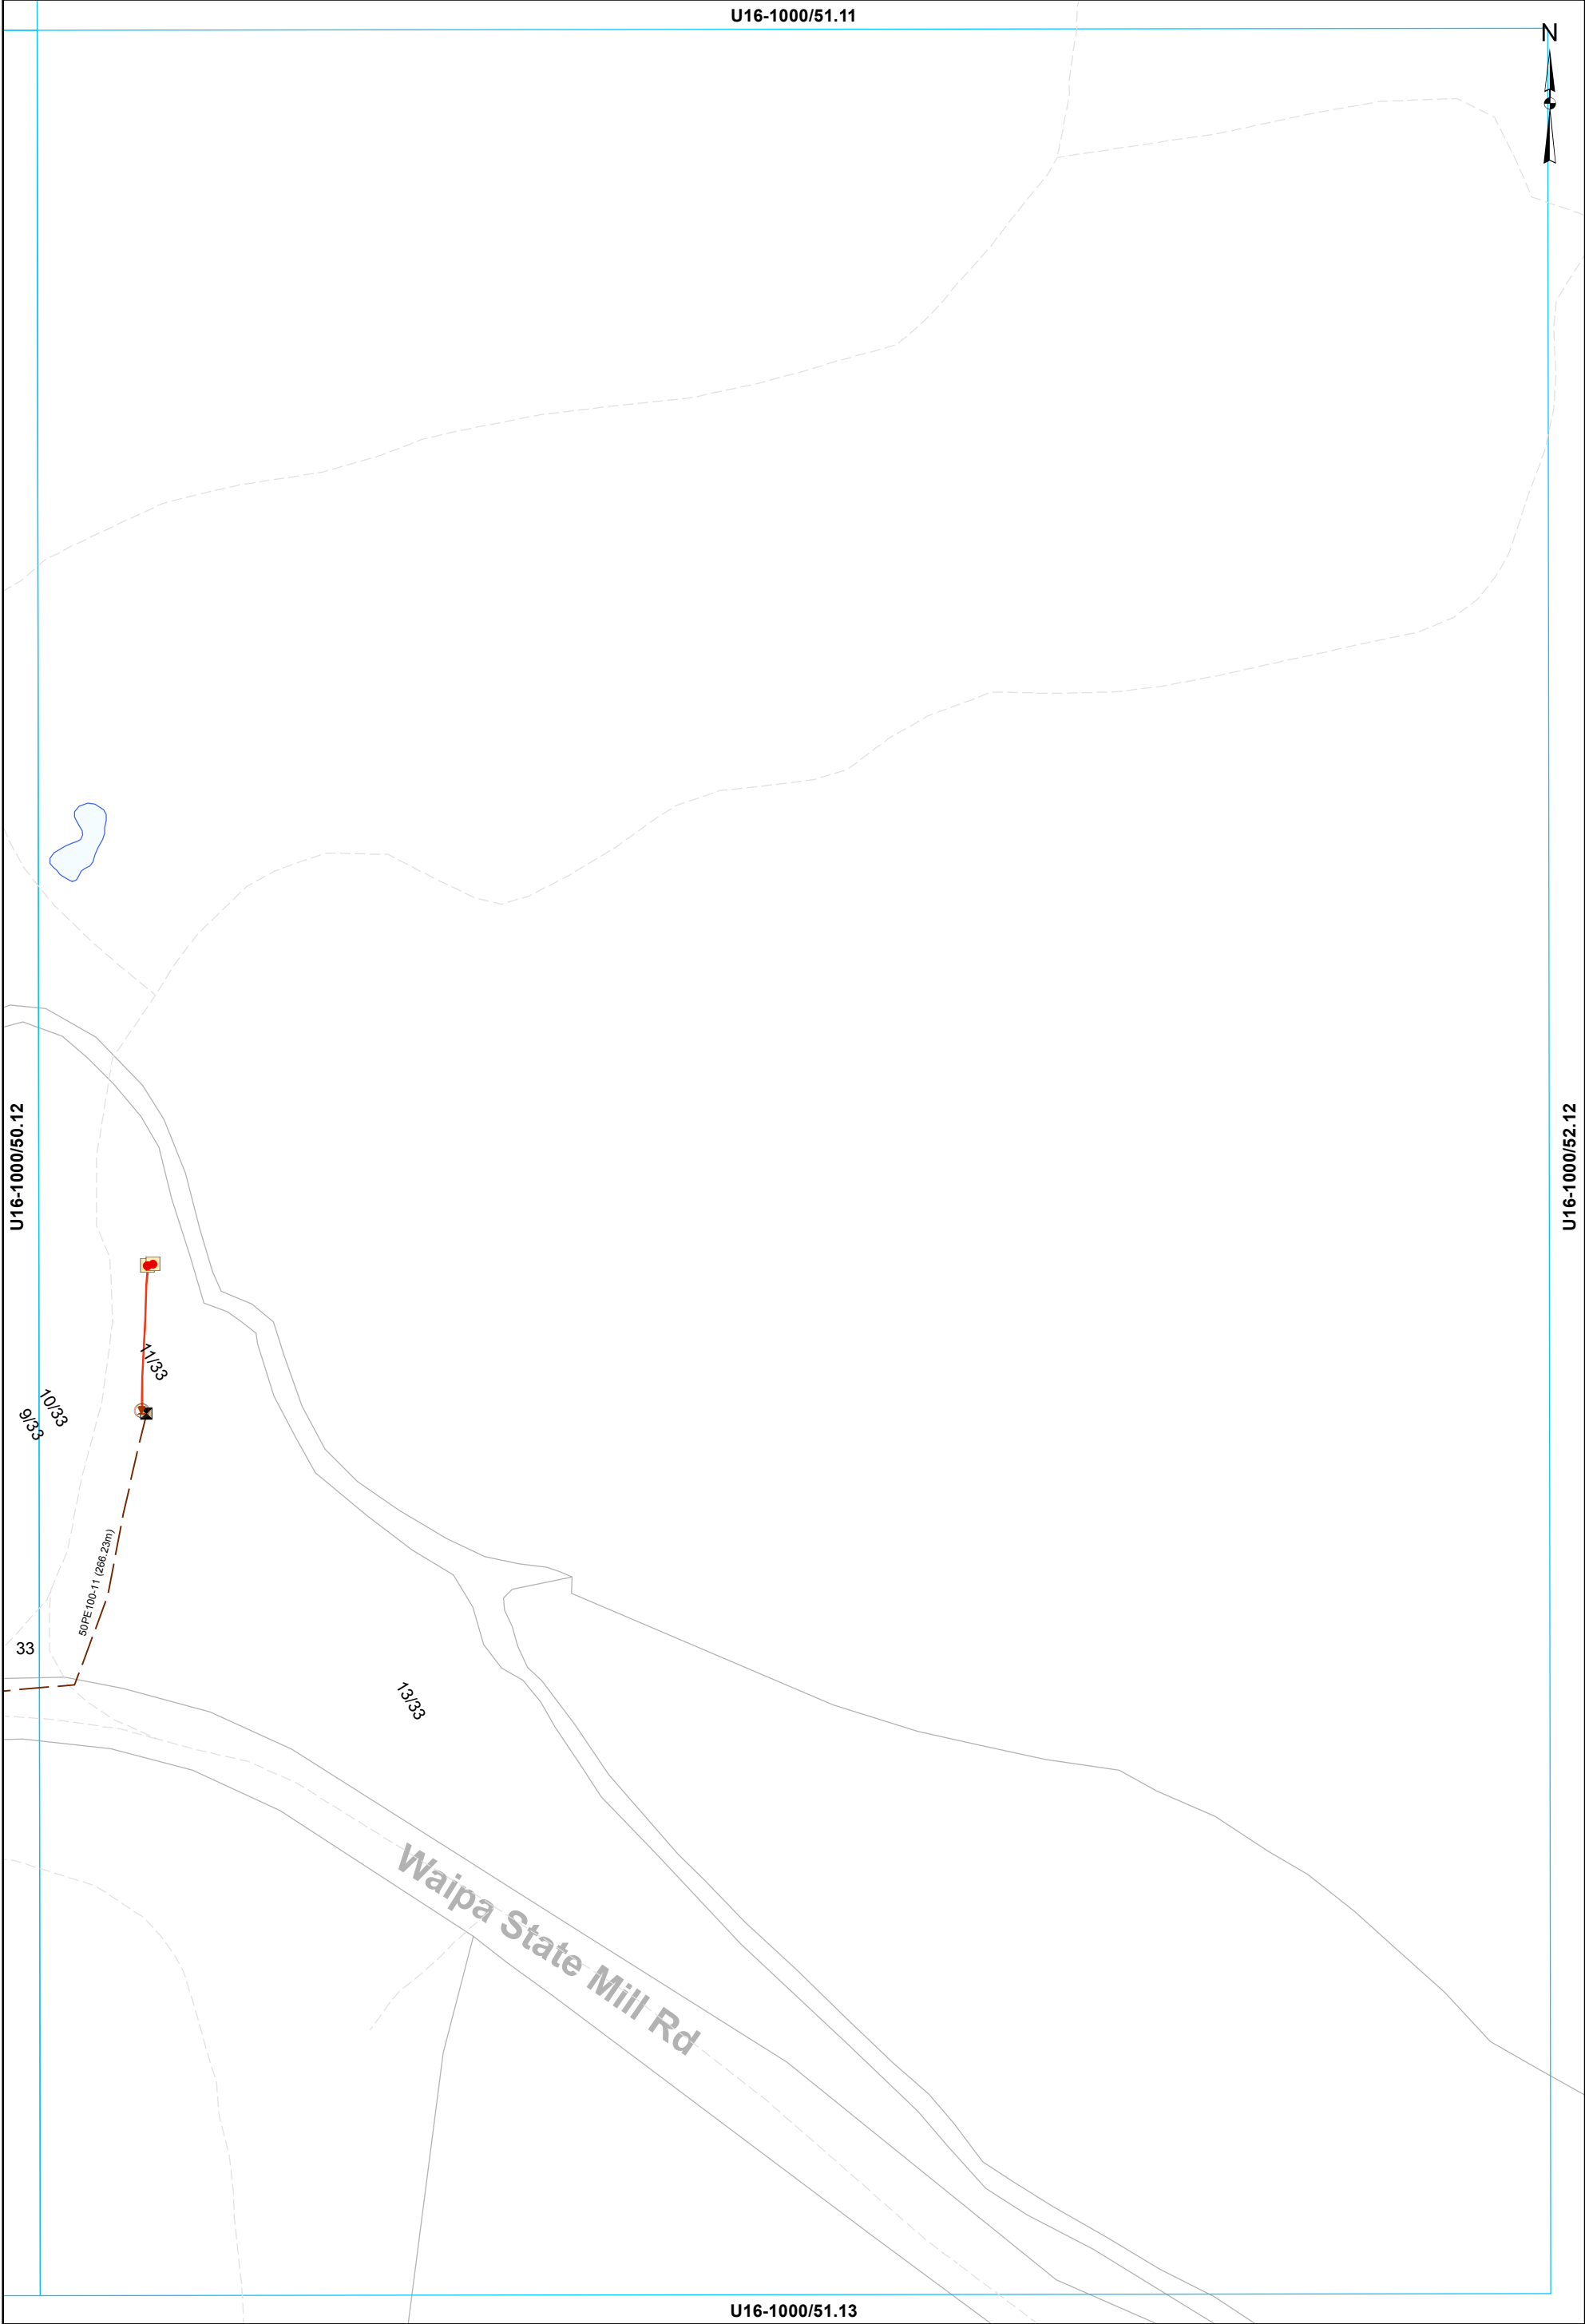


- | | | |
|----------------------|-------------------|----------------------|
| Grinder Pump Chamber | Boundary Assembly | Low Pressure Main |
| LP Grinder Pump | Clean Out Point | Unknown Service Line |
| | | LPGP Service Line |

WASTEWATER SERVICES
1:2000 @ A3 - (U16-1000/51.12)

This data is derived from sources outside the control of Rotorua District Council and is for information only


Rotorua District Council 2006. Facsimile 07 346 3143 Telephone 07 348 4199 email mail@rdc.govt.nz

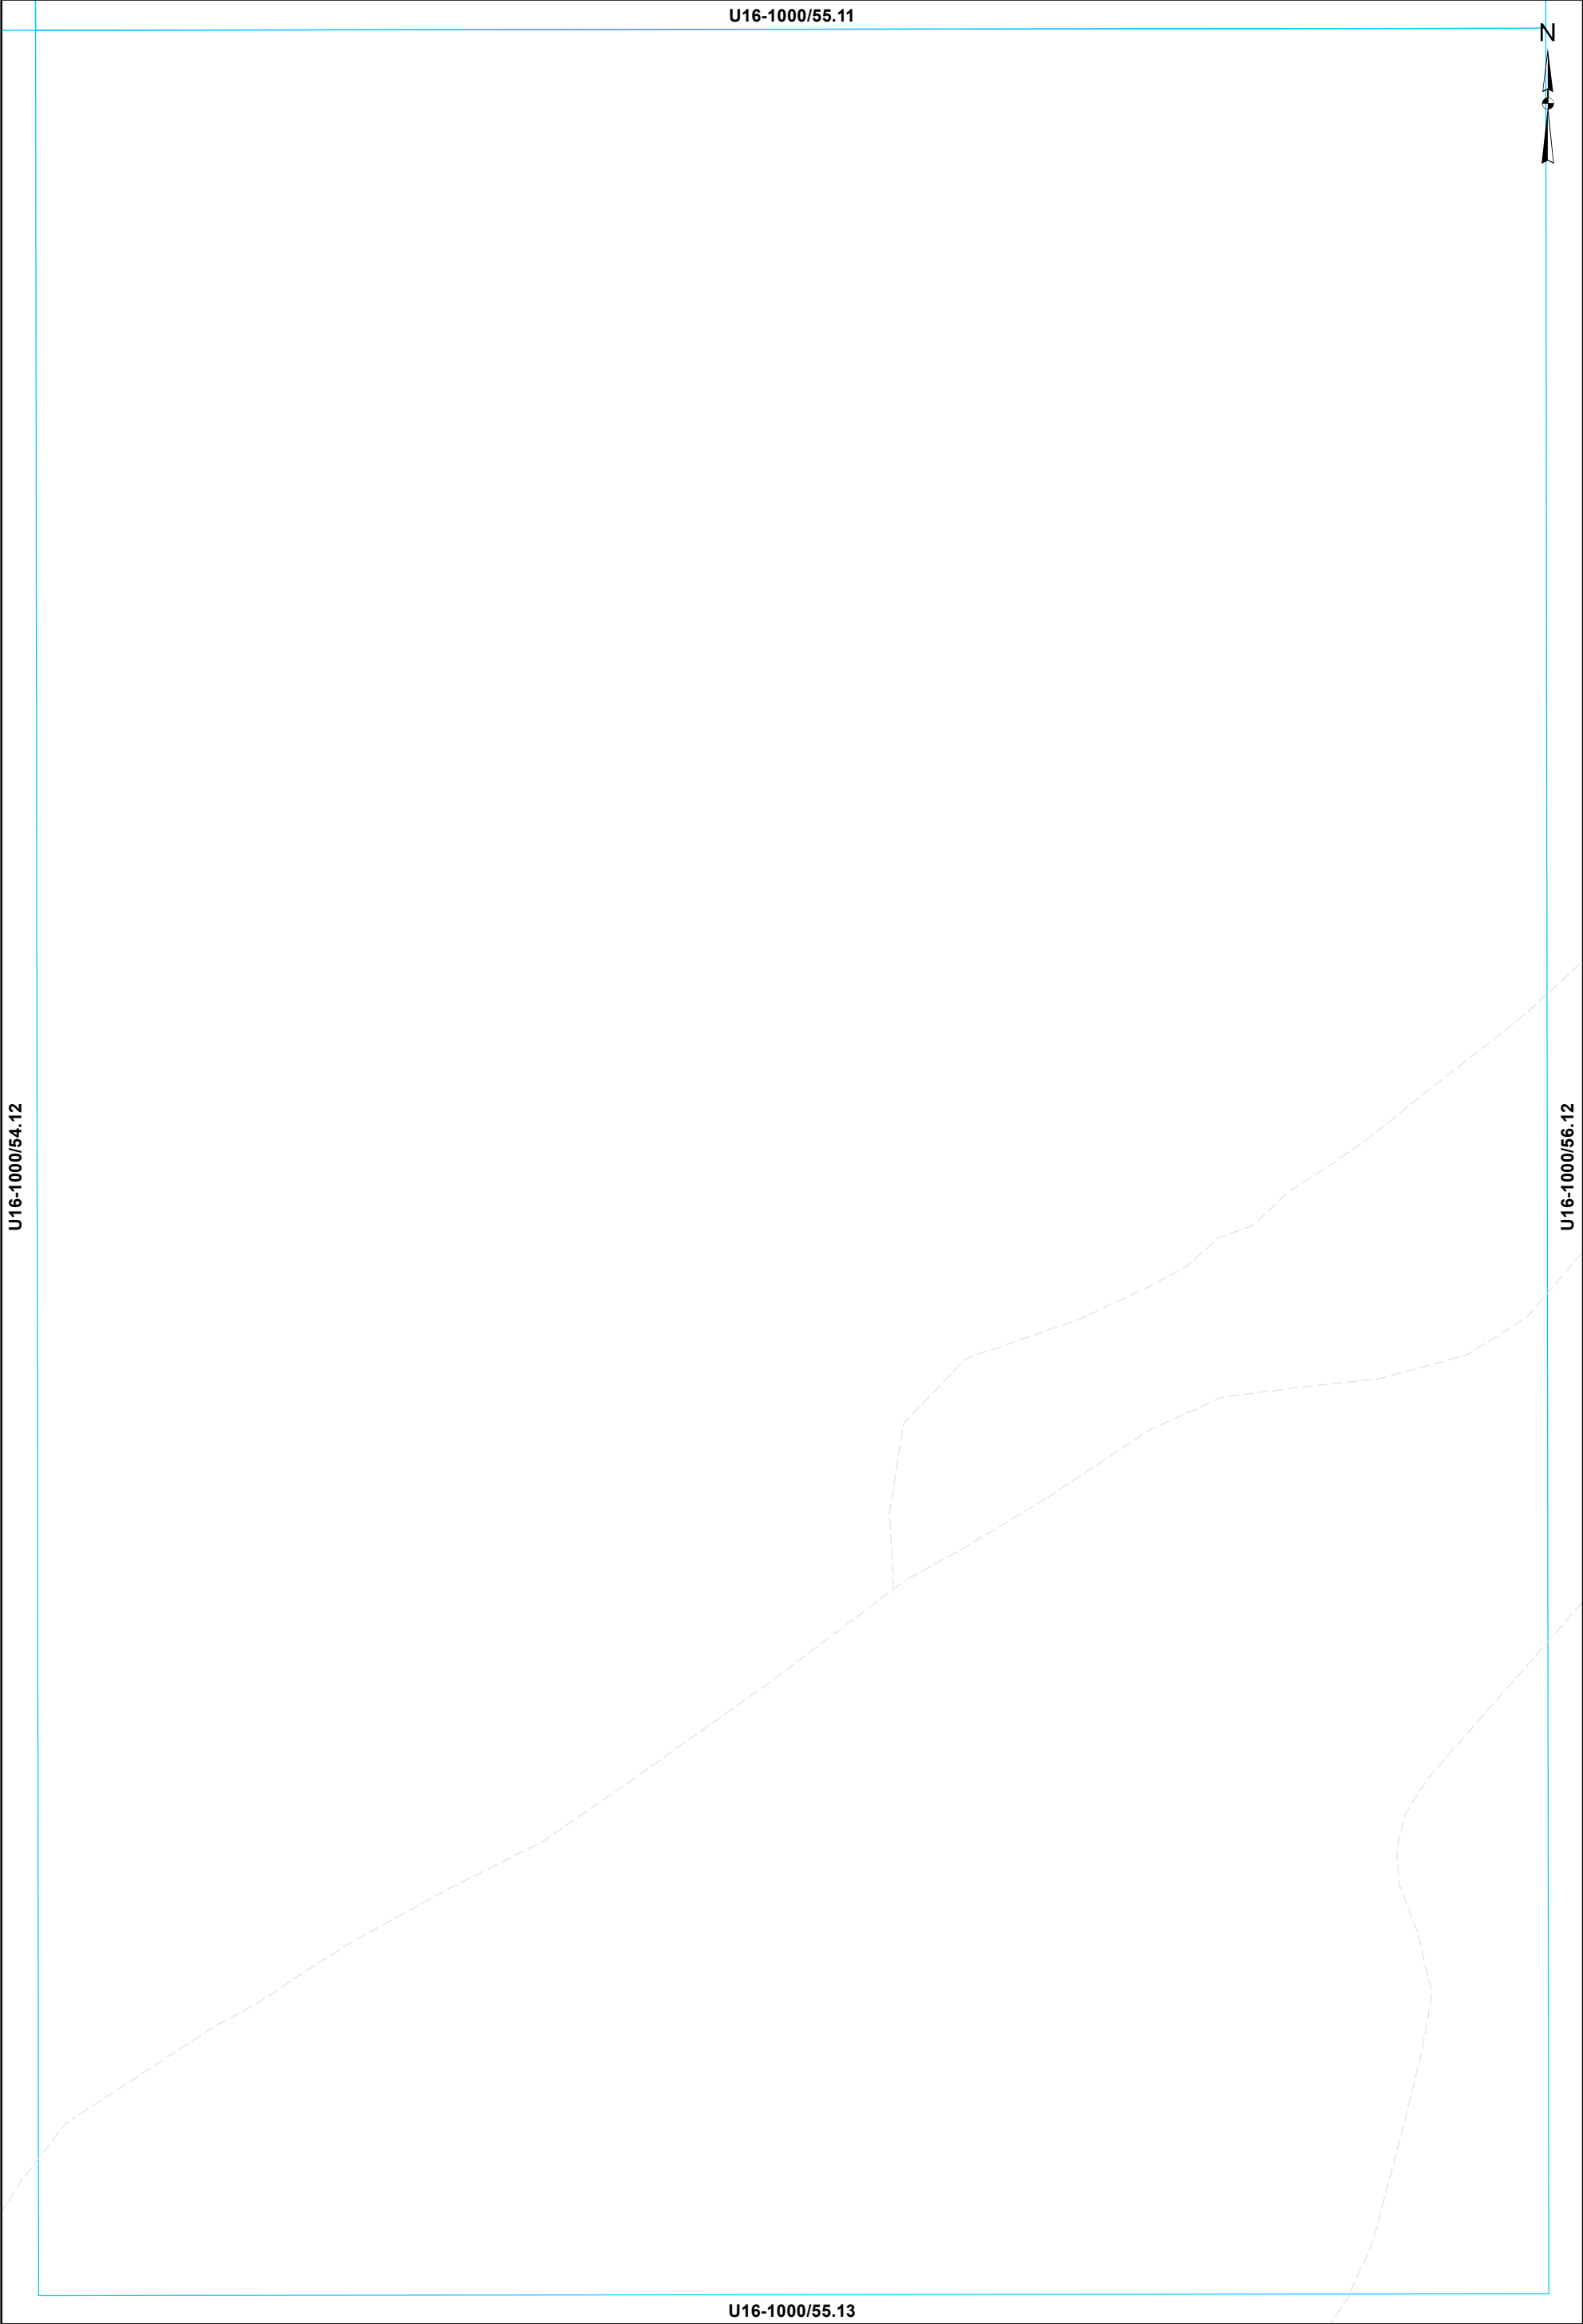

This data is derived from sources outside the control of Rotorua District Council and is for information only

All dimensions and levels should be verified by physical location on-site.

Rotorua District Council 2006. Facsimile 07 346 3143 Telephone 07 348 4199 email mail@rdc.govt.nz

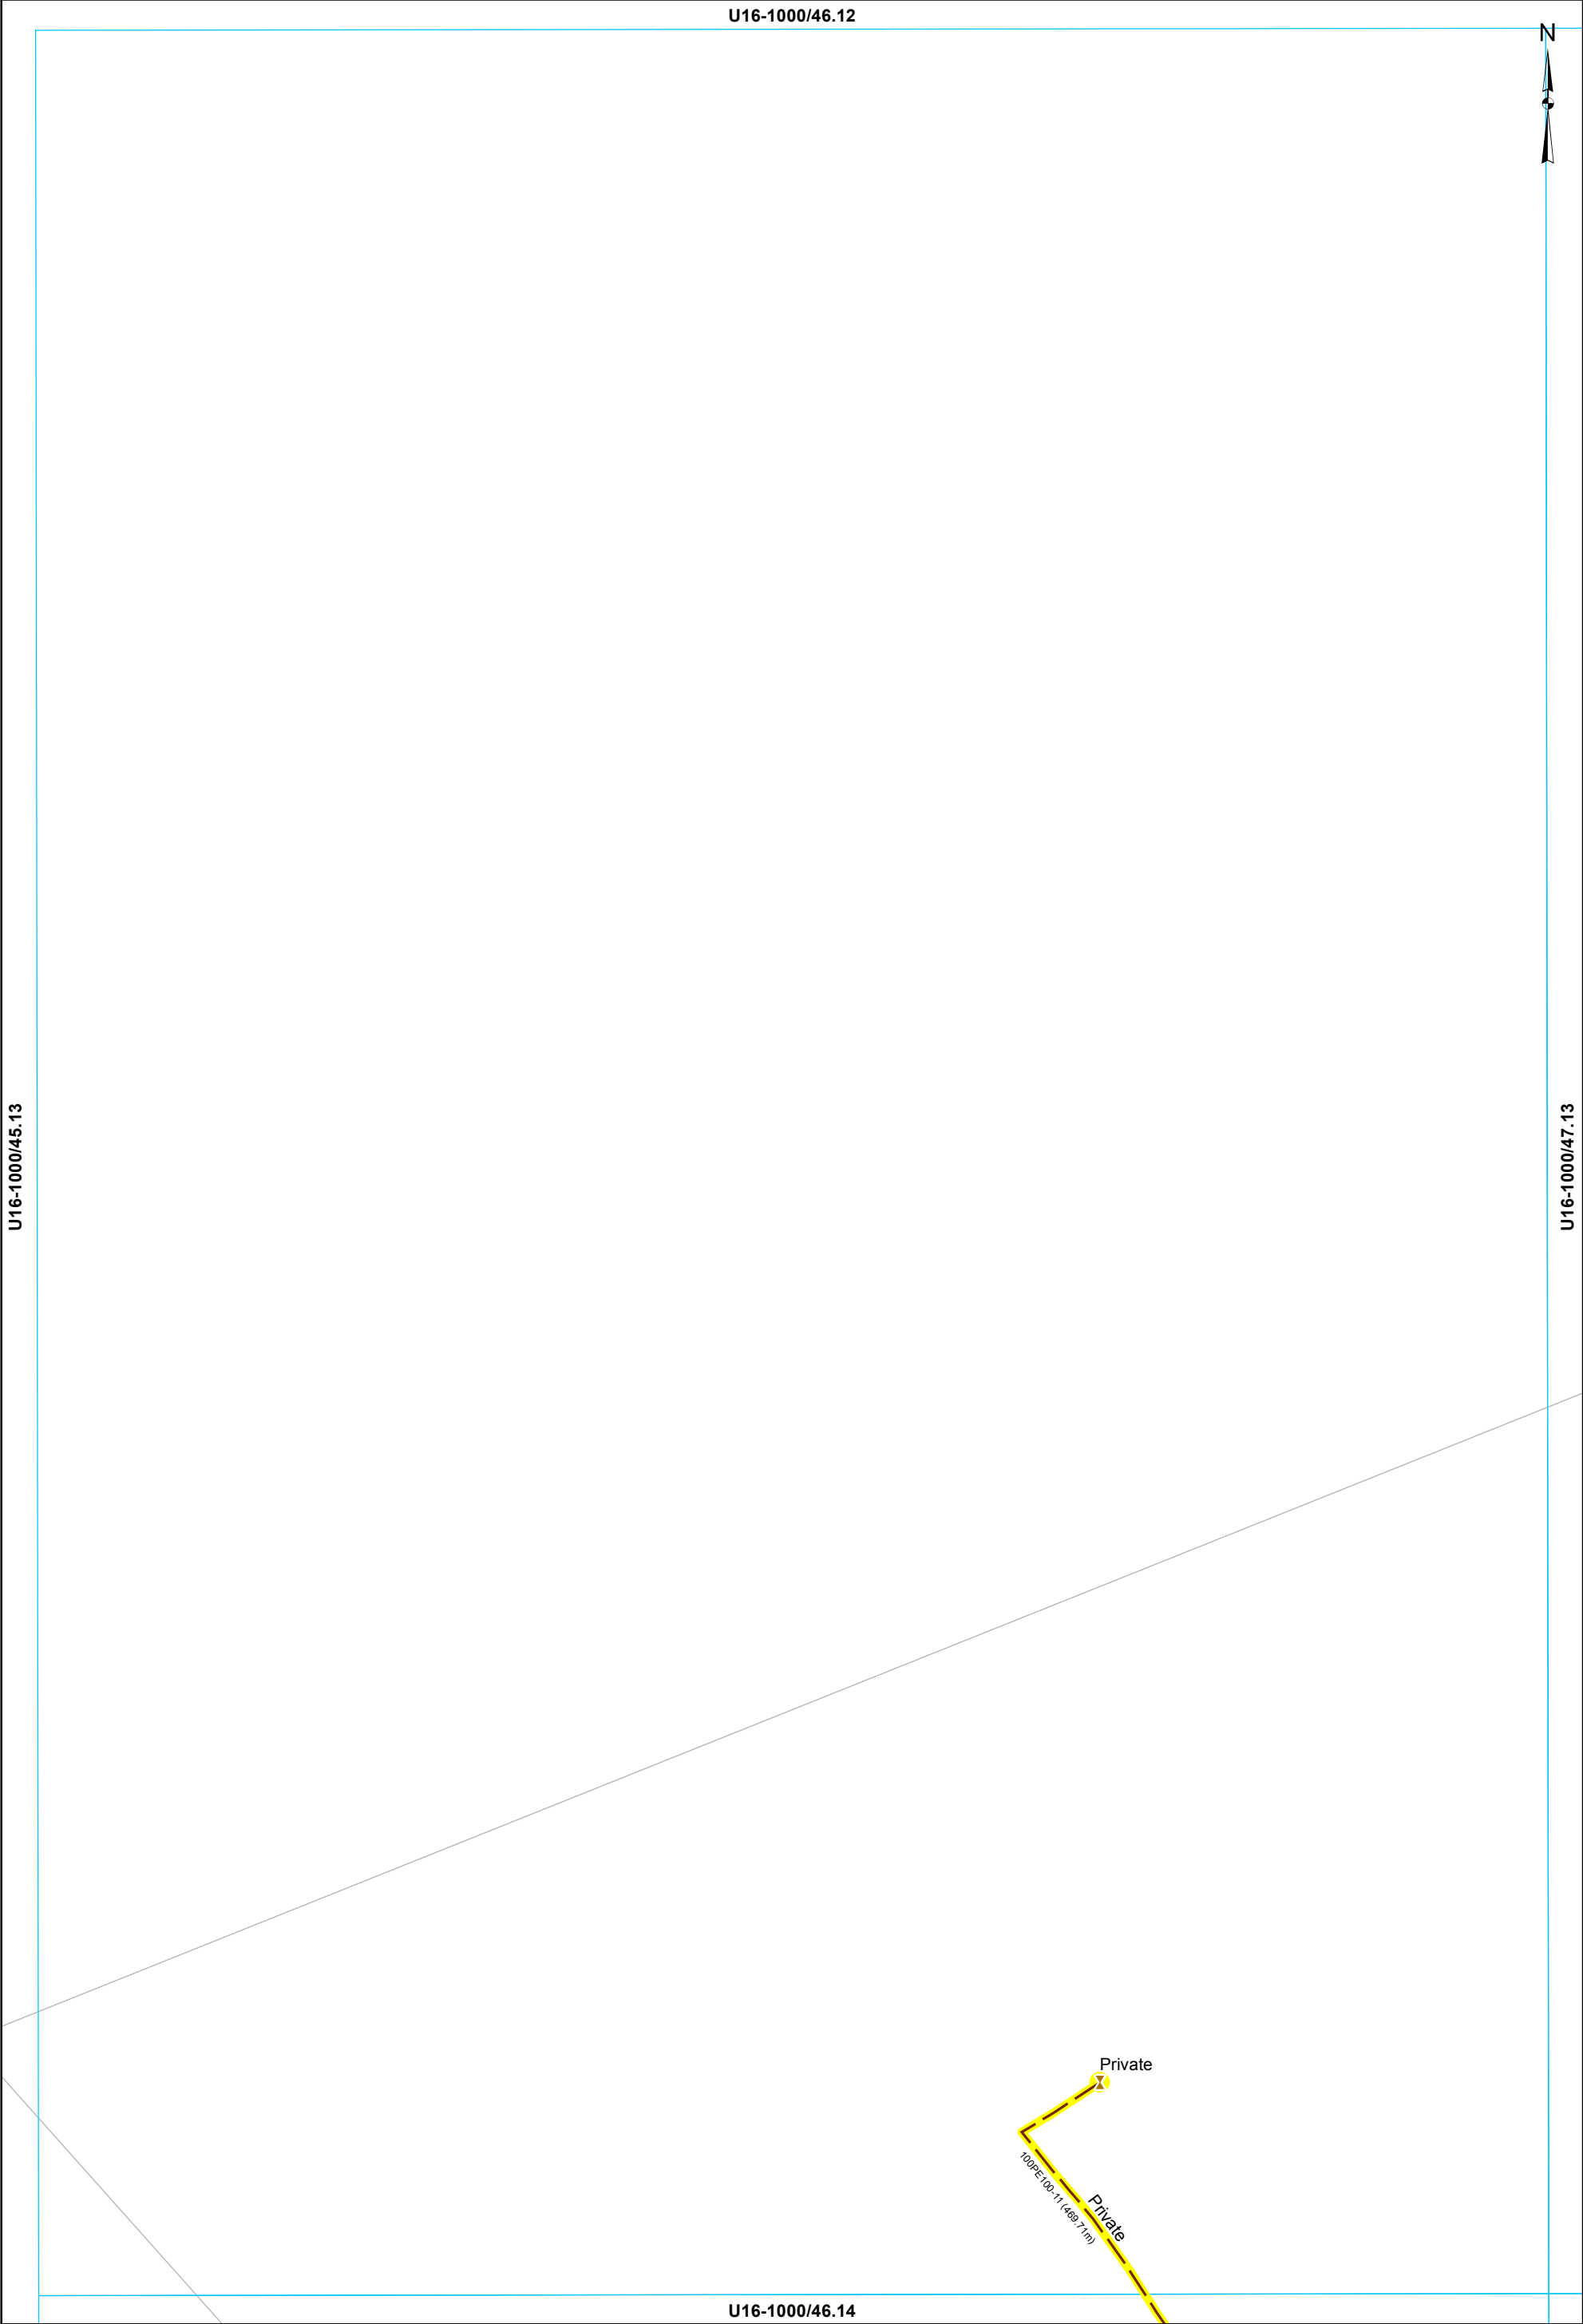


Isolating Valve

Private Asset


Private Asset

Rising main

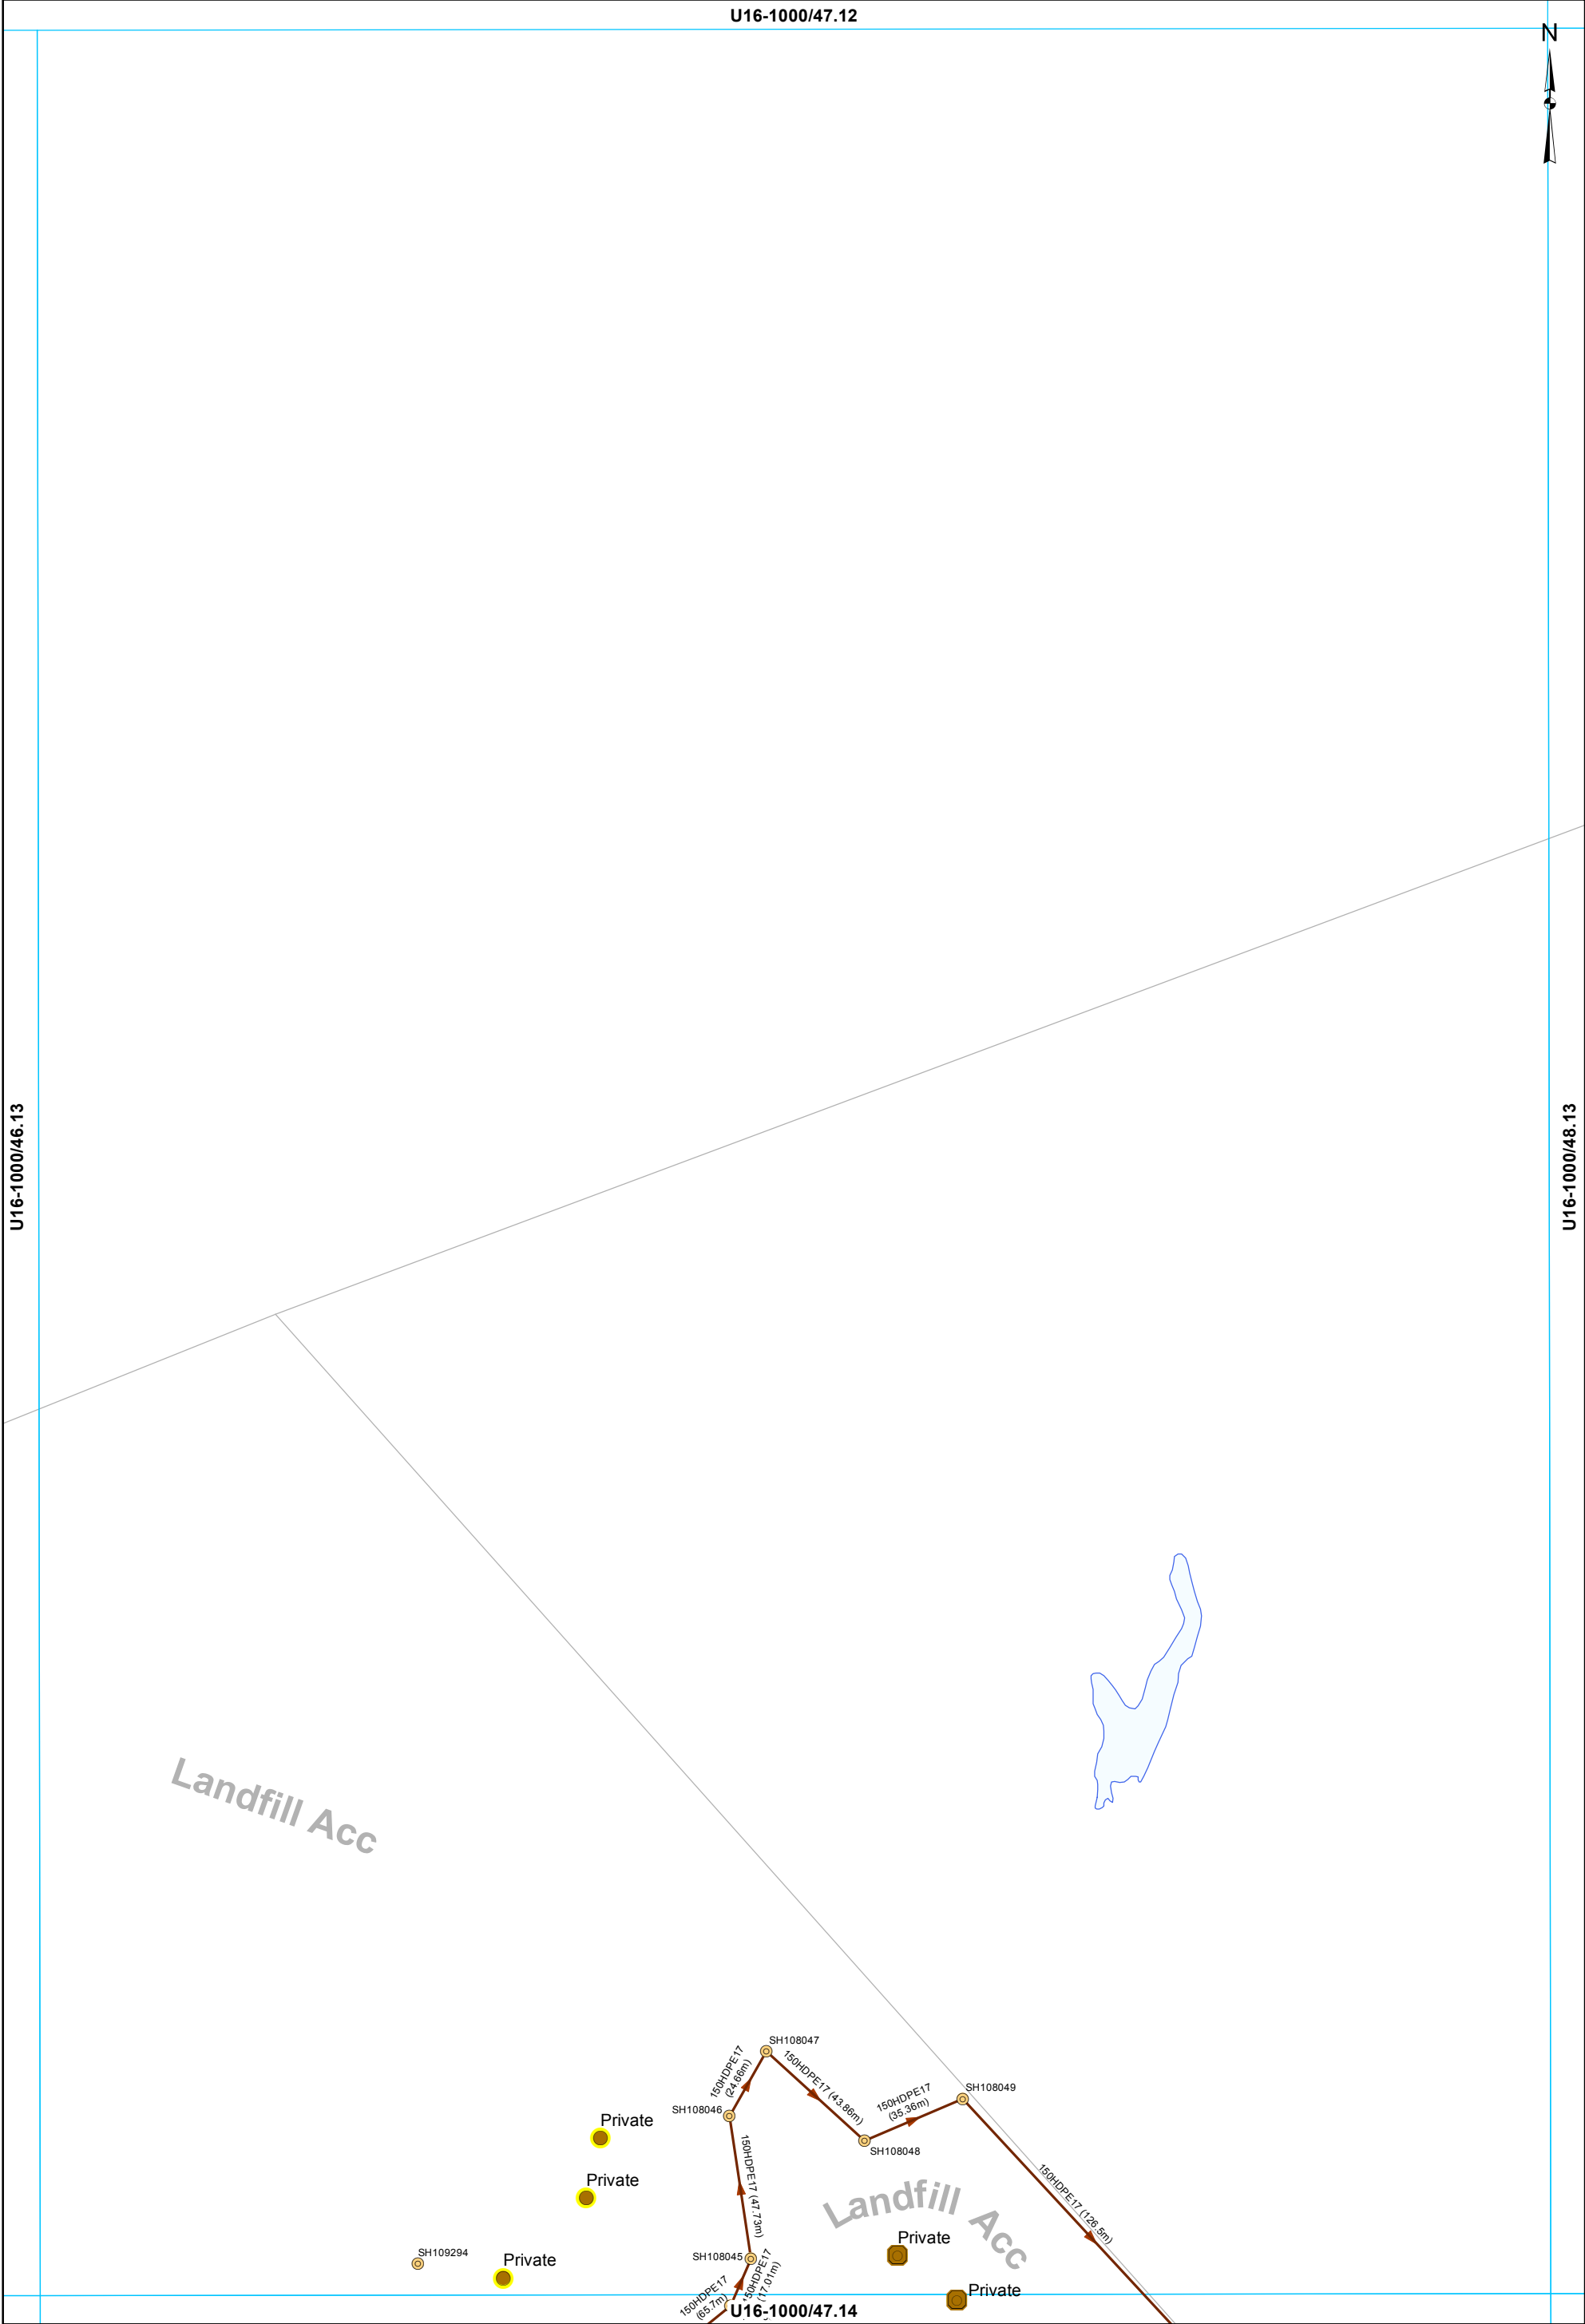

- Manhole
 - Chamber manhole for multiple services
 - Bore Test
 - Private Asset
- Main line

WASTEWATER SERVICES
1:2000 @ A3 - (U16-1000/47.13)

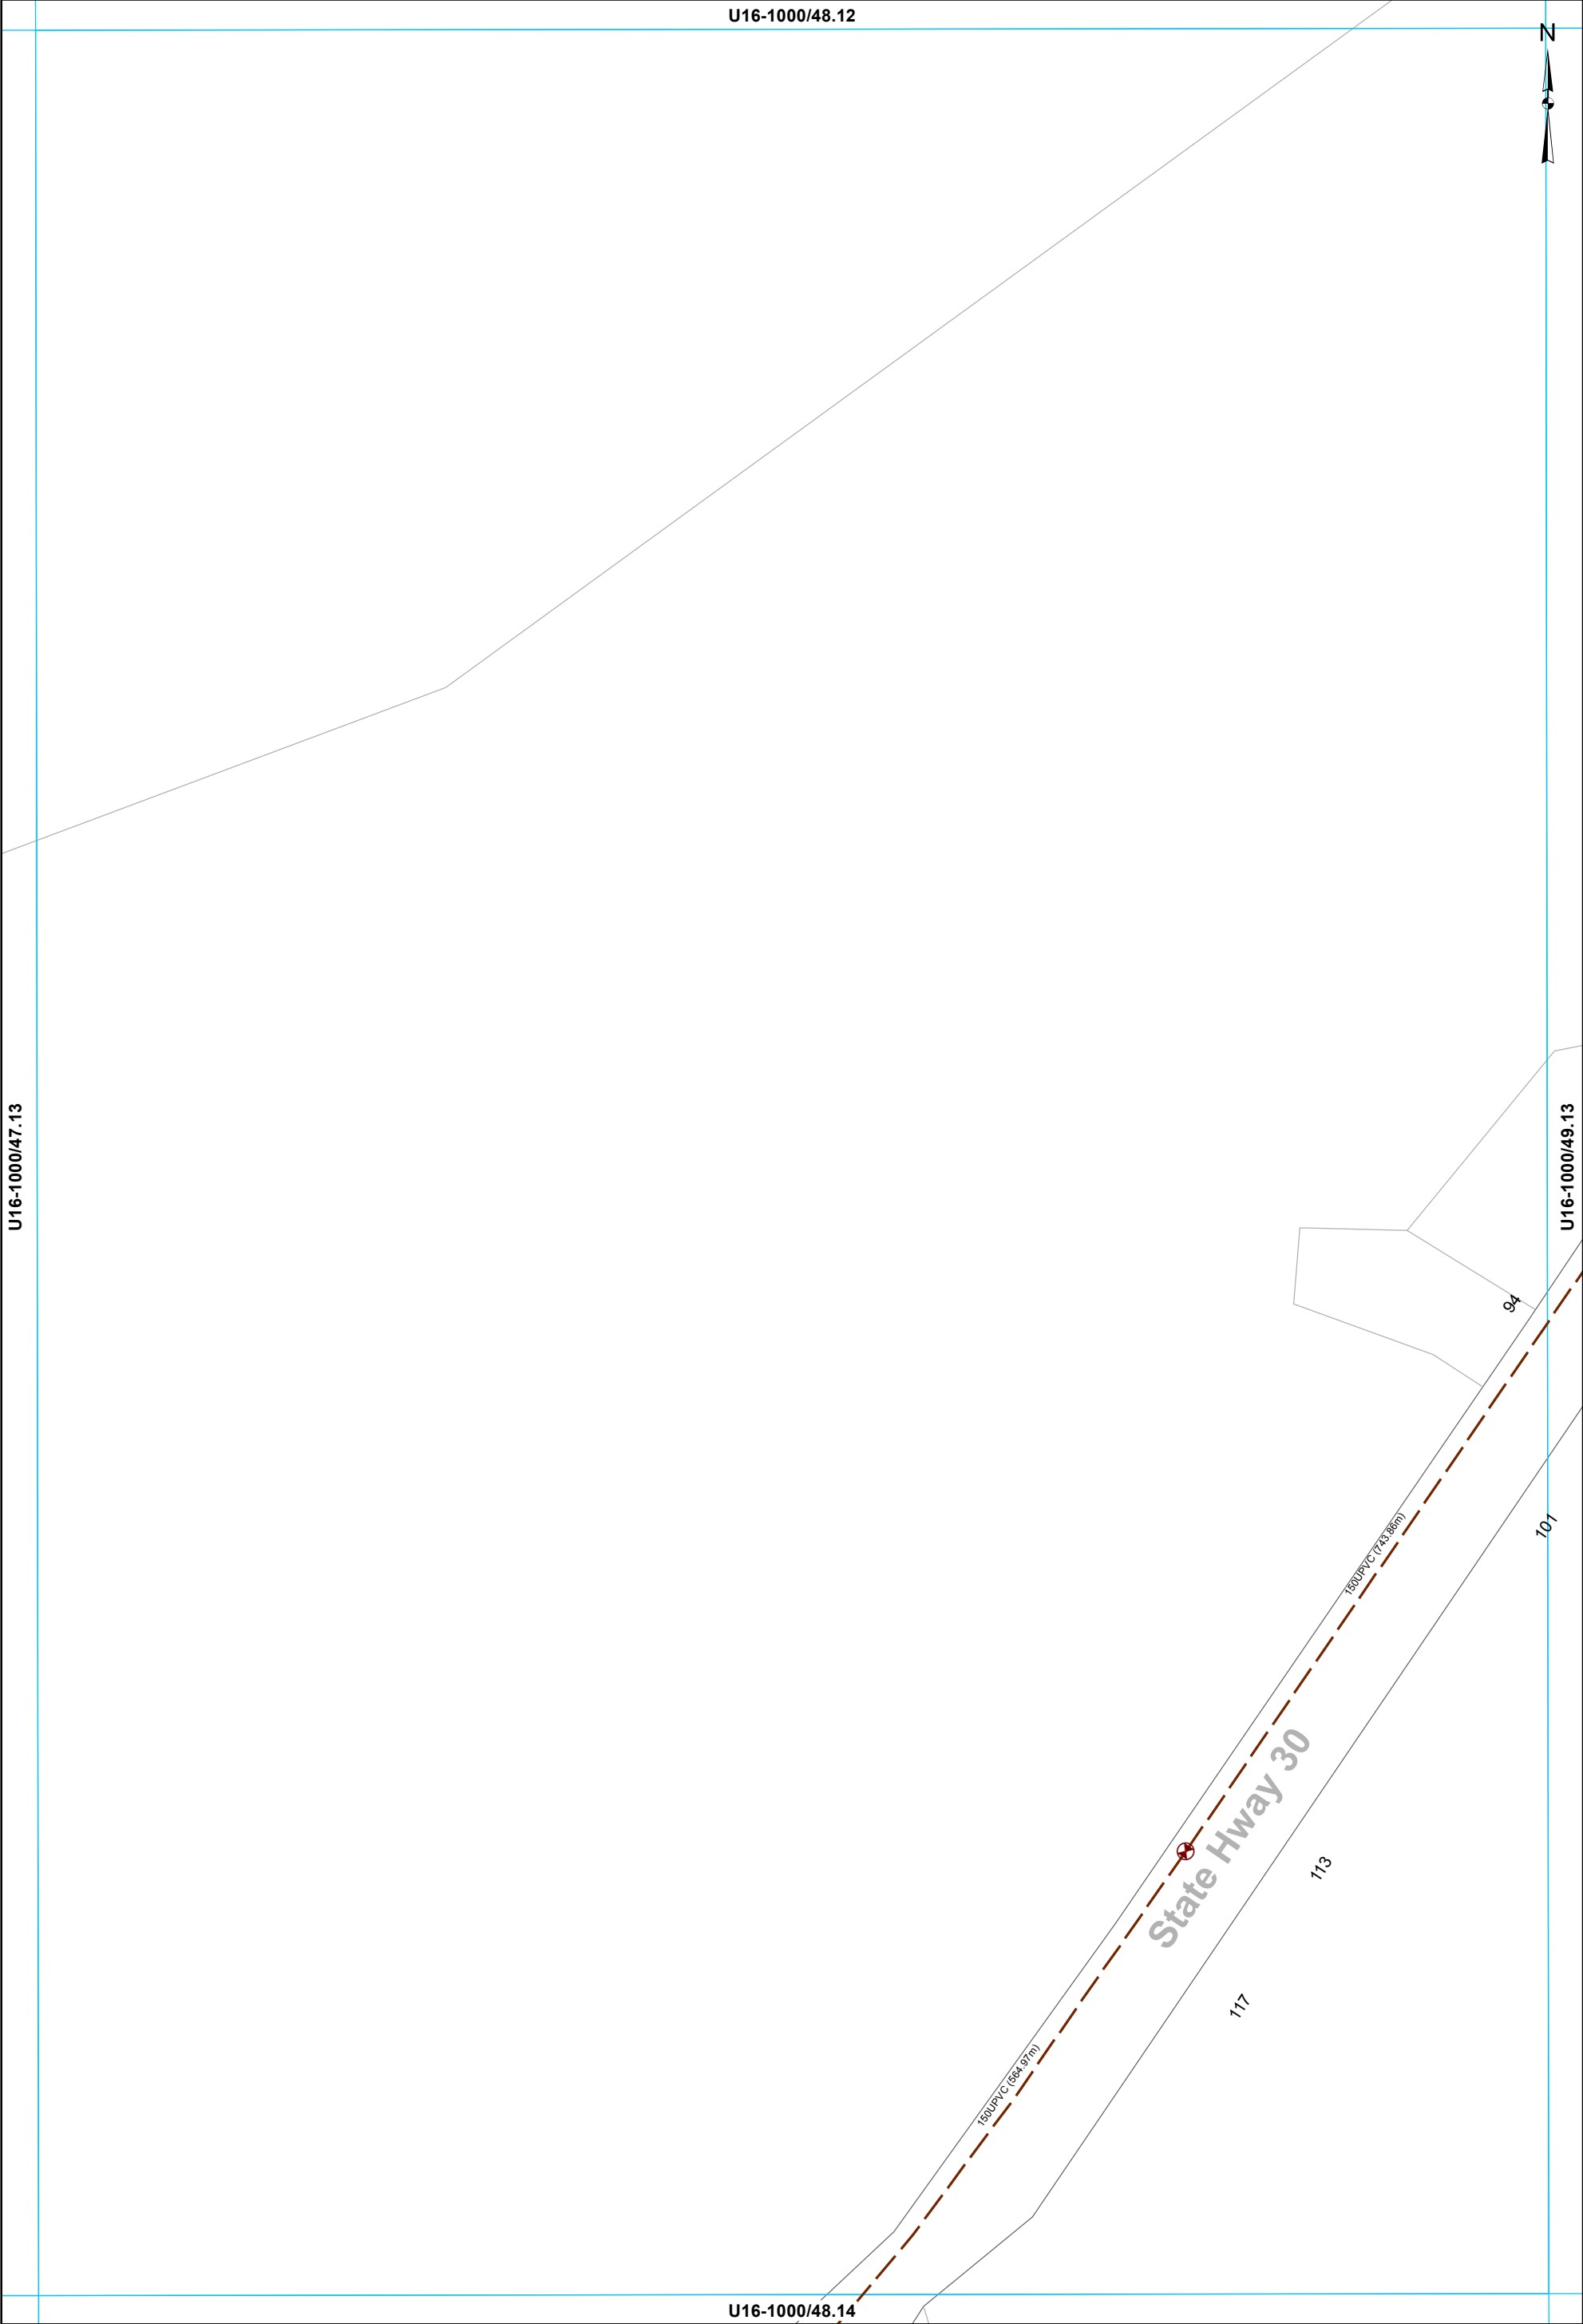


⊗ Air Valve - Rising main

WASTEWATER SERVICES
1:2000 @ A3 - (U16-1000/48.13)

This data is derived from sources outside the control of Rotorua District Council and is for information only

Rotorua District Council 2006. Facsimile 07 346 3143 Telephone 07 348 4199 email mail@rdc.govt.nz

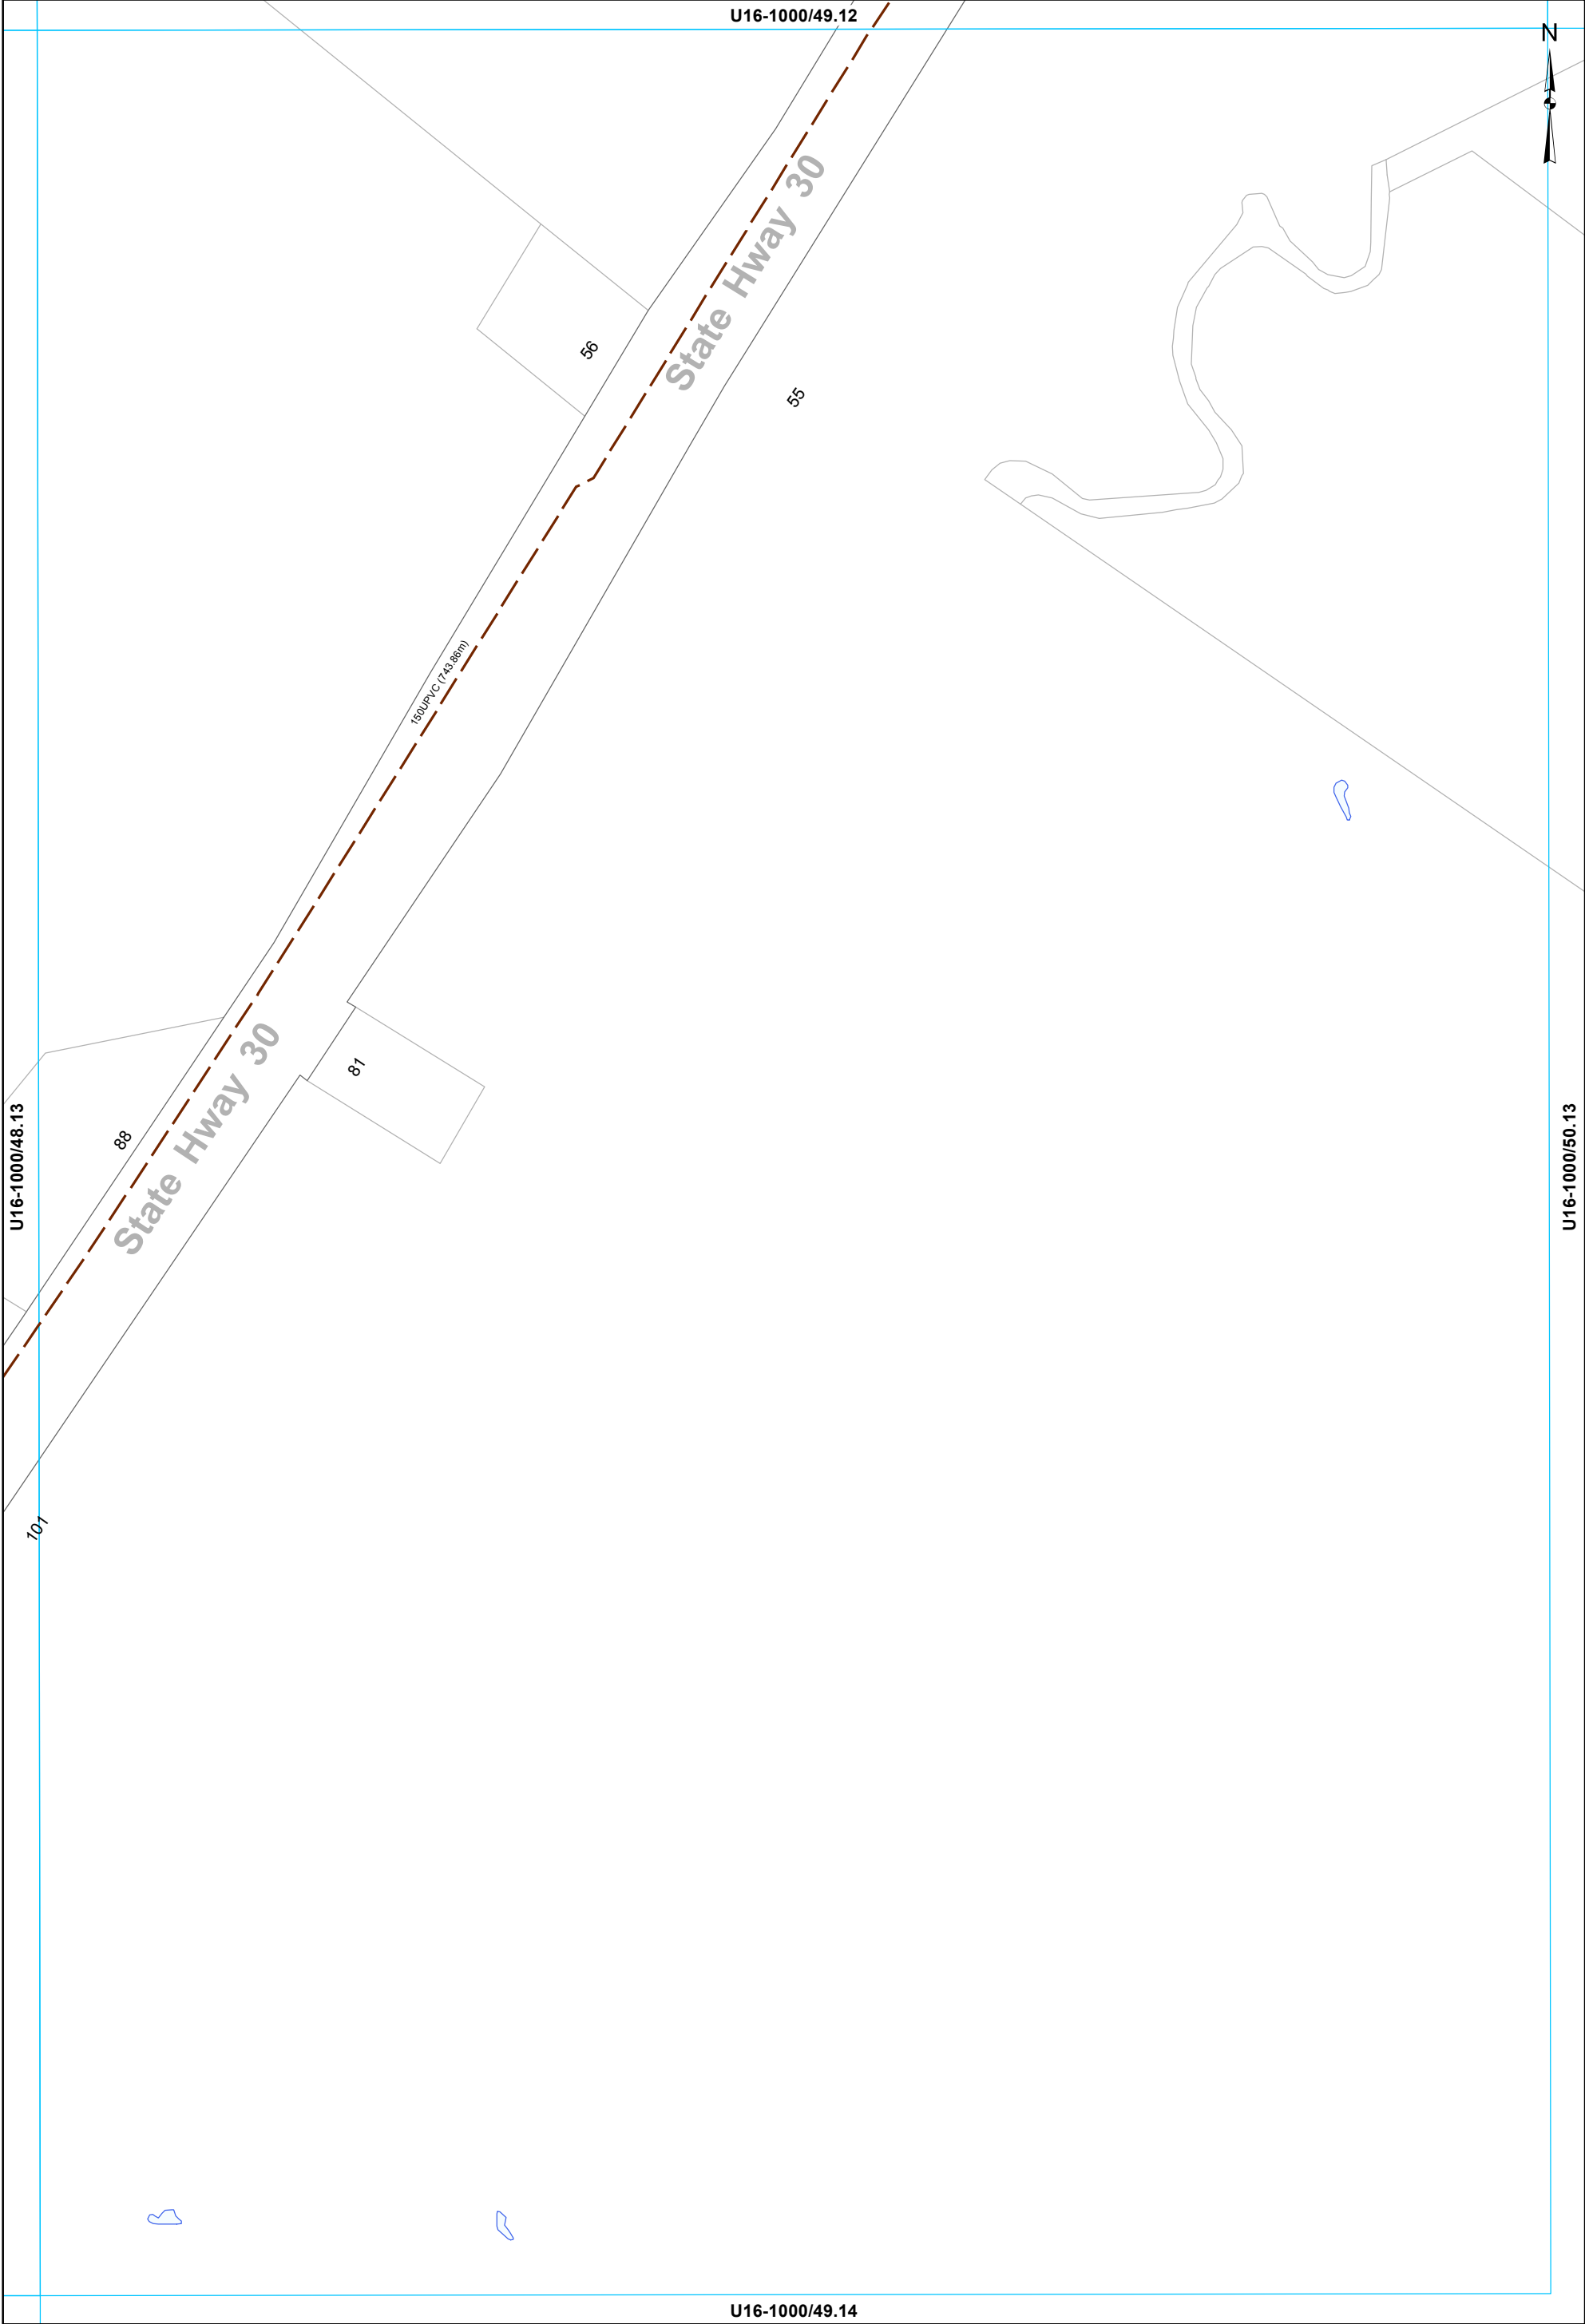

— Rising main

WASTEWATER SERVICES
1:2000 @ A3 - (U16-1000/49.13)

This data is derived from sources outside the control of Rotorua District Council and is for information only


Rotorua District Council 2006. Facsimile 07 346 3143 Telephone 07 348 4199 email mail@rdc.govt.nz



WASTEWATER SERVICES
1:2000 @ A3 - (U16-1000/46.14)



- WASTEWATER SERVICES**
1:2000 @ A3 - (U16-1000/47.14)

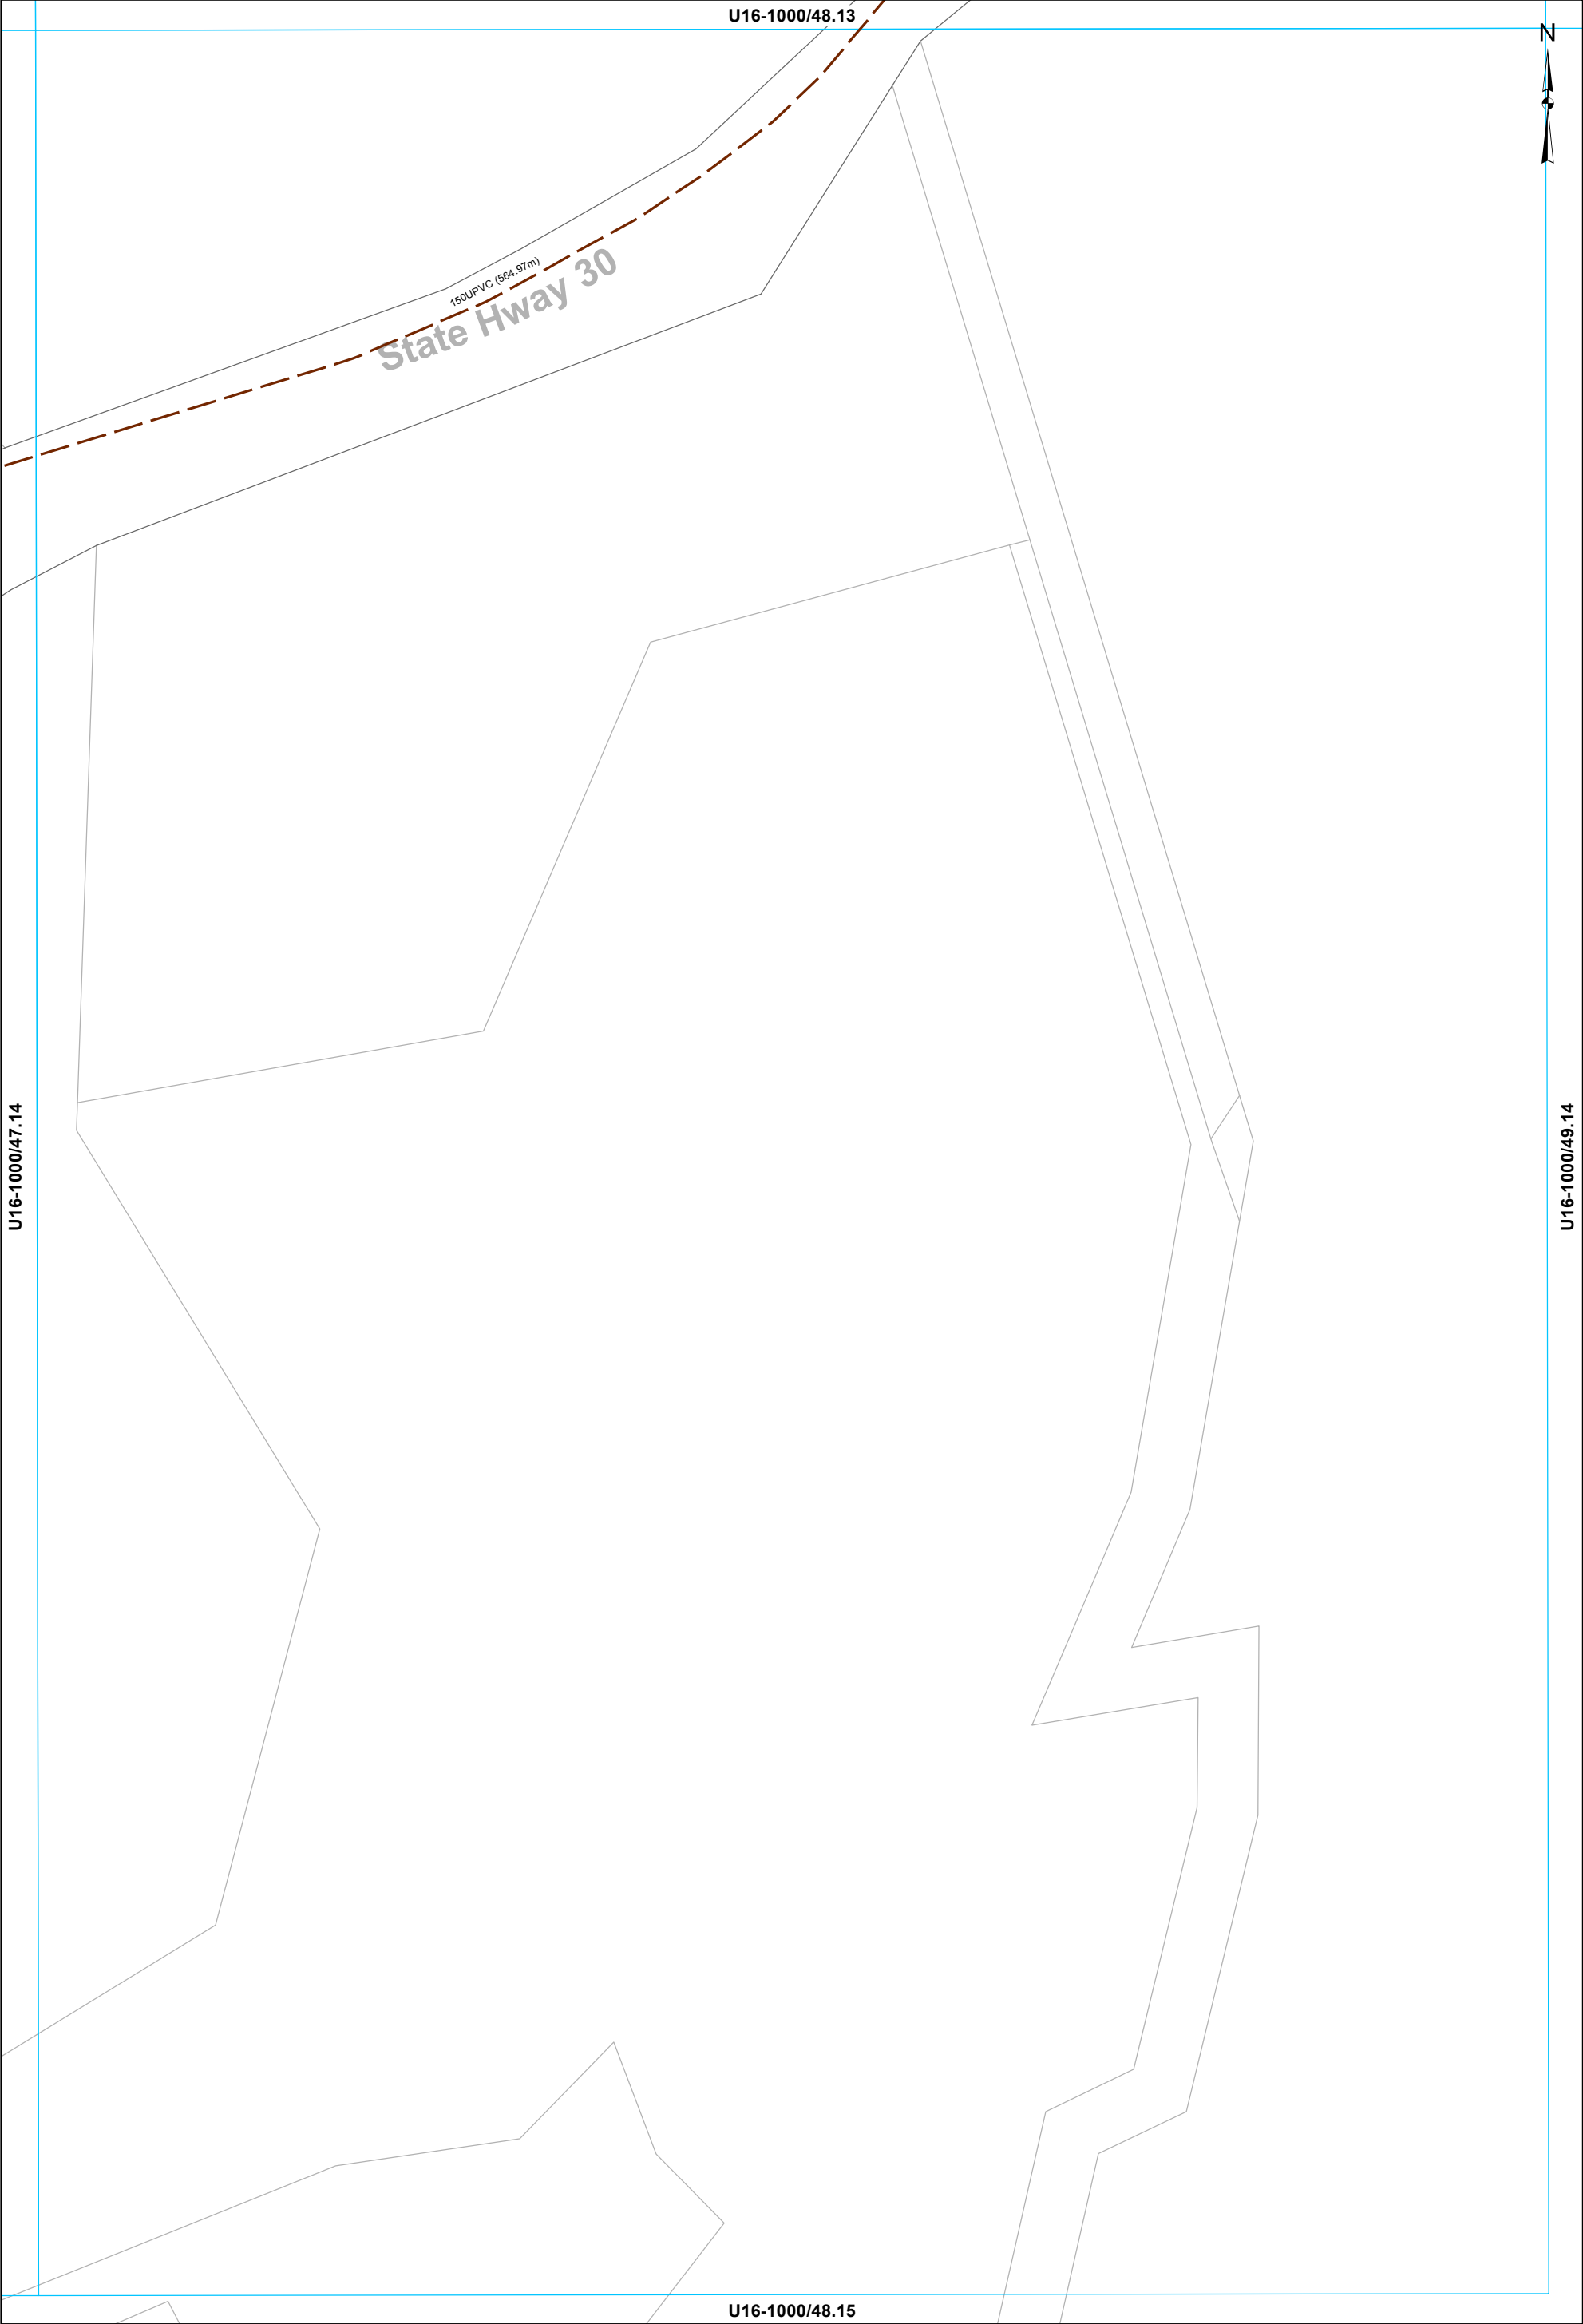

— Rising main