




Waste Water Asbuilt Sheet Index  
FAIRY\_SPRINGS

Date: 5/2/2023

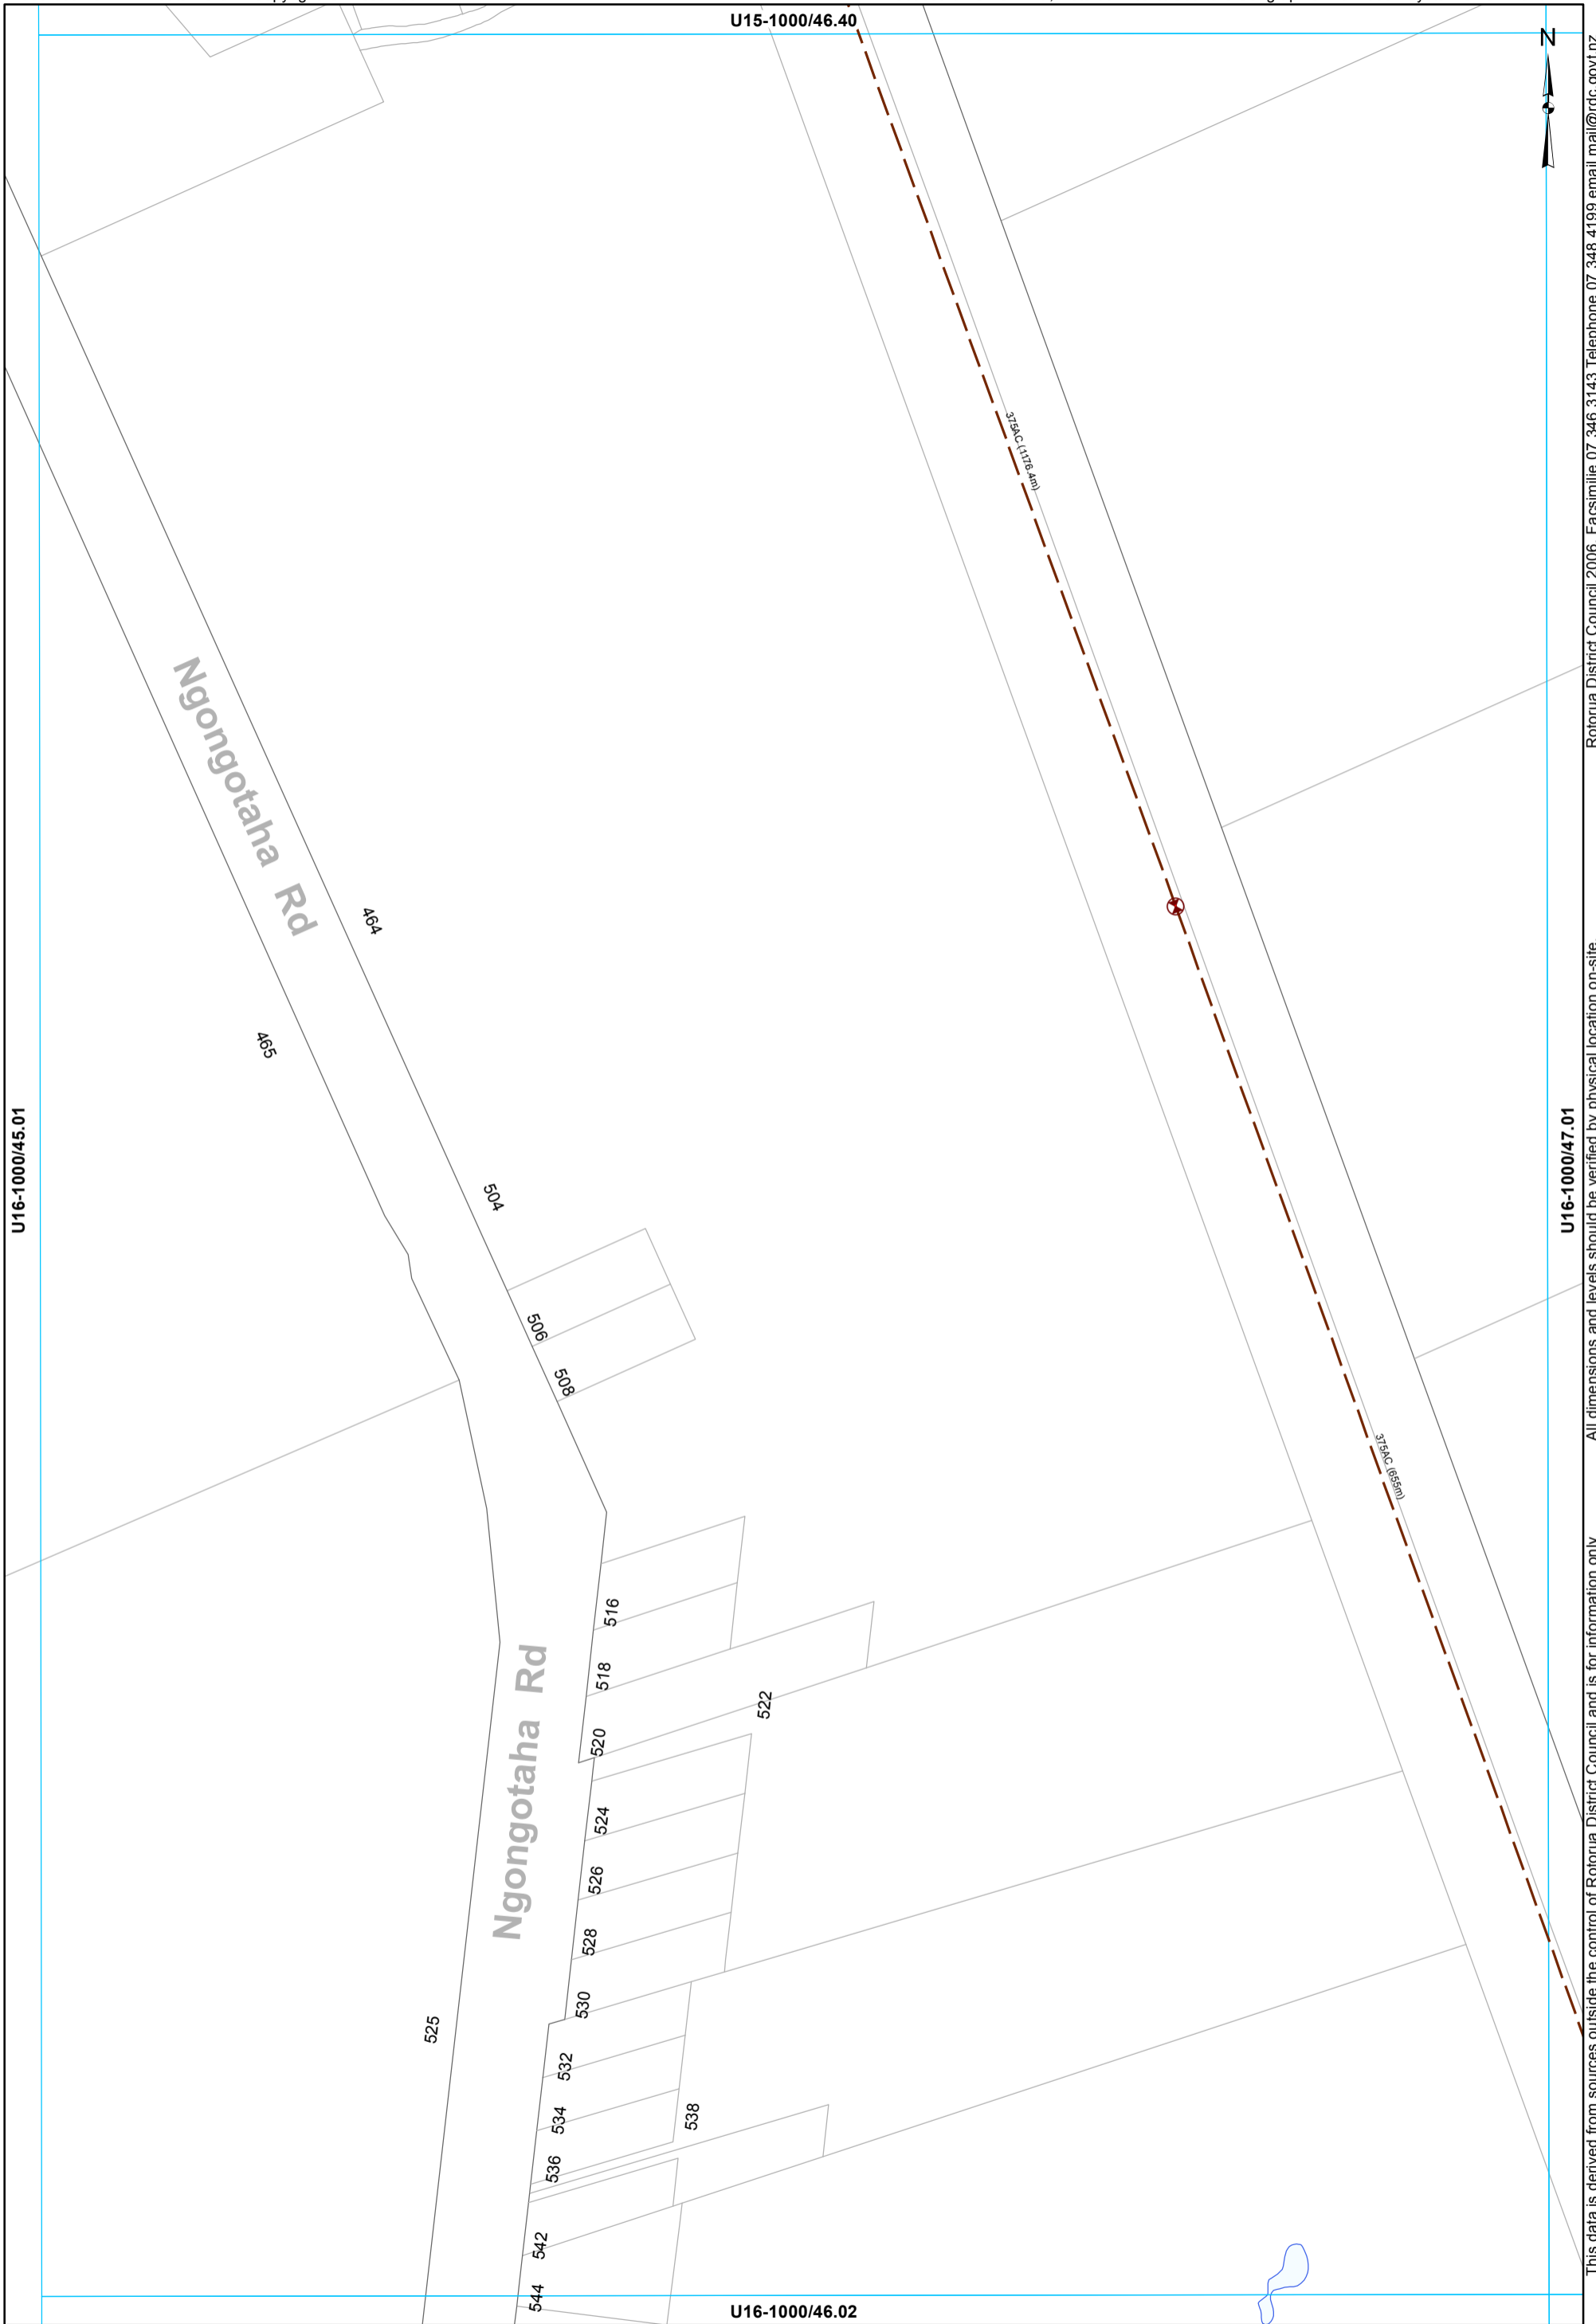


 Air Valve
  - Rising main

**WASTEWATER SERVICES**  
 1:2000 @ A3 - (U16-1000/46.01)



This data is derived from sources outside the control of Rotorua District Council and is for information only. All dimensions and levels should be verified by physical location on-site. Rotorua District Council 2006. Facsimile 07 346 3143 Telephone 07 348 4199 email mail@rdc.govt.nz

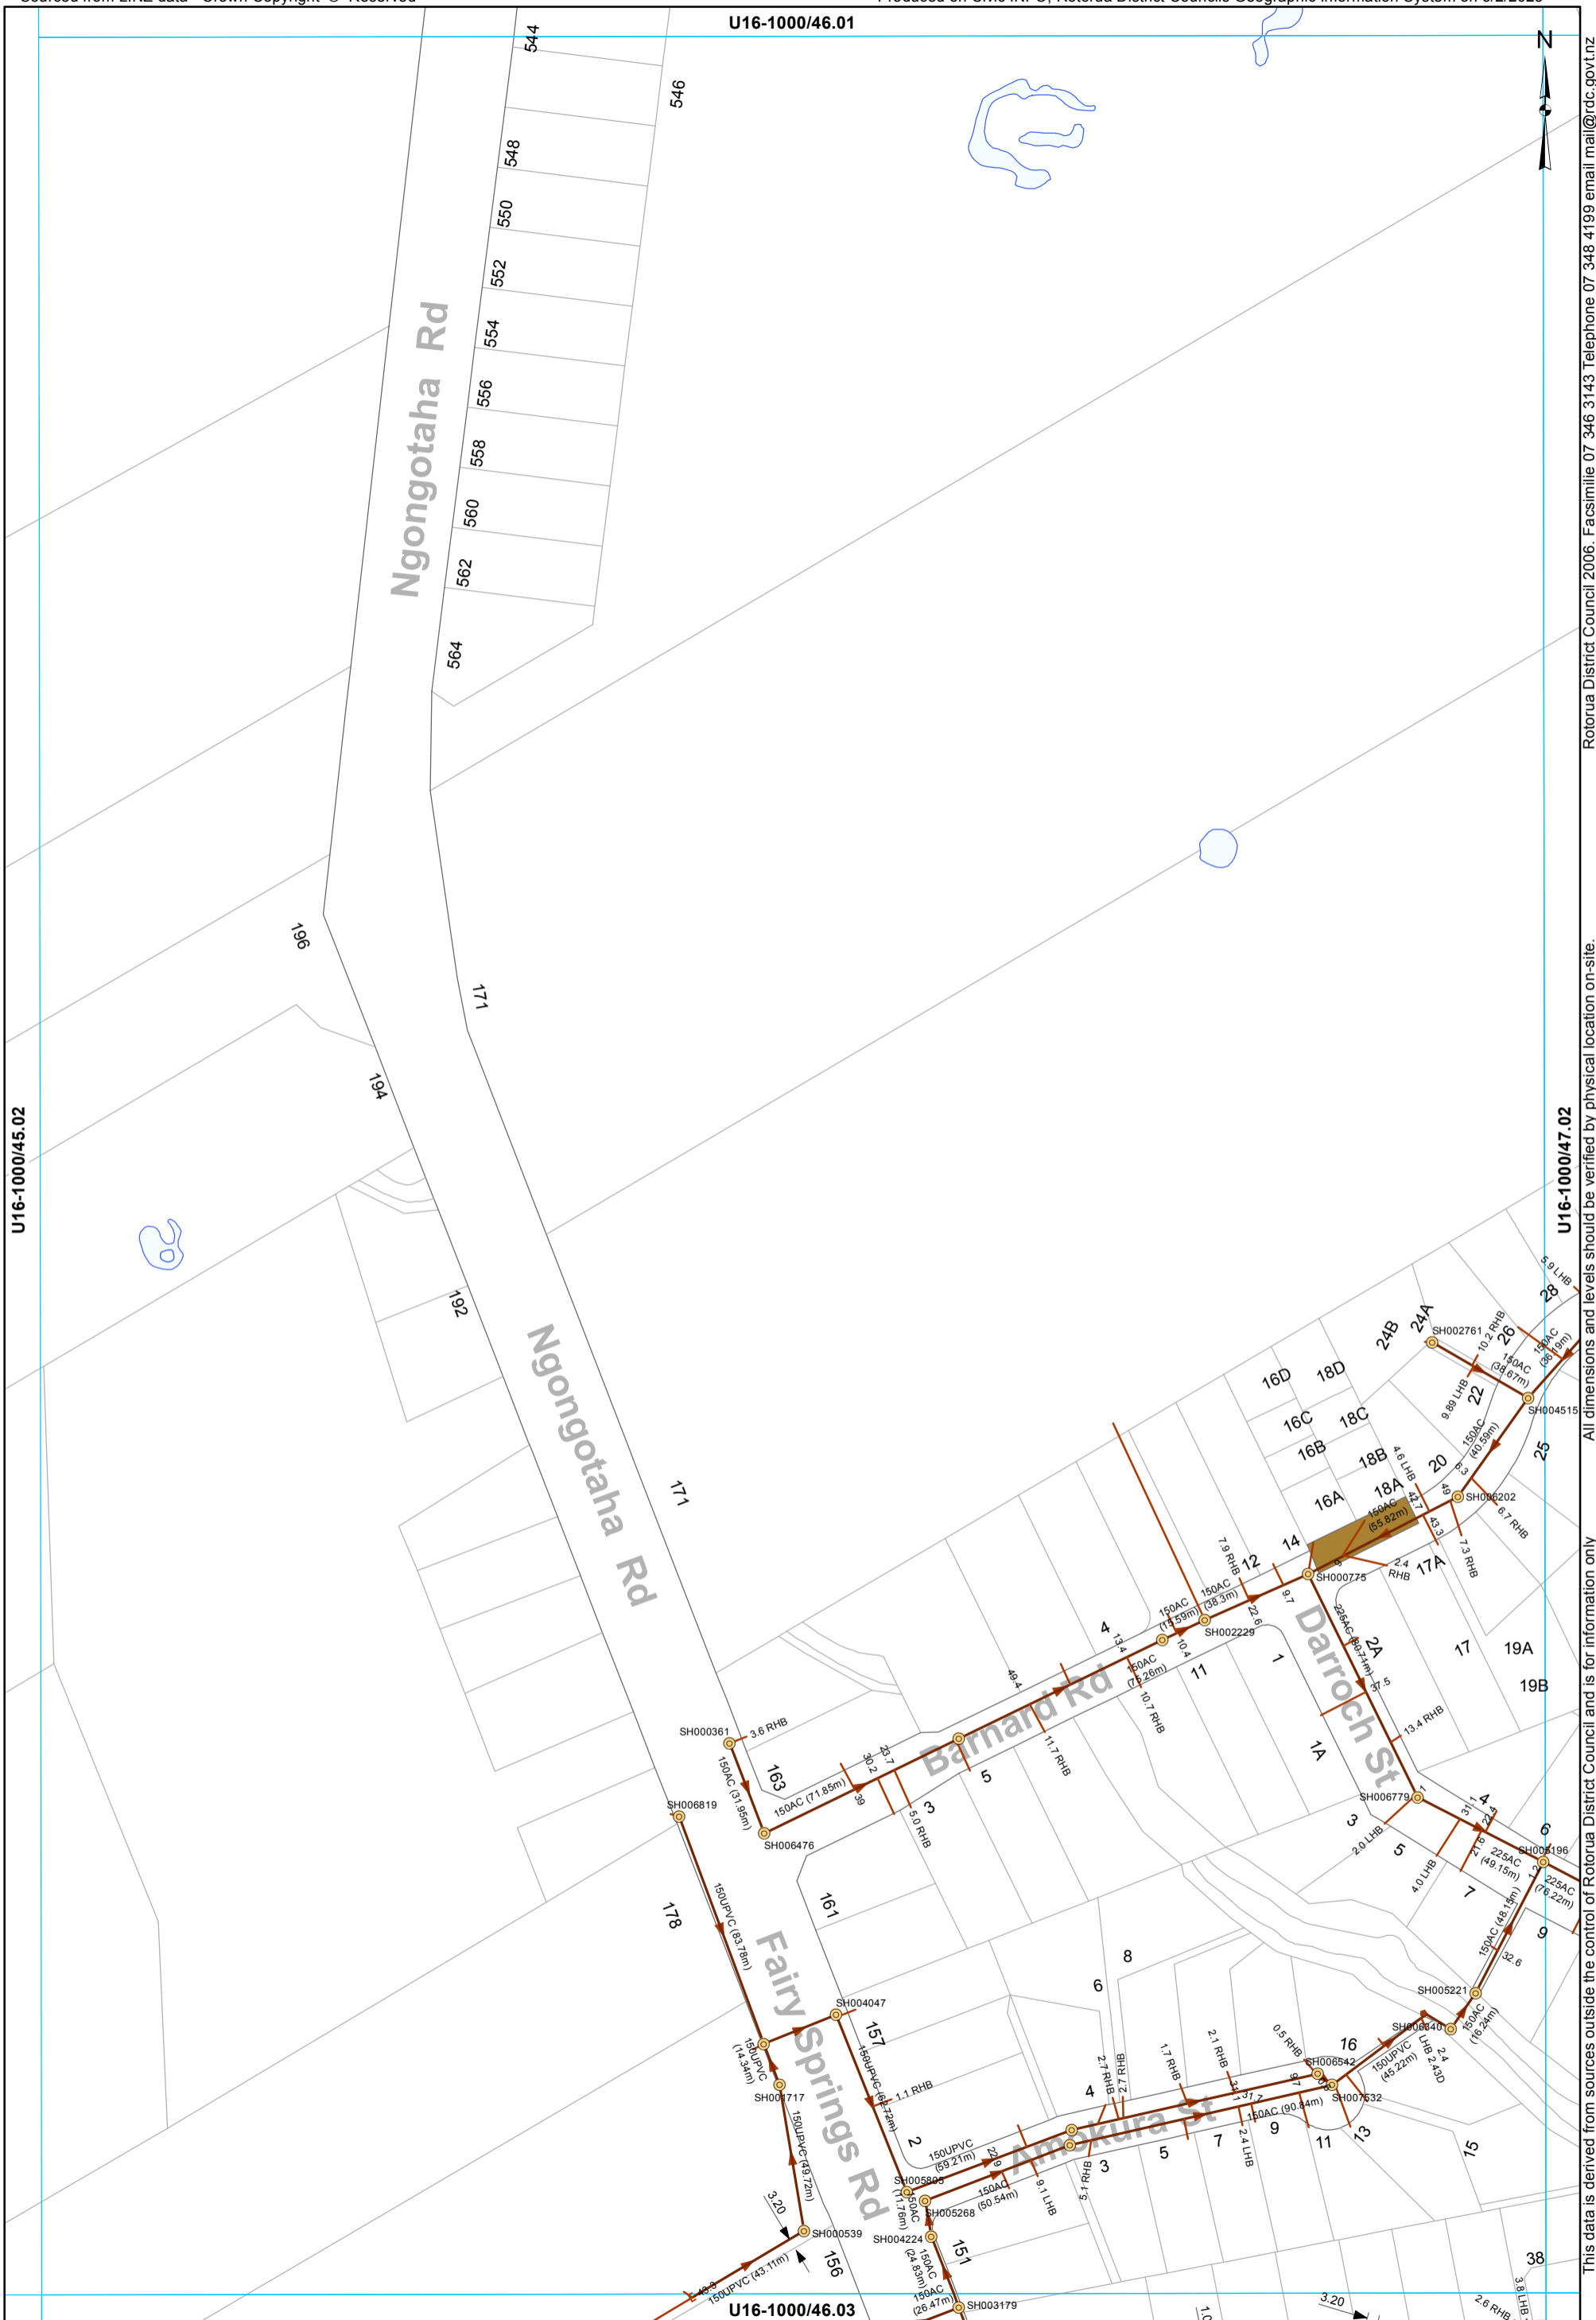

- Manhole
- End of line - Capped end
- End of line - Cleaning eye
- Main line
- Service Line

**WASTEWATER SERVICES**  
**1:2000 @ A3 - (U16-1000/46.02)**

This data is derived from sources outside the control of Rotorua District Council and is for information only

Rotorua District Council 2006. Facsimile 07 346 3143 Telephone 07 348 4199 email mail@rdc.govt.nz

U16-1000/45.02

U16-1000/46.01

U16-1000/47.02

U16-1000/46.03