


Waste Water Asbuilt Sheet Index
MOUNTAIN_ROAD

Date: 5/2/2023

U16-1000/42.04

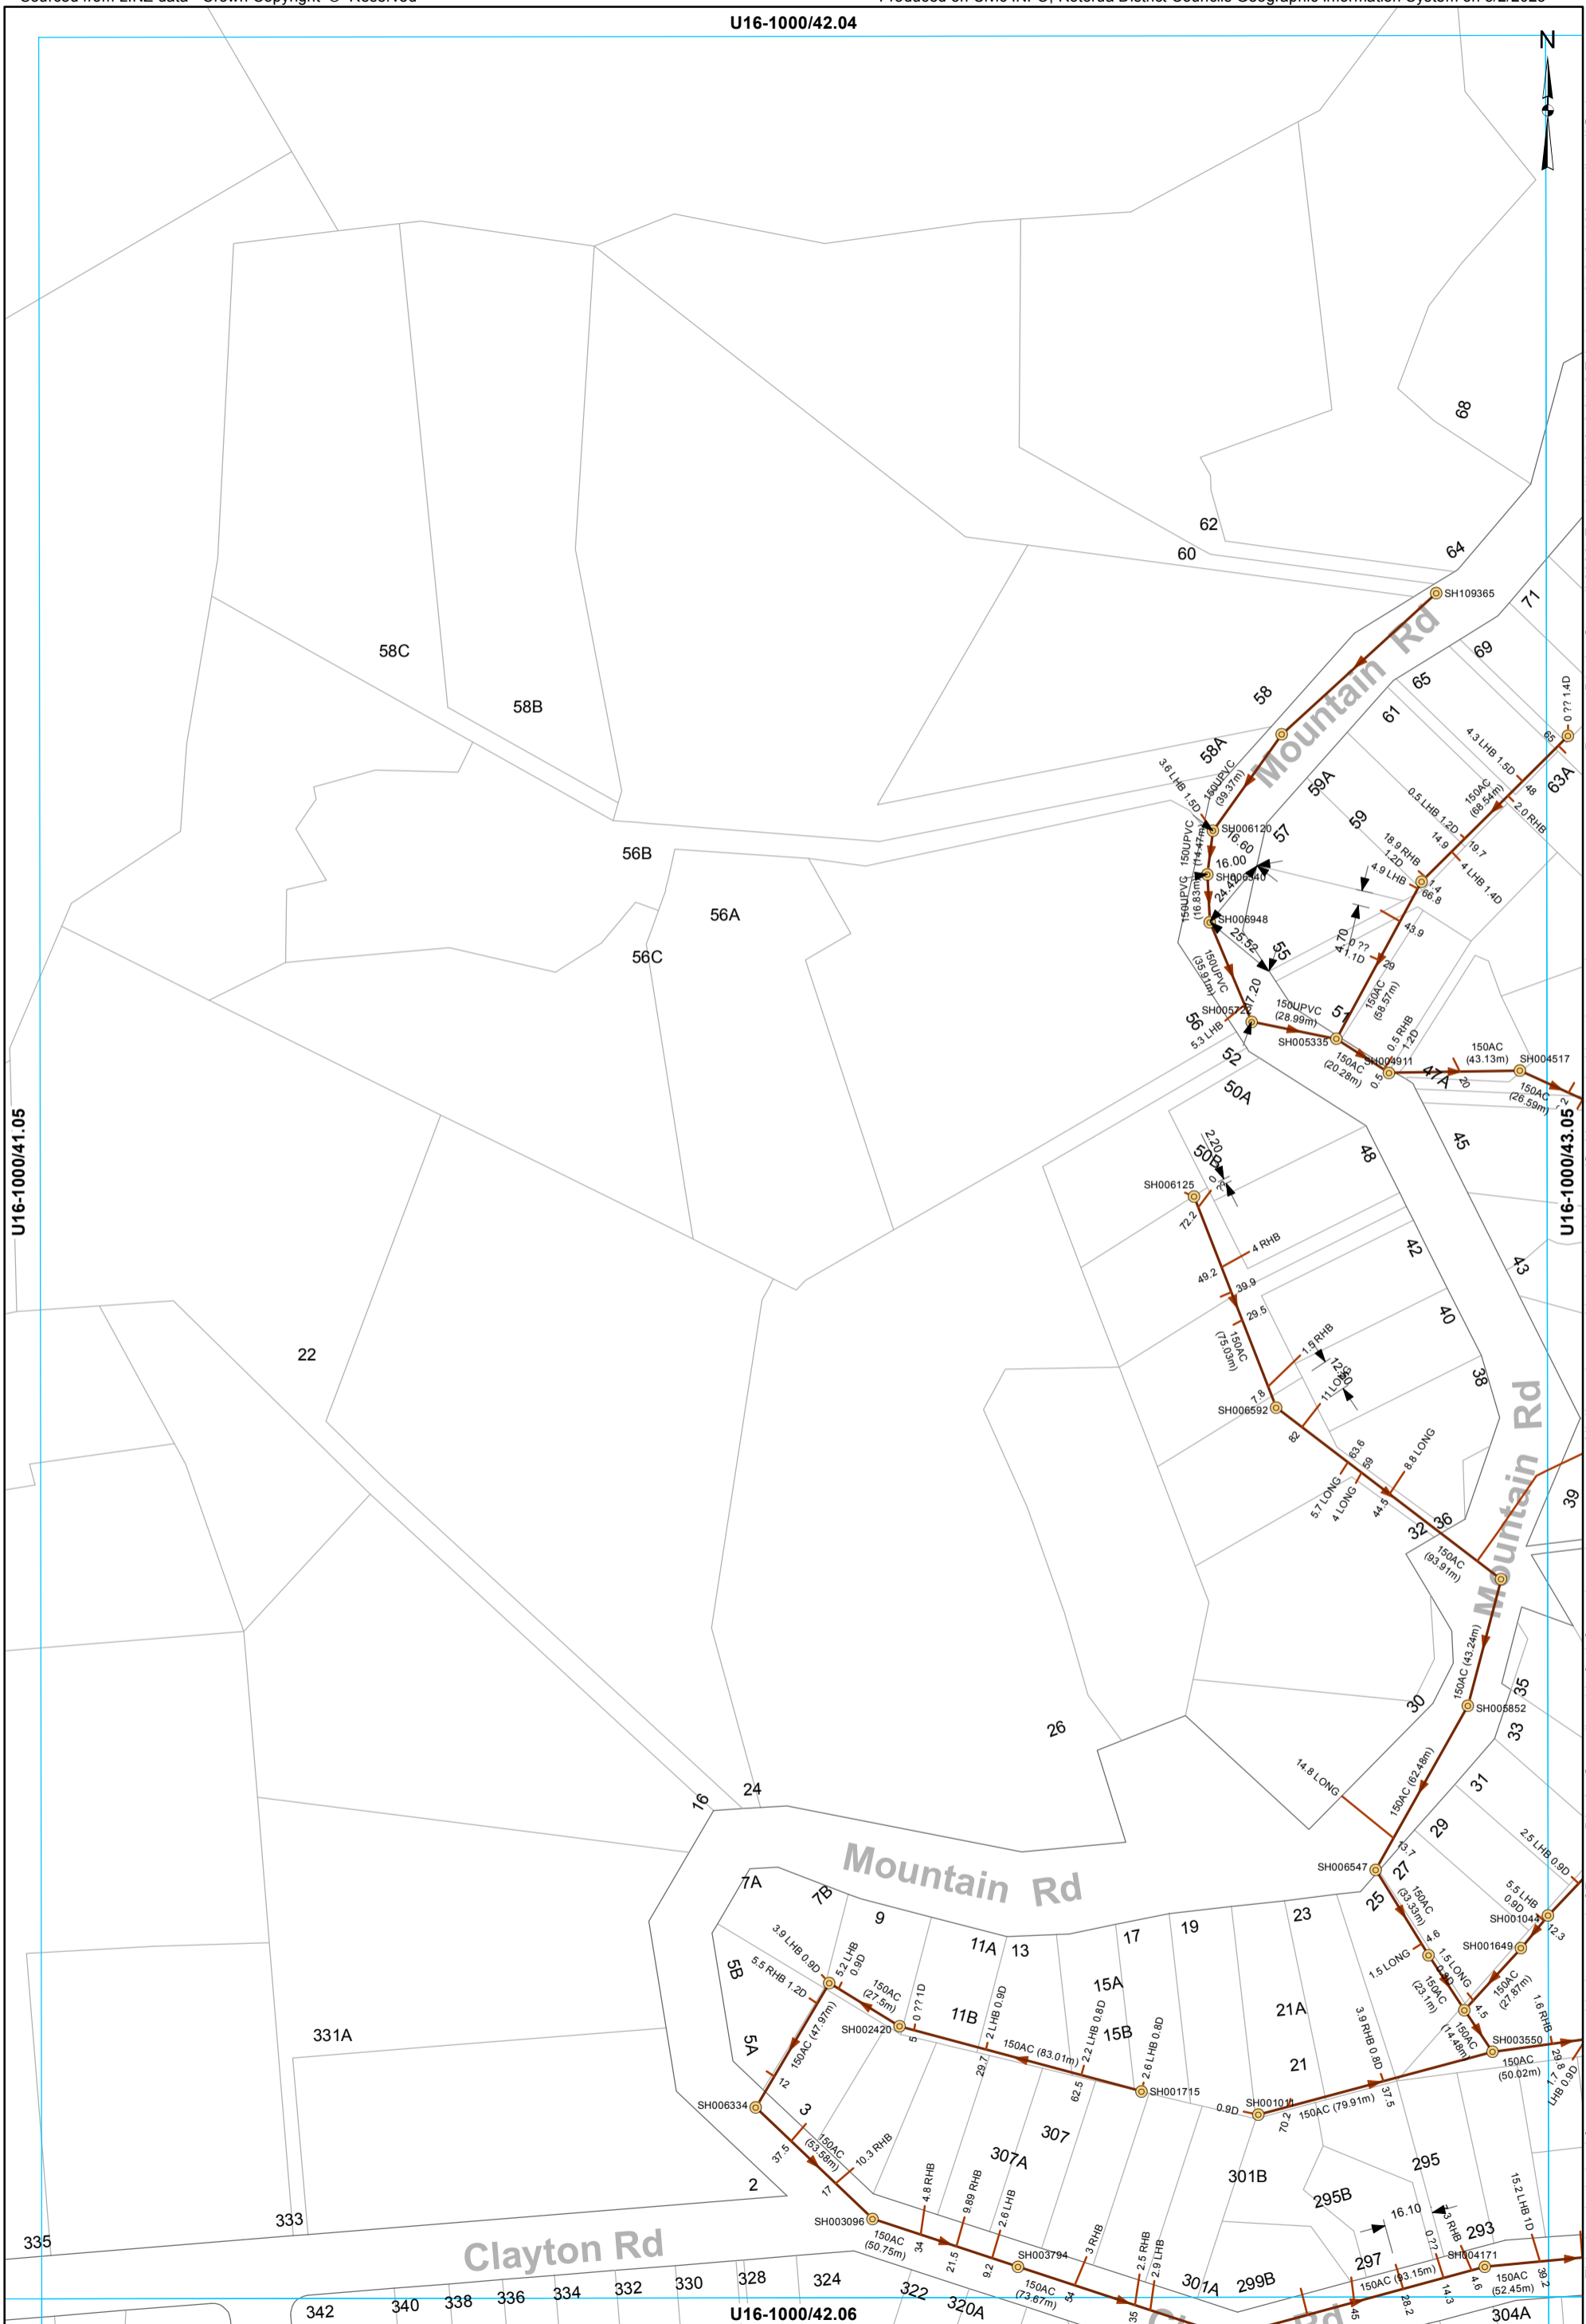

Manhole
 Main line
 Service Line

WASTEWATER SERVICES
1:2000 @ A3 - (U16-1000/42.05)


This data is derived from sources outside the control of Rotorua District Council and is for information only. All dimensions and levels should be verified by physical location on-site. Rotorua District Council 2006. Facsimile 07 346 3143 Telephone 07 348 4199 email mail@rdc.govt.nz

U16-1000/41.05

U16-1000/43.05

U16-1000/42.06


U16-1000/43.04

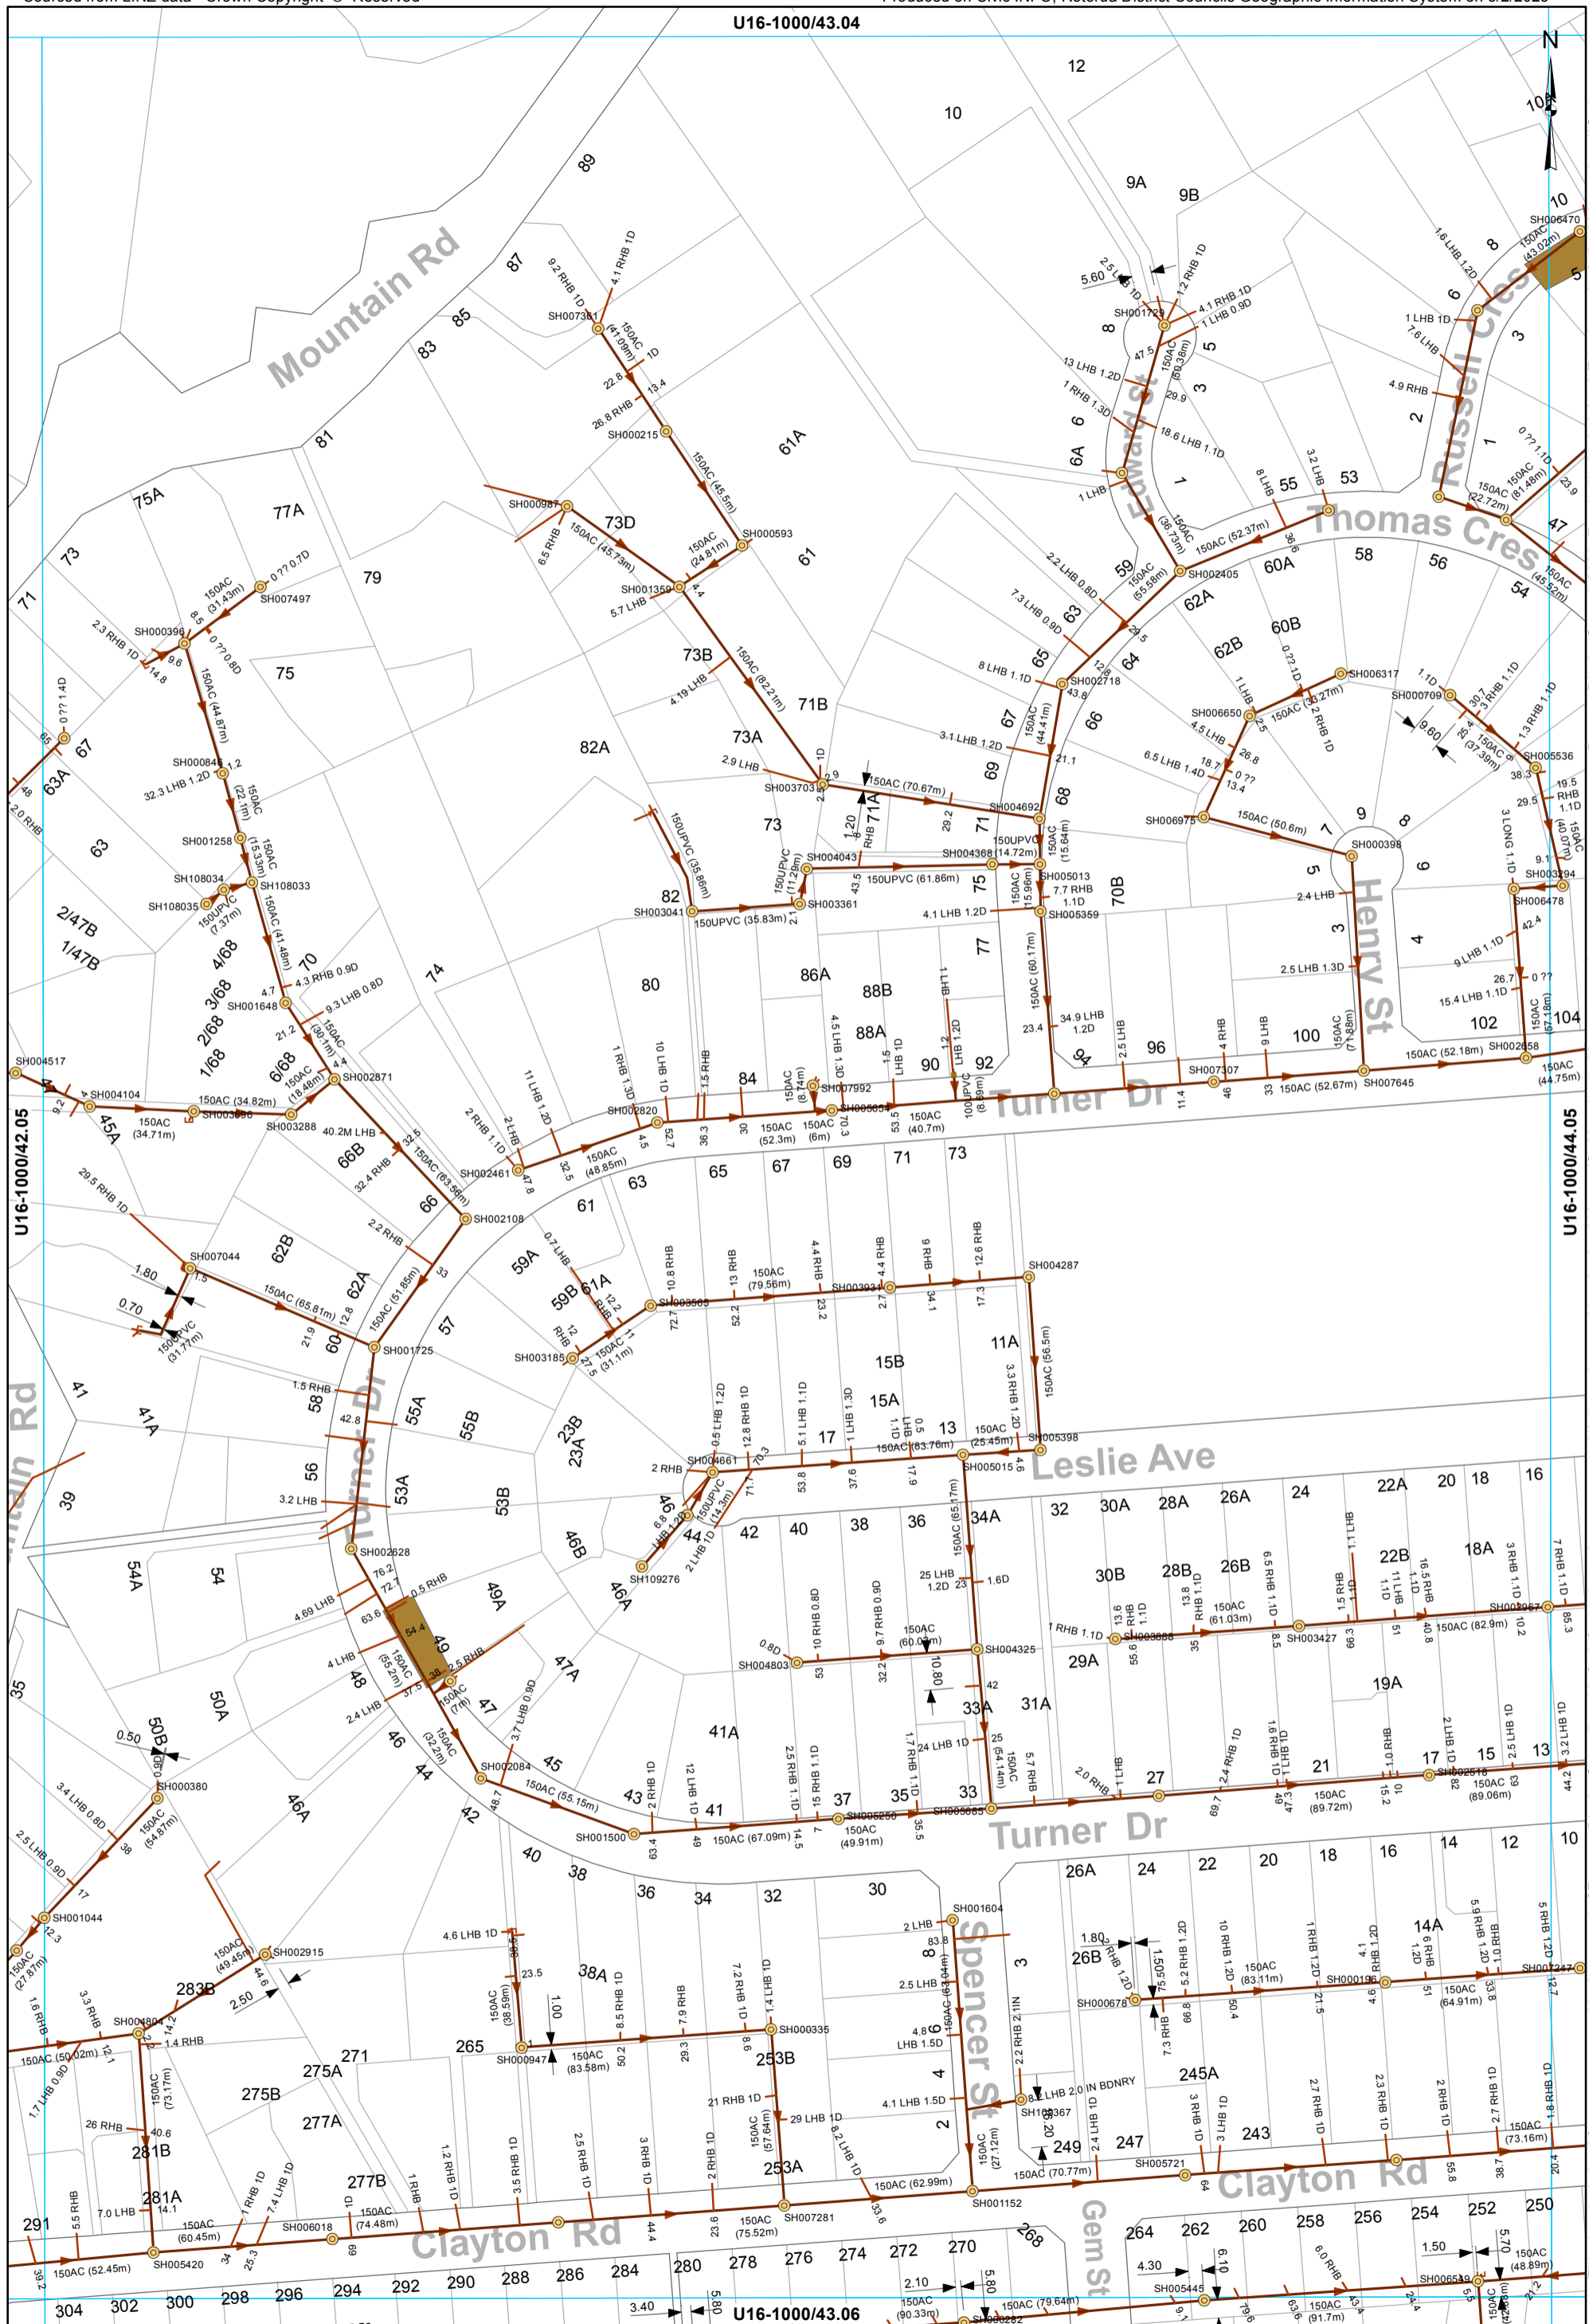

- Manhole
- Chamber - Inspection
- End of line - Capped end
- Main line
- Service Line

WASTEWATER SERVICES
1:2000 @ A3 - (U16-1000/43.05)

All dimensions and levels outside the control of Rotorua District Council and is for information only. Rotorua District Council 2006. Facsimile 07 346 3143 Telephone 07 348 4199 email mail@rdc.govt.nz

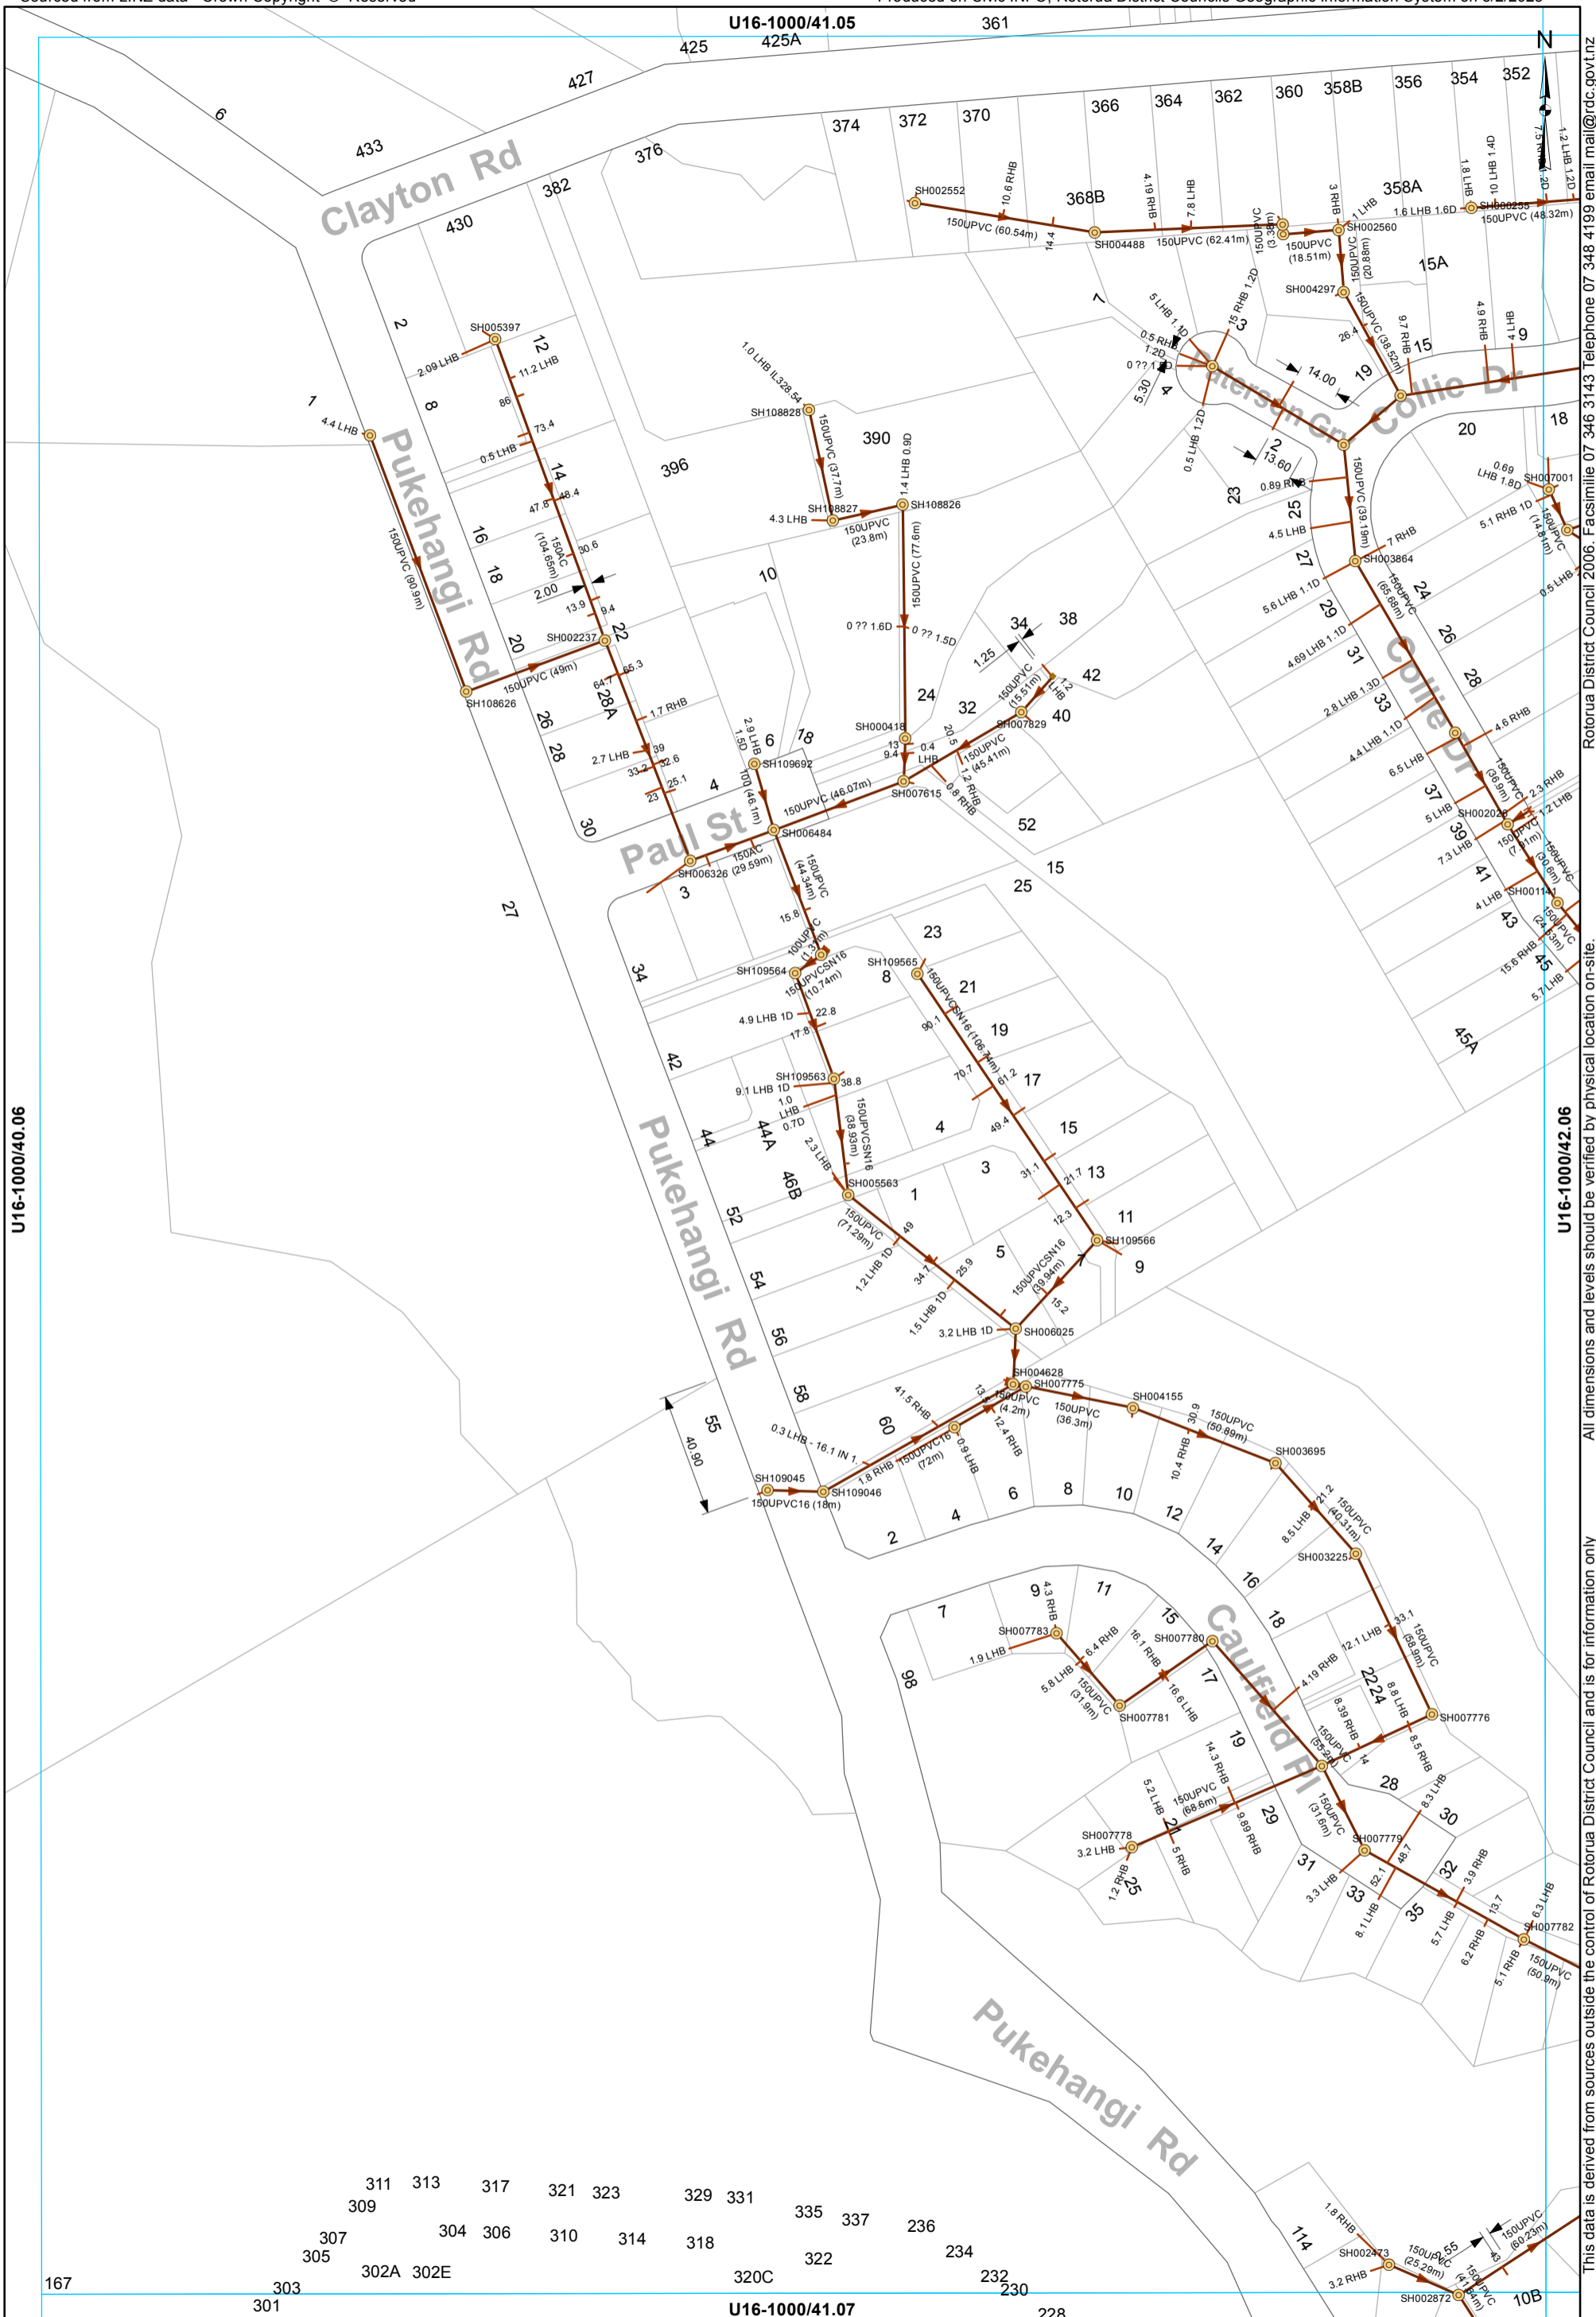

- Manhole
- Chamber - Inspection
- End of line - Capped end
- Main line
- Service Line

WASTEWATER SERVICES
1:2000 @ A3 - (U16-1000/41.06)

This data is derived from sources outside the control of Rotorua District Council and is for information only

Rotorua District Council 2006. Facsimile 07 346 3143 Telephone 07 348 4199 email mail@rdc.govt.nz