


Waste Water Asbuilt Sheet Index
PARADISE_VALLEY

Date: 5/2/2023

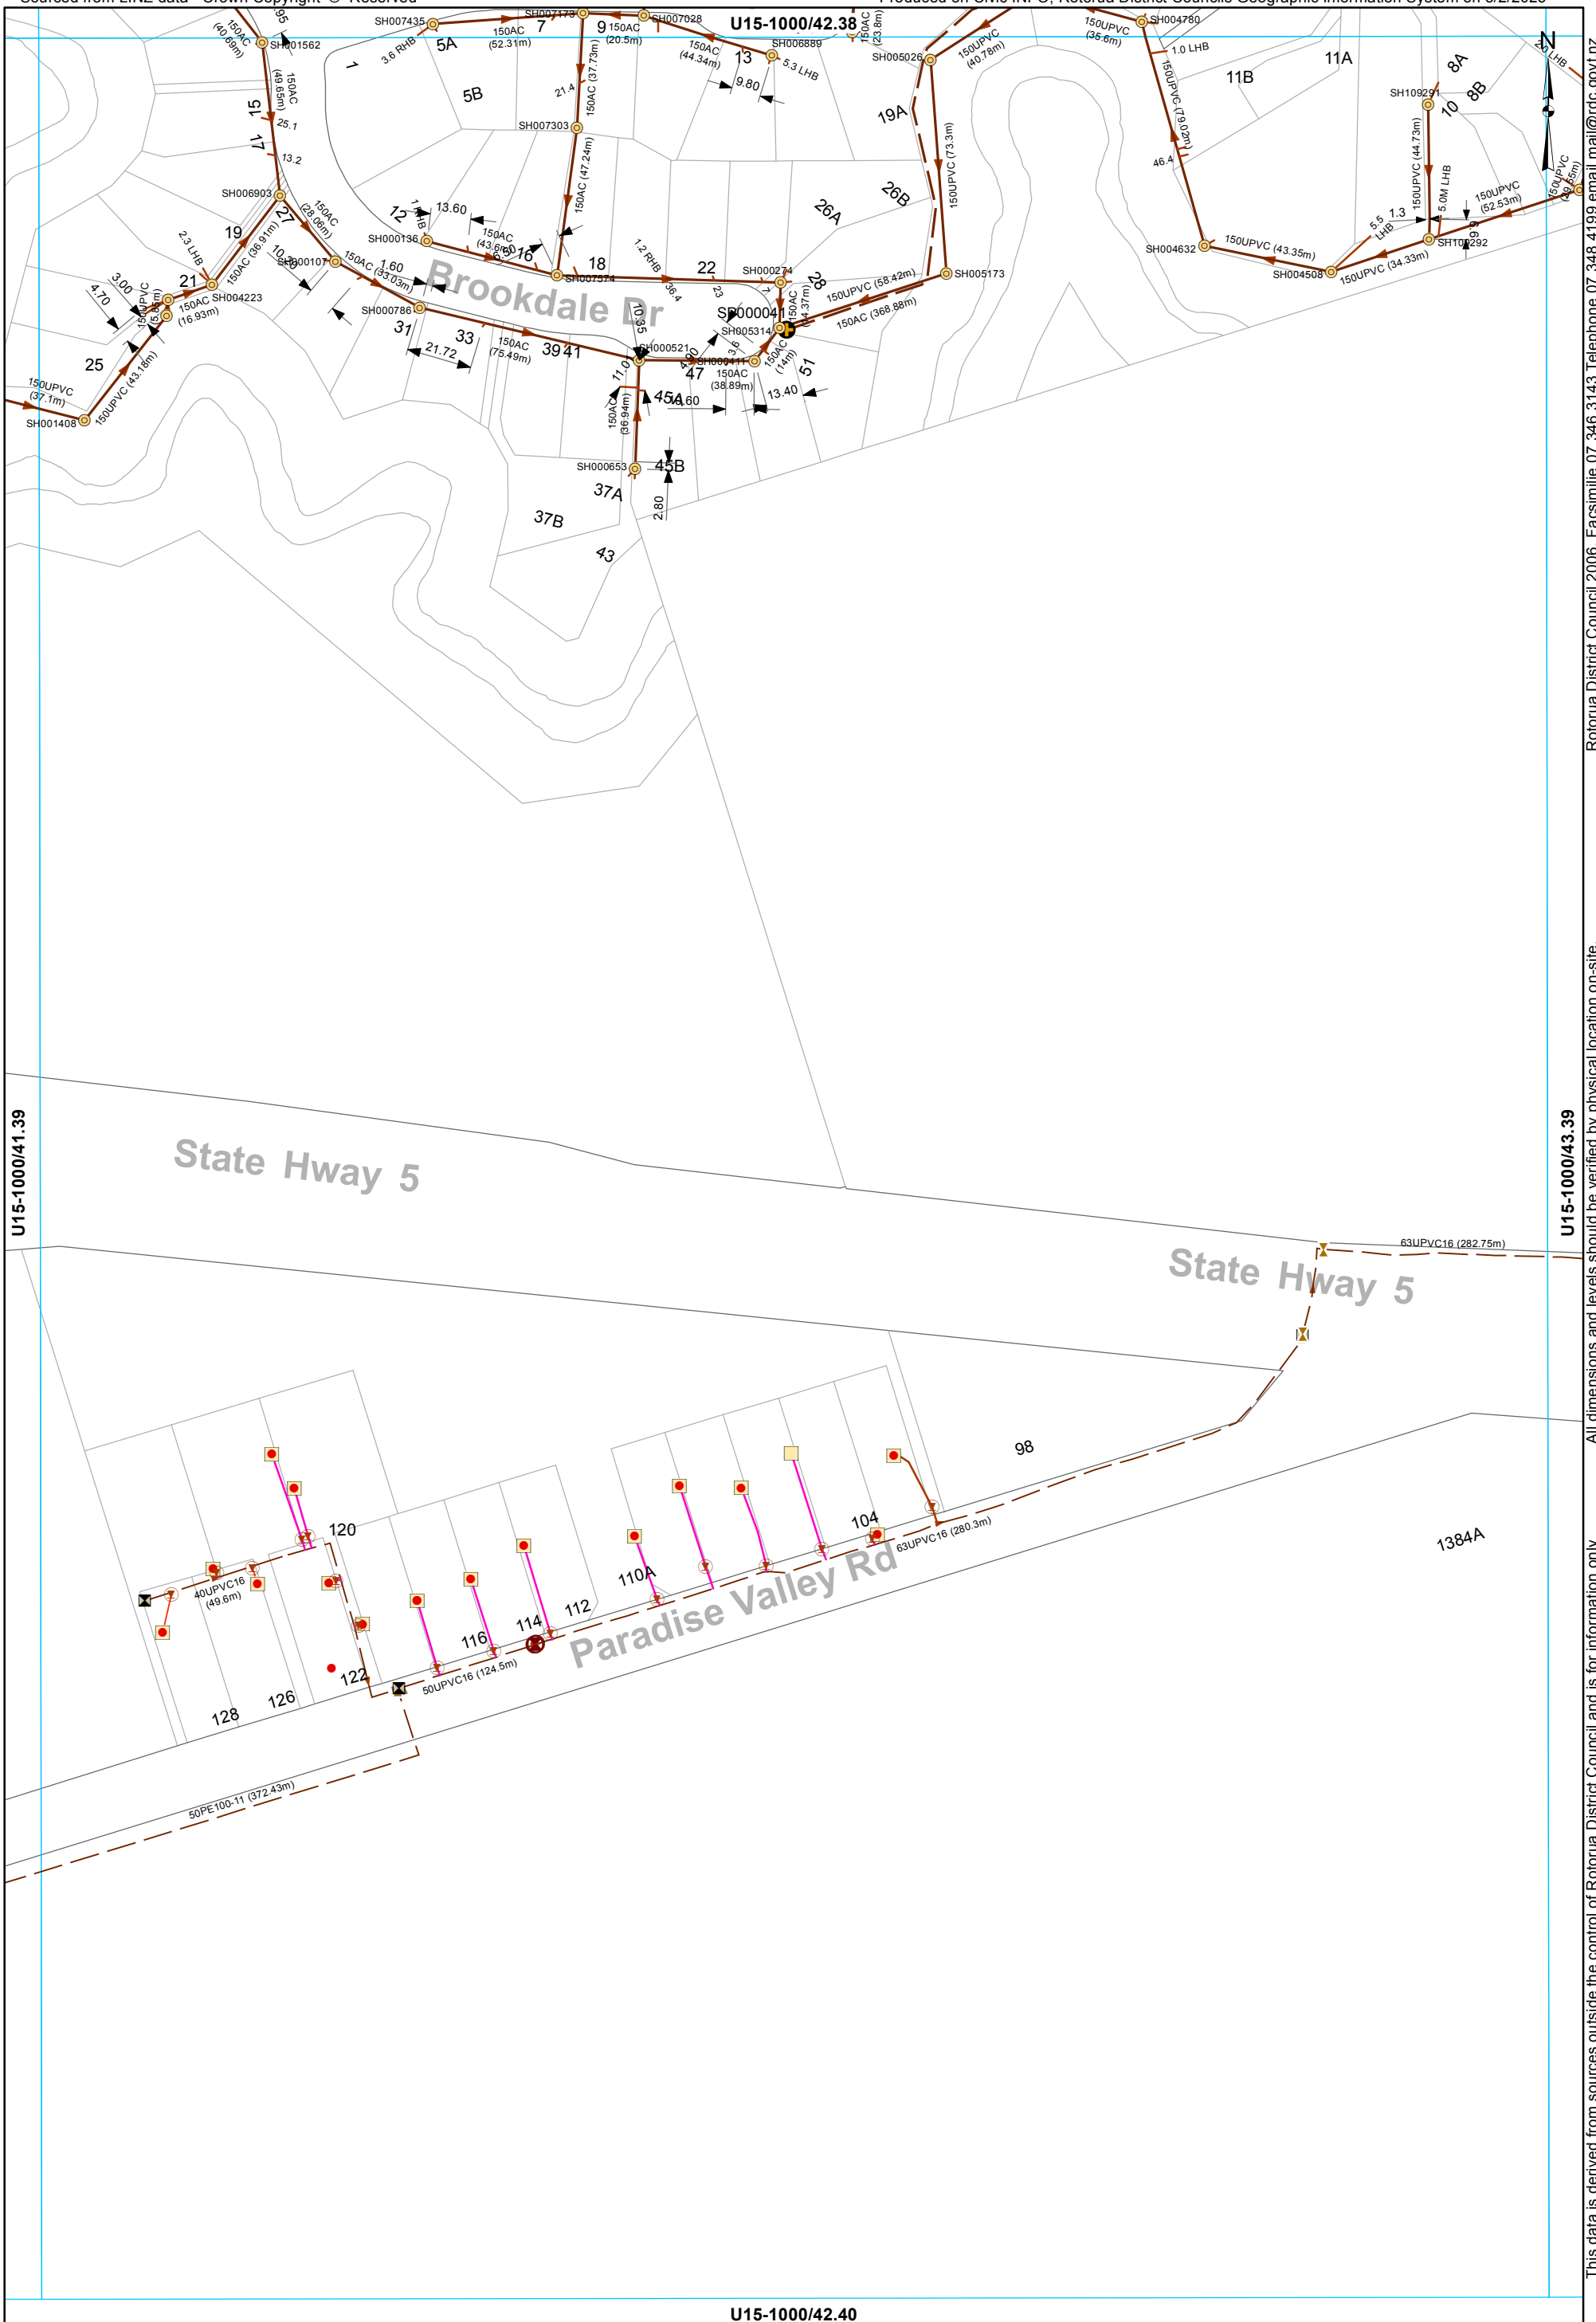

U15-1000/41.39

U15-1000/43.39

U15-1000/42.40

- Manhole
- ⊕ Pump Station
- Grinder Pump Chamber
- LP Grinder Pump
- ⊗ Air Valve
- ⊠ Boundary Assembly
- ⊞ Clean Out Point
- ⊡ Isolating Valve
- Low Pressure Main
- Main line
- Rising main
- Unknown Service Line
- Service Line
- LPGP Service Line

WASTEWATER SERVICES
1:2000 @ A3 - (U15-1000/42.39)

All dimensions and levels should be verified by physical location on-site.

Rotorua District Council 2006. Facsimile 07 346 3143 Telephone 07 348 4199 email mail@rdc.govt.nz